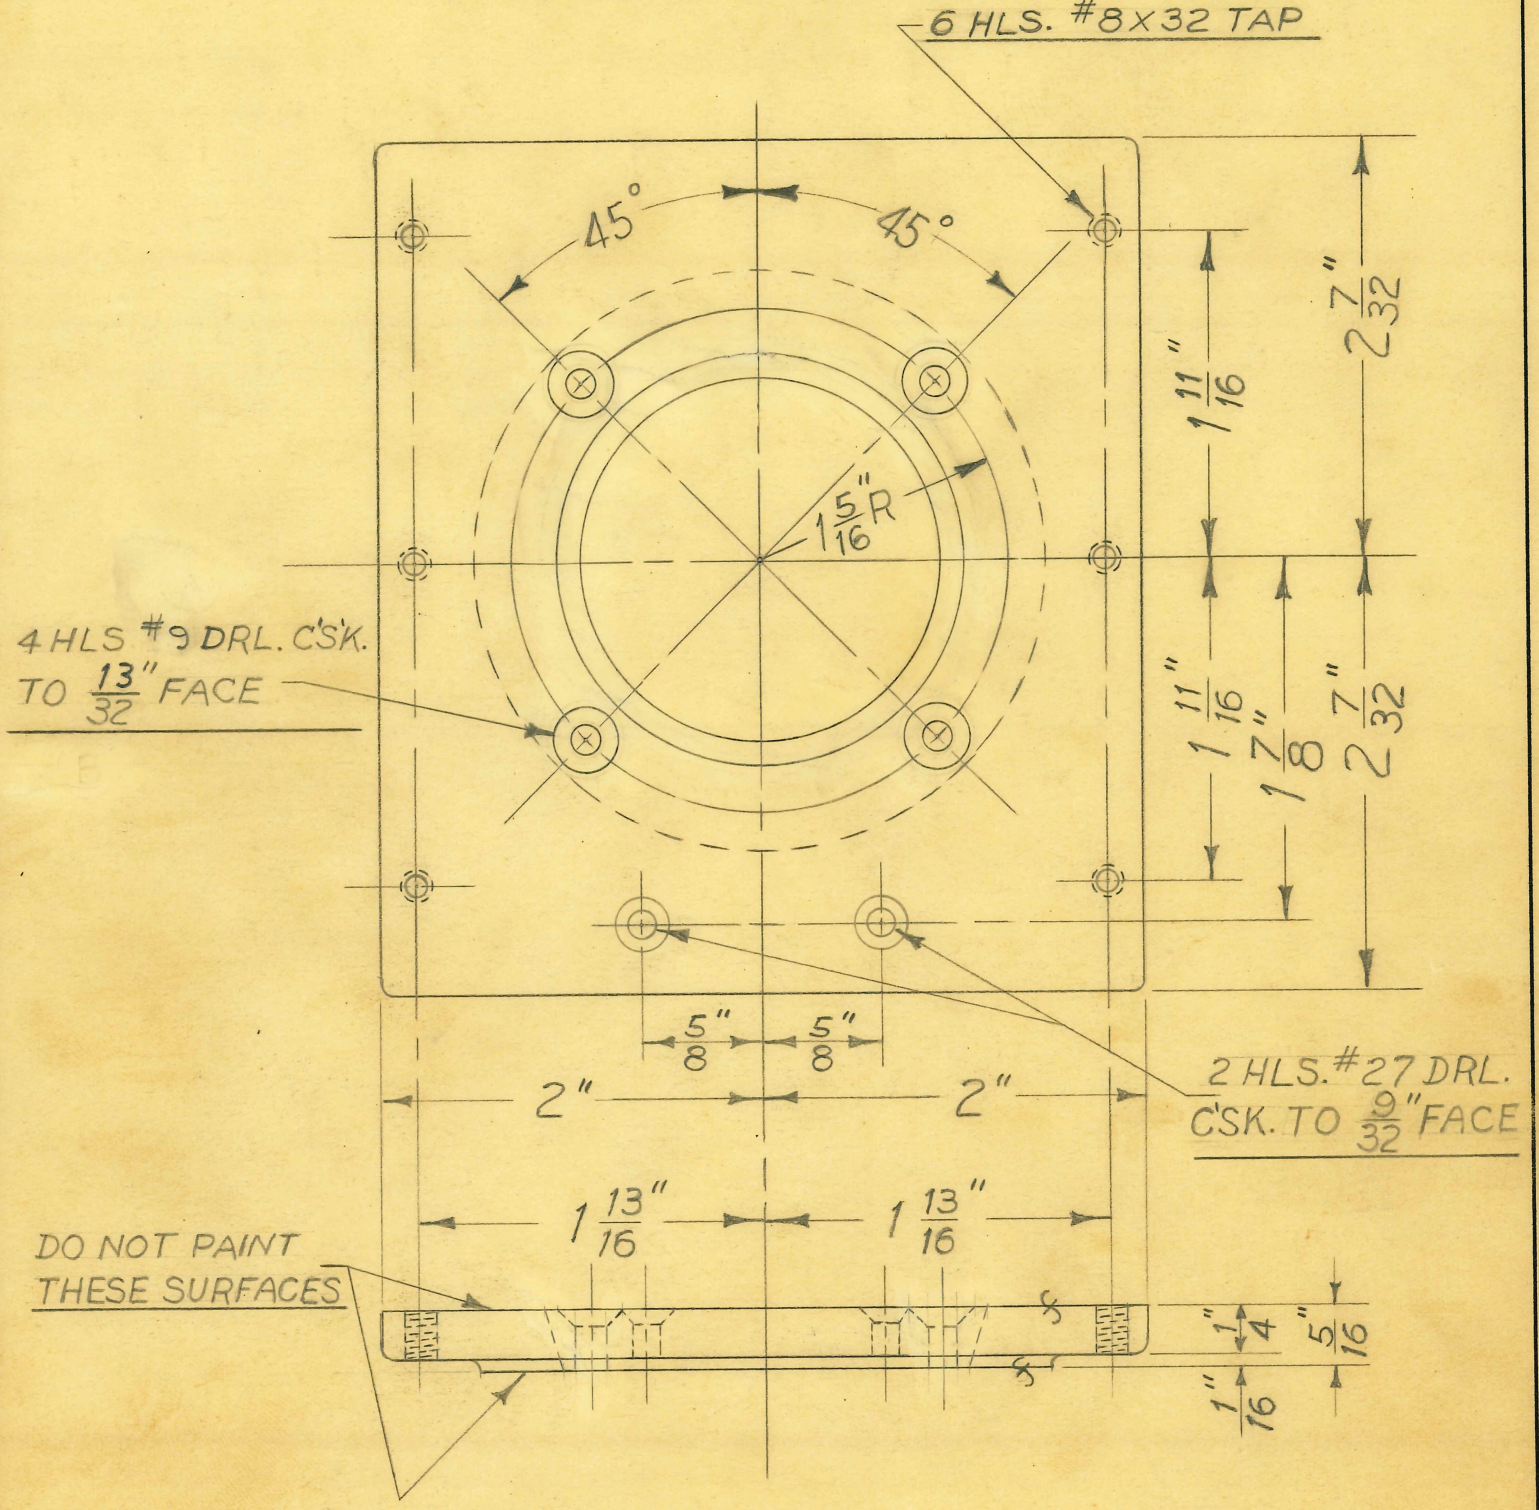

1-REQUIRED

TURN MANDREL #7610
DRILL JIG #7601
13413 FA

DIMENSIONS	
FRACTIONAL	± .015
DECIMAL	± .005
ANGULAR	± 1/2°

UNLESS OTHERWISE SPECIFIED

SIZE	#12 ALUM.	ISSUE 2-12-48	J.B.G.
KIND	CASTING	CHANGED	
SHAPE		"	
FINISH	PAINTED	"	
~~TEMP.~~	(SEE NOTE)	"	
PATT.	#2315	"	

TITLE: FISCHER "DE LUXE RF100" X-RAY UNIT – TUBE HEAD ADAPTOR

H. G. FISCHER & CO.
2335 WABANSIA AVE.
CHICAGO, ILL.

CAT. NO.

PART NO. 17311-F

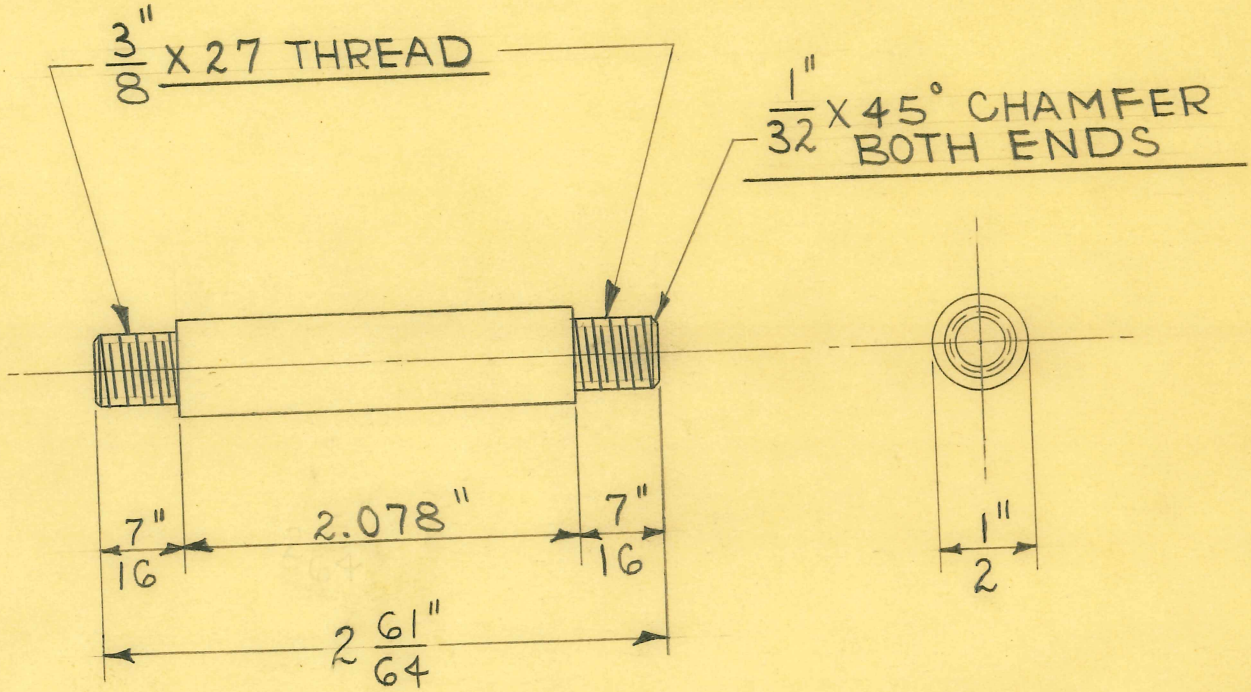

1 REQUIRED

DIMENSIONS	
FRACTIONAL	± .015
DECIMAL	± .005
ANGULAR	± 1/2°

UNLESS OTHERWISE SPECIFIED

SIZE	1/2" DIA.	ISSUE 5-5-48	W.J.
KIND	C.R. STEEL	CHANGED	
SHAPE	ROD	"	
FINISH	CAD. #23	"	
TEMP.		"	
PATT.		"	

TITLE: FISCHER DELUXE RF-100 X-RAY UNIT SCREEN PIVOT SHAFT

H. G. FISCHER & CO.
2335 WABANSIA AVE.
CHICAGO, ILL.

CAT. NO.

PART NO. 17314

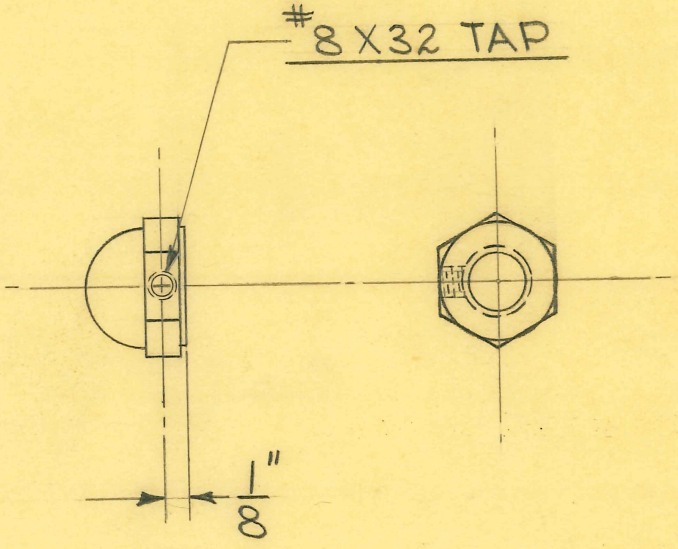

1 REQUIRED

DRILL JIG TOOL #9808

DIMENSIONS	
FRACTIONAL	± .015
DECIMAL	± .005
ANGULAR	± 1/2°

UNLESS OTHERWISE SPECIFIED

SIZE	FROM 1835	ISSUE 5-5-48	W.J.
KIND		CHANGED	
SHAPE		"	
FINISH		"	
TEMP.		"	
PATT.		"	

TITLE:
FISCHER DELUXE RF-100 X-RAY UNIT
SCREEN PIVOT SHAFT NUT

H. G. FISCHER & CO.
2335 WABANSIA AVE.
CHICAGO, ILL.

CAT. NO.

PART NO. 17315

$\frac{1}{32}$" X 45° CHAMFER ON BOTH ENDS

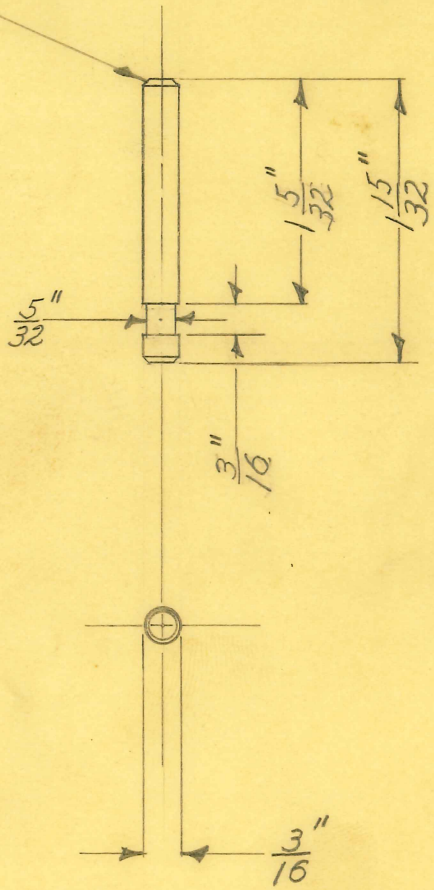

1-REQUIRED

SIZE	3/16" DIAM.	ISSUE 10-22-47	J.M.F
KIND	C.R. STEEL	CHANGED	
SHAPE	ROD	"	
FINISH	CAD. #23	"	
TEMP.		"	
PATT.		"	

TITLE:
FISCHER DELUXE RF-100
LATERAL SLIDE LOCK SUPPORT PIN #1

H. G. FISCHER & CO.
2335 WABANSIA AVE.
CHICAGO, ILL.

CAT. NO.

PART NO. 17316

1/32" X 45° CHAMFER ON BOTH ENDS

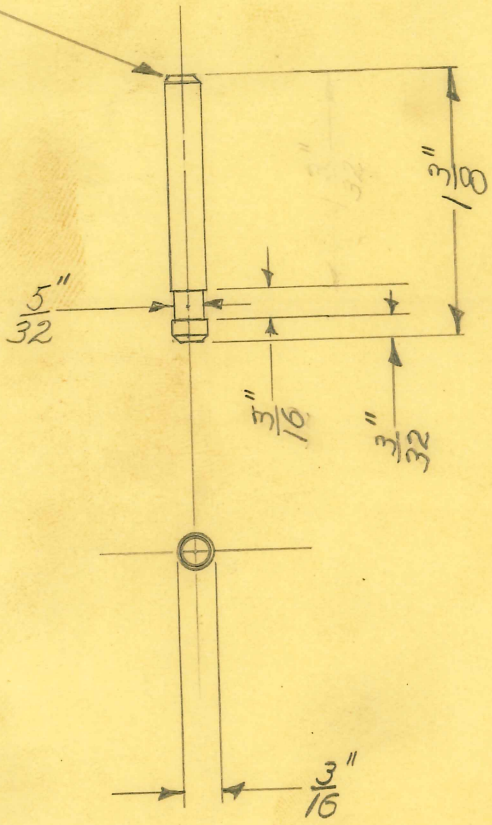

1-REQUIRED

SIZE	3/16" DIAM.	ISSUE 10-22-47	J.M.F
KIND	C.R. STEEL	CHANGED	
SHAPE	ROD	"	
FINISH	CAD. #23	"	
TEMP.		"	
PATT.		"	

TITLE: FISCHER DELUXE RF-100 LATERAL SLIDE LOCK SUPPORT PIN #2

H. G. FISCHER & CO.
2335 WABANSIA AVE.
CHICAGO, ILL.

CAT. NO.

PART NO. 17317

$\frac{1}{32}$" X 45° CHAMFER ON BOTH ENDS

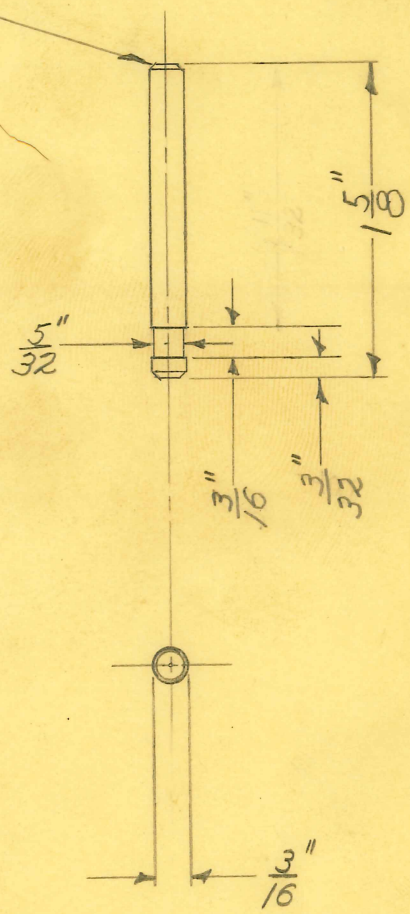

1~REQUIRED

SIZE	3/16" DIAM.	ISSUE 10-22-47	J.M.F
KIND	C.R. STEEL	CHANGED	
SHAPE	ROD	"	
FINISH	CAD. #23	"	
TEMP.		"	
PATT.		"	

TITLE:
FISCHER DELUXE RF-100
LONGITUDINAL SLIDE LOCK SUPPORT PIN

H. G. FISCHER & CO.
2335 WABANSIA AVE.
CHICAGO, ILL.

CAT. NO.

PART NO. 17318

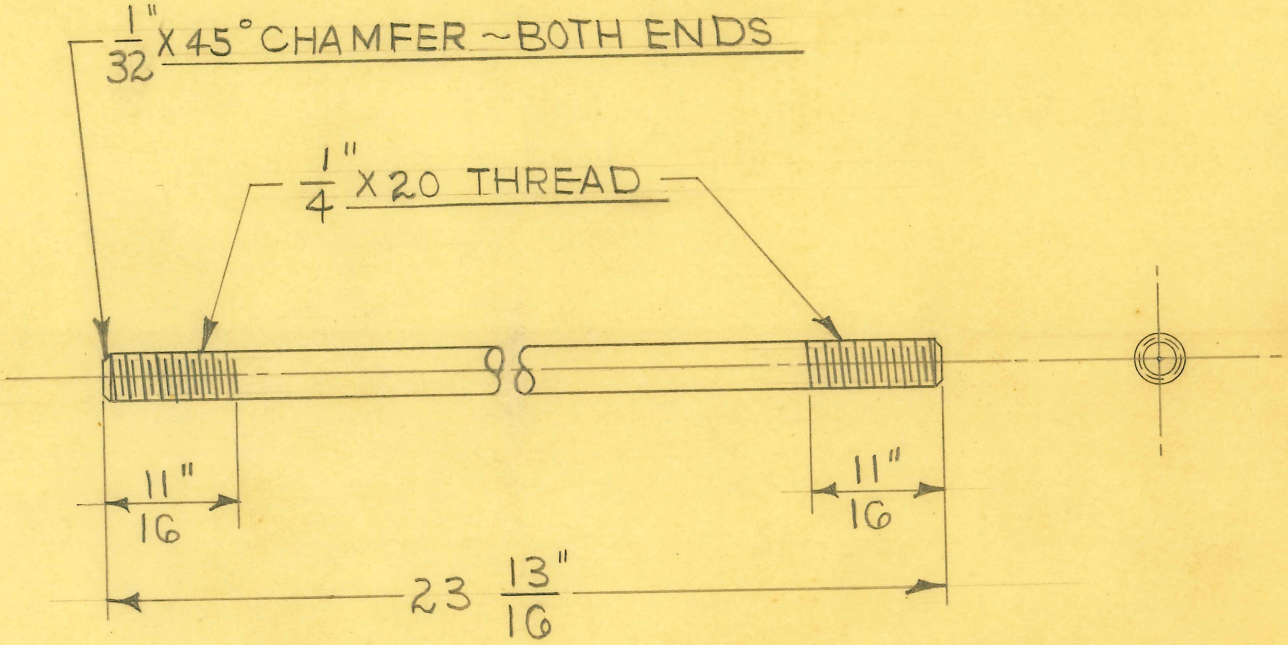

1 REQUIRED

SIZE	1/4" DIA.	ISSUE 10-29-47	W.J.
KIND	C.R.STEEL	CHANGED	
SHAPE	ROD	"	
FINISH		"	
TEMP.		"	
PATT.		"	

TITLE:
FISCHER "DELUXE RF-100" X-RAY UNIT
FLUOROSOPIC CWT. BEARING CLAMPING ROD

H. G. FISCHER & CO.
2335 WABANSIA AVE.
CHICAGO, ILL.

CAT. NO.

PART NO. 17320

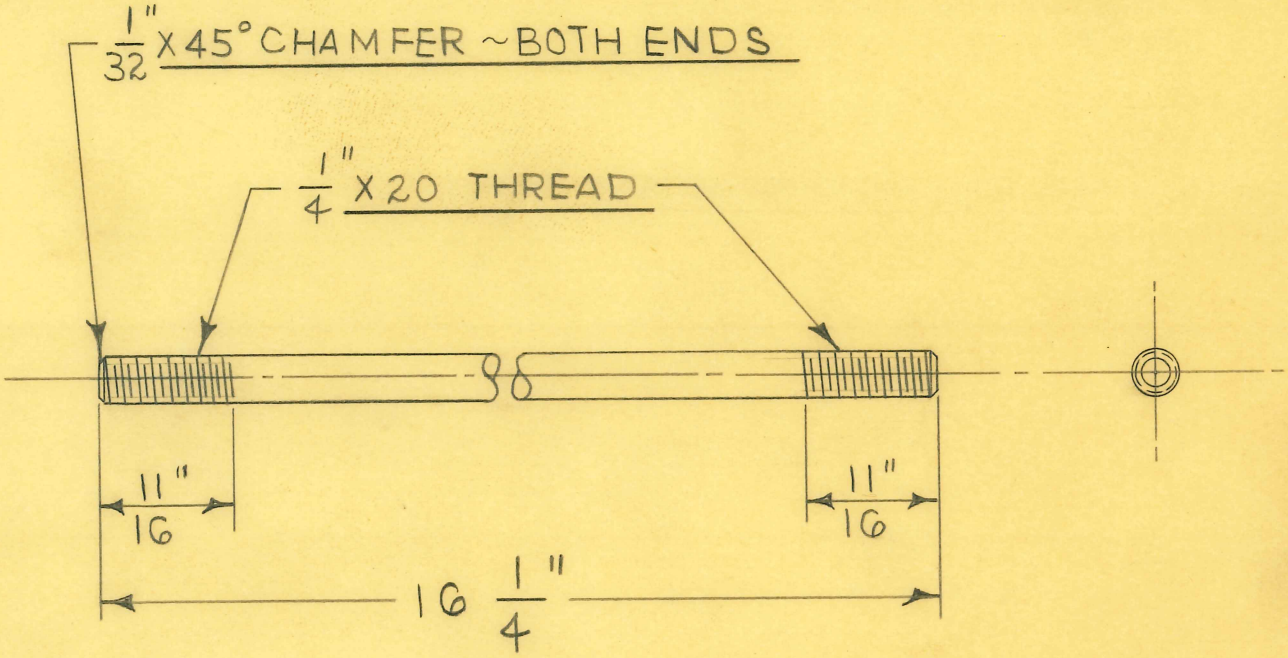

1 REQUIRED

SIZE	1/4" DIA.	ISSUE 10-31-47	W. J.	**TITLE:** FISCHER "DELUXE RF-100" X-RAY UNIT BUCKY CWT. BEARING CLAMPING ROD
KIND	C.R. STEEL	CHANGED		
SHAPE	ROD	"		
FINISH		"		
TEMP.		"		
PATT.		"		

H. G. FISCHER & CO.
2335 WABANSIA AVE.
CHICAGO, ILL.

CAT. NO.

PART NO. 17324

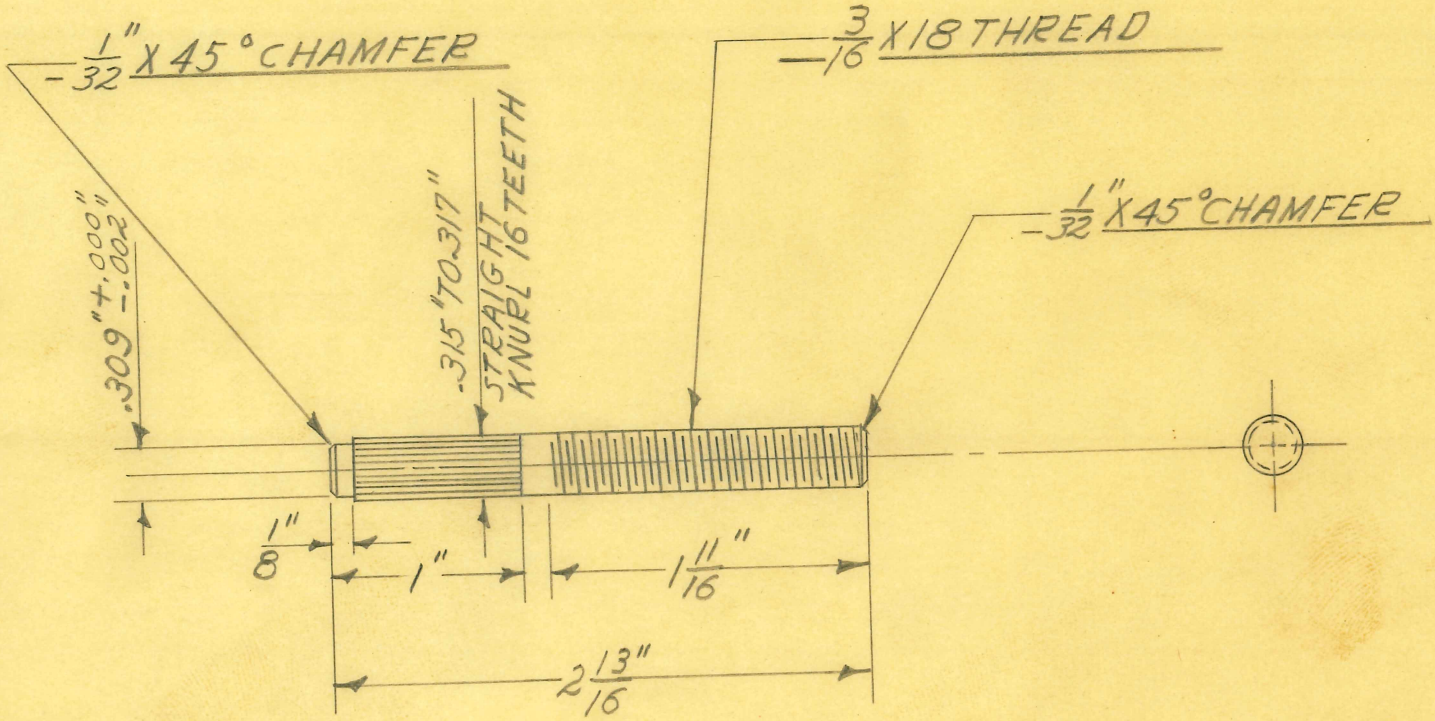

1 - REQUIRED

SPLIT BUSHING TOOL # 9512

SIZE	5/16" DIAM.	ISSUE 11-4-47	J.M.F
KIND	C.R. STEEL	CHANGED	
SHAPE	ROD	"	
FINISH	CAD # 23	"	
TEMP.		"	
PATT.		"	

TITLE: FISCHER DELUXE RF-100 FLUOROSCOPIC SLIDE LOCK LONGITUDINAL ADJ. ROD

H. G. FISCHER & CO.
2335 WABANSIA AVE.
CHICAGO, ILL.

CAT. NO.

PART NO. 17326

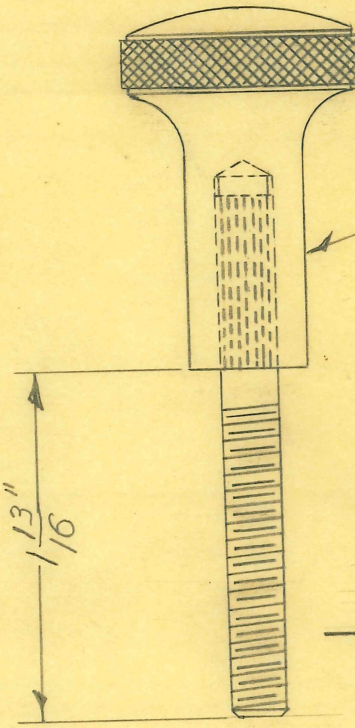

PRESS PCE. #17326 ROD INTO PCE. # 17283 KNOB

1- REQUIRED

ASSEMBLY PUNCH TOOL #9711
ASSEMBLY FIXTURE TOOL #9510

SIZE		ISSUE 11-4-47	J.M.F
KIND		CHANGED	
SHAPE		"	
FINISH		"	
TEMP.		"	
PATT.		"	

TITLE: FISCHER DELUXE RF.-100
FLUOROSCOPIC SLIDE LOCK
LONGITUDINAL KNOB & ROD ASSEM.

H. G. FISCHER & CO.
2335 WABANSIA AVE.
CHICAGO, ILL.

CAT. NO.

PART NO. 17327G

TITLE

FISCHER DELUXE "RF-100" X-RAY SCREEN ADJ. KNOB & ROD ASSEM.

H. G. FISCHER & CO.
FRANKLIN PARK, ILLINOIS

PART NO. 17331GA

REVISION	DATE	BY

DATE 10-5-50 | DR. BY W. J. | CH'K'D.

PATTERN | FINISH | SCALE FULL

TOOLS: DRILL JIG # 11452

MATERIAL: 1-PCE.# 17332A-#23
1-PCE.# 16739-#23 1-PCE.# 19173

DIMENSIONS
FRACTIONAL ± .015
DECIMAL ± .005
ANGULAR ± ½°
UNLESS OTHERWISE SPECIFIED

1 REQUIRED

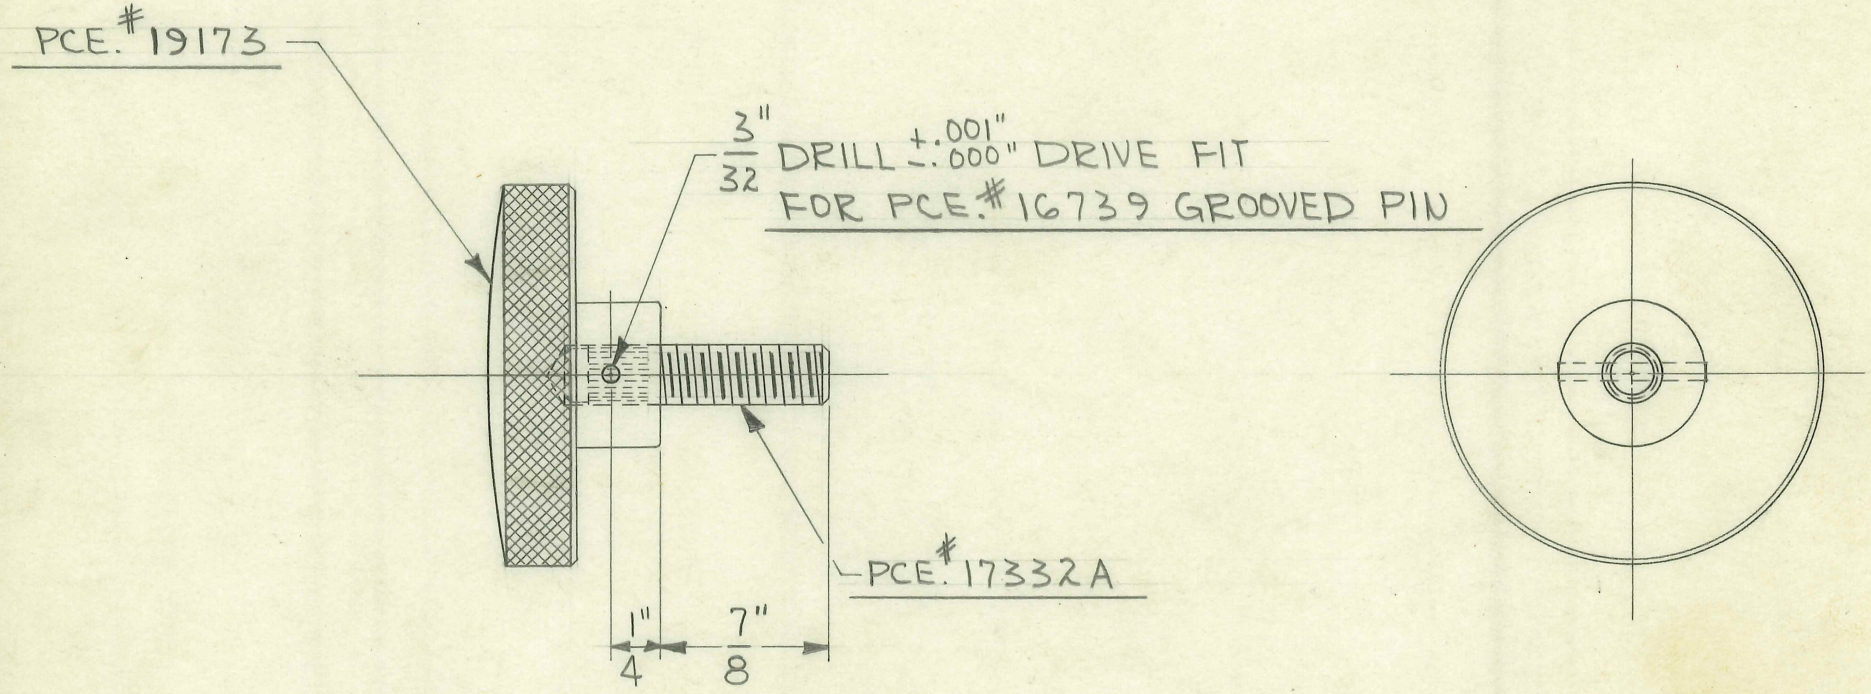

FOLDER #127

TITLE

FISCHER DELUXE RF-100 X-RAY SCREEN ADJ. STUD

H. G. FISCHER & CO.
FRANKLIN PARK, ILLINOIS

PART NO. 17332 A

DATE 10-4-50 | DR. BY W. J. | CH'K'D.

REVISION	DATE	BY

PATTERN | FINISH CAD. # 23 | SCALE FULL

TOOLS | MATERIAL $\frac{5}{16}$" DIA. C.R. STEEL

DIMENSIONS UNLESS OTHERWISE SPECIFIED
FRACTIONAL ± .015
DECIMAL ± .005
ANGULAR ± ½°

1 REQUIRED

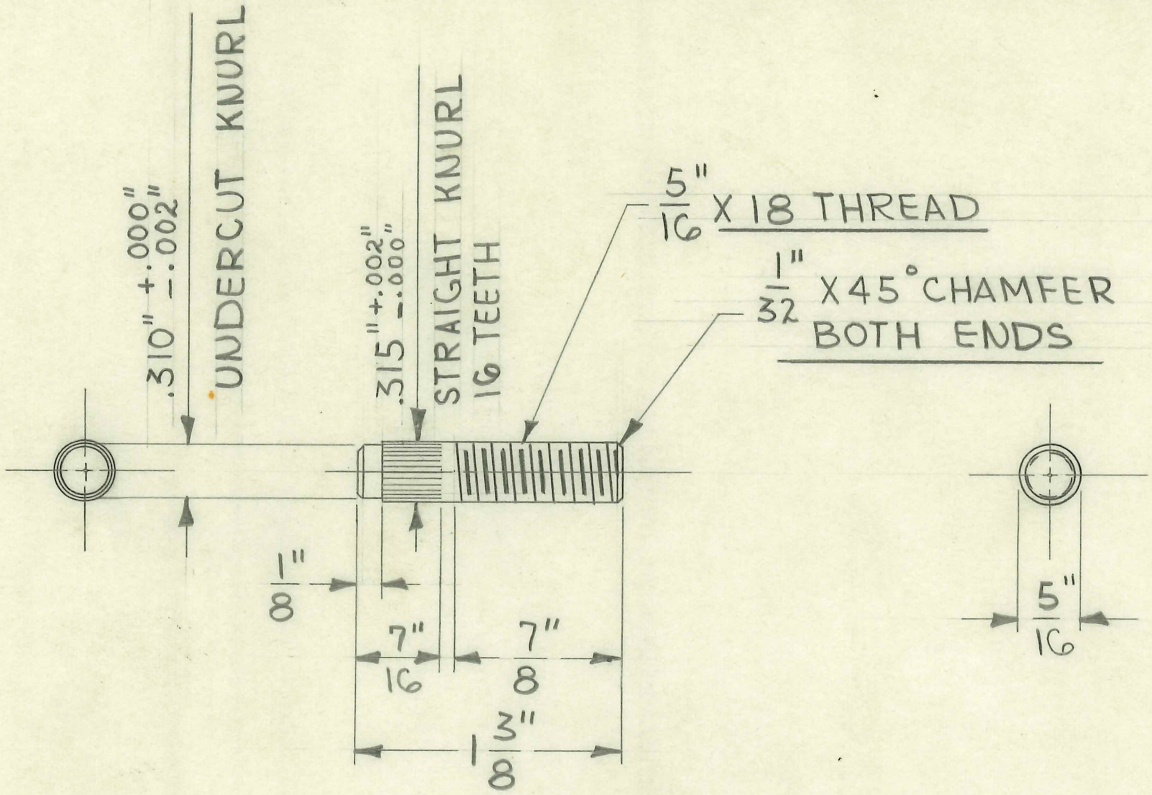

FOLDER #127

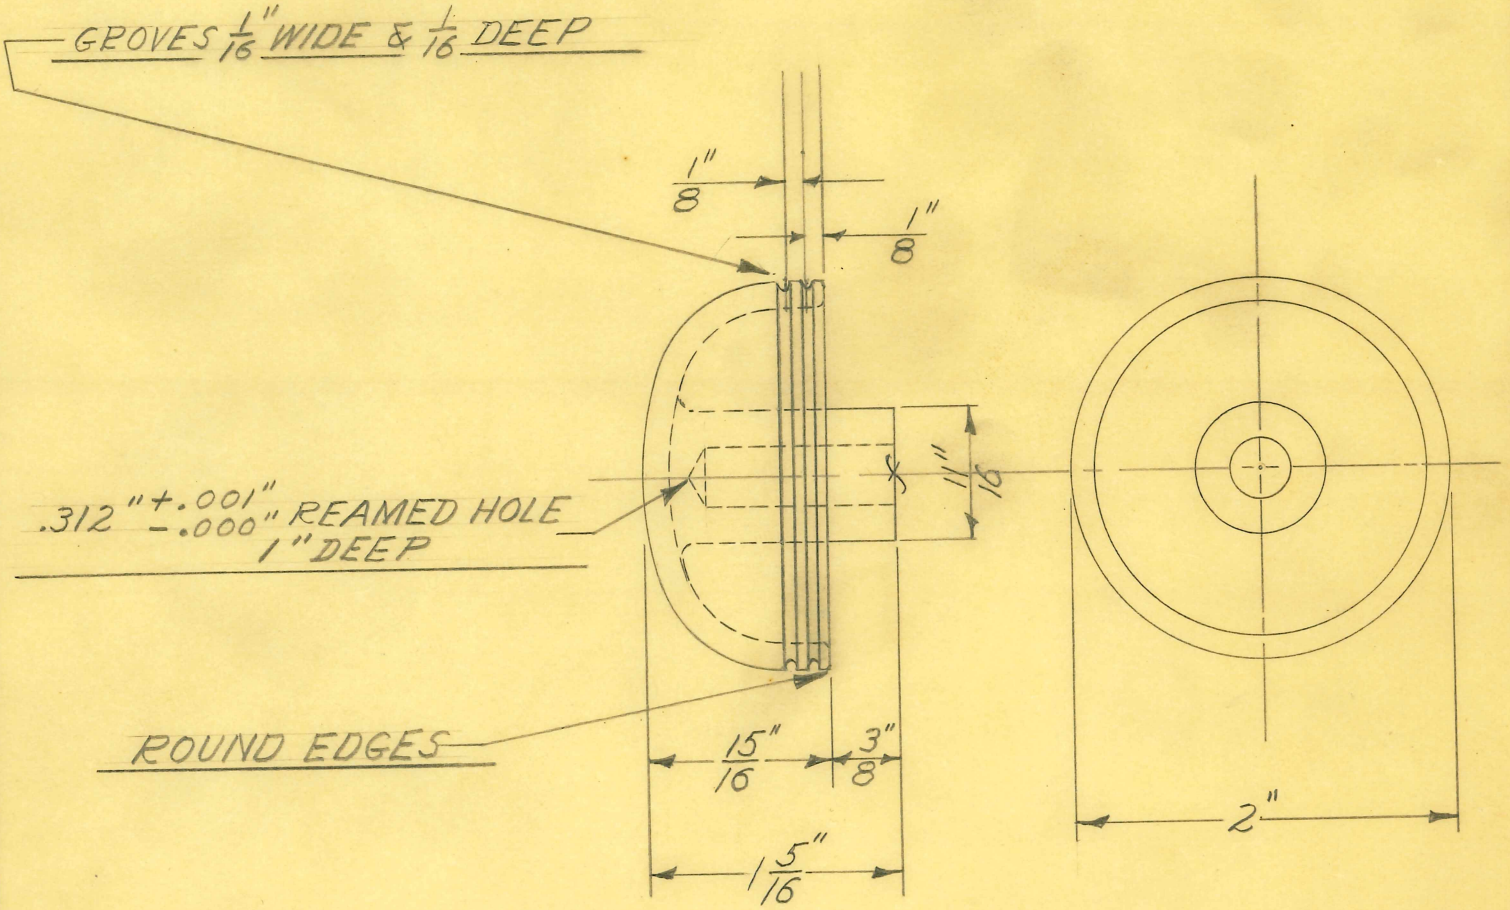

1-REQUIRED

DIMENSIONS	
FRACTIONAL	± .015
DECIMAL	± .005
ANGULAR	± ½°

UNLESS OTHERWISE SPECIFIED

SIZE	MADE	ISSUE 11-5-47	J.M.F.	TITLE: FISCHER DELUXE "RF-100" X RAY SCREEN ADJ. KNOB
KIND	FROM	CHANGED		
SHAPE	8399	"		
FINISH	POLISH	"		
TEMP.		"		
PATT.		"		

H. G. FISCHER & CO.
2335 WABANSIA AVE.
CHICAGO, ILL.

CAT. NO.

PART NO. 17333

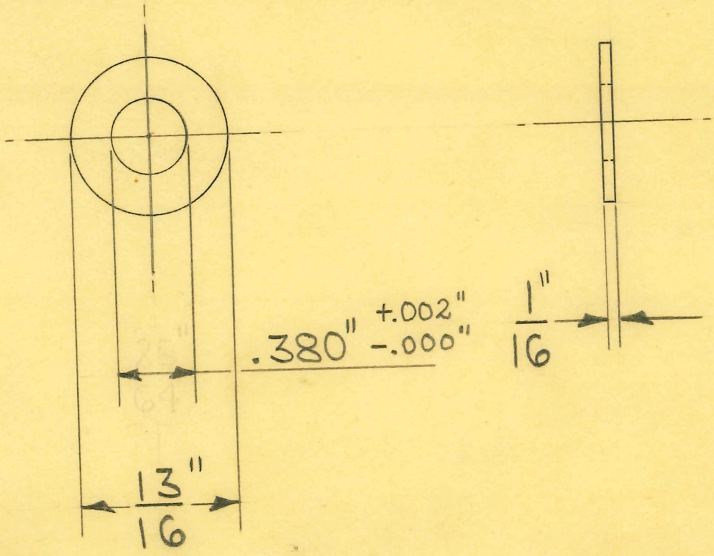

8 REQUIRED

DIMENSIONS
FRACTIONAL ± .015
DECIMAL ± .005
ANGULAR ± 1/2°
UNLESS OTHERWISE SPECIFIED

SIZE	1/16" SHEET	ISSUE 5-25-48	W. J.
KIND	C.R. STEEL	CHANGED	
SHAPE		"	
FINISH	CAD. #23	"	
TEMP.		"	
PATT.		"	

TITLE: FISCHER DELUXE "RF-100" X-RAY UNIT
UPRIGHT TUBE SUPP. BEARING WASHER

H. G. FISCHER & CO.
2335 WABANSIA AVE.
CHICAGO, ILL.

CAT. NO.

PART NO. 17334

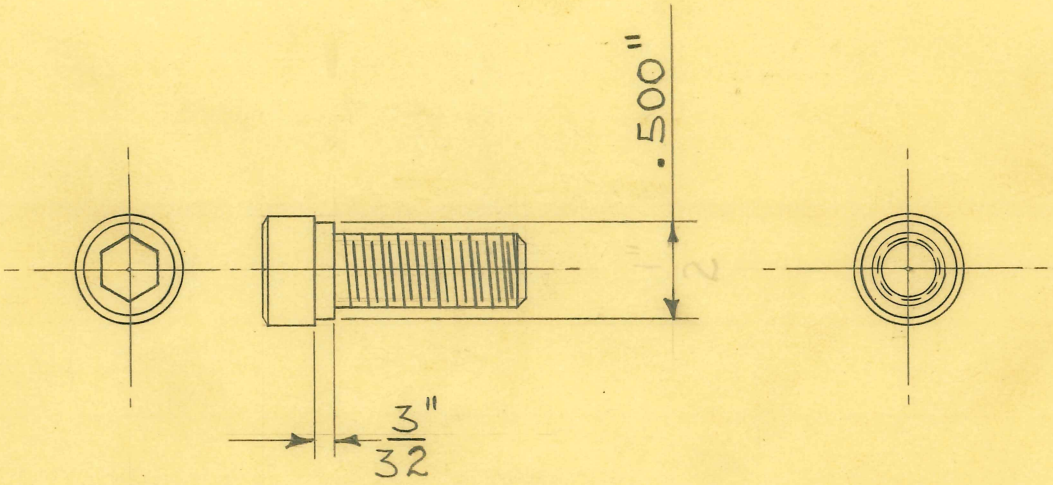

6 REQUIRED

3/8" X 16 X 1" SOCKET HEAD CAP SCREW

DIMENSIONS	
FRACTIONAL	± .015
DECIMAL	± .005
ANGULAR	± 1/2°

UNLESS OTHERWISE SPECIFIED

SIZE	FROM	ISSUE 5-24-48	W.J.
KIND	11496 1/2	CHANGED	
SHAPE		"	
FINISH		"	
TEMP.		"	
PATT.		"	

TITLE: FISCHER DELUXE "RF-100" X-RAY UPRIGHT TUBE SUPP. BEARING SCREW

H. G. FISCHER & CO.
2335 WABANSIA AVE.
CHICAGO, ILL.

CAT. NO.

PART NO. 17335

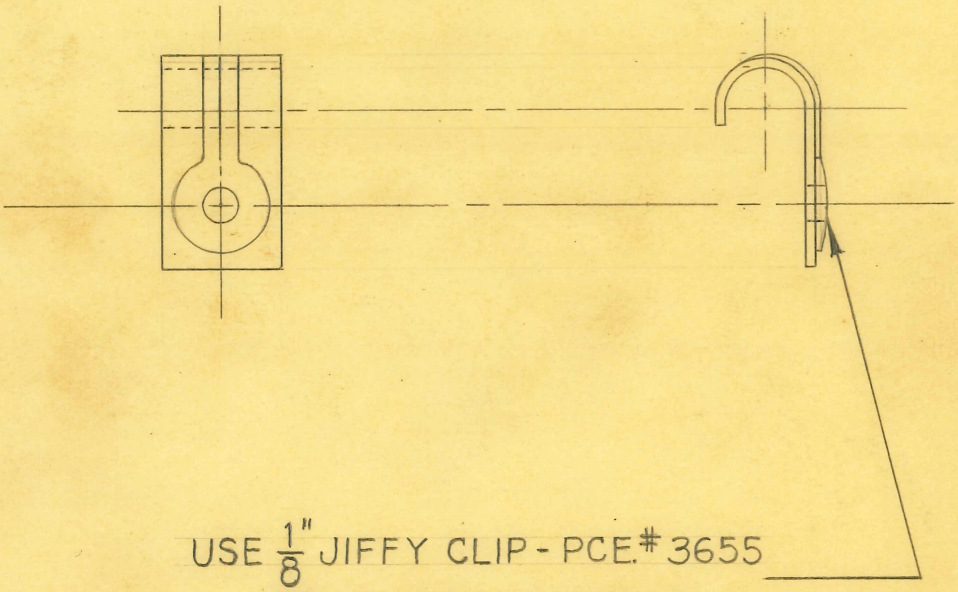

USE $\frac{1}{8}$" JIFFY CLIP - PCE.# 3655
STRAIGHTEN AS SHOWN

1 - REQUIRED

DIMENSIONS	
FRACTIONAL	± .015
DECIMAL	± .005
ANGULAR	± 1/2°

UNLESS OTHERWISE SPECIFIED

SIZE		ISSUE 5-11-48	J.B.G.
KIND		CHANGED	
SHAPE		"	
FINISH		"	
TEMP.		"	
PATT.		"	

TITLE:
FISCHER "DELUXE RF-100" X-RAY UNIT
TILT TABLE BUCKY CORD CLAMP

H. G. FISCHER & CO.
2335 WABANSIA AVE.
CHICAGO, ILL.

CAT. NO.

PART NO. 17338

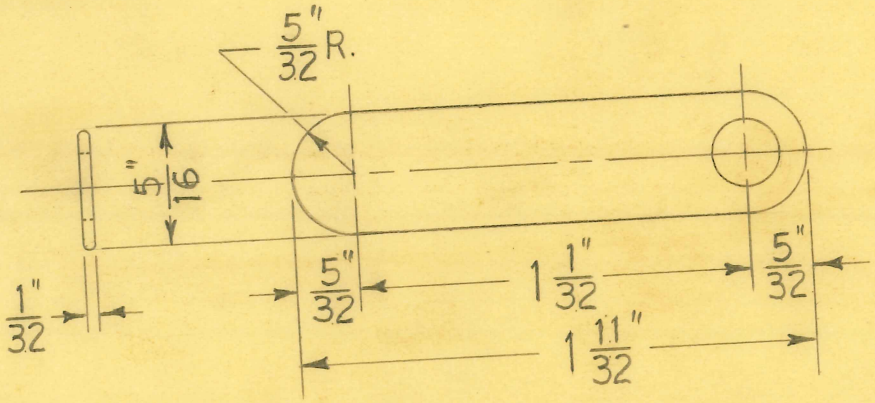

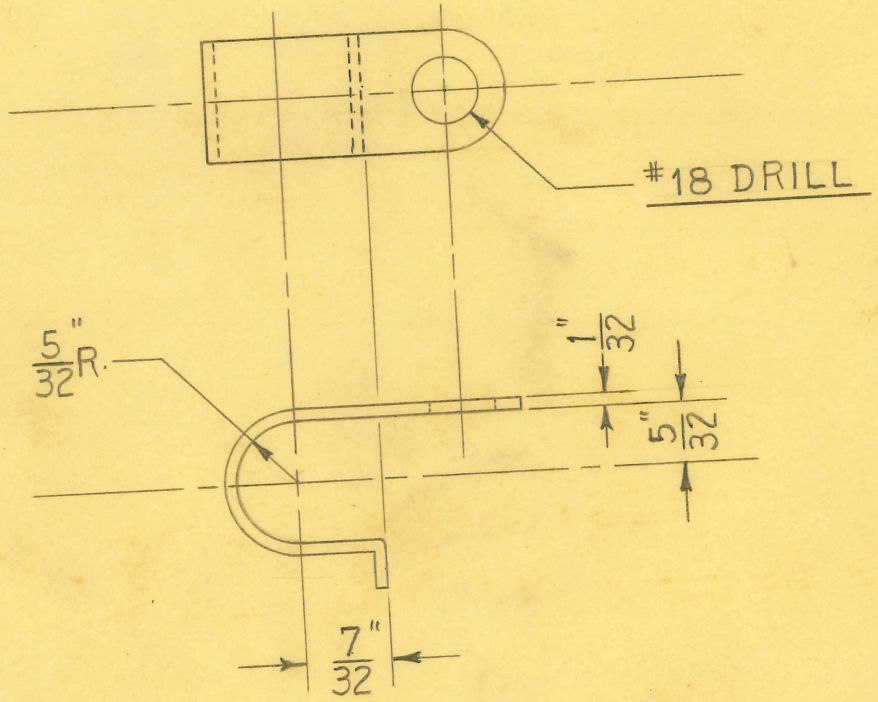

SCALE ÷ DOUBLE SIZE

1 - REQUIRED

DIMENSIONS	
FRACTIONAL	± .015
DECIMAL	± .005
ANGULAR	± 1/2°

UNLESS OTHERWISE SPECIFIE

FORMING FIXTURE TOOL #9817

SIZE	5/16" X 1/32"	ISSUE 5-11-48	J.B.G.
KIND		CHANGED	
SHAPE	FLAT WIRE	"	
FINISH	CAD. #23	"	
TEMP.		"	
		"	

TITLE: FISCHER "DELUXE RF-100" X-RAY UNIT
TILT TABLE BUCKY CORD CLAMP

H. G. FISCHER & CO.
2335 WABANSIA AVE.
CHICAGO, ILL.

CAT. NO.

PART NO. 17339

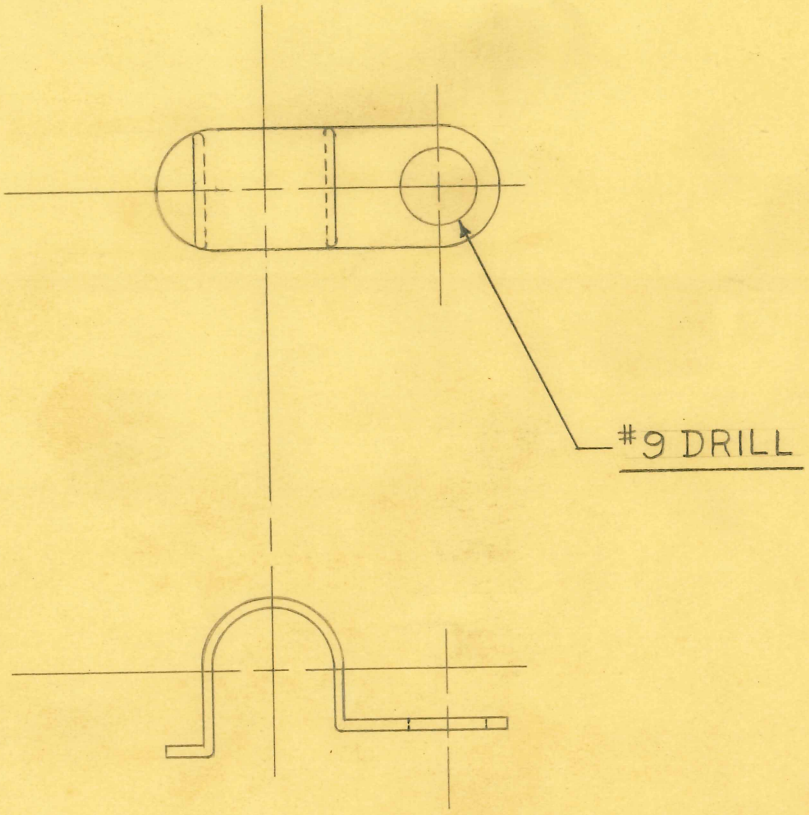

SCALE ÷ DOUBLE SIZE

1- REQUIRED

FROM PCE.# 11205

DIMENSIONS	
FRACTIONAL	± .015
DECIMAL	± .005
ANGULAR	± 1/2°

UNLESS OTHERWISE SPECIFIED

SIZE		ISSUE 5-11-48	J.B.G.
KIND		CHANGED	
SHAPE		"	
FINISH	CAD.#23	"	
TEMP.		"	
PATT.		"	

TITLE:
FISCHER "DELUXE RF-100" X-RAY UNIT
TILT TABLE FRAME BUCKY CORD CLAMP

H. G. FISCHER & CO.
2335 WABANSIA AVE.
CHICAGO, ILL.

CAT. NO.

PART NO. 17342

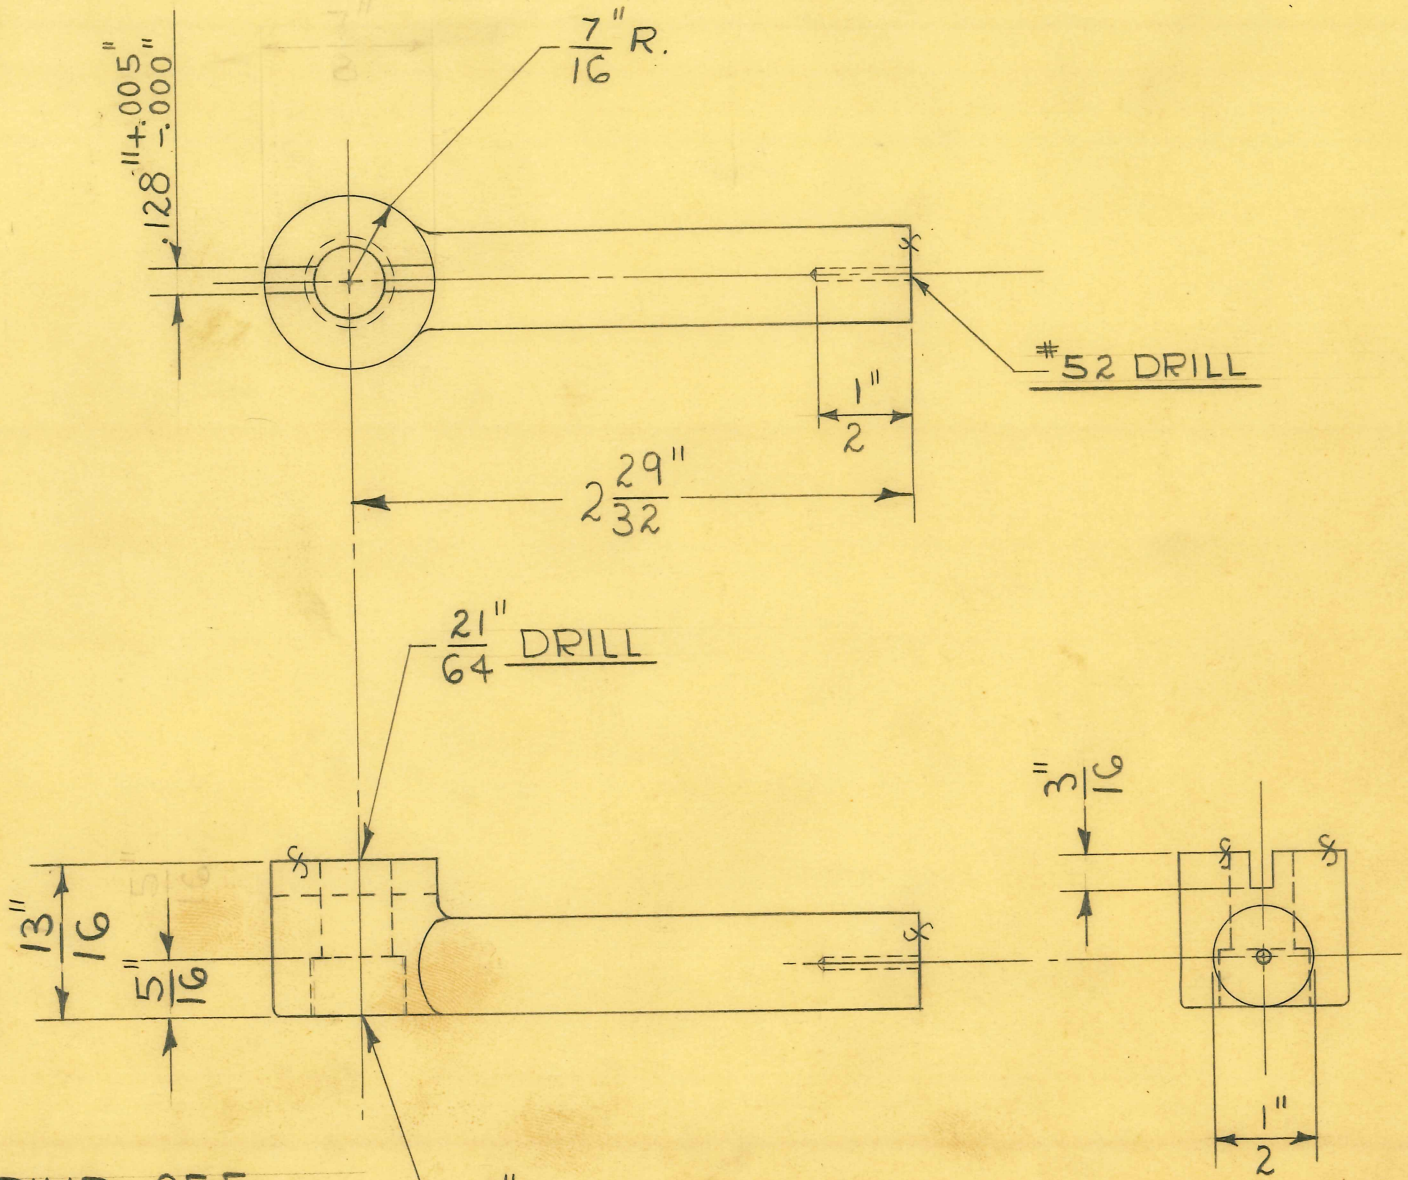

GRIND OFF PROMINENT ROUGH SPOTS & FINS ONLY

2 REQUIRED

MILLING JAWS #9732
DRILL JIG #9735

DIMENSIONS	
FRACTIONAL	± .015
DECIMAL	± .005
ANGULAR	± 1/2°

UNLESS OTHERWISE SPECIFIED

SIZE	CAST IN	ISSUE 3-11-48	W.J.
KIND	BRASS	CHANGED	
SHAPE		"	
FINISH	CAD. #23	"	
TEMP.		"	
PATT.	2317	"	

TITLE: FISCHER DELUXE RF-100 X-RAY TILT TABLE FRONT STOP

H. G. FISCHER & CO.
2335 WABANSIA AVE.
CHICAGO, ILL.

CAT. NO.

PART NO. 17343F

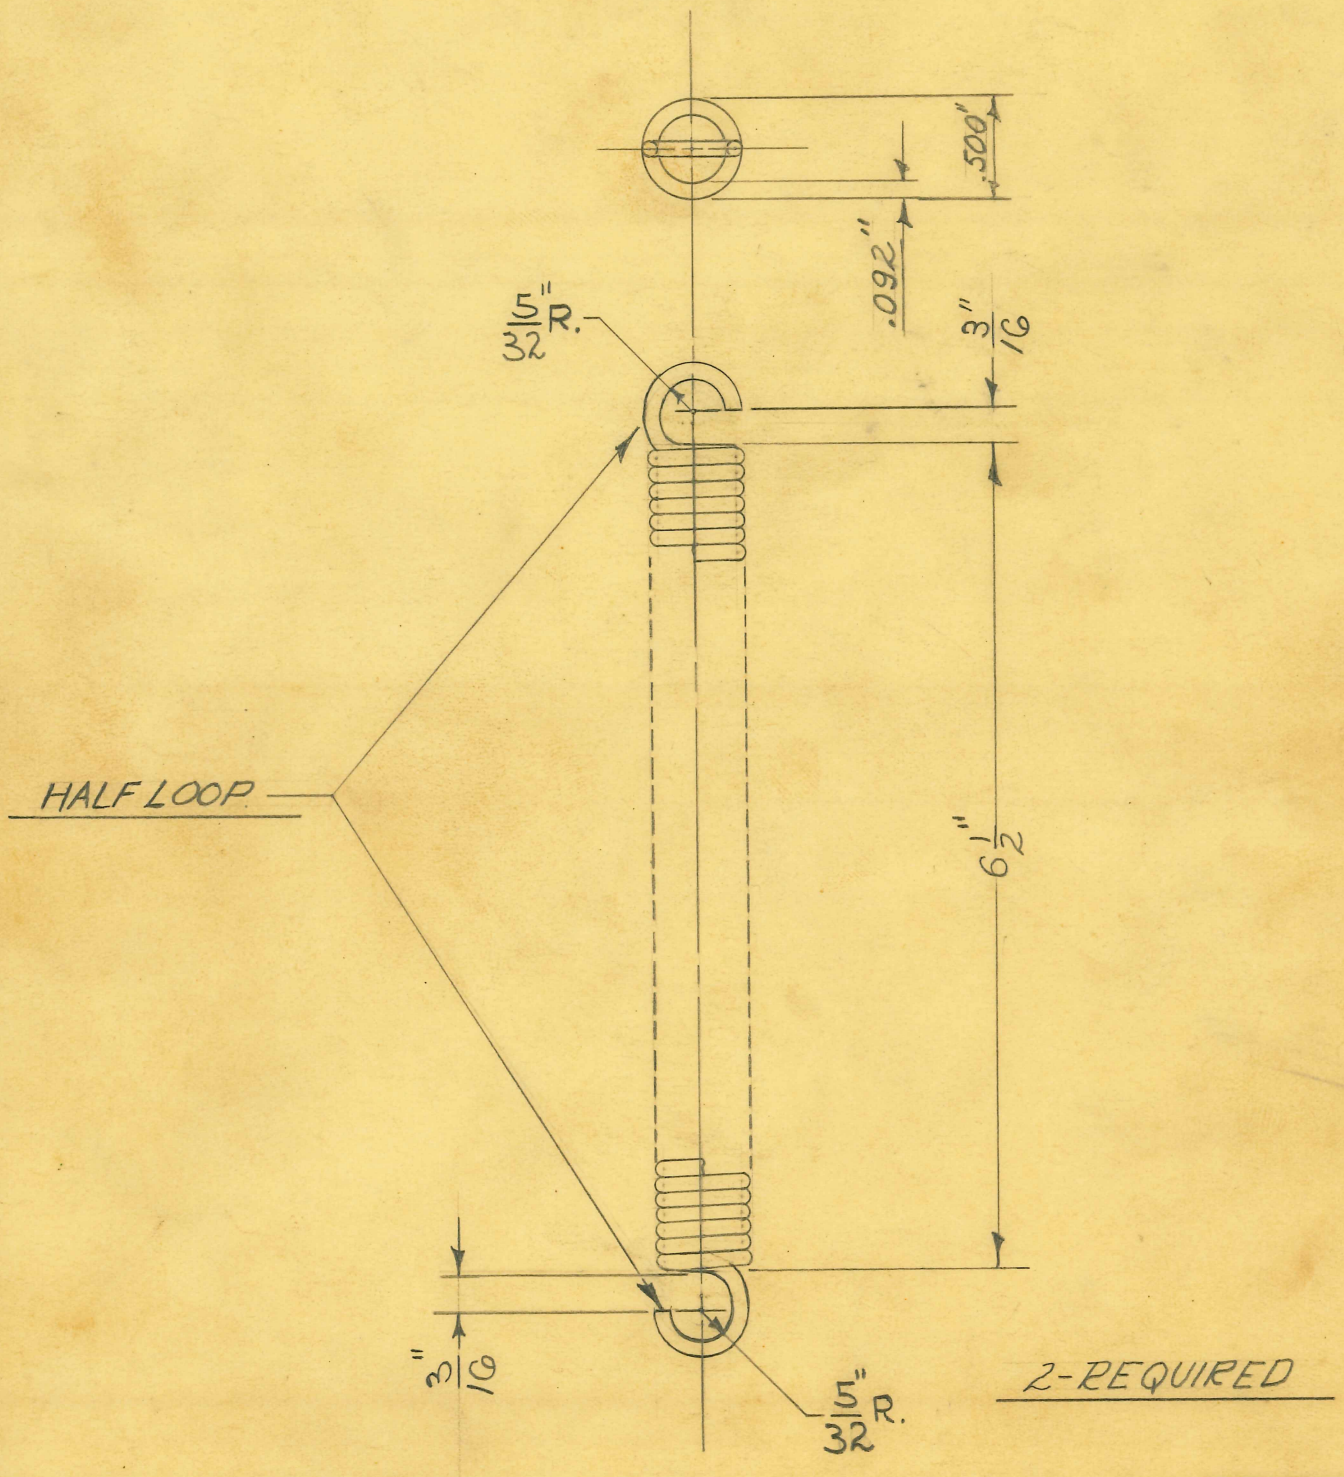

TENSION PER INCH OF STRETCH = 22#

DIMENSIONS	
FRACTIONAL	± .015
DECIMAL	± .005
ANGULAR	± 1/2°

UNLESS OTHERWISE SPECIFIED

SIZE	#13 GA. (.092")	ISSUE 11-19-47	J.M.F
KIND		CHANGED	
SHAPE		"	
FINISH		"	
TEMP.		"	
PATT.		"	

TITLE: FISCHER DELUXE "RF-100" X RAY SCREEN CWT. SPRING

H. G. FISCHER & CO.
2335 WABANSIA AVE.
CHICAGO, ILL.

CAT. NO.

PART NO. 17344

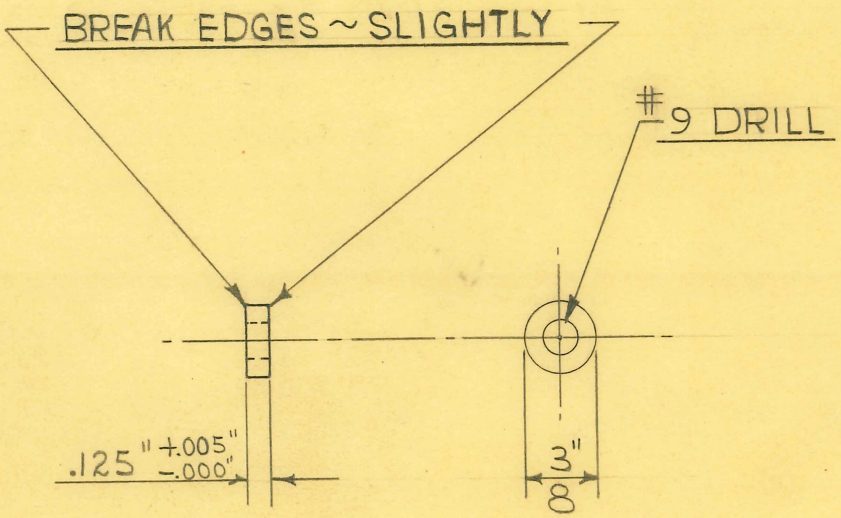

4 REQUIRED

DIMENSIONS	
FRACTIONAL	± .015
DECIMAL	± .005
ANGULAR	± 1/2°

UNLESS OTHERWISE SPECIFIED

SIZE	3/8" DIA.	ISSUE 11-14-47	W. J.
KIND	JEWELERS	CHANGED	
SHAPE	ROD	"	
FINISH		"	
TEMP.		"	
PATT.		"	

TITLE:
FISCHER DELUXE RF-100 X-RAY UNIT
SCREEN ARM SWIVEL LOCK PLATE DOWEL

H. G. FISCHER & CO.
2338 WABANSIA AVE.
CHICAGO, ILL.

CAT. NO.

PART NO. 17345

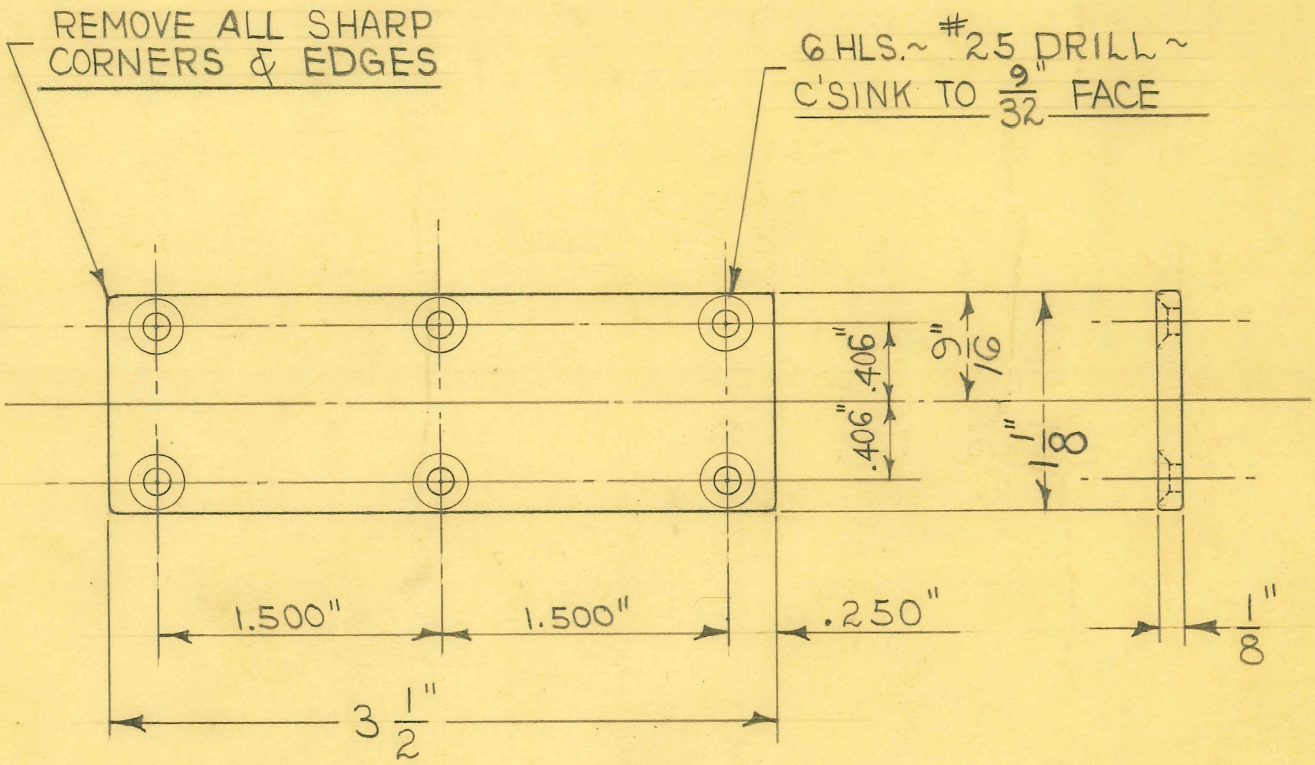

1 REQUIRED

DRILL JIG TOOL # 9546

DIMENSIONS	
FRACTIONAL	± .015
DECIMAL	± .005
ANGULAR	± 1/2°

UNLESS OTHERWISE SPECIFIED

SIZE	1/8"X1 1/8"	ISSUE 11-11-47	W.J.
KIND	C.R. STEEL	CHANGED	
SHAPE		"	
FINISH	CAD #23	"	
TEMP.		"	
PATT.		"	

TITLE:

FISCHER "DELUXE RF-100" X-RAY UNIT
SCREEN COUNTERPOISE INTERLOCK SHAFT
RETAINING PLATE

H. G. FISCHER & CO.
2335 WABANSIA AVE.
CHICAGO, ILL.

CAT. NO.

PART NO. 17347

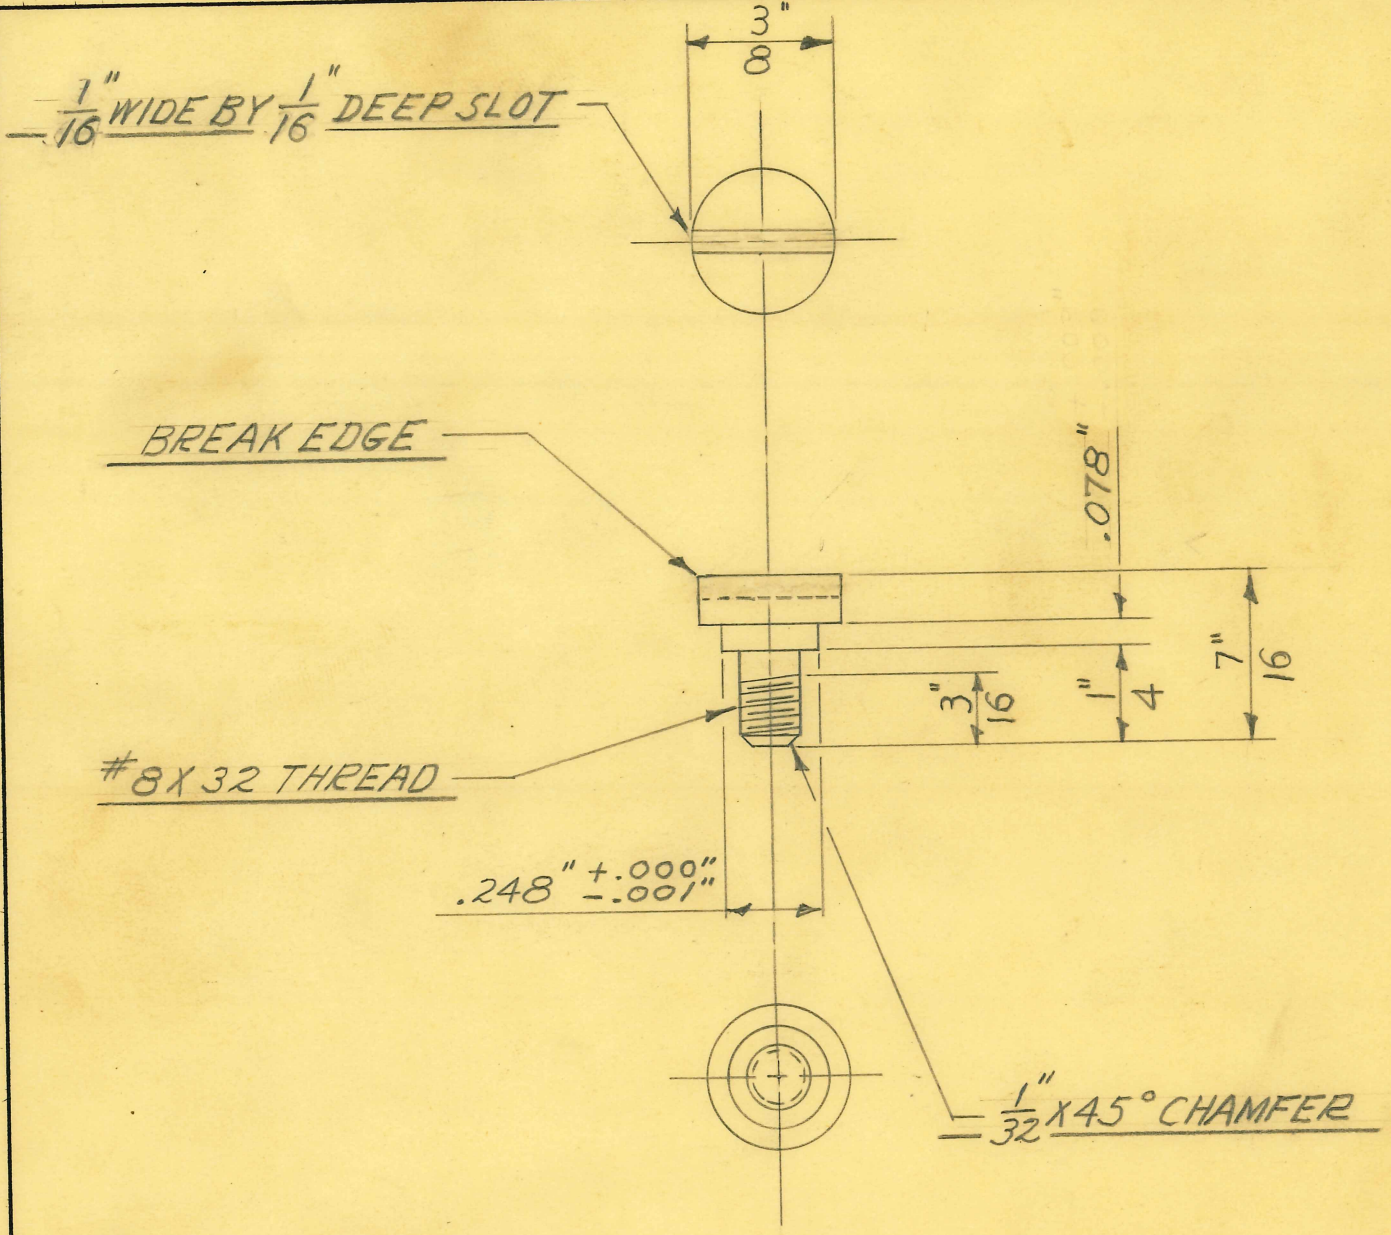

SCALE ~ DOUBLE SIZE

4-REQUIRED

DIMENSIONS	
FRACTIONAL	± .015
DECIMAL	± .005
ANGULAR	± 1/2°

UNLESS OTHERWISE SPECIFIED

SIZE	3/8" DIAM	ISSUE 11-11-47	J.M.F
KIND	C.R. STEEL	CHANGED	
SHAPE	ROD	"	
FINISH	CAD #23	"	
TEMP.		"	
PATT.		"	

TITLE: FISCHER DELUXE "RF-100" X-RAY SHUTTER CABLE SWIVEL ARM & CONNECTING LINK SCREW

H. G. FISCHER & CO.
2335 WABANSIA AVE.
CHICAGO, ILL.

CAT. NO.

PART NO. 17357

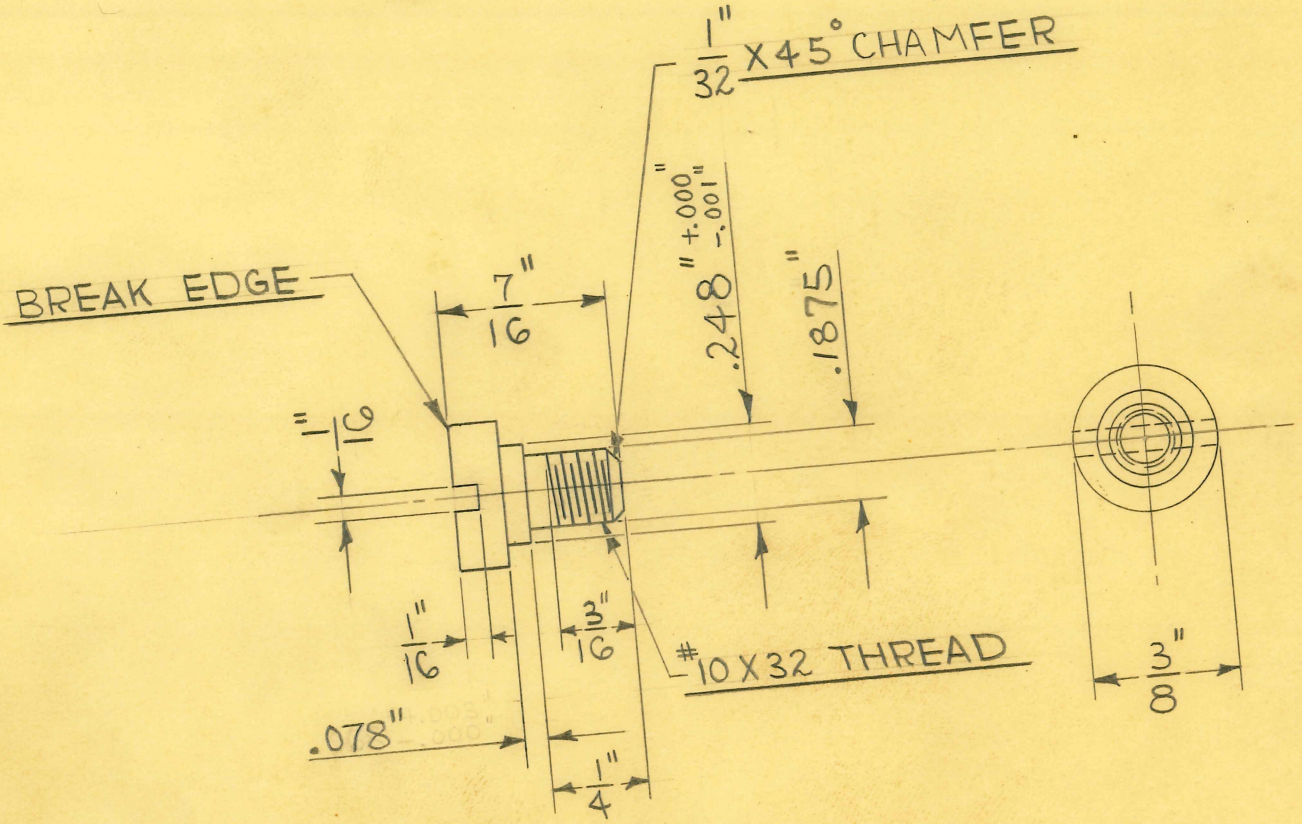

SCALE ≈ DOUBLE SIZE

1 REQUIRED

DIMENSIONS
FRACTIONAL ± .0
DECIMAL ± .0
ANGULAR ± 1
UNLESS OTHERWISE SPE

SIZE	3/8" DIA.	ISSUE 4-21-48	W.J.
KIND	C.R. STEEL	CHANGED	
SHAPE	ROD	"	
FINISH	CAD # 23	"	
TEMP.		"	
		"	

TITLE: FISCHER DELUXE "RF-100" X-RAY UN
SHUTTER CABLE SWIVEL ARM SCREW

H. G. FISCHER & CO.
2335 WABANSIA AVE.
CHICAGO, ILL.

CAT. NO.

PART NO. 1735

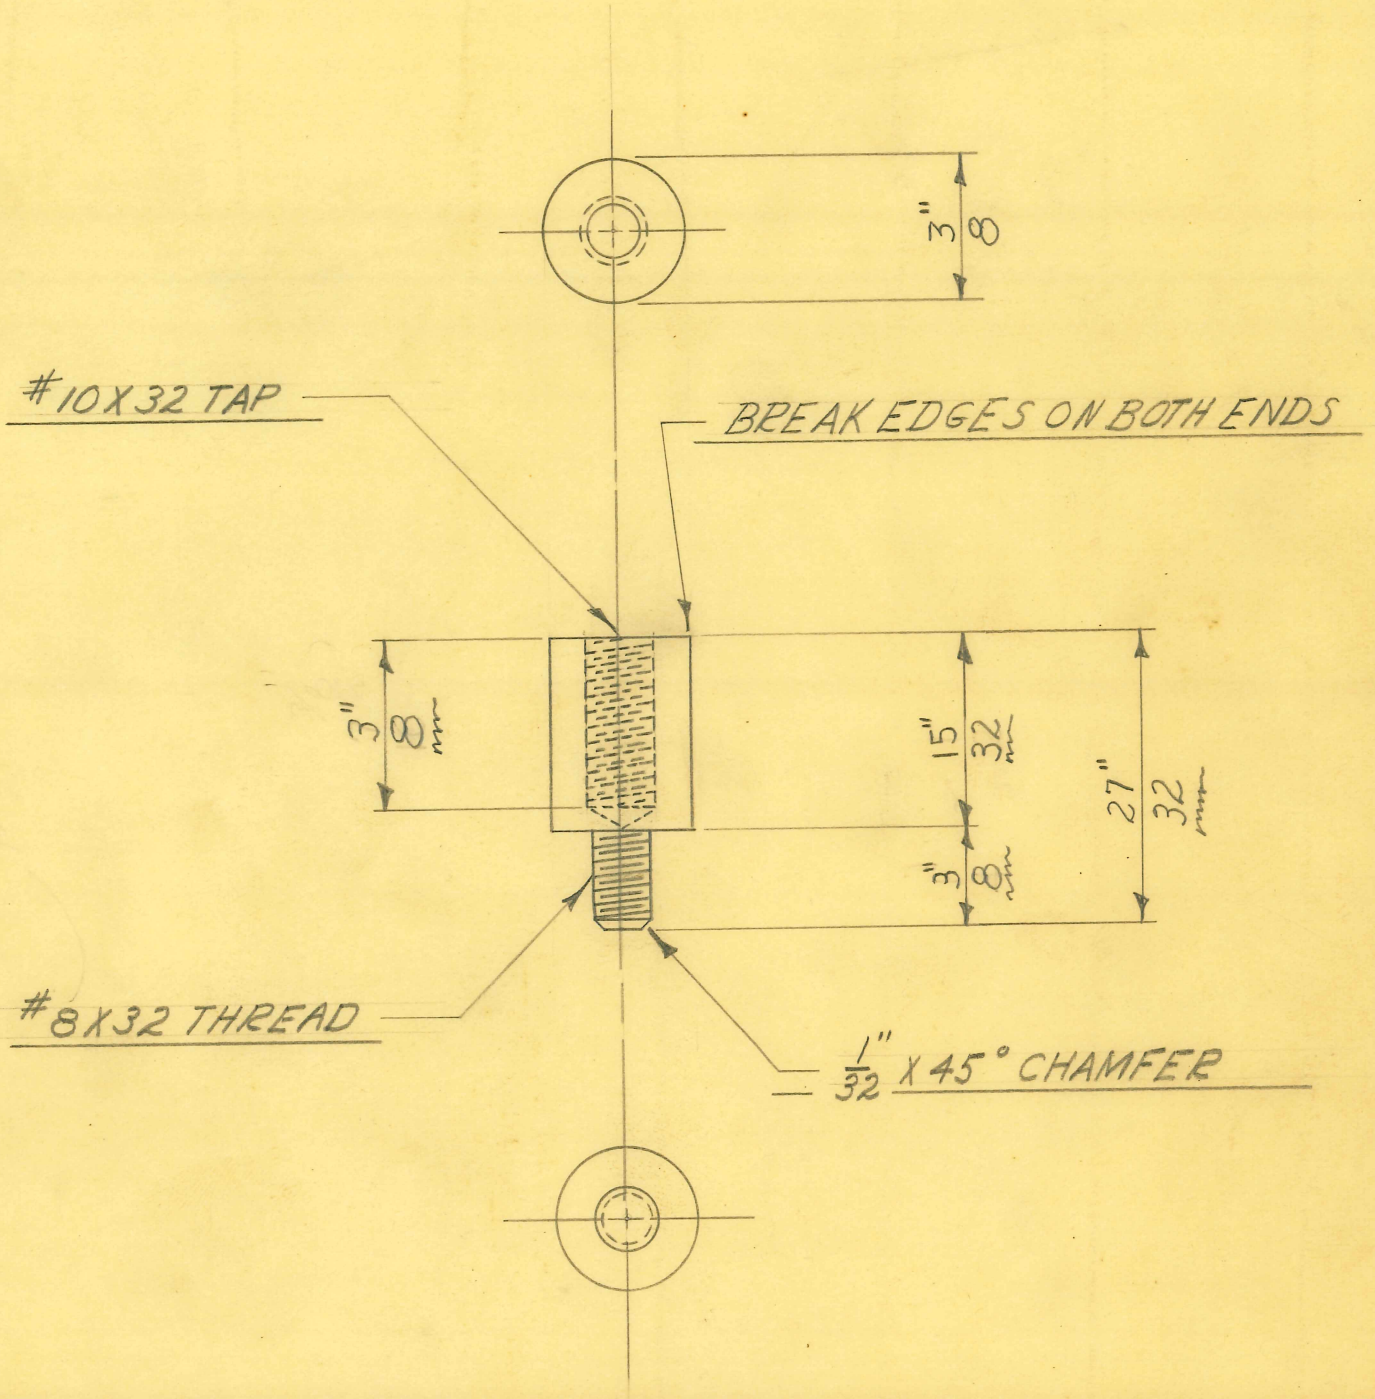

SCALE ÷ DOUBLE SIZE

1- REQUIRED

DIMENSIONS	
FRACTIONAL	± .015
DECIMAL	± .005
ANGULAR	± 1/2°

UNLESS OTHERWISE SPECIFIED

SIZE	3/8" DIAM.	ISSUE 11-12-47	J.M.F.
KIND	BRASS	CHANGED	
SHAPE	ROD	"	
FINISH	CAD# 23	"	
TEMP.		"	
PATT.		"	

TITLE: FISCHER DELUXE "RF-100" X-RAY HORIZONTAL SHUTTER CABLE BINDING POST

H. G. FISCHER & CO.
2335 WABANSIA AVE.
CHICAGO, ILL.

CAT. NO.

PART NO. 17358

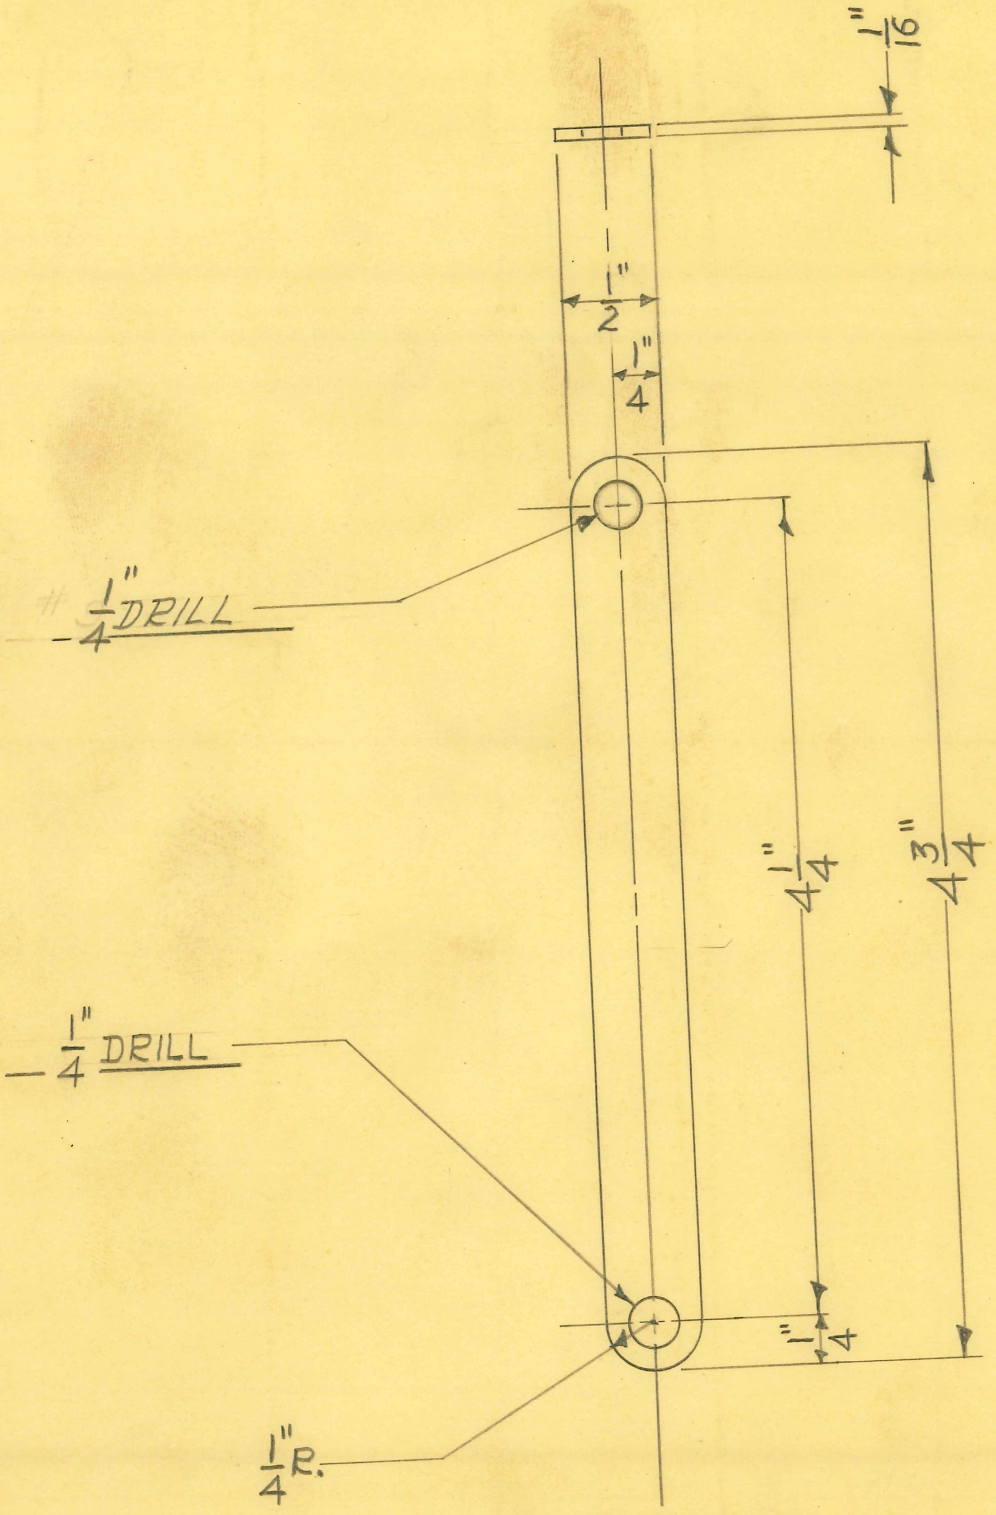

1-REQUIRED

DIMENSIONS	
FRACTIONAL	± .015
DECIMAL	± .005
ANGULAR	± 1/2°

UNLESS OTHERWISE SPECIFIE

SIZE	1/16" X 1/2"	ISSUE 11-11-47	J.M.F.
KIND	C.R. STEEL	CHANGED	
SHAPE		"	
FINISH	CAD. #23	"	
TEMP.		"	
PATT.		"	

TITLE: FISCHER DELUXE RF-100 X-RAY LATERAL SHUTTER CABLE SWIVEL ARM CONNECTING LINK

H. G. FISCHER & CO.
2338 WABANSIA AVE.
CHICAGO, ILL.

CAT. NO.

PART NO. 17359

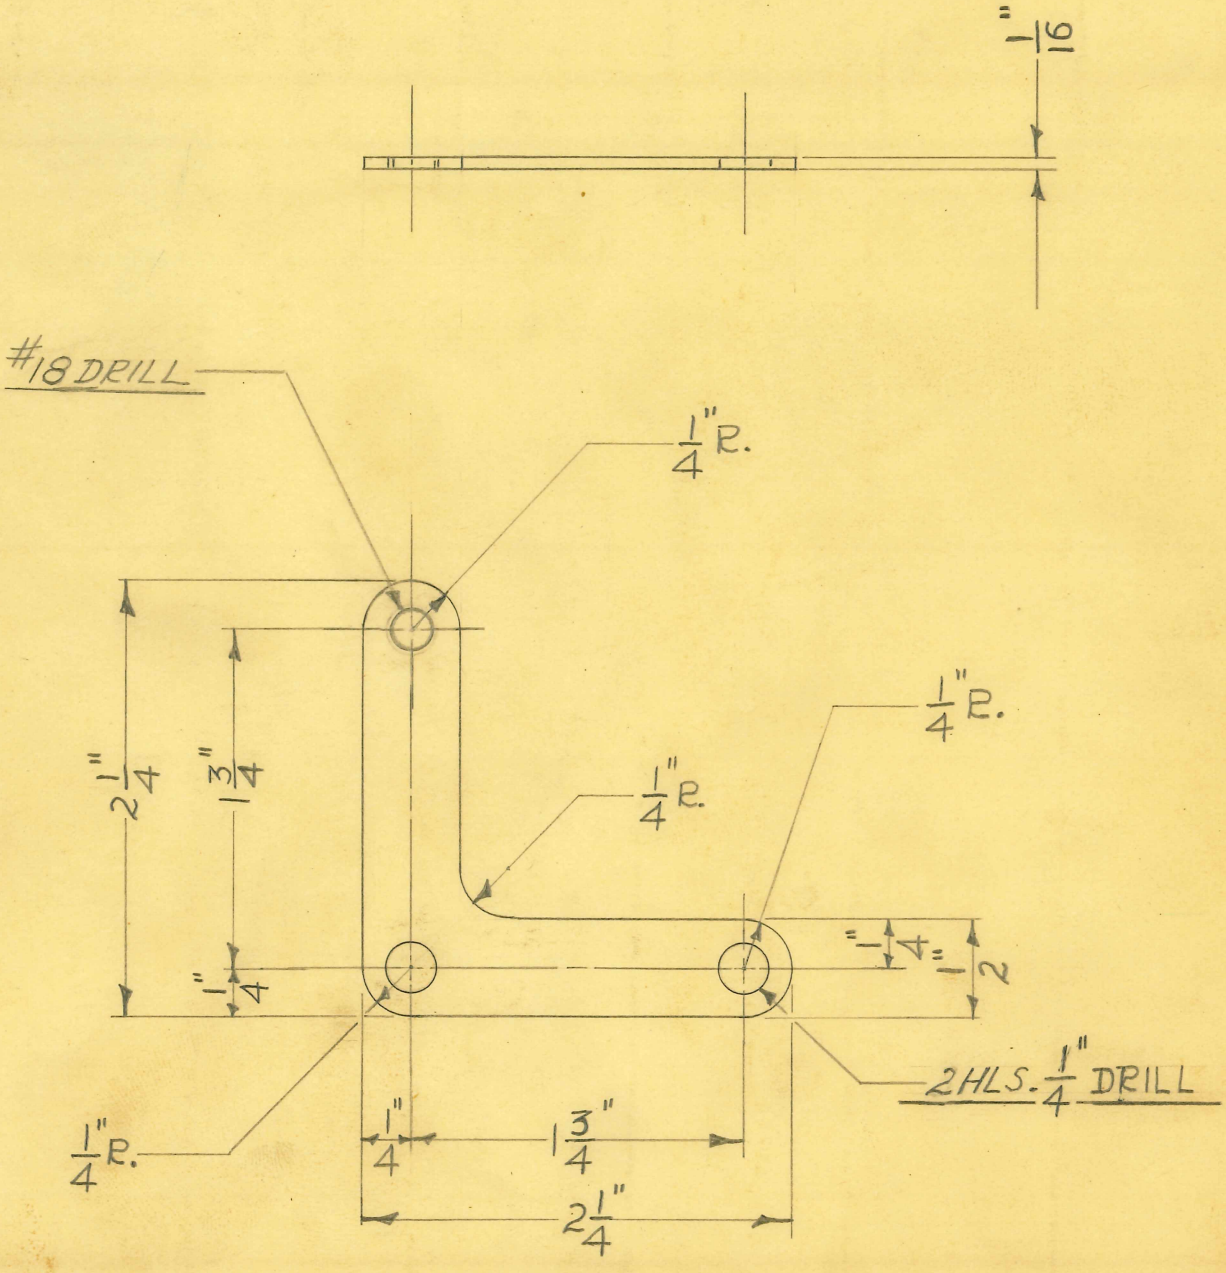

1-REQUIRED

1/16" X 3 1/4" SHEARED COLD ROLLED STEEL
BLANK & PIERCING DIE TOOL # 9545

DIMENSIONS	
FRACTIONAL	± .015
DECIMAL	± .005
ANGULAR	± 1/2°

UNLESS OTHERWISE SPECIFIED

SIZE	1/16 SHEET	ISSUE 11-10-47	J.M.F.
KIND	C.R. STEEL	CHANGED	
SHAPE		"	
FINISH	CAD # 23	"	
TEMP.		"	
PATT.		"	

TITLE: FISCHER DELUXE "RF-100" X-RAY LATERAL SHUTTER CABLE SWIVEL ARM

H. G. FISCHER & CO.
2335 WABANSIA AVE.
CHICAGO, ILL.

CAT. NO.

PART NO. 17360

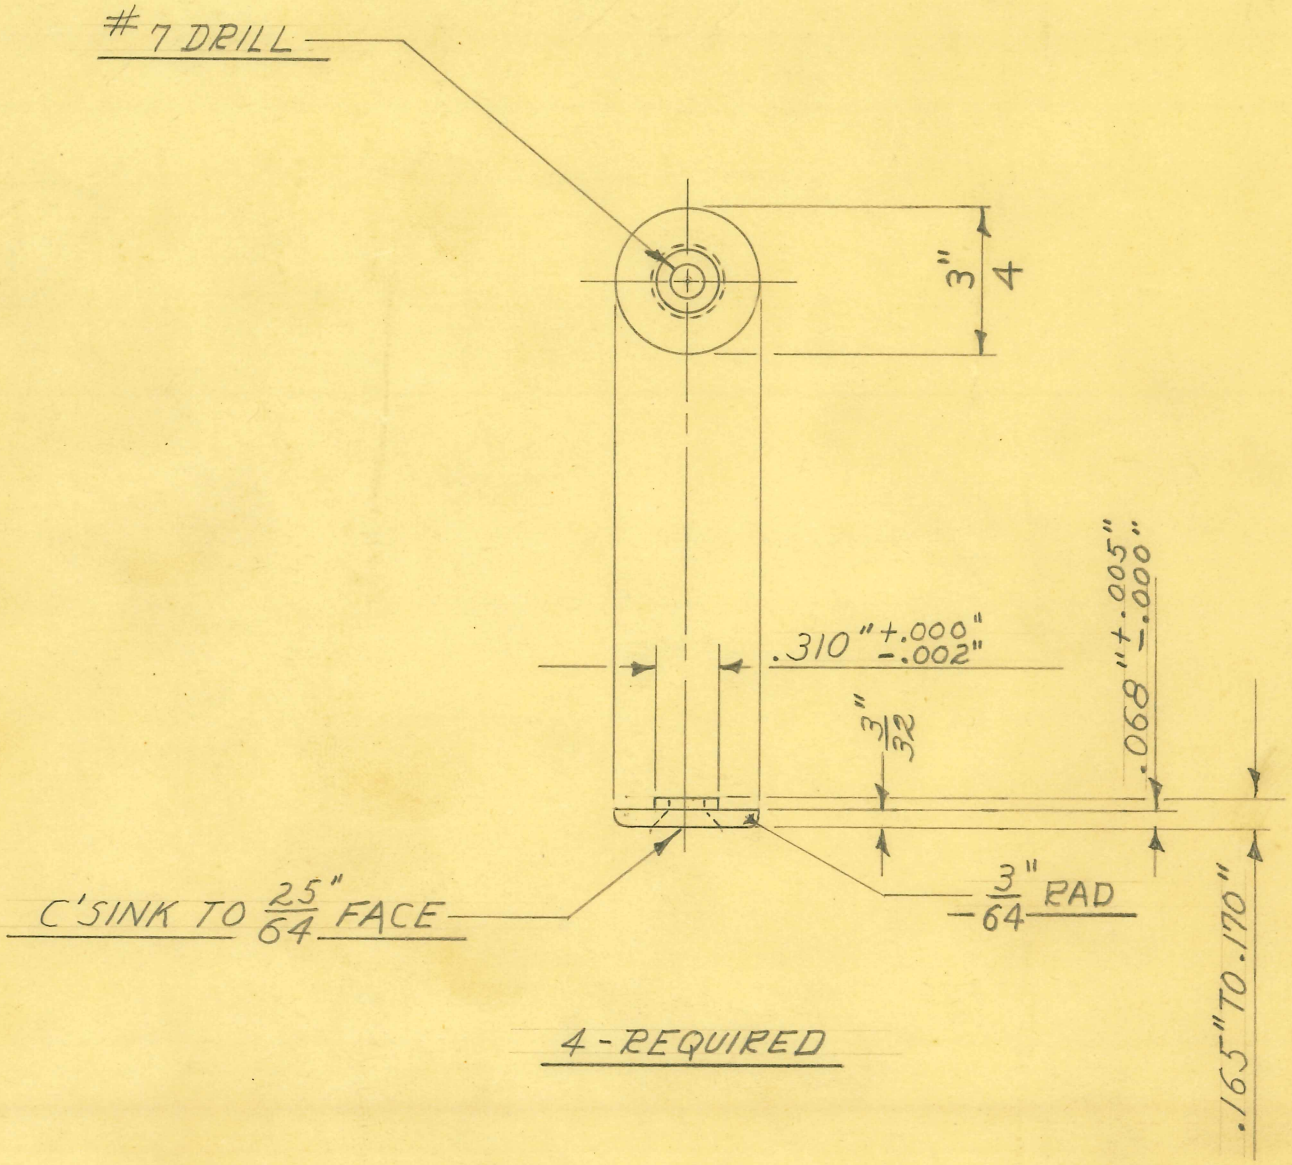

4 - REQUIRED

DIMENSIONS	
FRACTIONAL	± .015
DECIMAL	± .005
ANGULAR	± 1/2°

UNLESS OTHERWISE SPECIFIED

SIZE	3/4" DIAM	ISSUE 11-13-47	J.M.F
KIND	C.R. STEEL	CHANGED	
SHAPE	ROD	"	
FINISH	CAD# 23	"	
TEMP.		"	
PATT.		"	

TITLE: FISCHER DELUXE "RF-100" X-RAY SHUTTER ARM BUSHING

H. G. FISCHER & CO.
2335 WABANSIA AVE.
CHICAGO, ILL.

CAT. NO.

PART NO. 17361

TITLE
FISCHER DELUXE "RF-100" X-RAY SCREEN FORK SUPPORT SHAFT

H. G. FISCHER & CO.
FRANKLIN PARK, ILLINOIS

PART NO. 17363A

DATE 2-24-50 | DR. BY J.V.W. | CH'K'D.

REVISION	DATE	BY

PATTERN | FINISH | SCALE FULL

TOOLS: DRILL JIG # 11291

MATERIAL: $\frac{3}{4}$" DIA. C.R. STEEL

DIMENSIONS UNLESS OTHERWISE SPECIFIED

FRACTIONAL	± .015
DECIMAL	± .005
ANGULAR	± ½°

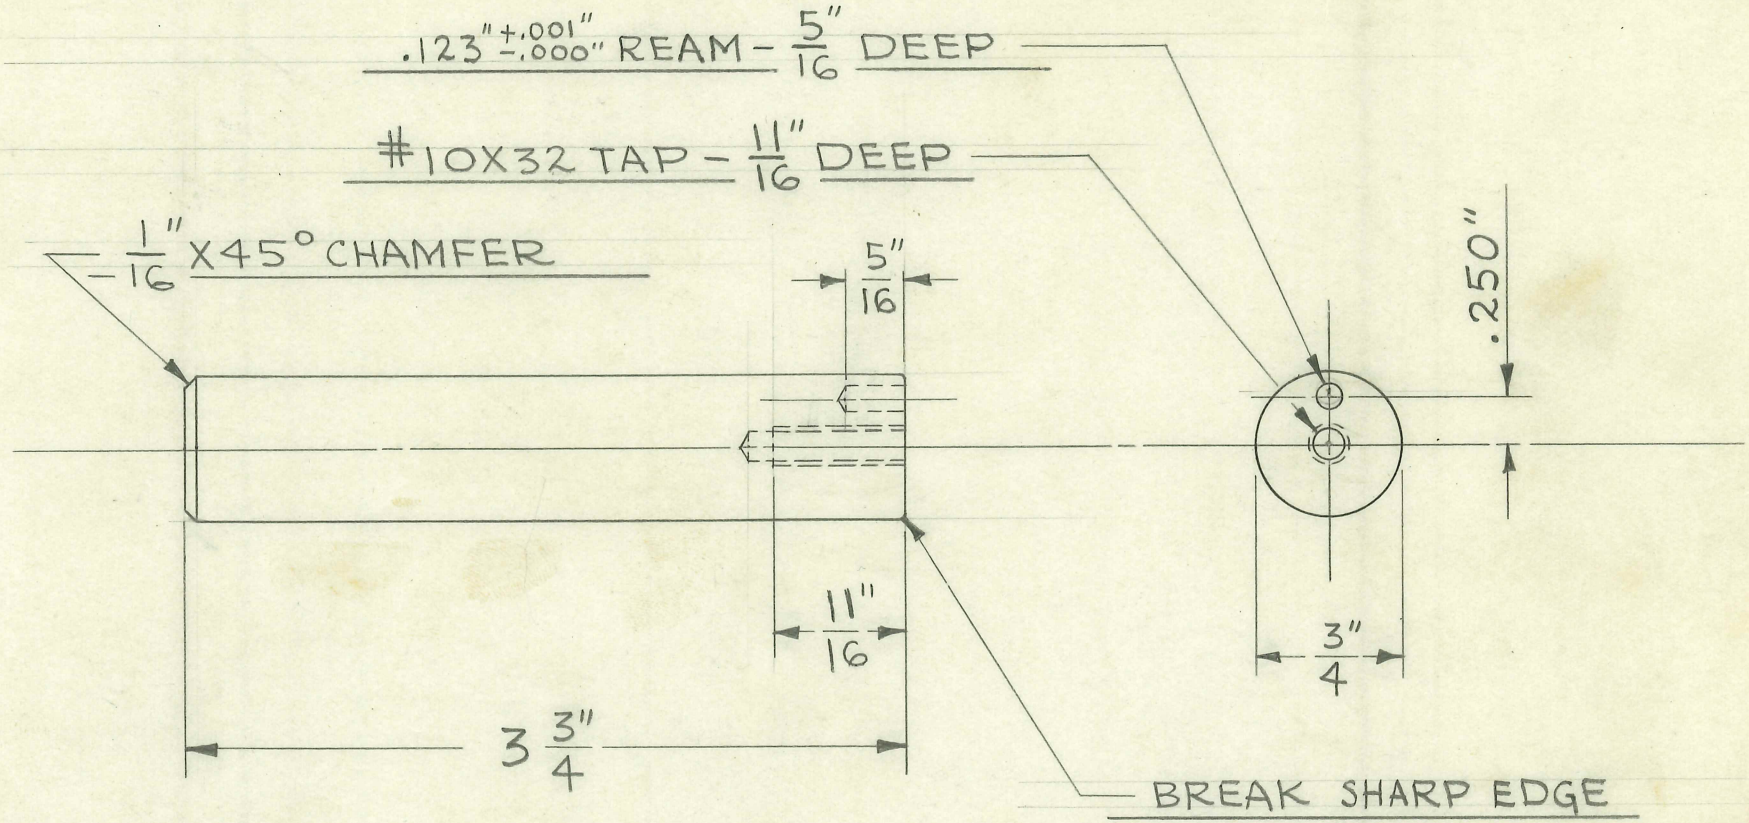

1 REQUIRED

FOLDER # 127

TITLE
FISCHER DELUXE "RF-100" X-RAY SCREEN FORK SUPP. SHAFT ASSEM.

H. G. FISCHER & CO.
FRANKLIN PARK, ILLINOIS

PART NO. 17363 1/2 G

DATE 2-24-50 | DR. BY J.V.W. | CH'K'D.

REVISION	DATE	BY

PATTERN | FINISH | SCALE FULL

TOOLS
ARBOR PRESS FIX. #11292

MATERIAL
1-17246
1-17363A

DIMENSIONS
FRACTIONAL ± .015
DECIMAL ± .005
ANGULAR ± ½°
UNLESS OTHERWISE SPECIFIED

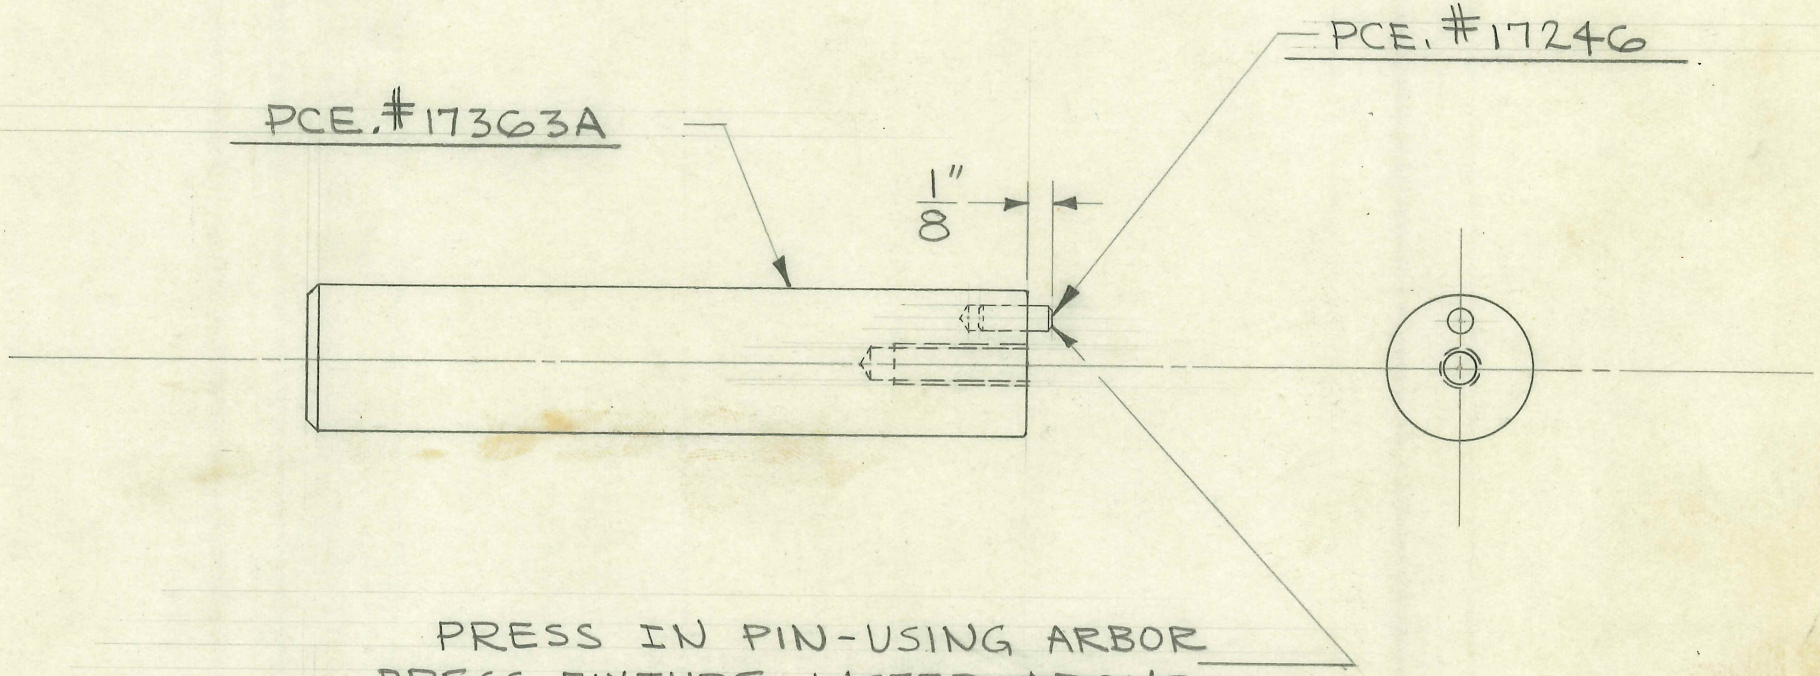

PRESS IN PIN-USING ARBOR PRESS FIXTURE LISTED ABOVE.

1 REQUIRED

FOLDER #127

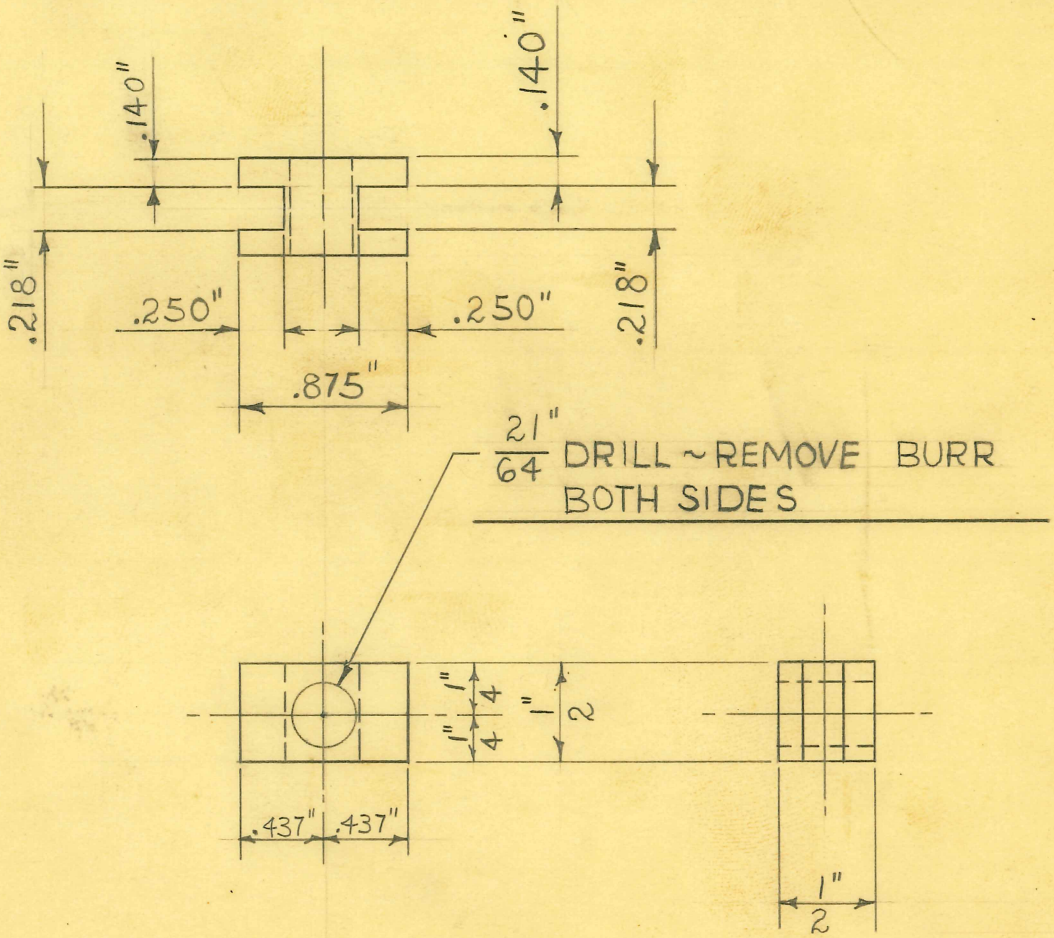

1 REQUIRED Drill Jig Tool #9572
Milling Fixture #9573

DIMENSIONS	
FRACTIONAL	± .015
DECIMAL	± .005
ANGULAR	± 1/2°
UNLESS OTHERWISE SPECIFIED	

SIZE	1/2" SQUARE	ISSUE 11-2047	W.J.
KIND	C.R. STEEL	CHANGED	
SHAPE		"	
FINISH	CAD #23	"	
TEMP.		"	
PATT.		"	

TITLE:
FISCHER DELUXE RF-100 X-RAY UNIT
SCREEN COUNTERPOISE LOCK SUPP.

H. G. FISCHER & CO.
2335 WABANSIA AVE.
CHICAGO, ILL.

CAT. NO.

PART NO. 17367

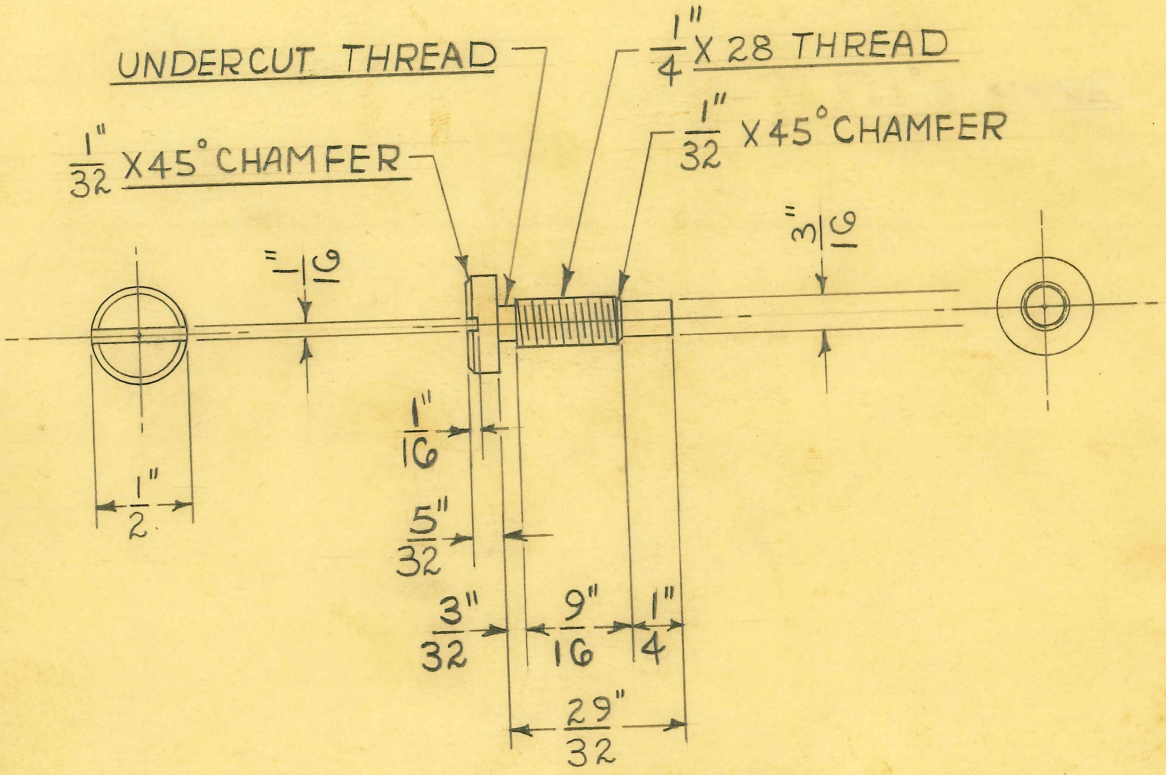

2 REQUIRED

DIMENSIONS	
FRACTIONAL	± .015
DECIMAL	± .005
ANGULAR	± 1/2°

UNLESS OTHERWISE SPECIFIED

SIZE	1/2" DIA.	ISSUE 11-22-47	W.J.
KIND	C.R. STEEL	CHANGED	
SHAPE	ROD	"	
FINISH	CAD. #23	"	
TEMP.		"	
PATT.		"	

TITLE:

FISCHER DELUXE RF-100 X-RAY UNIT
SCREEN COUNTERPOISE LOCK POSITION SCREW

H. G. FISCHER & CO.
2335 WABANSIA AVE.
CHICAGO, ILL.

CAT. NO.

PART NO. 17368

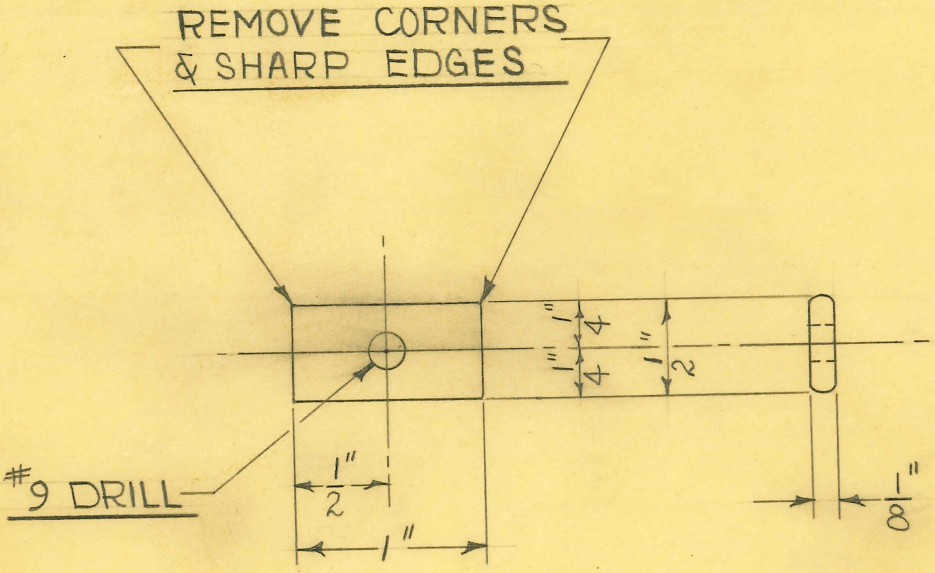

1 REQUIRED

DRILL JIG TOOL #9575

DIMENSIONS	
FRACTIONAL	± .015
DECIMAL	± .005
ANGULAR	± 1/2°

UNLESS OTHERWISE SPECIFIED

SIZE	1/8" X 1/2"	ISSUE 11-24-47	W.J.
KIND	FLAT WIRE	CHANGED	
SHAPE		"	
FINISH	CAD. #23	"	
TEMP.		"	
PATT.		"	

TITLE:
FISCHER DELUXE RF-100 X-RAY UNIT
SCREEN PIVOT SUPP. CLAMP WASHER

H. G. FISCHER & CO.
2335 WABANSIA AVE.
CHICAGO, ILL.

CAT. NO.

PART NO. 17369

BREAK EDGES INSIDE & OUT ON BOTH ENDS

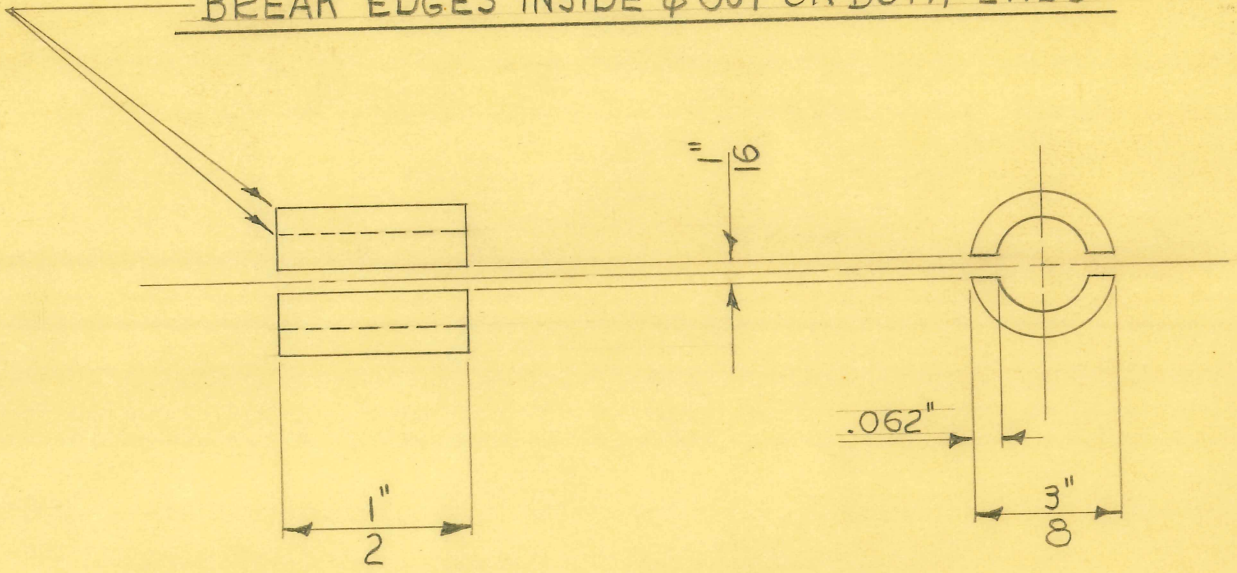

SCALE ÷ DOUBLE SIZE

1- REQUIRED

— 3/8" O.D. X 1/4" I.D. SEAMLESS BRASS TUBING

SLOTTING FIXTURE TOOL # 9569

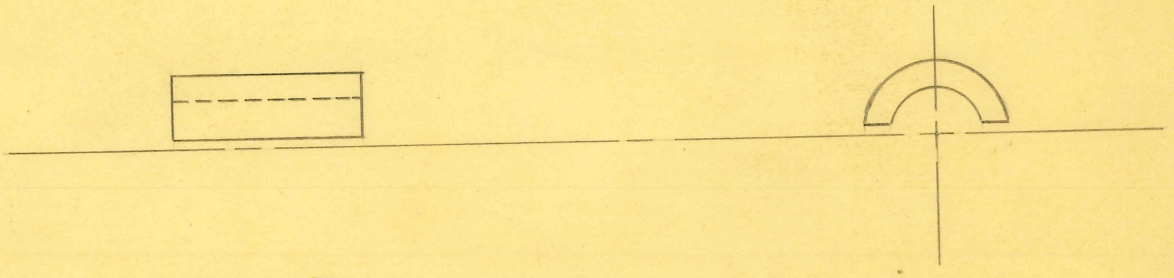

2 HALVES - REQUIRED

DIMENSIONS	
FRACTIONAL	± .015
DECIMAL	± .005
ANGULAR	± 1/2°

UNLESS OTHERWISE SPECIFIED

SIZE		ISSUE	12-18-47	J.M.F
KIND		CHANGED		
SHAPE		"		
FINISH		"		
TEMP.		"		
PATT.		"		

TITLE: FISCHER DELUXE RF-100 X-RAY SHUTTER CABLE END SUPP. SPLIT BUSHING

H. G. FISCHER & CO.
2335 WABANSIA AVE.
CHICAGO, ILL.

CAT. NO.

PART NO. 17370

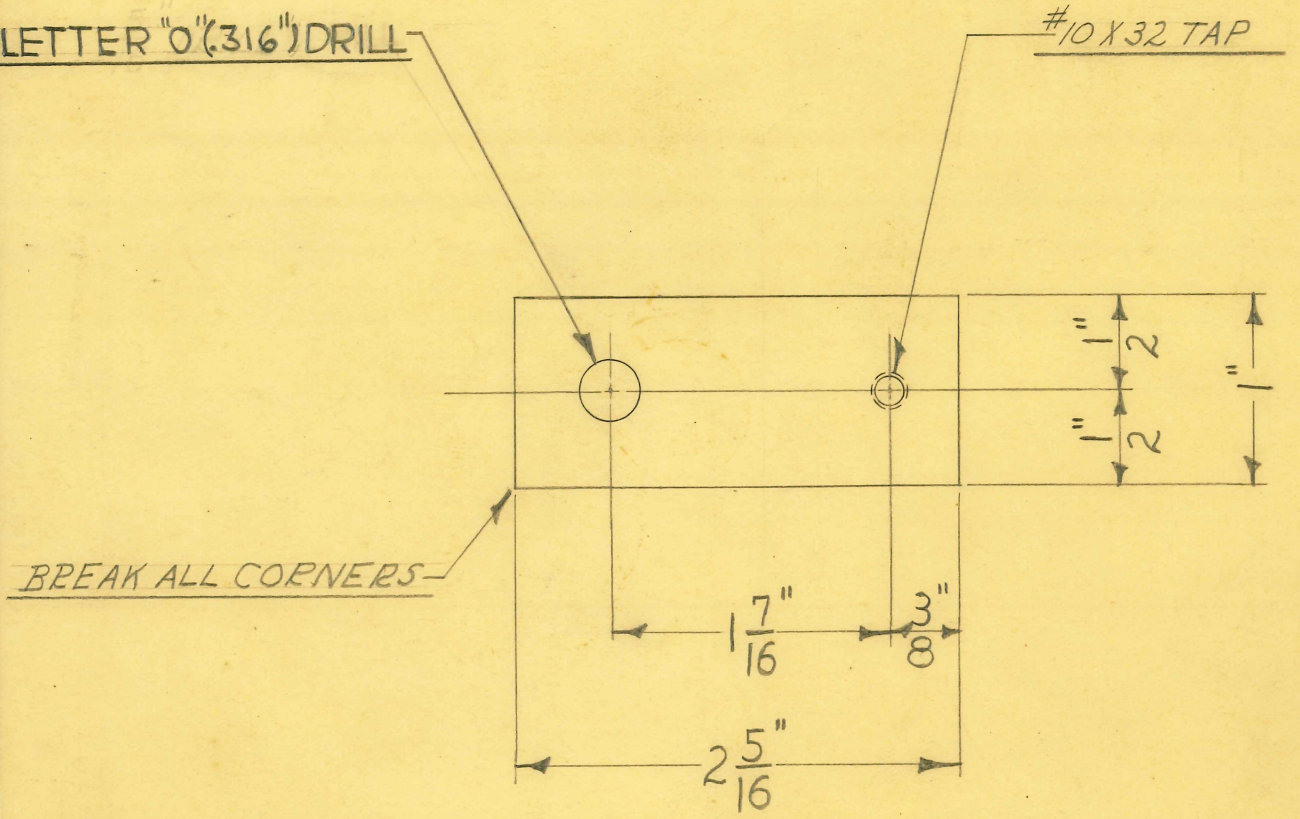

2-REQUIRED

DRILL JIG TOOL #9587

DIMENSIONS	
FRACTIONAL	± .015
DECIMAL	± .005
ANGULAR	± 1/2°

UNLESS OTHERWISE SPECIFIED

SIZE	1" X 1/8"	ISSUE 11-25-47	JMF
KIND	C.R. STEEL	CHANGED	
SHAPE	BAR	"	
FINISH	CAD #23	"	
TEMP.		"	
PATT.		"	

TITLE: FISCHER DELUXE "RF-100" X-RAY BUCKY BUMPER SUPPORT PLATE

H. G. FISCHER & CO.
2335 WABANSIA AVE.
CHICAGO, ILL.

CAT. NO.

PART NO. 17376

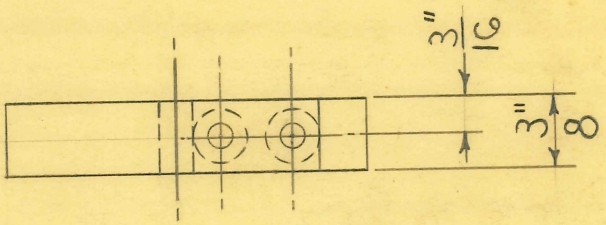

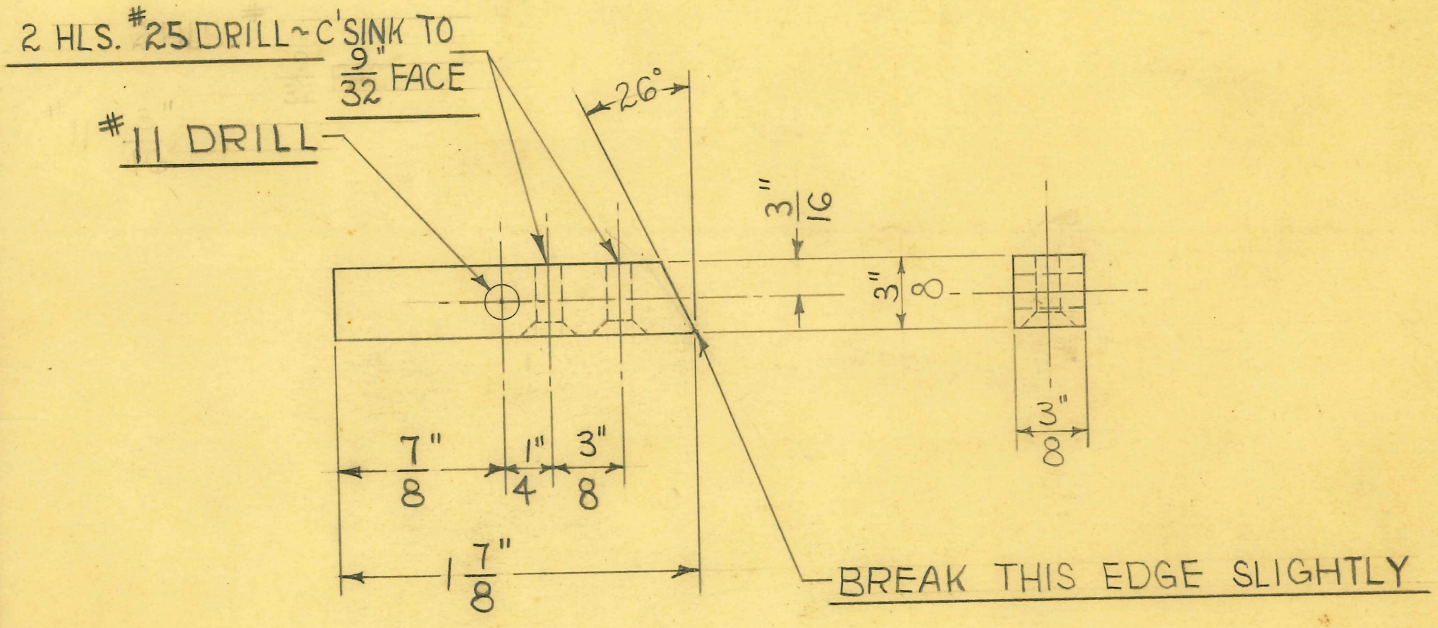

1 REQUIRED

DRILL JIG TOOL #9590

DIMENSIONS	
FRACTIONAL	± .015
DECIMAL	± .005
ANGULAR	± 1/2°

UNLESS OTHERWISE SPECIFIED

SIZE	3/8" SQUARE	ISSUE 11-22-47	W.J.
KIND	C.R. STEEL	CHANGED	
SHAPE		"	
FINISH	CAD. #23	"	
TEMP.		"	
PATT.		"	

TITLE:
FISCHER DELUXE RF-100 X-RAY UNIT
SCREEN COUNTERPOISE INTERLOCK CATCH

H. G. FISCHER & CO.
2335 WABANSIA AVE.
CHICAGO, ILL.

CAT. NO.

PART NO. 17377

2 HLS. #49 DRILL

ROUND EDGE ~ BOTH ENDS

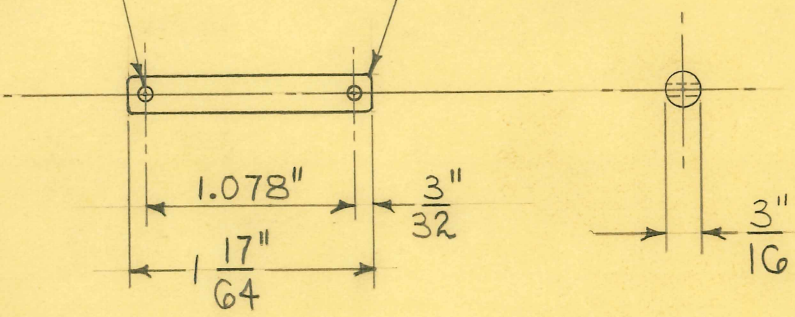

1 REQUIRED

DRILL JIG TOOL #9591

DIMENSIONS	
FRACTIONAL	± .015
DECIMAL	± .005
ANGULAR	± 1/2°

UNLESS OTHERWISE SPECIFIED

SIZE	3/16" DIA.	ISSUE 12-3-47	W.J.
KIND	C.R. STEEL	CHANGED	
SHAPE		"	
FINISH	CAD. #23	"	
TEMP.		"	
PATT.		"	

TITLE:
FISCHER "DELUXE RF-100" X-RAY UNIT
SCREEN COUNTERPOISE INTERLOCK CATCH PIN

H. G. FISCHER & CO.
2335 WABANSIA AVE.
CHICAGO, ILL.

CAT. NO.

PART NO. 17378

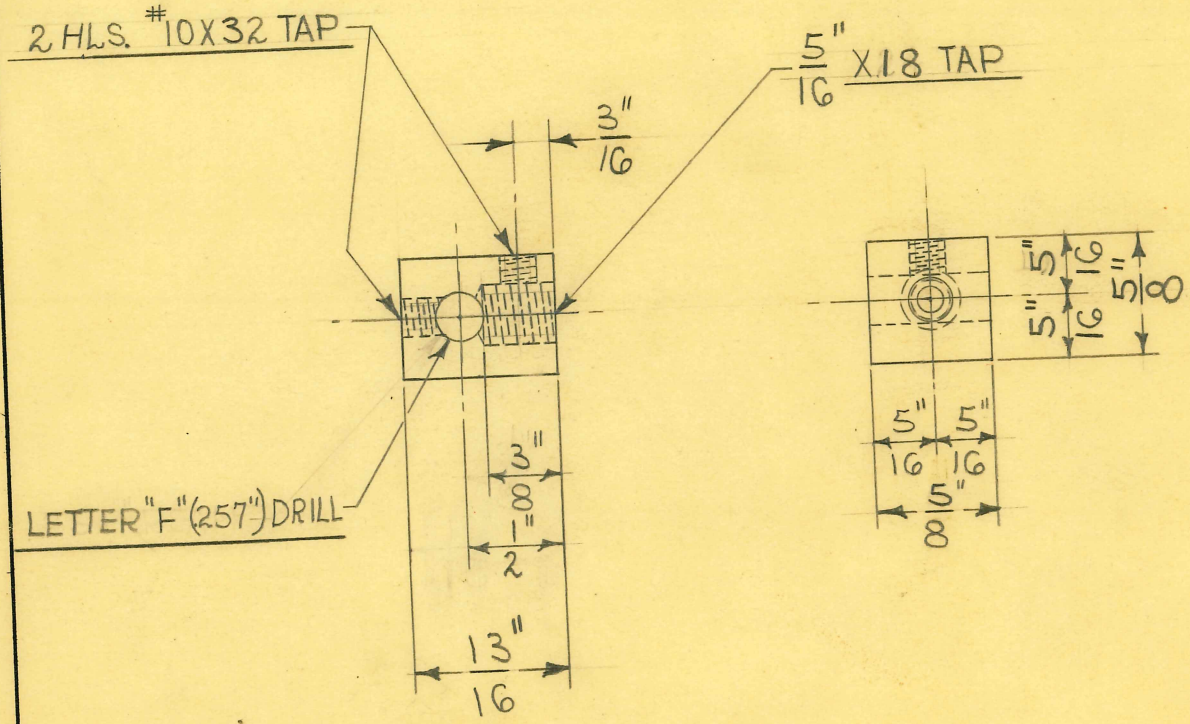

1 REQUIRED

DIMENSIONS
FRACTIONAL ± .015
DECIMAL ± .005
ANGULAR ± 1/2°
UNLESS OTHERWISE SPECIFIED

DRILL JIG TOOL # 9620

SIZE	5/8" SQUARE	ISSUE 12-19-47	W.J.
KIND	C.R. STEEL	CHANGED	
SHAPE	BAR	"	
FINISH	CAD #23	"	
TEMP.		"	
PATT.		"	

TITLE:
FISCHER "DELUXE RF-100" X-RAY UNIT
COUNTERPOISE PIN SUPP.

H. G. FISCHER & CO.
2338 WABANSIA AVE.
CHICAGO, ILL.

CAT. NO.

PART NO. 17380

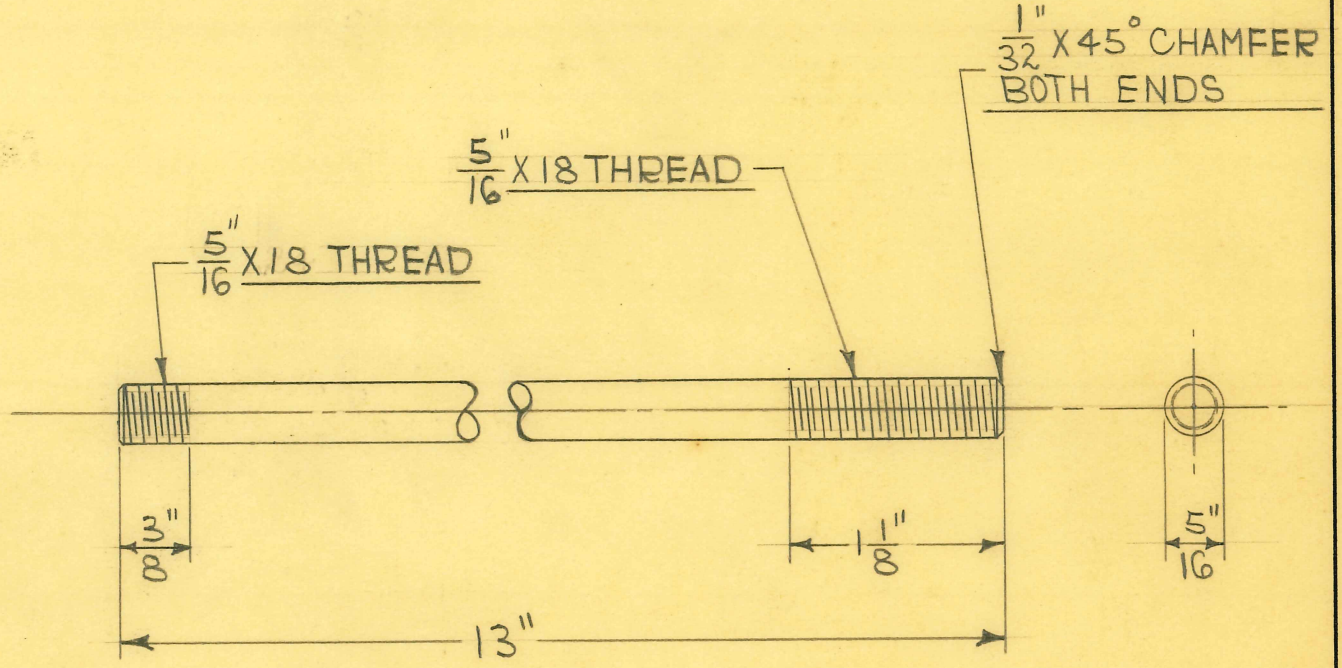

1 REQUIRED

DIMENSIONS	
FRACTIONAL	± .015
DECIMAL	± .005
ANGULAR	± 1/2°
UNLESS OTHERWISE SPECIFIED	

SIZE	5/16" DIA.	ISSUE 12-18-47	W.J.	**TITLE:** FISCHER "DELUXE RF-100" X-RAY UNIT COUNTER POISE ROD
KIND	C.R. STEEL	CHANGED		
SHAPE	ROD	"		
FINISH	CAD. #23	"		
TEMP.		"		
PATT.		"		

H. G. FISCHER & CO.
2335 WABANSIA AVE.
CHICAGO, ILL.

CAT. NO.

PART NO. 17381

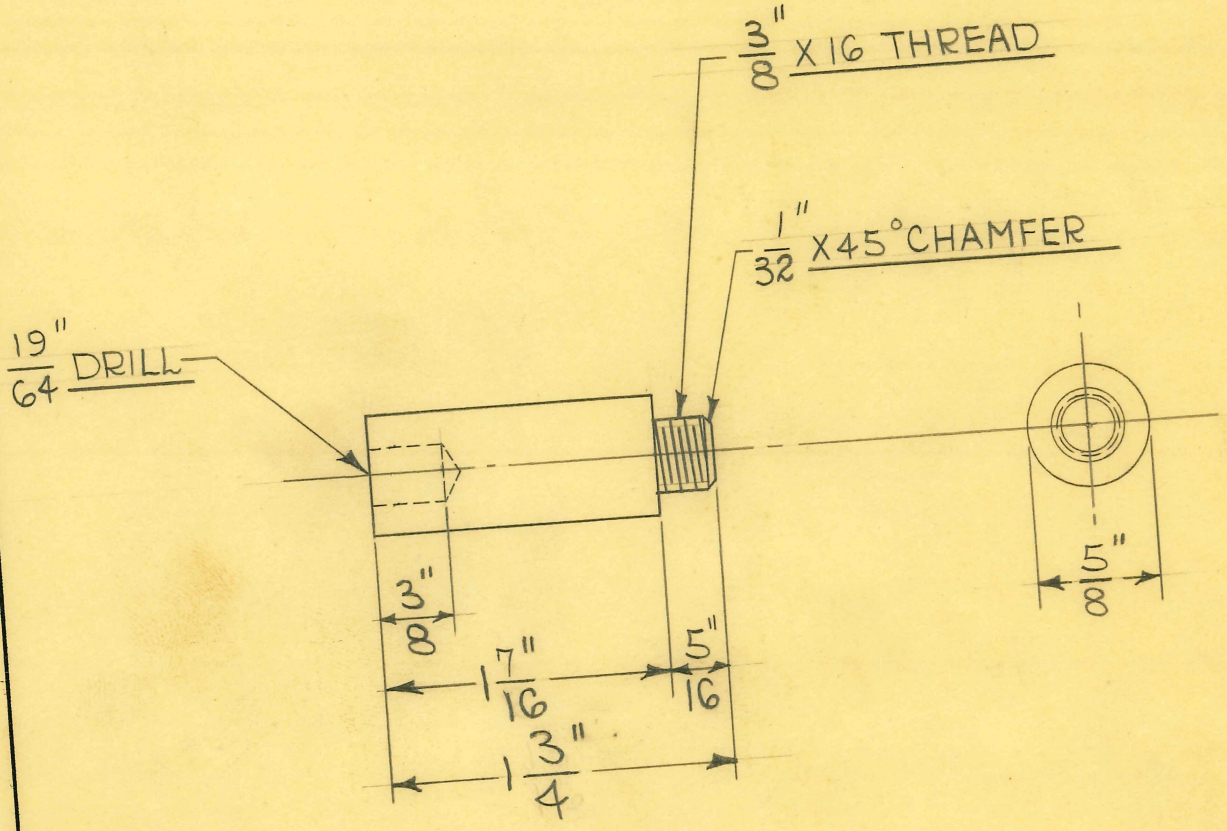

2 REQUIRED

DIMENSIONS
FRACTIONAL ± .01
DECIMAL ± .00
ANGULAR ± 1/2
UNLESS OTHERWISE SPECI

SIZE	5/8" DIA.	ISSUE 2-18-47	W. J.
KIND	C.R. STEEL	CHANGED	
SHAPE	ROD	"	
FINISH	CAD. #23	"	
TEMP.		"	
PATT.		"	

TITLE: FISCHER "DELUXE RF-100" X-RAY UNIT
FLUOROSCOPIC CONE BUMPER SUPP.

H. G. FISCHER & CO.
2335 WABANSIA AVE.
CHICAGO, ILL.

CAT. NO.

PART NO. 17382

2 HLS. #49 DRILL

ROUND EDGE ~ BOTH ENDS

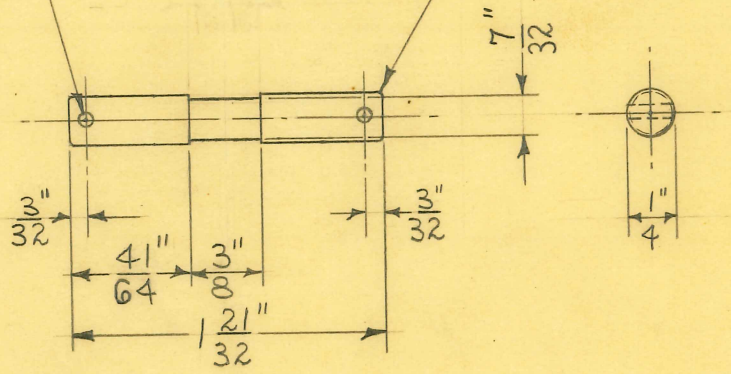

1 REQUIRED

DRILL JIG TOOL # 9626

DIMENSIONS	
FRACTIONAL	± .015
DECIMAL	± .005
ANGULAR	± 1/2°

UNLESS OTHERWISE SPECIFIED

SIZE	1/4" DIA.	ISSUE 12-19-47	W. J.
KIND	C.R. STEEL	CHANGED	
SHAPE	ROD	"	
FINISH	CAD. #23	"	
TEMP.		"	
PATT.		"	

TITLE:

FISCHER DELUXE RF-100 X-RAY UNIT

COUNTERPOISE PIN

H. G. FISCHER & CO.
2335 WABANSIA AVE.
CHICAGO, ILL.

CAT. NO.

PART NO. 17383

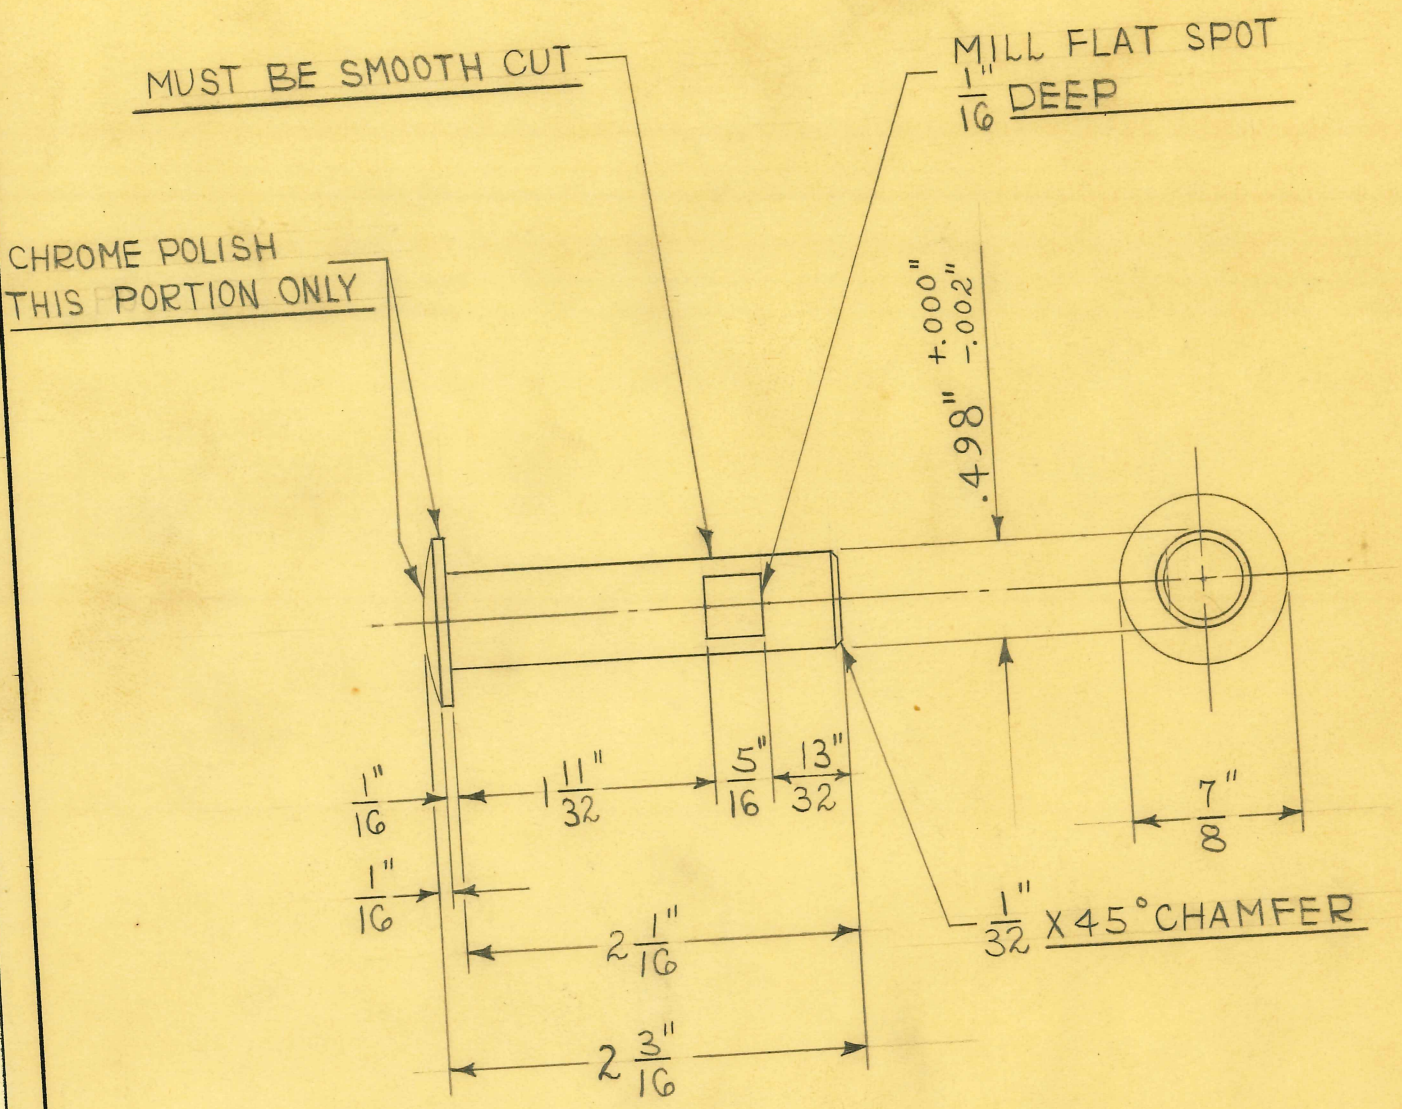

2 REQUIRED

DIMENSIONS	
FRACTIONAL	± .015
DECIMAL	± .00
ANGULAR	± 1/2

UNLESS OTHERWISE SPECIF

SIZE	7/8" DIA.	ISSUE 12-22-47	W. J.
KIND	C. R. STEEL	CHANGED	
SHAPE	ROD	"	
FINISH	SEE NOTE	"	
TEMP.		"	
PATT.		"	

TITLE: FISCHER "DELUXE RF-100" X-RAY UNIT
SCREEN FORK SWIVEL SHAFT

H. G. FISCHER & CO.
2335 WABANSIA AVE.
CHICAGO, ILL.

CAT. NO.

PART NO. 1738

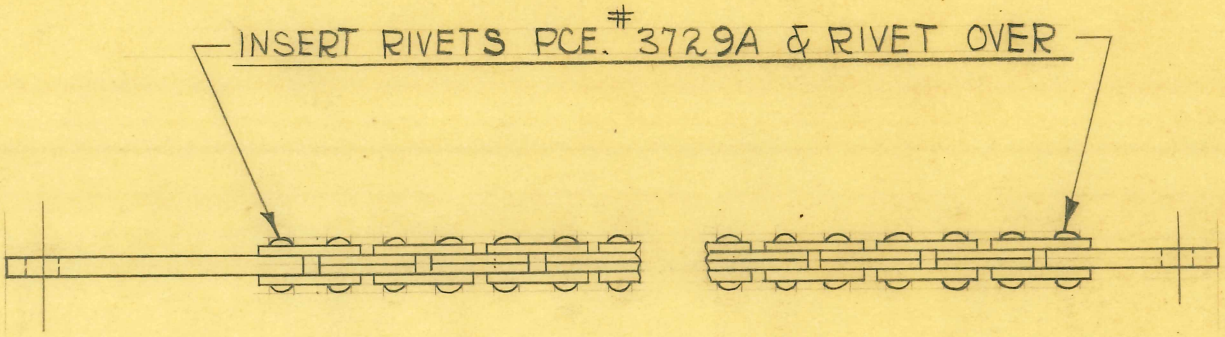

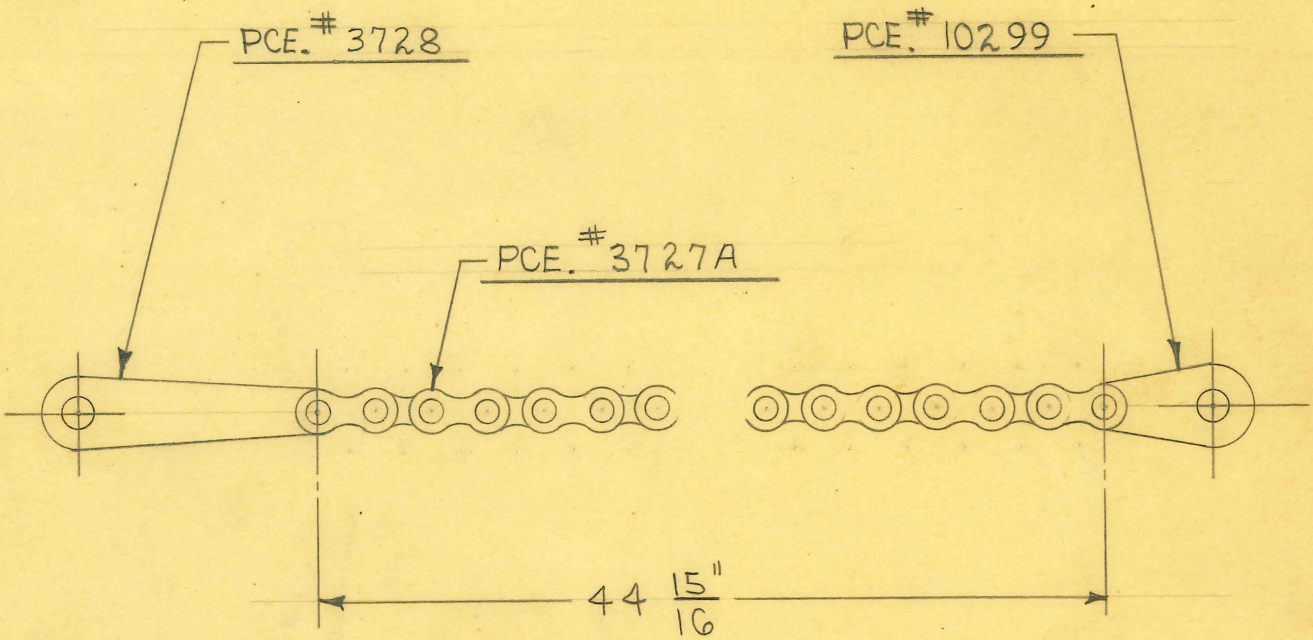

1 REQUIRED

SIZE		ISSUE 12-20-47	W.J.
KIND		CHANGED	
SHAPE		"	
FINISH		"	
TEMP.		"	
PATT.		"	

TITLE: FISCHER "DELUXE RF-100 X-RAY UNIT SCREEN CWT. CHAIN ASSEM. UPPER

H. G. FISCHER & CO.
2335 WABANSIA AVE.
CHICAGO. ILL.

CAT. NO.

PART NO. 17385G

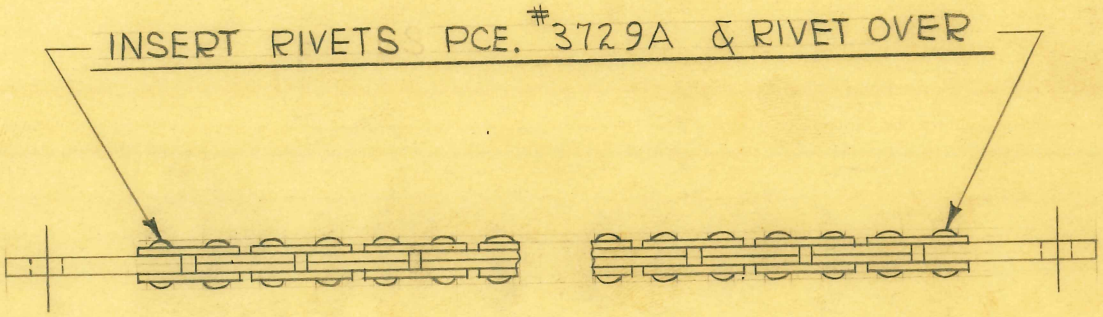

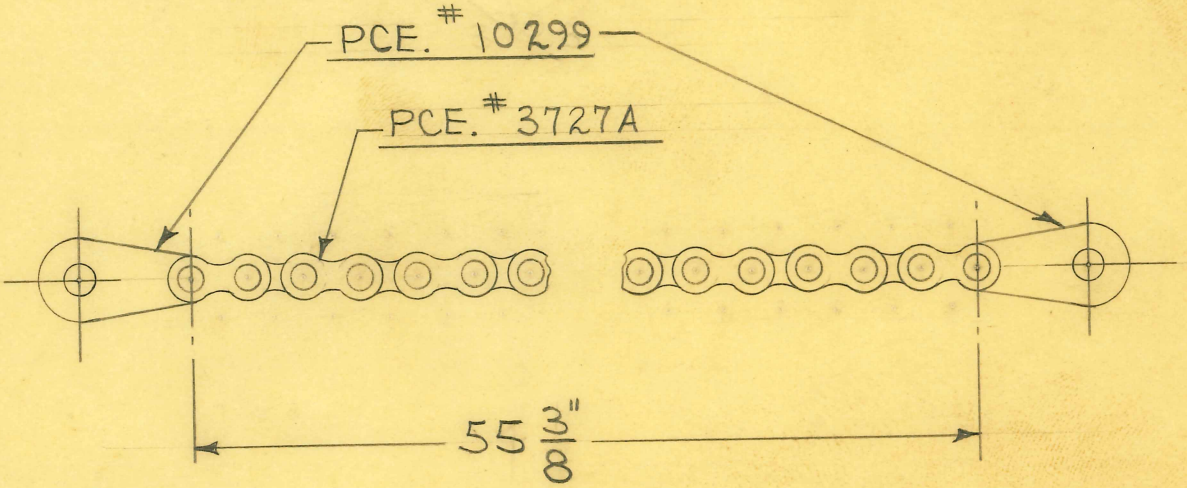

1 REQUIRED

SIZE		ISSUE 2-20-47	W.J.	
KIND		CHANGED		
SHAPE		"		
FINISH		"		
TEMP.		"		
PATT.		"		

TITLE:
FISCHER "DELUXE RF-100" X-RAY UNIT
SCREEN CWT CHAIN ASSEM. LOWER

H. G. FISCHER & CO.
2335 WABANSIA AVE.
CHICAGO. ILL.

CAT. NO.

PART NO. 173866

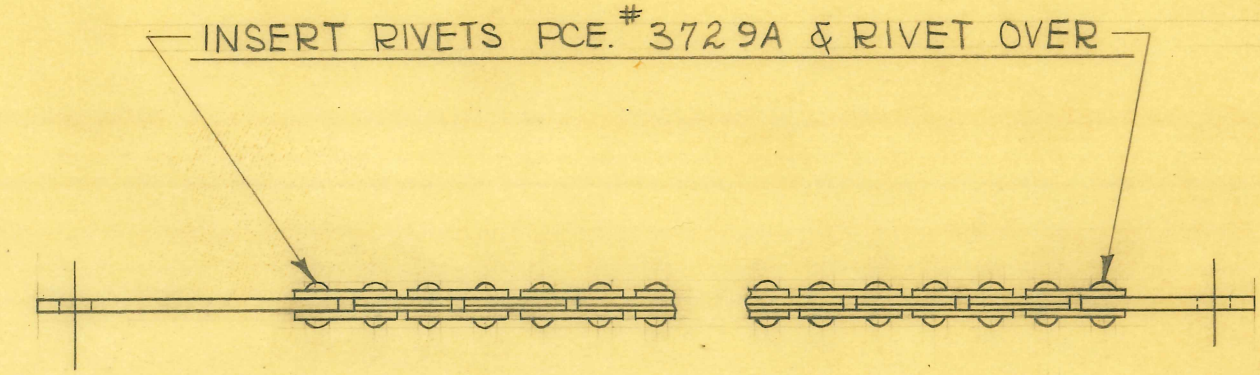

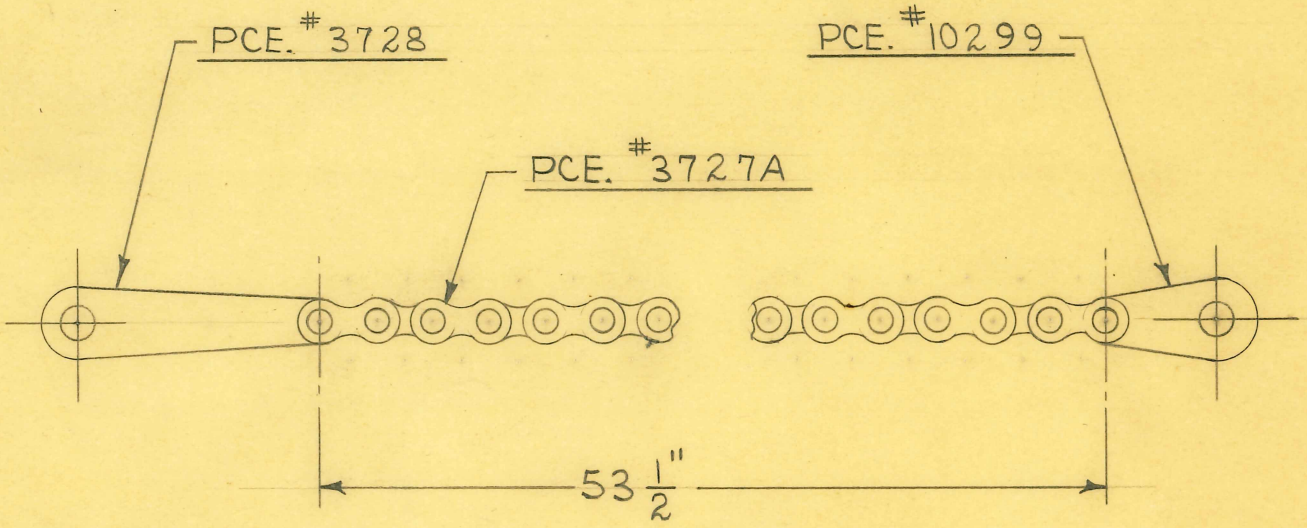

1 REQUIRED

SIZE		ISSUE	
KIND		CHANGED	
SHAPE		"	
FINISH		"	
TEMP.		"	
PATT.		"	

TITLE:
FISCHER "DELUXE RF-100 X-RAY UNIT
BUCKY CWT CHAIN ASSEM. - UPPER

H. G. FISCHER & CO.
2335 WABANSIA AVE.
CHICAGO, ILL.

CAT. NO.

PART NO. 17387G

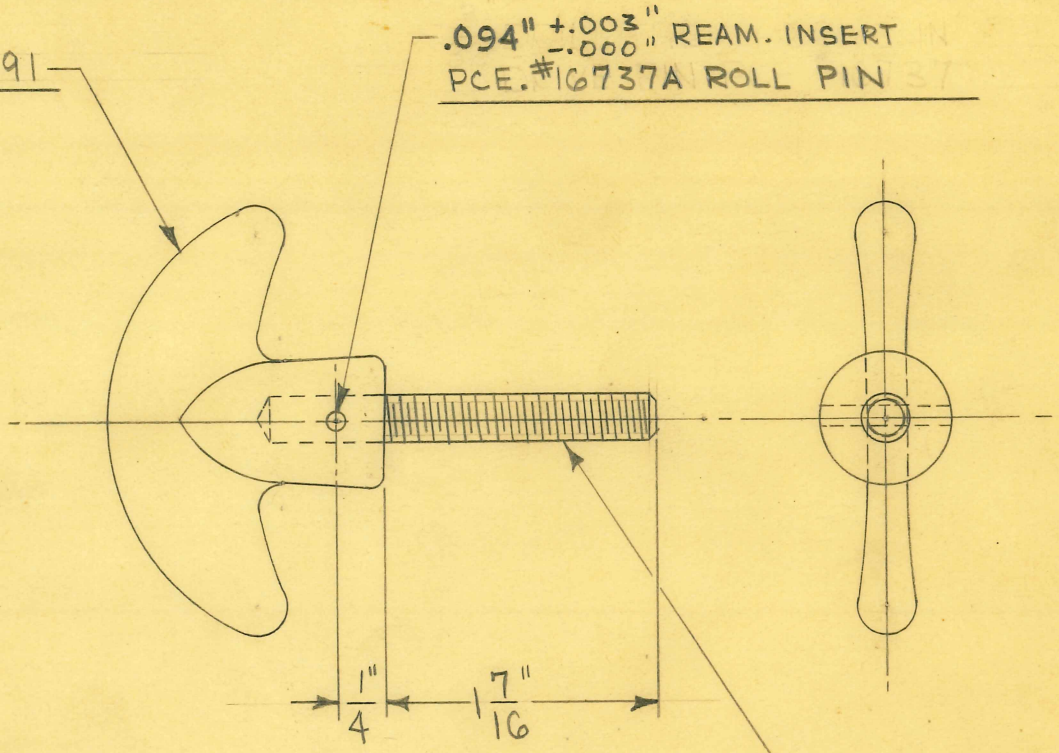

1 REQUIRED

DRILL JIG TOOL #9627

DIMENSIONS	
FRACTIONAL	± .015
DECIMAL	± .005
ANGULAR	± 1/2°

UNLESS OTHERWISE SPECIFIED

SIZE		ISSUE 12-22-47	W.J.
KIND		CHANGED	
SHAPE		" 7-18-49	W.J.
FINISH		"	
TEMP.		"	
PATT.		"	

TITLE:
FISCHER DELUXE RF-100 X-RAY UNIT
SCREEN FORK LOCK WING SCREW ASSEM.

H. G. FISCHER & CO.
2335 WABANSIA AVE.
CHICAGO, ILL.

CAT. NO.

PART NO. 17390G

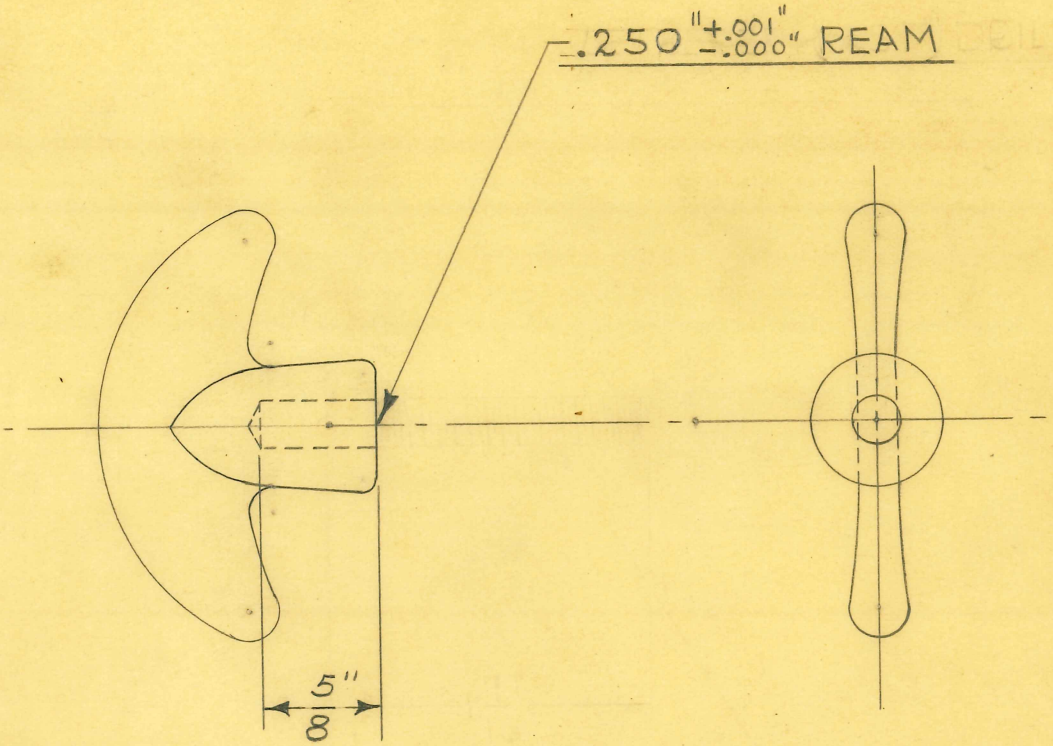

1 REQUIRED

TURNING JAWS # 11542

DIMENSIONS	
FRACTIONAL	± .015
DECIMAL	± .005
ANGULAR	± 1/2°

UNLESS OTHERWISE SPECIFIED

SIZE	FROM 12995	ISSUE 12-22-47	W.J.
KIND		CHANGED	
SHAPE		"	
FINISH	CHROME #2	"	
TEMP.		"	
PATT.		"	

TITLE:
FISCHER DELUXE RF-100 X-RAY UNIT
SCREEN FORK LOCK SHAFT WING NUT

H. G. FISCHER & CO.
2335 WABANSIA AVE.
CHICAGO, ILL.

CAT. NO.

PART NO. 17391

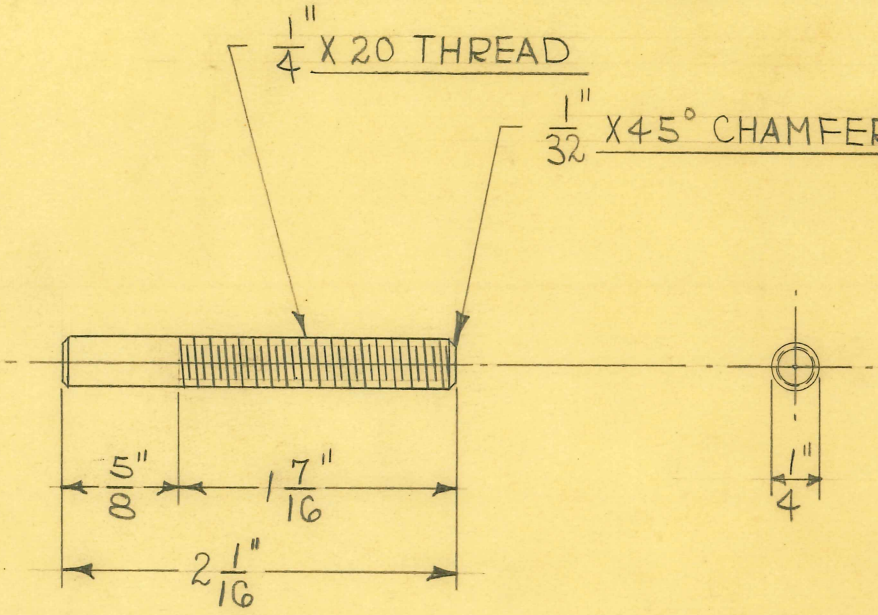

1 REQUIRED

DIMENSIONS	
FRACTIONAL	± .015
DECIMAL	± .005
ANGULAR	± 1/2°

UNLESS OTHERWISE SPECIFIED

SIZE	1/4" DIA.	ISSUE 12-22-47	W.J.
KIND	C.R.STEEL	CHANGED	
SHAPE	ROD	"	
FINISH	CAD. #23	"	
TEMP.		"	
PATT.		"	

TITLE: FISCHER DELUXE RF-100 X-RAY UNIT
SCREEN FORK LOCK SHAFT

H. G. FISCHER & CO.
2335 WABANSIA AVE.
CHICAGO, ILL.

CAT. NO.

PART NO. 17392

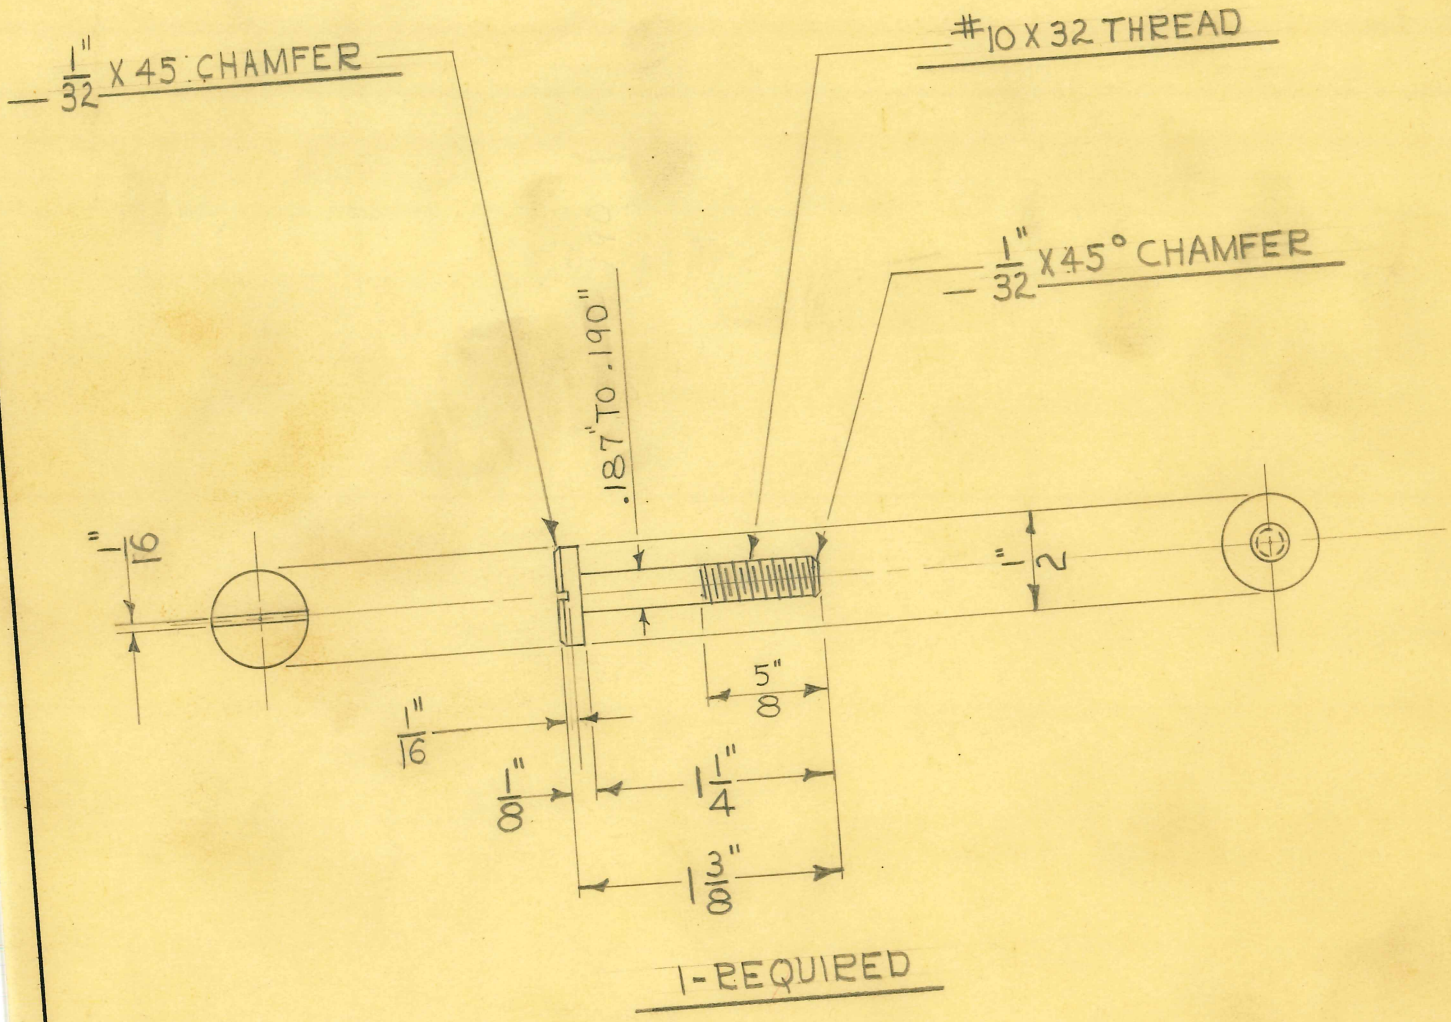

1-REQUIRED

DIMENSIONS	
FRACTIONAL	± .01
DECIMAL	± .00
ANGULAR	± 1/2

UNLESS OTHERWISE SPECI

SIZE	1/2" DIAM.	ISSUE 12-30-47	J.M.F	
KIND	C.R. STEEL	CHANGED		
SHAPE	ROD	"		
FINISH	CAD.# 23	"		
TEMP.		"		
		"		

TITLE: FISCHER DELUXE RF-100 X-RAY UNIT SCREEN FORK LOCK BUSHING SCREW

H. G. FISCHER & CO.
2335 WABANSIA AVE.
CHICAGO, ILL.

CAT. NO.

PART NO. 17403

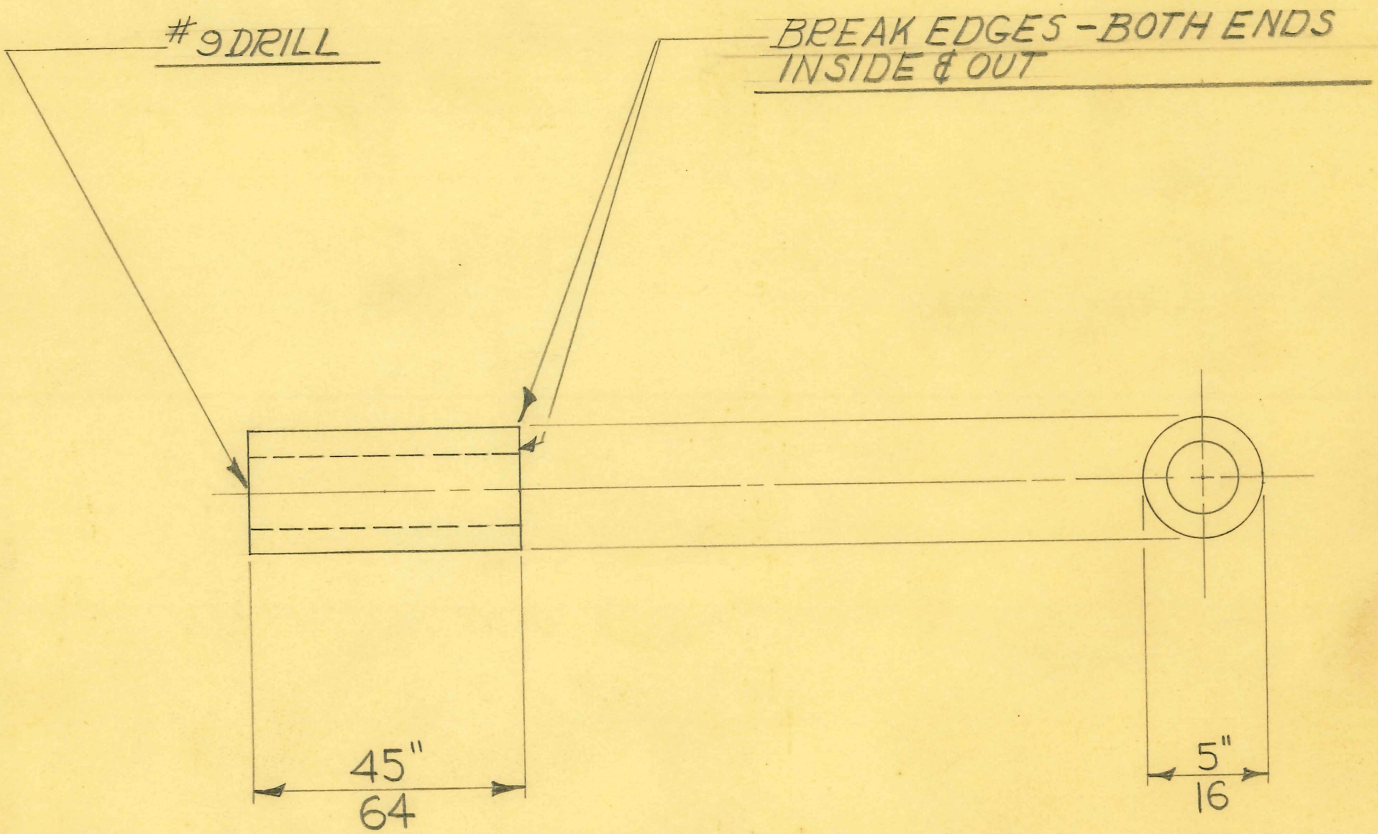

SCALE ~ DOUBLE SIZE

1 - REQUIRED

DIMENSIONS	
FRACTIONAL	± .015
DECIMAL	± .005
ANGULAR	± 1/2°

UNLESS OTHERWISE SPECIFIED

SIZE	5/16" DIAM.	ISSUE 12-29-47	J.M.F
KIND	C.R. STEEL	CHANGED	
SHAPE	ROD	"	
FINISH	CAD# 23	"	
TEMP.		"	
PATT.		"	

TITLE:

FISCHER DELUXE RF-100 X-RAY SCREEN FORK LOCK BUSHING

H. G. FISCHER & CO.
2335 WABANSIA AVE.
CHICAGO, ILL.

CAT. NO.

PART NO. 17404

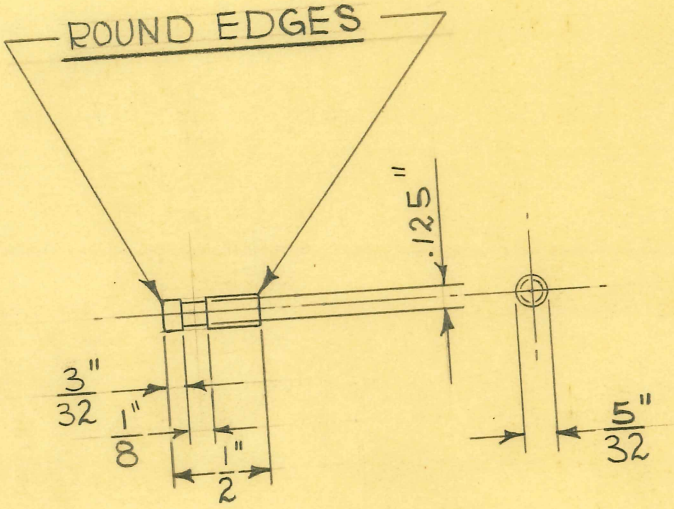

2 REQUIRED

DIMENSIONS	
FRACTIONAL	± .015
DECIMAL	± .005
ANGULAR	± 1/2°

UNLESS OTHERWISE SPECIFI

SIZE	5/32" DIA.	ISSUE 12-29-47	W.J.
KIND	C.R. STEEL	CHANGED	
SHAPE	ROD.	"	
FINISH	CAD. #23	"	
TEMP.		"	
PATT.		"	

TITLE: FISCHER DELUXE RF-100 X-RAY UNIT
SHUTTER CABLE PIN

H. G. FISCHER & CO.
2335 WABANSIA AVE.
CHICAGO, ILL.

CAT. NO.

PART NO. 17405

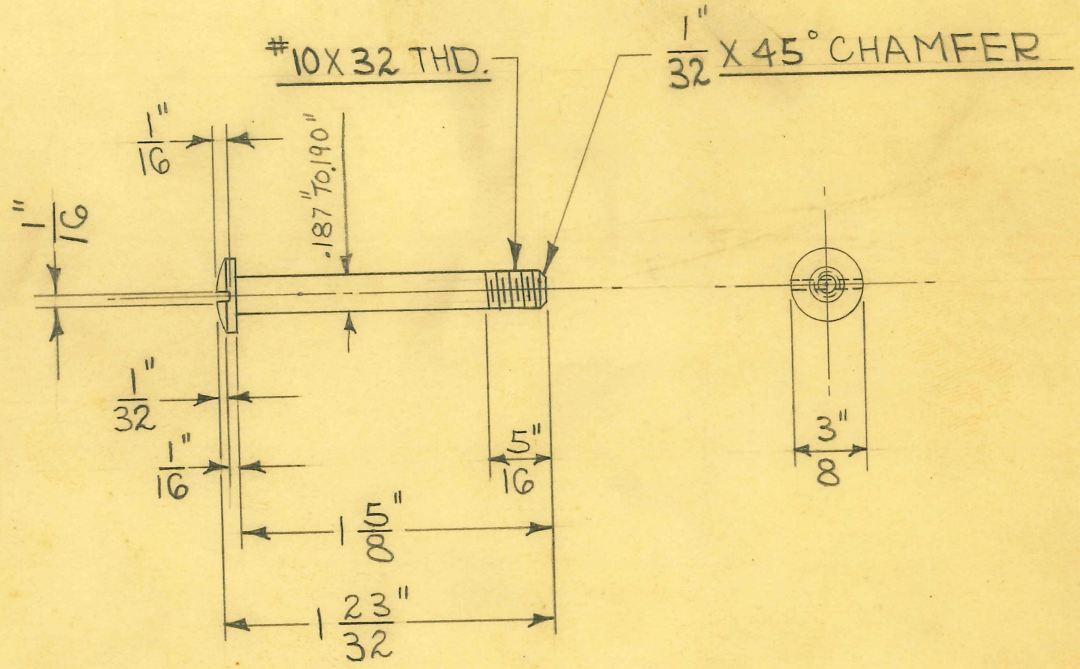

1 REQUIRED

DIMENSIONS	
FRACTIONAL	± .015
DECIMAL	± .005
ANGULAR	± 1/2°

UNLESS OTHERWISE SPECIFIED

SIZE	3/8" DIA.	ISSUE 12-30-47	W.J.
KIND	C.R. STEEL	CHANGED	
SHAPE	ROD	"	
FINISH	CAD. #23	"	
TEMP.		"	
PATT.		"	

TITLE: FISCHER DELUXE RF-100 X-RAY UNIT
SHUTTER LEVER RETAINING SCREW

H. G. FISCHER & CO.
2335 WABANSIA AVE.
CHICAGO, ILL.

CAT. NO.

PART NO. 17406

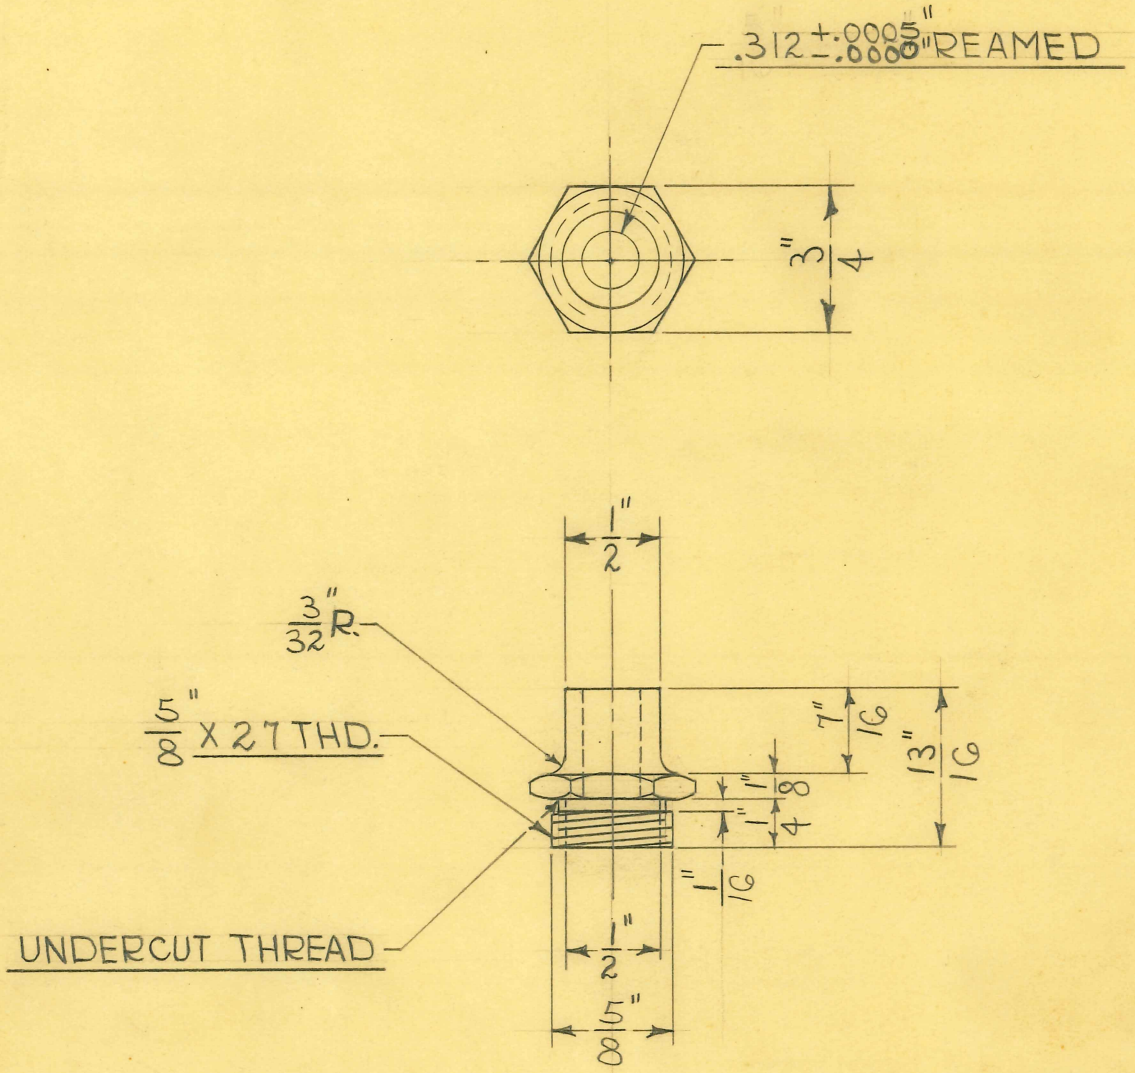

1 REQUIRED

DIMENSIONS	
FRACTIONAL	± .015
DECIMAL	± .005
ANGULAR	± 1/2°

UNLESS OTHERWISE SPECIFIED

SIZE	3/4" HEX	ISSUE 12-30-47	W.J.
KIND	C.R. STEEL	CHANGED	
SHAPE		"	
FINISH	CHROME POL.	"	
TEMP.		"	
PATT.		"	

TITLE: FISCHER "DELUXE RF-100" X-RAY UNIT

SCREEN PIVOT LOCK PIN UPPER GUIDE

H. G. FISCHER & CO.
2335 WABANSIA AVE.
CHICAGO, ILL.

CAT. NO.

PART NO. 17407

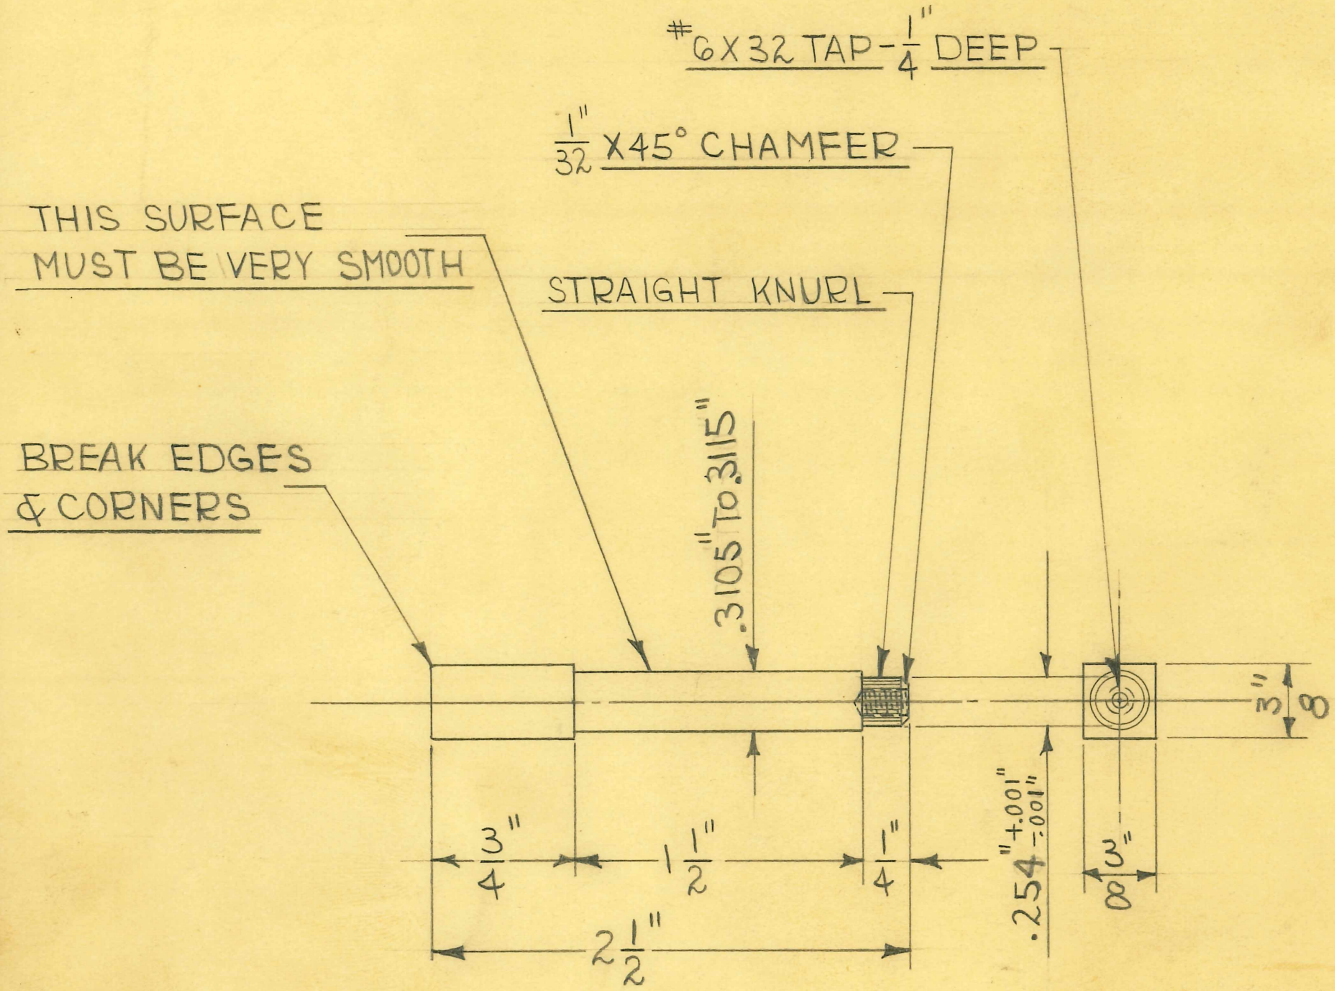

1 REQUIRED

DIMENSIONS	
FRACTIONAL	± .015
DECIMAL	± .005
ANGULAR	± 1/2°

UNLESS OTHERWISE SPECIFIED

SIZE	3/8" SQUARE	ISSUE 12-31-47	W.J.
KIND	DRILL	CHANGED	
SHAPE	ROD	"	
FINISH	WH. NICK. #13	"	
TEMP.		"	
PATT.		"	

TITLE:

FISCHER "DELUXE RF-100 X-RAY UNIT SCREEN PIVOT LOCK PIN

H. G. FISCHER & CO.
2335 WABANSIA AVE.
CHICAGO, ILL.

CAT. NO.

PART NO. 17408

TITLE FISCHER DELUXE "RF-100" X-RAY UNIT SCREEN
COUNTERPOISE INTERLOCK WEIGHT SUPP. ASSEMBLY

H. G. FISCHER & CO.
FRANKLIN PARK, ILLINOIS

DATE 10-20-48 | DR. BY K.S. | CH'K'D.

SCALE FULL

PATTERN | FINISH | MATERIAL

TOOLS ASSEMBLY MOLD #1829

DIMENSIONS
FRACTIONAL ± .015
DECIMAL ± .005
ANGULAR ± ½°
UNLESS OTHERWISE SPECIFIED

PCE. # 17410 G A

REVISION	DATE	BY

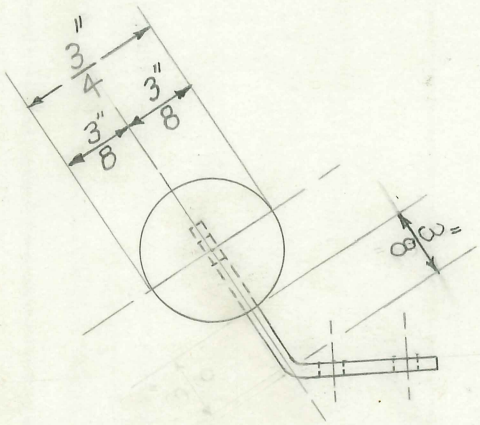

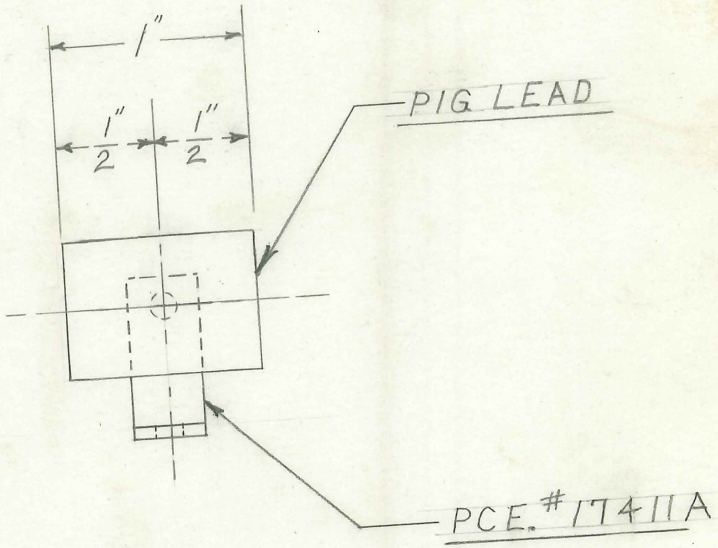

1 REQUIRED

FOLDER #127

TITLE FISCHER DELUXE "RF-100" X-RAY UNIT SCREEN COUNTERPOISE INTERLOCK WEIGHT SUPP.

H. G. FISCHER & CO.
FRANKLIN PARK, ILLINOIS

PART NO. 17411A

DATE 10-20-48 | DR. BY K.S. | CH'K'D. J.V.W.

REVISION	DATE	BY

PATTERN | FINISH CAD #23 | SCALE FULL

TOOLS DRILL JIG TOOL #9681 | MATERIAL $\frac{1}{16}$" X $\frac{3}{8}$" FLAT WIRE

DIMENSIONS UNLESS OTHERWISE SPECIFIED
FRACTIONAL ± .015
DECIMAL ± .005
ANGULAR ± ½°

PUNCH TOOL #9953 TO BE USED WITH "V" DIE #6372-Z7

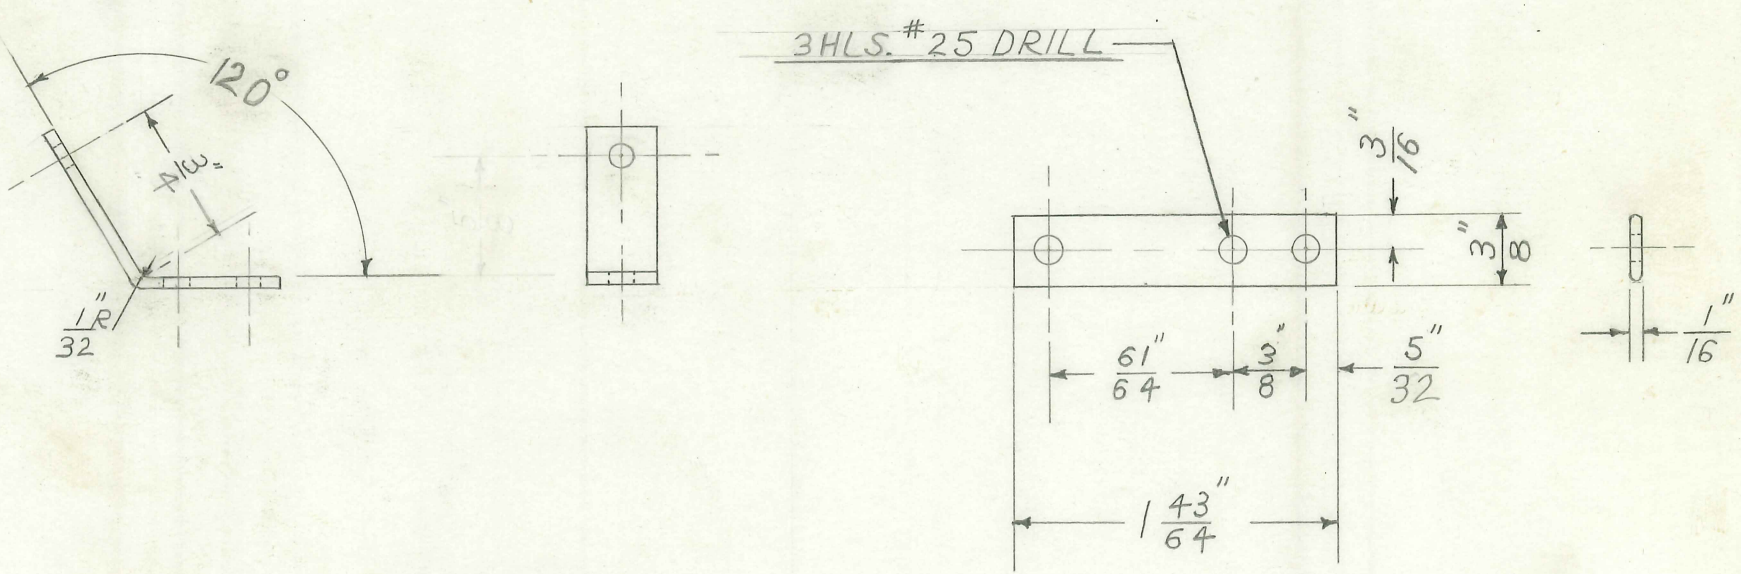

DEVELOPMENT

1 REQUIRED

FOLDER #127

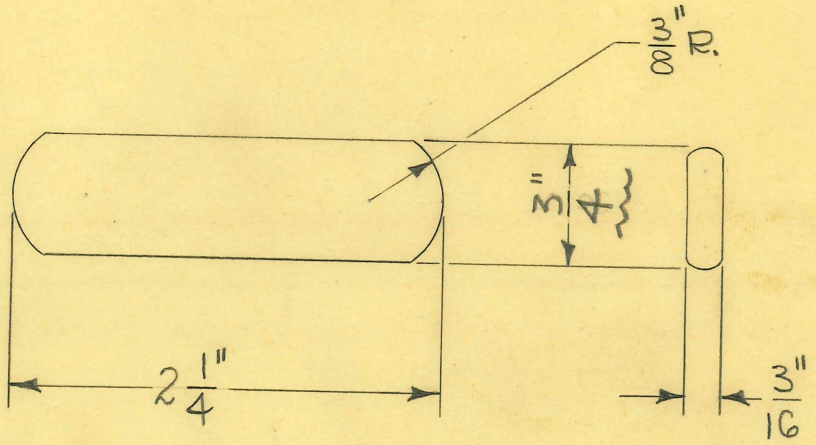

DEVELOPMENT

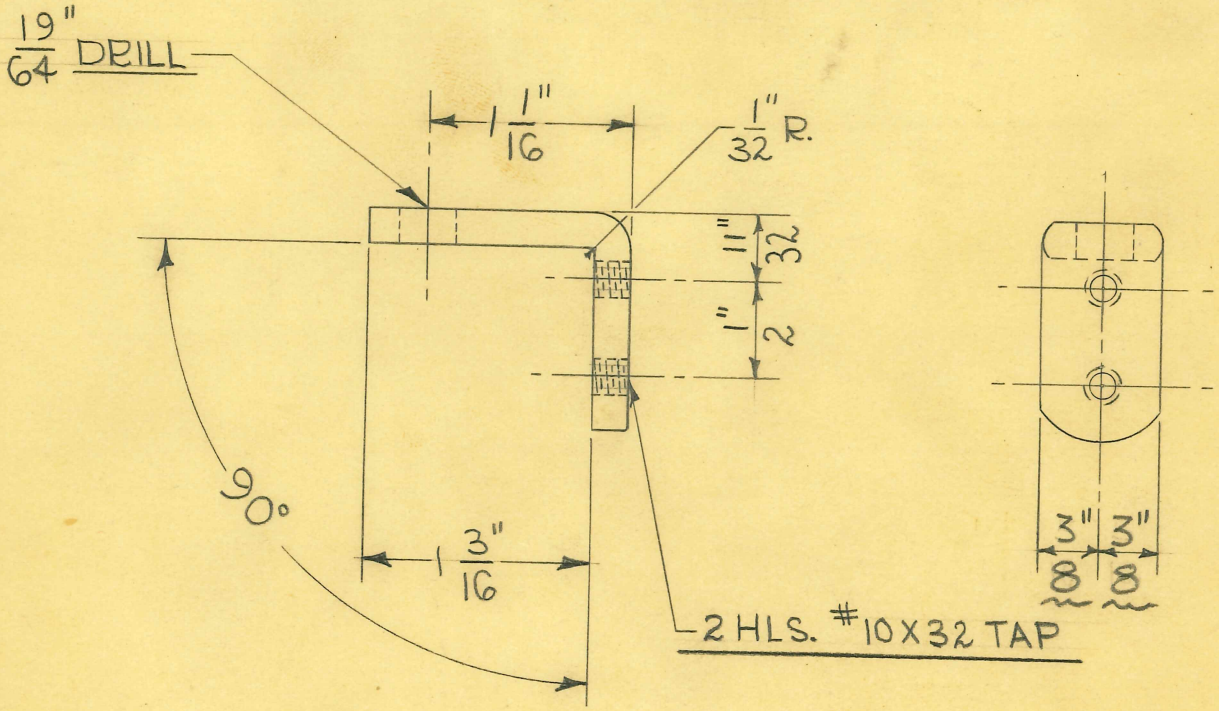

2 REQUIRED

DRILL JIG Tool #9705

CUT OFF DIE #3045

SIZE	3/16" X 3/4"	ISSUE 2-10-48	W.J.
KIND	FLAT WIRE	CHANGED	
SHAPE	FLAT WIRE	"	
FINISH	CAD. #23	"	
TEMP.		"	
PATT.		"	

DIMENSIONS
FRACTIONAL ± .015
DECIMAL ± .005
ANGULAR ± 1/2°
UNLESS OTHERWISE SPECIFIED

TITLE:
FISCHER DELUXE "RF-100" X-RAY UNIT
FLUOROSCOPIC BUMPER SUPP.

H. G. FISCHER & CO.
2335 WABANSIA AVE.
CHICAGO, ILL.

CAT. NO.

PART NO. 17412

TITLE
FISCHER DELUXE "RF-100" X-RAY SCREEN FORK SUPPORT SHAFT CAP

H. G. FISCHER & CO.
FRANKLIN PARK, ILLINOIS

PART NO. 17414

DATE 2-24-50 | DR. BY J.V.W. | CH'K'D.

REVISION	DATE	BY

PATTERN | FINISH CAD. #23 | SCALE FULL

TOOLS: DRILL JIG. #11291

MATERIAL: 1 1/4" DIA. C.R. STEEL

DIMENSIONS UNLESS OTHERWISE SPECIFIED
FRACTIONAL ± .015
DECIMAL ± .003
ANGULAR ± ½°

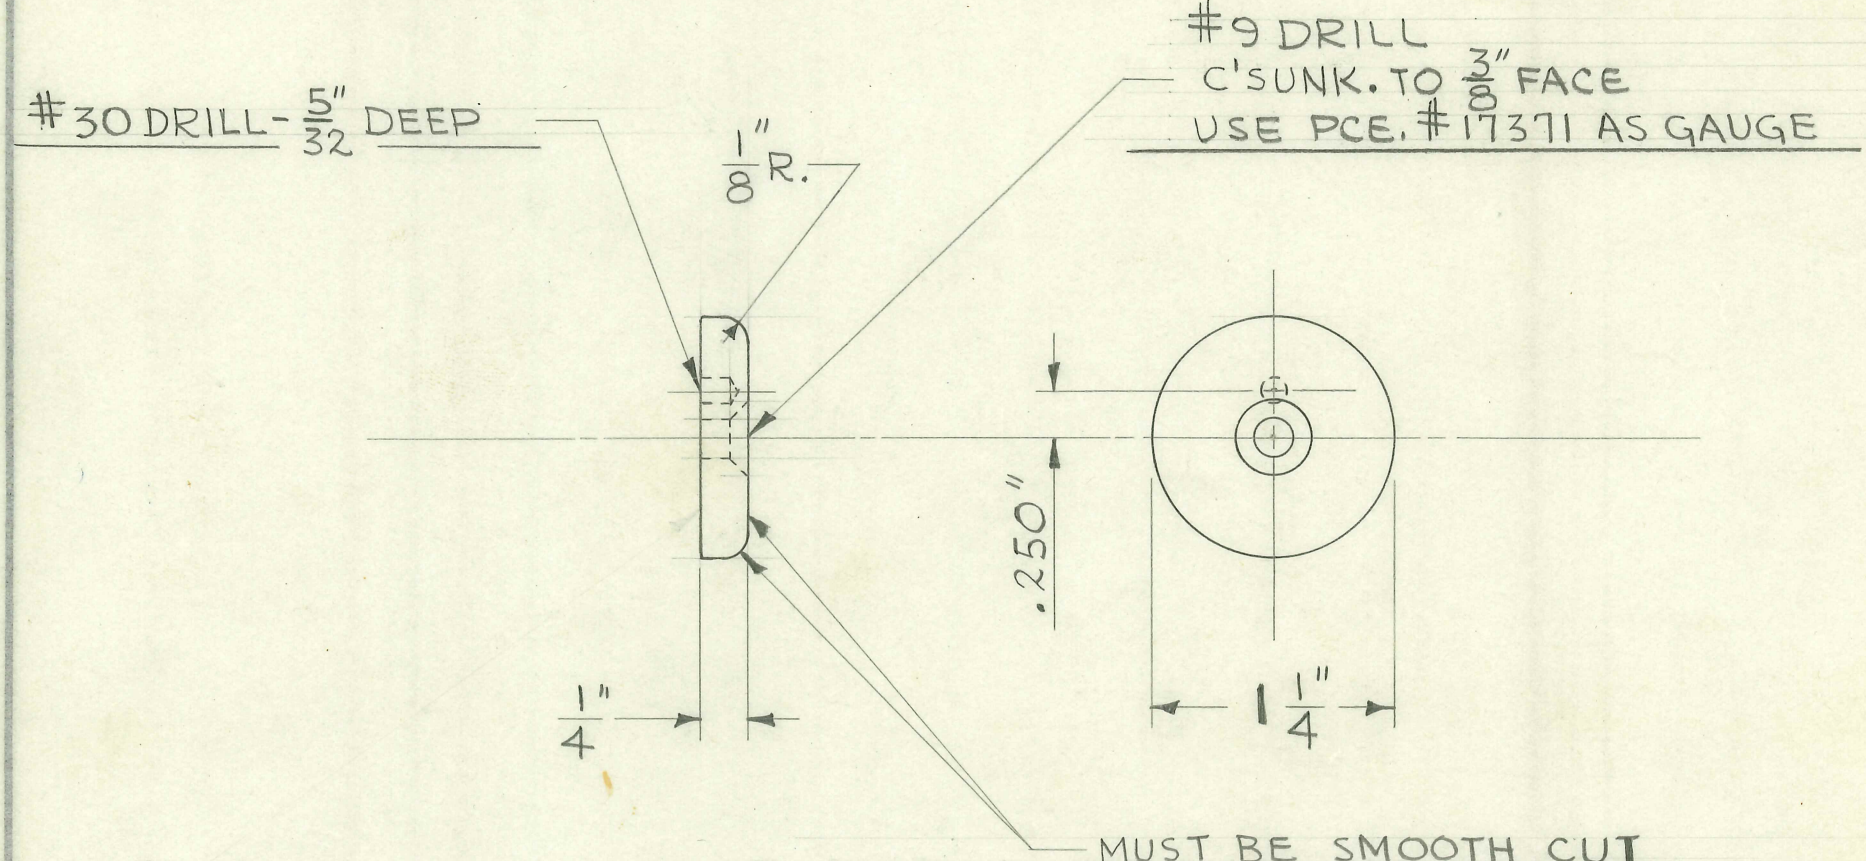

1 REQUIRED

FOLDER #127

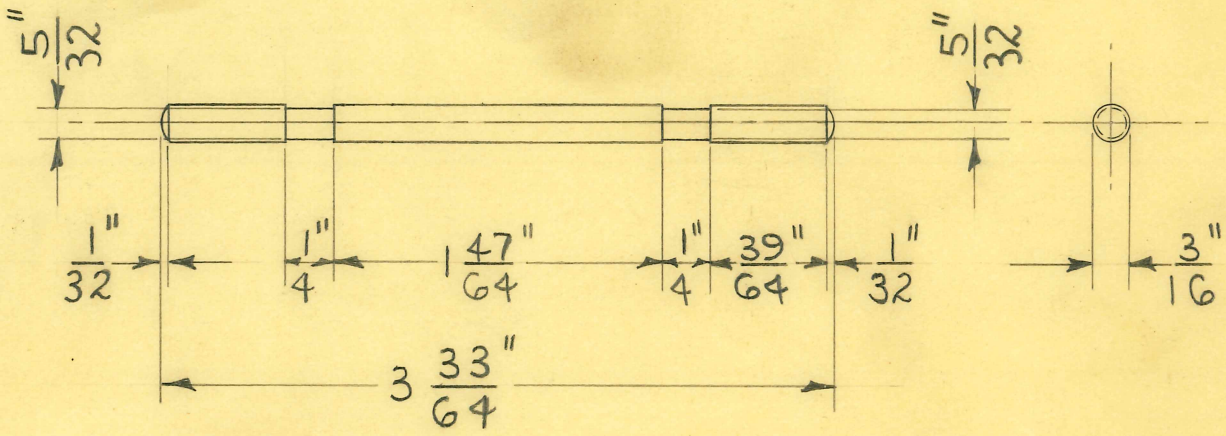

1 REQUIRED

DIMENSIONS	
FRACTIONAL	± .015
DECIMAL	± .005
ANGULAR	± 1/2°

UNLESS OTHERWISE SPECIFIED

SIZE	3/16" DIA.	ISSUE 5-6-48	W.J.
KIND	C.R. STEEL	CHANGED	
SHAPE	ROD	"	
FINISH	CAD. #23	"	
TEMP.		"	
PATT.		"	

TITLE:

FISCHER "DELUXE RF-100" X-RAY UNIT

TUBE HEAD INTERLOCKING LEVER ROD

H. G. FISCHER & CO.
2335 WABANSIA AVE.
CHICAGO, ILL.

CAT. NO.

PART NO. 17415

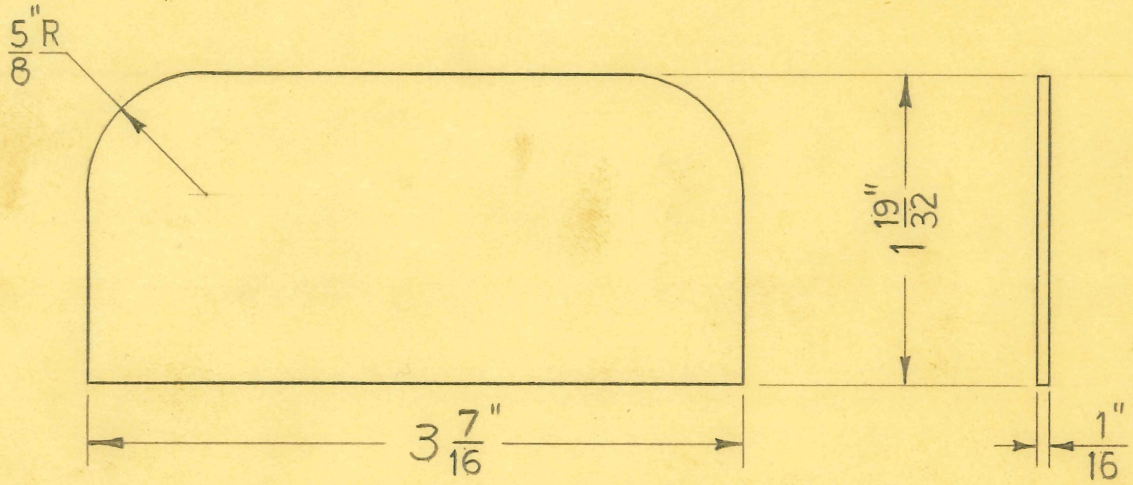

1- REQUIRED

5/8" CORNER DIE # 11687

DIMENSIONS	
FRACTIONAL	± .015
DECIMAL	± .005
ANGULAR	± 1/2°

UNLESS OTHERWISE SPECIFIED

SIZE	1/16" SHEET	ISSUE 4-27-48	J.B.G.
KIND	C.R. STEEL	CHANGED	
SHAPE		"	
FINISH		"	
TEMP.		"	
PATT.		"	

TITLE:

FISCHER "DELUXE RF-100" TRANSF. COVER CABLE OPENING PLATE BLANK

H. G. FISCHER & CO.
2335 WABANSIA AVE.
CHICAGO, ILL.

CAT. NO.

PART NO. 17418

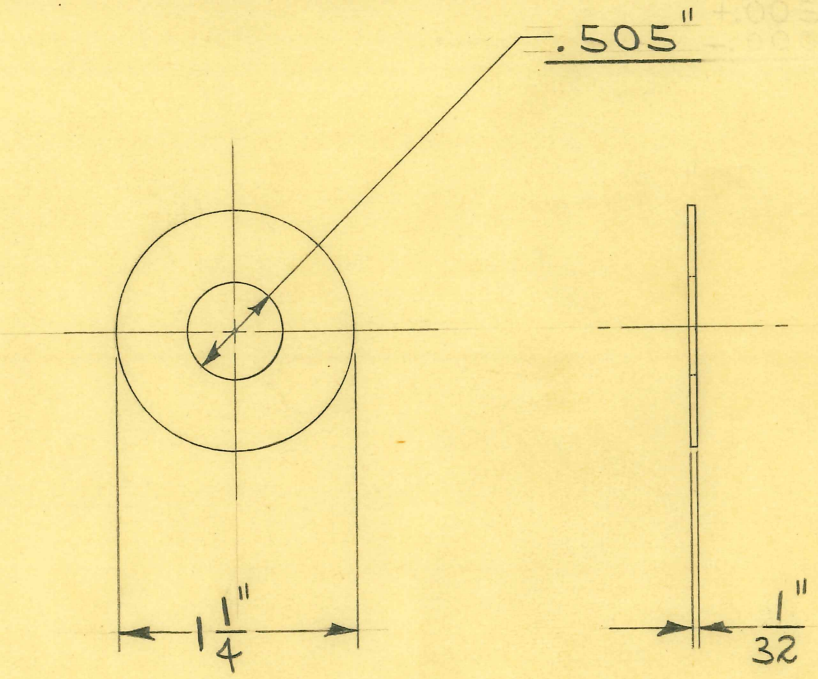

2 REQUIRED

BLANKING DIE TOOL 6799-Y4
PIERCING PUNCH TOOL 9750

DIMENSIONS	
FRACTIONAL	± .015
DECIMAL	± .005
ANGULAR	± 1/2°

UNLESS OTHERWISE SPECIFIED

SIZE	1/32" SHEET	ISSUE 3-31-48	W.J.
KIND	FIBER	CHANGED	
SHAPE		"	
FINISH		"	
TEMP.		"	
PATT.		"	

TITLE:
FISCHER DELUXE RF-100 X-RAY UNIT
SCREEN PIVOT ROCKER ARM WASHER

H. G. FISCHER & CO.
2335 WABANSIA AVE.
CHICAGO, ILL.

CAT. NO.

PART NO. 17419

TITLE

FISCHER MODIFIED TILT TABLE
BUCKY C'W'T. CHAIN ASSEM.- UPPER

H. G. FISCHER & CO.
FRANKLIN PARK, ILLINOIS

DATE 9-20-48 | DR. BY J. B. G. | CH'K'D. J.W.

PART NO. 17421G

REVISION	DATE	BY

PATTERN	FINISH	SCALE
	CAD.#23	FULL

TOOLS

MATERIAL

DIMENSIONS
FRACTIONAL ± .015
DECIMAL ± .005
ANGULAR ± ½°
UNLESS OTHERWISE SPECIFIED

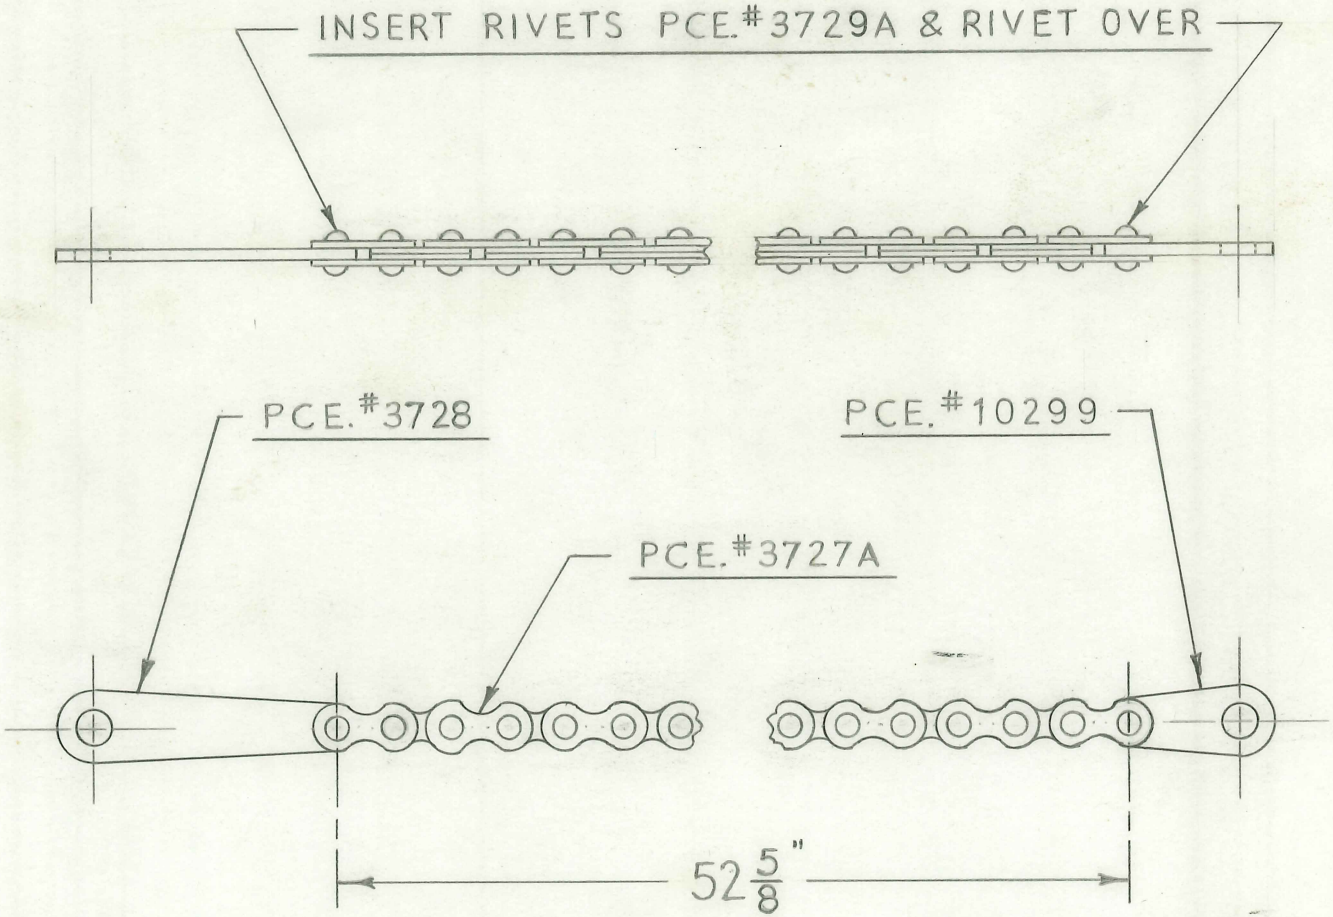

1-REQUIRED

FOLDER #127

CUT OFF TOP OF HEAD TO DIMENSION SHOWN

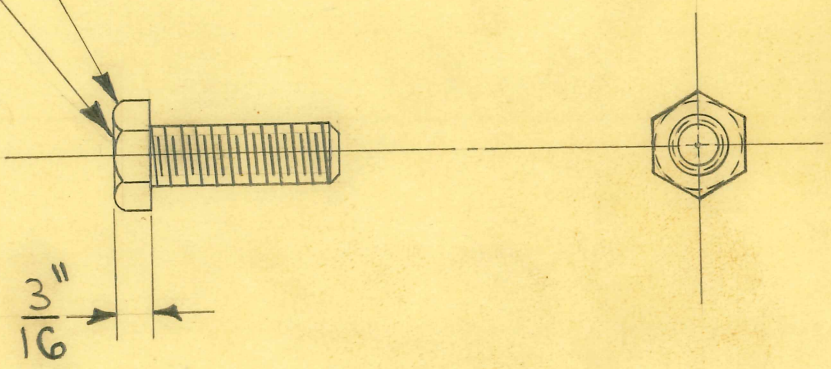

4 REQUIRED

DIMENSIONS	
FRACTIONAL	± .015
DECIMAL	± .005
ANGULAR	± 1/2°

UNLESS OTHERWISE SPECIFIED

SIZE	5/16"X24X1"	ISSUE 4-23-48	W.J.
KIND	HEX. CAP	CHANGED	
SHAPE	SCREW	"	
FINISH	CAD. #23	"	
TEMP.		"	
PATT.		"	

TITLE:

FISCHER DELUXE RF-100 X-RAY UNIT

FLUOROSCOPIC SLIDE BEARING SCREW

H. G. FISCHER & CO.
2335 WABANSIA AVE.
CHICAGO, ILL.

CAT. NO.

PART NO. 17426

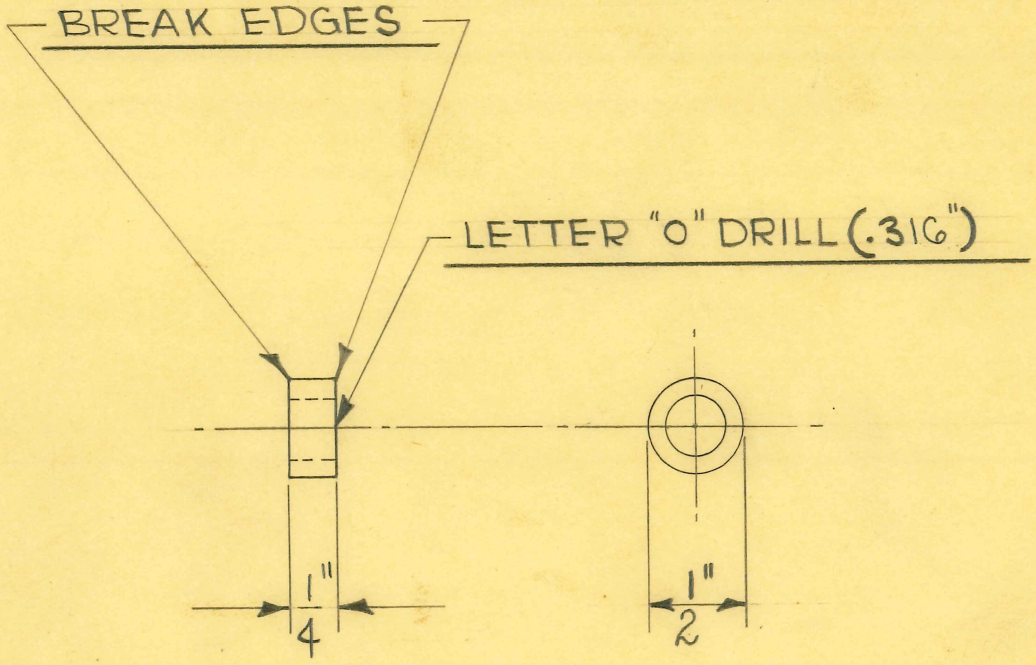

2 REQUIRED

DIMENSIONS	
FRACTIONAL	± .015
DECIMAL	± .005
ANGULAR	± 1/2°

UNLESS OTHERWISE SPECIFIED

SIZE	1/2" DIA.	ISSUE 4-26-48	W.J.
KIND	C.R. STEEL	CHANGED	
SHAPE	ROD	"	
FINISH	CAD. #23	"	
TEMP.		"	
PATT.		"	

TITLE:
FISCHER DELUXE RF-100 X-RAY UNIT
FLUOROSCOPIC SLIDE BEARING SPACER

H. G. FISCHER & CO.
2335 WABANSIA AVE.
CHICAGO, ILL.

CAT. NO.

PART NO. 17427

FORM FIXTURE TOOL # 9707
DRILL JIG TOOL # 9708

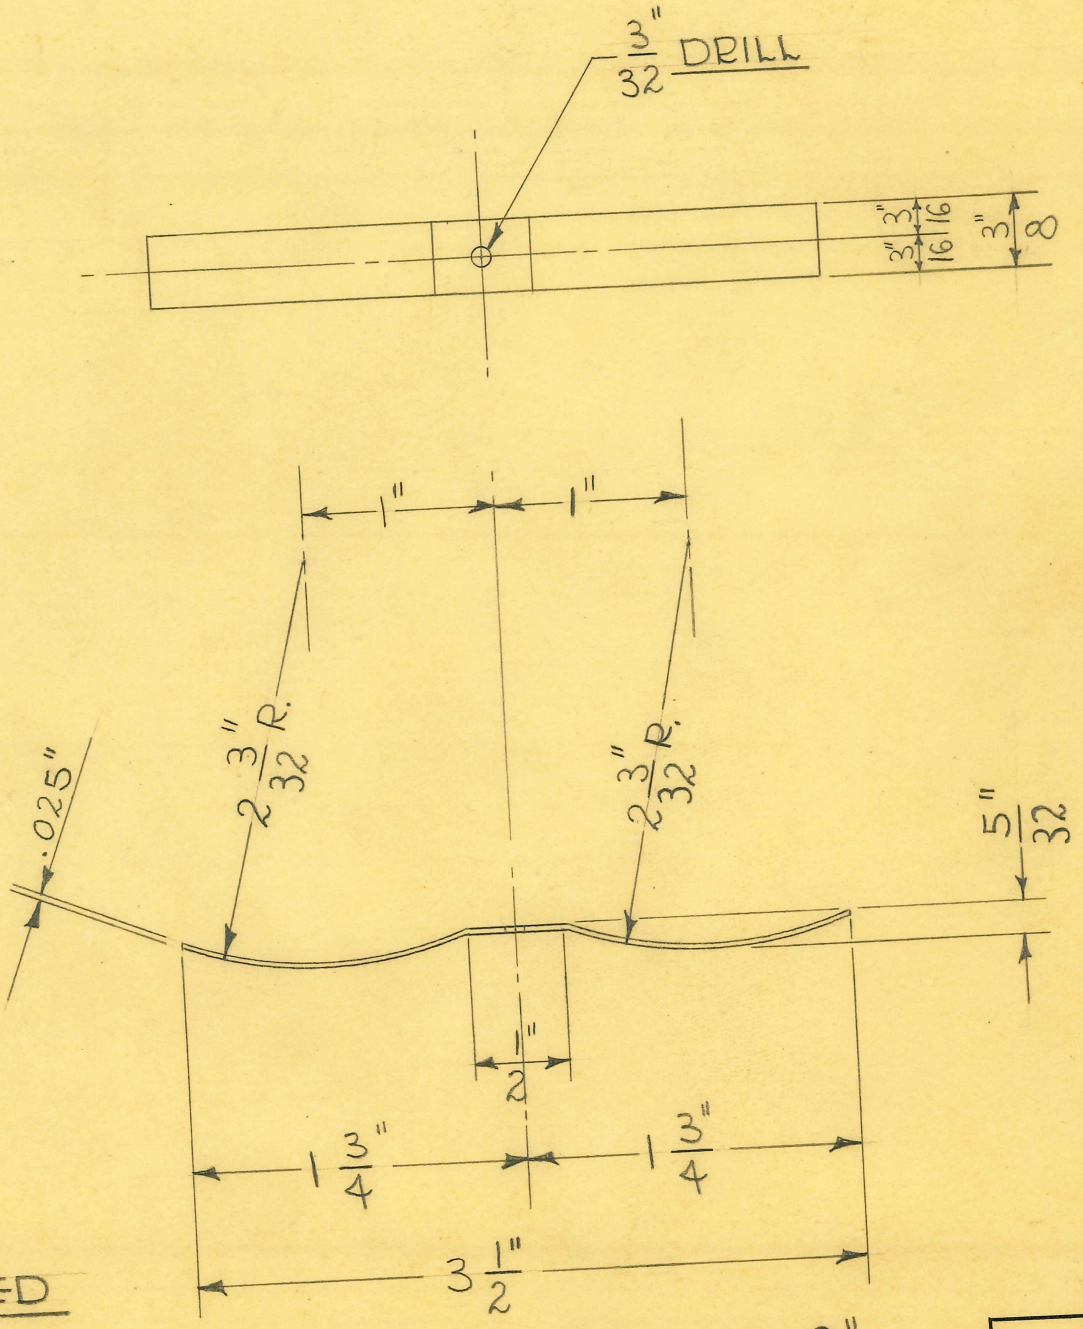

1 REQUIRED

LENGTH OF DEVELOPMENT 3 9/16"

DIMENSIONS	
FRACTIONAL	± .015
DECIMAL	± .005
ANGULAR	± 1/2°

UNLESS OTHERWISE SPECIFIED

SIZE	.025" X 3/8"	ISSUE 2-13-48	W.J.
KIND	PHOS. BRONZE	CHANGED	
SHAPE	SHEARED	"	
FINISH		"	
TEMP.		"	
PATT.		"	

TITLE: FISCHER IMMOBILIZING & COMPRESSION FRICTION SPRING

H. G. FISCHER & CO.
2335 WABANSIA AVE.
CHICAGO, ILL.

CAT. NO.

PART NO. 17431

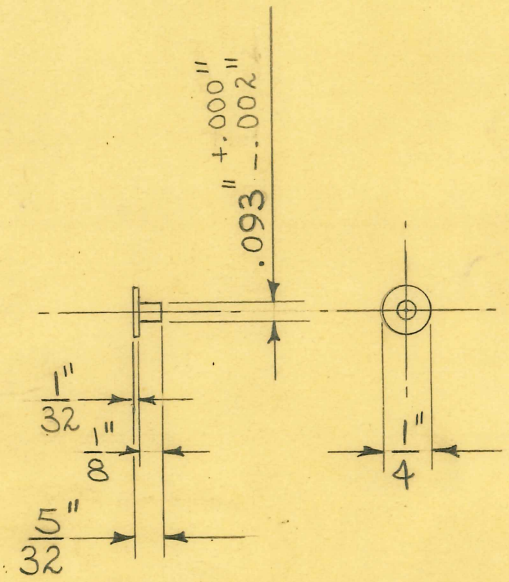

1 REQUIRED

DIMENSIONS	
FRACTIONAL	± .015
DECIMAL	± .005
ANGULAR	± 1/2°

UNLESS OTHERWISE SPECIFIED

SIZE	1/4" DIA.	ISSUE 2-11-48	W.J.
KIND	ALUM.	CHANGED	
SHAPE	ROD	"	
FINISH		"	
TEMP.		"	
PATT.		"	

TITLE: FISCHER IMMOBILIZING & COMPRESSION FRICTION SPRING RIVET

H. G. FISCHER & CO.
2335 WABANSIA AVE.
CHICAGO, ILL.

CAT. NO.

PART NO. 17432

DRILL JIG TOOL #6241

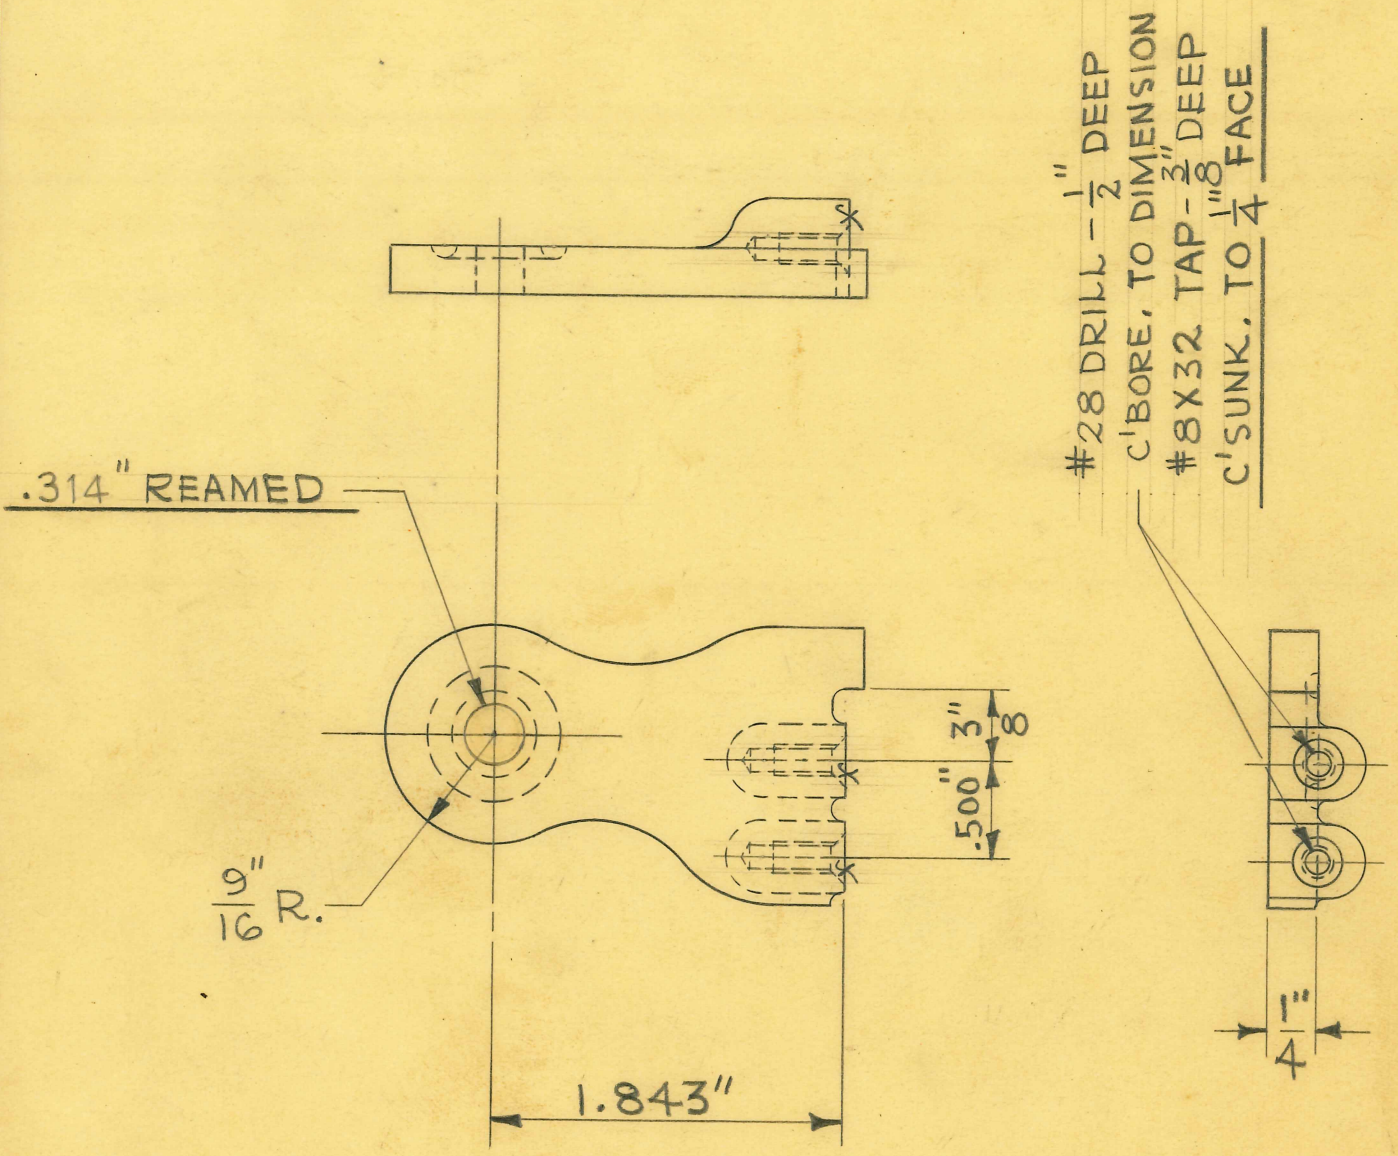

1-REQUIRED

DIMENSIONS	
FRACTIONAL	± .015
DECIMAL	± .005
ANGULAR	± 1/2°

UNLESS OTHERWISE SPECIFIED

SIZE	#12	ISSUE 2-17-48	J.V.W.
KIND	ALUM.	CHANGED	
SHAPE	CASTING	"	
FINISH	PAINTED	"	
TEMP.		"	
PATT.	2323	"	

TITLE: FISCHER DELUXE "RF-100" IMMOBILIZING & COMP. ATTACH. BRACKET-RIGHT

H. G. FISCHER & CO.
2335 WABANSIA AVE.
CHICAGO, ILL.

CAT. NO.

PART NO. 17434F

DRILL JIG TOOL #6241

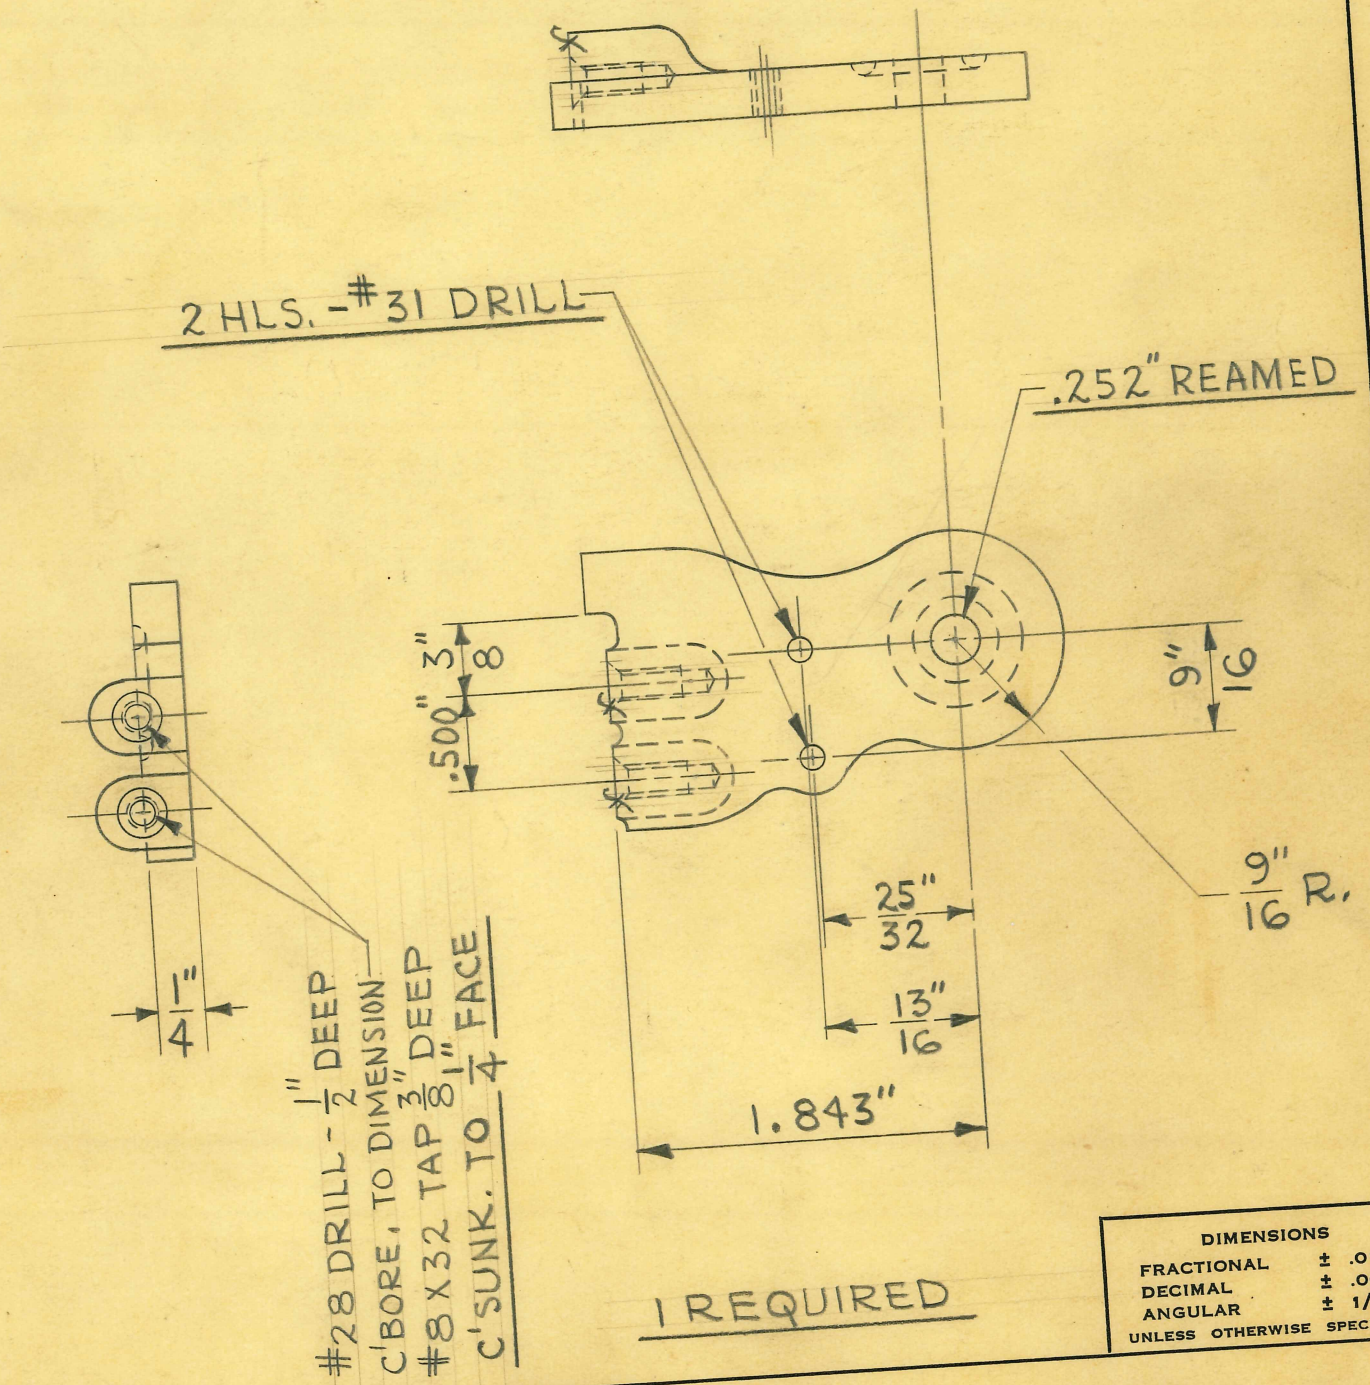

1 REQUIRED

DIMENSIONS	
FRACTIONAL	± .015
DECIMAL	± .005
ANGULAR	± 1/2°

UNLESS OTHERWISE SPECIFI

SIZE	#12	ISSUE 2-16-48	J.V.W.
KIND	ALUM.	CHANGED	
SHAPE	CASTING	"	
FINISH	PAINTED	"	
TEMP.		"	
	2324	"	

TITLE: FISCHER DELUXE "RF-100" IMM. & COMP. ATTACHMENT BRACKET - LEFT

H. G. FISCHER & CO.
2335 WABANSIA AVE.
CHICAGO, ILL.

CAT. NO.

PART NO. 174351

TITLE

FISCHER DELUXE RF-250 X-RAY HAND SWITCH TERMINAL BOARD

H. G. FISCHER & CO.
FRANKLIN PARK, ILLINOIS

PART NO. 17436

DATE 3-22-50 | DR. BY W. J. | CH'K'D. J.V.W.

REVISION	DATE	BY

PATTERN | FINISH | SCALE FULL

DIMENSIONS
FRACTIONAL ± .015
DECIMAL ± .005
ANGULAR ± ½°
UNLESS OTHERWISE SPECIFIED

TOOLS: DRILL JIG # 11307

MATERIAL: ¼" SHEET BLACK BAKELITE

1 REQUIRED

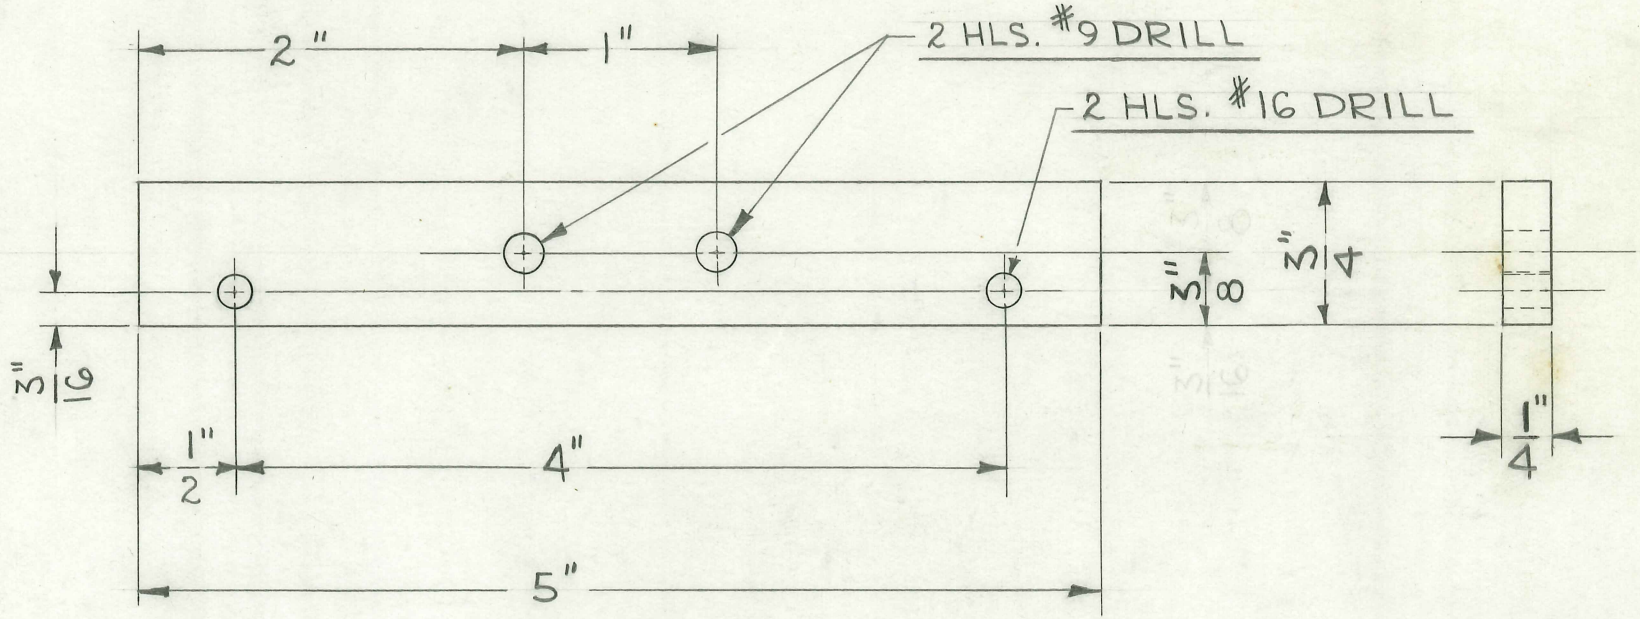

FOLDER #138

TITLE
FISCHER DELUXE "RF-250" X-RAY
RESISTOR SPACER - CENTER

H. G. FISCHER & CO.
FRANKLIN PARK, ILLINOIS

PART NO. 17443

DATE 11-5-48 | DR. BY W.J. | CH'K'D. J.V.W.

REVISION	DATE	BY

PATTERN | FINISH | SCALE FULL

TOOLS

MATERIAL
5/8" DIA. NATURAL BAKELITE ROD

DIMENSIONS
FRACTIONAL ± .015
DECIMAL ± .005
ANGULAR ± ½°
UNLESS OTHERWISE SPECIFIED

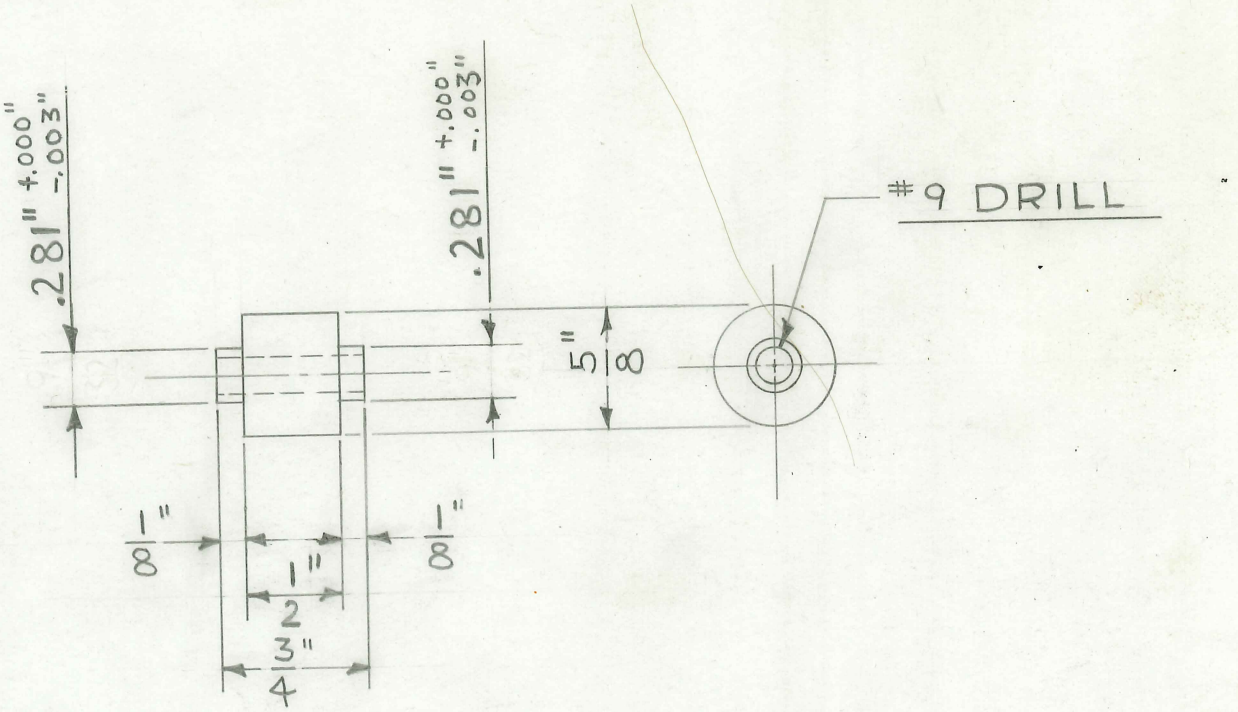

6 REQUIRED

FOLDER #138

TITLE			PART NO.
FISCHER DELUXE RF-250" X-RAY RESISTOR CLAMPING ROD	H. G. FISCHER & CO. FRANKLIN PARK, ILLINOIS		17444
	DATE 11-5-48	DR. BY W. J.	CH'K'D. J.V.W.

REVISION	DATE	BY

PATTERN	FINISH	SCALE
	CAD. #23	FULL

TOOLS	MATERIAL
	3/16 DIA. C.R. STEEL

DIMENSIONS
FRACTIONAL ± .015
DECIMAL ± .005
ANGULAR ± ½°
UNLESS OTHERWISE SPECIFIED

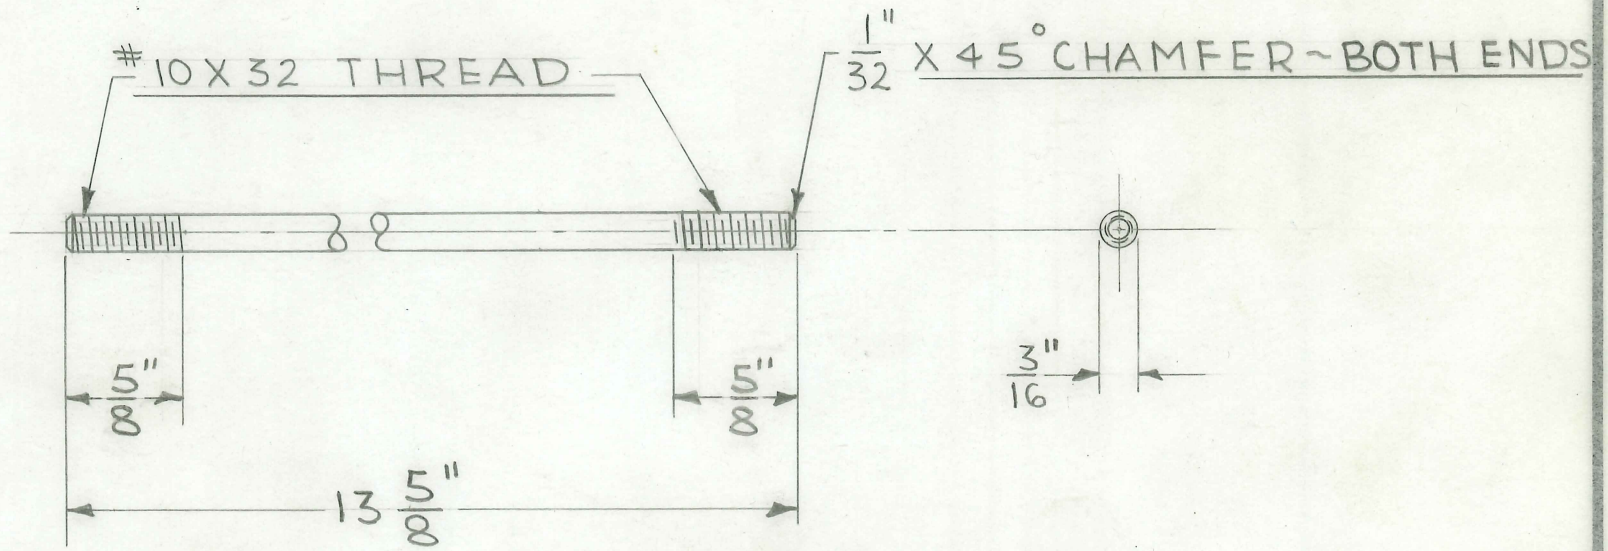

6 REQUIRED

FOLDER #138

TITLE

FISCHER DELUXE RF-100 X-RAY

FLUO. TILT TABLE BUCKY CWT. BEARING CLAMPING ROD

H. G. FISCHER & CO.
FRANKLIN PARK, ILLINOIS

DATE 2-28-49 | DR. BY W.J. | CH'K'D. J.V.W.

PART NO. 17456

REVISION	DATE	BY

PATTERN | FINISH | SCALE FULL

TOOLS | MATERIAL 1/4" DIA. C.R. STEEL ROD

DIMENSIONS
FRACTIONAL ± .015
DECIMAL ± .005
ANGULAR ± ½°
UNLESS OTHERWISE SPECIFIED

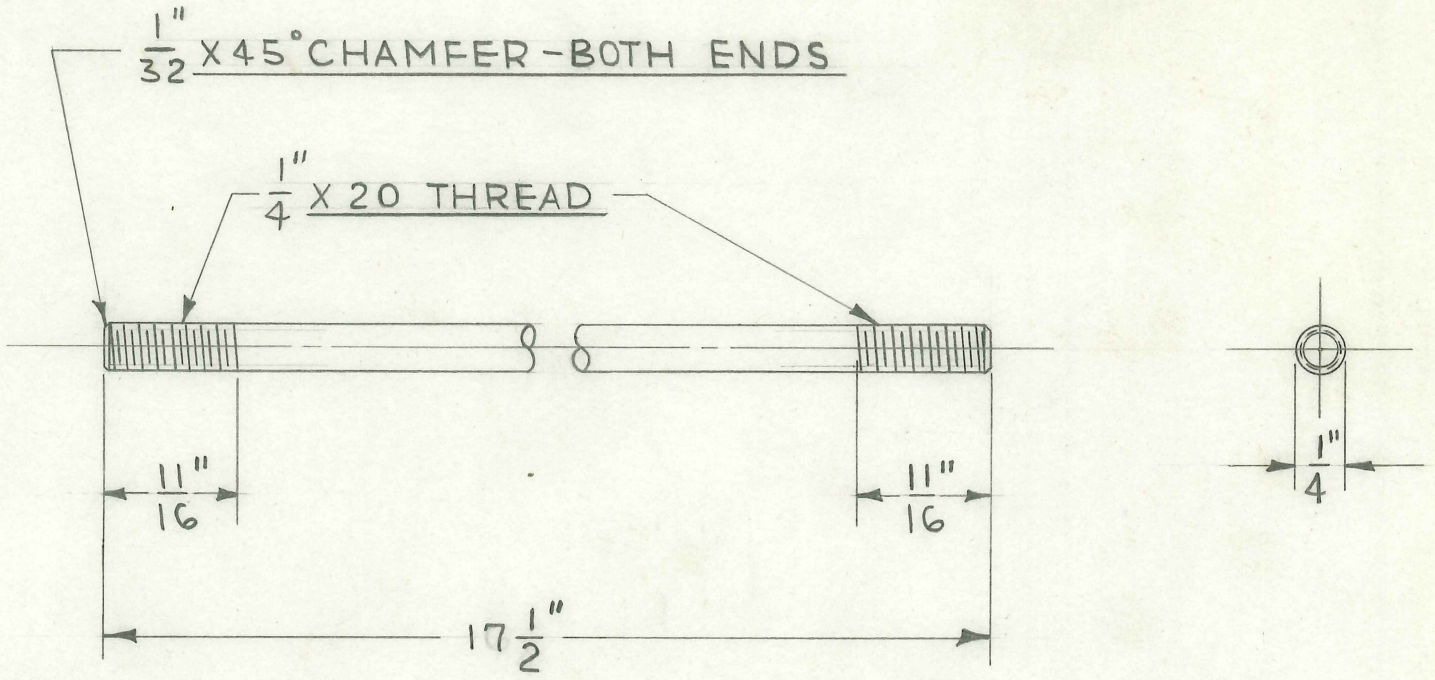

1 REQUIRED

FOLDER #127

TITLE

FISCHER DELUXE RF-100 X-RAY UPPER FLUO. TILT TABLE BUCKY CWT. CHAIN ASSEM.-

H. G. FISCHER & CO.
FRANKLIN PARK, ILLINOIS

DATE 3-2-49 | DR. BY W.J. | CH'K'D. J.V.W.

PART NO. 17459GA

PATTERN | FINISH CAD. # 23 | SCALE FULL

TOOLS | MATERIAL

DIMENSIONS
FRACTIONAL ± .015
DECIMAL ± .005
ANGULAR ± ½°
UNLESS OTHERWISE SPECIFIED

REVISION		DATE	BY
A	WAS 52 1/4"	3-7-51	J.V.W.

1 REQUIRED

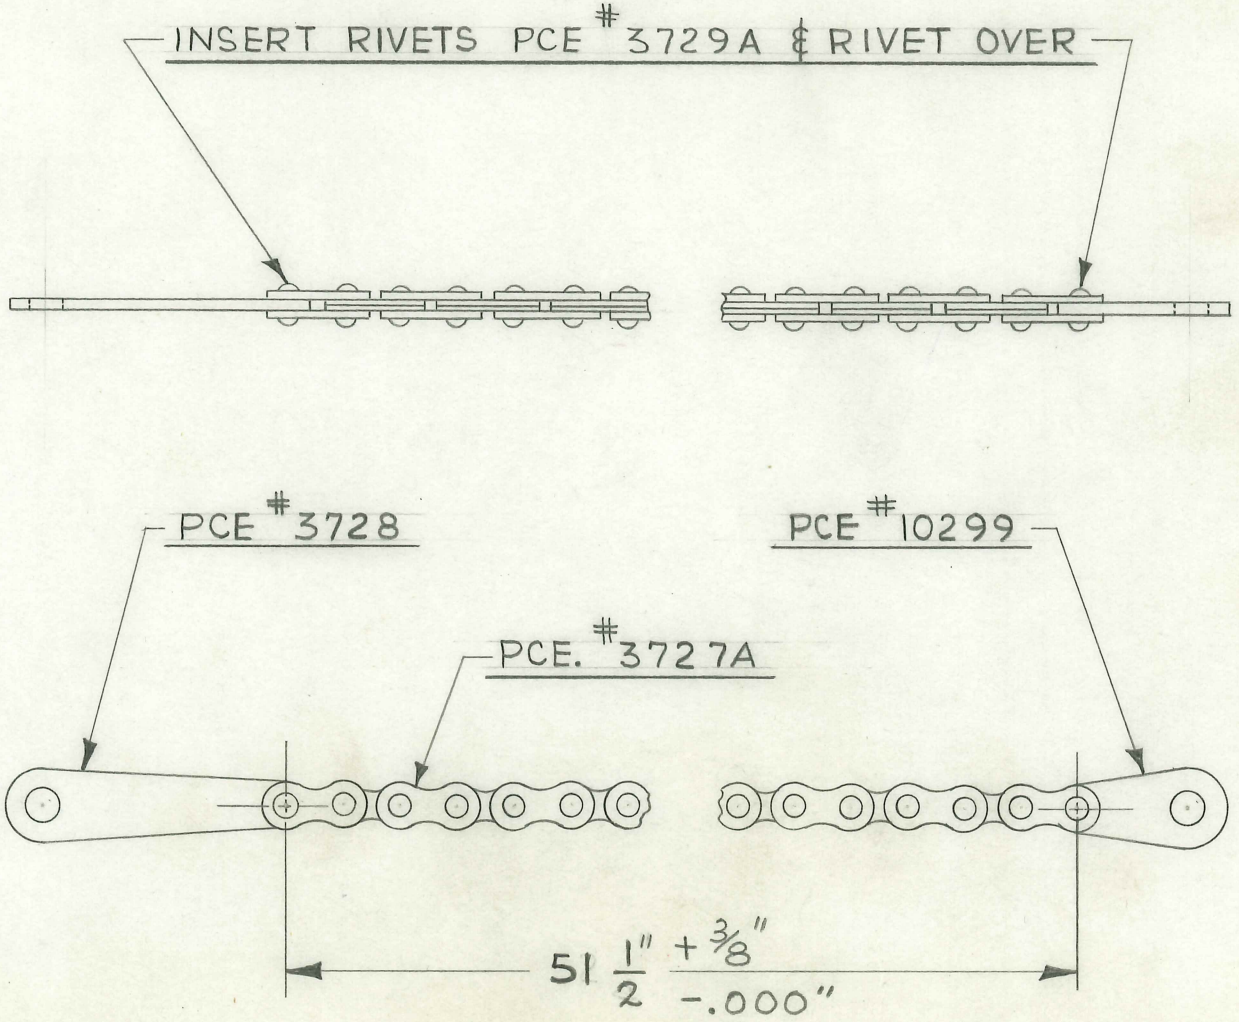

FOLDER #127

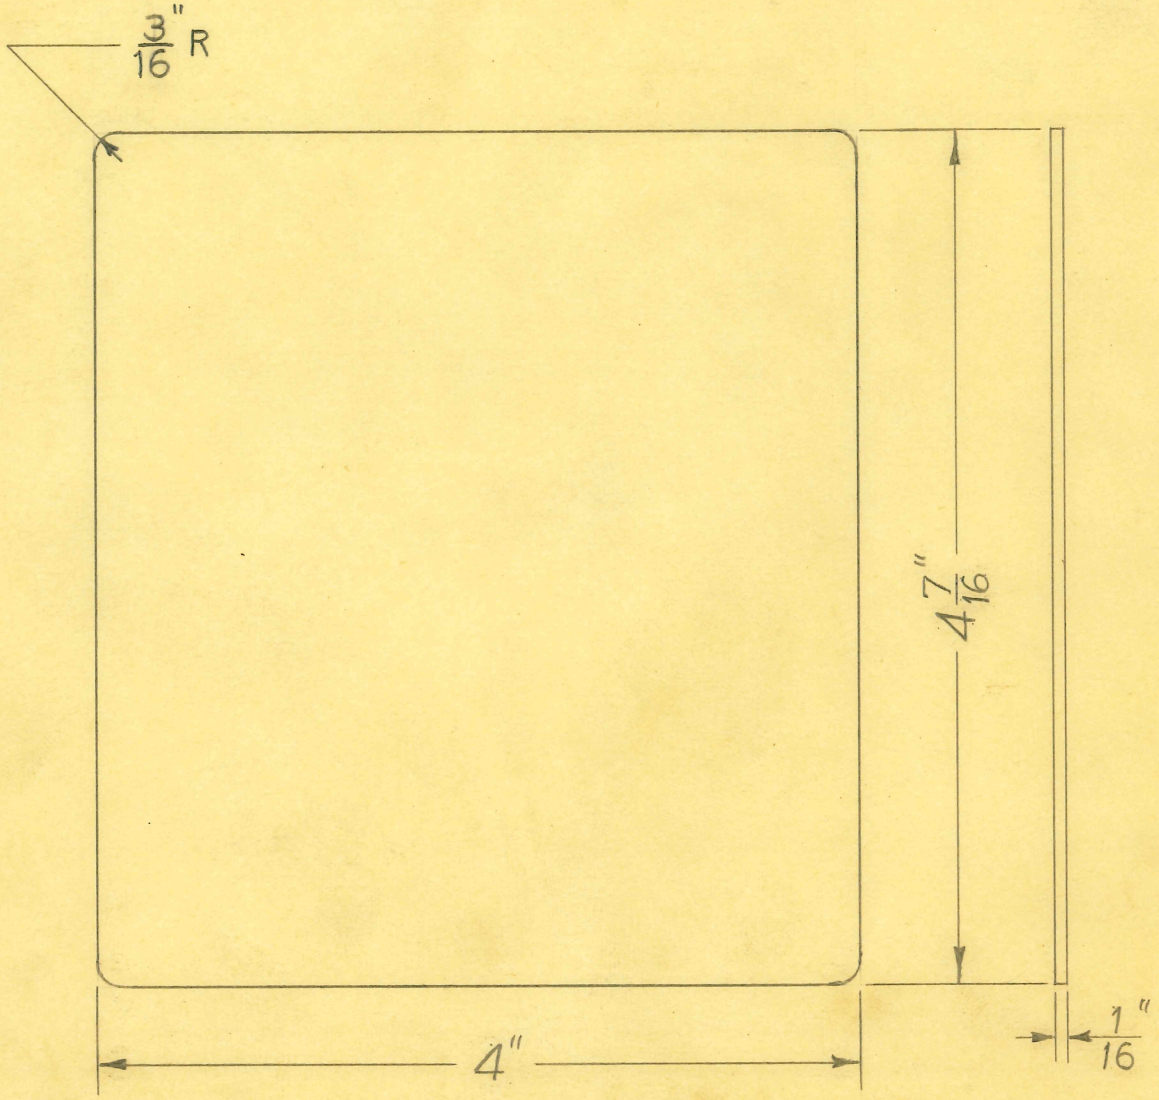

DIMENSIONS	
FRACTIONAL	± .015
DECIMAL	± .005
ANGULAR	± 1/2°

UNLESS OTHERWISE SPECIFIED

SIZE	1/16" SHEET	ISSUE 4-7-48	J.B.G.
KIND	C.R. STEEL	CHANGED	
SHAPE		"	
FINISH		"	
TEMP.		"	
PATT.		"	

TITLE: FISCHER "L-200" & "RF-100" X-RAY UNIT
TUBE ADAPTER RETAINER PLATE BLANK

H. G. FISCHER & CO.
2335 WABANSIA AVE.
CHICAGO, ILL.

CAT. NO.

PART NO. 17483

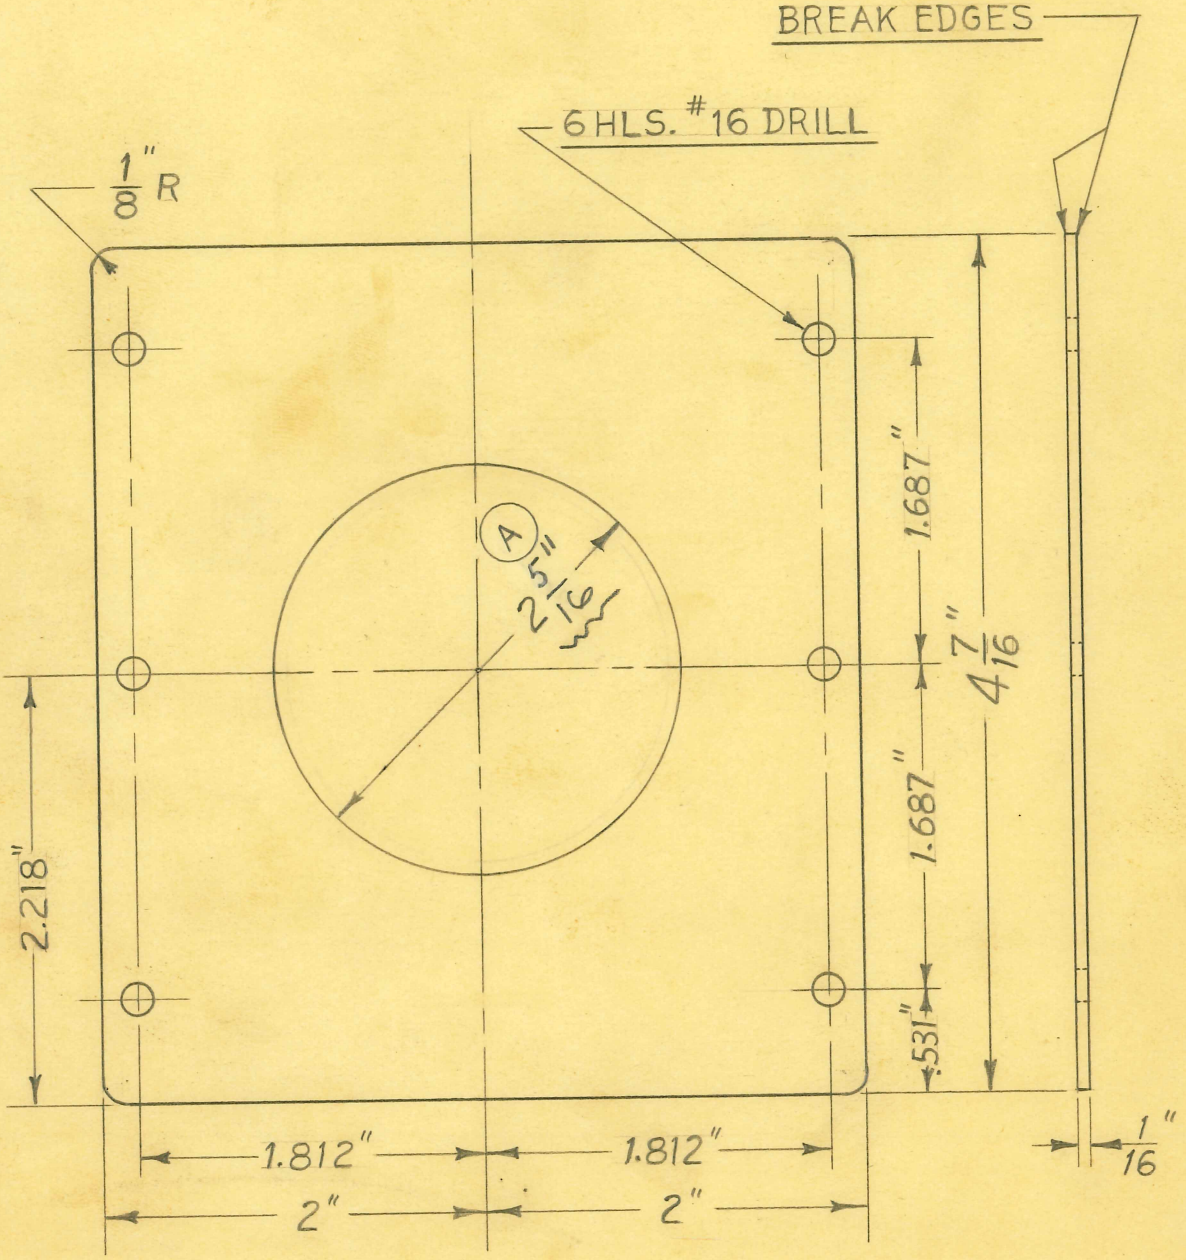

DRILL JIG TOOL # 9779
PIERCING DIE TOOL # 9772 - PUNCH # 1841

1 - REQUIRED

DIMENSIONS	
FRACTIONAL	± .015
DECIMAL	± .005
ANGULAR	± 1/2°

UNLESS OTHERWISE SPECIFIED

SIZE	FROM	ISSUE 4-1-48	J.B.G.
KIND	17483	CHANGED	
SHAPE		Ⓐ WAS 2 1/8"	W.J. 7-5-55
FINISH	#23 CAD.	"	
TEMP.		"	
PATT.		"	

TITLE: FISCHER "L-200" & "RF-100" X-RAY UNIT
TUBE ADAPTER RETAINER PLATE

H. G. FISCHER & CO.
2338 WABANSIA AVE.
CHICAGO, ILL.

CAT. NO.

PART NO. 17483FA

TITLE FISCHER "L-200" & "RF-100" X-RAY UNIT
TUBE ADAPTER BLOCKER SLIDE

H. G. FISCHER & CO.
FRANKLIN PARK, ILLINOIS

DATE 7-1-55 | DR BY W. J. | CH'K'D.

PART NO. 17484 B

REVISION	DATE	BY
A WAS C'SUNK TO 11/32" FACE	12-9-55	C.K.

PATTERN | FINISH CAD. #23 | SCALE FULL

TOOLS DRILL JIG #9778
2 5/16" PIERCING DIE #9772 WITH PUNCH PCE. #17484B

MATERIAL 1" 1/8 X 1 1/8 BRASS BAR

DIMENSIONS UNLESS OTHERWISE SPECIFIED
FRACTIONAL ± .015
DECIMAL ± .005
ANGULAR ± 1/2°

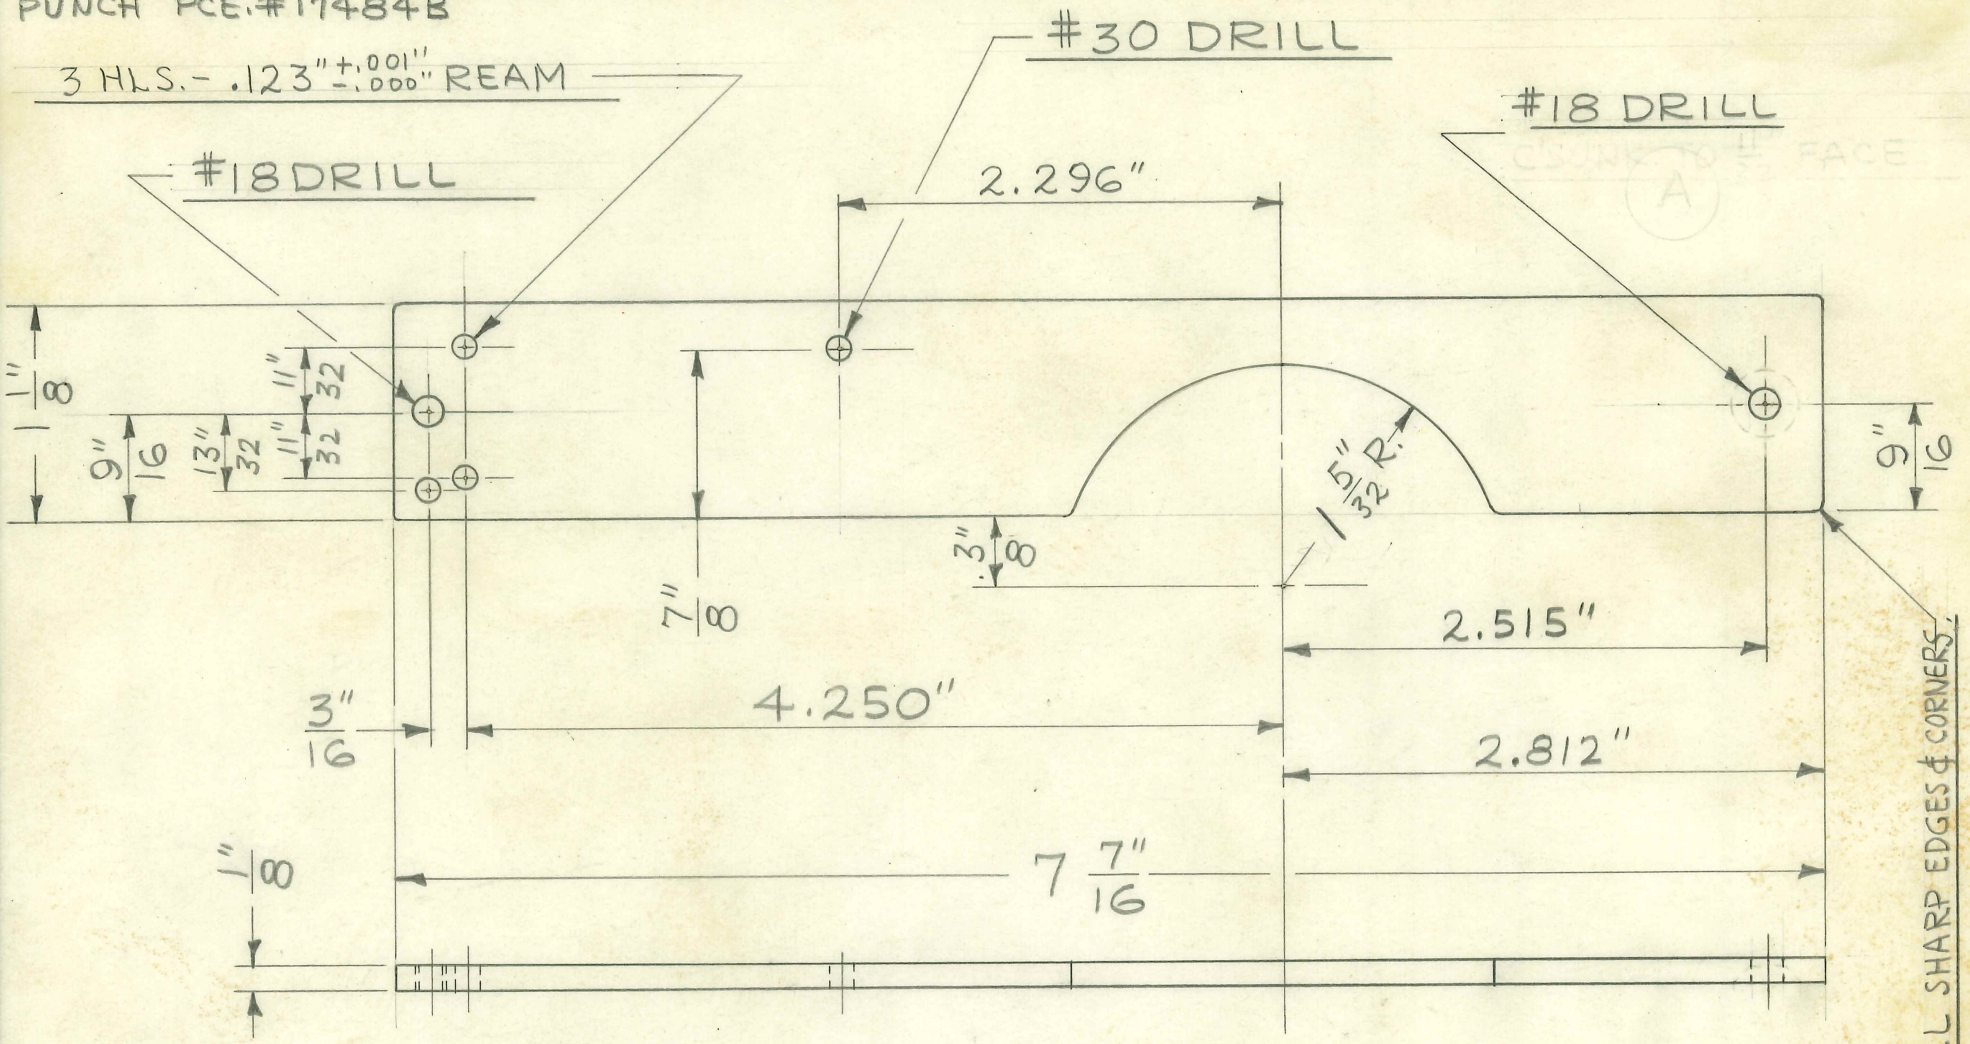

1 REQUIRED

FOLDER #130

REVISION

A- WAS .218 } 1-3-49

B- " 3/8 }

BREAK EDGES VERY LIGHTLY

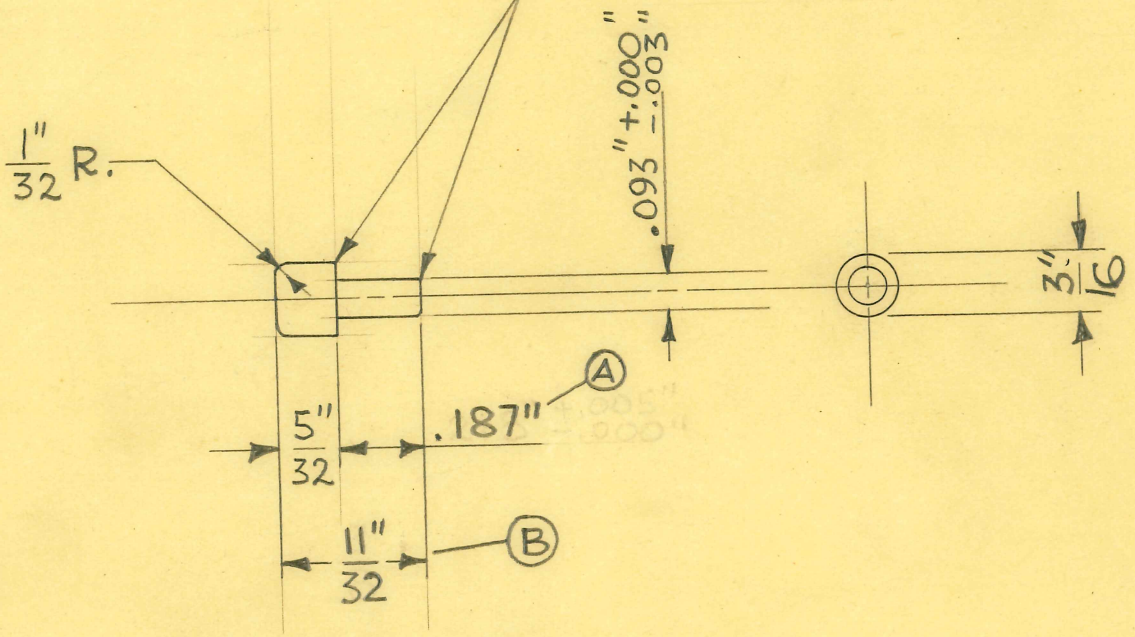

SCALE ~ DOUBLE SIZE

1 REQUIRED

3/16" DIA. TYPE 303 18-8 STAINLESS STEEL ROD

DIMENSIONS	
FRACTIONAL	± .015
DECIMAL	± .005
ANGULAR	± 1/2°

UNLESS OTHERWISE SPECIFIED

SIZE		ISSUE 4-2-48	J.V.W.
KIND		CHANGED	
SHAPE		"	
FINISH		"	
TEMP.		"	
PATT.		"	

TITLE: FISCHER "L-200" & "RF-100" X-RAY FULL SPINE BLOCKER & FILTER-STOP PIN

H. G. FISCHER & CO.
2335 WABANSIA AVE.
CHICAGO, ILL.

CAT. NO.

PART NO. 17485A

CHAMFER CORNERS

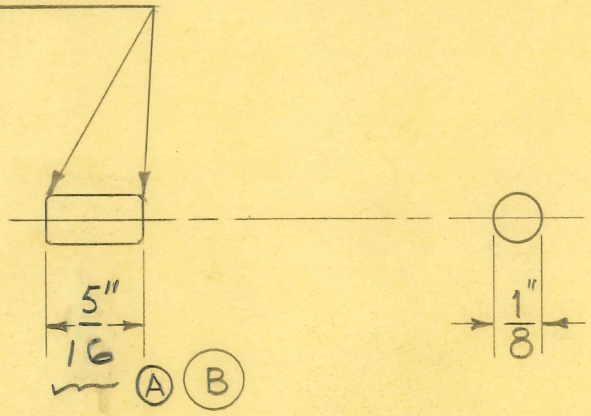

DOUBLE SIZE

2-REQUIRED

DIMENSIONS	
FRACTIONAL	± .015
DECIMAL	± .005
ANGULAR	± 1/2°

UNLESS OTHERWISE SPECIFIED

SIZE	1/8" C.R.	ISSUE 4-5-48	J.B.G.
KIND	STEEL ROD	CHANGED	
SHAPE		(Ⓐ WAS 1/4"	W.J.)
FINISH	#23 CAD.	2-21-50"	
TEMP.		WAS Ⓑ 3/8" 7-5-55	W.J.
PATT.		"	

TITLE:
FISCHER "L-200" & "RF-100" X-RAY UNIT
ADAPTER BLOCKER SLIDE STOP PIN

H. G. FISCHER & CO.
2338 WABANSIA AVE.
CHICAGO, ILL.

CAT. NO.

PART NO. 17486A

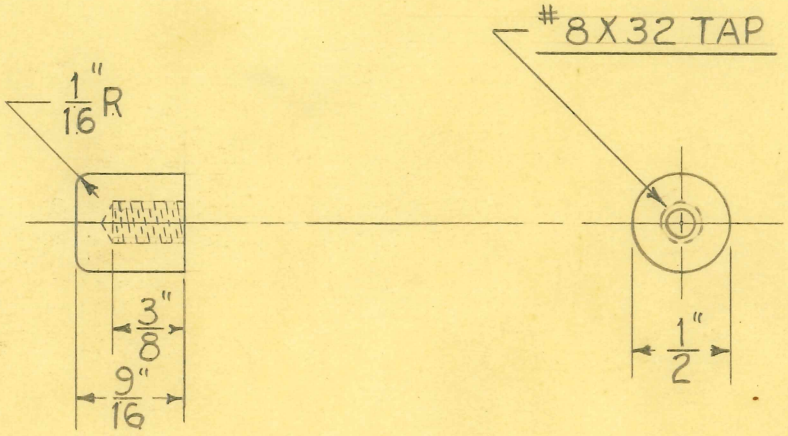

1-REQUIRED

DIMENSIONS	
FRACTIONAL	± .015
DECIMAL	± .005
ANGULAR	± 1/2°

UNLESS OTHERWISE SPECIFIED

SIZE	1/2" BRASS	ISSUE 4-5-48	J.B.G.
KIND	ROD	CHANGED	
SHAPE		"	
FINISH	#23 CAD.	"	
TEMP.		"	
PATT.		"	

TITLE: FISCHER "L-200" & "RF-100" X-RAY UNIT
ADAPTER BLOCKER SLIDE STOP NUT

H. G. FISCHER & CO.
2335 WABANSIA AVE.
CHICAGO, ILL.

CAT. NO.

PART NO. 17487

TITLE

FISCHER DELUXE "RF-250" X-RAY
R.A. X-RAY TUBE – VERTICAL ANGLE PLATE

H. G. FISCHER & CO.
FRANKLIN PARK, ILLINOIS

PART NO. 17510

DATE 1-20-49 | DR. BY J.V.W. | CH'K'D.

REVISION	DATE	BY

PATTERN | FINISH | SCALE FULL

TOOLS | MATERIAL #20 GA.(.032") SHEET ALUMINUM

DIMENSIONS UNLESS OTHERWISE SPECIFIED
FRACTIONAL ± .015
DECIMAL ± .005
ANGULAR ± ½°

BACKGROUND BLACK ANODIZED ALUM. - INDICATIONS - NUMERALS & BORDER - PLAIN ANODIZED ALUMINUM

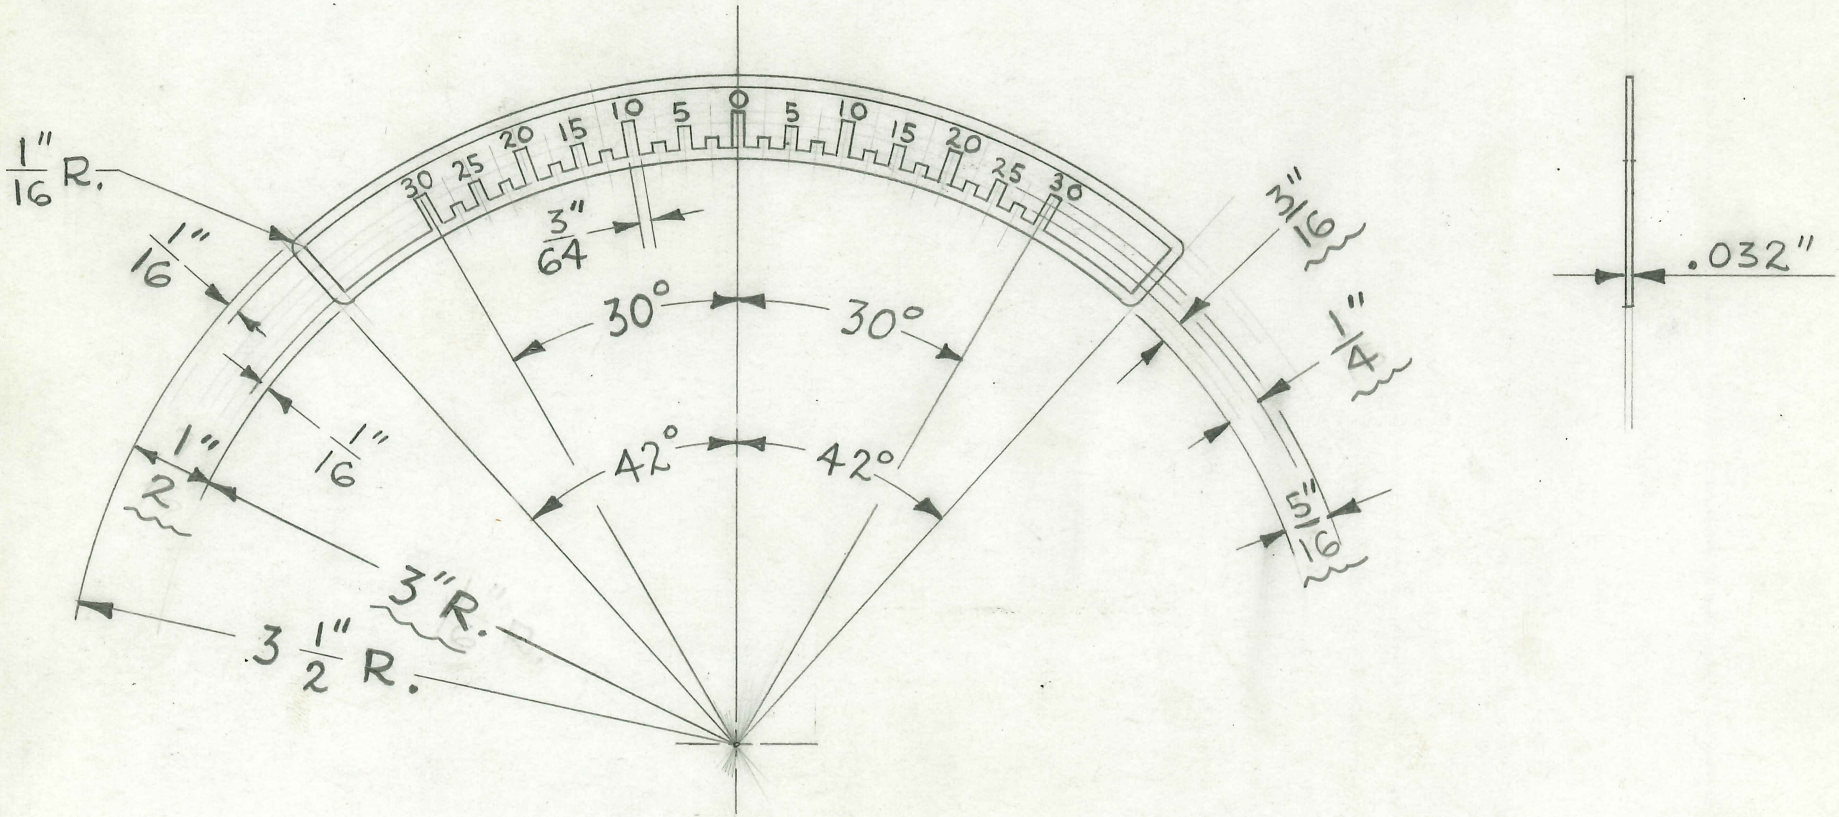

1 REQUIRED

FOLDER # 138

TITLE
FISCHER DELUXE "RF-250" X-RAY
R.A. X-RAY TUBE - VERTICAL ANGLE PLATE

H. G. FISCHER & CO.
FRANKLIN PARK, ILLINOIS

PART NO. 17510F

DATE 1-22-48 | DR. BY J.V.W. | CH'K'D.

REVISION	DATE	BY

PATTERN | FINISH | SCALE FULL

TOOLS PERFORATING DIE #9909
NEST #10046

MATERIAL
FROM #17510

DIMENSIONS
FRACTIONAL ± .015
DECIMAL ± .005
ANGULAR ± ½°
UNLESS OTHERWISE SPECIFIED

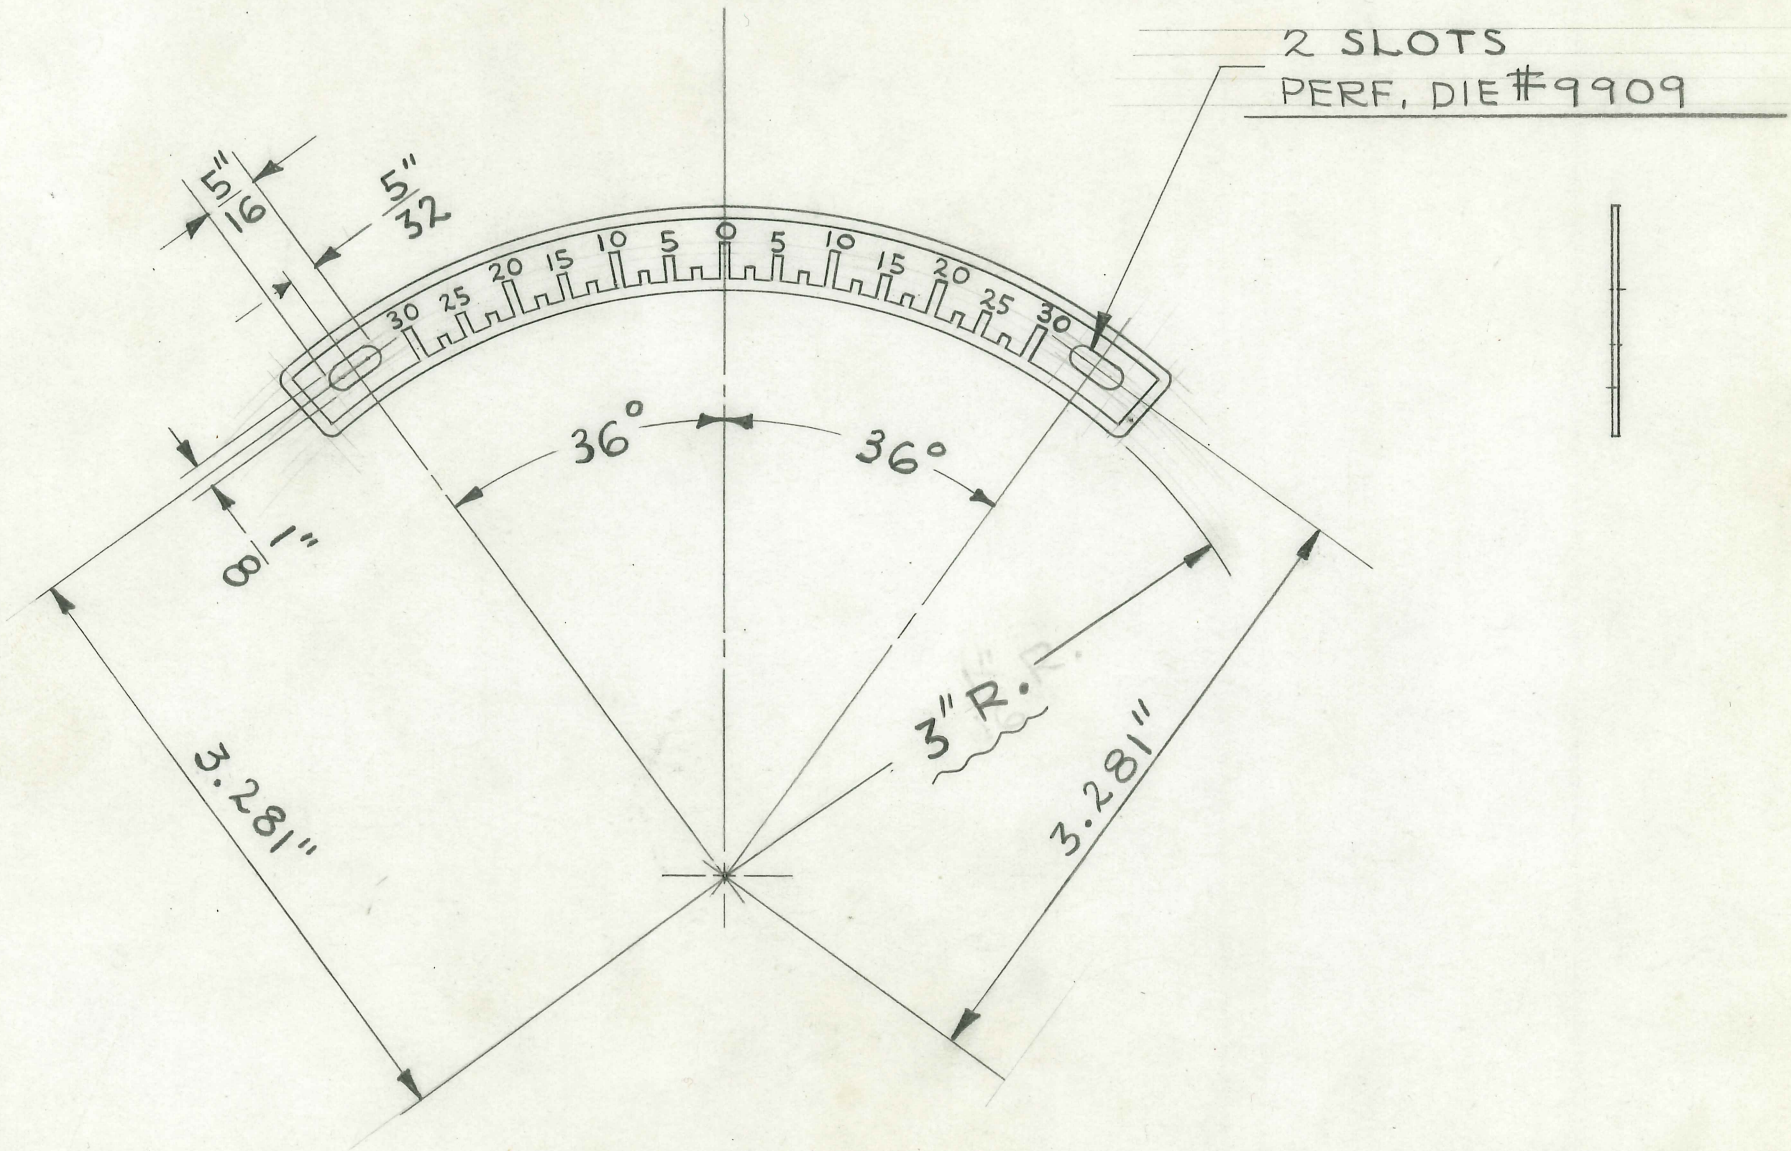

FOLDER #131

TITLE FISCHER DELUXE "RF-250" X-RAY
2 TUBE FLUOR. TILT TABLE
RESISTOR SUPP. BRACKET

H. G. FISCHER & CO.
FRANKLIN PARK, ILLINOIS

PART NO. 17526

DATE 5-3-49 | DR. BY W.J. | CH'K'D. J.V.W.

REVISION	DATE	BY

PATTERN | FINISH CAD. #23 | SCALE FULL

TOOLS: DRILL JIG #9969

MATERIAL: 16 GA.(.060") C.R. SHEET STEEL

DIMENSIONS UNLESS OTHERWISE SPECIFIED
FRACTIONAL ± .015
DECIMAL ± .005
ANGULAR ± ½°

1 REQUIRED

REMOVE ALL SHARP EDGES

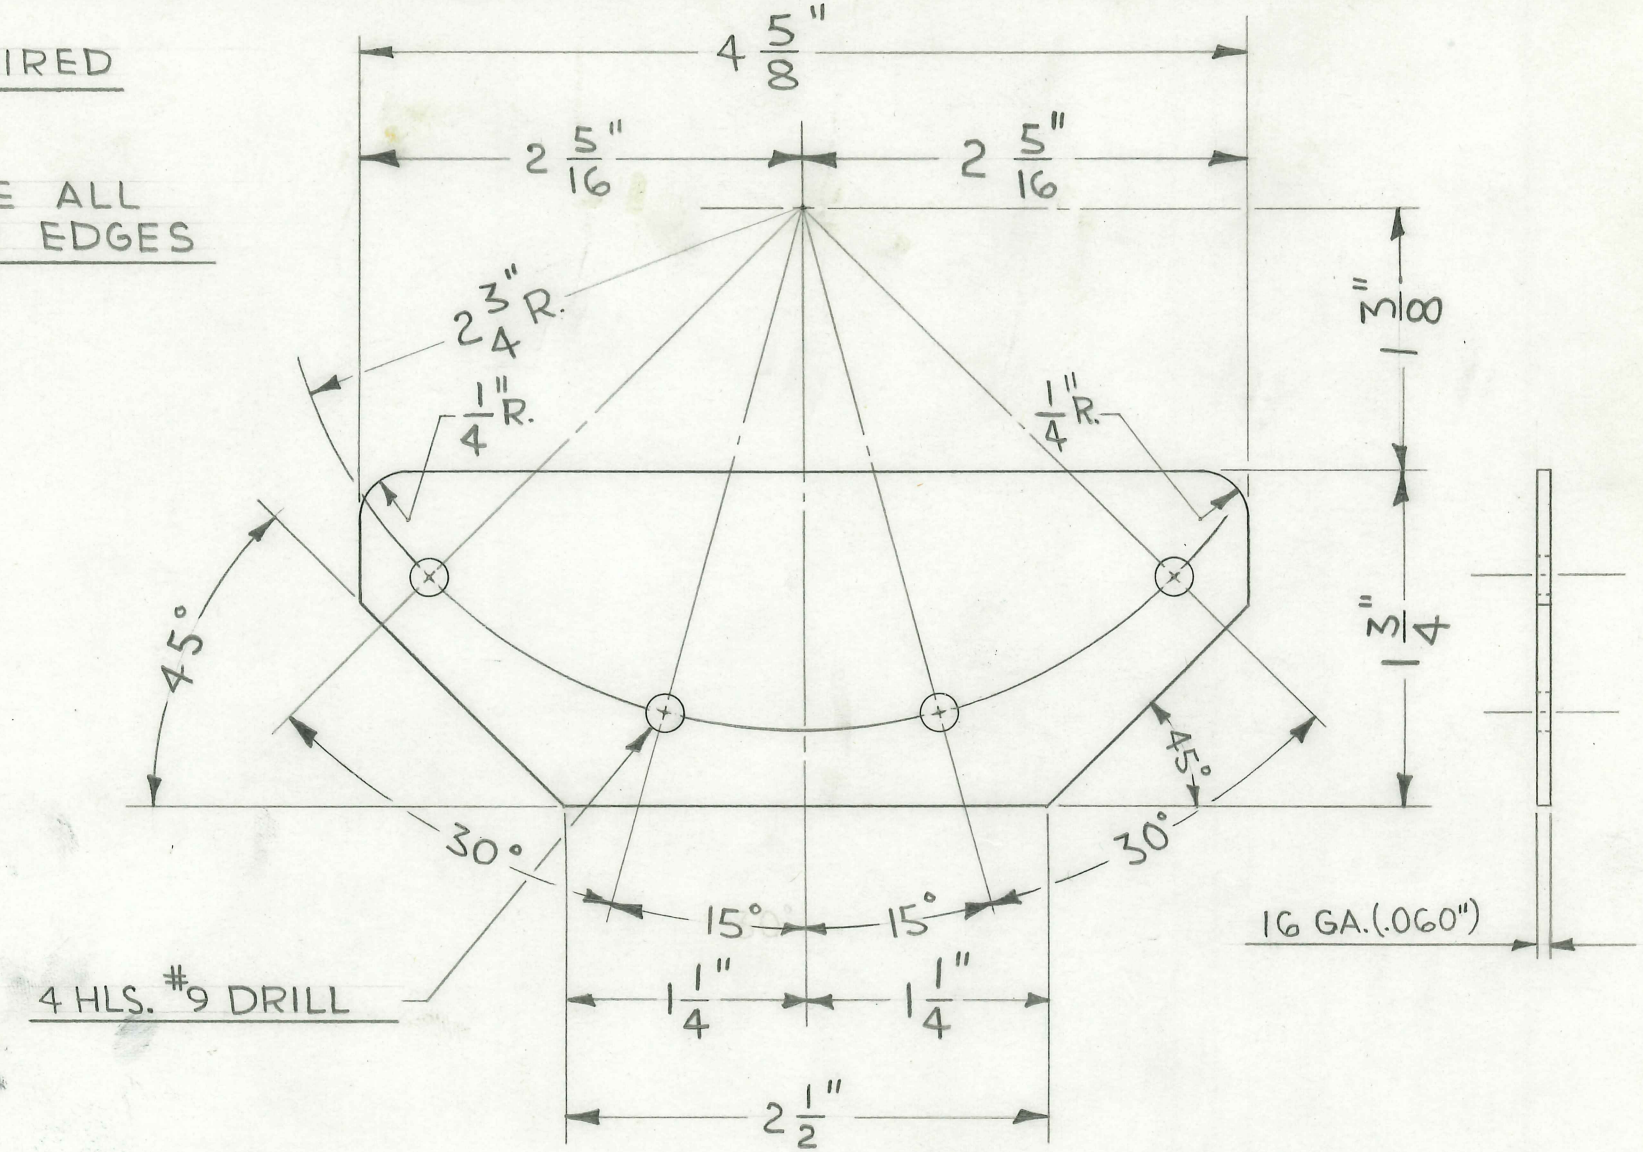

FOLDER #138

TITLE FISCHER DELUXE "RF-250" X-RAY
2 TUBE FLUOR. TILT TABLE
RESISTOR CLAMPING ROD

H. G. FISCHER & CO.
FRANKLIN PARK, ILLINOIS

PART NO. 17527

DATE 5-2-49 | DR. BY W.J. | CH'K'D. J.V.W.

REVISION	DATE	BY

PATTERN | FINISH CAD. #23 | SCALE FULL

TOOLS | MATERIAL 3/16 DIA. C.R. STEEL

DIMENSIONS
FRACTIONAL ± .015
DECIMAL ± .005
ANGULAR ± ½°
UNLESS OTHERWISE SPECIFIED

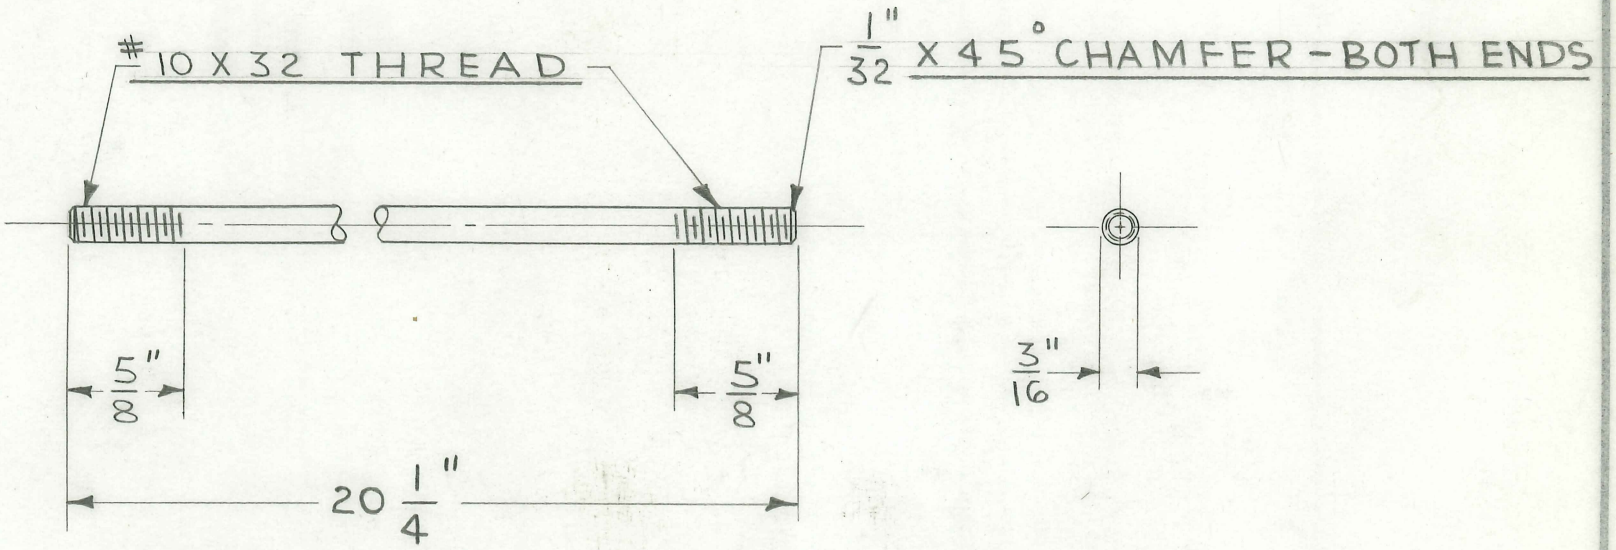

4 REQUIRED

FOLDER # 138

FOLDER #131

PART NO. 17528

REVISION	DATE	BY

H. G. FISCHER & CO.
FRANKLIN PARK, ILLINOIS

DATE 12-6-55 DR BY C.E.K. CH'K'D. W.J.W.

DIMENSIONS
FRACTIONAL ± .015
DECIMAL ± .005
ANGULAR ± ½°
UNLESS OTHERWISE SPECIFIED

SCALE

MATERIAL

FINISH

PATTERN

TOOLS

TITLE FOUR POSITION I TYPE LEVER SWITCH

ALL BLADE POSITIONS SHOWN ARE FOR LEVER IN NEUTRAL POSITION

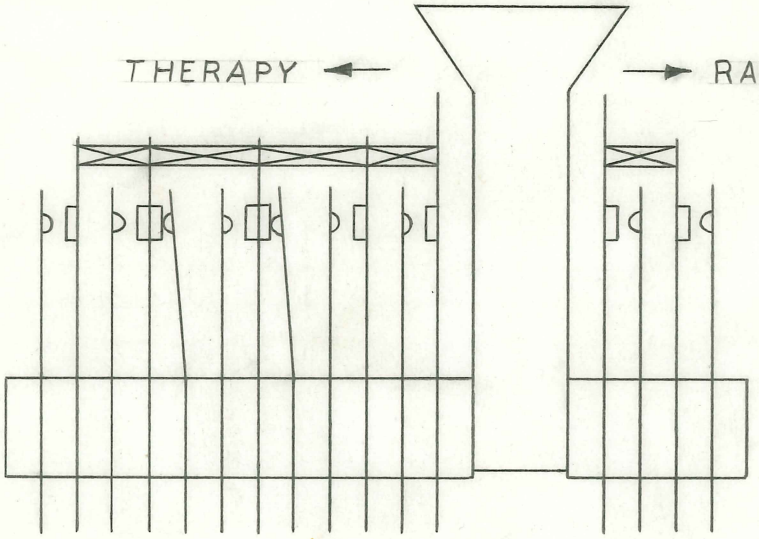

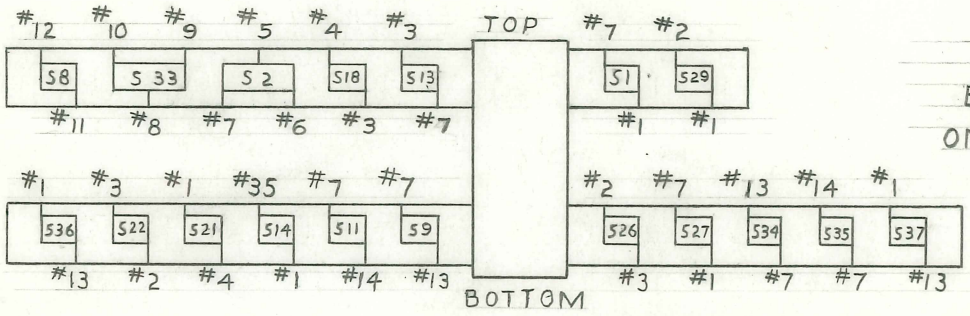

CIRCUIT BREAKER ON THIS SIDE

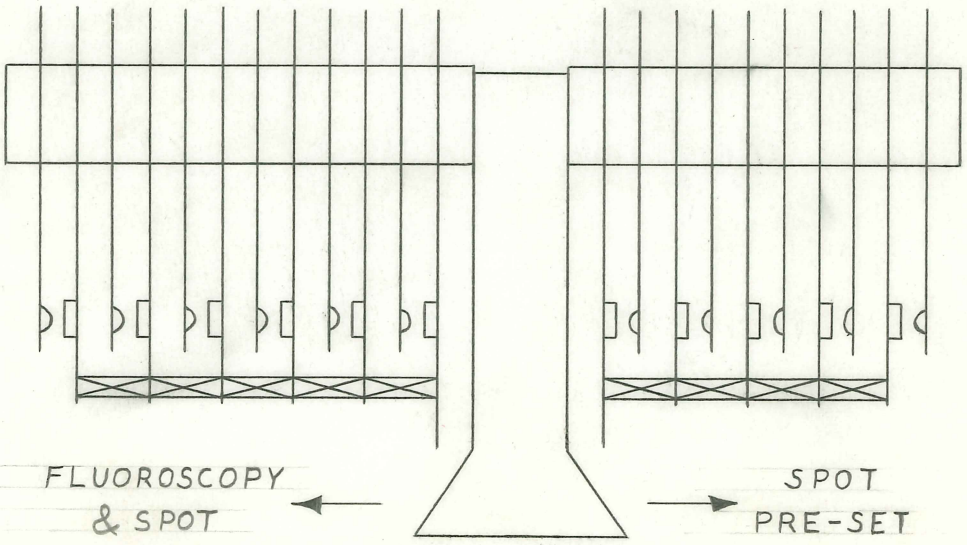

TITLE FISCHER DELUXE "RF-250" X-RAY 2 TUBE FLUOR. TILT TABLE AUXILIARY C' WEIGHT

H. G. FISCHER & CO.
FRANKLIN PARK, ILLINOIS

PART NO. 17546

DATE 4-27-49 | DR. BY W.J. | CH'K'D. J.N.W.

REVISION	DATE	BY

PATTERN | FINISH | SCALE FULL

TOOLS | MATERIAL 3/4 X 20 GA. (.035") WALL SQ. WELDED STEEL TUBING

DIMENSIONS UNLESS OTHERWISE SPECIFIED
FRACTIONAL ± .015
DECIMAL ± .005
ANGULAR ± ½°

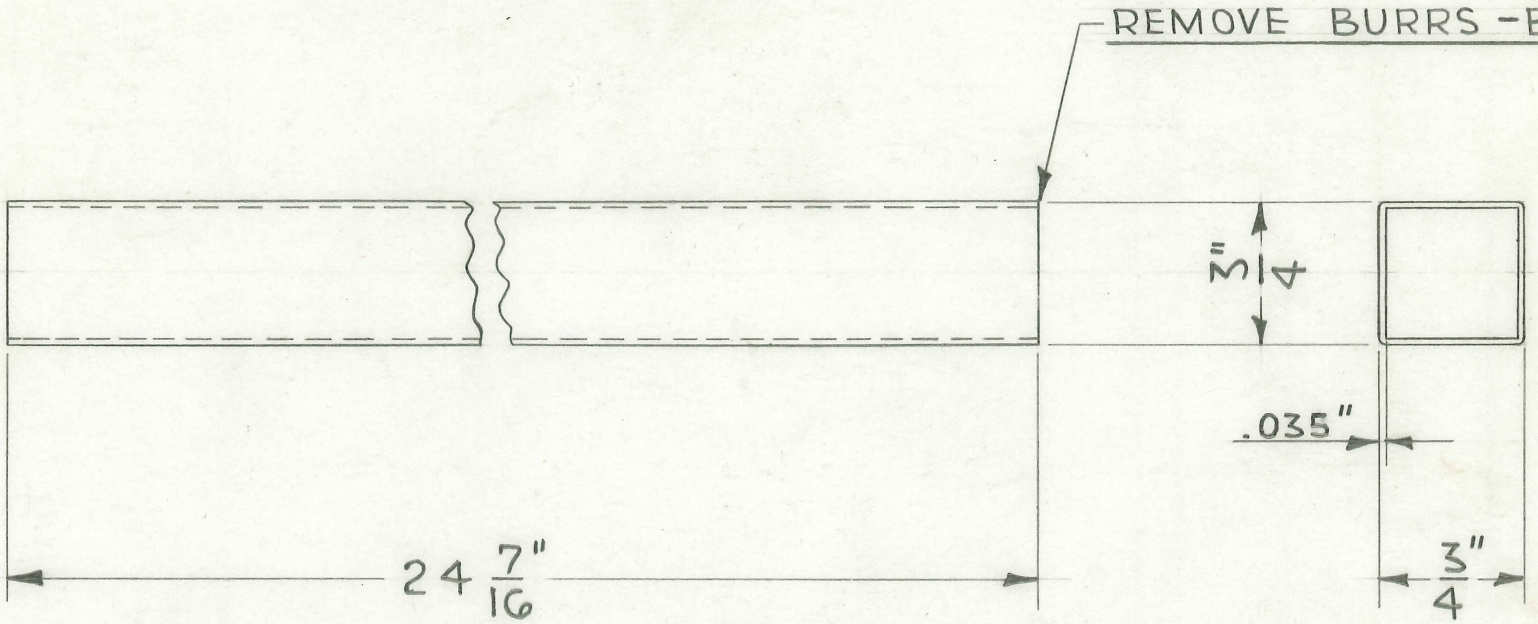

2 REQUIRED

FOLDER #142

TITLE FISCHER DELUXE "RF-250" X-RAY
2 TUBE FLUO. TILT TABLE TUBE
STAND SHEATHING CLAMP

H. G. FISCHER & CO.
FRANKLIN PARK, ILLINOIS

PART NO. 17548A

DATE 4-26-50 DR. BY J.V.W. CH'K'D.

REVISION	DATE	BY

PATTERN | FINISH PAINTED | SCALE FULL

TOOLS

MATERIAL $\frac{3}{32}$" X $\frac{3}{4}$" C.R. STEEL FLAT WIRE

DIMENSIONS UNLESS OTHERWISE SPECIFIED
FRACTIONAL ± .015
DECIMAL ± .005
ANGULAR ± ½°

1 REQUIRED

DEVELOPED LENGTH = $5\frac{1}{4}$"

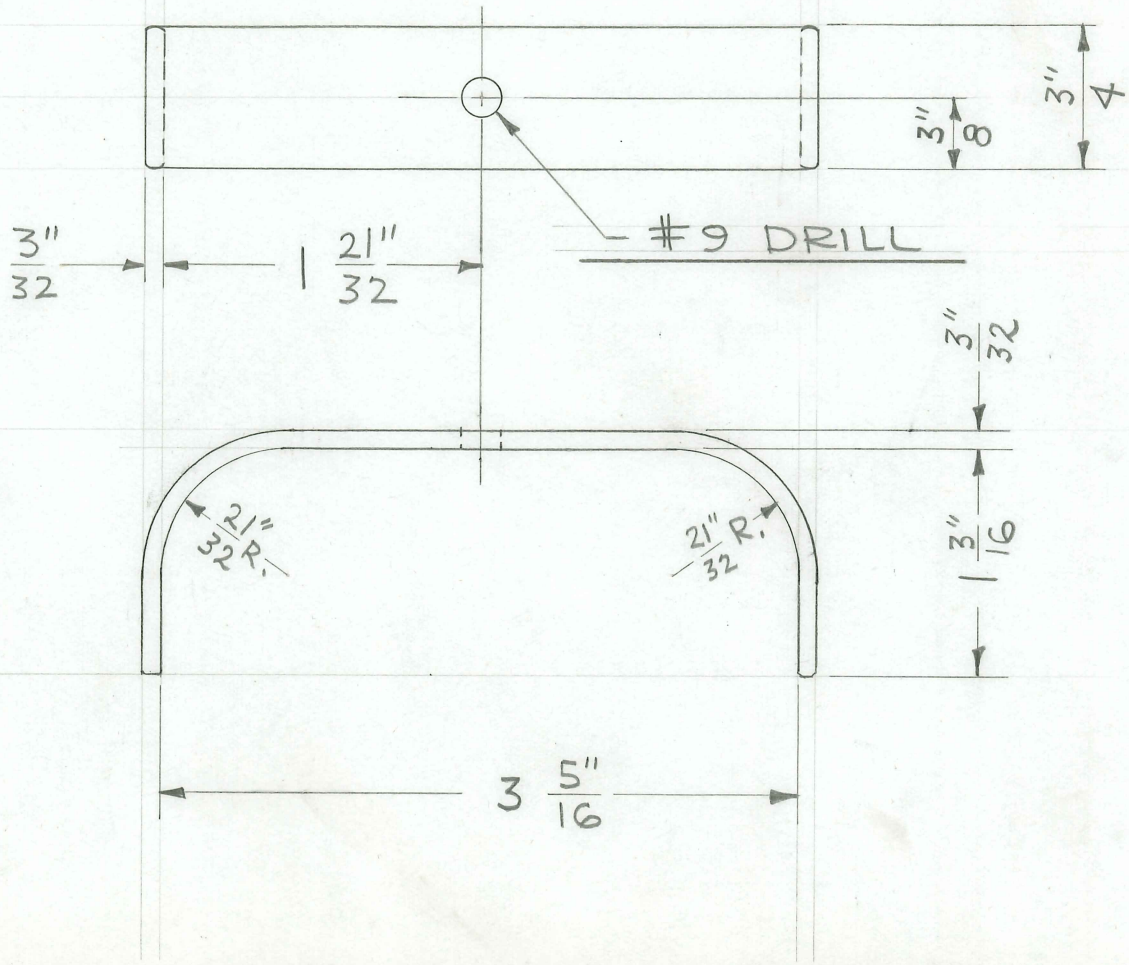

FOLDER #142

TITLE FISCHER DELUXE "RF-250" X-RAY
2 TUBE FLUO. TILT TABLE TUBE STAND
SHEATHING CLAMP SPACER

H. G. FISCHER & CO.
FRANKLIN PARK, ILLINOIS

PART NO. 17548 1/2

DATE 4-26-50 DR. BY J.V.W. CH'K'D.

REVISION	DATE	BY

PATTERN | FINISH PAINTED | SCALE FULL

TOOLS

MATERIAL
5/8" DIA. C.R. STEEL

DIMENSIONS
FRACTIONAL ± .015
DECIMAL ± .005
ANGULAR ± ½°
UNLESS OTHERWISE SPECIFIED

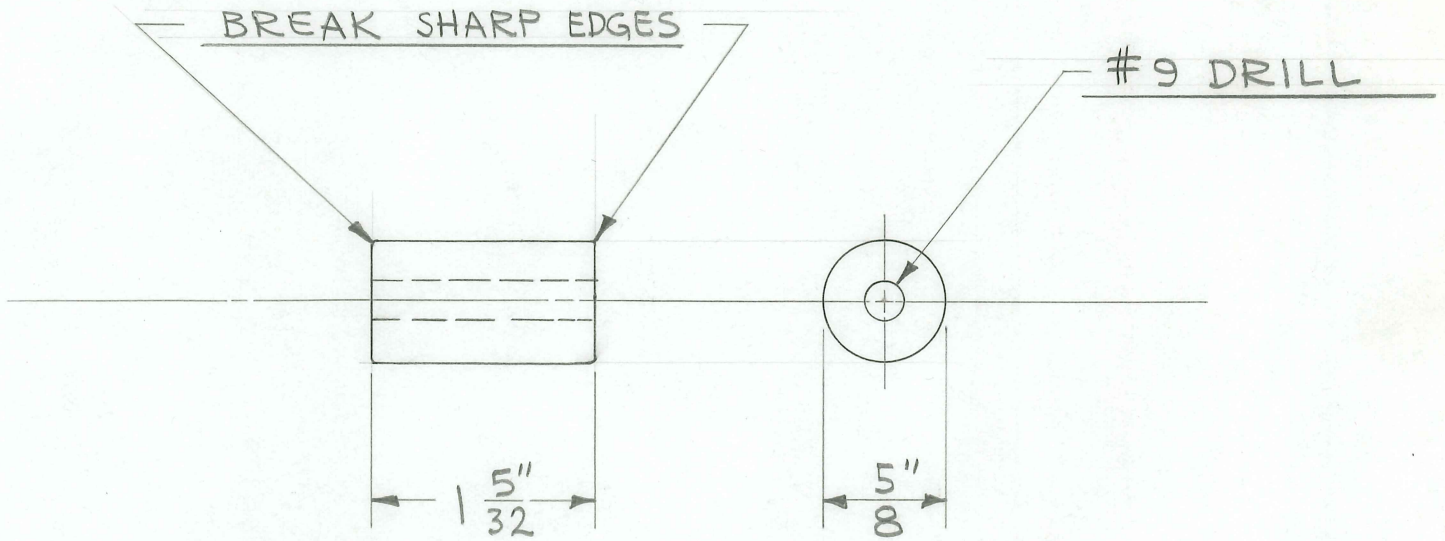

1 REQUIRED

FOLDER #142

TITLE FISCHER DELUXE "RF-250" X-RAY 2 TUBE FLUOR. TILT TABLE LOWER CABLE CLAMP SHEATHING CLAMP SUPP.	H. G. FISCHER & CO. FRANKLIN PARK, ILLINOIS	PART NO. 17549	
	DATE 4-25-49 DR. BY W.J. CH'K'D. J.V.W.	REVISION	DATE BY
PATTERN / FINISH / SCALE FULL	DIMENSIONS: FRACTIONAL ± .015; DECIMAL ± .003; ANGULAR ± ½°; UNLESS OTHERWISE SPECIFIED		
TOOLS / MATERIAL 3/32" X 5/8" FLAT WIRE			

1 REQUIRED

DEVELOPED LENGTH

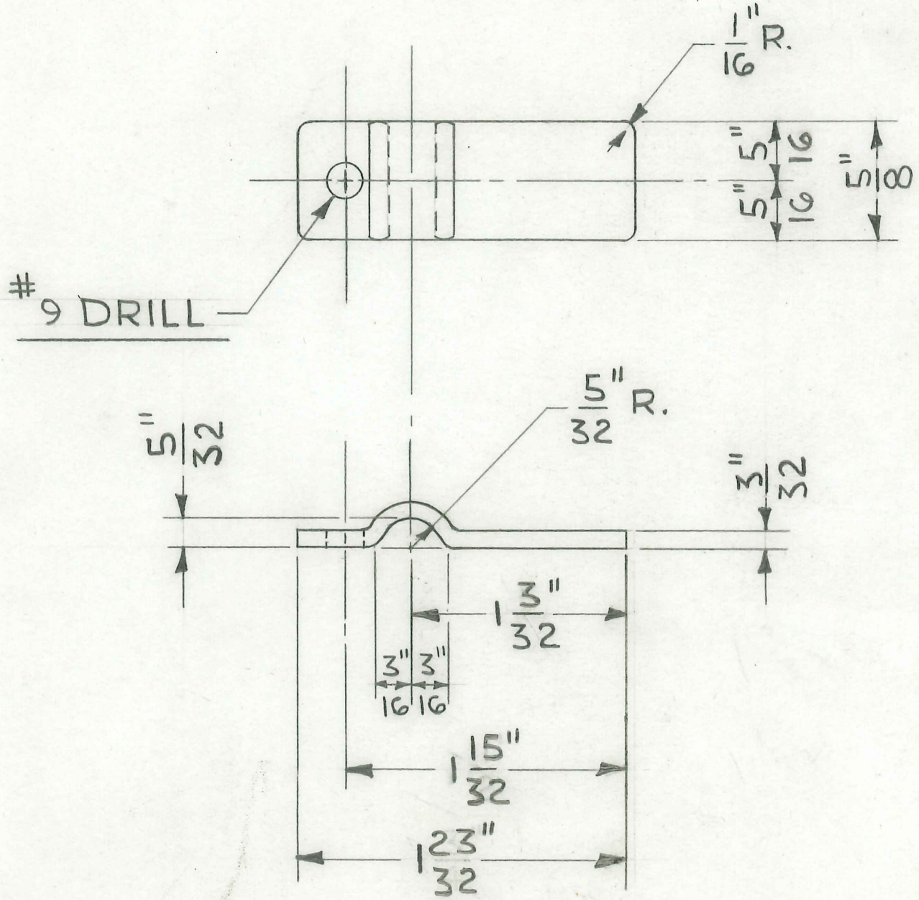

FOLDER #142

TITLE FISCHER DELUXE "RF-250" X-RAY 2 TUBE FLUOR. TILT TABLE LOWER CABLE CLAMP SHEATHING CLAMP - BLANK

H. G. FISCHER & CO.
FRANKLIN PARK, ILLINOIS

PART NO. 17557

DATE 4-25-49 | DR. BY W.J. | CH'K'D. J.N.W.

REVISION	DATE	BY

PATTERN | FINISH | SCALE FULL

TOOLS | MATERIAL 5/32" X 1" FLAT WIRE

DIMENSIONS
FRACTIONAL ± .015
DECIMAL ± .005
ANGULAR ± ½°
UNLESS OTHERWISE SPECIFIED

DEVELOPED LENGTH = 1 REQUIRED

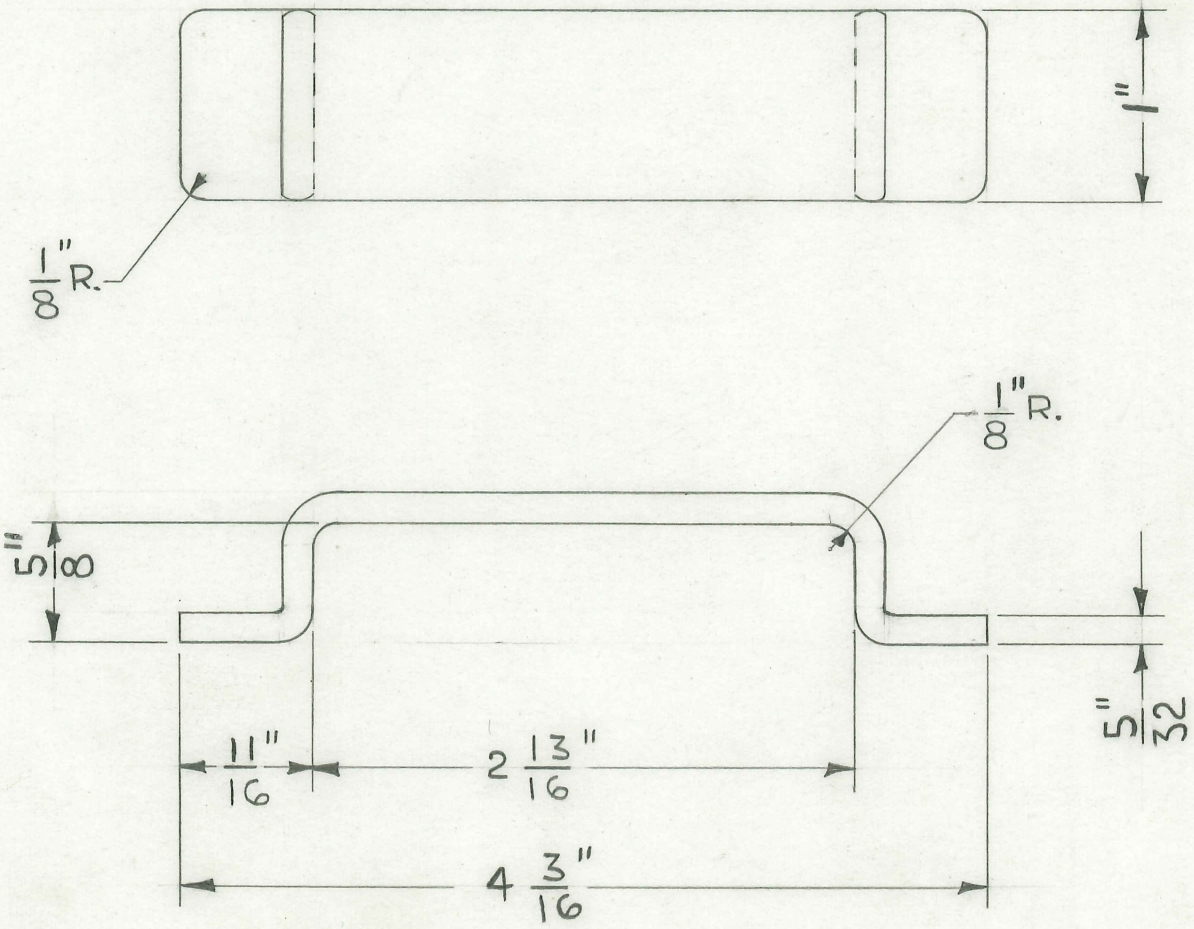

FOLDER #142

TITLE FISCHER DELUXE "RF-250" X-RAY 2 TUBE FLUOR. TILT TABLE LOWER CABLE CLAMP SHEATHING CLAMP - LOWER	H. G. FISCHER & CO. FRANKLIN PARK, ILLINOIS	PART NO. 17558	
	DATE 4-25-49 DR. BY W.J. CH'K'D. J.V.W.	REVISION	DATE BY
PATTERN / FINISH PAINTED / SCALE FULL	DIMENSIONS: FRACTIONAL ± .015, DECIMAL ± .005, ANGULAR ± ½° UNLESS OTHERWISE SPECIFIED		
TOOLS / MATERIAL FROM 17557			

1 REQUIRED

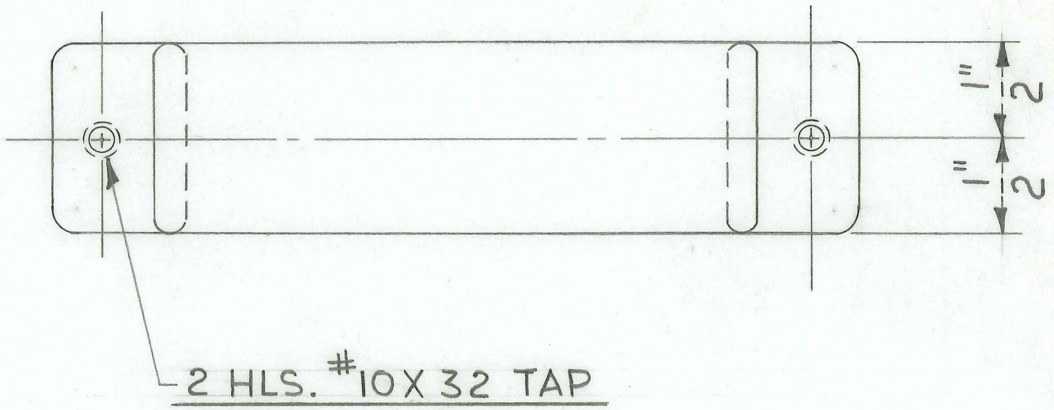

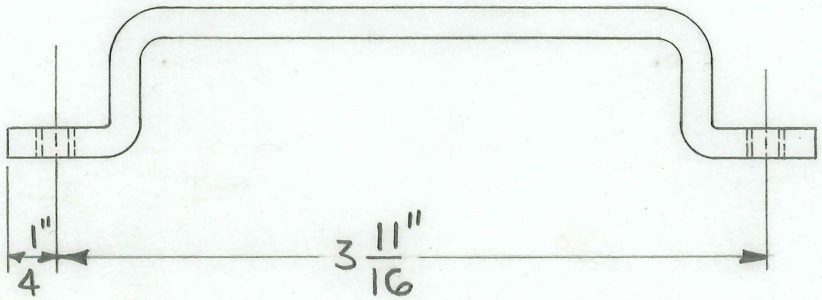

FOLDER #142

TITLE FISCHER DELUXE "RF-250" X-RAY
2 TUBE FLUOR. TILT TABLE LOWER
CABLE CLAMP SHEATHING CLAMP- UPPER

H. G. FISCHER & CO.
FRANKLIN PARK, ILLINOIS

PART NO. 17559

DATE 4-25-49 DR. BY W. J. CH'K'D. J.N.W.

REVISION	DATE	BY

PATTERN | FINISH | SCALE FULL

TOOLS | MATERIAL FROM 17557

DIMENSIONS
FRACTIONAL ± .015
DECIMAL ± .005
ANGULAR ± ½°
UNLESS OTHERWISE SPECIFIED

1 REQUIRED

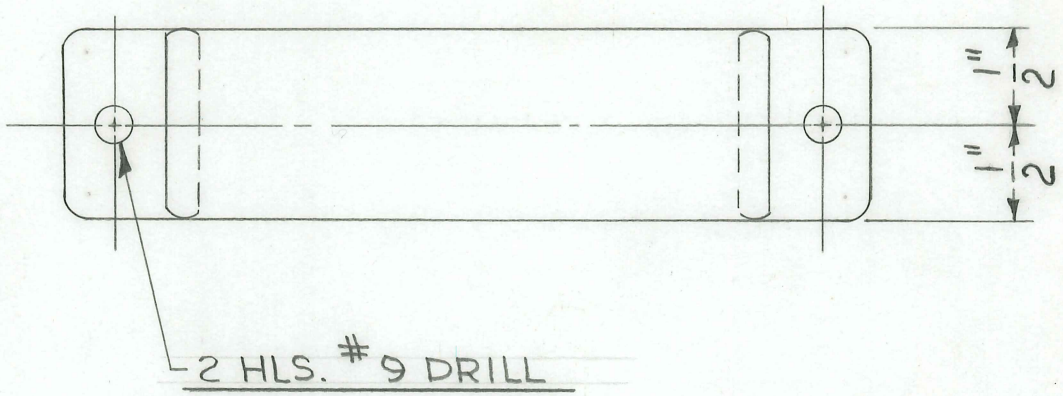

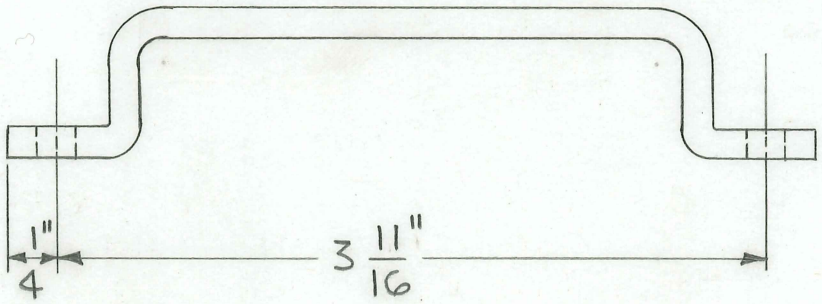

FOLDER # 142

TITLE
FISCHER DELUXE "RF-250" X-RAY (BLANK
2 TUBE FLUOR. TILT TABLE CORD CLAMP UPPER

H. G. FISCHER & CO.
FRANKLIN PARK, ILLINOIS

PART NO. 17560

DATE 4-21-49 | DR. BY W.J. | CH'K'D. J.V.W.

REVISION	DATE	BY

PATTERN | FINISH | SCALE FULL

TOOLS | MATERIAL 3/32" X 3/4" FLAT WIRE

DIMENSIONS
FRACTIONAL ± .015
DECIMAL ± .005
ANGULAR ± ½°
UNLESS OTHERWISE SPECIFIED

DEVELOPED LENGTH

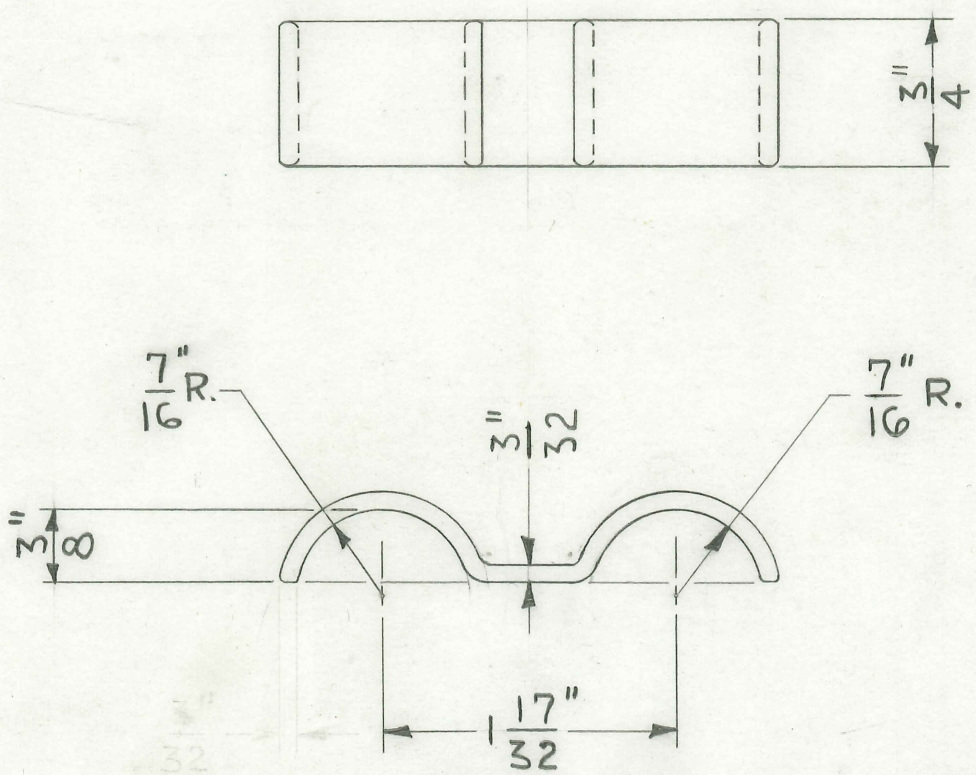

1 REQUIRED

FOLDER #142

TITLE
FISCHER DELUXE RF-250 X-RAY
2TUBE FLUO. TILT TABLE CWT. CLAMPING ROD

H. G. FISCHER & CO.
FRANKLIN PARK, ILLINOIS

PART NO. 17562

DATE 4-5-49 DR. BY W.J. CH'K'D. J.V.W.

REVISION	DATE	BY

PATTERN | FINISH | SCALE FULL

TOOLS | MATERIAL 1/4" DIA. C.R. STEEL ROD

DIMENSIONS UNLESS OTHERWISE SPECIFIED
FRACTIONAL ± .015
DECIMAL ± .005
ANGULAR ± ½°

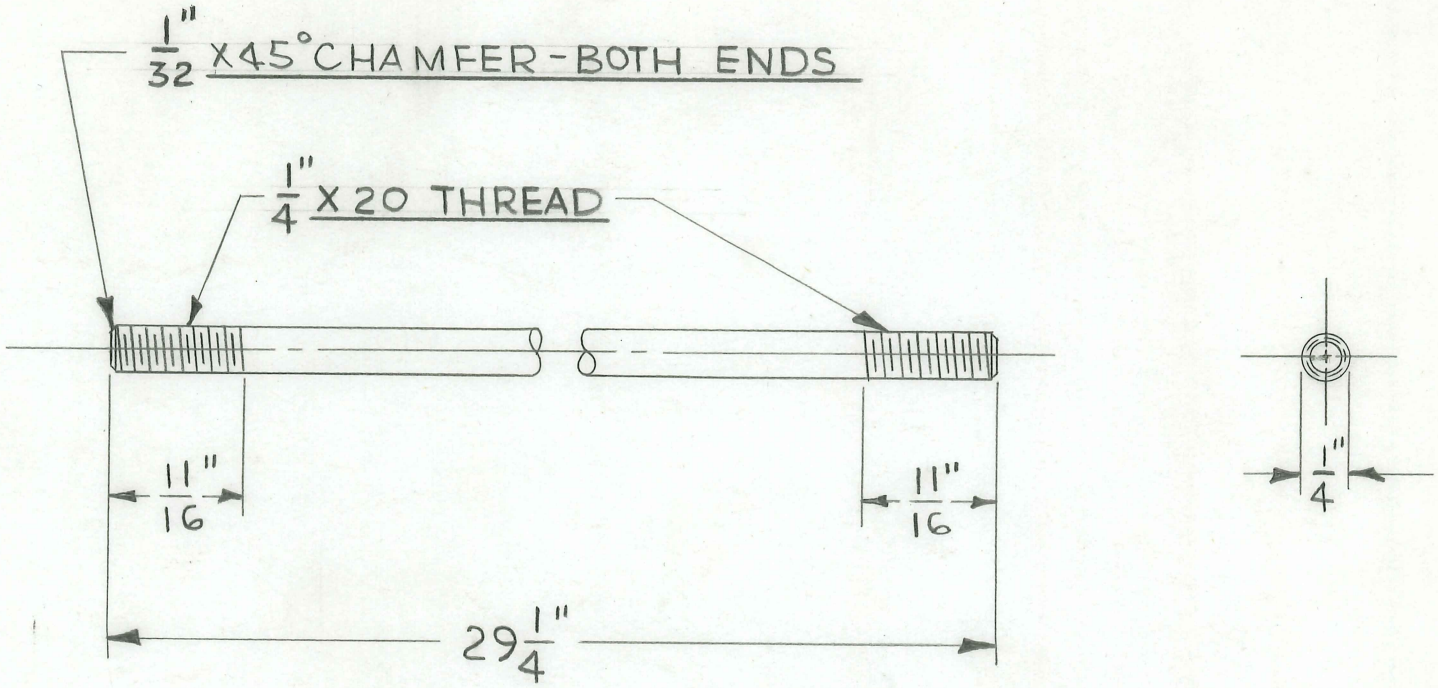

1 REQUIRED

FOLDER # 142

TITLE FISCHER DELUXE RF-250 X-RAY 2 TUBE FLUOR. TILT TABLE CORD CLAMP UPPER

H. G. FISCHER & CO.
FRANKLIN PARK, ILLINOIS

PART NO. 17564

DATE 4-21-49 DR. BY W. J. CH'K'D. J.V.W.

REVISION	DATE	BY

PATTERN | FINISH PAINTED | SCALE FULL

TOOLS | MATERIAL FROM 17560

DIMENSIONS
FRACTIONAL ± .015
DECIMAL ± .005
ANGULAR ± ½°
UNLESS OTHERWISE SPECIFIED

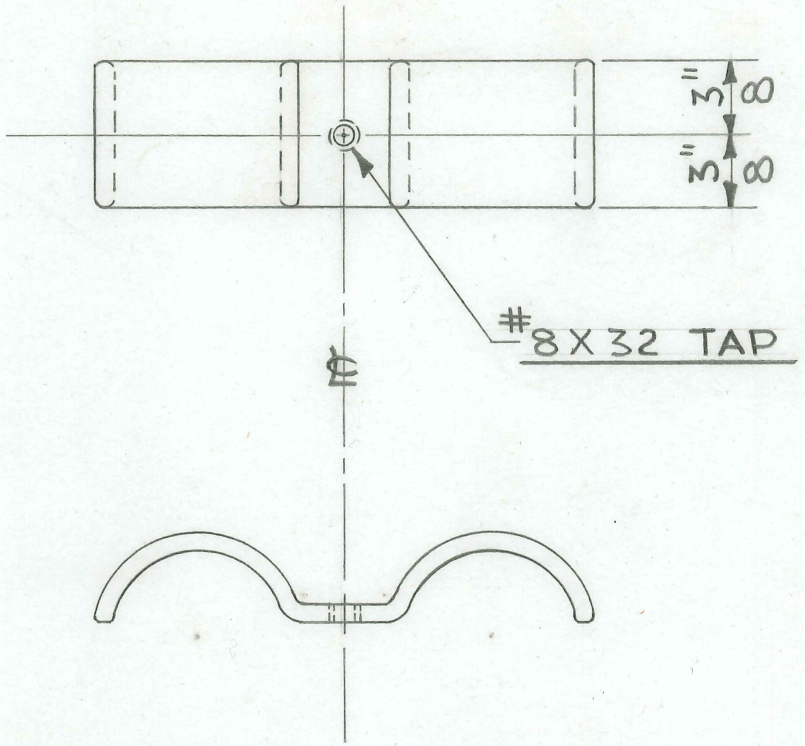

1 REQUIRED

FOLDER #142

TITLE FISCHER DELUXE "RF-250" X-RAY
2 TUBE FLUOR. TILT TABLE CORD
CLAMP UPPER

H. G. FISCHER & CO.
FRANKLIN PARK, ILLINOIS

DATE 4-21-49 DR. BY W. J. CH'K'D. J.V.W.

PART NO. 17565

REVISION	DATE	BY

PATTERN | FINISH PAINTED | SCALE FULL

TOOLS | MATERIAL FROM 17560

DIMENSIONS
FRACTIONAL ± .015
DECIMAL ± .005
ANGULAR ± ½°
UNLESS OTHERWISE SPECIFIED

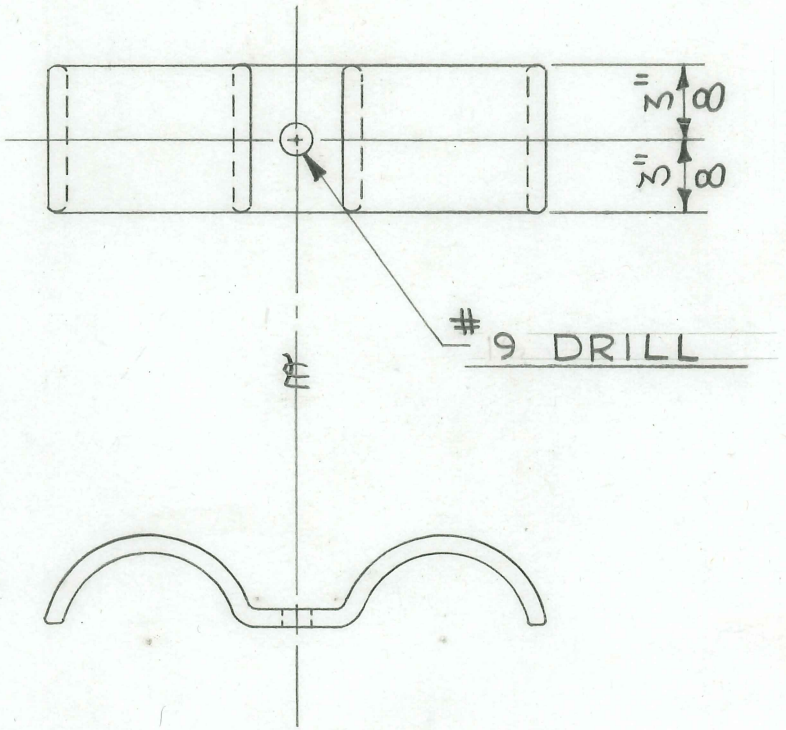

1 REQUIRED

FOLDER #142

TITLE

FISCHER DELUXE "RF-250" X-RAY
2 TUBE FLUOR. TABLE SCREEN CWT. CHAIN UPPER ASSEM.

H. G. FISCHER & CO.
FRANKLIN PARK, ILLINOIS

DATE 3-15-49 DR. BY W.J. CH'K'D. J.N.W.

PART NO. 17568G

REVISION	DATE	BY

PATTERN | FINISH CAD.# 23 | SCALE FULL

TOOLS | MATERIAL

DIMENSIONS
FRACTIONAL ± .015
DECIMAL ± .005
ANGULAR ± ½°
UNLESS OTHERWISE SPECIFIED

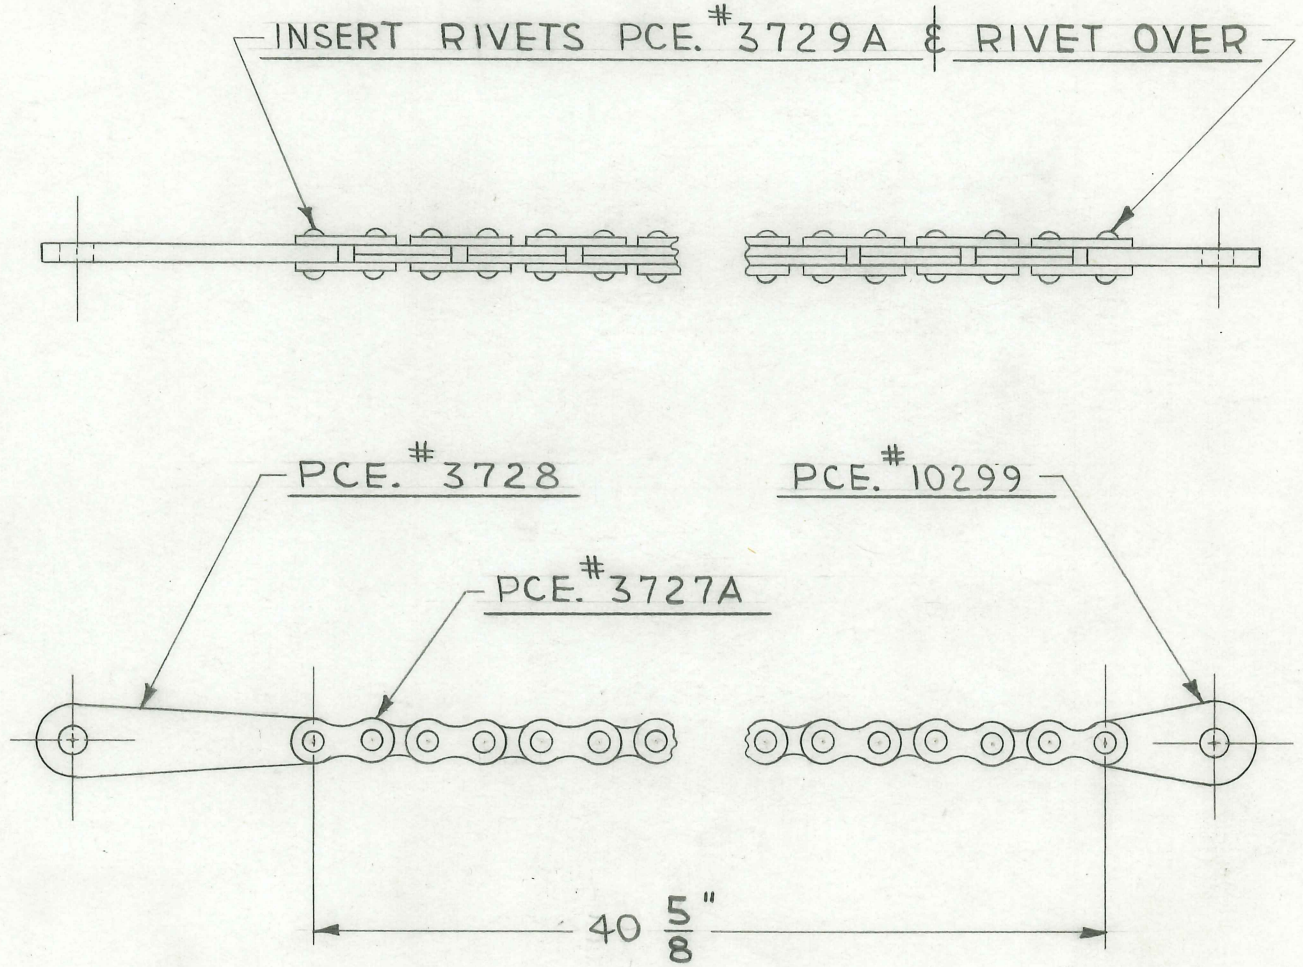

1 REQUIRED

FOLDER #142

TITLE	H. G. FISCHER & CO.	PART NO.
FISCHER "DELUXE RF-250" X-RAY 2 TUBE CWT. SUPP. STUD - SHORT	FRANKLIN PARK, ILLINOIS	17570

DATE	DR. BY	CH'K'D.
4-4-49	W. J.	J.V.W.

REVISION	DATE	BY

PATTERN	FINISH	SCALE
	CAD. #23	FULL

TOOLS	MATERIAL
	$\frac{5}{16}$" DIA. C.R. STEEL

DIMENSIONS UNLESS OTHERWISE SPECIFIED

FRACTIONAL	± .015
DECIMAL	± .005
ANGULAR	± ½°

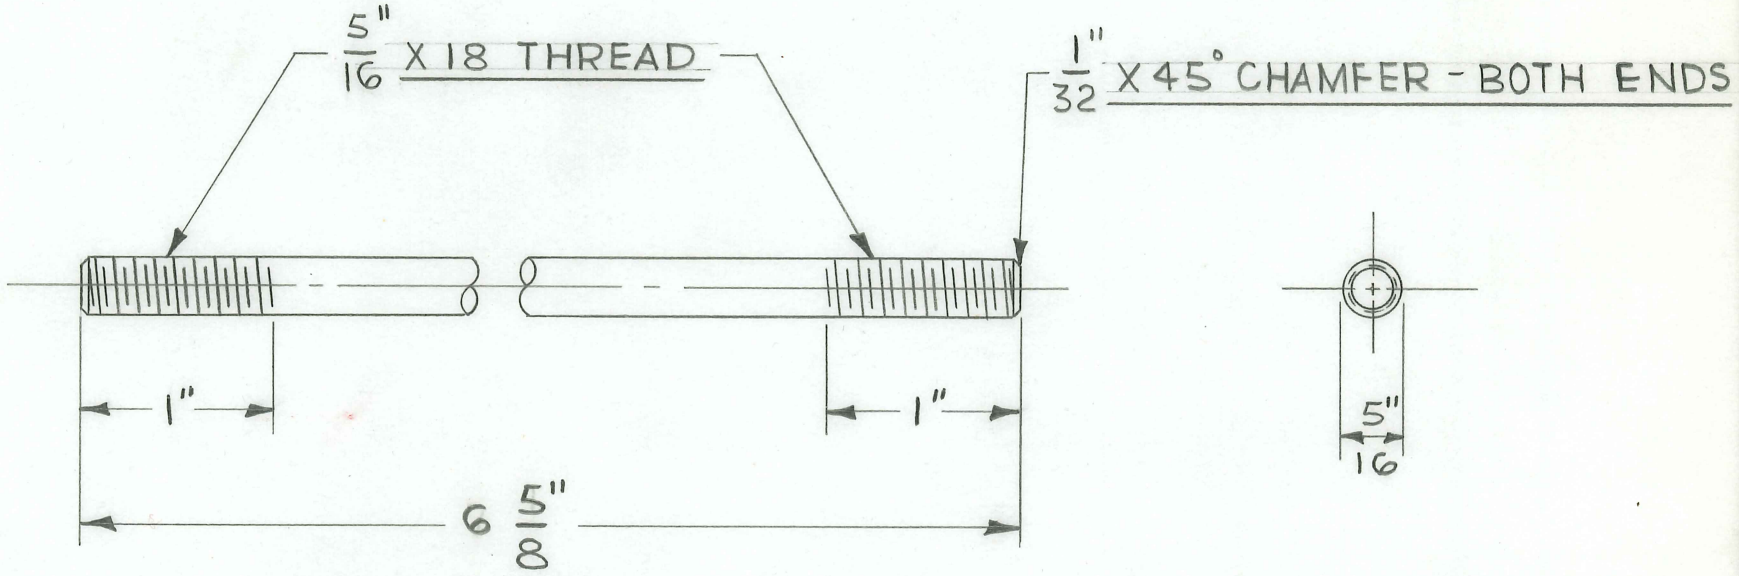

1 REQUIRED

FOLDER # 142

TITLE
FISCHER "DELUXE RF-250" X-RAY
2 TUBE CWT. SUPR. STUD - LONG

H. G. FISCHER & CO.
FRANKLIN PARK, ILLINOIS

PART NO. 17571

DATE 4-4-49 | DR. BY W.J. | CH'K'D. J.V.W.

REVISION	DATE	BY

PATTERN | FINISH CAD. #23 | SCALE FULL

TOOLS | MATERIAL $\frac{5}{16}$" DIA. C.R. STEEL

DIMENSIONS UNLESS OTHERWISE SPECIFIED
FRACTIONAL ± .015
DECIMAL ± .005
ANGULAR ± ½°

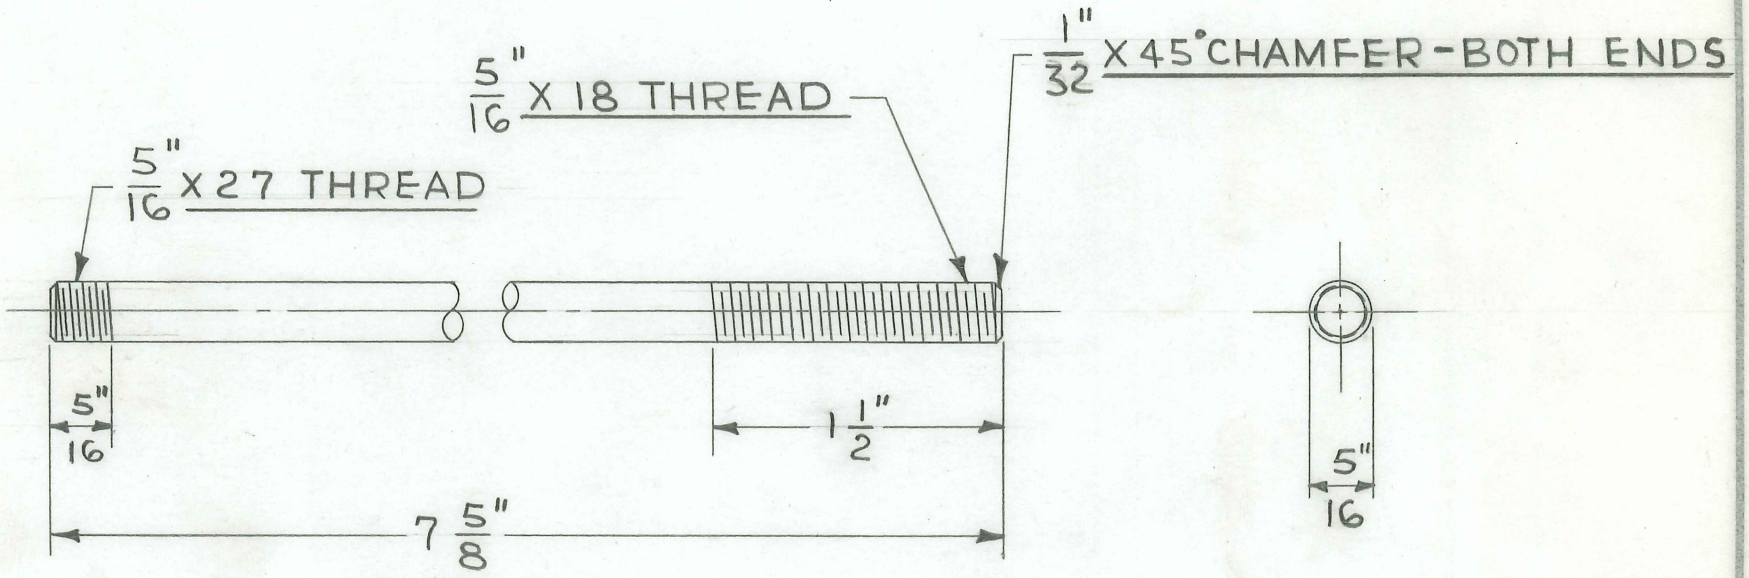

2 REQUIRED

FOLDER #142

TITLE FISCHER DELUXE RF-"250" X-RAY 2 TUBE FLUOR. TILT TABLE FLEXIBLE CABLE FERRULE	H. G. FISCHER & CO. FRANKLIN PARK, ILLINOIS		PART NO. 17576
	DATE 4-20-49	DR. BY W. J.	CH'K'D. J.V.W.
PATTERN	FINISH	SCALE FULL	
TOOLS	MATERIAL $1\frac{5}{16}$" DIA. BRASS ROD		

DIMENSIONS
FRACTIONAL ± .015
DECIMAL ± .005
ANGULAR ± ½°
UNLESS OTHERWISE SPECIFIED

REVISION	DATE	BY

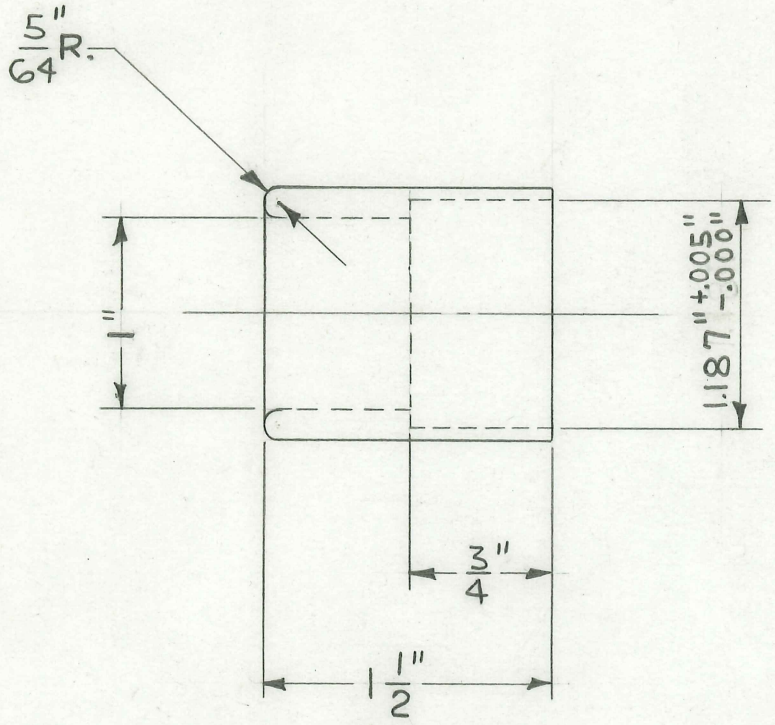

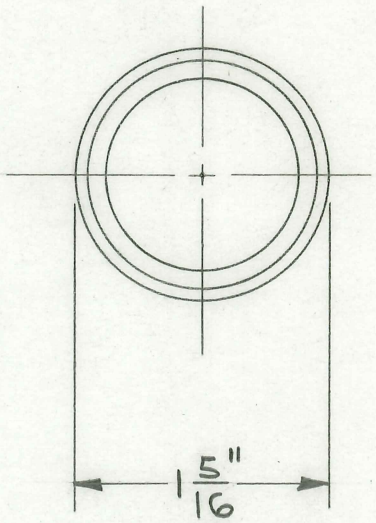

4 REQUIRED

FOLDER #142

TITLE FISCHER DELUXE "RF-250" X-RAY 2 TUBE FLUOR. TILT TABLE LOWER CABLE CLAMP SHEATHING CLAMP-UPPER SUPP. ASSEM.

H. G. FISCHER & CO.
FRANKLIN PARK, ILLINOIS

PART NO. 17578G

DATE 4-26-49 | DR. BY W. J. | CH'K'D. J.V.W.

PATTERN	FINISH	SCALE
	PAINTED	FULL

TOOLS

MATERIAL

DIMENSIONS
FRACTIONAL ± .015
DECIMAL ± .005
ANGULAR ± ½°
UNLESS OTHERWISE SPECIFIED

REVISION	DATE	BY

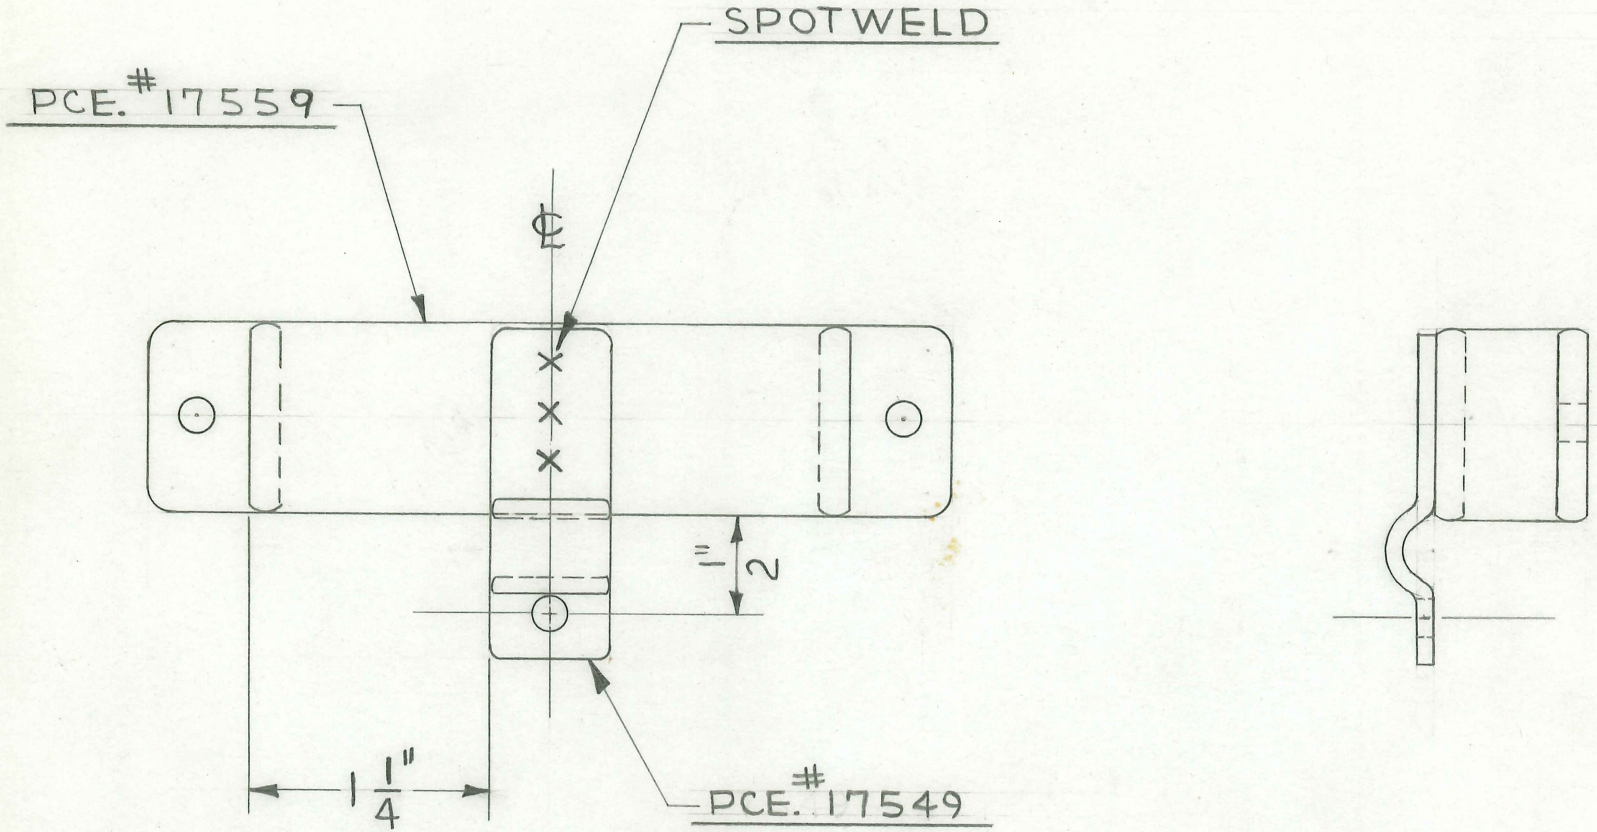

1 REQUIRED

FOLDER #142

TITLE
FISCHER DELUXE "RF-250" X-RAY
2 TUBE FLUOR. TILT TABLE CABLE SUPP. CHAIN

H. G. FISCHER & CO.
FRANKLIN PARK, ILLINOIS

PART NO. 17579

DATE 4-29-49 | DR. BY W.J. | CH'K'D J.N.W.

REVISION	DATE	BY

PATTERN | FINISH CAD. #23 | SCALE FULL

TOOLS

MATERIAL
SASH CHAIN

DIMENSIONS
FRACTIONAL ± .015
DECIMAL ± .005
ANGULAR ± ½°
UNLESS OTHERWISE SPECIFIED

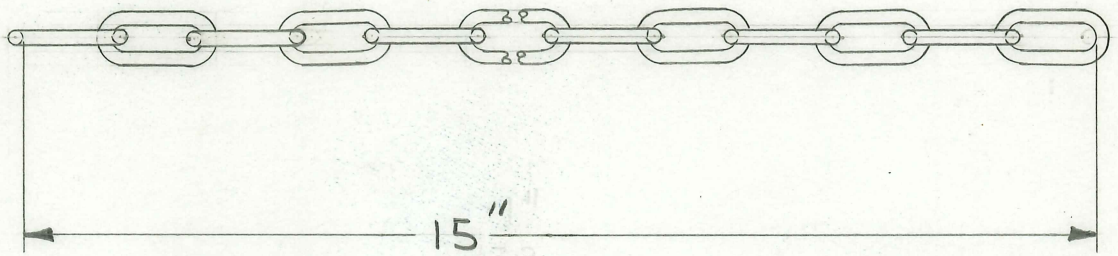

1 REQUIRED

FOLDER #142

TITLE	H. G. FISCHER & CO.	PART NO.
FISCHER DELUXE "RF-250" R.A. MOTOR CONTROL MOUNTING SPACER	FRANKLIN PARK, ILLINOIS	17599
	DATE 12-26-51 DR. BY W.J. CH'K'D. J.V.W.	REVISION / DATE / BY
PATTERN / FINISH / SCALE FULL	DIMENSIONS: FRACTIONAL ± .015; DECIMAL ± .005; ANGULAR ± ½°; UNLESS OTHERWISE SPECIFIED	
TOOLS / MATERIAL ½" DIA. BLACK BAKELITE ROD		

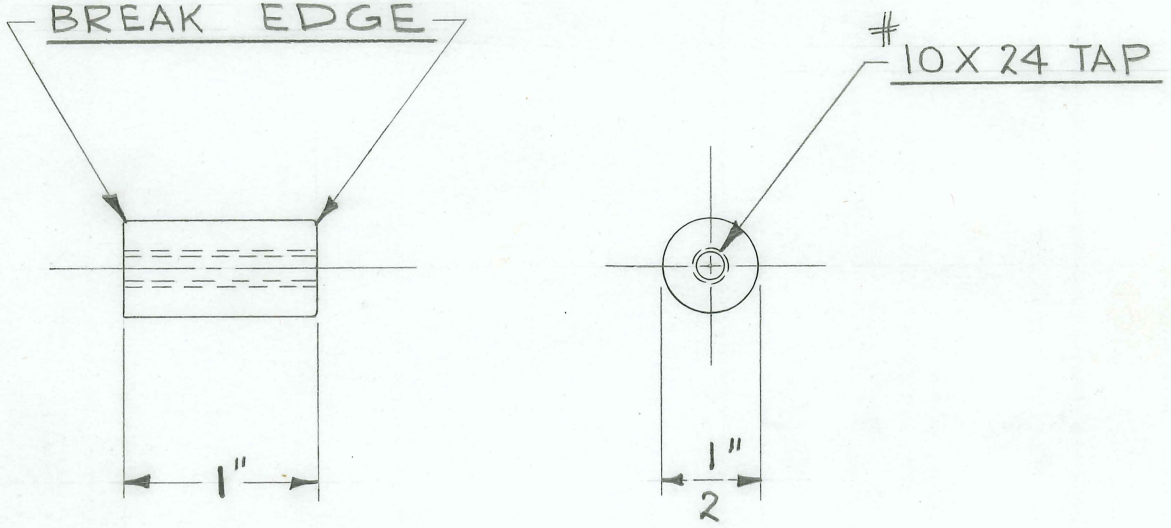

1 REQUIRED

FOLDER #131

TITLE
FISCHER WALL FRAME TILTING BUCKY STAND
TIE ROD-TOP FOR 8"X10" CASSETTE & GRID HOLDER

H. G. FISCHER & CO.
FRANKLIN PARK, ILLINOIS

PART NO. 17603

DATE 5-9-49 | DR. BY W. J. | CH'K'D. J.V.W.

REVISION	DATE	BY

PATTERN | FINISH CAD. #23 | SCALE FULL

TOOLS | MATERIAL $\frac{3}{8}$" DIA. C.R. STEEL ROD

DIMENSIONS UNLESS OTHERWISE SPECIFIED
FRACTIONAL ± .015
DECIMAL ± .005
ANGULAR ± ½°

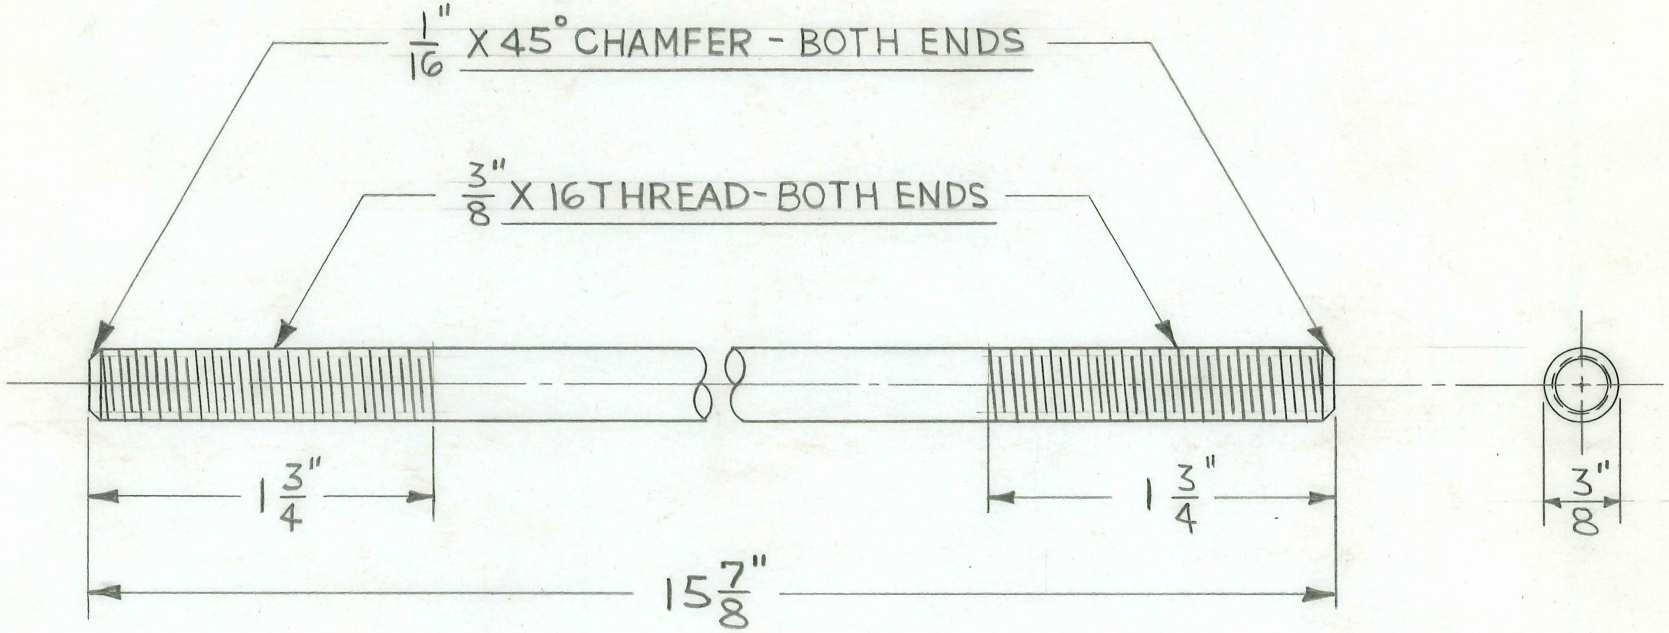

2 - REQUIRED

FOLDER # 134

TITLE
FISCHER WALL FRAME TILT. BUCKY STAND
TIE ROD-BOTTOM FOR 8"X10" CASSETTE & GRID HOLDER

H. G. FISCHER & CO.
FRANKLIN PARK, ILLINOIS

PART NO. 17604

DATE 5-9-49 | DR. BY W.J. | CH'K'D. J.V.W.

REVISION	DATE	BY

PATTERN | FINISH CAD. #23 | SCALE FULL

TOOLS | MATERIAL $\frac{1}{2}$" DIA. C.R. STEEL ROD

DIMENSIONS
FRACTIONAL ± .015
DECIMAL ± .005
ANGULAR ± ½°
UNLESS OTHERWISE SPECIFIED

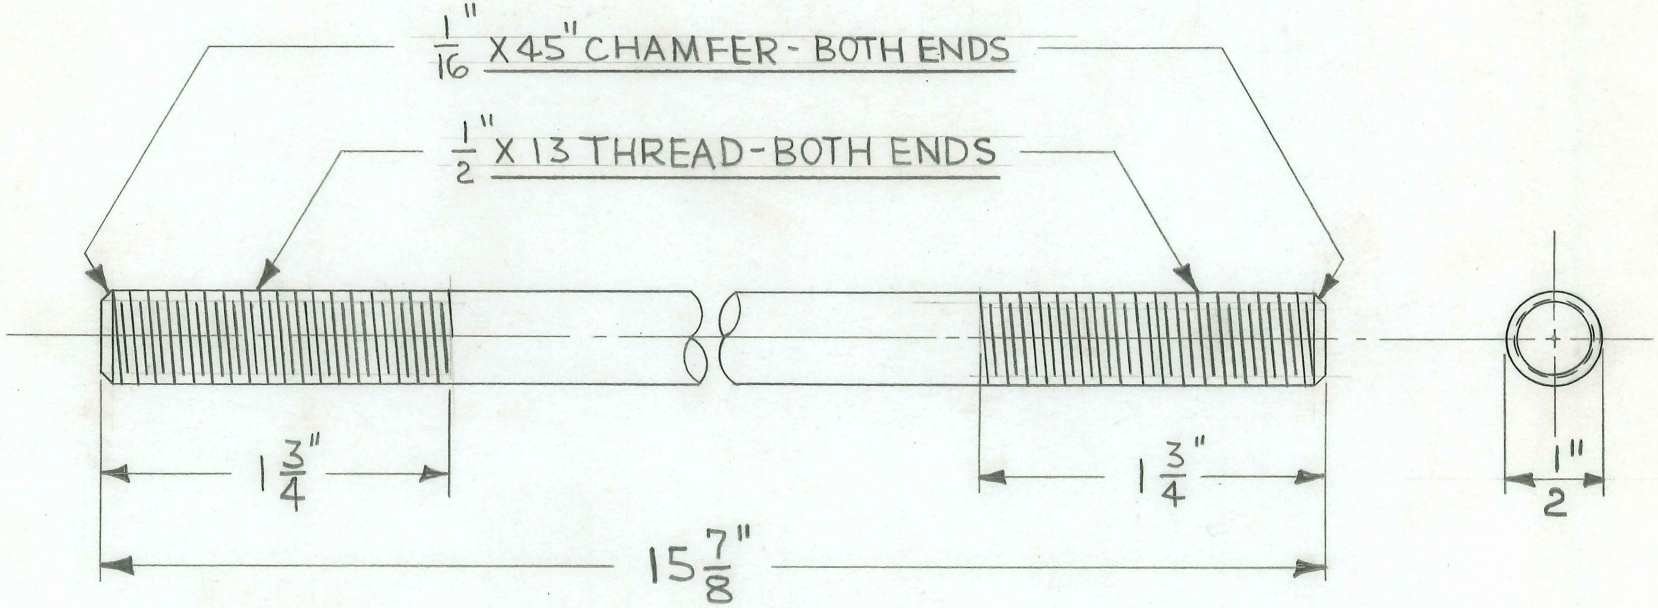

1-REQUIRED

FOLDER #134

TITLE
FISCHER WALL FRAME TILTING BUCKY STAND
C' WEIGHT FOR 8"X10" CASSETTE & GRID HOLDER

H. G. FISCHER & CO.
FRANKLIN PARK, ILLINOIS

DATE 5-9-49 | DR. BY W.J. | CH'K'D. J.V.W.

PART NO. 17606

REVISION	DATE	BY

PATTERN | FINISH | SCALE FULL

TOOLS | MATERIAL 1 3/4" DIA. C.R. STEEL ROD

DIMENSIONS UNLESS OTHERWISE SPECIFIED
FRACTIONAL ± .015
DECIMAL ± .005
ANGULAR ± ½°

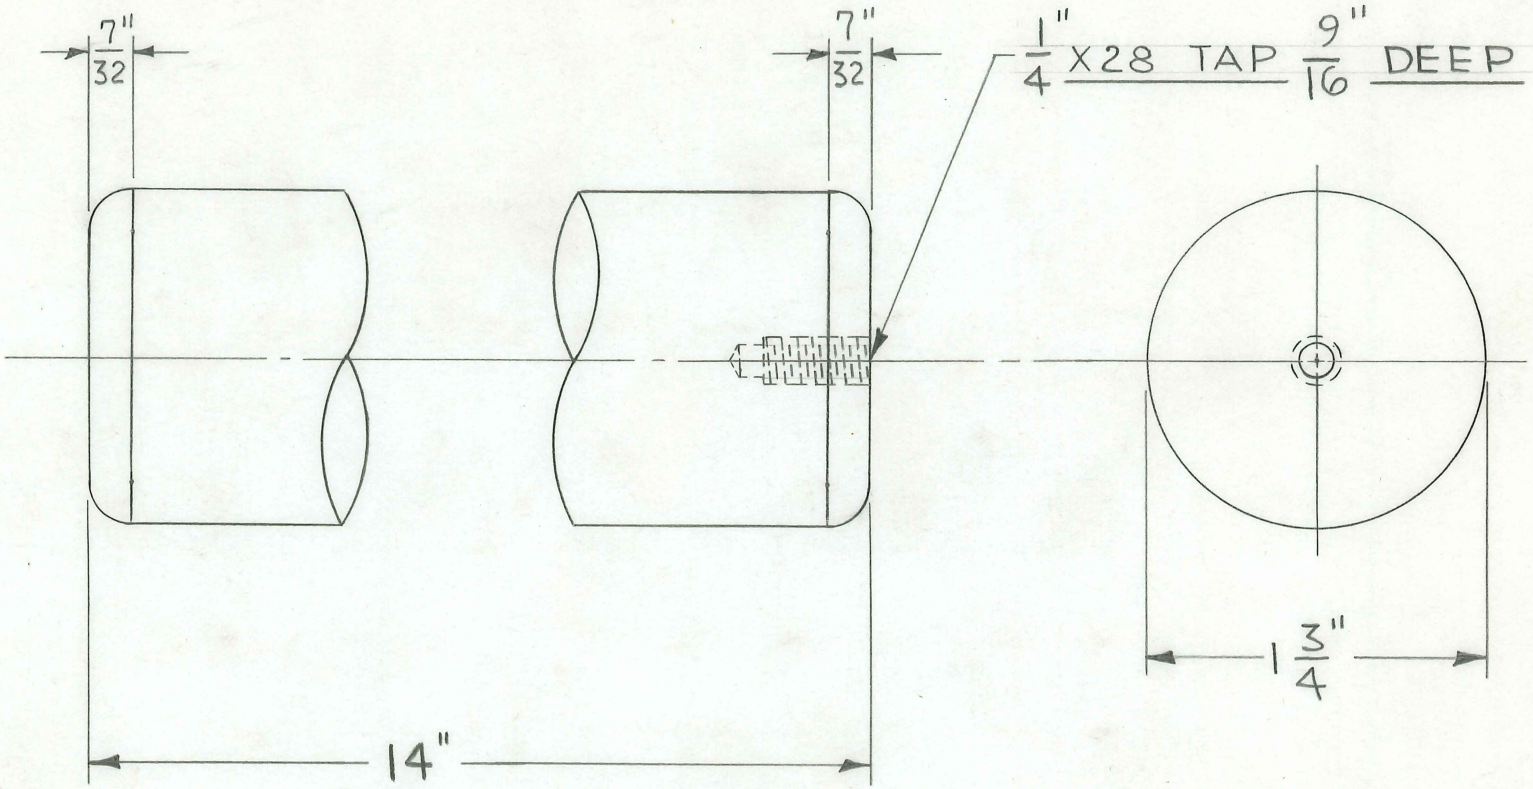

2 REQUIRED

FOLDER #134

TITLE
FISCHER WALL FRAME TILT. BUCKY STAND
8"X10" CASSETTE & GRID HOLDER SPRING

H. G. FISCHER & CO.
FRANKLIN PARK, ILLINOIS

PART NO. 17607

DATE 5-10-49 | DR. BY W.J. | CH'K'D. J.V.W

REVISION	DATE	BY

PATTERN | FINISH | SCALE FULL

TOOLS DRILL JIG # 11071
BENDING FIX. # 11072

MATERIAL
20 GA. (.032") PHOS. BRONZE

DIMENSIONS
FRACTIONAL ± .015
DECIMAL ± .005
ANGULAR ± ½°
UNLESS OTHERWISE SPECIFIED

DEVELOPED LENGTH 7 13/16"

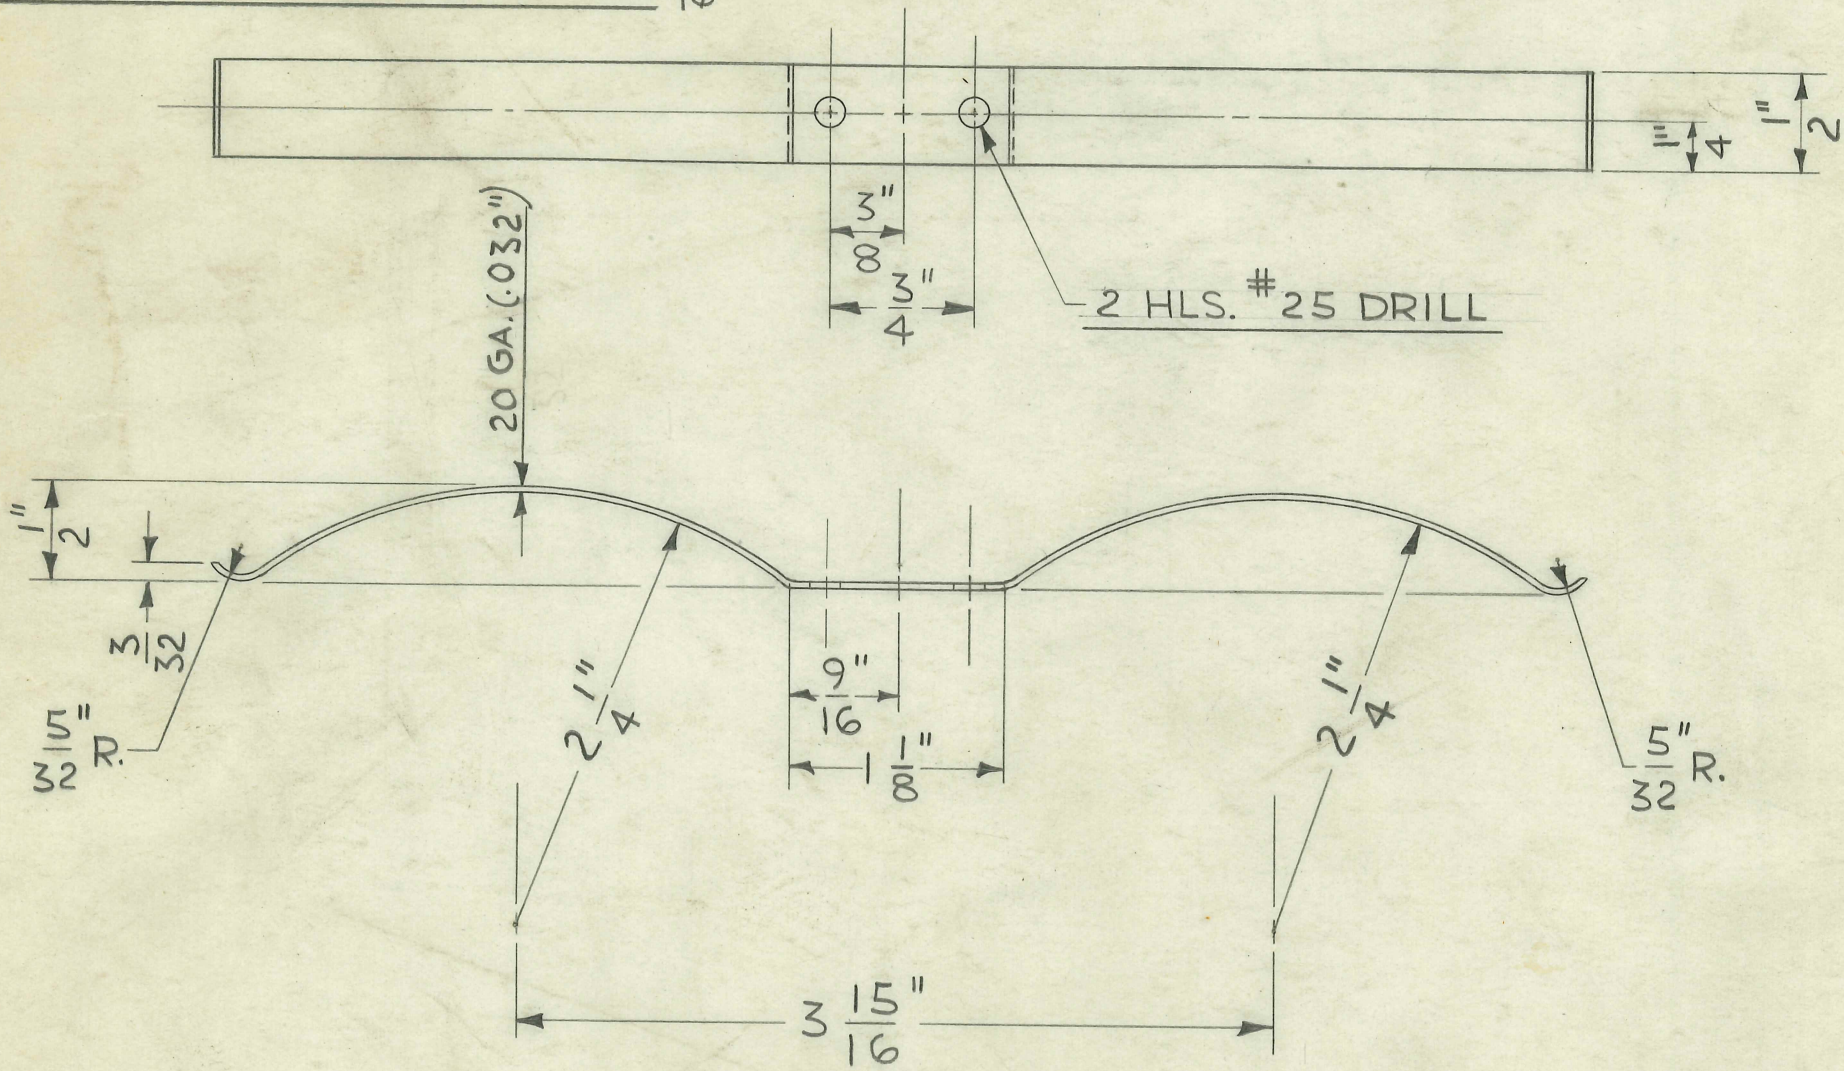

1 REQUIRED

FOLDER #134

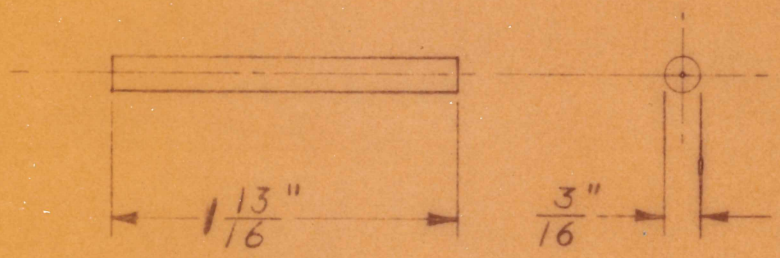

8 REQUIRED

DIMENSIONS
FRACTIONAL ± .015
DECIMAL ± .005
ANGULAR ± 1/2°
UNLESS OTHERWISE SPECIFIED

SIZE	3/16"	ISSUE 6-30-47	W.J.
KIND	C.R.STEEL	CHANGED	
SHAPE	ROD	"	
FINISH		"	
TEMP.		"	
PATT.		"	

TITLE:
FISCHER "PRECISION 200" X-RAY UNIT
BUCKY STAND COUNTERWEIGHT CLAMPING-PIN

H. G. FISCHER & CO.
2338 WABANSIA AVE.
CHICAGO, ILL.

CAT. NO.

PART NO. 17003

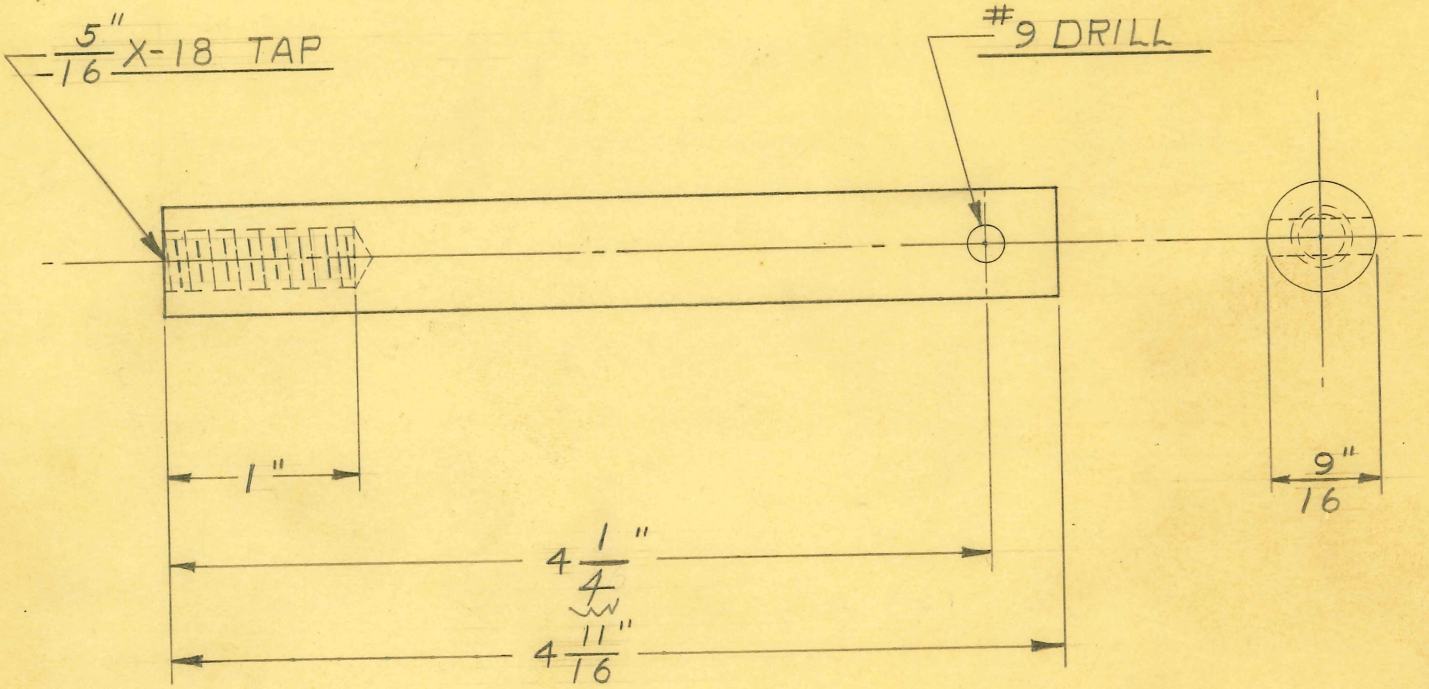

2 REQUIRED

DIMENSIONS	
FRACTIONAL	± .015
DECIMAL	± .005
ANGULAR	± ½°

UNLESS OTHERWISE SPECIFIED

Drill Jig Tool #9408

SIZE	9/16"	ISSUE 6-30-47	W.J.
KIND	C.R. STEEL	CHANGED	
SHAPE	ROD	"	
FINISH		"	
TEMP.		"	
PATT.		"	

TITLE: FISCHER "PRECISION 200" X-RAY UNIT
BUCKY STAND COUNTERWEIGHT CLAMPING END

H. G. FISCHER & CO.
2335 WABANSIA AVE.
CHICAGO, ILL.

CAT. NO.

PART NO. 17004

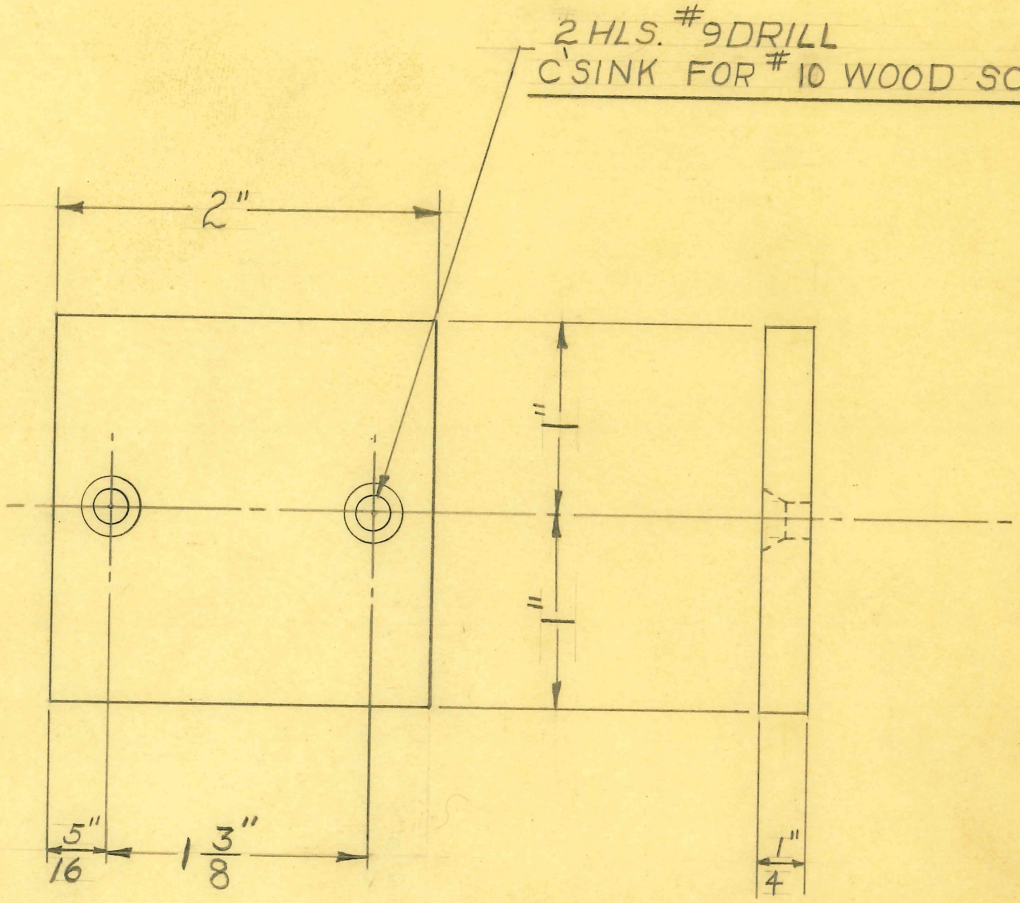

2 REQUIRED

DIMENSIONS
FRACTIONAL ±.015
DECIMAL ±.005
ANGULAR ±½°
UNLESS OTHERWISE SPECIFIED

DRILL JIG TOOL #9407

1/4" X 2" COLD ROLLED STEEL BAR

SIZE		ISSUE 6-25-47	W.J.
KIND		CHANGED	
SHAPE		"	
FINISH		"	
TEMP.		"	
PATT.		"	

TITLE:
FISCHER "PRECISION 200" X-RAY UNIT
BUCKY STAND LEVELING DEVICE FLOOR PAD

H. G. FISCHER & CO.
2335 WABANSIA AVE.
CHICAGO, ILL.

CAT. NO.

PART NO. 17005

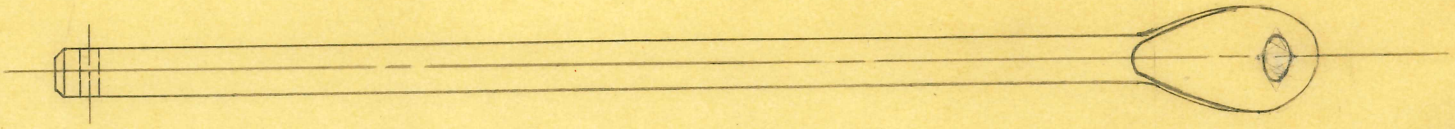

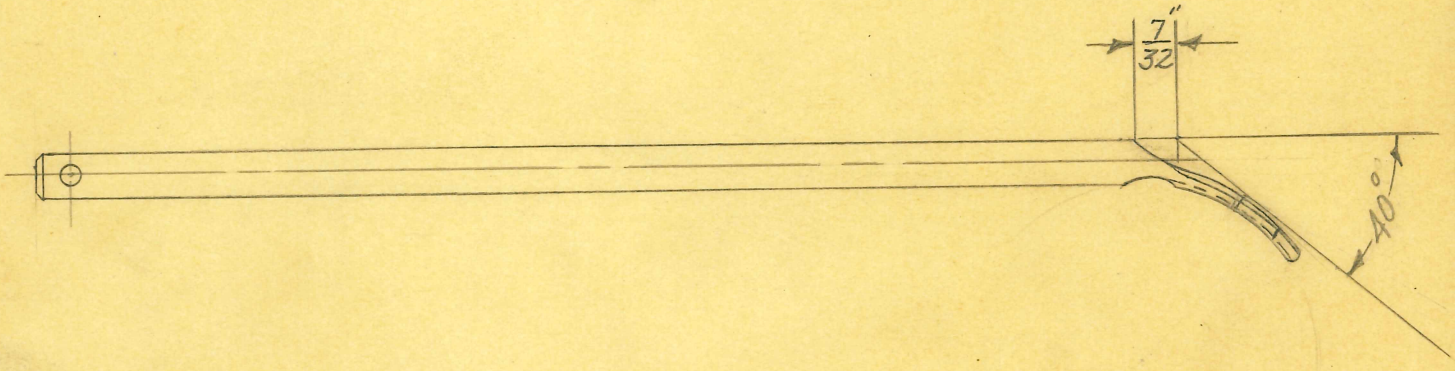

1 REQUIRED

BENDING FIXTURE TOOL #9476

SIZE		ISSUE 7-24-47	J.M.F.	TITLE: FISCHER "PRECISION 200" X RAY UNIT BUCKY STAND MIRROR SHAFT
KIND		CHANGED		
SHAPE		"		
FINISH		"		
TEMP.		"		
PATT.		"		

H. G. FISCHER & CO.
2335 WABANSIA AVE.
CHICAGO, ILL.

CAT. NO.

PART NO. 17006F

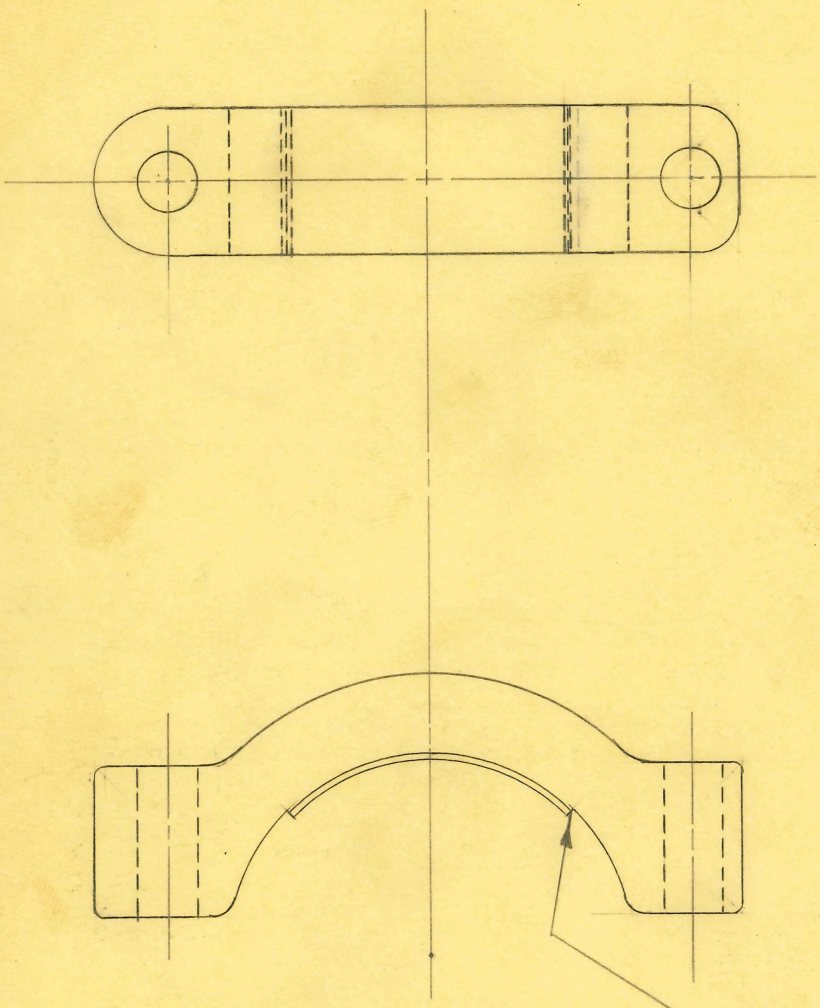

COAT MILLED SURFACE OF CASTING #16849 AND OUTSIDE FACE OF PCE. #17010 DRAWING MATERIAL WITH PCE. #16729 ADHESIVE. CLAMP TOGETHER IN FIXTURE AND LET DRY FOR 2 HOURS.

1 - REQUIRED

ASSEMBLY FIXTURE TOOL #9460

SIZE		ISSUE 9-26-47	J.M.F
KIND		CHANGED	
SHAPE		"	
FINISH		"	
TEMP.		"	
PATT.		"	

TITLE:
FISCHER PRECISION 200 X-RAY UNIT
BUCKY LOCK CLAMP PIECE ASSEM.

H. G. FISCHER & CO.
2335 WABANSIA AVE.
CHICAGO, ILL.

CAT. NO.

PART NO. 17008G

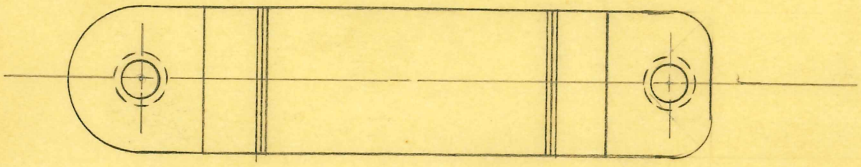

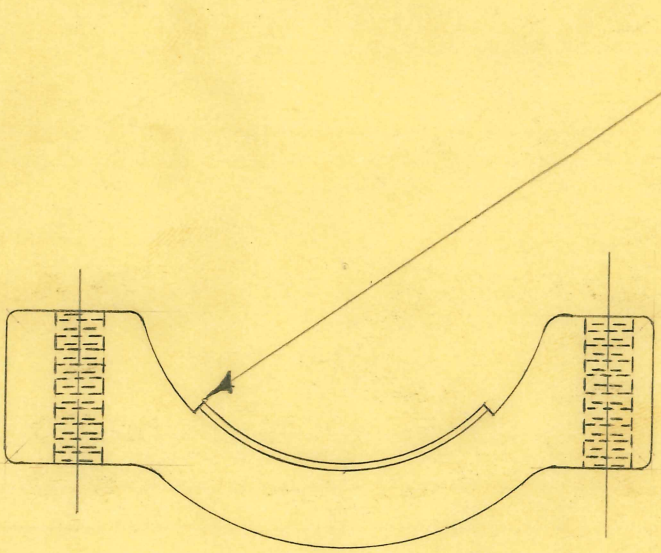

COAT MILLED SURFACE OF CASTING #16832F AND OUTSIDE FACE OF PCE. #17010 BRAKING MATERIAL WITH PCE. #16729 ADHESIVE. CLAMP TOGETHER IN FIXTURE AND LET DRY FOR TWO HOURS

1-REQUIRED

ASSEMBLY FIXTURE TOOL #9460

SIZE		ISSUE 9-26-47	J.M.F
KIND		CHANGED	
SHAPE		"	
FINISH		"	
TEMP.		"	
PATT.		"	

TITLE:
FISCHER "PRECISION 200" X-RAY UNIT
BUCKY LOCK CLAMP PIECE ASSEM.
TAPPED

H. G. FISCHER & CO.
2335 WABANSIA AVE.
CHICAGO, ILL.

CAT. NO.

PART NO. 17009G

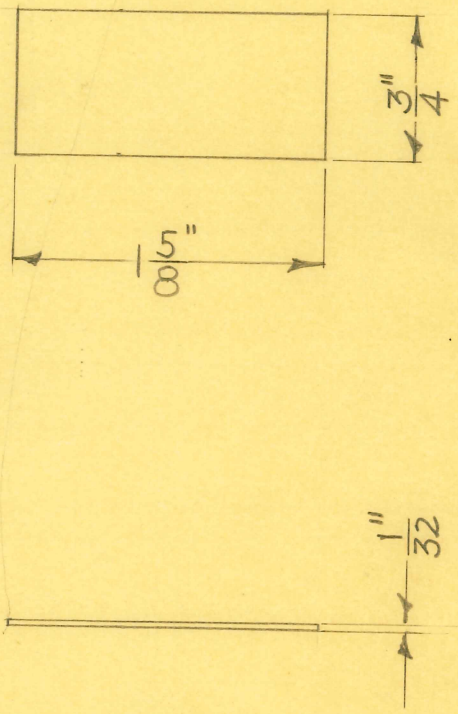

MATERIAL

1/32" #60S UNGRAPHITED SERVICE SHEET

2-REQUIRED

SIZE		ISSUE 9-26-47	J.M.F
KIND		CHANGED	
SHAPE		"	
FINISH		"	
TEMP.		"	
PATT.		"	

TITLE:
FISCHER PRECISION 200 X-RAY UNIT
BUCKY LOCK CLAMP PIECE

H. G. FISCHER & CO.
2335 WABANSIA AVE.
CHICAGO, ILL.

CAT. NO.

PART NO. 17010

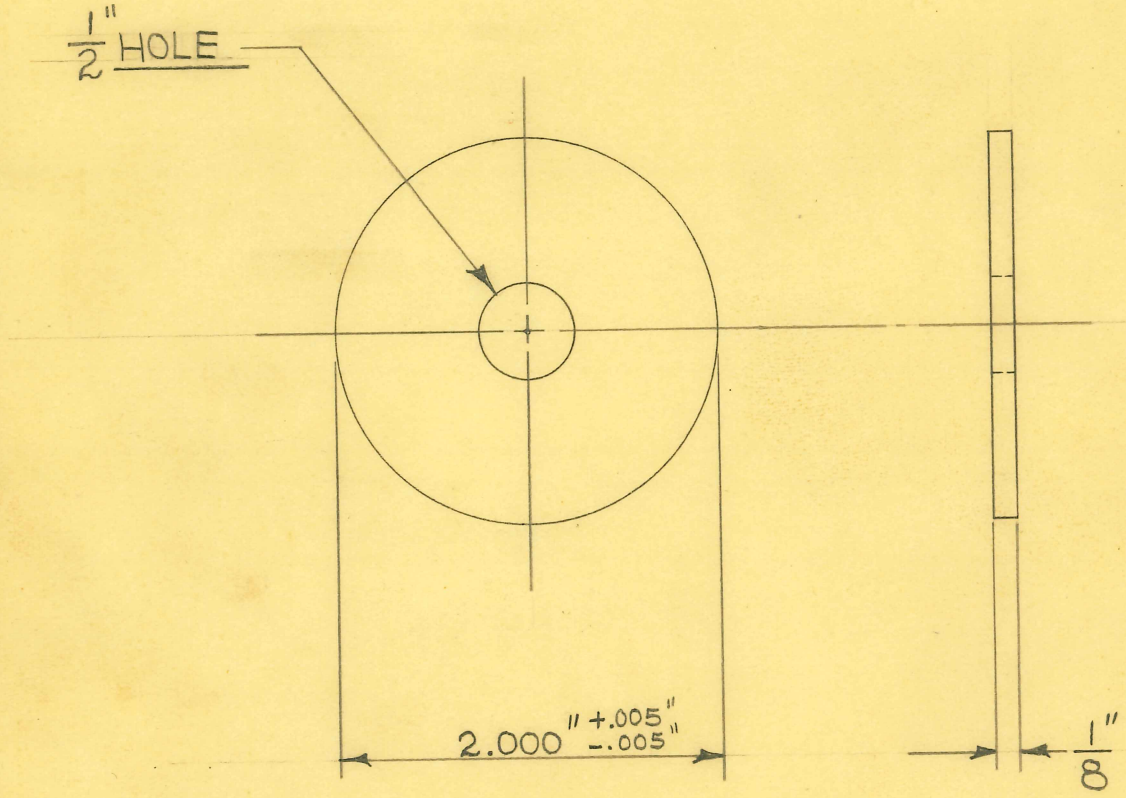

2 REQUIRED

DIMENSIONS	
FRACTIONAL	± .015
DECIMAL	± .005
ANGULAR	± 1/2°

UNLESS OTHERWISE SPECIFIED

SIZE	1/8"	ISSUE 11-17-47	W.J.
KIND	C.R. STEEL	CHANGED	
SHAPE	SHEET	"	
FINISH		"	
TEMP.		"	
PATT.		"	

TITLE: FISCHER PRECISION 200 X-RAY UNIT
BUCKY STAND CWT. BUMPER RETAINING PLATE

H. G. FISCHER & CO.
2335 WABANSIA AVE.
CHICAGO, ILL.

CAT. NO.

PART NO. 17011

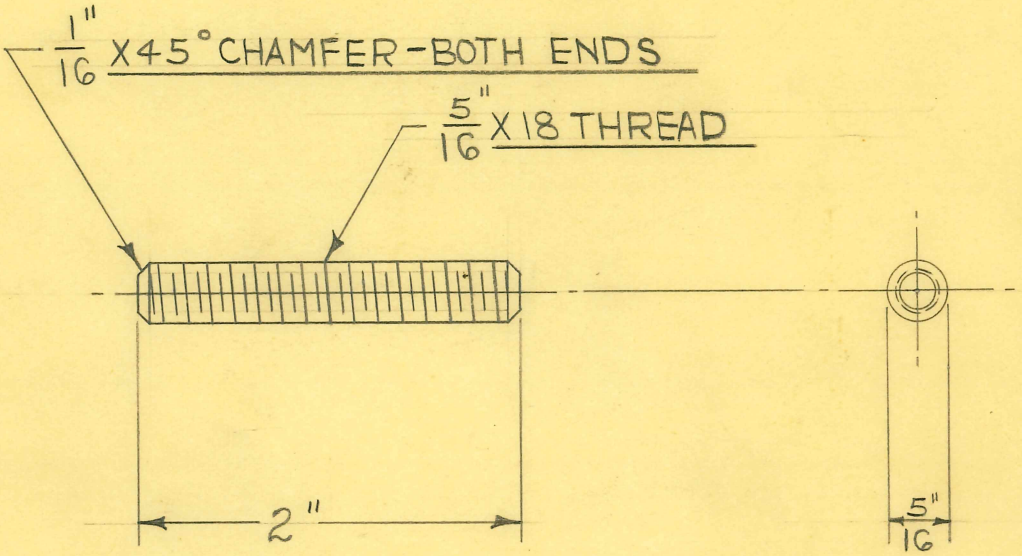

2 REQUIRED

DIMENSIONS	
FRACTIONAL	± .015
DECIMAL	± .005
ANGULAR	± 1/2°

UNLESS OTHERWISE SPECIFIED

SIZE	5/16" DIA.	ISSUE 11-17-47	W. J.
KIND	C.R. STEEL	CHANGED	
SHAPE		"	
FINISH		"	
TEMP.		"	
PATT.		"	

TITLE:

FISCHER PRECISION 200 X-RAY UNIT
5/16" X 18 THD. X 2" LONG STUD

H. G. FISCHER & CO.
2338 WABANSIA AVE.
CHICAGO, ILL.

CAT. NO.

PART NO. 17012

TITLE
FISCHER RF-100 X-RAY UNIT
SPOTOGRAPH HOOK BRACKET

H. G. FISCHER & CO.
FRANKLIN PARK, ILLINOIS

PART NO. 17014

REVISION	DATE	BY

DATE 10-25-48 DR. BY W. J. CH'K'D. J.V.W.

PATTERN | FINISH | SCALE FULL

DIMENSIONS
FRACTIONAL ± .015
DECIMAL ± .005
ANGULAR ± ½°
UNLESS OTHERWISE SPECIFIED

TOOLS
CUT OFF DIE # 3045

MATERIAL
1/8" X 5/8" FLAT WIRE

BREAK SHARP EDGES

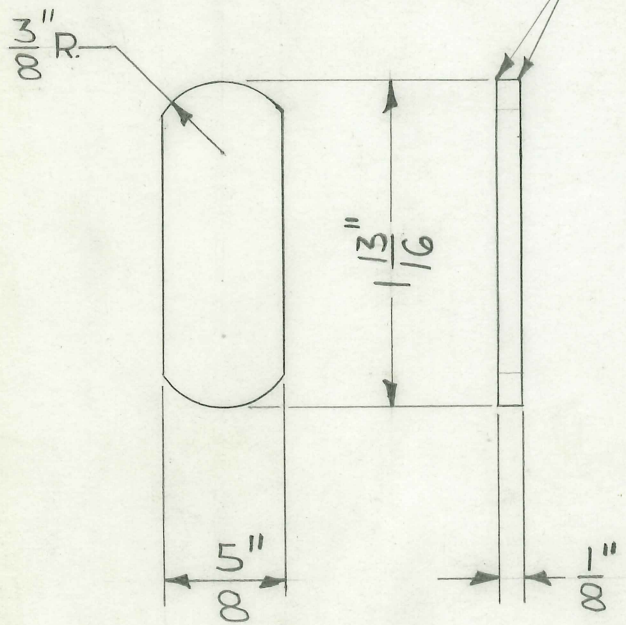

DEVELOPMENT

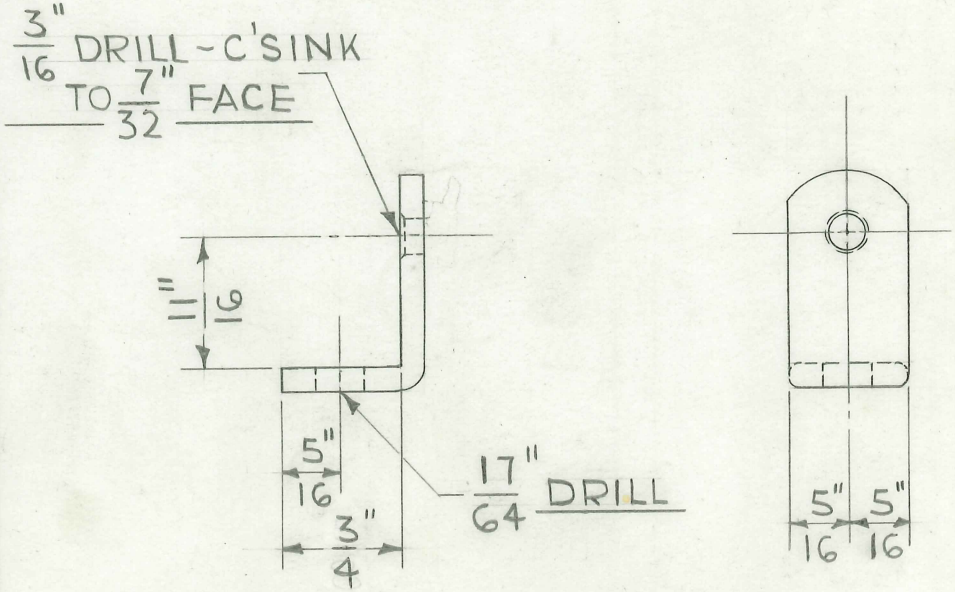

1 REQUIRED

FOLDER #107

TITLE
FISCHER RF-100 X-RAY UNIT
SPOTOGRAPH HOOK BRACKET ASSEM.

H. G. FISCHER & CO.
FRANKLIN PARK, ILLINOIS

PART NO. 17015G

DATE 10-29-48 DR. BY W. J. CH'K'D.

REVISION	DATE	BY

PATTERN | FINISH CAD. # 23 | SCALE FULL

TOOLS | MATERIAL

DIMENSIONS
FRACTIONAL ± .015
DECIMAL ± .005
ANGULAR ± ½°
UNLESS OTHERWISE SPECIFIED

INSERT PIN INTO BRACKET & RIVET THIS END OF PIN OVER FLUSH WITH BRACKET

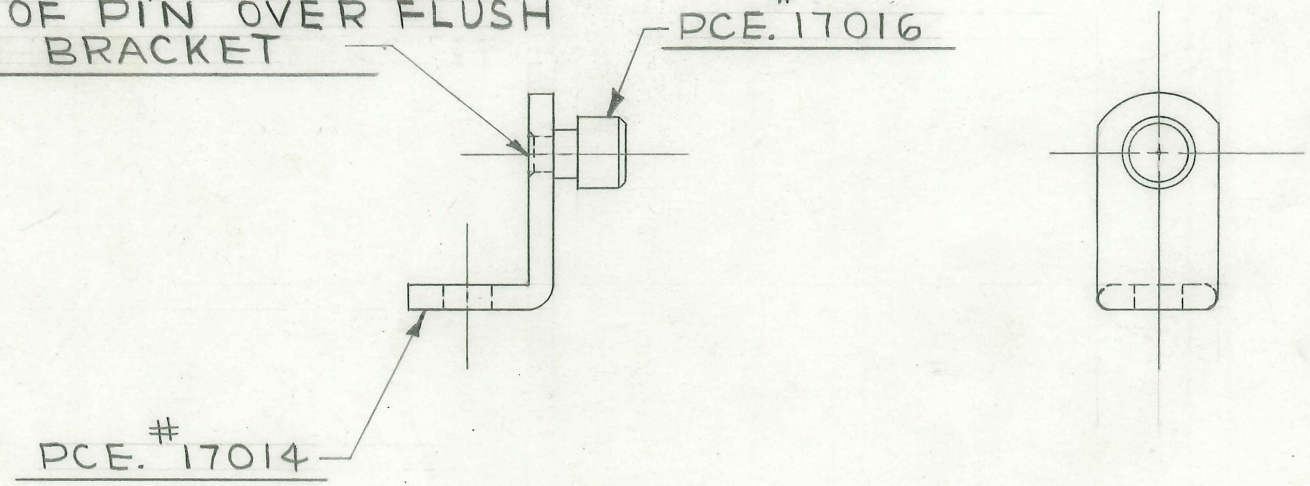

1 REQUIRED

FOLDER #107

TITLE

FISCHER "RF-100" X-RAY UNIT
HOOK RETAINING PIN

H. G. FISCHER & CO.
FRANKLIN PARK, ILLINOIS

PART NO. 17016

DATE 10-25-48 | DR. BY W.J. | CH'K'D.

REVISION	DATE	BY

PATTERN | FINISH | SCALE FULL

TOOLS | MATERIAL 3/8" DIA. C.R. STEEL

DIMENSIONS
FRACTIONAL ± .015
DECIMAL ± .005
ANGULAR ± ½°
UNLESS OTHERWISE SPECIFIED

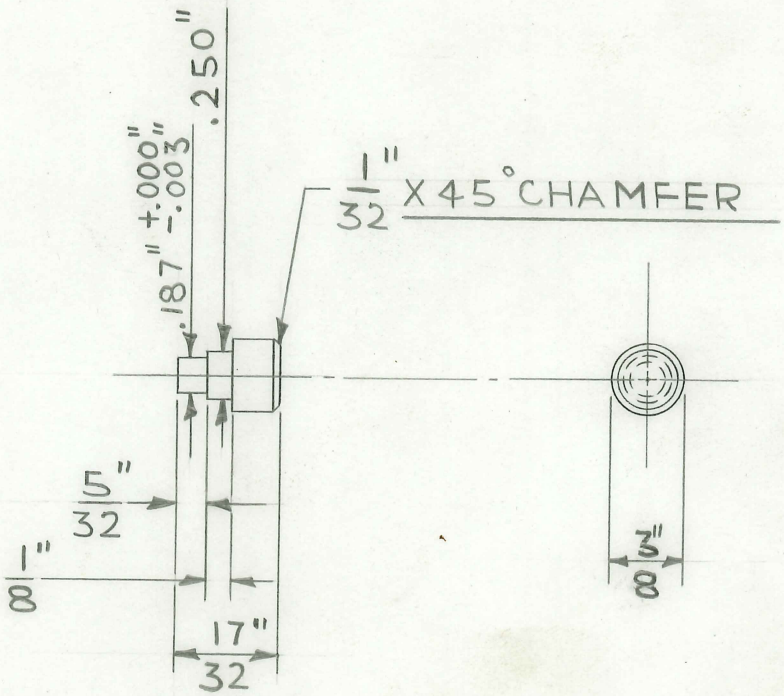

1 REQUIRED

FOLDER #107

TITLE: FISCHER DELUXE "RF-250" X-RAY AUTO TRANSF. CLAMP MTG. PIECE

H. G. FISCHER & CO.
FRANKLIN PARK, ILLINOIS

PART NO. 17021A

DATE 12-20-48 DR. BY J.V.W. CH'K'D.

REVISION		DATE	BY
A	WAS .312"	5-23-49	W.J
B	" 3"	"	W.J.

PATTERN | FINISH | SCALE FULL

TOOLS: DRILL JIG # 10041

MATERIAL: 3/8" X 1 1/2" C.R. STEEL BAR

DIMENSIONS UNLESS OTHERWISE SPECIFIED
FRACTIONAL ± .015
DECIMAL ± .005
ANGULAR ± ½°

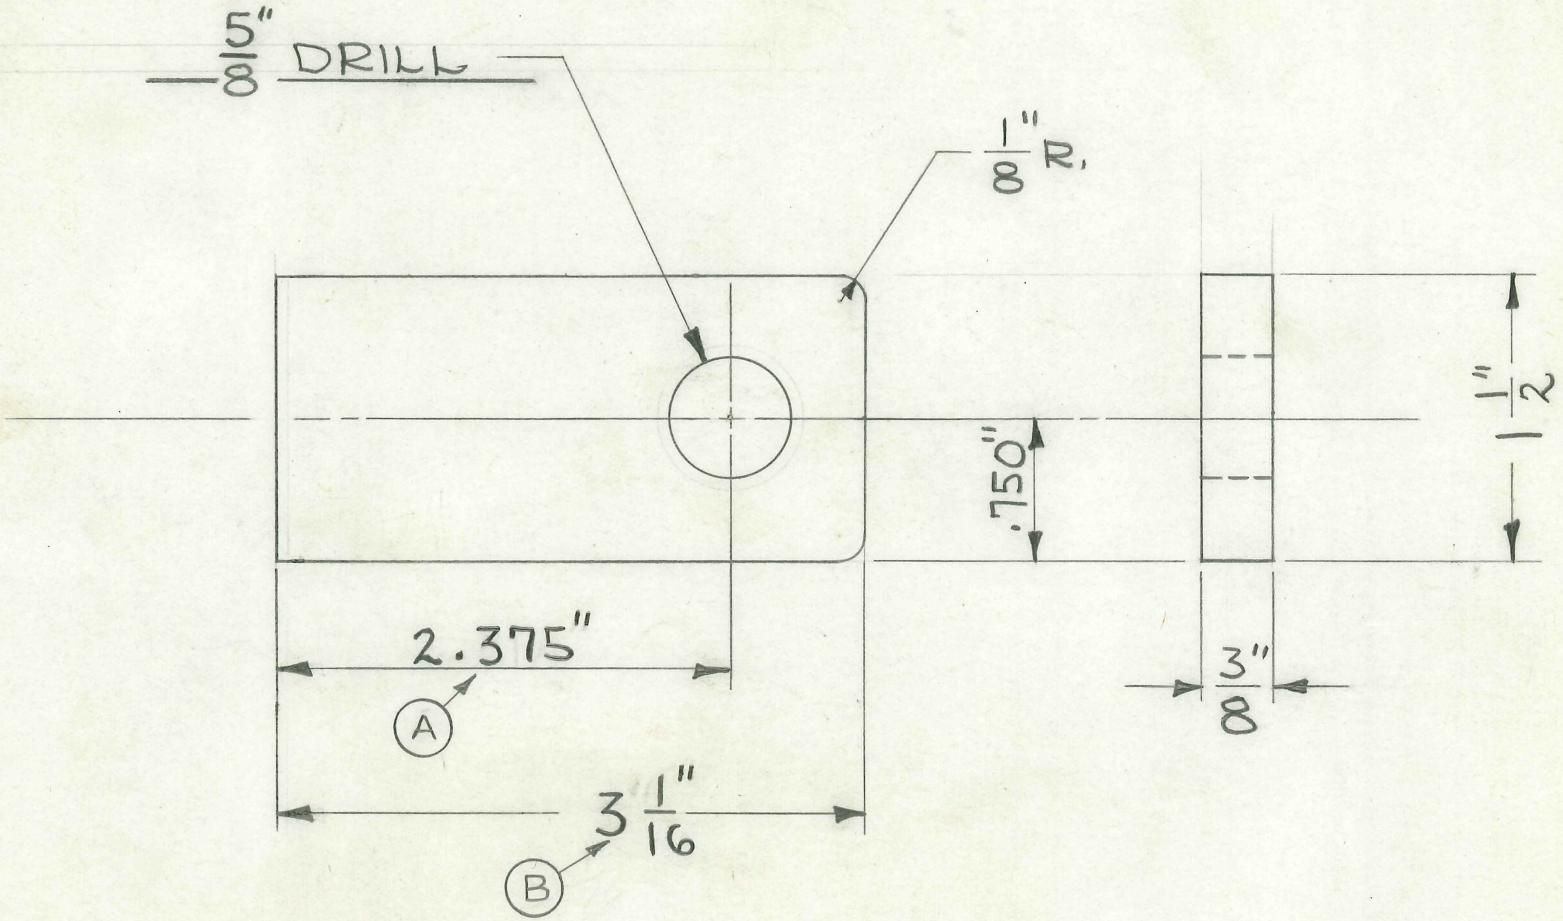

4 REQUIRED

FOLDER # 138

TITLE FISCHER DELUXE "RF-250" X-RAY AUTO TRANSF. CLAMPING PAD

H. G. FISCHER & CO.
FRANKLIN PARK, ILLINOIS

PART NO. 17022

DATE 12-20-48 DR. BY J.V.W. CH'K'D.

REVISION	DATE	BY

PATTERN | FINISH | SCALE FULL

TOOLS | MATERIAL $\frac{1}{8}$" SHEET BLACK FIBRE

DIMENSIONS
FRACTIONAL ± .015
DECIMAL ± .005
ANGULAR ± ½°
UNLESS OTHERWISE SPECIFIED

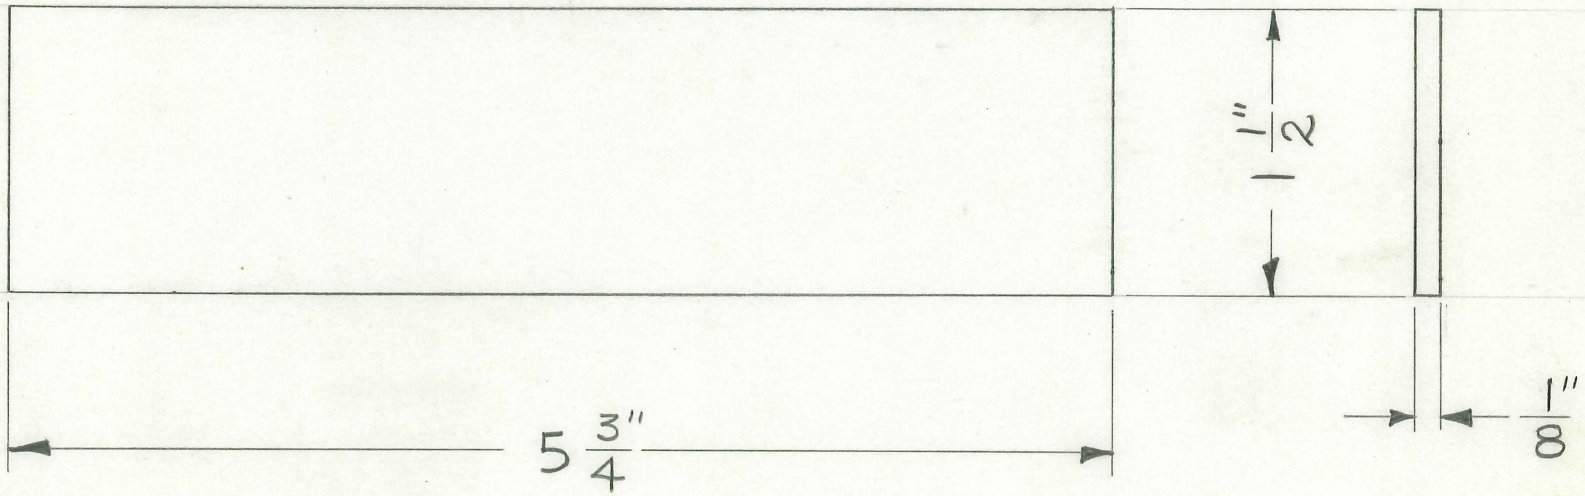

4 REQUIRED

FOLDER # 138

TITLE: SPRING, 1" x 1½" LONG

H. G. FISCHER, INC.
FRANKLIN PARK, ILLINOIS

PART No. 17646

DATE: 1/20/75 | DR. BY: TT | CH'K'D:

REVISION: 1/ ECO 0380 1/20/75 TT

FINISH: CAD. #123

SCALE: 1" = 1"

MATERIAL: PURCHASE

DIMENSIONS UNLESS OTHERWISE SPECIFIED

.X	± .030
.XX	± .010
.XXX	± .005
ANGULAR	± 1/2°

USED ON:	AMT
17824G	1

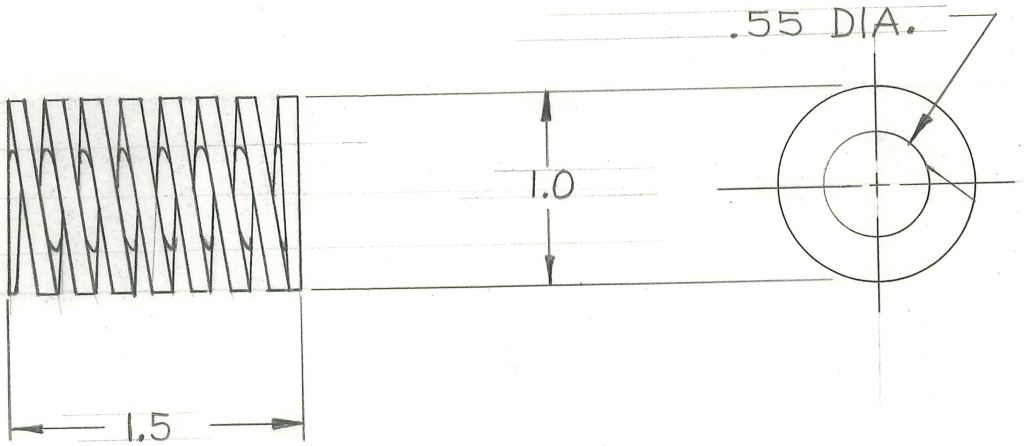

TITLE FISCHER WALL FRAME TILTING BUCKY STAND - SPRING LOCK BODY

H. G. FISCHER & CO.
FRANKLIN PARK, ILLINOIS

PART NO. 17647A

DATE 8-2-62 | DR BY E.M. | CH'K'D. RCT

REVISION	DATE	BY

PATTERN | FINISH CAD. #23 | SCALE FULL

DIMENSIONS
FRACTIONAL ± .015
DECIMAL ± .005
ANGULAR ± ½°
UNLESS OTHERWISE SPECIFIED

TOOLS DRILL JIG #13254
MILLING FIX. #10038

MATERIAL 1¼" DIA. BRASS ROD

USED ON	NO. REQ.
17823 G	1
17824 G	1

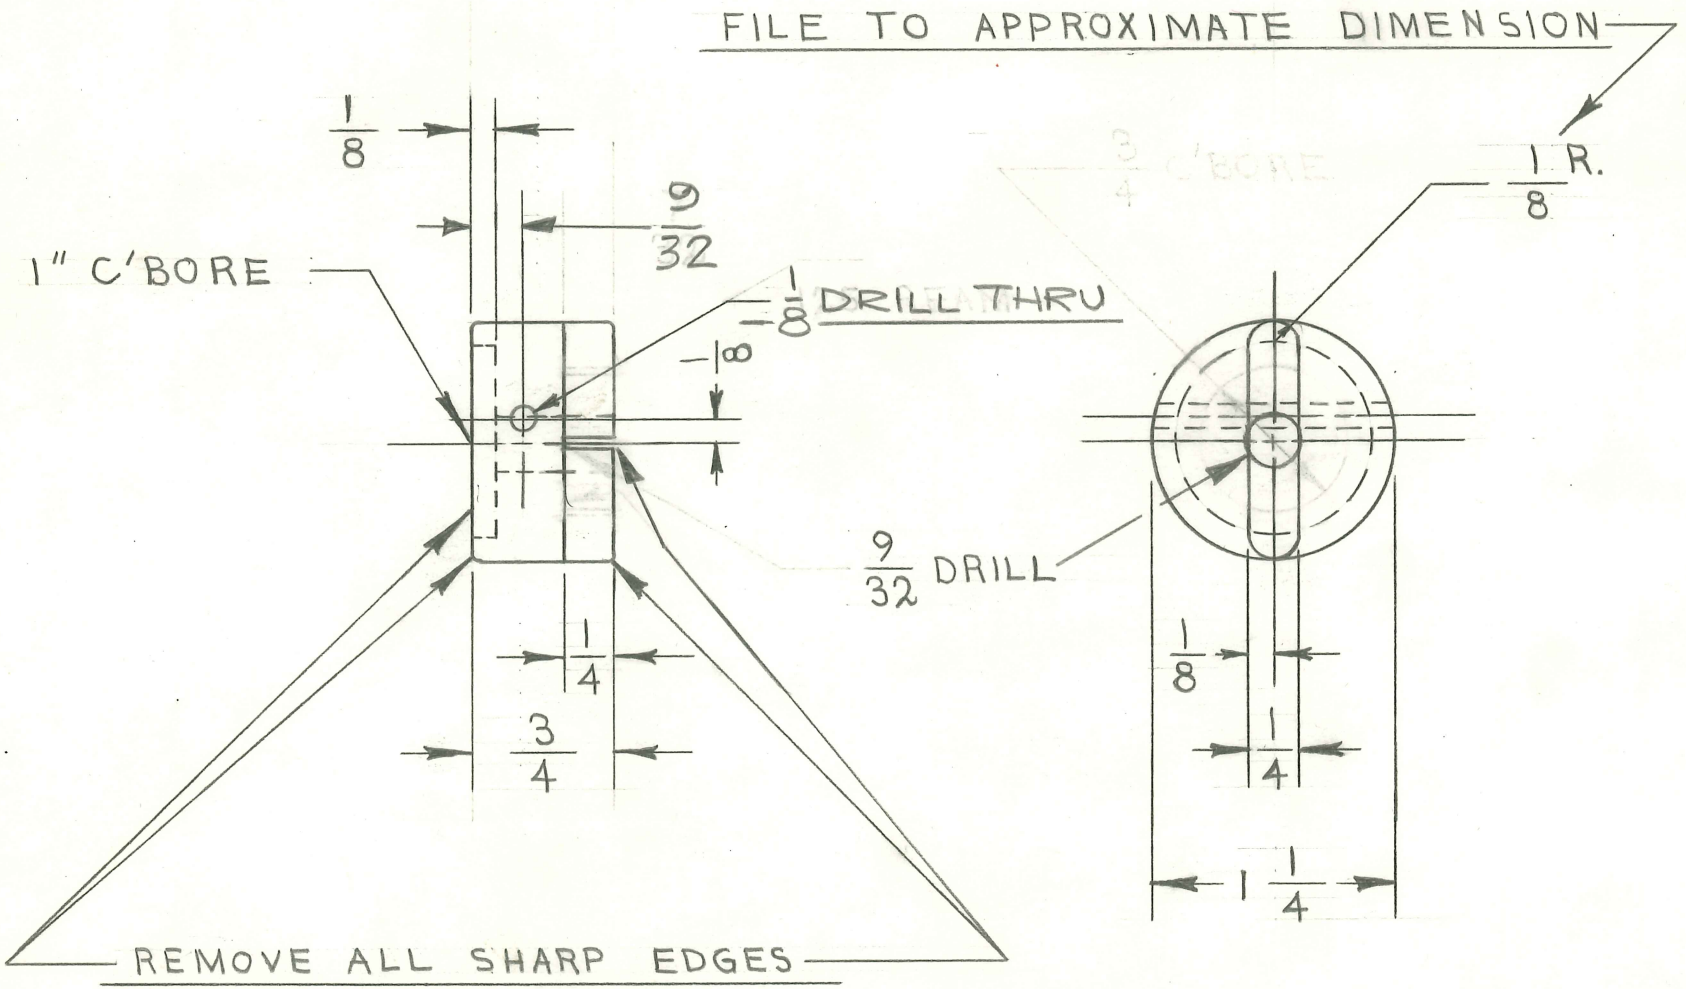

FOLDER 134

TITLE: FISCHER WALL FRAME TILTING BUCKY STAND - SPRING LOCK SHAFT

H. G. FISCHER & CO.
FRANKLIN PARK, ILLINOIS

PART NO. 17648 A

DATE 8-2-62 | DR BY E.M. | CH'K'D. RCT

REVISION	DATE	BY

PATTERN | FINISH CAD. # 23 | SCALE FULL

DIMENSIONS
FRACTIONAL ± .015
DECIMAL ± .005
ANGULAR ± ½°
UNLESS OTHERWISE SPECIFIED

TOOLS: DRILL JIG # 13255

MATERIAL: ¼" DIA. C.R. STEEL ROD

CINTIMATIC VISE JAWS #14627

USED ON	NO. REQ.
17823G	1
17824G	1

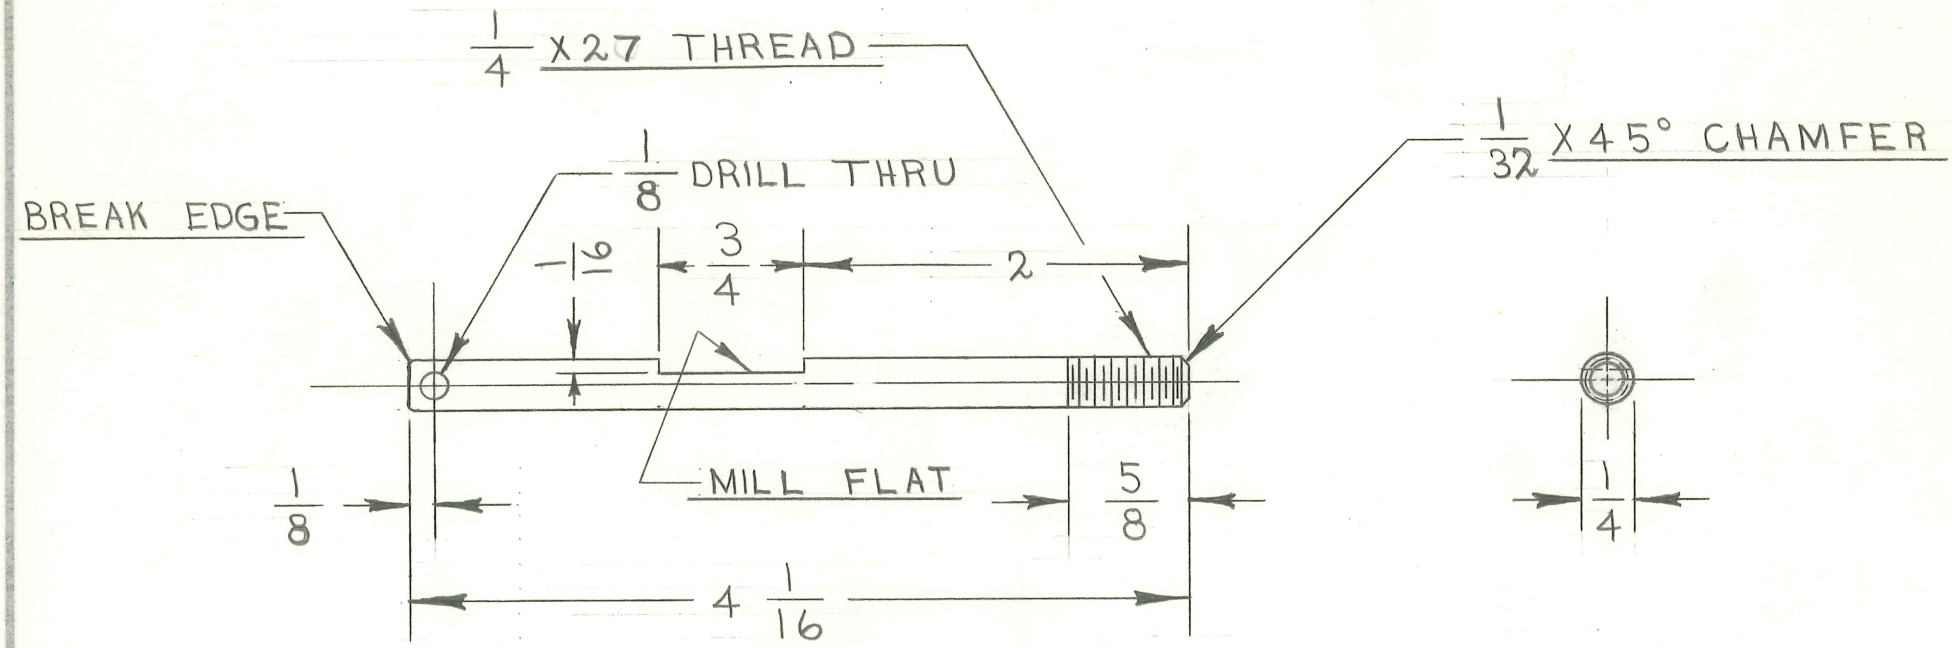

FOLDER 134

TITLE
FISCHER WALL FRAME TILTING BUCKY STAND
SPRING LOCK CAP

H. G. FISCHER & CO.
FRANKLIN PARK, ILLINOIS

PART NO. 17649

DATE 12-23-48 DR. BY W. J. CH'K'D. J.V.W.

REVISION	DATE	BY

PATTERN | FINISH CAD. #23 | SCALE FULL

TOOLS BOX TOOL SECTION
FORM TOOL #17649

MATERIAL 1 1/4" DIA. BRASS ROD

DIMENSIONS
FRACTIONAL ± .015
DECIMAL ± .005
ANGULAR ± ½°
UNLESS OTHERWISE SPECIFIED

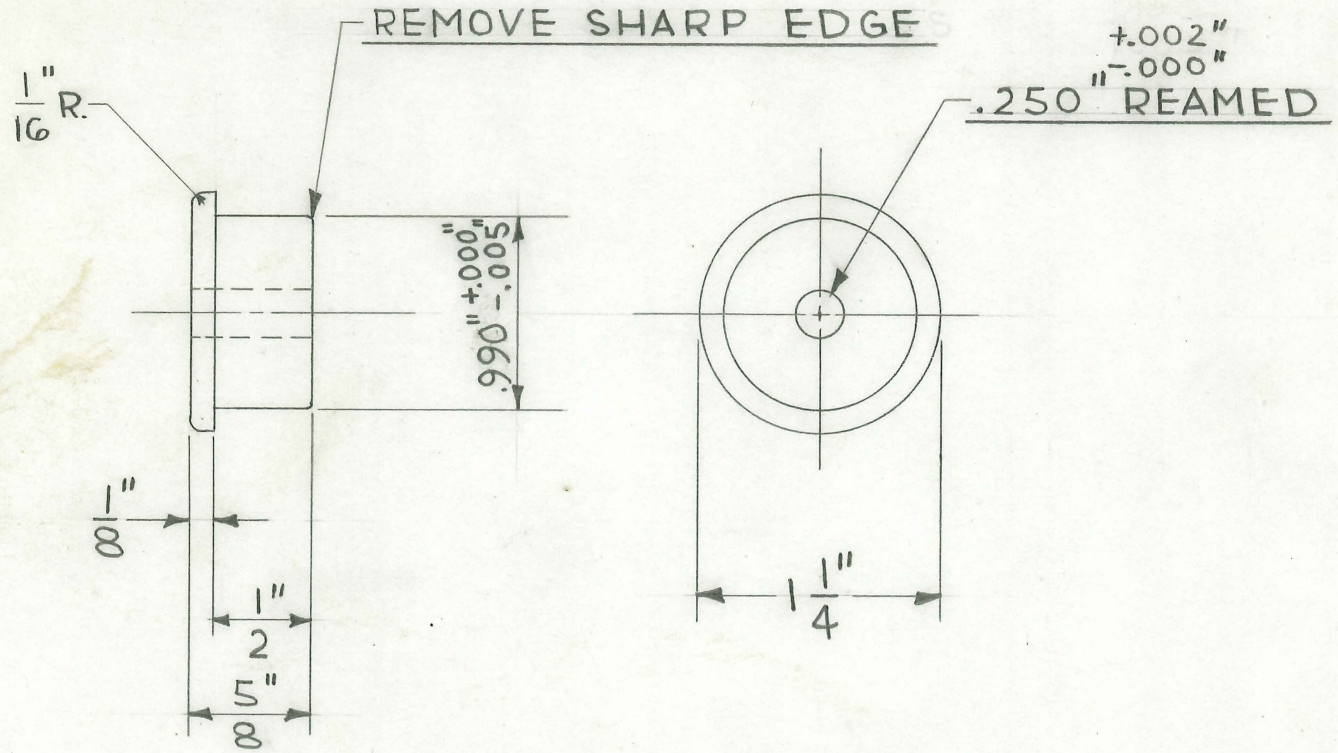

1 REQUIRED

FOLDER #134

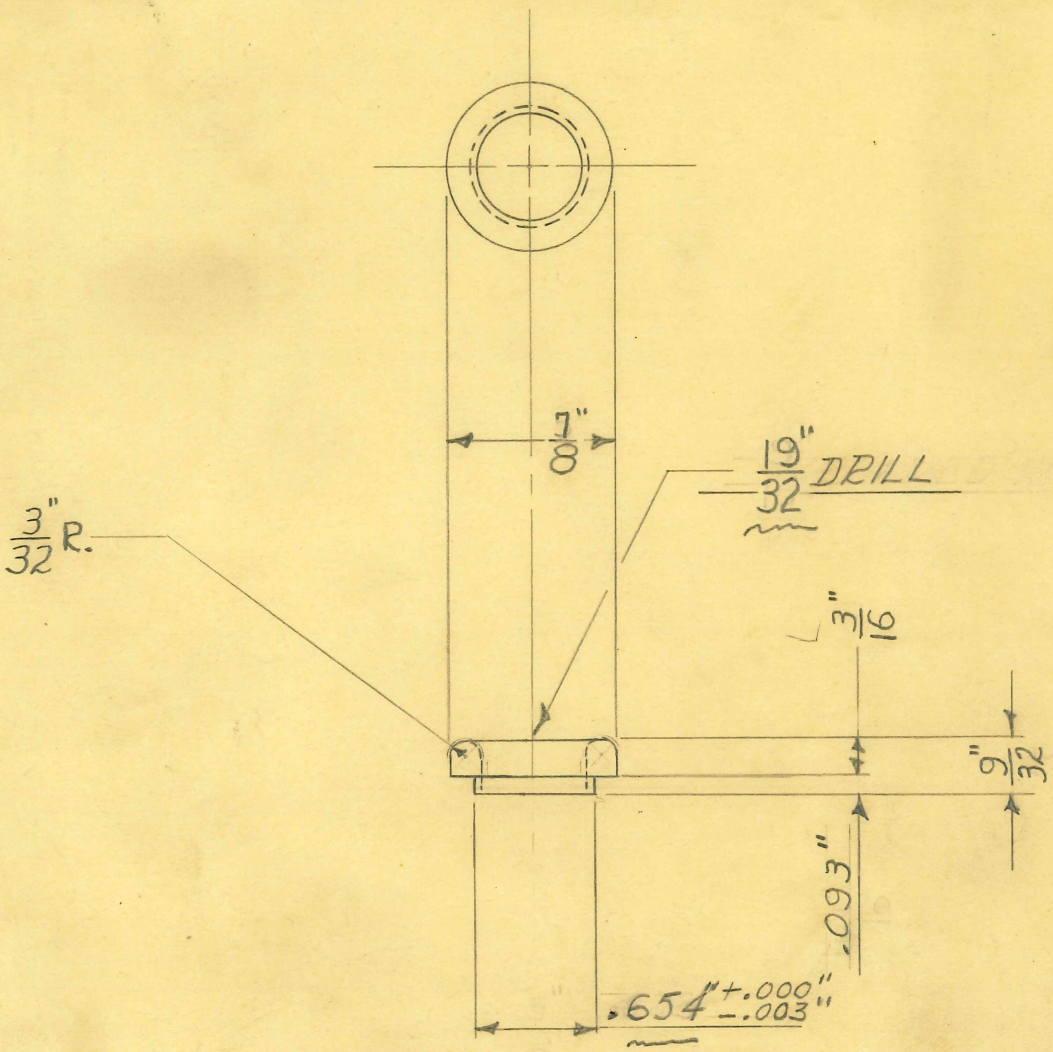

1-REQUIRED

DIMENSIONS	
FRACTIONAL	± .015
DECIMAL	± .005
ANGULAR	± 1/2°

UNLESS OTHERWISE SPECIFIED

SIZE	7/8" DIAM	ISSUE 11-24-47	J.M.F
KIND	C.R. STEEL	CHANGED	
SHAPE	ROD	"	
FINISH		"	
TEMP.		"	
PATT.		"	

TITLE: FISCHER DELUXE "RF-100" X-RAY CONTROL CABINET OUTLET PLATE CORD BUSHING FILAMENT

H. G. FISCHER & CO.
2335 WABANSIA AVE.
CHICAGO, ILL.

CAT. NO.

PART NO. 17110

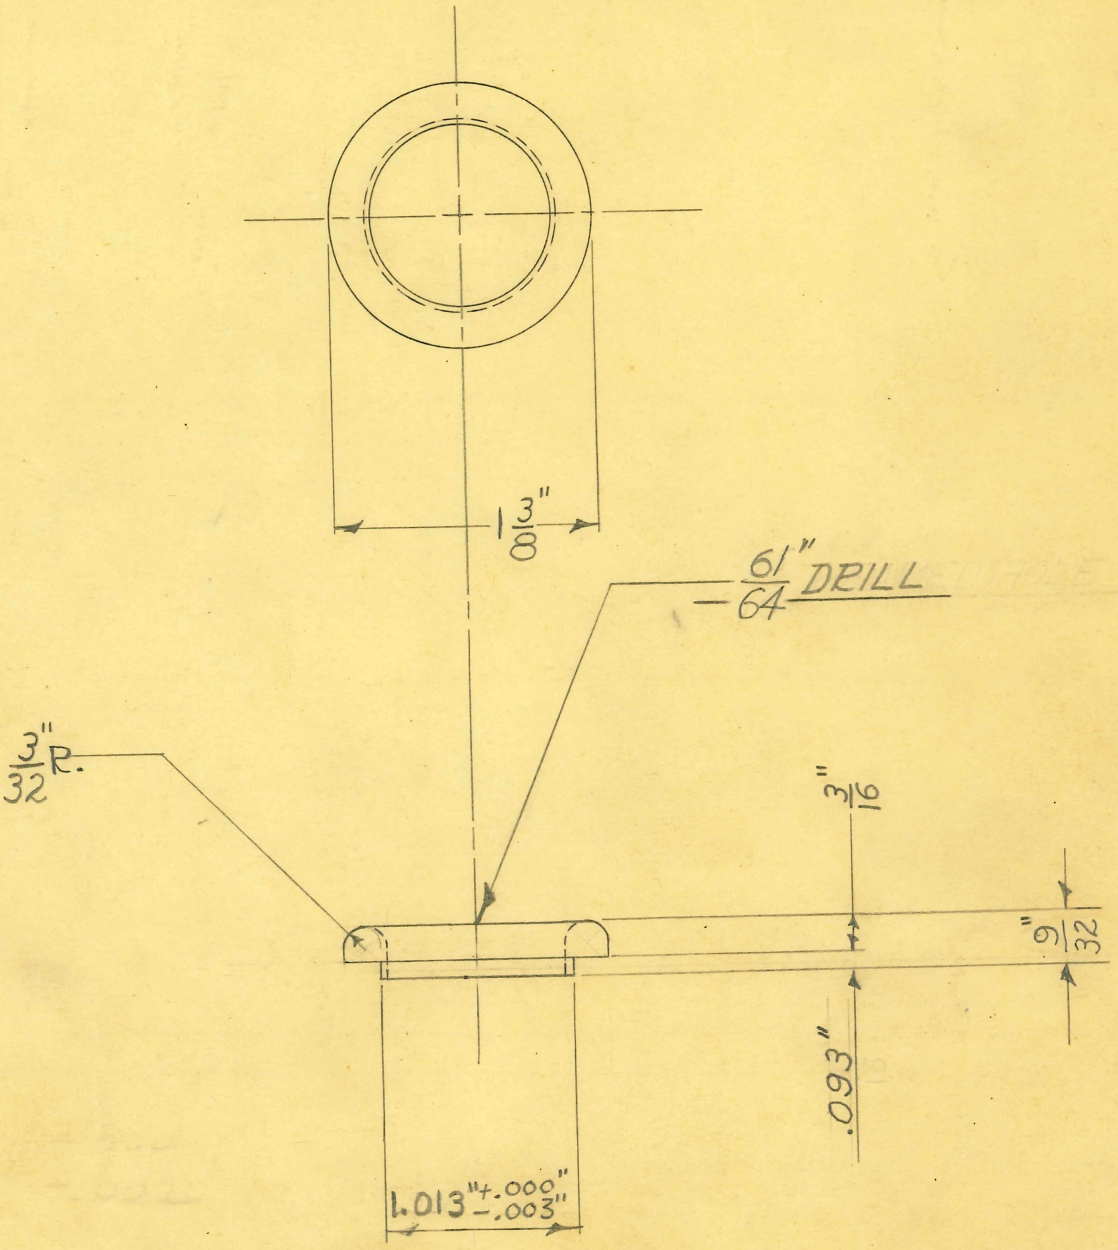

1-REQUIRED

DIMENSIONS	
FRACTIONAL	± .015
DECIMAL	± .005
ANGULAR	± 1/2°
UNLESS OTHERWISE SPECIFIED	

SIZE	1 3/8" DIAM.	ISSUE 11-24-47	J.M.F
KIND	C.R. STEE	CHANGED	
SHAPE	ROD	"	
FINISH		"	
TEMP.		"	
		"	

TITLE: FISCHER DELUXE "RF-100" X-RAY CONTROL CABINET OUTLET PLATE CORD BUSHING LINE

H. G. FISCHER & CO.
2335 WABANSIA AVE.
CHICAGO, ILL.

CAT. NO.

PART NO. 17112

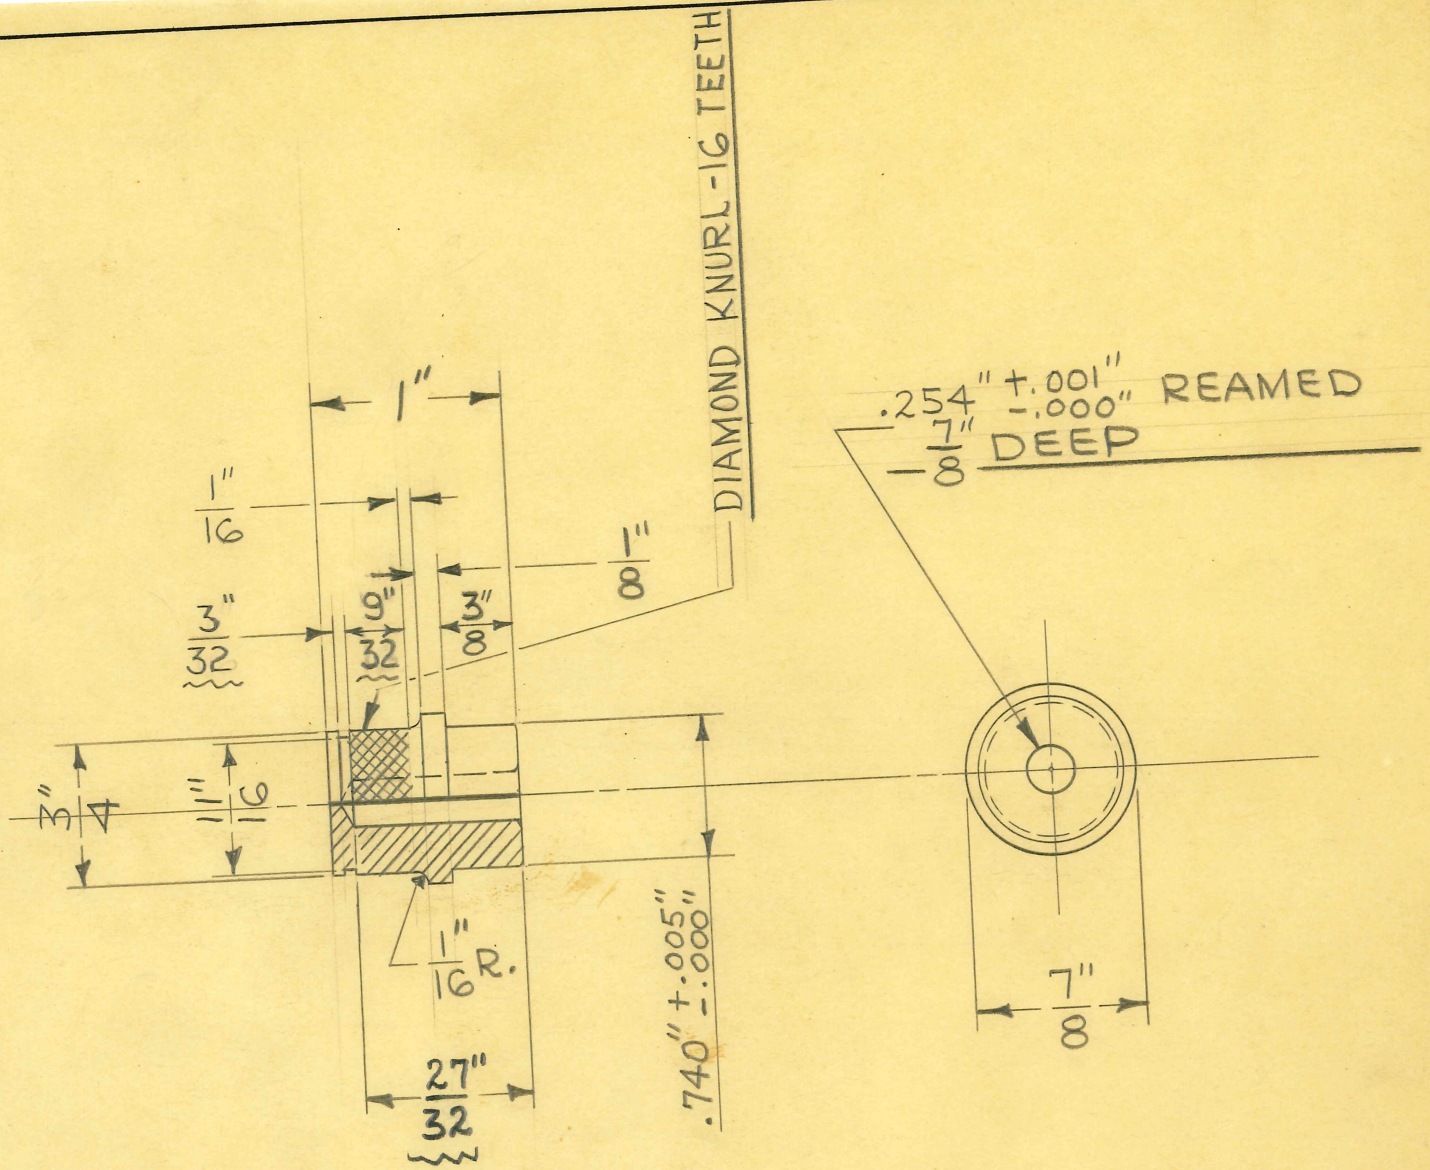

1 REQUIRED

DIMENSIONS	
FRACTIONAL	± .015
DECIMAL	± .005
ANGULAR	± 1/2°

UNLESS OTHERWISE SPECIFIED

FLAT FORM TOOL # 9648

SIZE	7/8" DIA.	ISSUE 1-12-48	J.V.W.	TITLE: FISCHER DELUXE "RF-100" X-RAY CONTROL KNOB INSERT
KIND	BRASS ROD	CHANGED		
SHAPE		"		
FINISH	CAD.#23	"		
TEMP.		"		
BATT		"		

H. G. FISCHER & CO.
2335 WABANSIA AVE.
CHICAGO, ILL.

CAT. NO.

PART NO. 17116

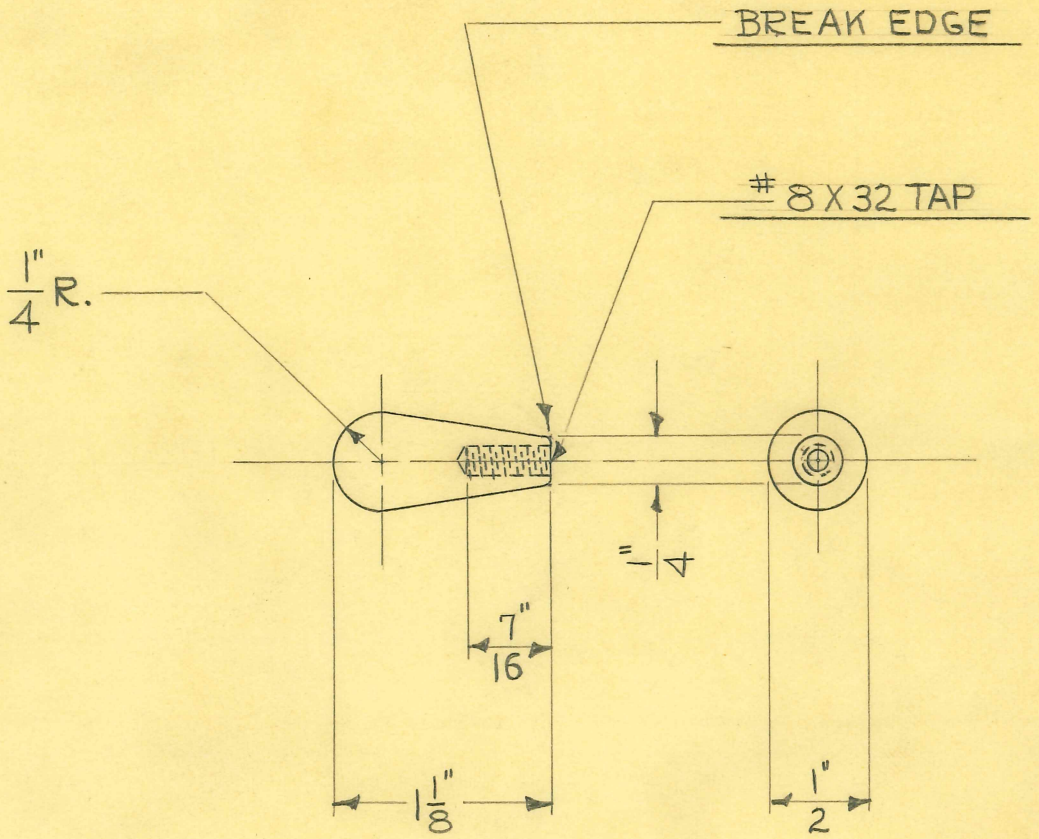

2-REQUIRED

1/2" DIA. POLISHED HARD RUBBER ROD

DIMENSIONS	
FRACTIONAL	± .015
DECIMAL	± .005
ANGULAR	± 1/2°

UNLESS OTHERWISE SPECIFIED

SIZE		ISSUE 1-21-48	J.M.F
KIND		CHANGED	
SHAPE		"	
FINISH	POLISH	"	
TEMP.		"	
PATT.		"	

TITLE:
FISCHER DELUXE RF-100 X-RAY UNIT
SWITCH HANDLE

H. G. FISCHER & CO.
2335 WABANSIA AVE.
CHICAGO. ILL.

CAT. NO.

PART NO. 17117

TITLE: FISCHER DELUXE "RF-250" X-RAY AUTO TRANSF. CLAMP STUD

H. G. FISCHER & CO.
FRANKLIN PARK, ILLINOIS

PART NO. 17118A

DATE 12-20-48 DR. BY J.V.W. CH'K'D.

REVISION	DATE	BY

PATTERN | FINISH | SCALE FULL

TOOLS | MATERIAL: $\frac{5}{16}$" DIA. C.R. STEEL (SCREW STK.)

DIMENSIONS UNLESS OTHERWISE SPECIFIED
FRACTIONAL ± .015
DECIMAL ± .005
ANGULAR ± ½°

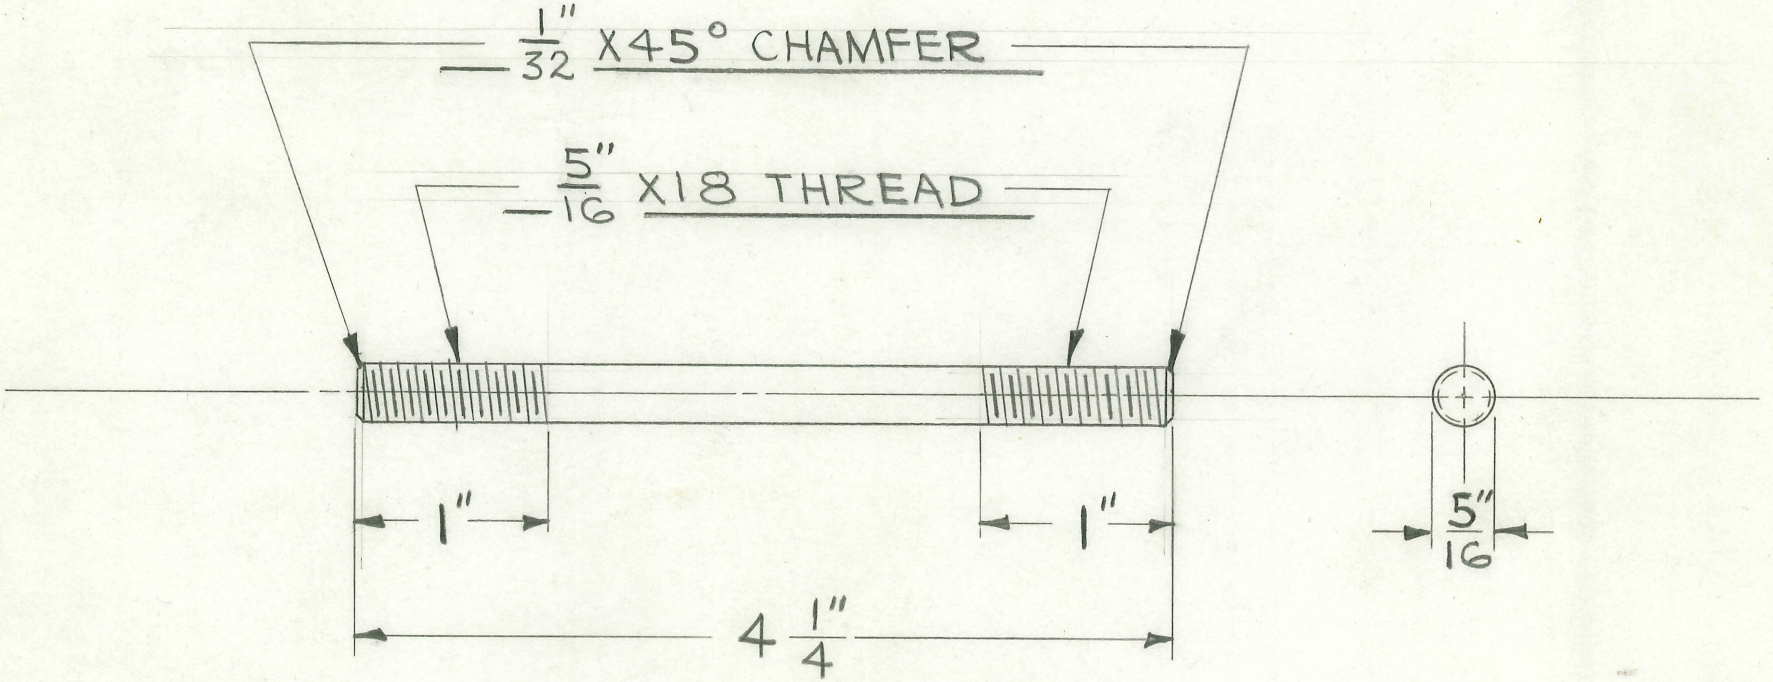

4 REQUIRED

FOLDER #138

TITLE
FISCHER DELUXE "RF-250" X-RAY SPACE CHARGE SWITCH

H. G. FISCHER & CO.
FRANKLIN PARK, ILLINOIS

PART NO. 17143

DATE 9-29-48 | DR. BY J.V.W. | CH'K'D.

REVISION	DATE	BY

PATTERN | FINISH | SCALE FULL

TOOLS | MATERIAL ONE DECK CENTRALAB SWITCH

DIMENSIONS
FRACTIONAL ± .015
DECIMAL ± .005
ANGULAR ± ½°
UNLESS OTHERWISE SPECIFIED

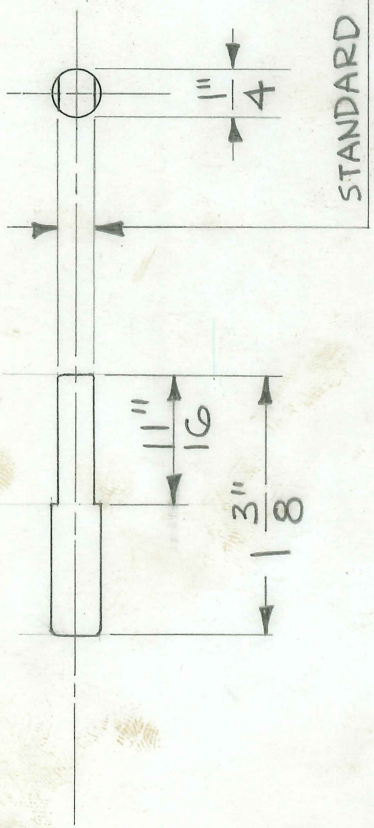

STANDARD CENTRALAB FLAT SPOTS FOR SWITCH SHOWN

SHAFT FOR SWITCH SHOWN

#5X40X1 1/8" LONG R. HD. MACHINE SCREW-2

#5X40 HEX. NUT-4

#5 SPLIT LOCK WASHER-2

STANDARD SPACER-2

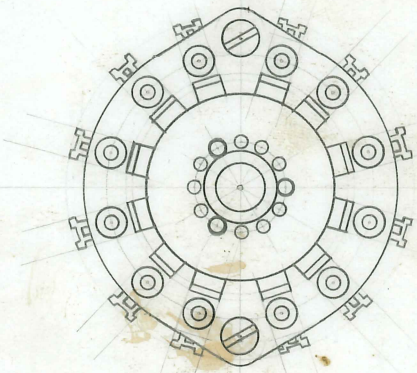

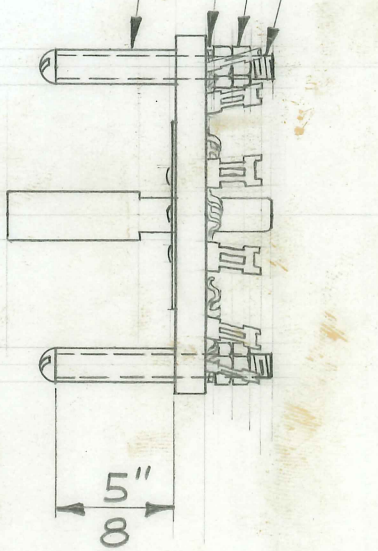

"CRL" NO. BHXC10537

FOLDER #138

TITLE
FISCHER DELUXE "RF-250" X-RAY MILLIAMPERE SELECTOR KNOB

H. G. FISCHER & CO.
FRANKLIN PARK, ILLINOIS

PART NO. 17148

DATE 9-18-48 DR. BY J.V.W. CH'K'D.

REVISION	DATE	BY

PATTERN | FINISH | SCALE

TOOLS | MATERIAL: FROM 17115

DIMENSIONS
FRACTIONAL ± .015
DECIMAL ± .005
ANGULAR ± ½°
UNLESS OTHERWISE SPECIFIED

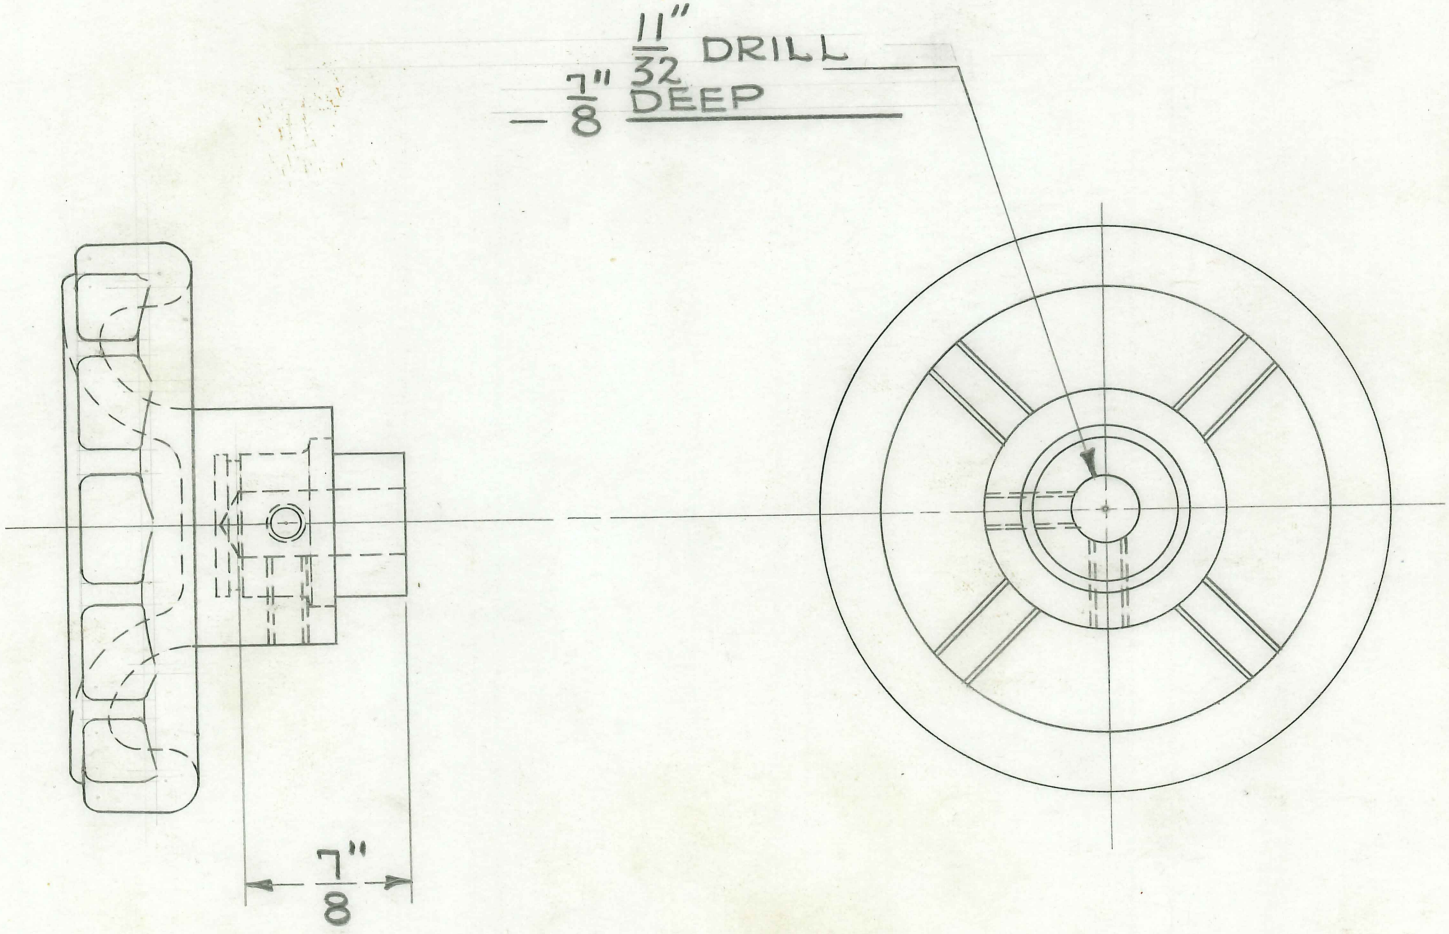

1- REQUIRED

FOLDER #138

TITLE
FISCHER "DELUXE RF-100" X-RAY
PULLMAN C' BALANCE HOOK

H. G. FISCHER & CO.
FRANKLIN PARK, ILLINOIS

DATE 10-12-48 | DR. BY W. J. | CH'K'D.

PART NO. 17159

REVISION	DATE	BY

PATTERN | FINISH CAD. #23 | SCALE FULL

DIMENSIONS
FRACTIONAL ± .015
DECIMAL ± .005
ANGULAR ± ½°
UNLESS OTHERWISE SPECIFIED

TOOLS
CUT OFF DIE #9948
DRILL JIG #9949
MILLING FIX. #9950

MATERIAL
3/4" X 3/32" C.R. STEEL FLAT WIRE

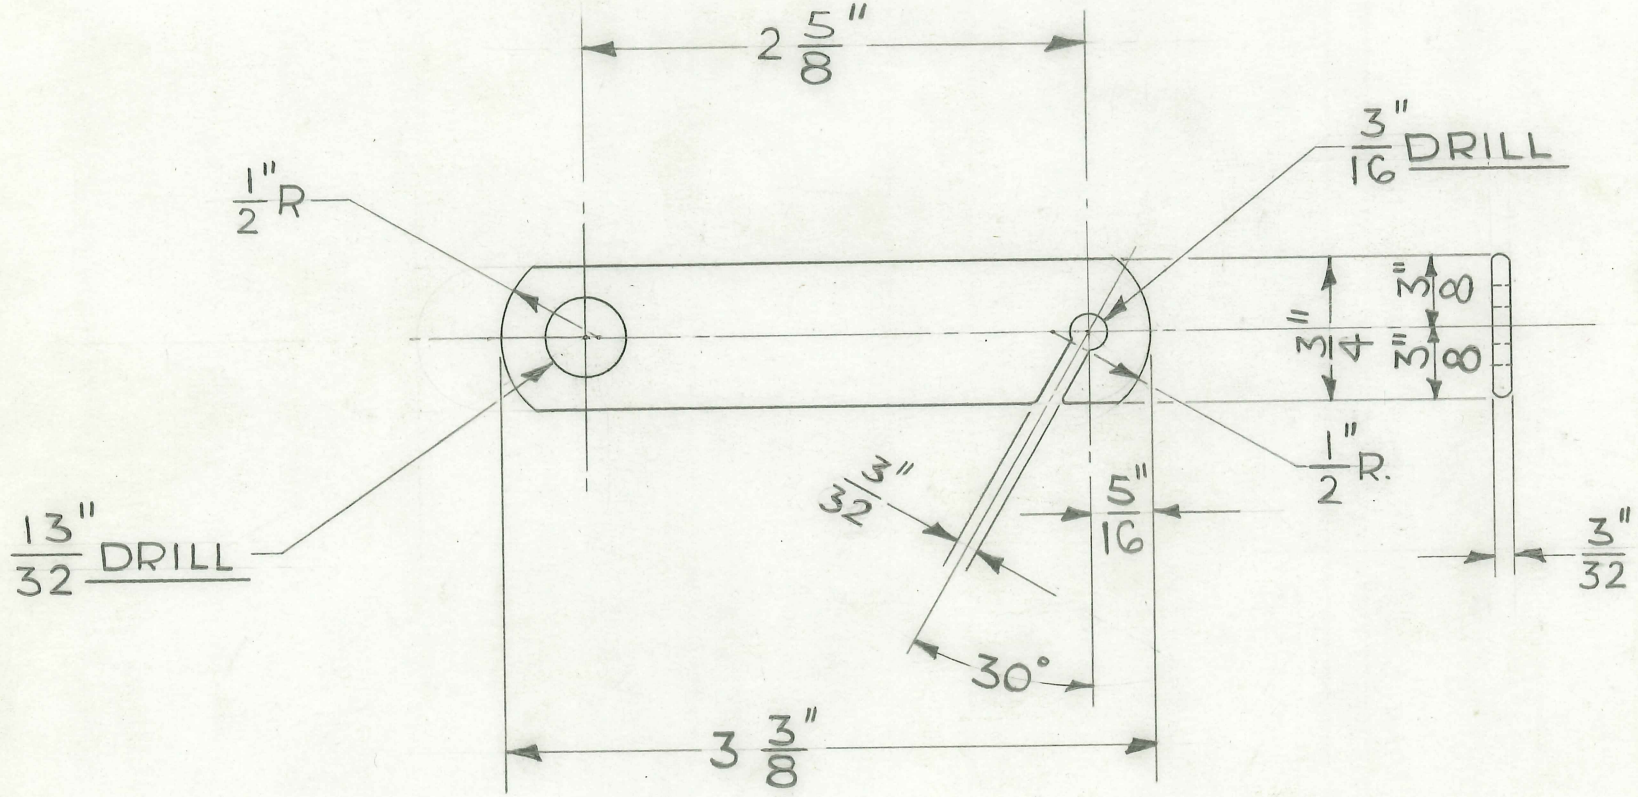

1 REQUIRED

FOLDER #127

TITLE
FISCHER DELUXE "RF-250" X-RAY SPACE CHARGE SWITCH MTG. PLATE

H. G. FISCHER & CO.
FRANKLIN PARK, ILLINOIS

PART NO. 17160

DATE 9-29-48 | DR. BY J.V.W. | CH'K'D.

REVISION	DATE	BY

PATTERN | FINISH | SCALE FULL

DIMENSIONS
FRACTIONAL ± .015
DECIMAL ± .005
ANGULAR ± ½°
UNLESS OTHERWISE SPECIFIED

TOOLS BLANKING DIE #C2372
¾" DIE INSERT & PUNCH #9935
DRILL JIG #9926
MASTER DIE BLOCK #9938

MATERIAL #18GA.(.040") SHEET BRASS H.H.

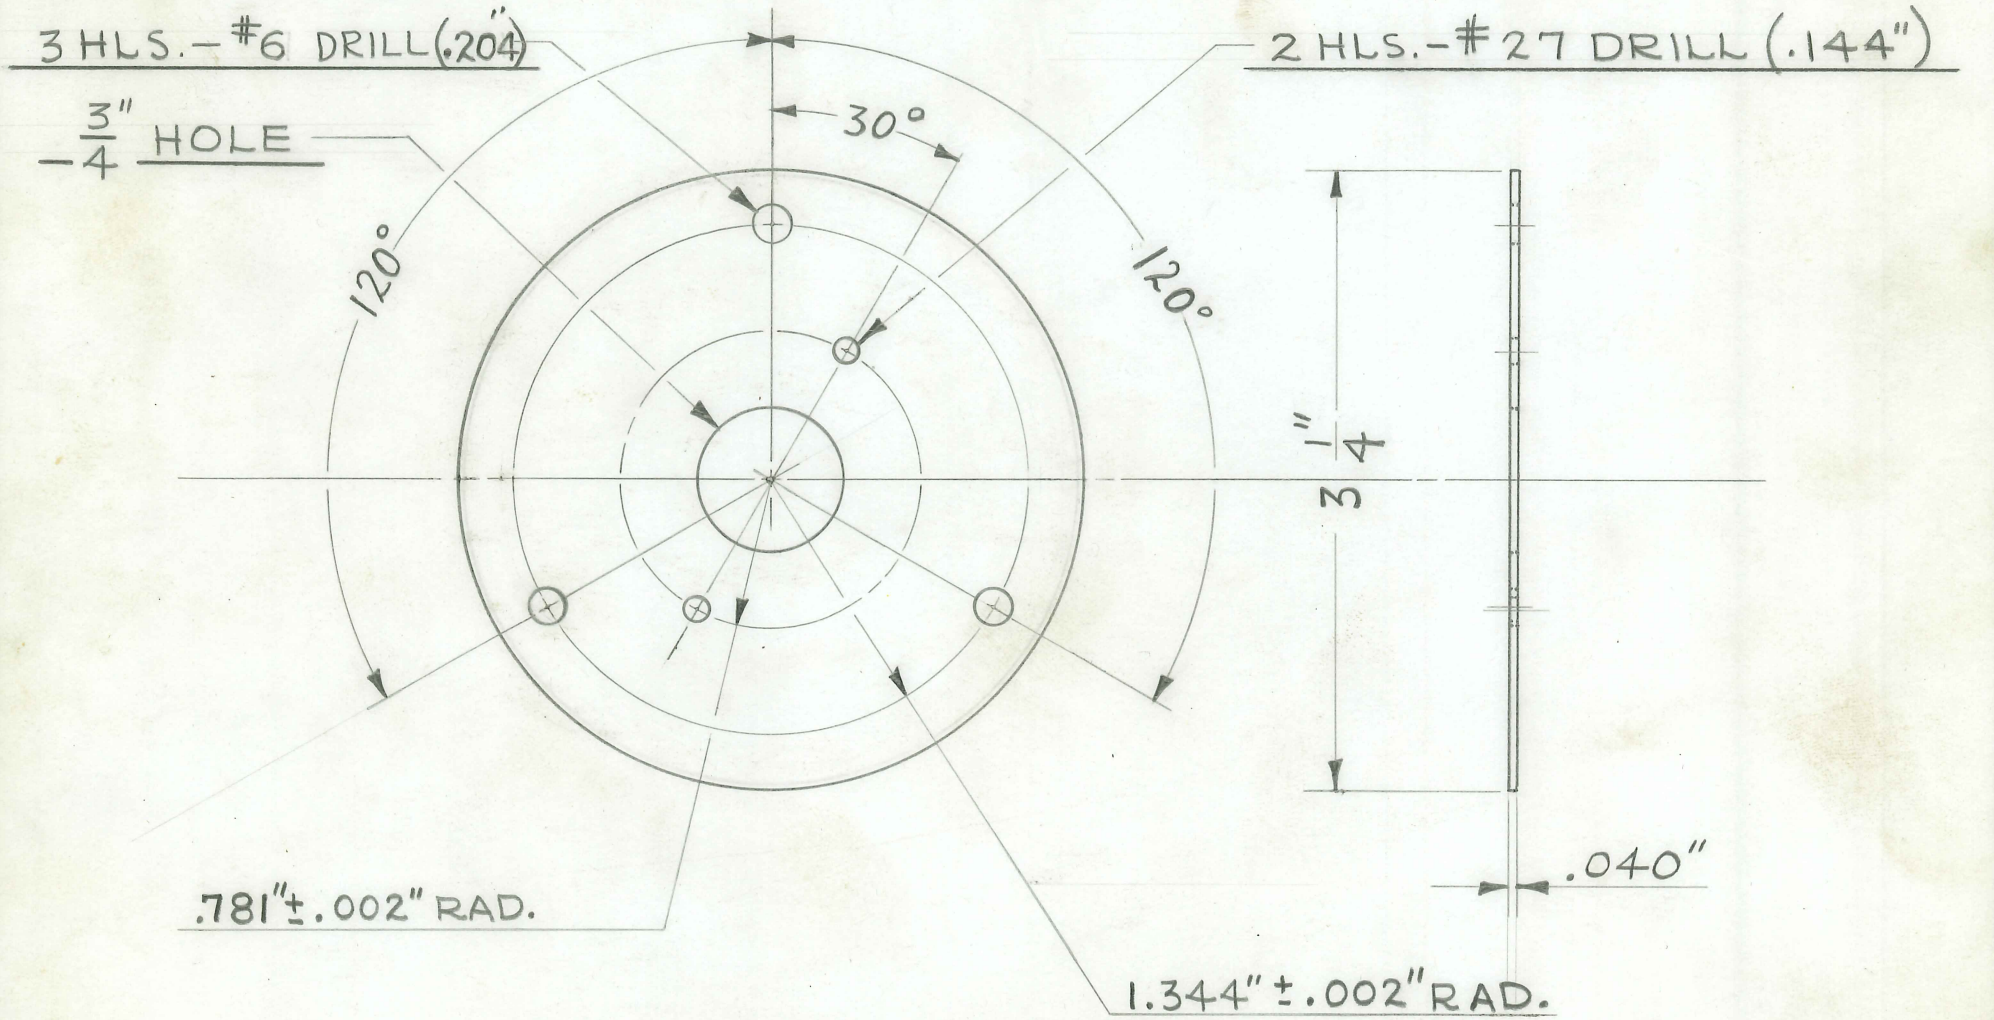

1 REQUIRED

FOLDER #138

TITLE
FISCHER DELUXE "RF-250" X-RAY
SPACE CHARGE SWITCH MTG. PLATE SPACER

H. G. FISCHER & CO.
FRANKLIN PARK, ILLINOIS

PART NO. 17161

DATE 9-29-48 | DR. BY J.V.W. | CH'K'D.

REVISION	DATE	BY

PATTERN | FINISH | SCALE FULL

TOOLS

MATERIAL
$\frac{5}{16}$" DIA. BRASS ROD

DIMENSIONS
FRACTIONAL ± .015
DECIMAL ± .005
ANGULAR ± ½°
UNLESS OTHERWISE SPECIFIED

#20 DRILL THRU
#10 X 32 TAP - BOTH ENDS
C'SINK. TO $\frac{7}{32}$" FACE - BOTH ENDS

BREAK EDGE
BOTH ENDS

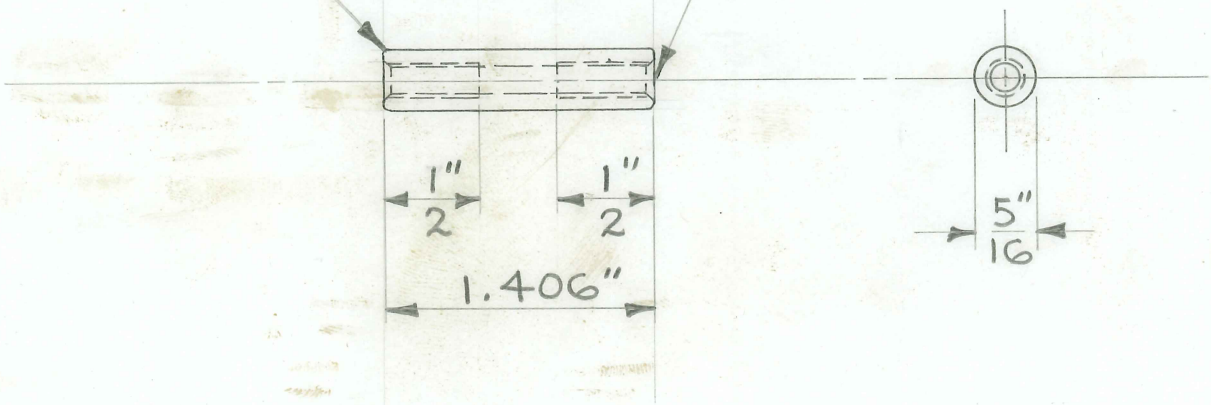

3 REQUIRED

FOLDER # 138

TITLE
FISCHER DELUXE "RF-250" X-RAY
SPACE CHARGE SWITCH MTG. PLATE SPACER-INS.

H. G. FISCHER & CO.
FRANKLIN PARK, ILLINOIS

PART NO. 17162

DATE 9-29-48 DR. BY J.V.W. CH'K'D.

REVISION	DATE	BY

PATTERN | FINISH | SCALE FULL

TOOLS | MATERIAL FROM #5084 BLACK VARNISHED TUBING

DIMENSIONS
FRACTIONAL ± .015
DECIMAL ± .005
ANGULAR ± ½°
UNLESS OTHERWISE SPECIFIED

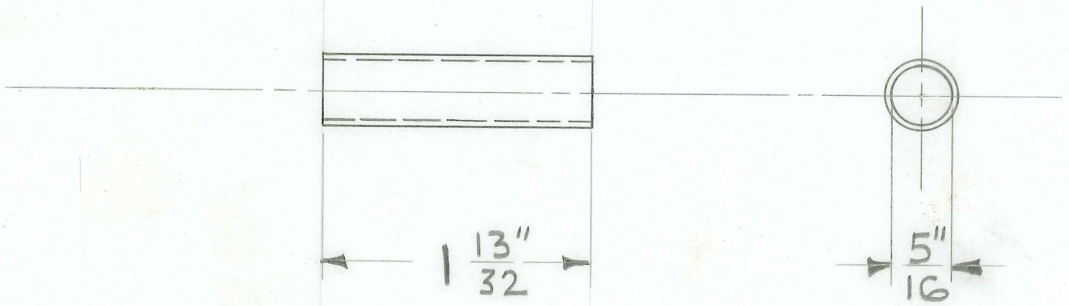

3 REQUIRED

FOLDER #138

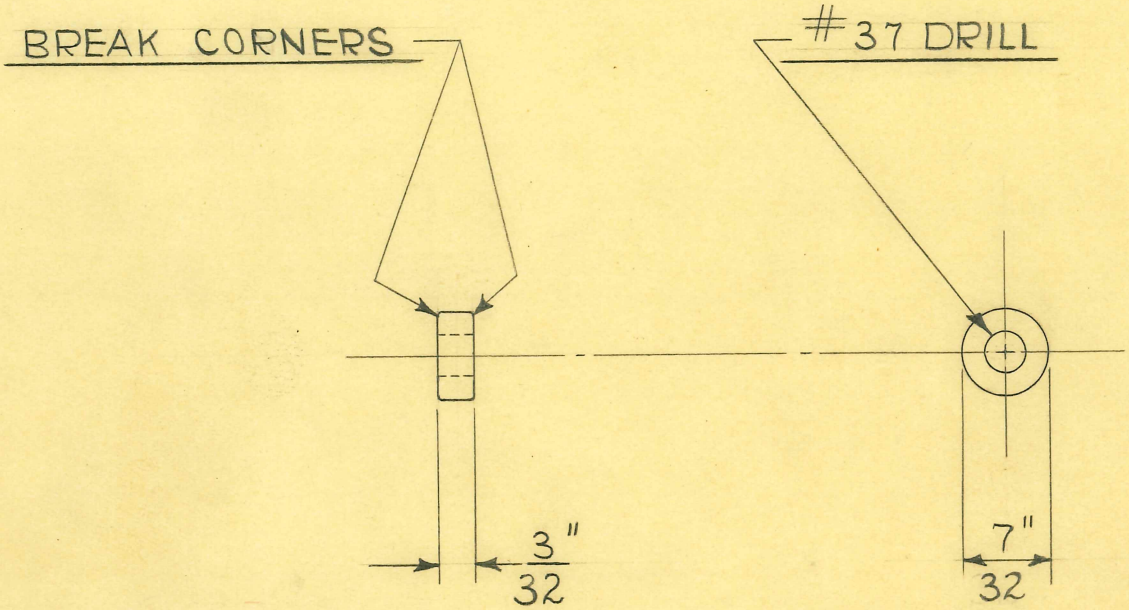

SCALE ÷ DOUBLE SIZE

2 REQUIRED

DIMENSIONS	
FRACTIONAL	± .015
DECIMAL	± .005
ANGULAR	± 1/2°

UNLESS OTHERWISE SPECIFIED

SIZE	7/32" DIA.	ISSUE 3-16-48	W. J.
KIND	BRASS	CHANGED	
SHAPE	ROD	"	
FINISH	CAD. #23	"	
TEMP.		"	
PATT.		"	

TITLE: FISCHER DELUXE RF-100 X-RAY VERTICAL ANGLE INDICATOR SPACER

H. G. FISCHER & CO.
2335 WABANSIA AVE.
CHICAGO, ILL.

CAT. NO.

PART NO. 17172

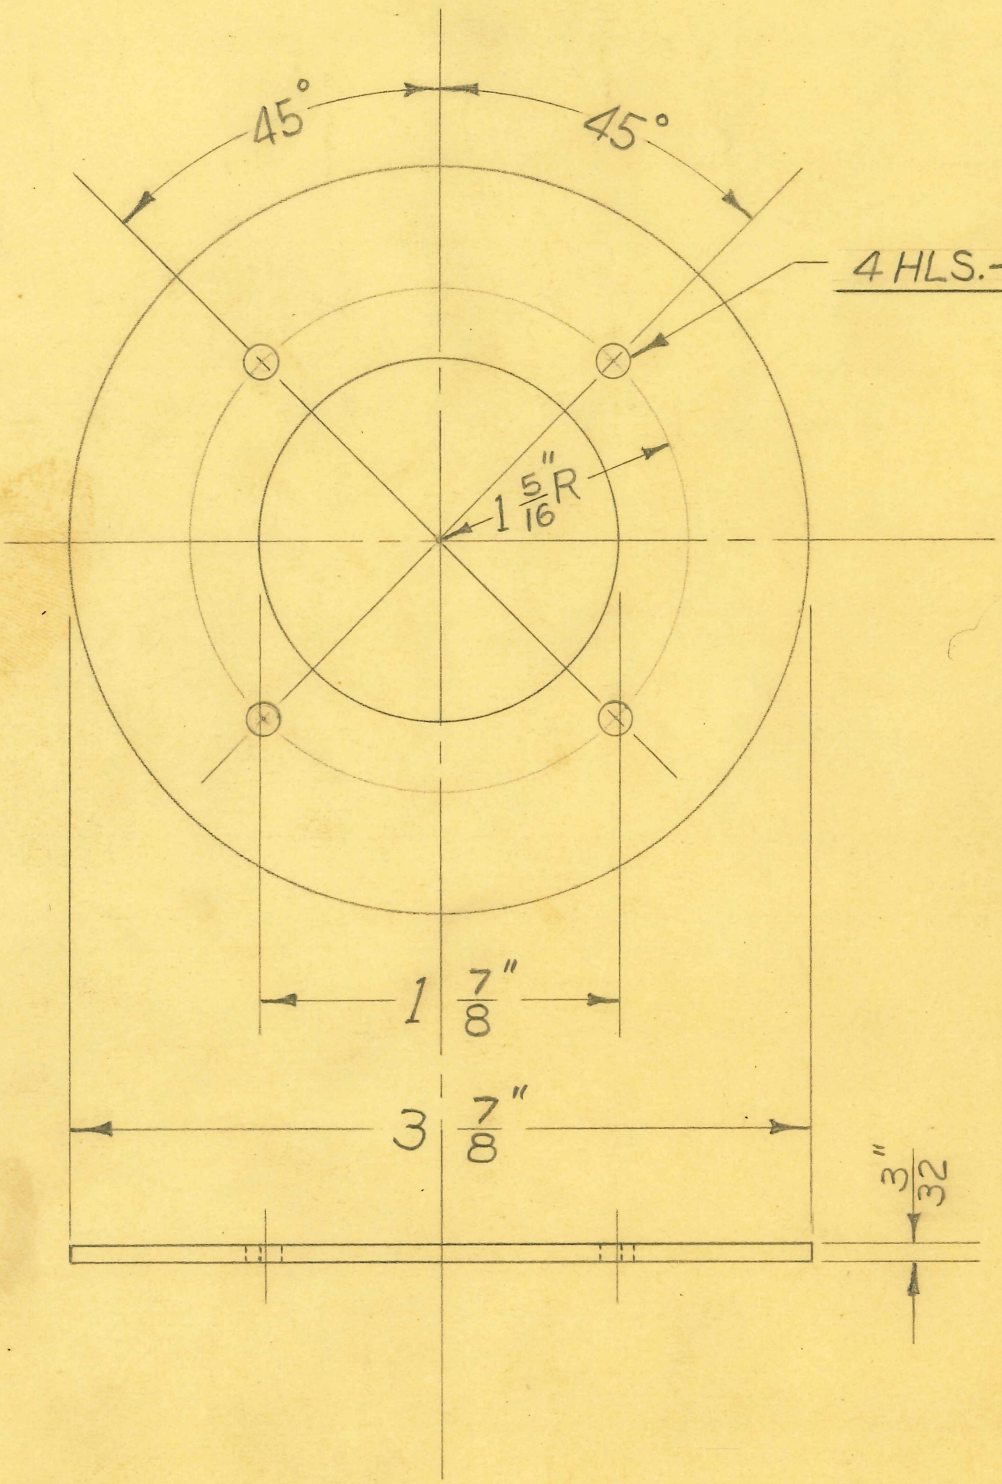

1-REQUIRED

PUNCHING DIE TOOL # 9753

DIMENSIONS	
FRACTIONAL	± .015
DECIMAL	± .005
ANGULAR	± 1/2°

UNLESS OTHERWISE SPECIFIED

SIZE	3/32" SHEET	ISSUE 2-11-48	J.B.G.
KIND	LEAD	CHANGED	
SHAPE		"	
FINISH	BLK. #80	"	
TEMP.		"	
PATT.		"	

TITLE:

FISCHER "DE LUXE RF100" X-RAY HEAD

LEAD PROTECTION DISC

H. G. FISCHER & CO.
2338 WABANSIA AVE.
CHICAGO, ILL.

CAT. NO.

PART NO. 17173

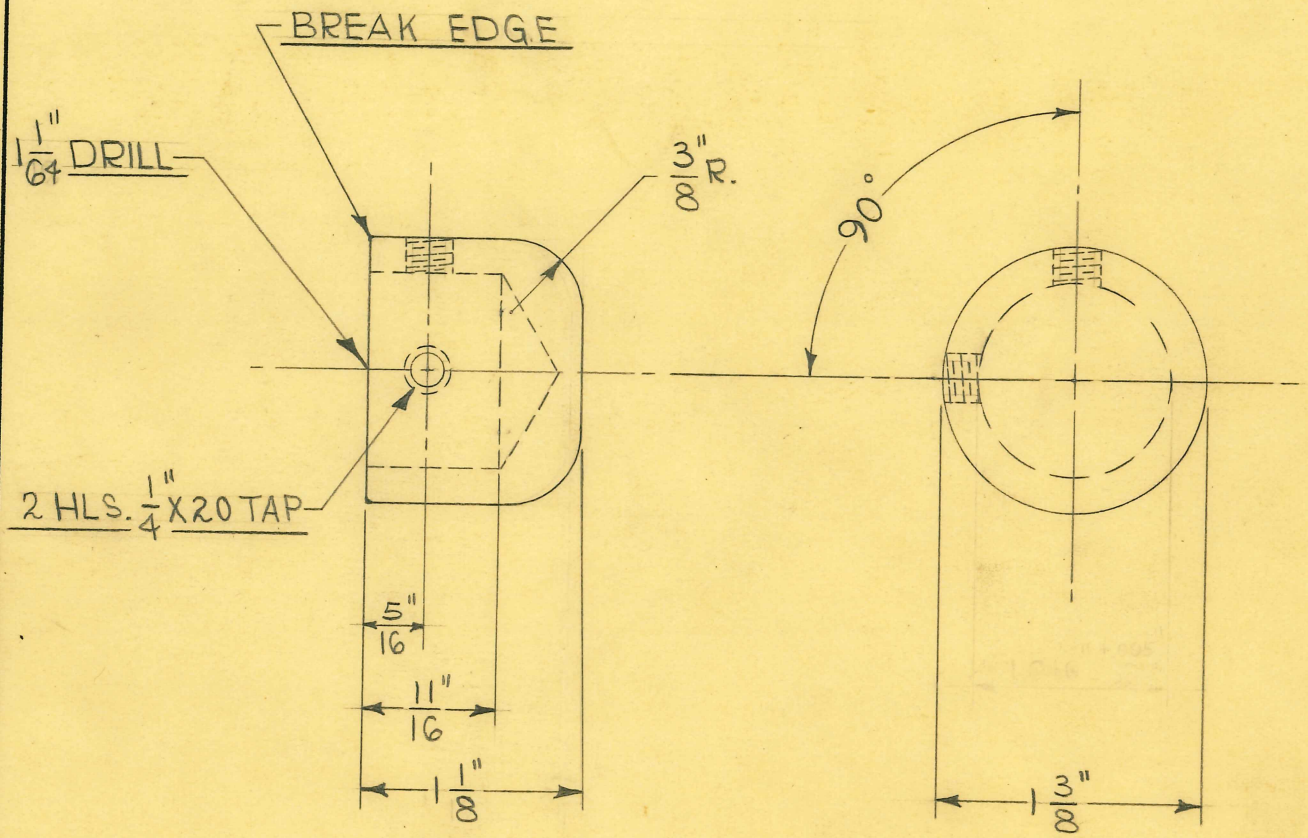

1 REQUIRED

Drill Jig Tool #9704

DIMENSIONS	
FRACTIONAL	± .015
DECIMAL	± .005
ANGULAR	± 1/2°

UNLESS OTHERWISE SPECIFIED

SIZE	1 3/8" DIA.	ISSUE 2-9-48	W. J.
KIND	C.R. STEEL	CHANGED	
SHAPE	ROD	"	
FINISH	CHROME #2	"	
TEMP.		"	
PATT.		"	

TITLE: FISCHER DELUXE RF-100 X-RAY UNIT

INNER TUBE HEAD CAP

H. G. FISCHER & CO.
2333 WABANSIA AVE.
CHICAGO, ILL.

CAT. NO.

PART NO. 17174

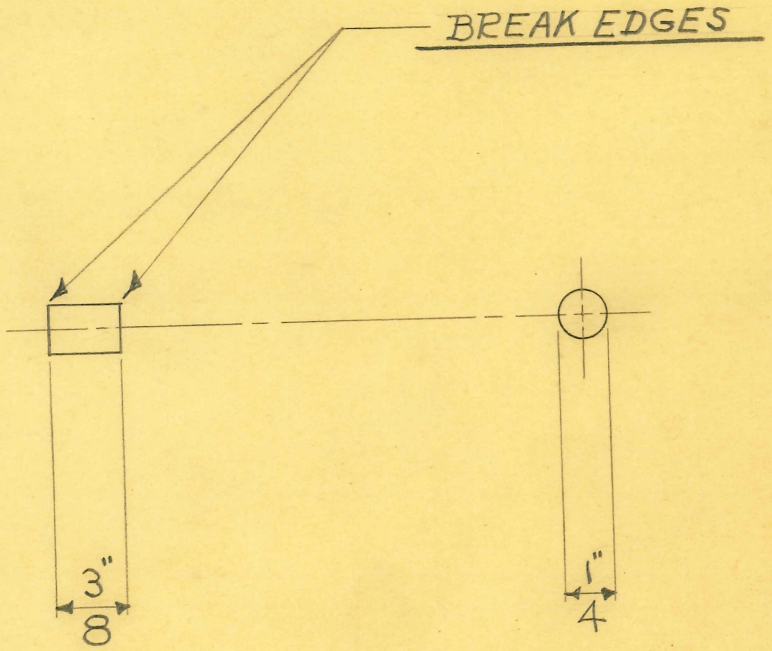

1-REQUIRED

DIMENSIONS	
FRACTIONAL	± .015
DECIMAL	± .005
ANGULAR	± 1/2°

UNLESS OTHERWISE SPECIFIED

SIZE	1/4" DIA.	ISSUE 2-2-48	JVF
KIND	BRASS	CHANGED	
SHAPE	ROD	"	
FINISH		"	
TEMP.		"	
PATT.		"	

TITLE: FISCHER DELUXE RF-100 X-RAY HORIZ. SLIDE CLAMP SLUG

H. G. FISCHER & CO.
2335 WABANSIA AVE.
CHICAGO, ILL.

CAT. NO.

PART NO. 17175

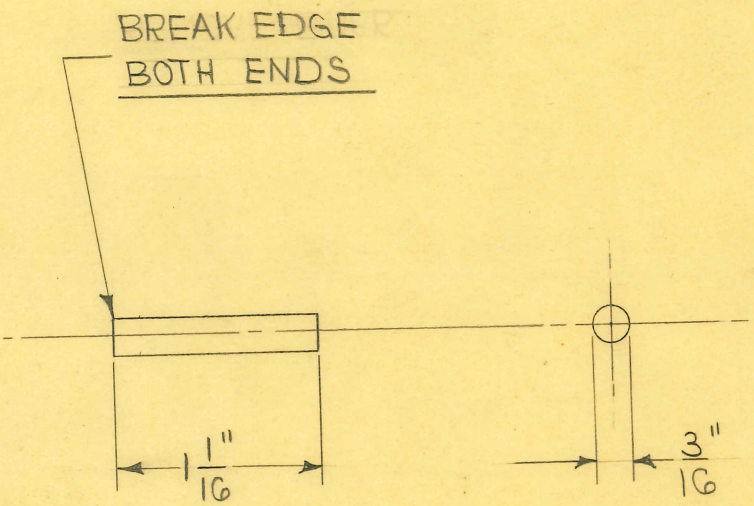

1 REQUIRED

DIMENSIONS	
FRACTIONAL	± .015
DECIMAL	± .005
ANGULAR	± 1/2°

UNLESS OTHERWISE SPECIFIED

SIZE	3/16" DIA.	ISSUE 2-2-48	W. J.
KIND	C.R. STEEL	CHANGED	
SHAPE	ROD	"	
FINISH		"	
TEMP.		"	
PATT.		"	

TITLE: FISCHER "DELUXE RF-100" X-RAY UNIT

INNER TUBE HEAD SUPP. HORIZ. TUBE PLUG RIVET

H. G. FISCHER & CO.
2335 WABANSIA AVE.
CHICAGO, ILL.

CAT. NO.

PART NO. 17177

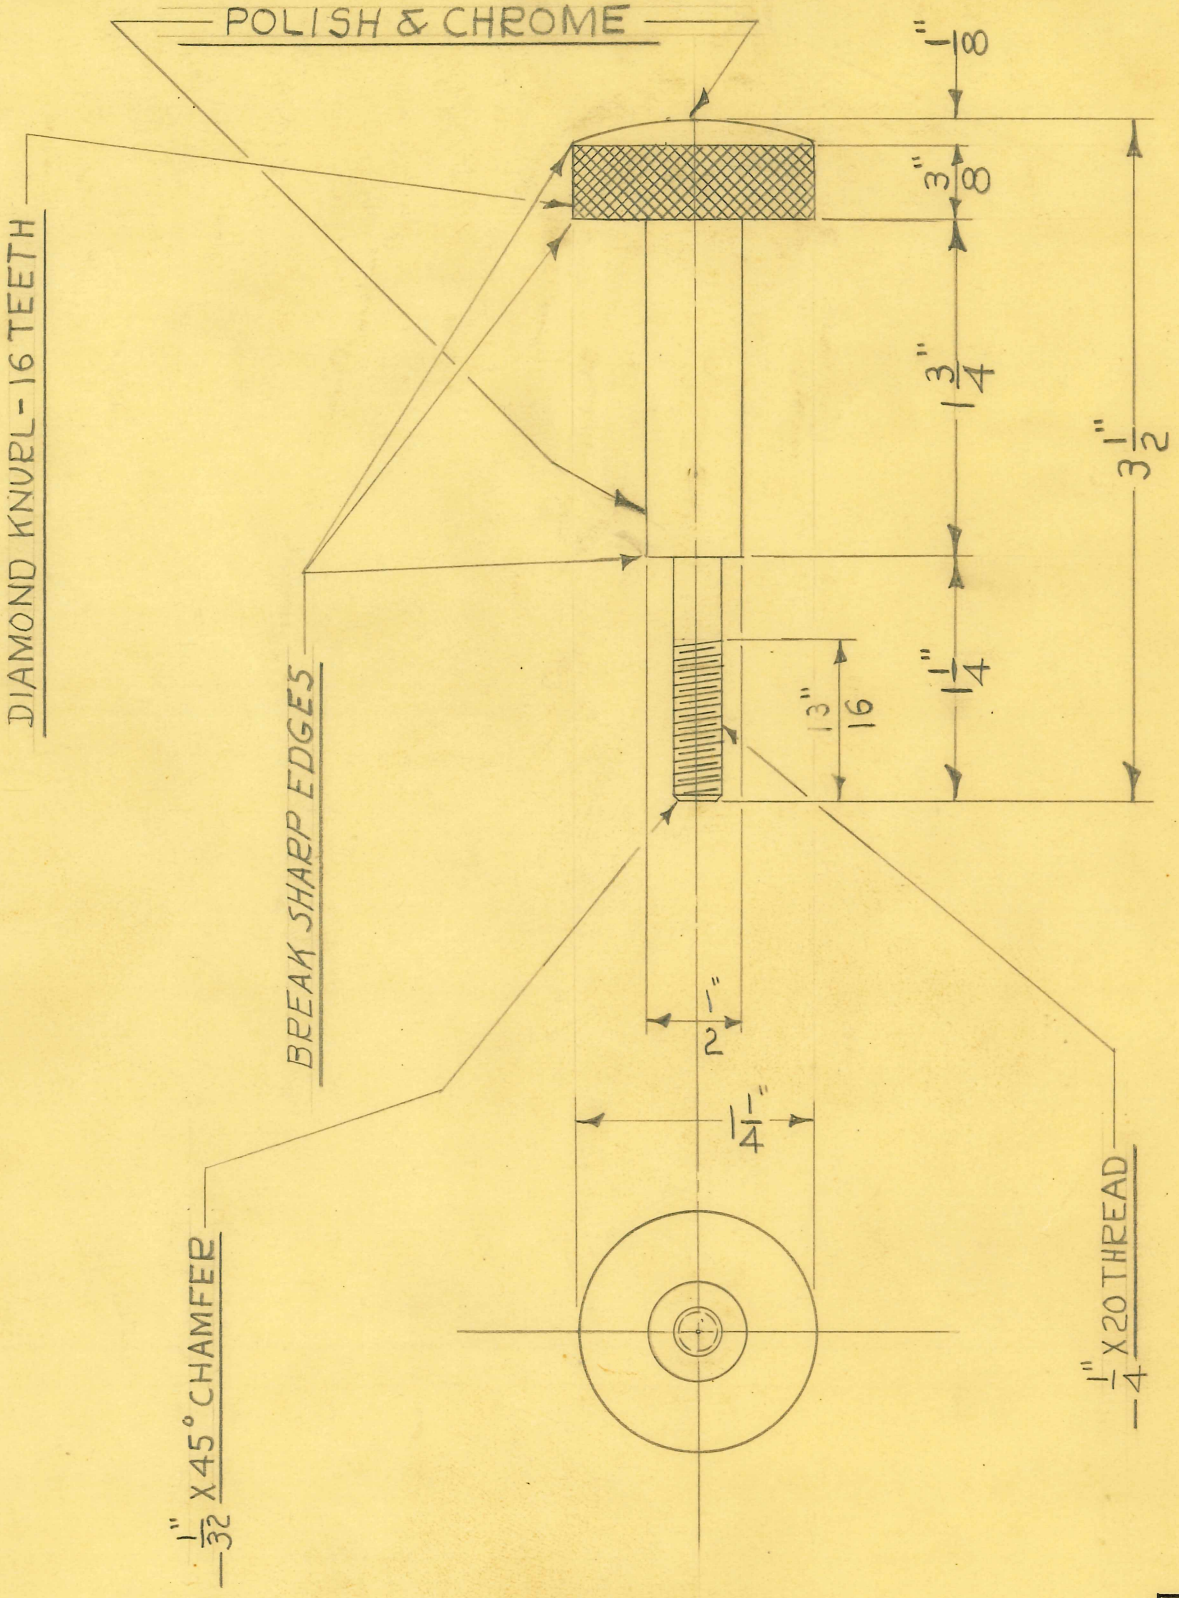

1-REQUIRED

DIMENSIONS	
FRACTIONAL	± .015
DECIMAL	± .005
ANGULAR	± 1/2°

UNLESS OTHERWISE SPECIFIED

SIZE	1¼" DIAM.	ISSUE 12-30-47	J.M.F	
KIND	BRASS	CHANGED		
SHAPE	ROD	"		
FINISH	SEE NOTE	"		
TEMP.		"		
PATT.		"		

TITLE:
FISCHER DELUXE RF-100 X-RAY UNIT
TUBE HEAD ANGULATING LOCK SCREW

H. G. FISCHER & CO.
2335 WABANSIA AVE.
CHICAGO, ILL.

CAT. NO.

PART NO. 17182

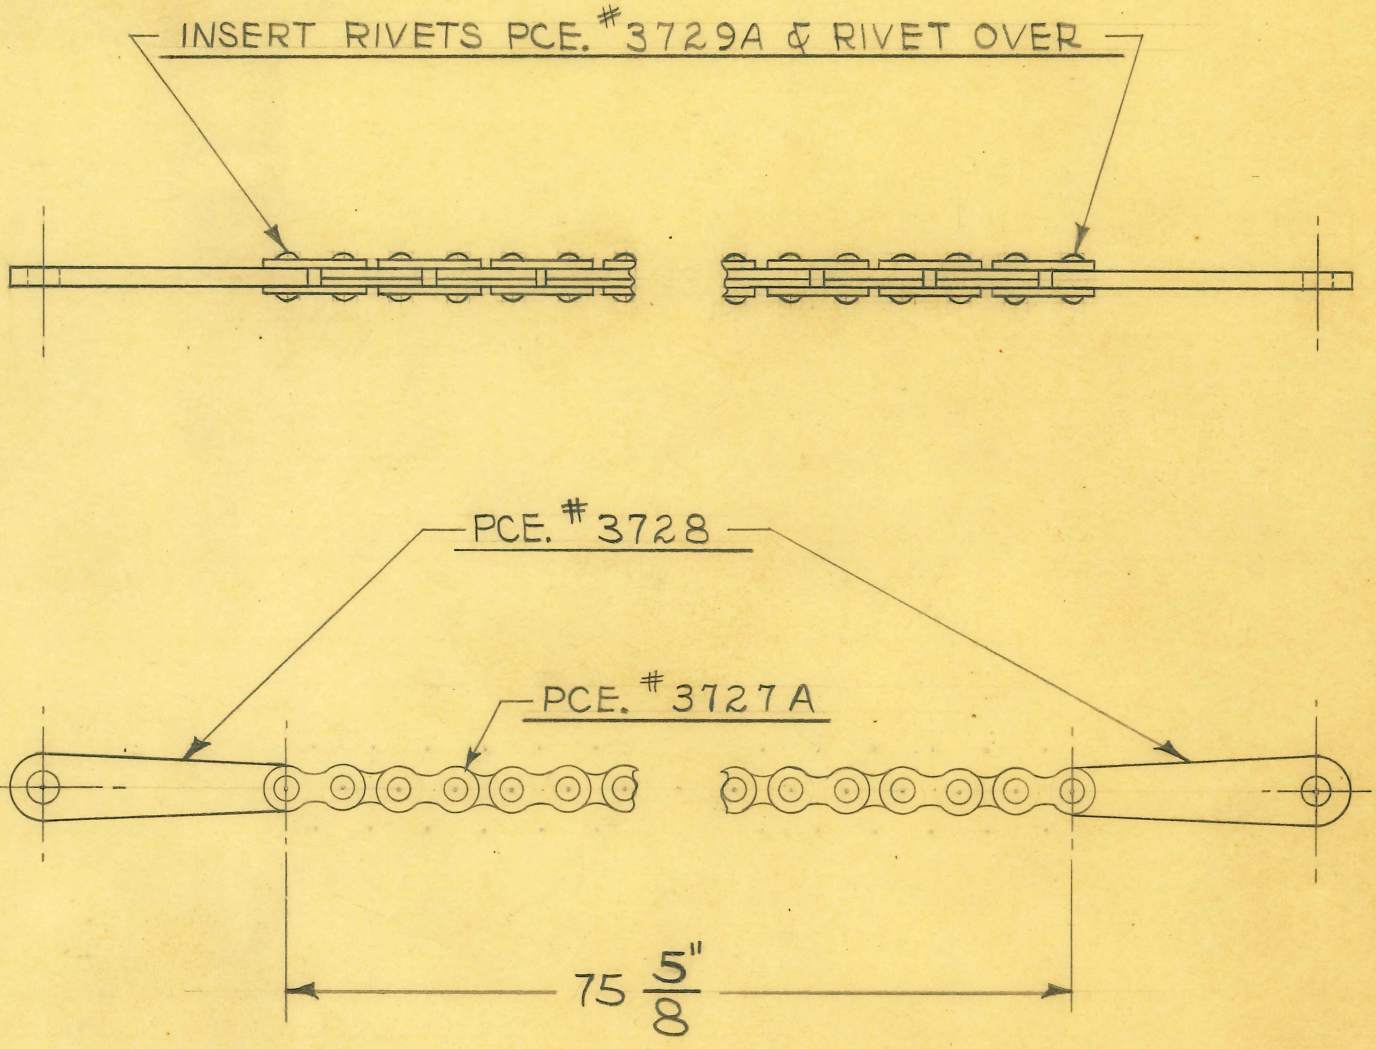

1 REQUIRED

SIZE		ISSUE 11-6-47	W. J.
KIND		CHANGED	
SHAPE		"	
FINISH		"	
TEMP.		"	
PATT.		"	

TITLE:
FISCHER "DELUXE RF-100" X-RAY UNIT
CWT. CHAIN ASSEM.

H. G. FISCHER & CO.
2335 WABANSIA AVE.
CHICAGO, ILL.

CAT. NO.

PART NO. 17183G

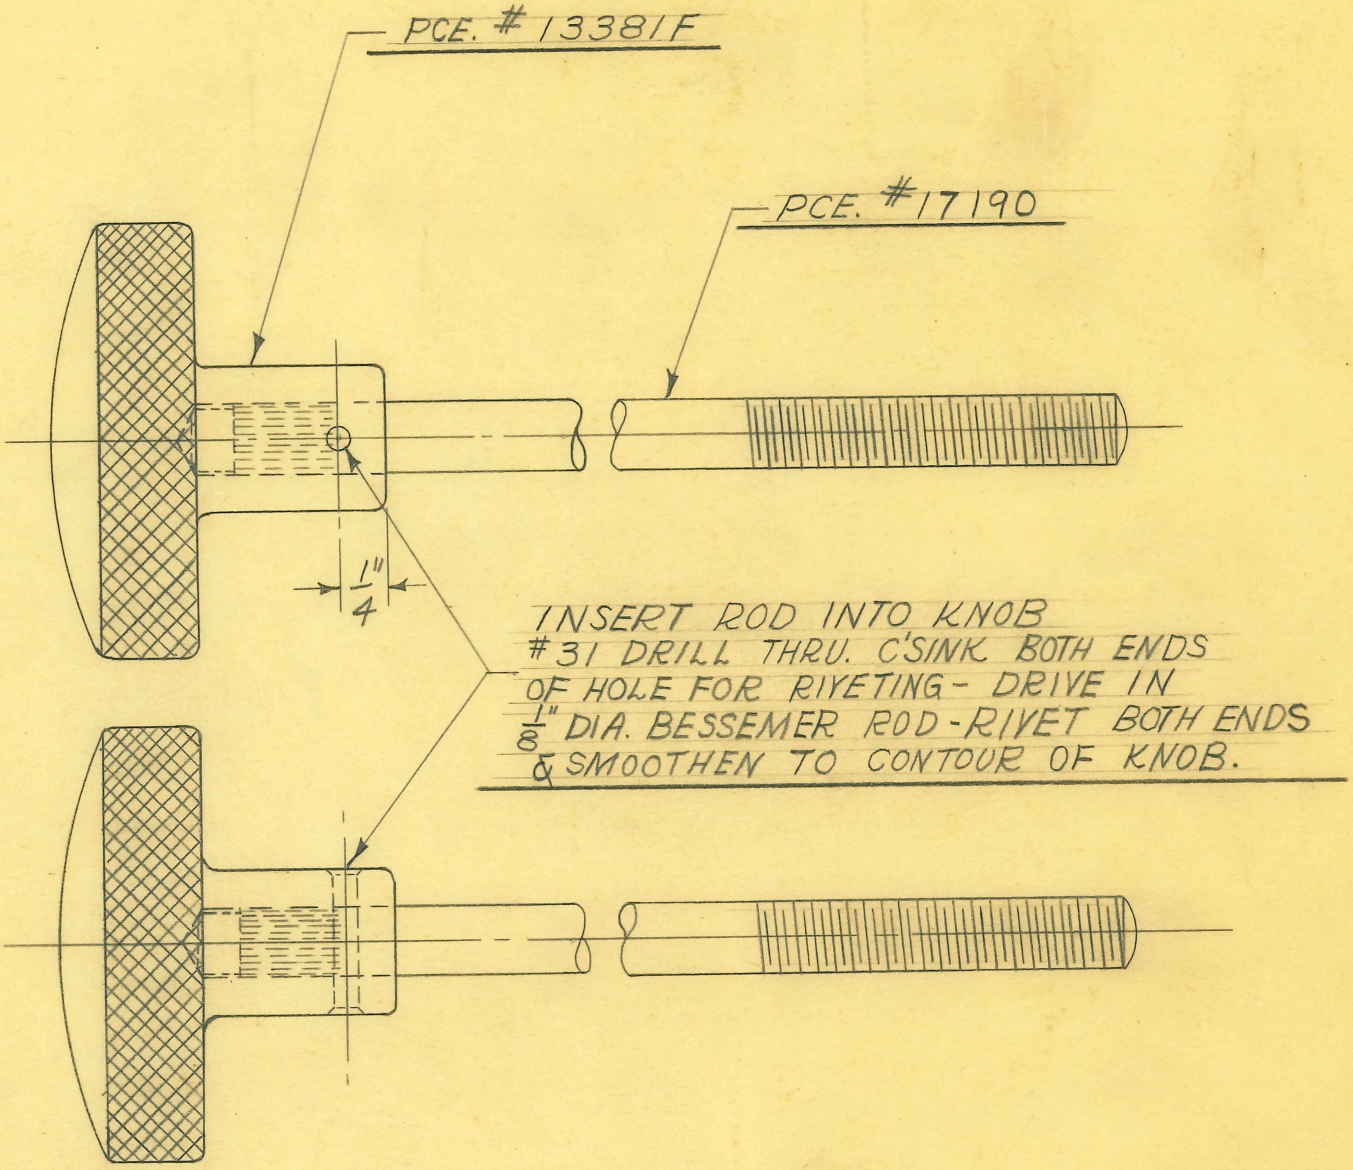

1 REQUIRED

DIMENSIONS	
FRACTIONAL	± .015
DECIMAL	± .005
ANGULAR	± 1/2°

UNLESS OTHERWISE SPECIFIED

SIZE		ISSUE 12-1-47	W.J.
KIND		CHANGED	
SHAPE		"	
FINISH		"	
TEMP.		"	
PATT.		"	

TITLE: FISCHER "DELUXE RF-100" X-RAY UNIT
BASE STOP ROD & KNOB ASSEM.

H. G. FISCHER & CO.
2335 WABANSIA AVE.
CHICAGO, ILL.

CAT. NO.

PART NO. 17189GA

TITLE

FISCHER DELUXE RF-100 X-RAY
BASE STOP ROD

H. G. FISCHER & CO.
FRANKLIN PARK, ILLINOIS

PART NO. 17190A

DATE 9-7-50 | DR. BY W.J. | CH'K'D J.V.W.

REVISION	DATE	BY

PATTERN | FINISH CAD. #23 | SCALE FULL

TOOLS | MATERIAL $\frac{3}{8}$" DIA. C.R. STEEL

DIMENSIONS
FRACTIONAL ± .015
DECIMAL ± .005
ANGULAR ± ½°
UNLESS OTHERWISE SPECIFIED

1 REQUIRED

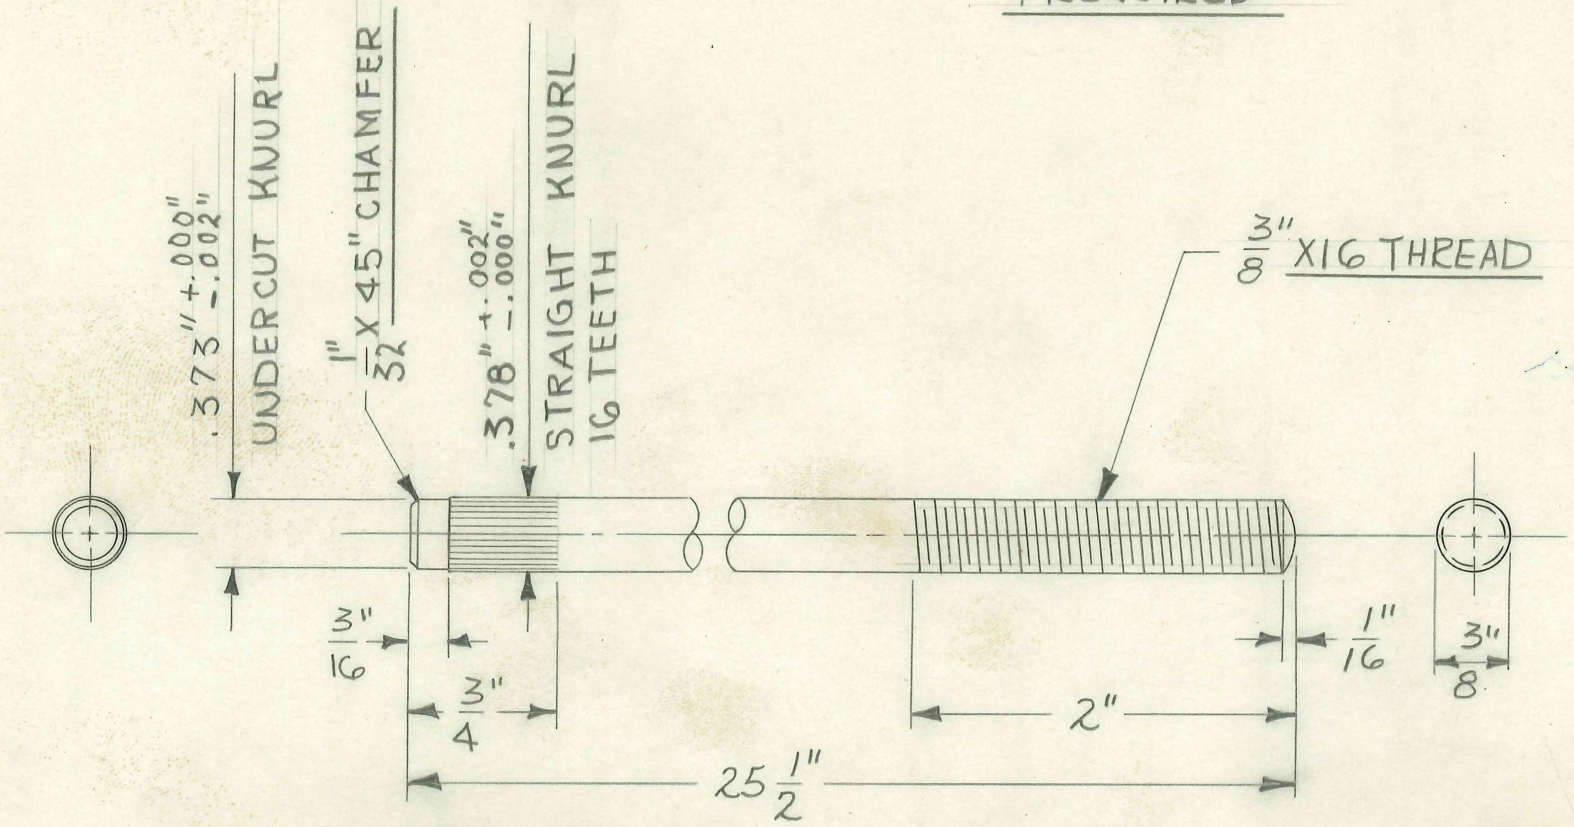

FOLDER #127

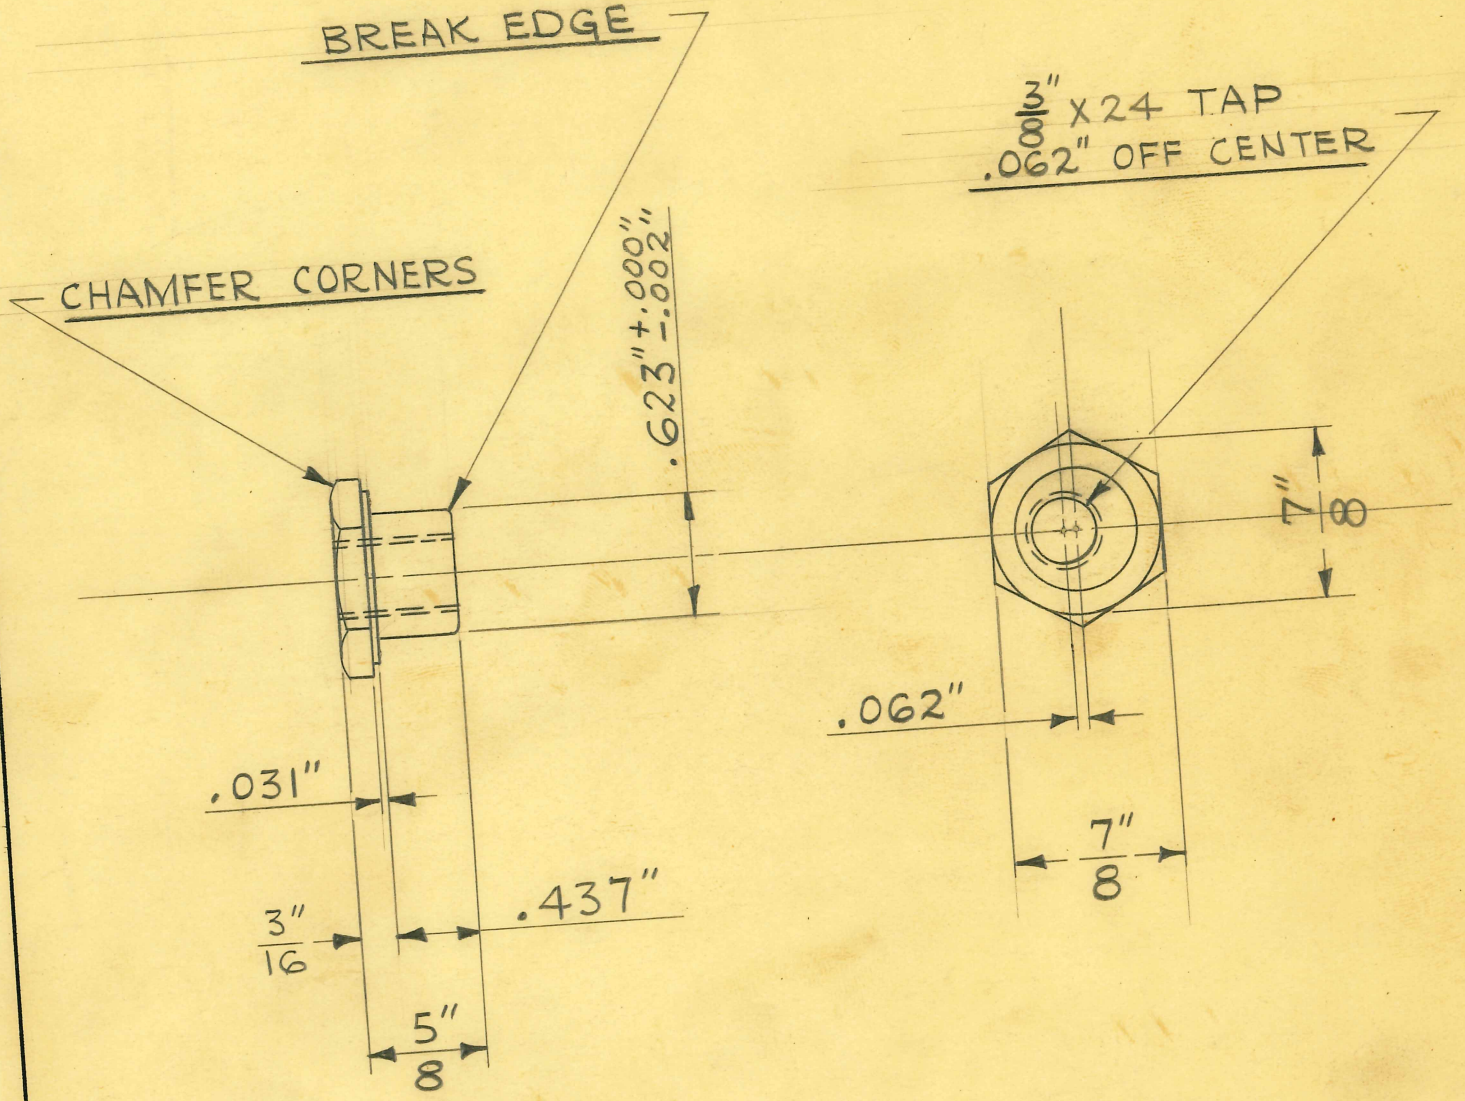

2 REQUIRED

DIMENSIONS	
FRACTIONAL	± .015
DECIMAL	± .005
ANGULAR	± 1/2°

UNLESS OTHERWISE SPECIFIE

SIZE	7/8" HEX.	ISSUE	1-18-47	J.V.W.
KIND	C.R.STEEL	CHANGED		
SHAPE		"		
FINISH	CAD. #23	"		
TEMP.		"		
PATT.		"		

TITLE: FISCHER DELUXE "RF-100" X-RAY UPRIGHT BASE ECCENTRIC BUSHING

H. G. FISCHER & CO.
2335 WABANSIA AVE.
CHICAGO, ILL.

CAT. NO.

PART NO. 17192

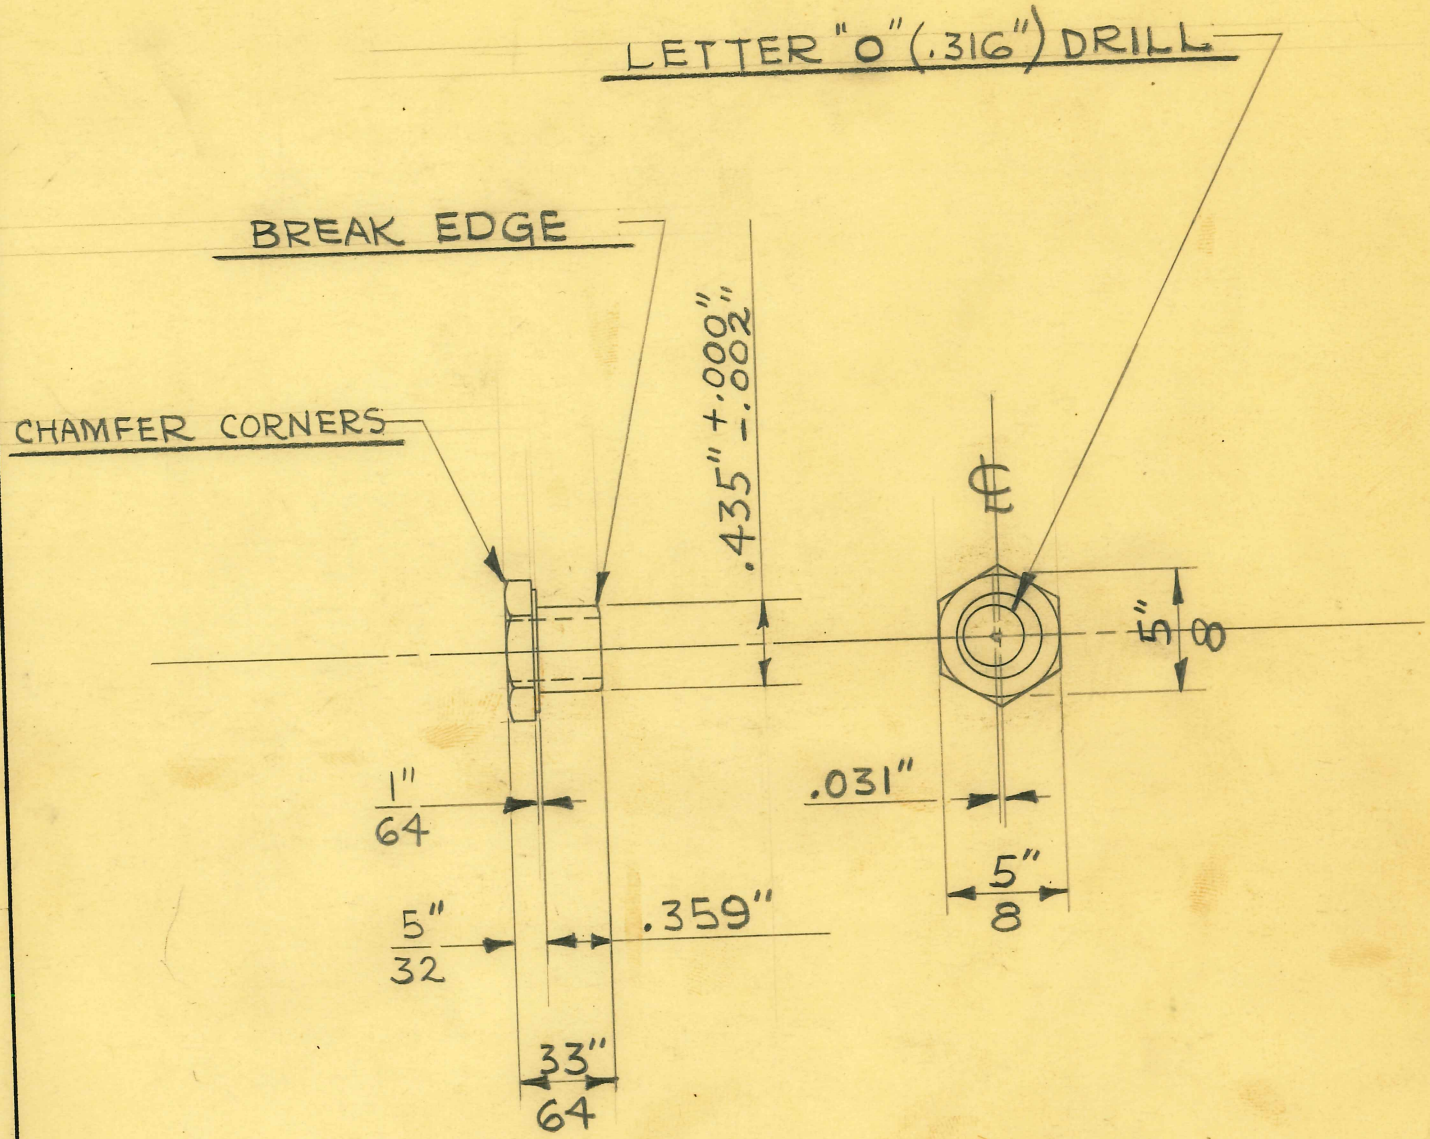

2 REQUIRED

DIMENSIONS	
FRACTIONAL	± .015
DECIMAL	± .005
ANGULAR	± 1/2°

UNLESS OTHERWISE SPECIFIED

SIZE	5/8" HEX.	ISSUE 11-17-47	J.V.W.
KIND	C.R. STEEL	CHANGED	
SHAPE		"	
FINISH	CAD. #23	"	
TEMP.		"	
PATT.		"	

TITLE: FISCHER DELUXE "RF-100" X-RAY ECCENTRIC BUSHING

H. G. FISCHER & CO.
2335 WABANSIA AVE.
CHICAGO, ILL.

CAT. NO.

PART NO. 17194

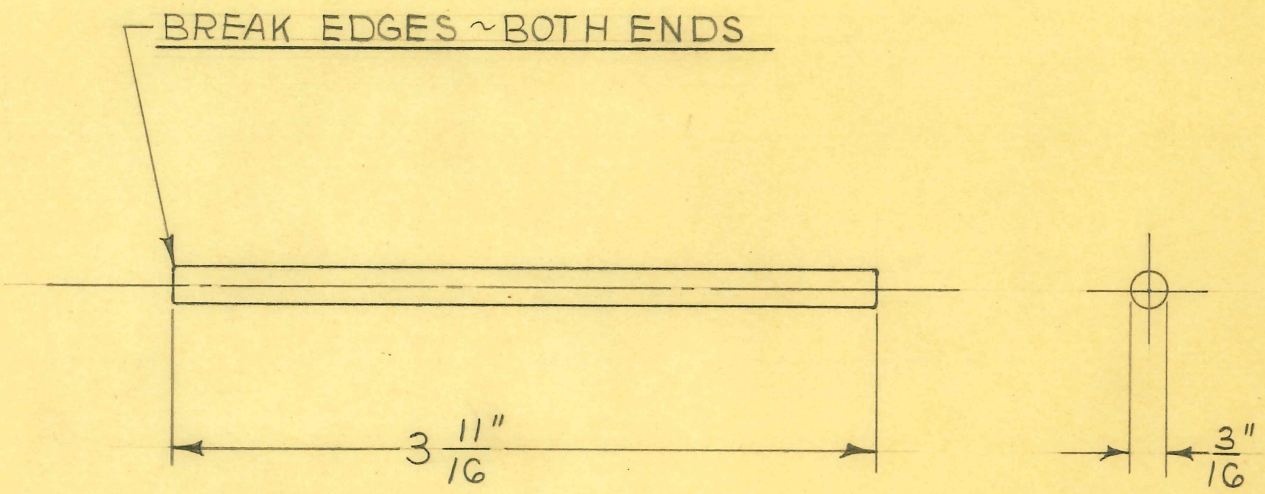

1 REQUIRED

SIZE	3/16" DIA.	ISSUE 11-7-47	W.J.
KIND	C.R. STEEL	CHANGED	
SHAPE	ROD	"	
FINISH		"	
TEMP.		"	
PATT.		"	

TITLE:
FISCHER DELUXE RF-100 X-RAY UNIT
CWT. TUBE PIN

H. G. FISCHER & CO.
2335 WABANSIA AVE.
CHICAGO, ILL.

CAT. NO.

PART NO. 17196

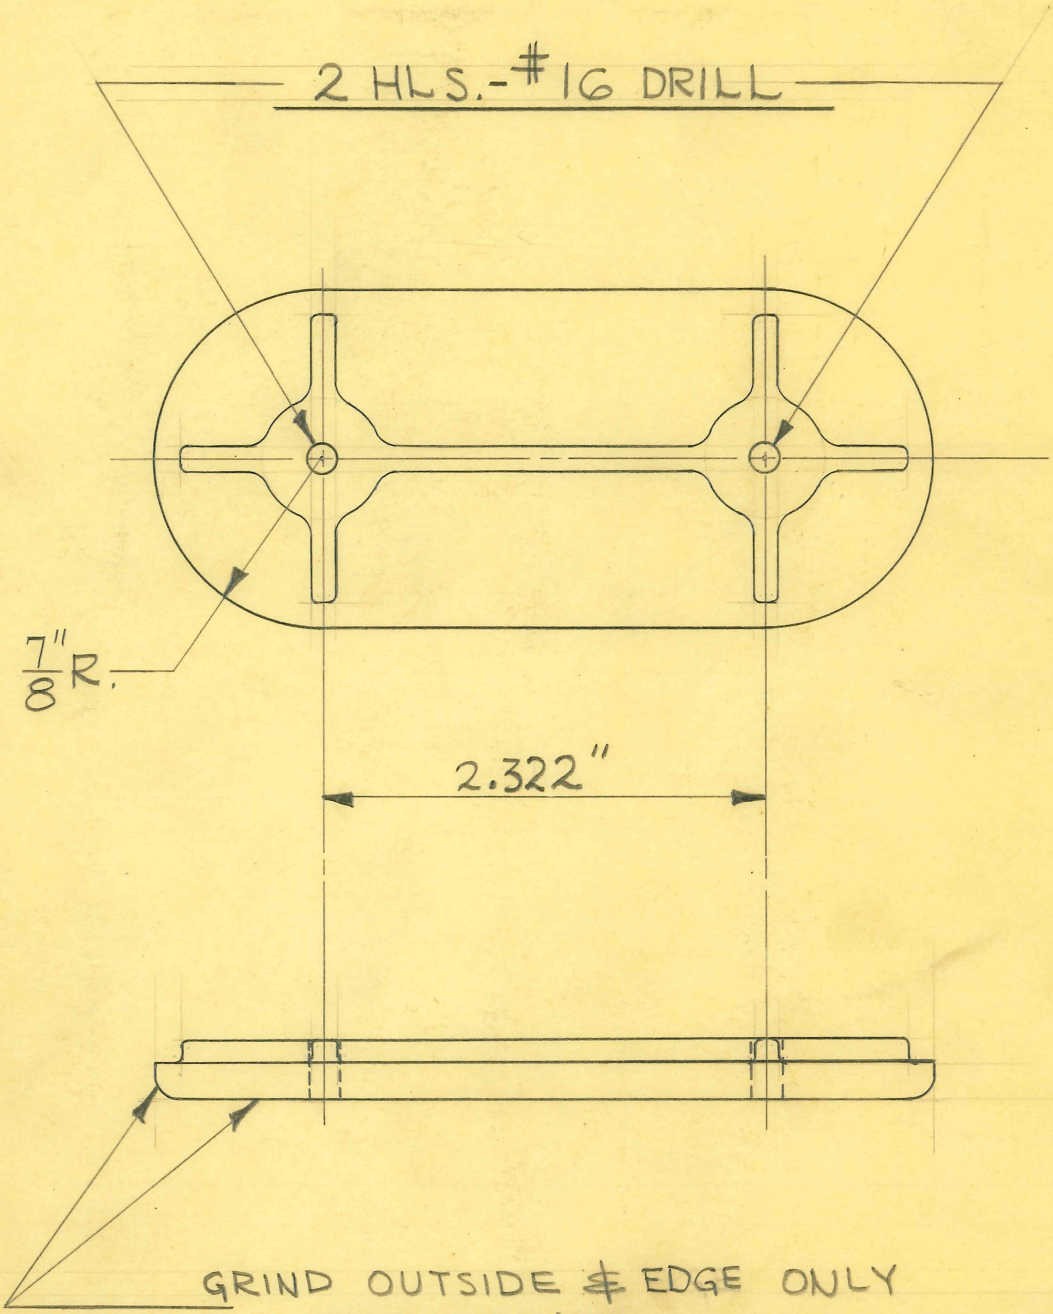

GRIND OUTSIDE & EDGE ONLY
FOR PAINTING

1 REQUIRED

DRILL JIG TOOL #9513

SIZE	#12 ALUM.	ISSUE 10-28-47	J.V.W.
KIND	CASTING	CHANGED	
SHAPE		"	
FINISH	PAINTED	"	
TEMP.		"	
PATT.	2237	"	

TITLE:
FISCHER DELUXE "RF-100" X-RAY
VERTICAL SLIDE BACK BEARING COVER

H. G. FISCHER & CO.
2335 WABANSIA AVE.
CHICAGO, ILL.

CAT. NO.

PART NO. 17241F

TITLE

FISCHER DELUXE "RF-100" X-RAY FLUOROSCOPIC BEARING SPACER

H. G. FISCHER & CO.
FRANKLIN PARK, ILLINOIS

PART NO. 17244

DATE 6-16-49 DR. BY W. J. CH'K'D.

REVISION	DATE	BY

PATTERN | FINISH | SCALE FULL

TOOLS | MATERIAL 3/4" DIA. BRASS ROD

DIMENSIONS
FRACTIONAL ± .015
DECIMAL ± .003
ANGULAR ± ½°
UNLESS OTHERWISE SPECIFIED

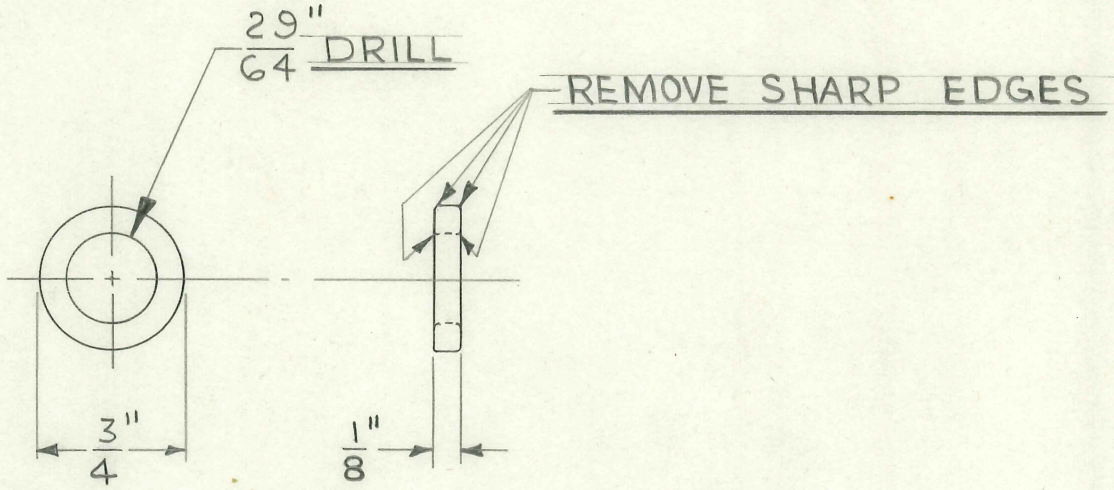

2 REQUIRED

FOLDER #127

TITLE
FISCHER DELUXE "RF-100" -X-RAY
SCREEN FORK SUPPORT SHAFT PIN

H. G. FISCHER & CO.
FRANKLIN PARK, ILLINOIS

PART NO. 17246

DATE 2-24-50 DR. BY J.V.W. CH'K'D.

REVISION	DATE	BY

PATTERN | FINISH | SCALE FULL

TOOLS | MATERIAL $\frac{1}{8}$" DIA. C.R. STEEL

DIMENSIONS
FRACTIONAL ± .015
DECIMAL ± .005
ANGULAR ± ½°
UNLESS OTHERWISE SPECIFIED

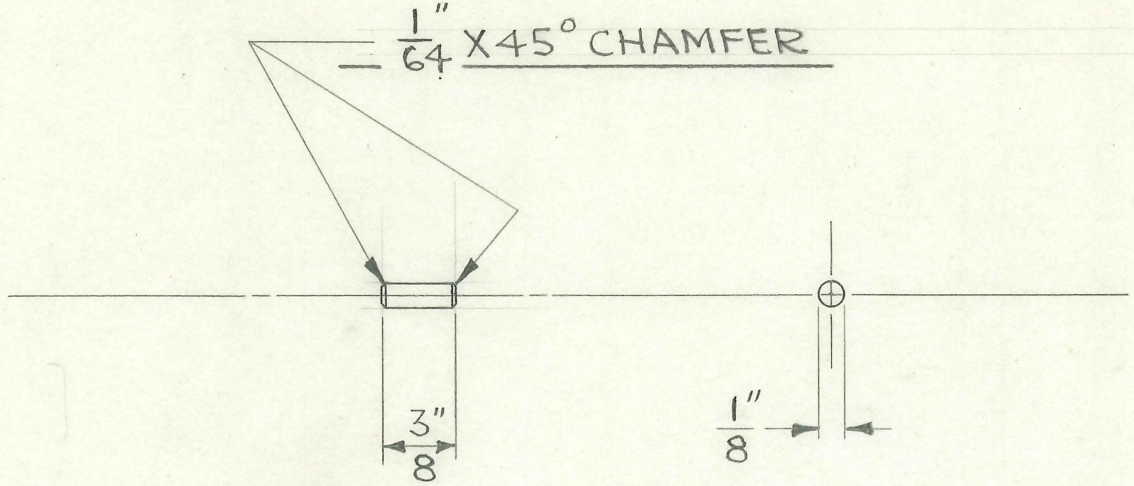

1 REQUIRED

FOLDER #127

MILLING FIXTURE TOOL # 9634
DRILL JIG TOOL # 9633

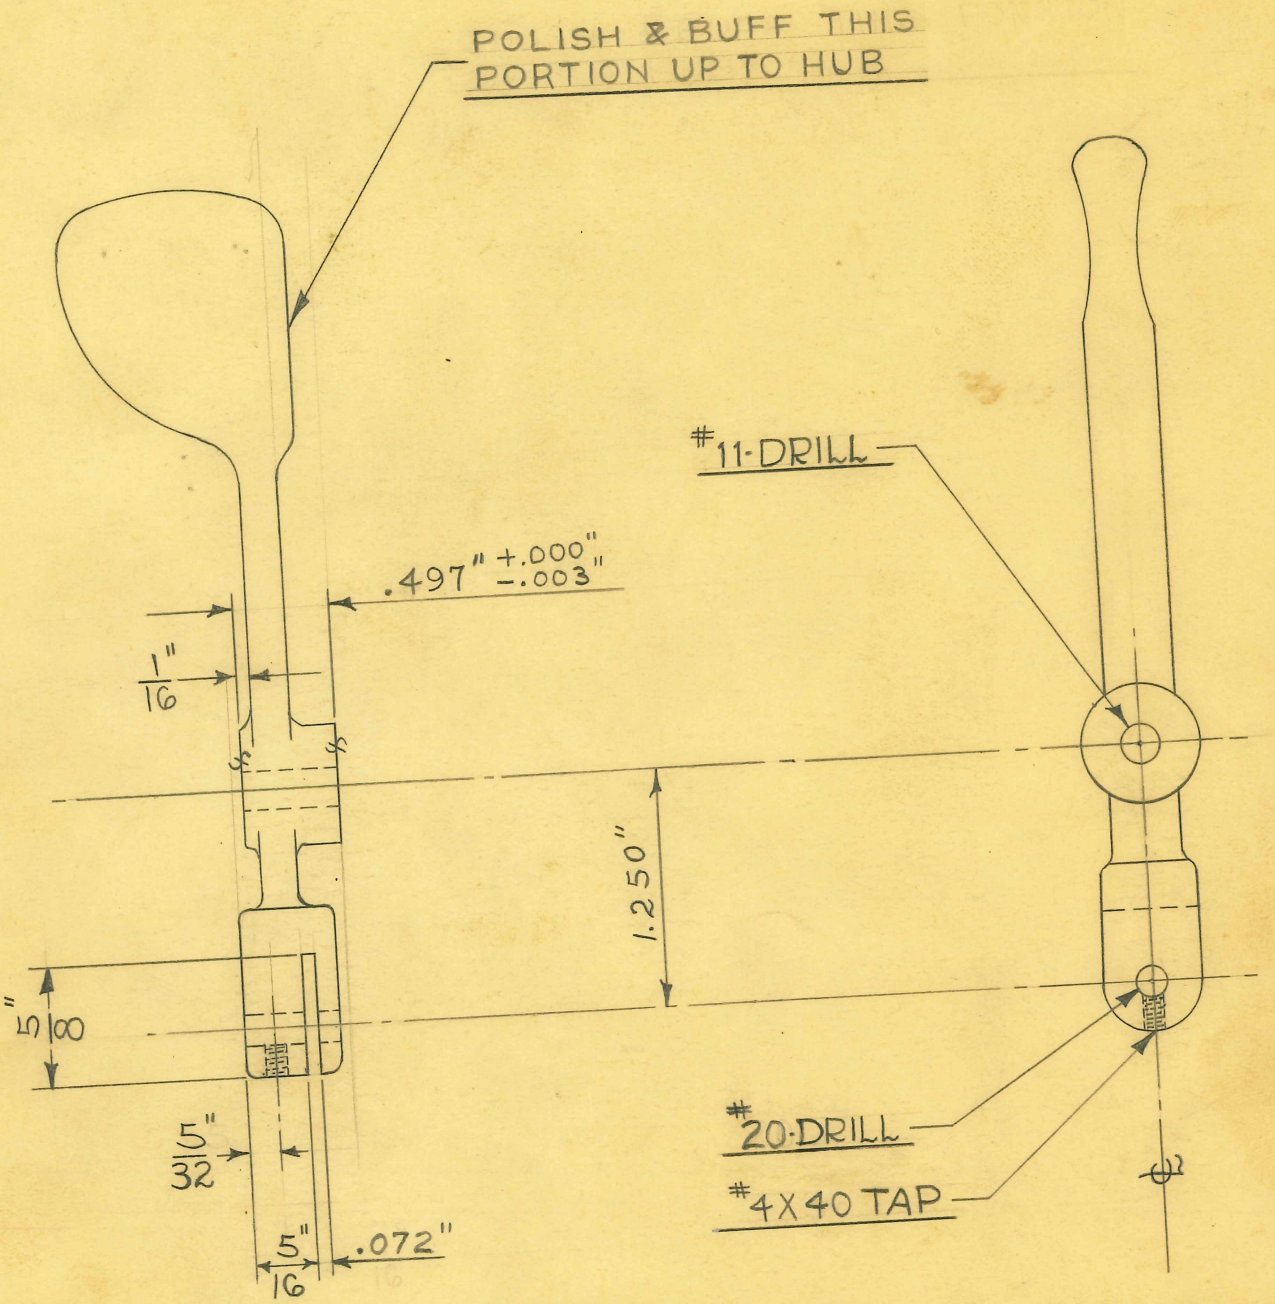

2-REQUIRED

DIMENSIONS	
FRACTIONAL	± .015
DECIMAL	± .005
ANGULAR	± 1/2°

UNLESS OTHERWISE SPECIFIED

SIZE	CAST IN	ISSUE 12-29-47	W. J.
KIND	#12 ALUM.	CHANGED	
SHAPE		"	
FINISH	SEE NOTE	"	
TEMP.		"	
	2265	"	

TITLE: FISCHER "DELUXE RF-100" X-RAY UNIT
SHUTTER LEVER

H. G. FISCHER & CO.
2335 WABANSIA AVE.
CHICAGO, ILL.

CAT. NO.

PART NO. 17253F

2 HLS. #25 DRILL

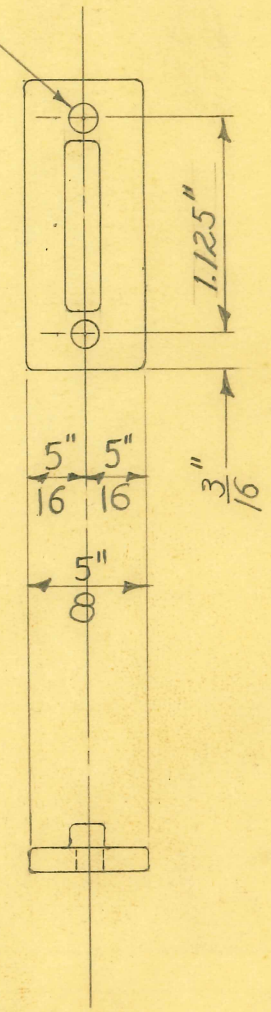

1-REQUIRED

DRILL JIG TOOL #9578

DIMENSIONS	
FRACTIONAL	± .015
DECIMAL	± .005
ANGULAR	± 1/2°

UNLESS OTHERWISE SPECIFIED

SIZE	CAST IN	ISSUE 12-1-47	J.M.F
KIND	BRASS	CHANGED	
SHAPE	CASTING	"	
FINISH	PAINTED	"	
TEMP.		"	
PATT.	#2266	"	

TITLE: FISCHER DELUXE "RF-100" X-RAY SHUTTER CABLE CLAMP

H. G. FISCHER & CO.
2335 WABANSIA AVE.
CHICAGO, ILL.

CAT. NO.

PART NO. 17254F

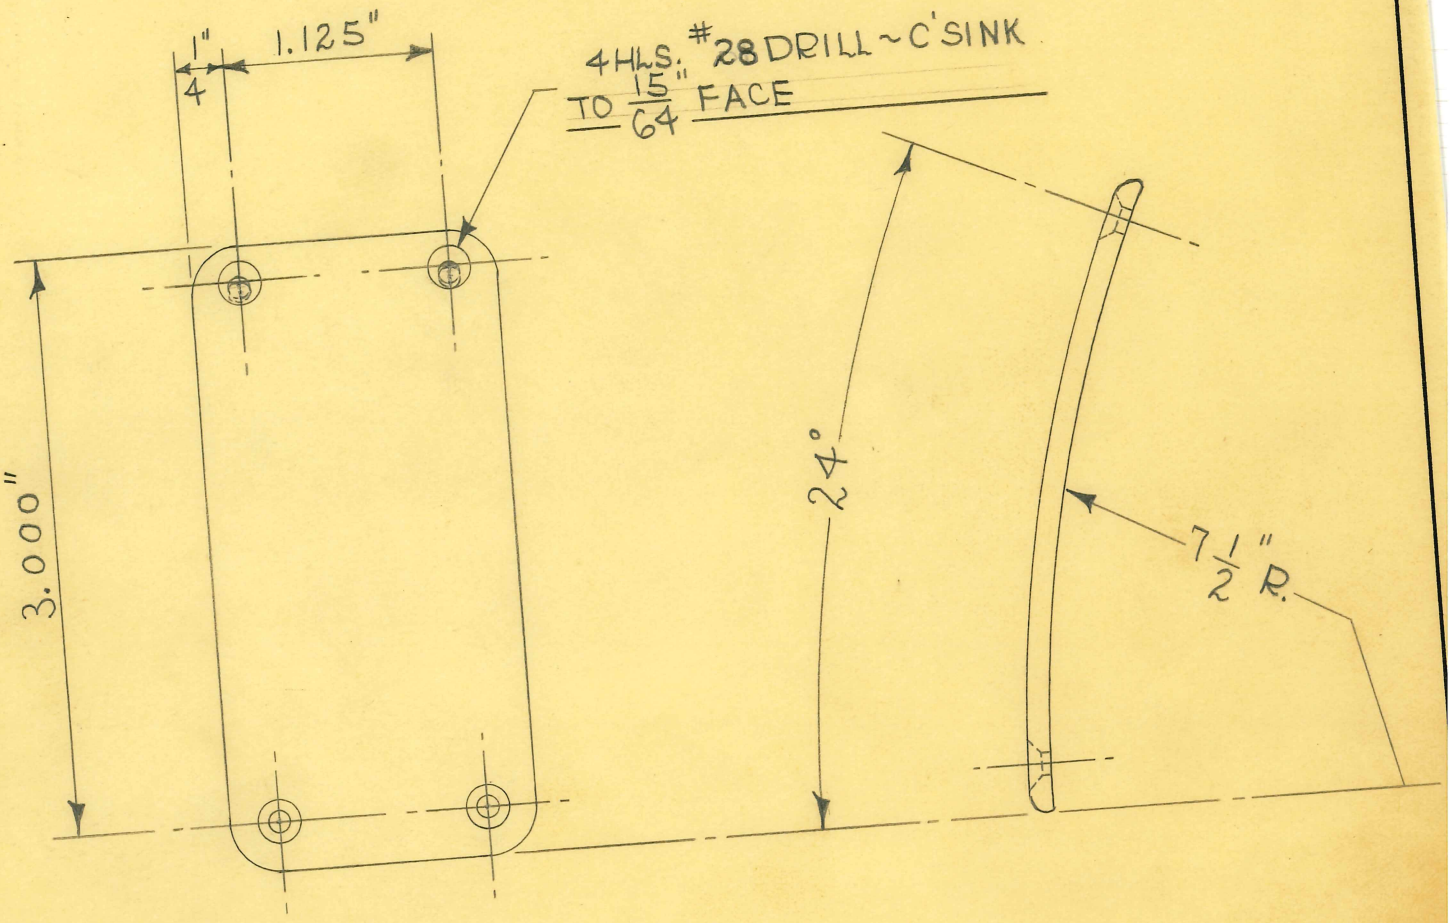

GRIND OFF PROMINENT
ROUGH SPOTS & FINS ONLY

DRILL JIG TOOL #9637

1 REQUIRED

DIMENSIONS	
FRACTIONAL	± .01
DECIMAL	± .00
ANGULAR	± 1/2

UNLESS OTHERWISE SPECIF

SIZE	CAST IN	ISSUE 12-30-47	W.J.	
KIND	# 12 ALUM.	CHANGED		
SHAPE		"		
FINISH	PAINTED	"		
TEMP.		"		
	2267	"		

TITLE: FISCHER DELUXE RF-100 X-RAY UNI
SHUTTER LEVER HOUSING COVER

H. G. FISCHER & CO.
2338 WABANSIA AVE.
CHICAGO, ILL.

CAT. NO.

PART NO. 17255

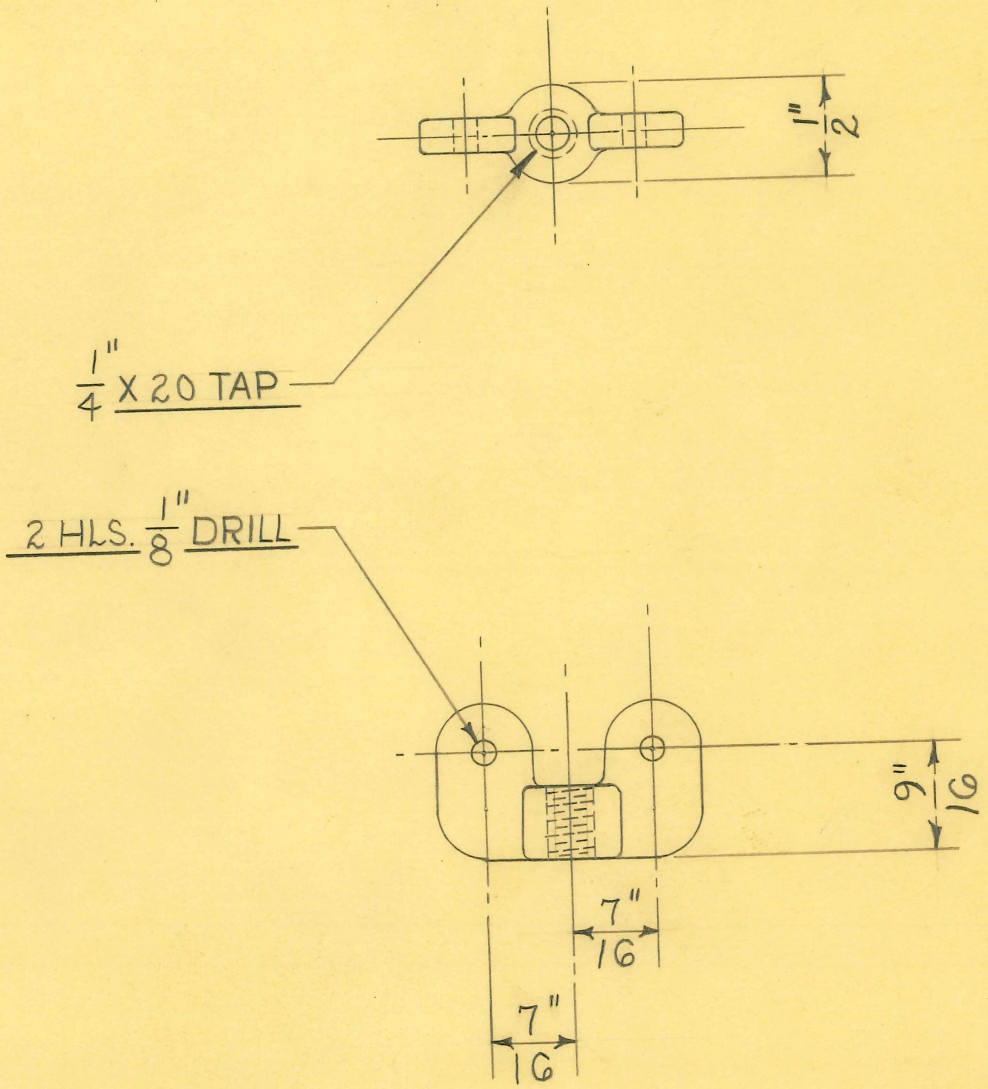

GRIND OFF PROMINENT ROUGH SPOTS ONLY

1 REQUIRED

DRILL JIG TOOL #9576

DIMENSIONS	
FRACTIONAL	± .015
DECIMAL	± .005
ANGULAR	± 1/2°

UNLESS OTHERWISE SPECIFIED

SIZE	CAST IN	ISSUE 11-24-47	W.J.
KIND	BRASS	CHANGED	
SHAPE		"	
FINISH		"	
TEMP.		"	
PATT.	2251	"	

TITLE: FISCHER DELUXE RF-100 X-RAY UNIT SPRING TENSION ADJUSTER

H. G. FISCHER & CO.
2335 WABANSIA AVE.
CHICAGO, ILL.

CAT. NO.

PART NO. 17259F

#9 DRILL

REMOVE ROUGHNESS FROM THIS FACE

5/16" R.

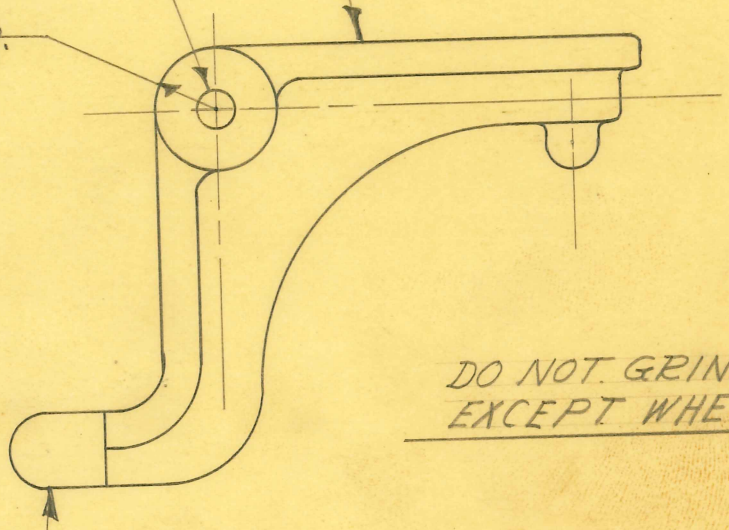

DO NOT GRIND CASTING EXCEPT WHERE SPECIFIED

SMOOTH AROUND THIS END ONLY

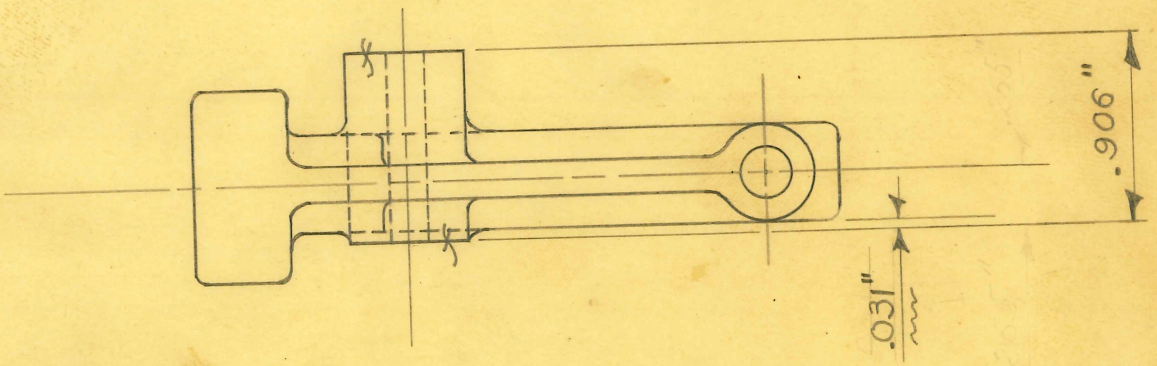

1- REQUIRED

DRILL JIG TOOL #9487

SIZE	CAST IN	ISSUE 10-14-47	J.M.F
KIND	BRONZE	CHANGED	
SHAPE	80-10-10	"	
FINISH	CAD#23	"	
TEMP.		"	
PATT.	#2215	"	

TITLE: FISCHER DELUXE RF-100 X RAY FLUOROSCOPIC LONGITUDINAL SLIDE LOCK

H. G. FISCHER & CO.
2335 WABANSIA AVE.
CHICAGO, ILL.

CAT. NO.

PART NO. 17265F

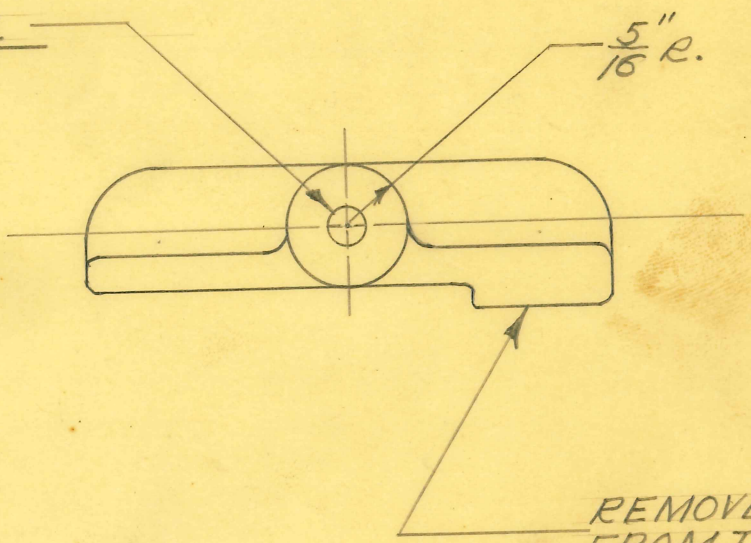

DO NOT GRIND CASTING EXCEPT WHERE SPECIFIED

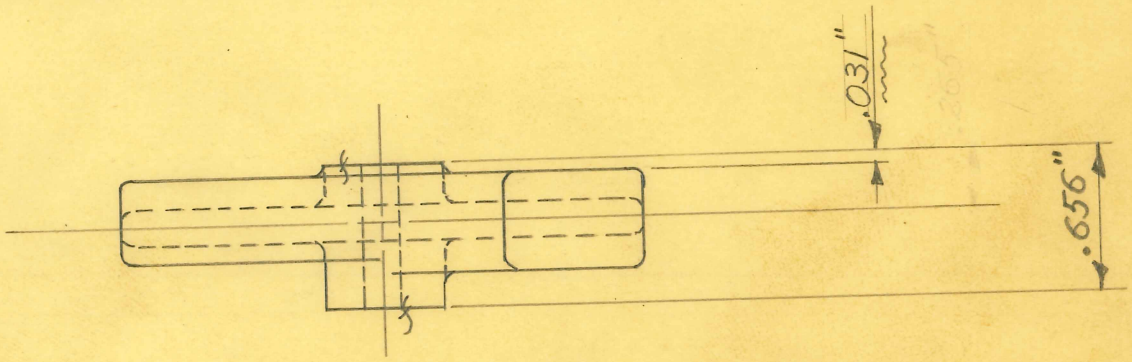

1-REQUIRED

DRILL JIG TOOL #9486

SIZE	CAST IN	ISSUE 10-14-41	J.M.F
KIND	BRONZE	CHANGED	
SHAPE	80-10-10	"	
FINISH	CAD #23	"	
TEMP.		"	
PATT.	2216	"	

TITLE: FISCHER DELUXE RF-100 FLUOROSCOPIC LATERAL SLIDE LOCK #1

H. G. FISCHER & CO.
2335 WABANSIA AVE.
CHICAGO, ILL.

CAT. NO.

PART NO. 17266F

#9 DRILL

5/16" R.

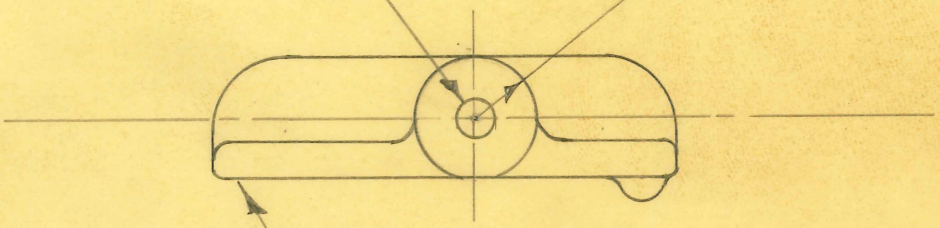

REMOVE ROUGHNESS
3/4" FROM THIS END

DO NOT GRIND CASTING
EXCEPT WHERE SPECIFIED

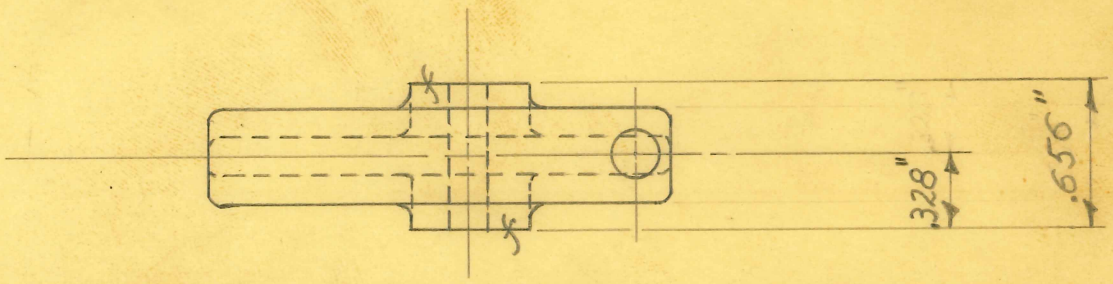

1~REQUIRED

DRILL JIG TOOL #9485

SIZE	CAST IN	ISSUE 10-14-47	J.M.F
KIND	BRONZE	CHANGED	
SHAPE	80-10-10	"	
FINISH		"	
TEMP.		"	
PATT.	#2217	"	

TITLE:
FISCHER DELUXE RF-100
FLUOROSCOPIC LATERAL SLIDE LOCK #2

H. G. FISCHER & CO.
2335 WABANSIA AVE.
CHICAGO, ILL.

CAT. NO.

PART NO. 17267F

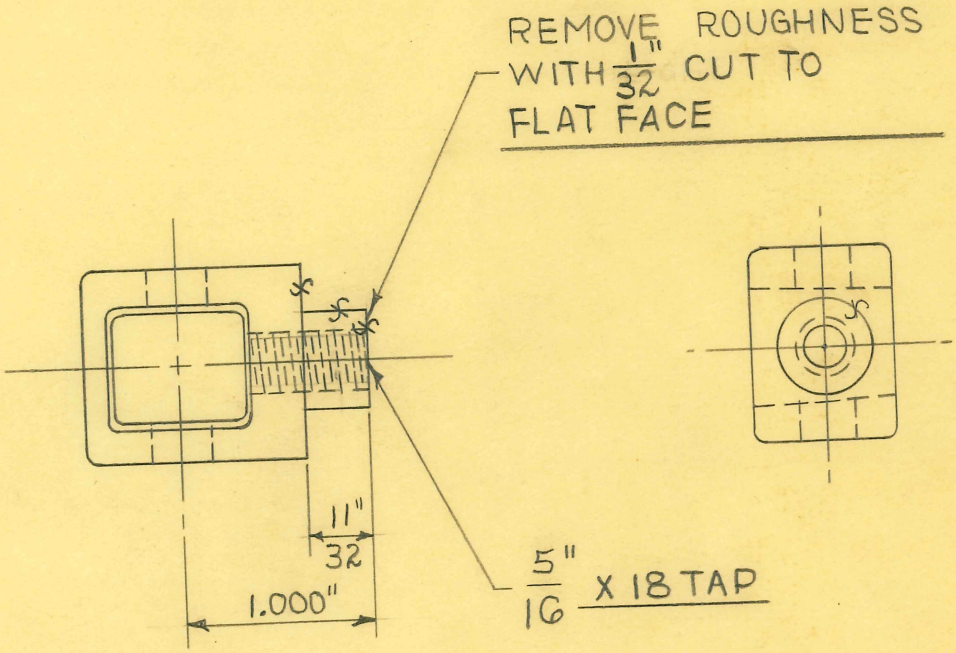

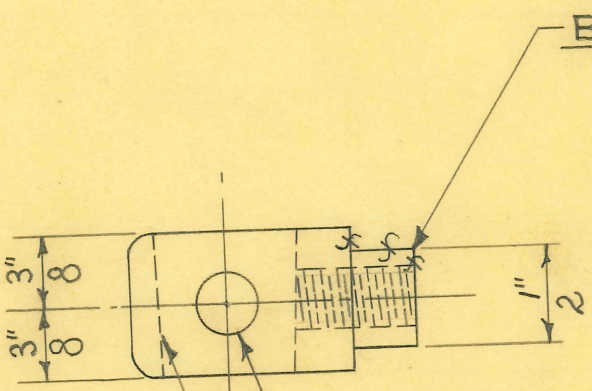

GRIND OFF PROMINENT ROUGH SPOTS ONLY

REMOVE ROUGHNESS ON INSIDE

21/64" DRILL~THRU

1 REQUIRED

TURNING JAWS TOOL #9577

DRILL JIG TOOL #9563

DIMENSIONS	
FRACTIONAL	± .015
DECIMAL	± .005
ANGULAR	± 1/2°

UNLESS OTHERWISE SPECIFIED

SIZE	80-10-10	ISSUE 11-20-47	W. J.
KIND	BRONZE	CHANGED	
SHAPE	CASTING	"	
FINISH		"	
TEMP.		"	
PATT.	2227	"	

TITLE:
FISCHER DELUXE RF-100 X-RAY UNIT
SCREEN COUNTERPOISE LOCK

H. G. FISCHER & CO.
2335 WABANSIA AVE.
CHICAGO, ILL.

CAT. NO.

PART NO. 17268 F

TITLE
FISCHER DELUXE "RF-100" X-RAY BUCKY CORD CLAMP

H. G. FISCHER & CO.
FRANKLIN PARK, ILLINOIS

PART NO. 17269

DATE 6-29-49 | DR. BY W. J. | CH'K'D. J.V.W.

REVISION	DATE	BY

PATTERN | FINISH CAD. #23 | SCALE FULL

TOOLS DRILL JIG # 11,109 | MATERIAL 1/16" X 3/8" FLAT WIRE

DIMENSIONS UNLESS OTHERWISE SPECIFIED
FRACTIONAL ± .015
DECIMAL ± .005
ANGULAR ± ½°

BENDING FIX # 11,110 TO BE USED IN ARBOR PRESS

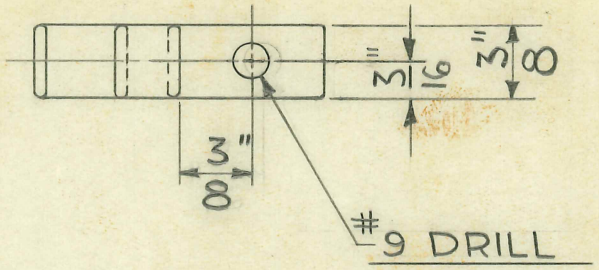

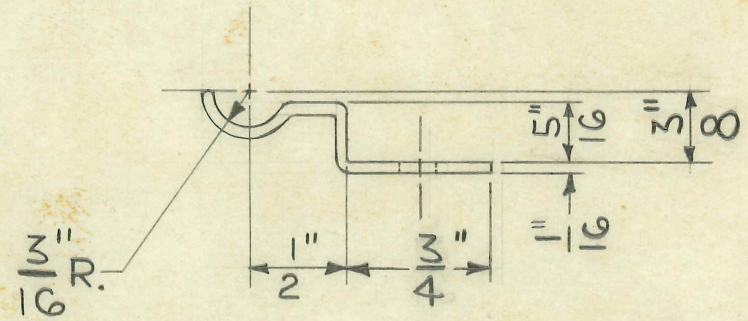

1 REQUIRED

FOLDER #127

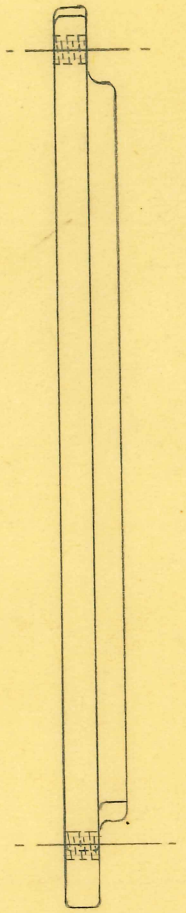

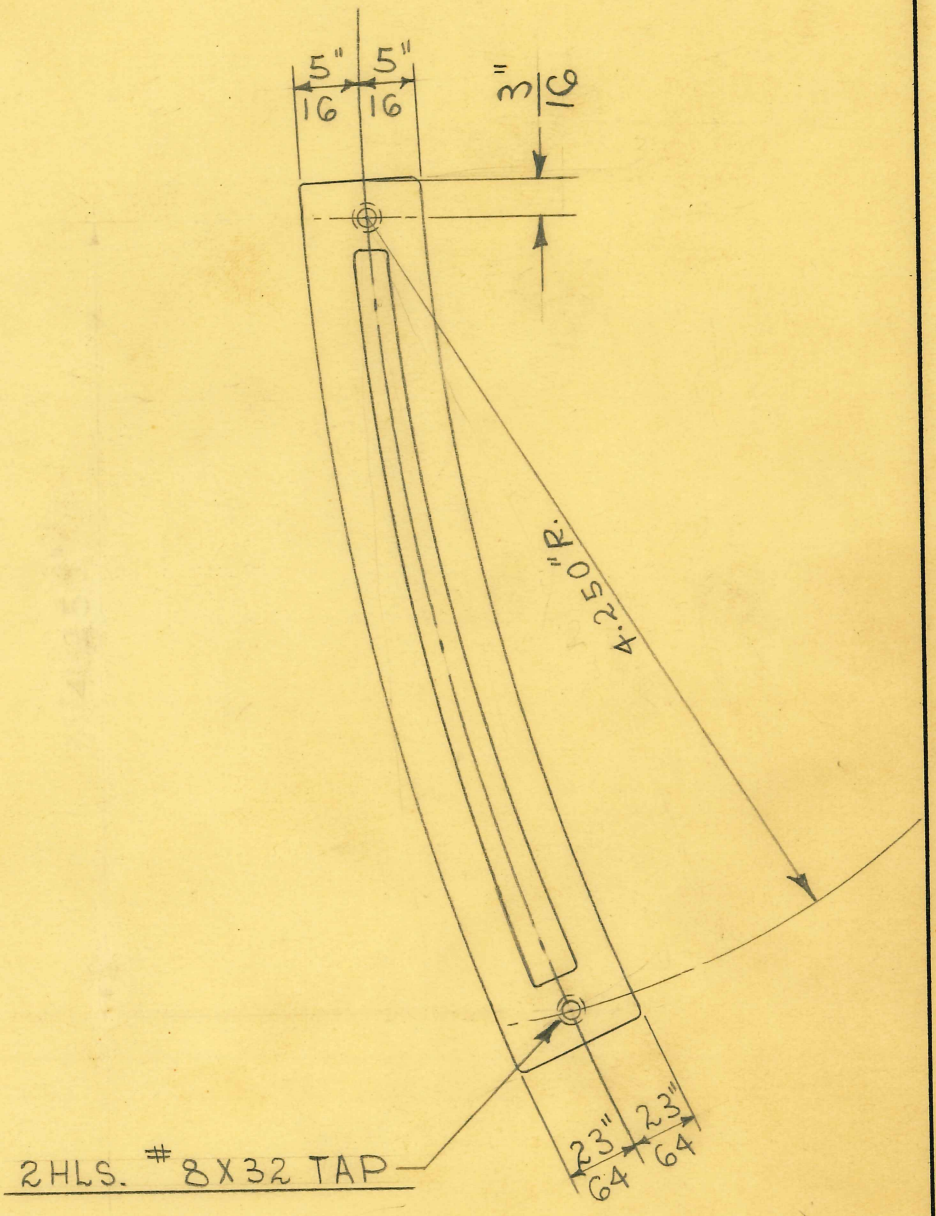

1 REQUIRED DRILL JIG TOOL # 9632

DIMENSIONS	
FRACTIONAL	± .015
DECIMAL	± .005
ANGULAR	± 1/2°

UNLESS OTHERWISE SPECIFIED

SIZE	CAST IN	ISSUE 12-24-47	W.J.
KIND	BRASS	CHANGED	
SHAPE		"	
FINISH		"	
TEMP.		"	
PATT.	2295	"	

TITLE: FISCHER DELUXE RF-100 X-RAY UNIT SHUTTER CABLE CLAMP

H. G. FISCHER & CO.
2338 WABANSIA AVE.
CHICAGO, ILL.

CAT. NO.

PART NO. 17279F

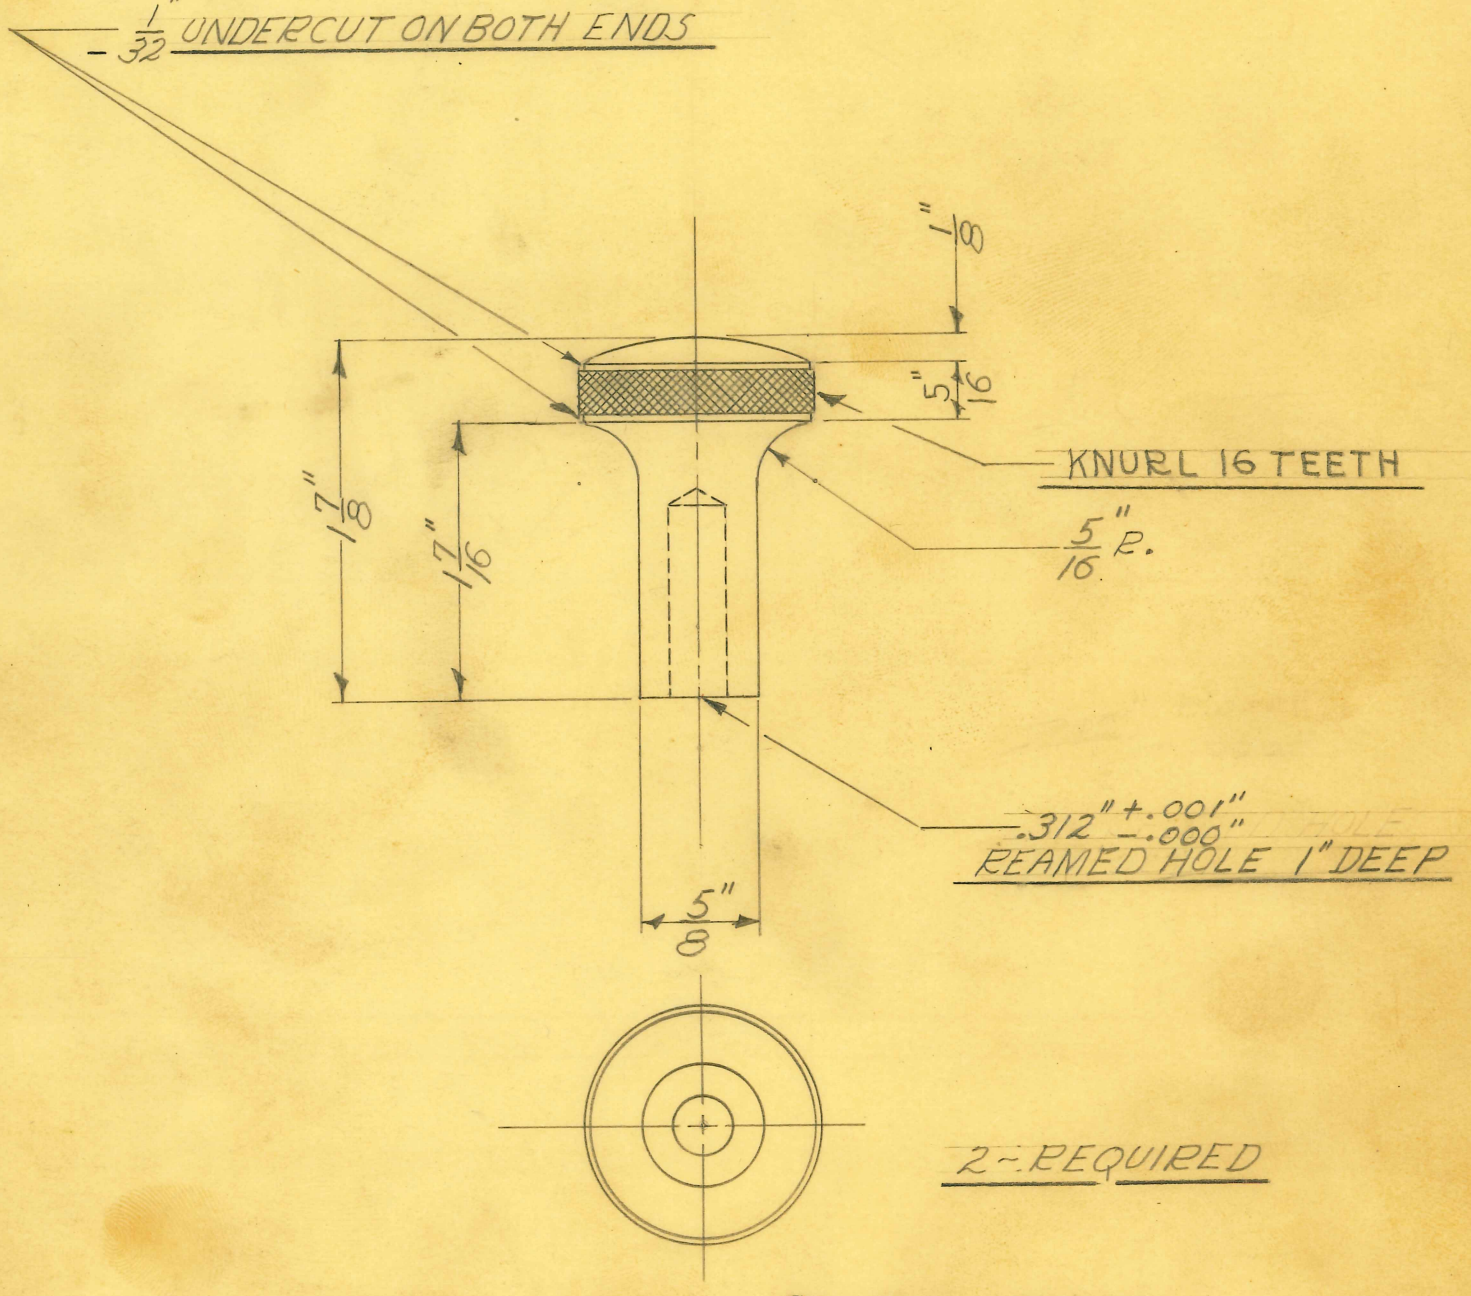

POLISH & BUFF

BOX TOOL SECTION
RECESSING TOOL # 9511

SIZE	1 1/4" DIAM.	ISSUE 10-16-47	J.M.F
KIND	ALUM. 17ST	CHANGED	
SHAPE	ROD	"	
FINISH	SEE NOTE	"	
TEMP.		"	
PATT.		"	

TITLE:
FISCHER DELUXE RF-100
FLOURSCOPIC SLIDE LOCK
LATERAL & LONGITUDINAL ADJ. KNOB

H. G. FISCHER & CO.
2335 WABANSIA AVE.
CHICAGO, ILL.

CAT. NO.

PART NO. 17283

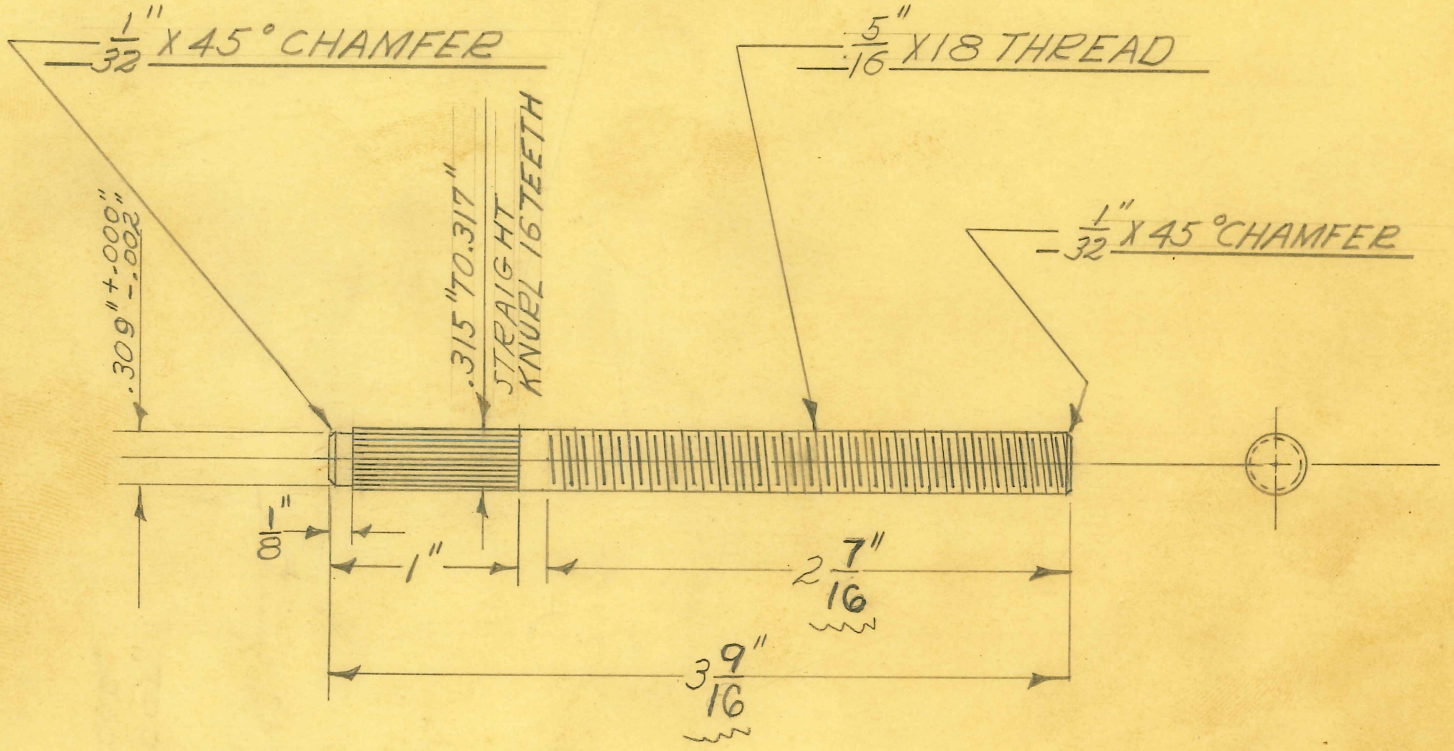

1-REQUIRED

SPLIT BUSHING TOOL # 9512

SIZE	5/16 DIAM.	ISSUE 10-16-47	J.M.F
KIND	C.R. STEEL	CHANGED	
SHAPE	ROD	"	
FINISH	CAD. #23	"	
TEMP.		"	
PATT.		"	

TITLE:
FISCHER DELUXE RF-100
FLOURSCOPIC SLIDE LOCK
LATERAL ADJ. ROD

H. G. FISCHER & CO.
2335 WABANSIA AVE.
CHICAGO, ILL.

CAT. NO.

PART NO. 17284

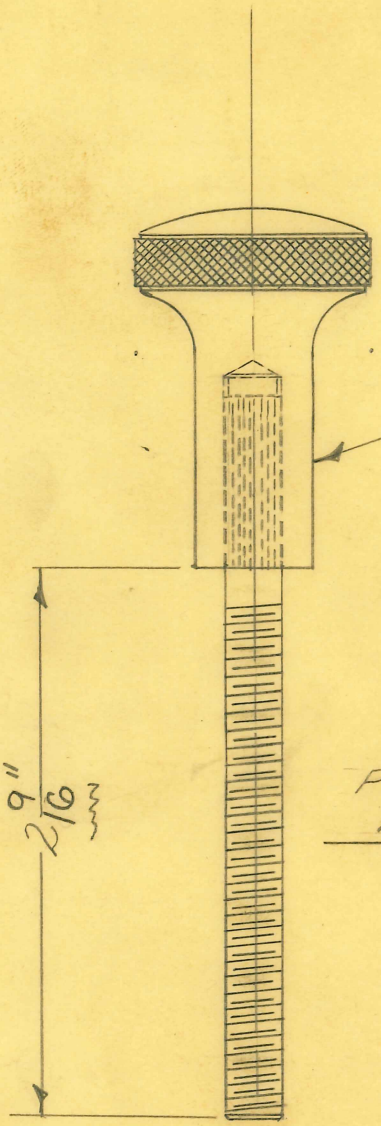

PRESS PCE. #17284 ROD INTO PCE. #17283 KNOB

1 ~ REQUIRED

ASSEMBLY FIXTURE TOOL #9510

SIZE		ISSUE 10-16-47	J.M.F
KIND		CHANGED	
SHAPE		"	
FINISH		"	
TEMP.		"	
PATT.		"	

TITLE: FISCHER DELUXE RF.-100 FLUOROSCOPIC SLIDE LOCK LATERAL ADJ. ROD & KNOB ASSEM.

H. G. FISCHER & CO.
2335 WABANSIA AVE.
CHICAGO, ILL.

CAT. NO.

PART NO. 17285 G

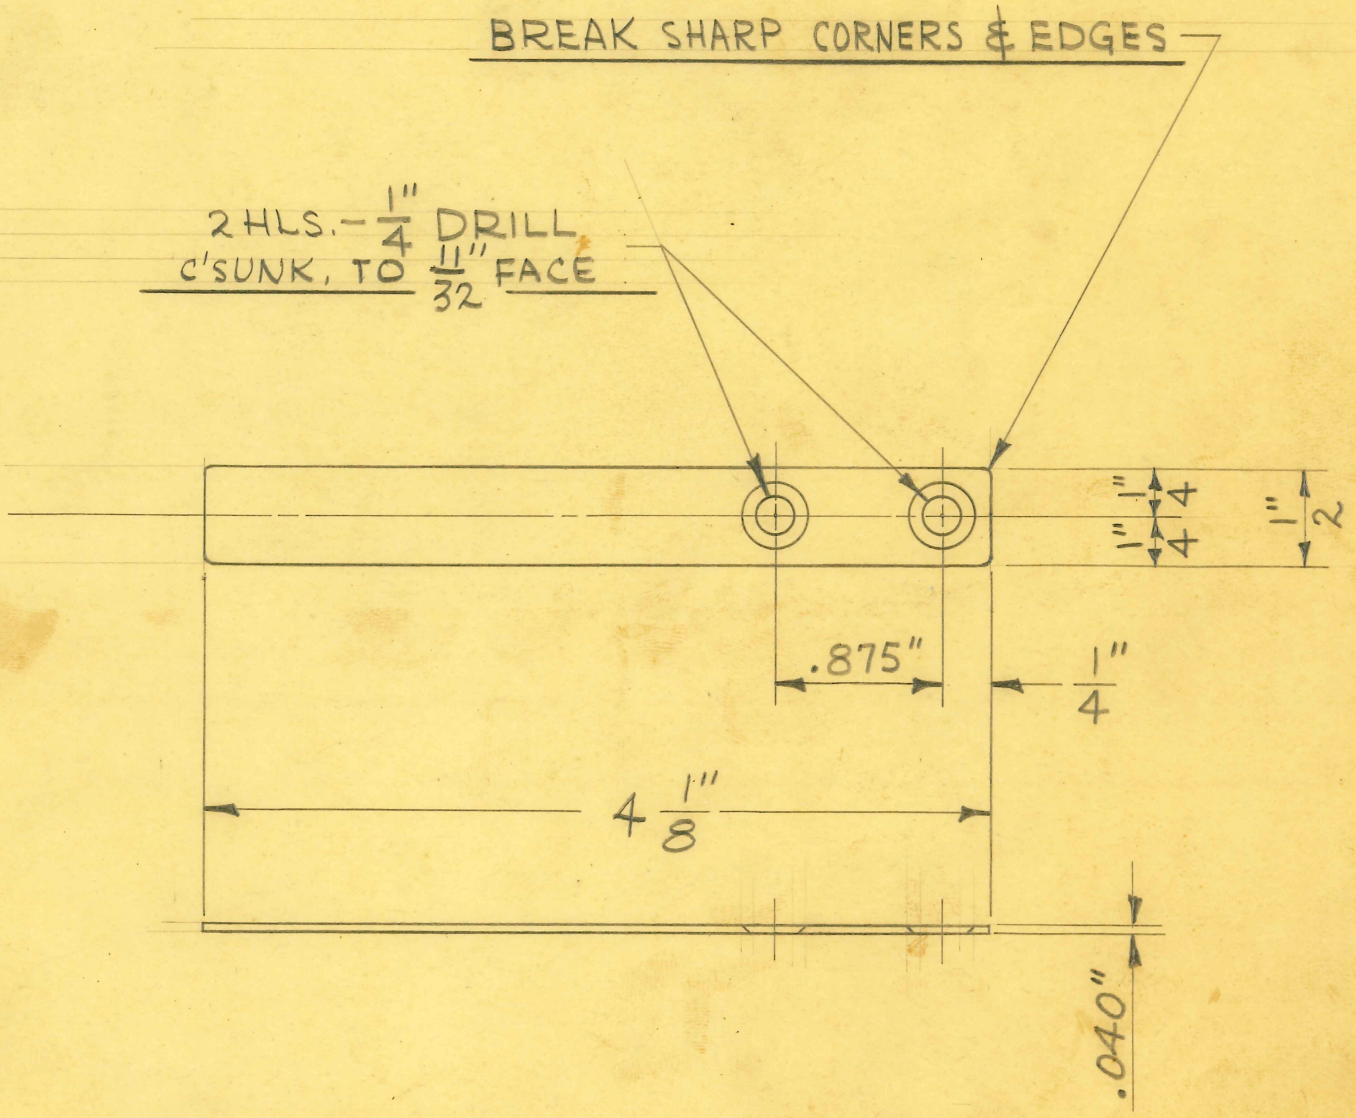

1 REQUIRED

DRILL JIG TOOL #9502

#18 GA. (.040") X 1/2" SHEARED PHOS. BRONZE

SIZE		ISSUE 10-17-47	J.N.W.
KIND		CHANGED	
SHAPE		"	
FINISH		"	
TEMP.		"	
PATT.		"	

TITLE: FISCHER "DELUXE RF-100" X-RAY TUBE STAND BRAKE PAD

H. G. FISCHER & CO.
2338 WABANSIA AVE.
CHICAGO, ILL.

CAT. NO.

PART NO. 17287

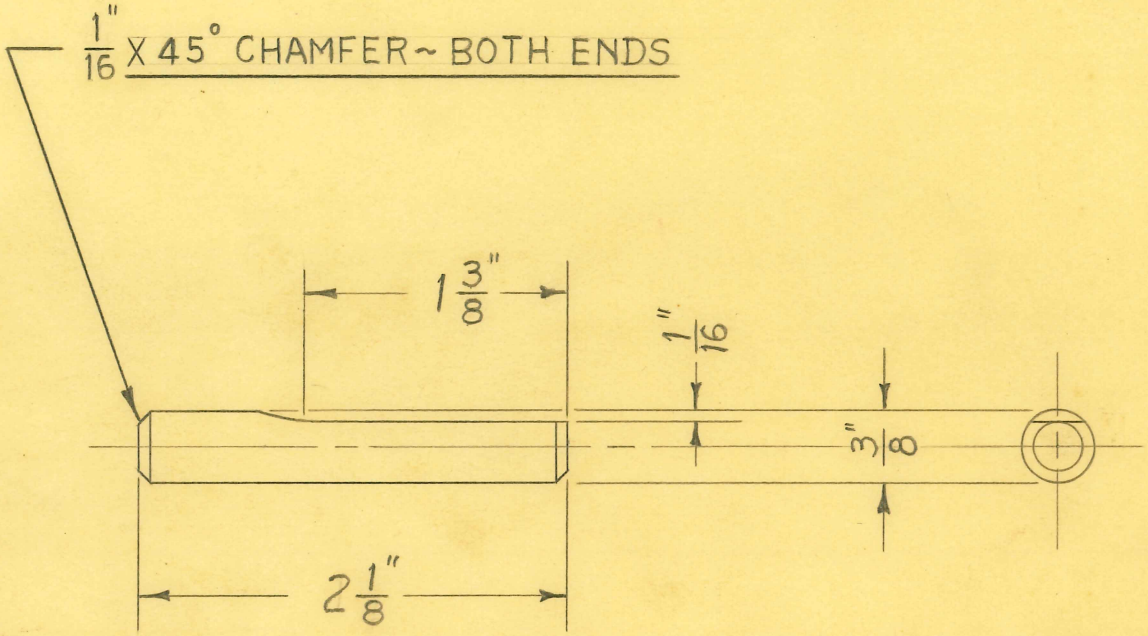

2 - REQUIRED

DIMENSIONS	
FRACTIONAL	± .015
DECIMAL	± .005
ANGULAR	± 1/2°

UNLESS OTHERWISE SPECIFIED

SIZE	3/8" DIA.	ISSUE 5-7-48	J.B.G.
KIND	C.R. STEEL	CHANGED	
SHAPE	ROD	"	
FINISH	CAD. #23	"	
TEMP.		"	
PATT.		"	

TITLE:
FISCHER "DELUXE RF-100" X-RAY UNIT
FLOOR RAIL CENTER SUPP. BRACKET ROD

H. G. FISCHER & CO.
2338 WABANSIA AVE.
CHICAGO, ILL.

CAT. NO.

PART NO. 17288A

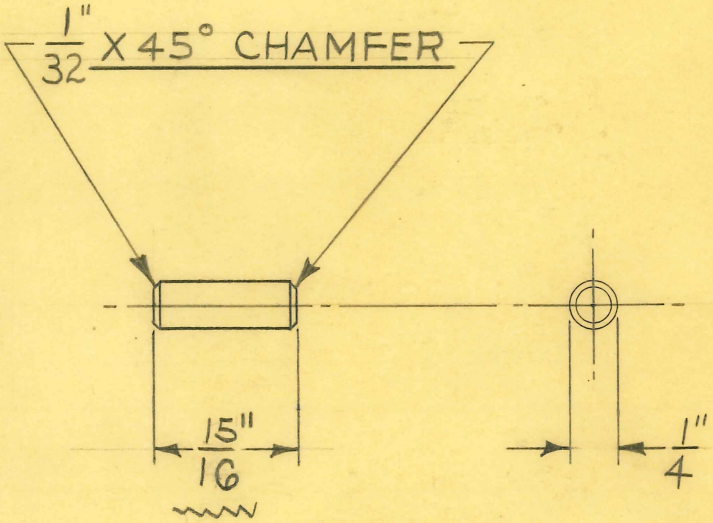

2 REQUIRED

DIMENSIONS	
FRACTIONAL	± .015
DECIMAL	± .005
ANGULAR	± ½°

UNLESS OTHERWISE SPECIFIED

SIZE	1/4" DIA.	ISSUE 10-23-47	W.J.
KIND	JEWELERS	CHANGED	
SHAPE	ROD	"	
FINISH	CAD. #23	"	
TEMP.		"	
PATT.		"	

TITLE:
FISCHER DELUXE RF 100 X-RAY UNIT
HORIZONTAL SLIDE LOCATING PIN

H. G. FISCHER & CO.
2335 WABANSIA AVE.
CHICAGO, ILL.

CAT. NO.

PART NO. 17291

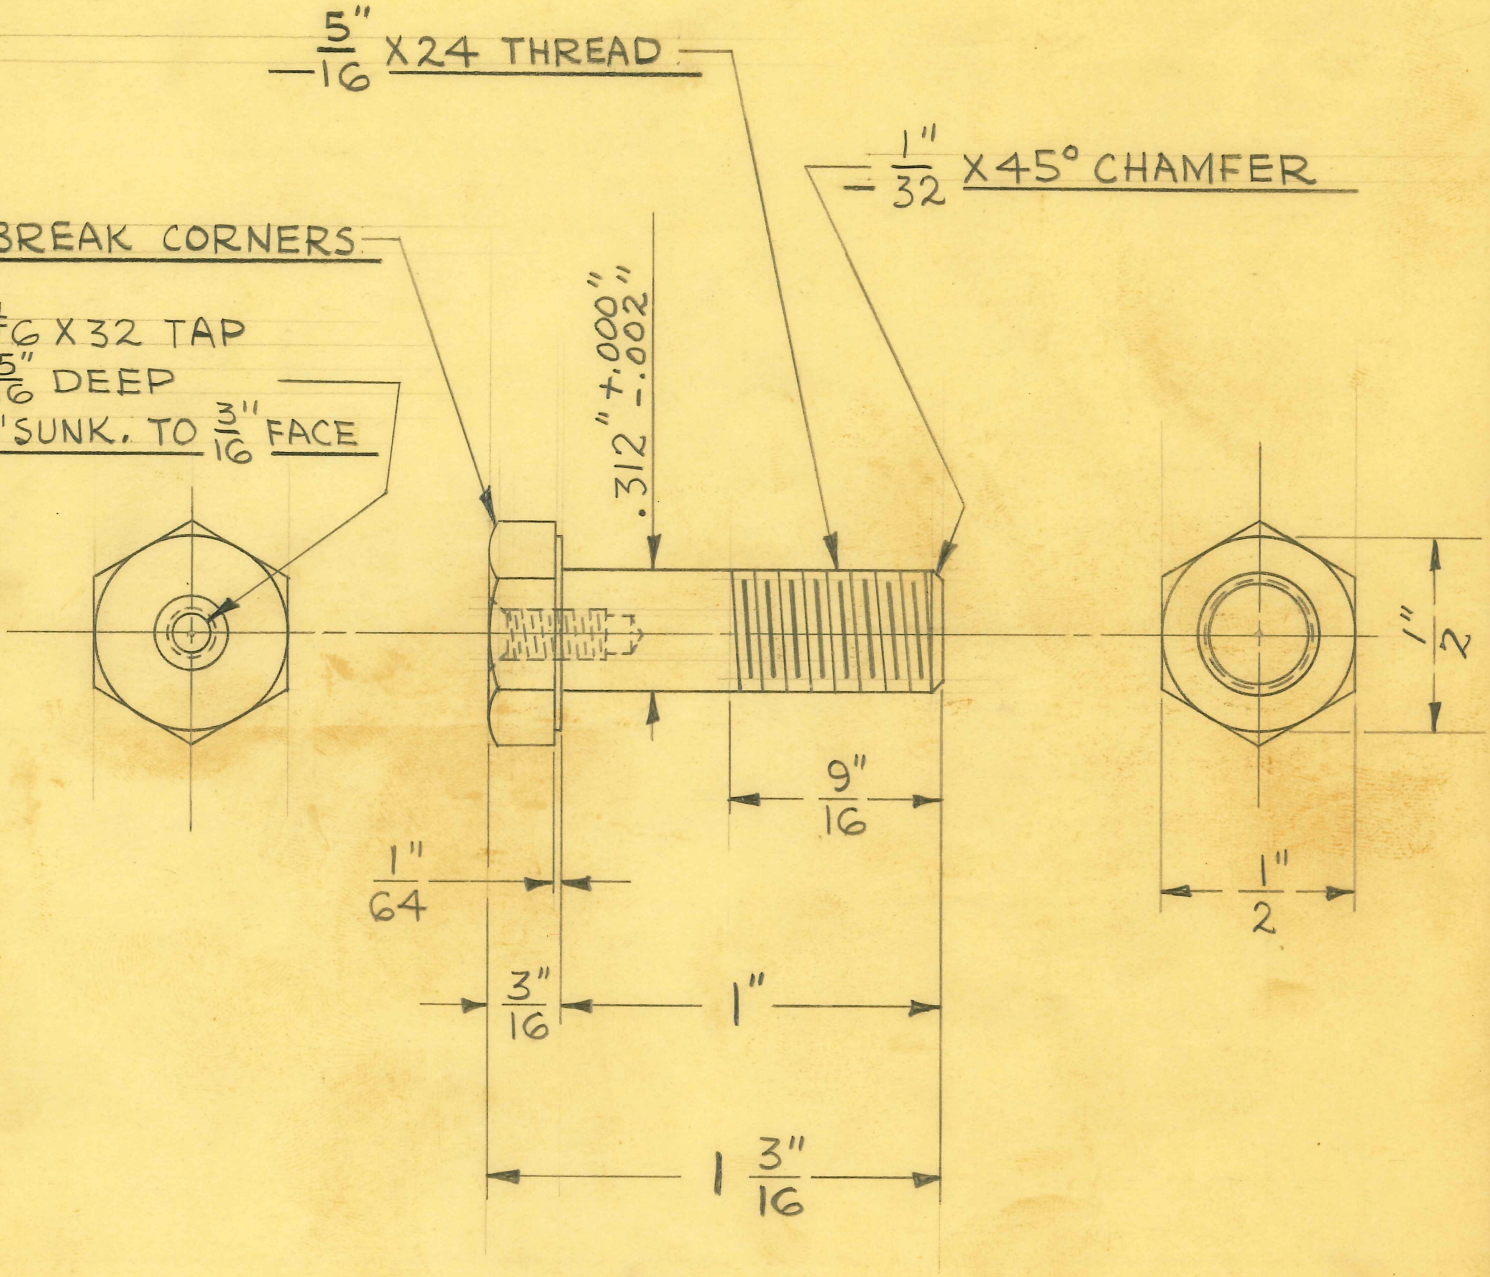

SCALE ~ DOUBLE SIZE

2 REQUIRED

DIMENSIONS	
FRACTIONAL	± .015
DECIMAL	± .005
ANGULAR	± 1/2°

UNLESS OTHERWISE SPECIFIED

SIZE	½" HEX.	ISSUE 11-15-47	J.V.W.
KIND	C.R. STEEL	CHANGED	
SHAPE	BAR	"	
FINISH	CAD. #23	"	
TEMP.		"	
PATT.		"	

TITLE: FISCHER DELUXE "RF-100" X-RAY GUIDE BAR BEARING SCREW

H. G. FISCHER & CO.
2335 WABANSIA AVE.
CHICAGO, ILL.

CAT. NO.

PART NO. 17295

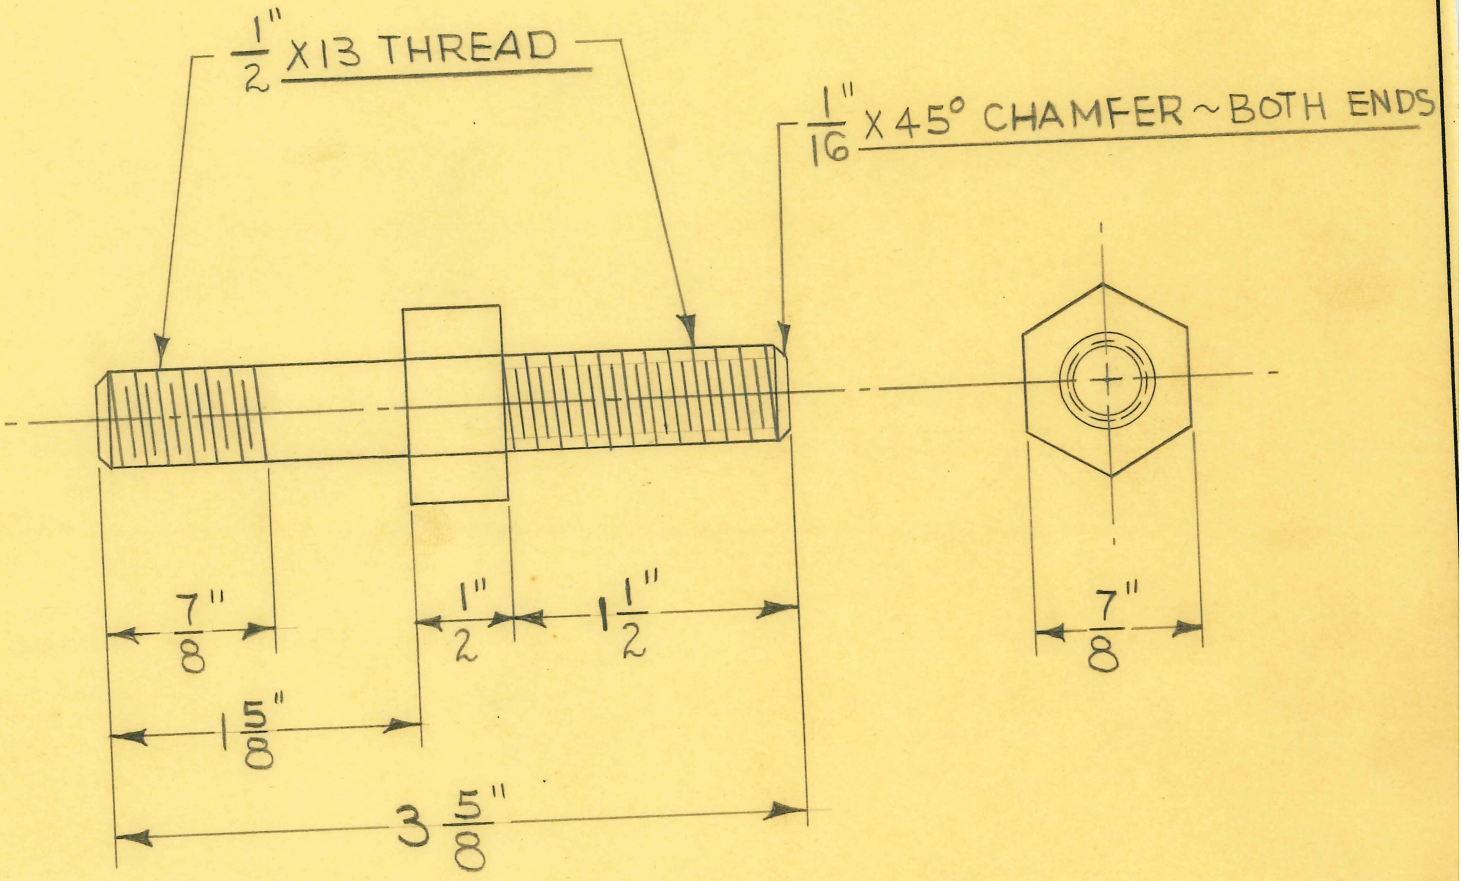

4 REQUIRED

SIZE	7/8" HEX	ISSUE 10-28-47	W.J.	TITLE: FISCHER DELUXE RF-100 X-RAY UNIT FLOOR RAIL LEVELING ROD
KIND	C.R. STEEL	CHANGED		
SHAPE		"		
FINISH	CAD #23	"		
TEMP.		"		
PATT.		"		

H. G. FISCHER & CO.
2335 WABANSIA AVE.
CHICAGO, ILL.

CAT. NO.

PART NO. 17296

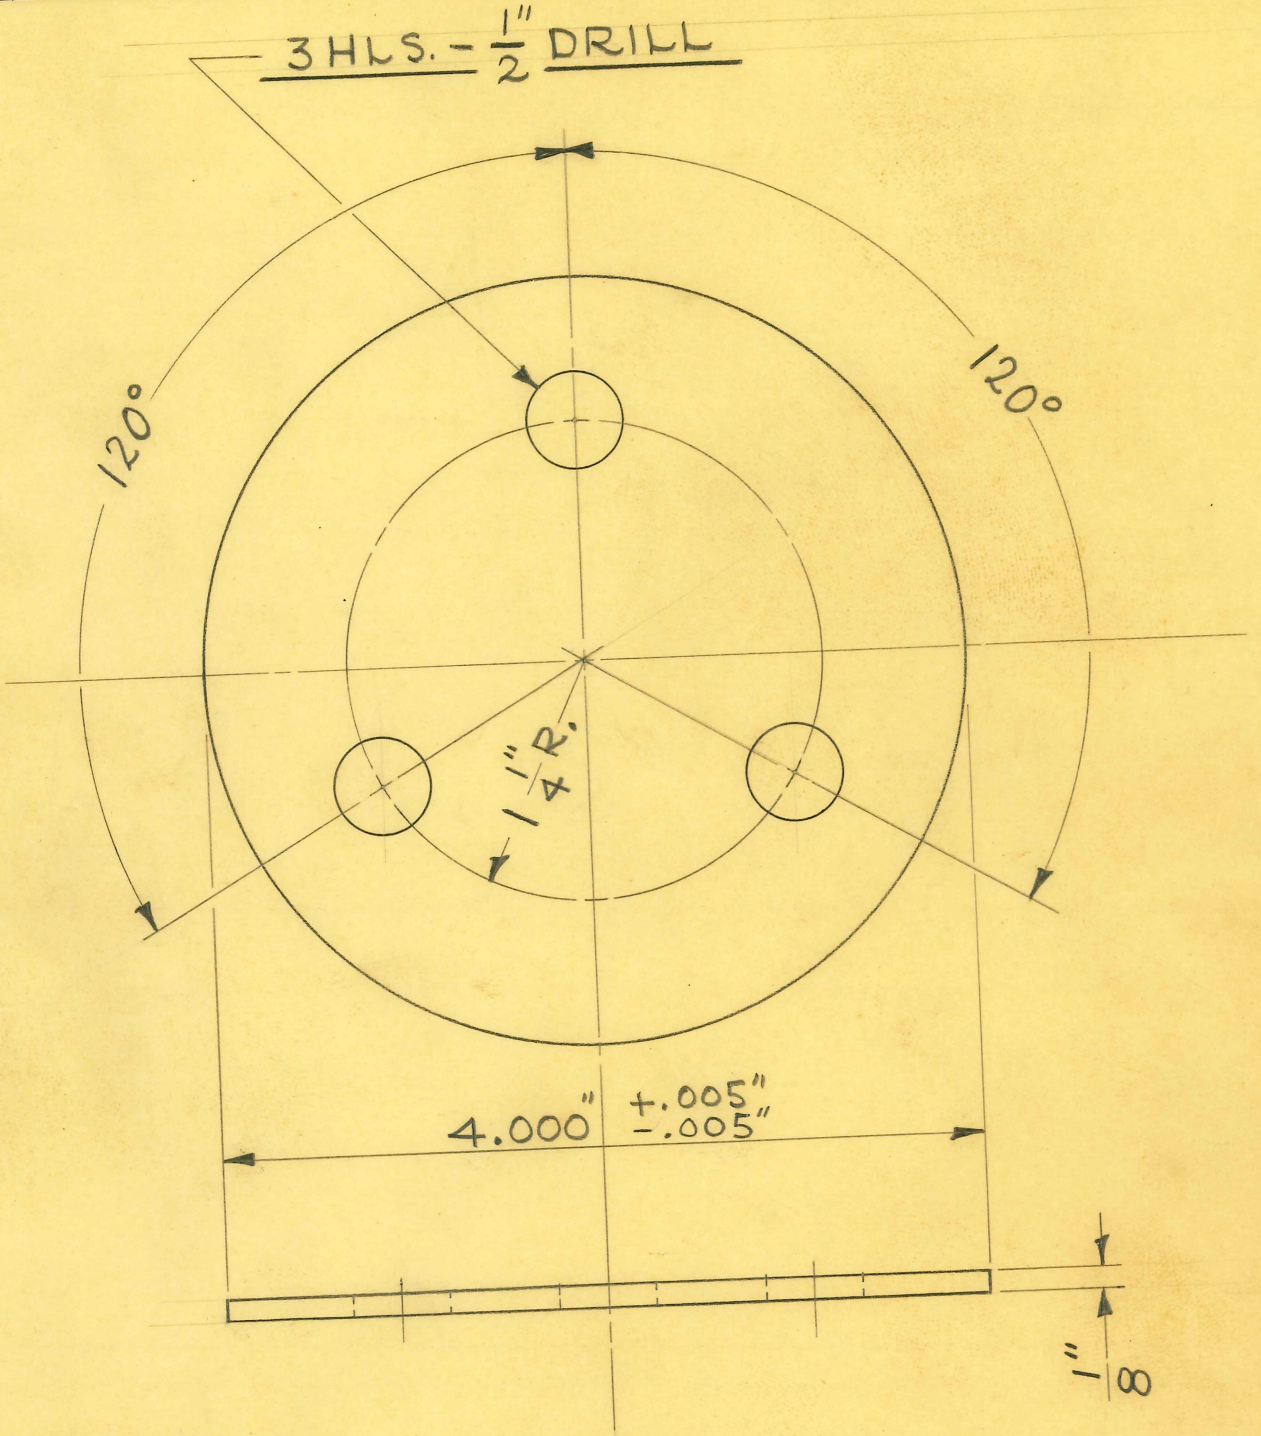

1 REQUIRED

SIZE	1/8" SHEET	ISSUE	10-29-47	J.V.W.
KIND	C.R. STEEL	CHANGED		
SHAPE		"		
FINISH		"		
TEMP.		"		
PATT.		"		

TITLE: FISCHER DELUXE "RF-100" X-RAY CWT. BUMPER DISC

H. G. FISCHER & CO.
2335 WABANSIA AVE.
CHICAGO, ILL.

CAT. NO.

PART NO. 17297

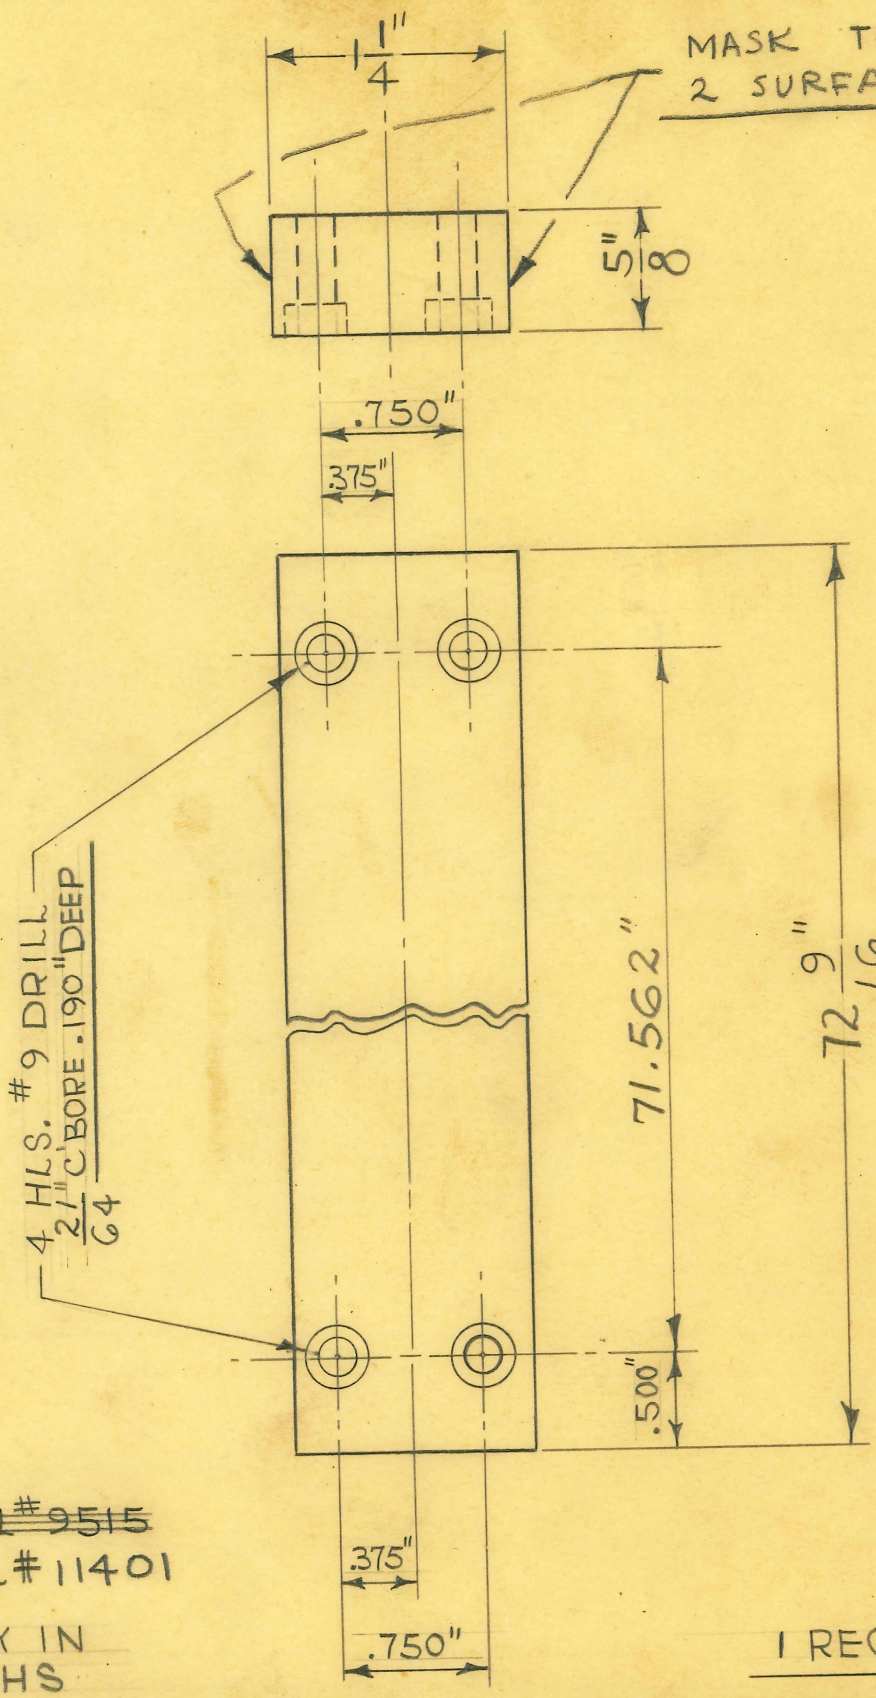

~~DRILL JIG TOOL # 9515~~

DRILL JIG-TOOL # 11401

ORDER STOCK IN 20 FT. LENGTHS

FINISH — CAD. #23 THEN PAINT

1 REQUIRED

SIZE	5/8" X 1 1/4"	ISSUE	1-4-47	W.J.
KIND	C.R. STEEL	CHANGED		
SHAPE	BAR	GAGING CHANGED	8-14-50	J.V.W.
FINISH	~~CHROME #2~~	"		
~~TEMP.~~	~~ALL OVER~~	"		
PATT.		"		

TITLE:
FISCHER "DELUXE RF-100" X-RAY UNIT
UPRIGHT GUIDE BAR

H. G. FISCHER & CO.
2335 WABANSIA AVE.
CHICAGO, ILL.

CAT. NO.

PART NO. 17298

ROUND EDGES
APPROX. 1/32" RADIUS

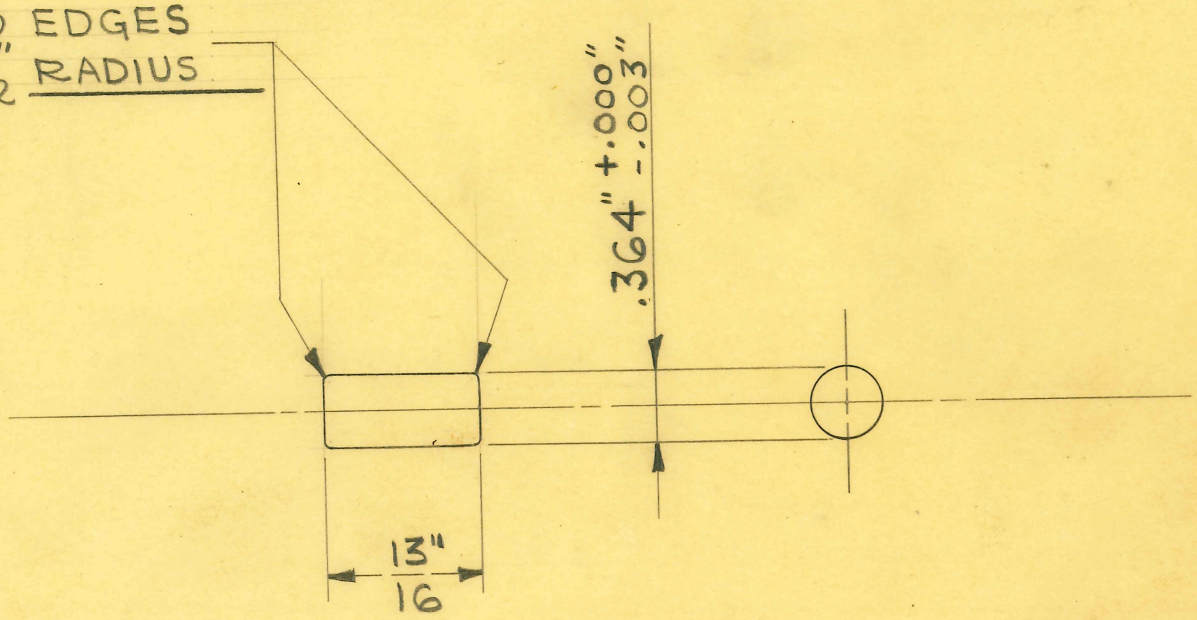

1 REQUIRED

SIZE	3/8" DIA.	ISSUE 10-29-47	J.V.W.	TITLE: FISCHER DELUXE "RF-100" X-RAY VERTICAL SLIDE CLAMP SLUG
KIND	BRASS ROD	CHANGED		
SHAPE		"		
FINISH		"		
TEMP.		"		
PATT.		"		

H. G. FISCHER & CO.
2335 WABANSIA AVE.
CHICAGO, ILL.

CAT. NO.

PART NO. 17299

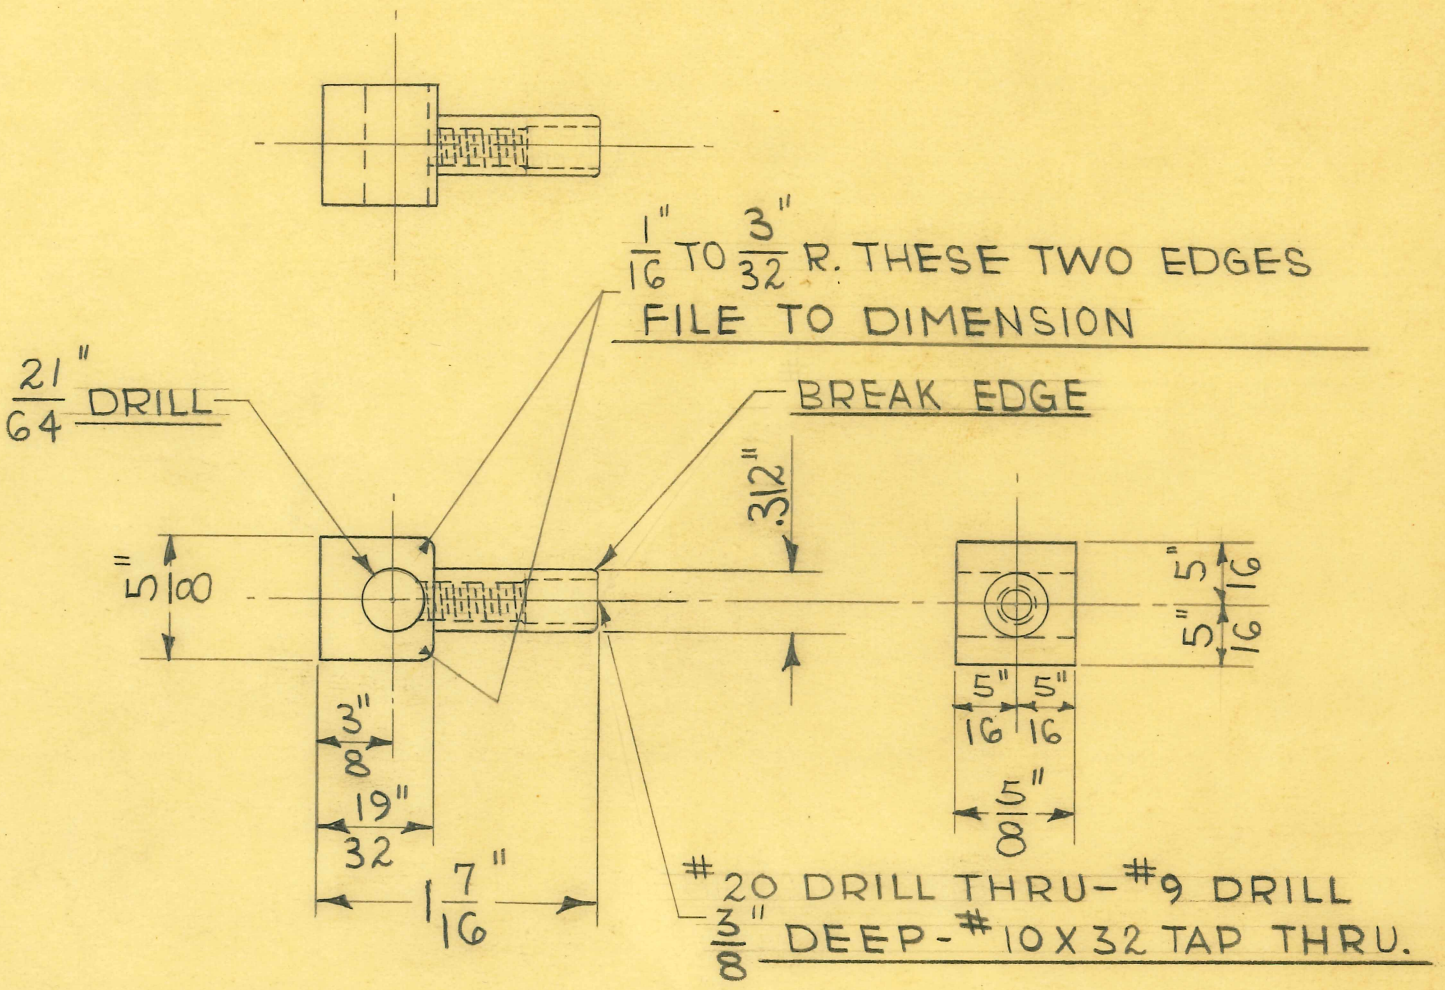

2-REQUIRED

DRILL JIG TOOL #9444

DIMENSIONS	
FRACTIONAL	± .015
DECIMAL	± .005
ANGULAR	± 1/2°

UNLESS OTHERWISE SPECIFIED

SIZE	5/8" SQUARE	ISSUE 5-4-48	W.J.
KIND	BRASS	CHANGED	
SHAPE	BAR	" 12-10-48	W.J.
FINISH	CAD. #23	"	
TEMP.		"	
PATT.		"	

TITLE:

FISCHER "DELUXE RF-100" X-RAY UNIT

STERO LOCK

H. G. FISCHER & CO.
2335 WABANSIA AVE.
CHICAGO, ILL.

CAT. NO.

PART NO. 17302

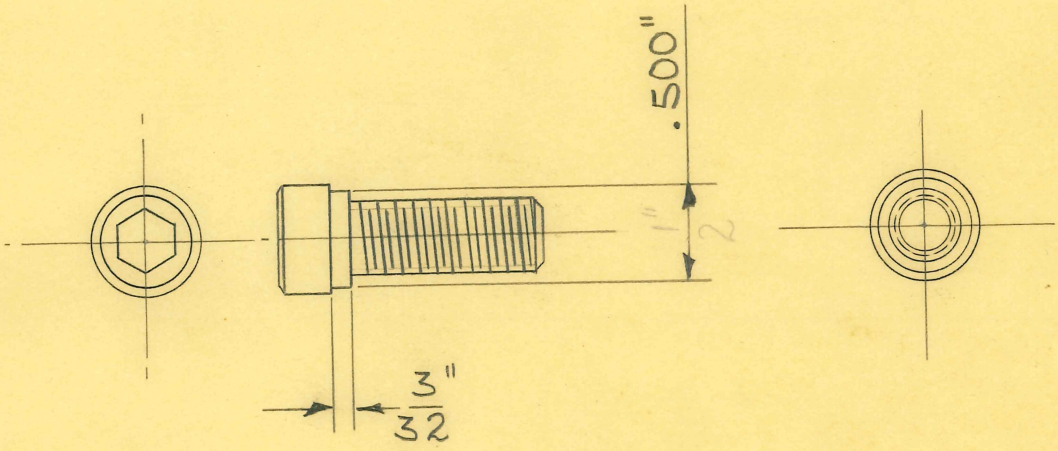

2 REQUIRED

$\frac{3}{8}$" X24 X1" SOCKET HEAD CAP SCREW

DIMENSIONS	
FRACTIONAL	± .015
DECIMAL	± .005
ANGULAR	± 1/2°

UNLESS OTHERWISE SPECIFIED

SIZE	FROM	ISSUE 5-24-48	W.J.
KIND	10290	CHANGED	
SHAPE		"	
FINISH		"	
TEMP.		"	
PATT.		"	

TITLE: FISCHER DELUXE "RF-100" X-RAY UPRIGHT TUBE SUPP. BEARING SCREW

H. G. FISCHER & CO.
2335 WABANSIA AVE.
CHICAGO, ILL.

CAT. NO.

PART NO. 17303

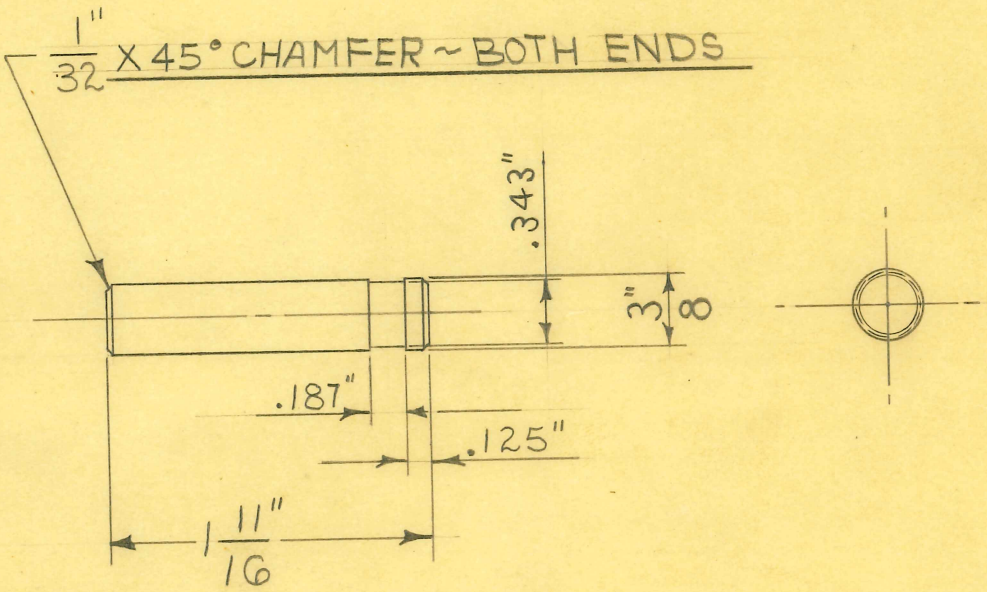

1 REQUIRED

SIZE	3/8" DIA.	ISSUE 11-3-47	W.J.
KIND	C.R. STEEL	CHANGED	
SHAPE	ROD	"	
FINISH	CAD. #23	"	
TEMP.		"	
PATT.		"	

TITLE: FISCHER DELUXE RF-100 X-RAY UNIT
COUNTERWEIGHT PULLEY SHAFT

H. G. FISCHER & CO.
2335 WABANSIA AVE.
CHICAGO, ILL.

CAT. NO.

PART NO. 17304

TITLE
FISCHER DELUXE "RF-100" X-RAY
BASE STOP VERTICAL TUBE

H. G. FISCHER & CO.
FRANKLIN PARK, ILLINOIS

PART NO. 17305A

REVISION	DATE	BY

DATE 7-12-51 | DR. BY J.V.W. | CH'K'D.

PATTERN | FINISH PAINTED | SCALE FULL

TOOLS
DRILL JIG # 9542

MATERIAL 1" O.D. X #11 GA. (.120") WALL
SEAMLESS STEEL TUBING

DIMENSIONS UNLESS OTHERWISE SPECIFIED

FRACTIONAL	± .015
DECIMAL	± .005
ANGULAR	± ½°

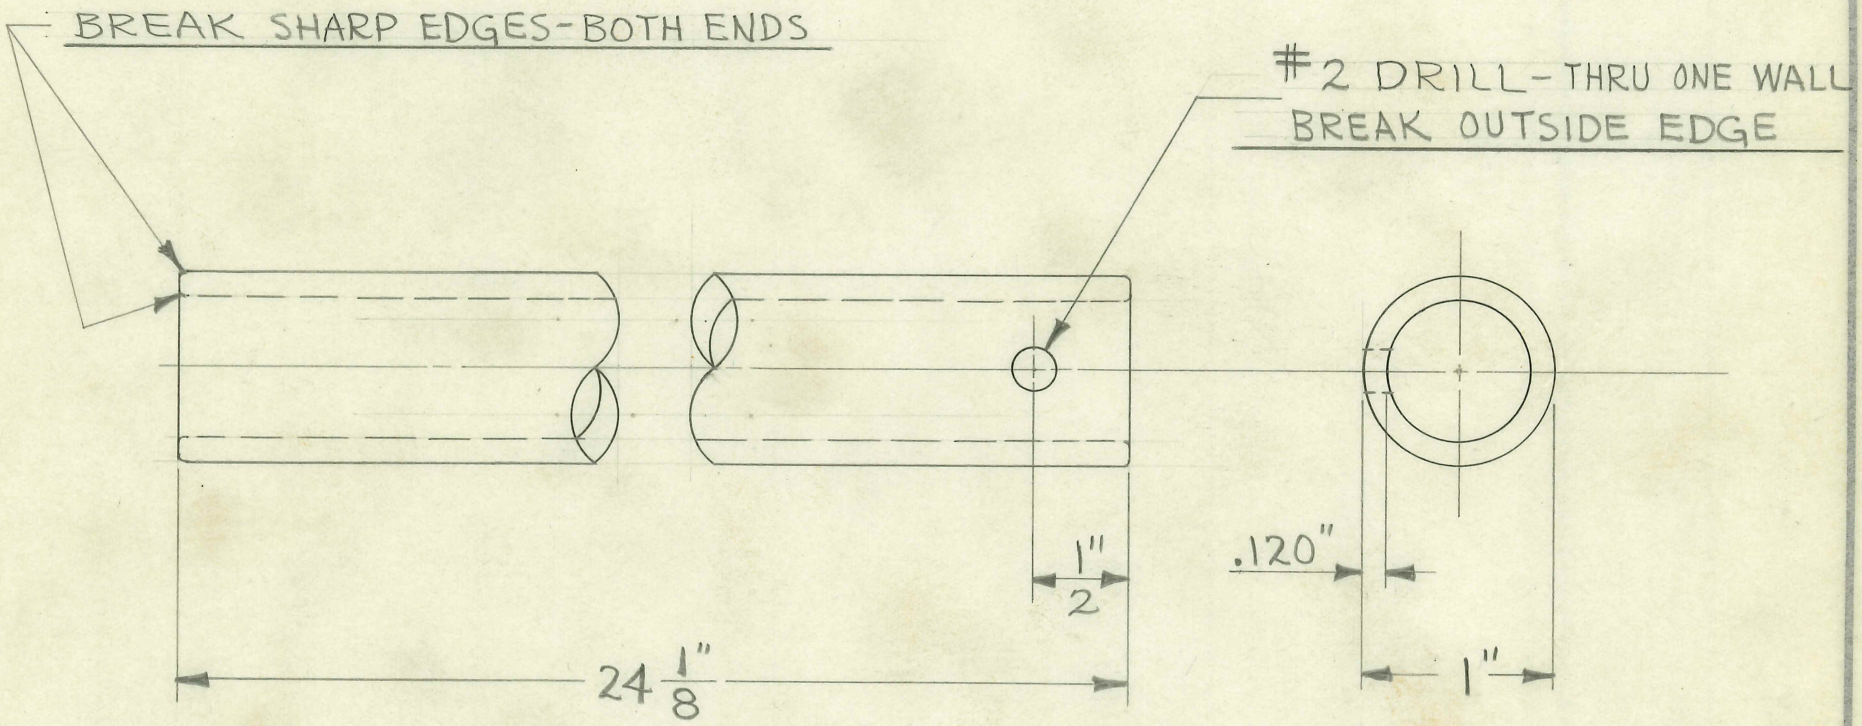

1 REQUIRED

FOLDER #127

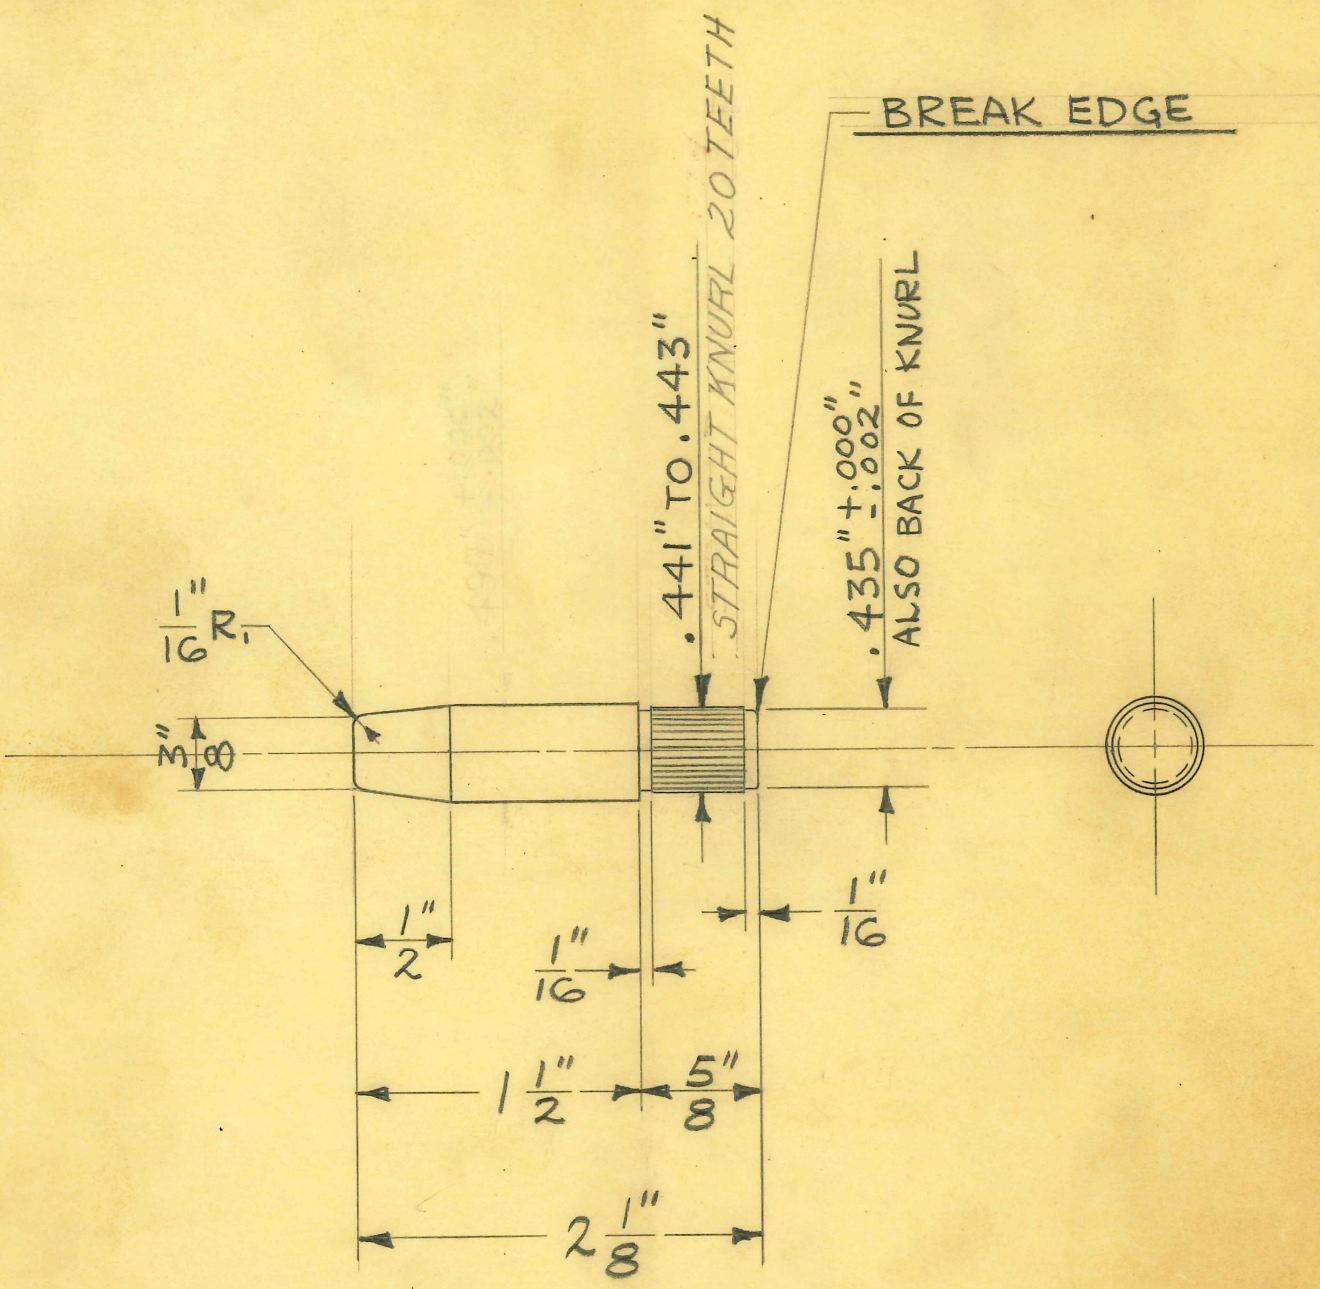

2 REQUIRED

1/2" DIA JEWELERS ROD

SIZE	~~1/2" DIA.~~	ISSUE 5-6-47	J.V.W.
KIND	~~C.R.STEEL~~	CHANGED 6-4-47	W.J.
SHAPE		"	
FINISH	CAD.#23	"	
TEMP.		"	
PATT.		"	

TITLE: FISCHER "MP-20" X-RAY UNIT CONTROL SUPPORT PIN - LOWER

H. G. FISCHER & CO.
2335 WABANSIA AVE.
CHICAGO, ILL.

CAT. NO.

PART NO. 16571

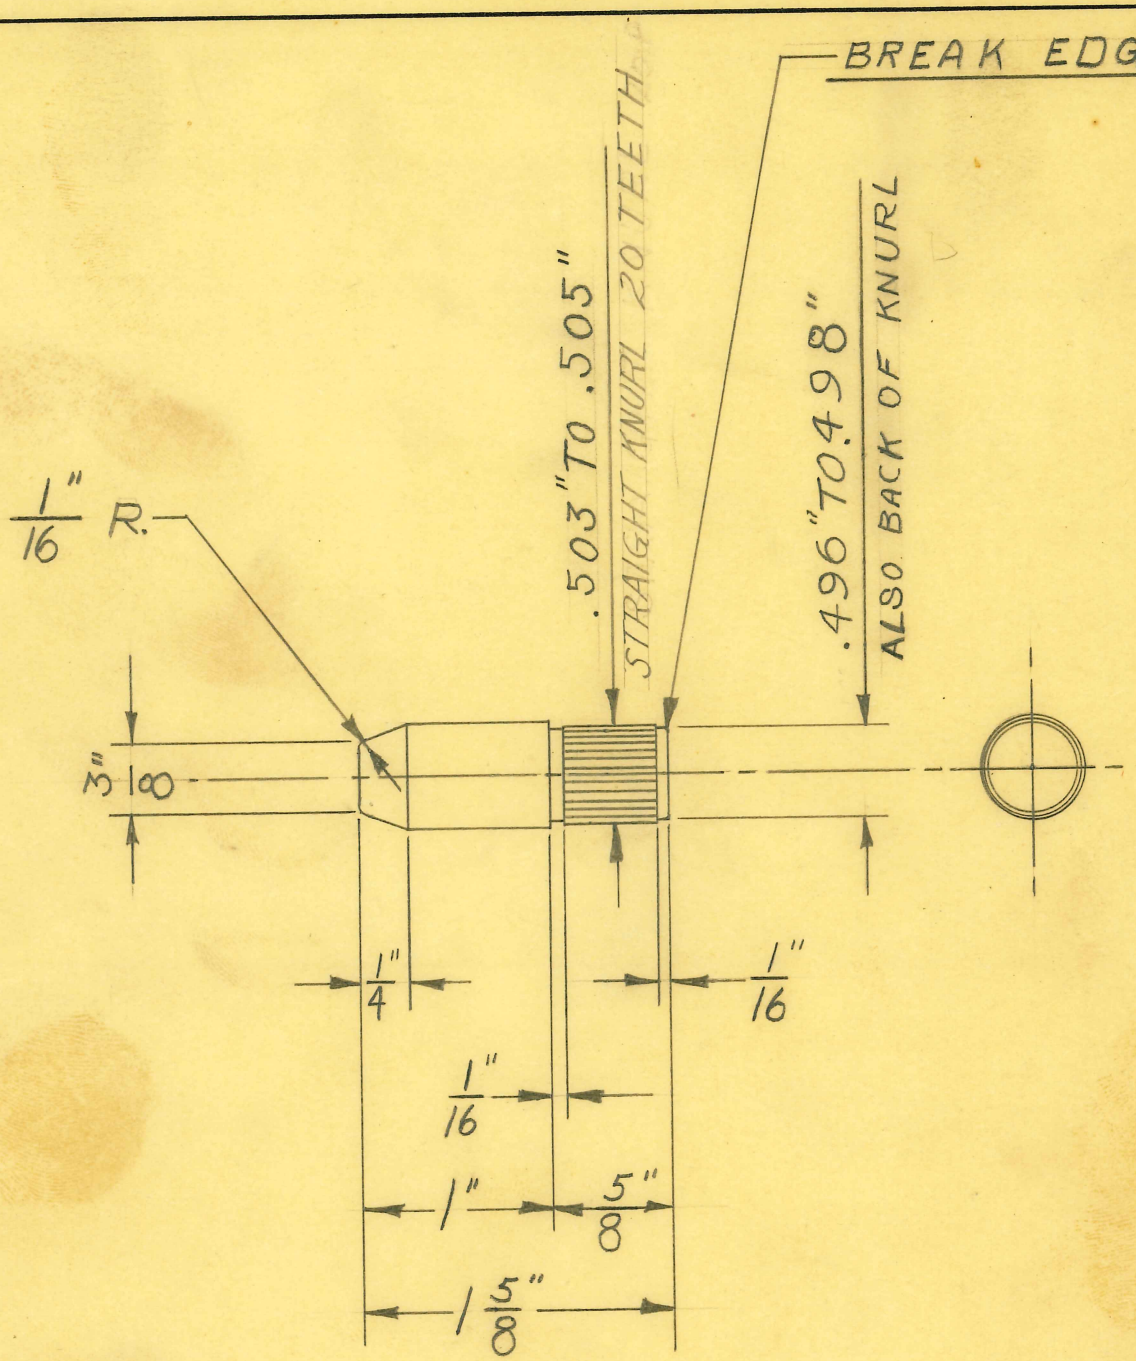

2 REQUIRED

9/16" DIA. JEWELERS ROD

SIZE		ISSUE 6-4-47	W.J.
KIND		CHANGED	
SHAPE		"	
FINISH	CAD. #23	"	
TEMP.		"	
PATT.		"	

TITLE: FISCHER "MP-20" X-RAY UNIT CONTROL SUPPORT PIN - UPPER

H. G. FISCHER & CO.
2335 WABANSIA AVE.
CHICAGO, ILL.

CAT. NO.

PART NO. 16572

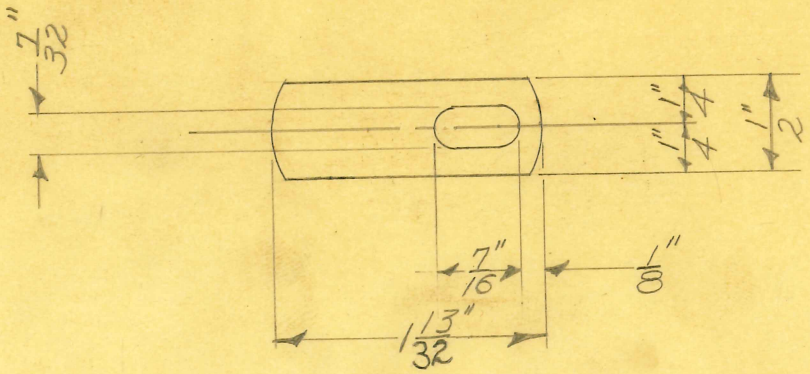

LENGTH OF DEVELOPMENT

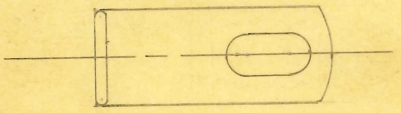

BREAK CORNERS & EDGES

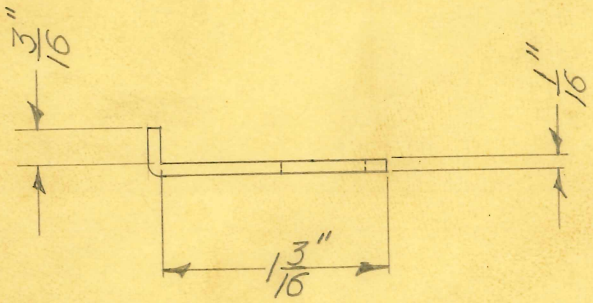

2 REQUIRED

CUT-OFF & PERFORATING DIE TOOL # 687 —— 94
BENDING DIE TOOL # 6336 —— 01
} LOCATION

SIZE	1/16" X 1/2"	ISSUE 9-11-47	J.M.F.
KIND	FLAT WIRE	CHANGED	
SHAPE		"	
FINISH		"	
TEMP.		"	
PATT.		"	

TITLE:
FISCHER "MP-20" X RAY UNIT
POWER TRANS. SHIELD CLAMP

H. G. FISCHER & CO.
2335 WABANSIA AVE.
CHICAGO, ILL.

CAT. NO.

PART NO. 16578

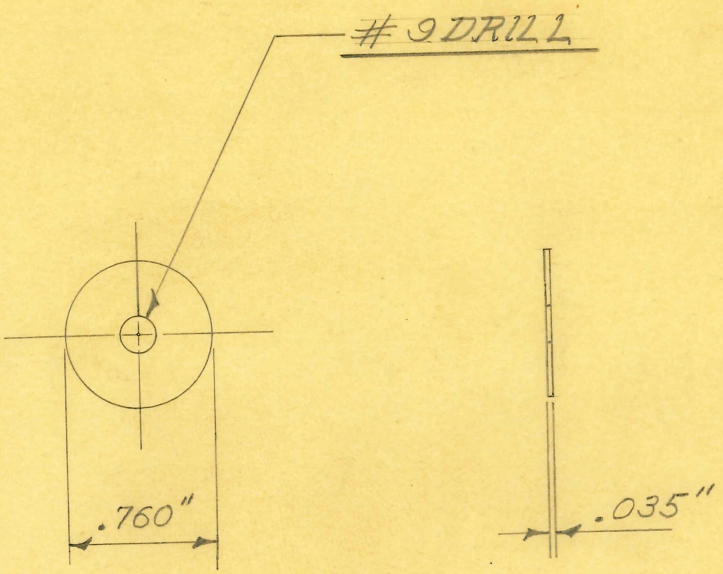

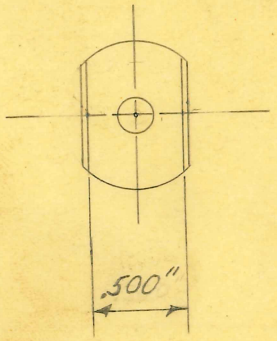

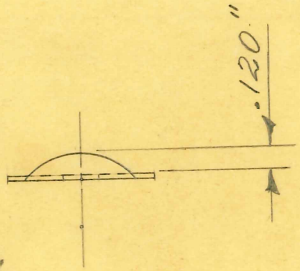

BLANKING & PIERCING DIE TOOL # 8484
BENDING DIE TOOL # 9449
LOCATION 03
2 - REQUIRED

MADE FROM
C.R. SHEARED STEEL

DIMENSIONS	
FRACTIONAL	± .015
DECIMAL	± .005
ANGULAR	± ½°
UNLESS OTHERWISE STATED	

SIZE	.035" X 1"	ISSUE 9-10-47	J.M.F
KIND		CHANGED	
SHAPE		"	
FINISH		"	
TEMP.		"	
PATT.		"	

TITLE:
FISCHER "MP-20" X-RAY UNIT
X-RAY TUBE SUPPORT CHANNEL
WASHER

H. G. FISCHER & CO.
2335 WABANSIA AVE.
CHICAGO, ILL.

CAT. NO.

PART NO. 16579

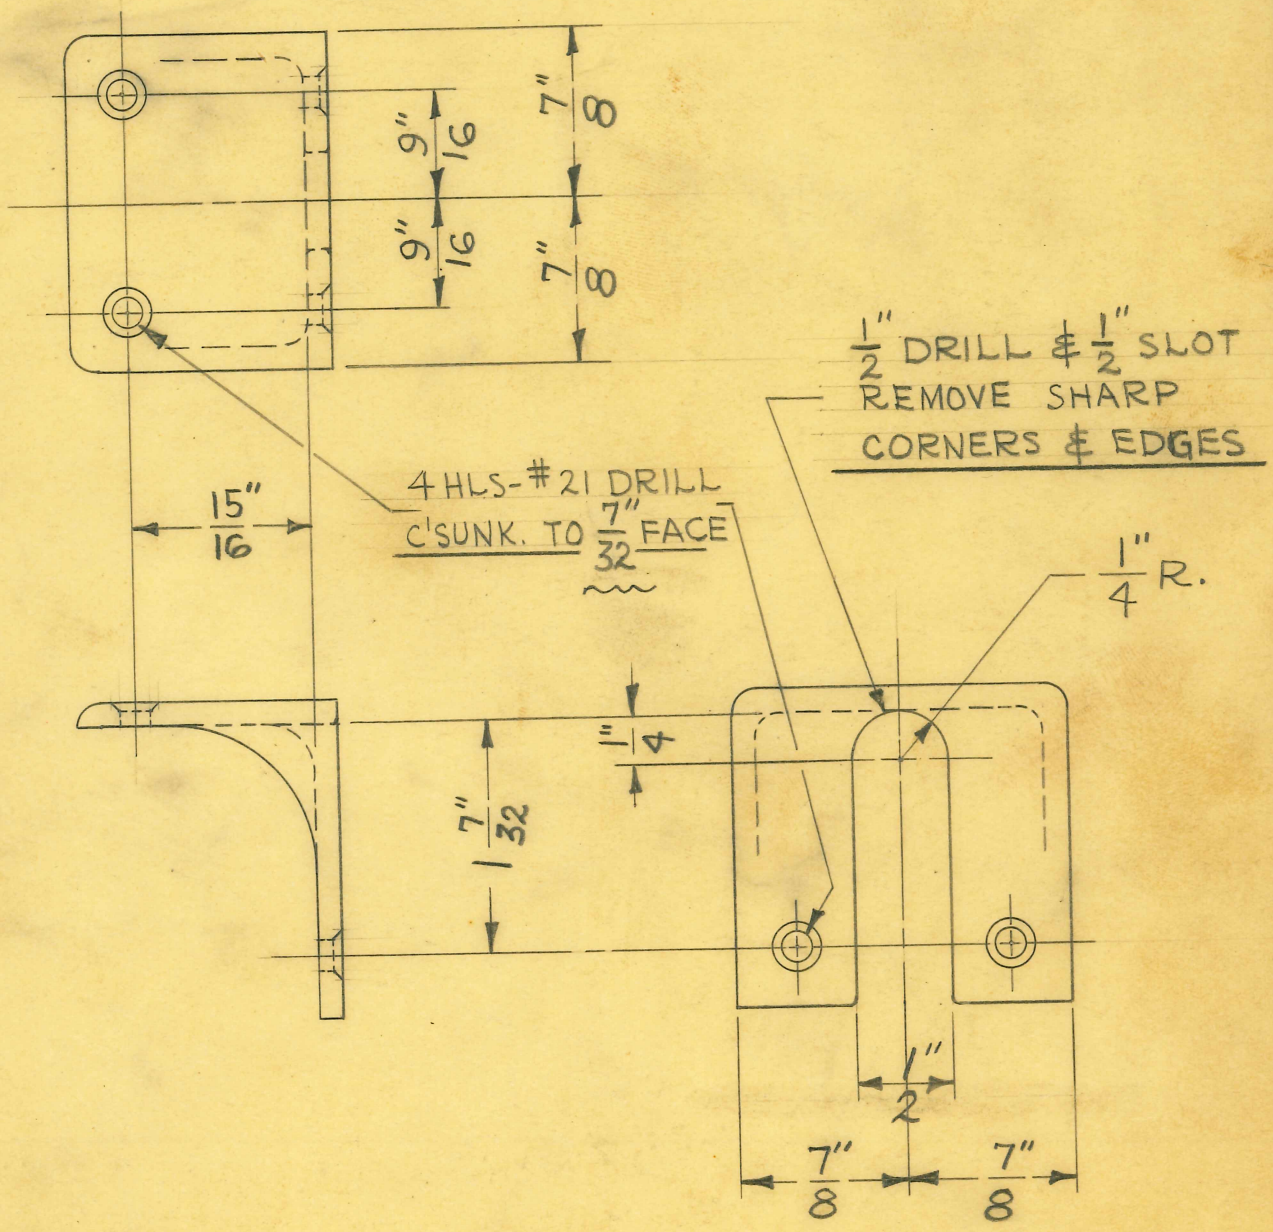

1 REQUIRED

MILLING FIX. TOOL #9390

DRILL JIG #9265 6-6-47 F.O. 173

SIZE	#12	ISSUE 6-6-47	J.V.W.
KIND	ALUMINUM	CHANGED	
SHAPE		"	
FINISH		"	
TEMP.		"	
PATT.	2186	"	

TITLE:
FISCHER "MP-20" X-RAY UNIT
TRANSF. COVER CABLE OUTLET

H. G. FISCHER & CO.
2335 WABANSIA AVE.
CHICAGO, ILL.

CAT. NO.

PART NO. 16582F

DRILL JIG TOOL #9286 F.O. 217

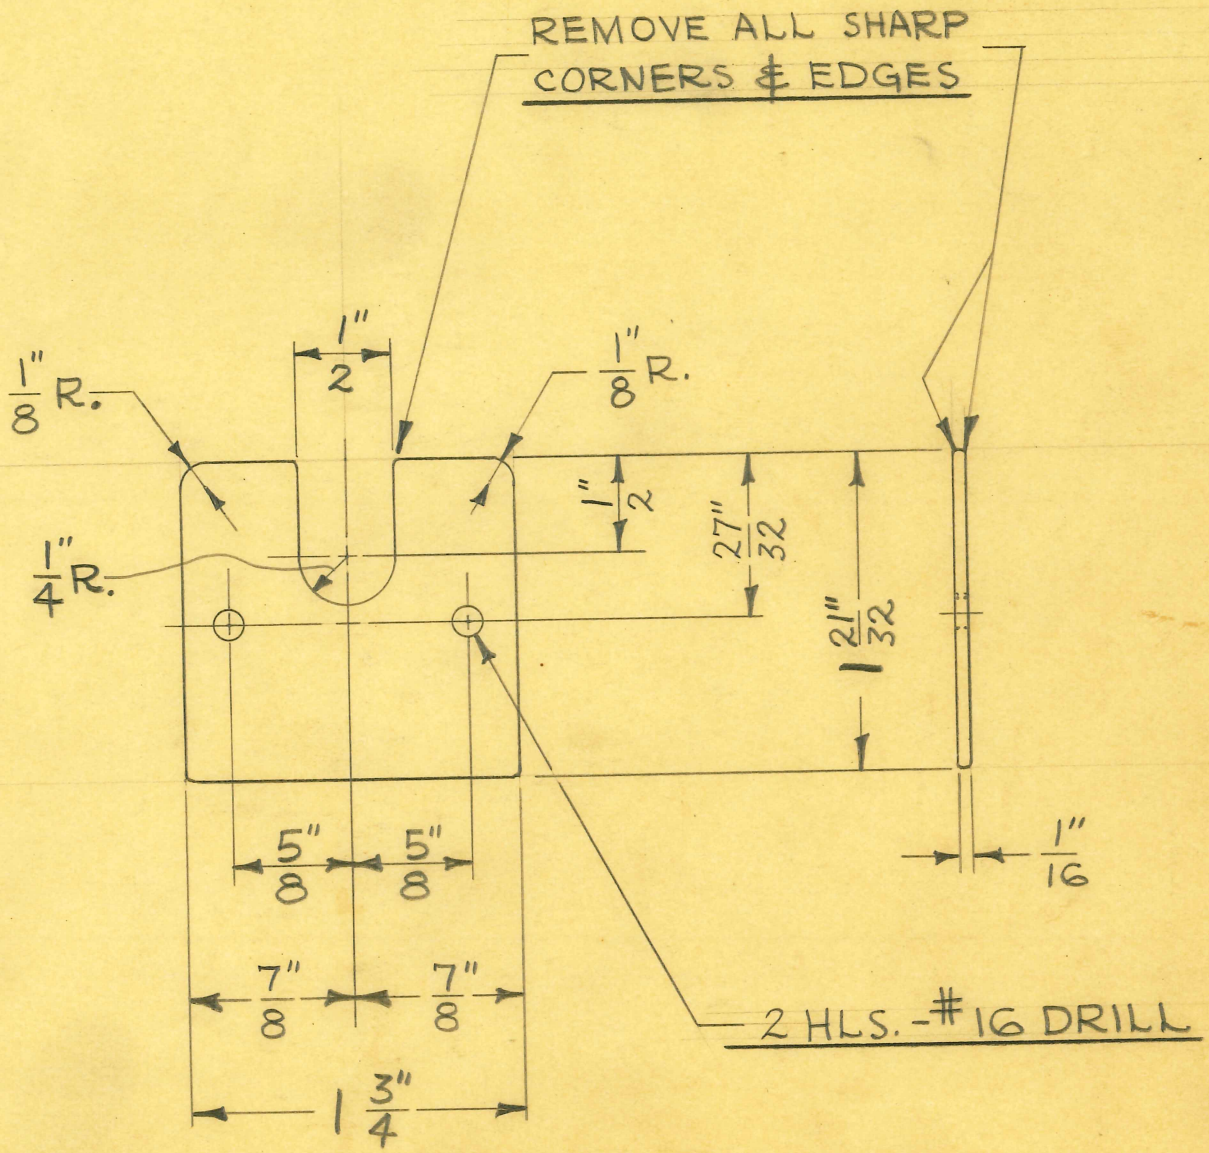

1 REQUIRED

SIZE	1/16" SHEET	ISSUE 3-31-47	J.V.W.
KIND	C.R. STEEL	CHANGED	
SHAPE		"	
FINISH	PAINTED	"	
TEMP.		"	
PATT.		"	

TITLE:
FISCHER "MP-20" X-RAY UNIT
TRANSF. COVER CABLE CLAMP PLATE

H. G. FISCHER & CO.
2338 WABANSIA AVE.
CHICAGO. ILL.

CAT. NO.

PART NO. 16585

BORE OUT TO DIMENSION SHOWN

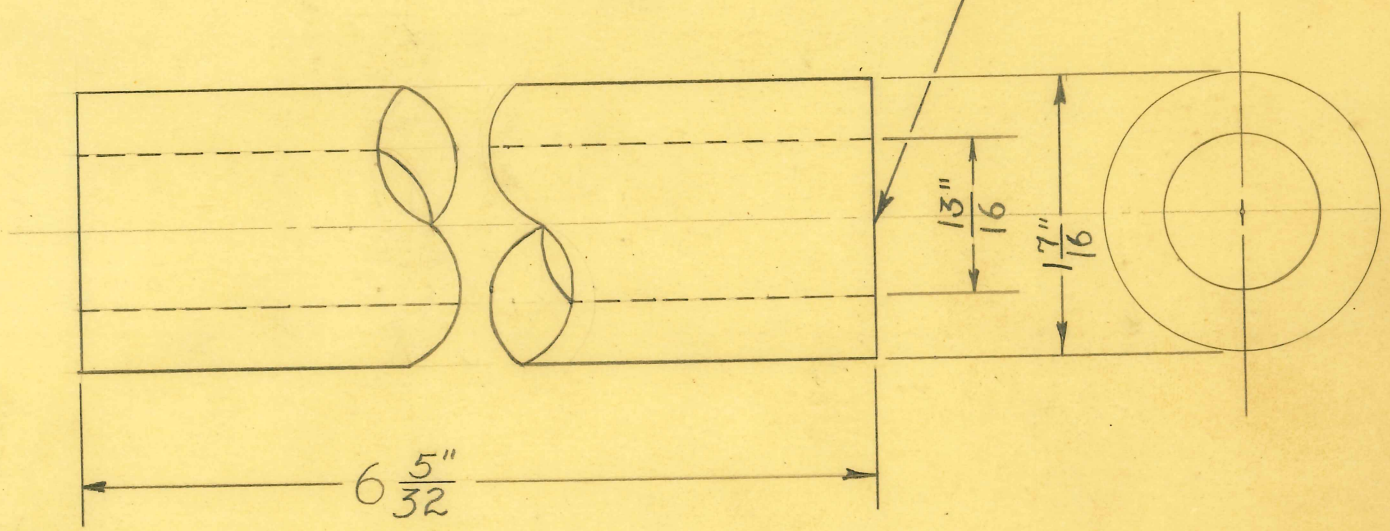

1 REQUIRED

1 7/16" O.D. X 13/16" I.D. #33 GROUND RUBBER TUBING

SIZE		ISSUE 5-23-47	W.J.
KIND		CHANGED	
SHAPE		"	
FINISH		"	
TEMP.		"	
PATT.		"	

TITLE:
FISCHER "MP-20" X-RAY UNIT
PRIMARY RUBBER TUBE

H. G. FISCHER & CO.
2338 WABANSIA AVE.
CHICAGO. ILL.

CAT. NO.

PART NO. 16607

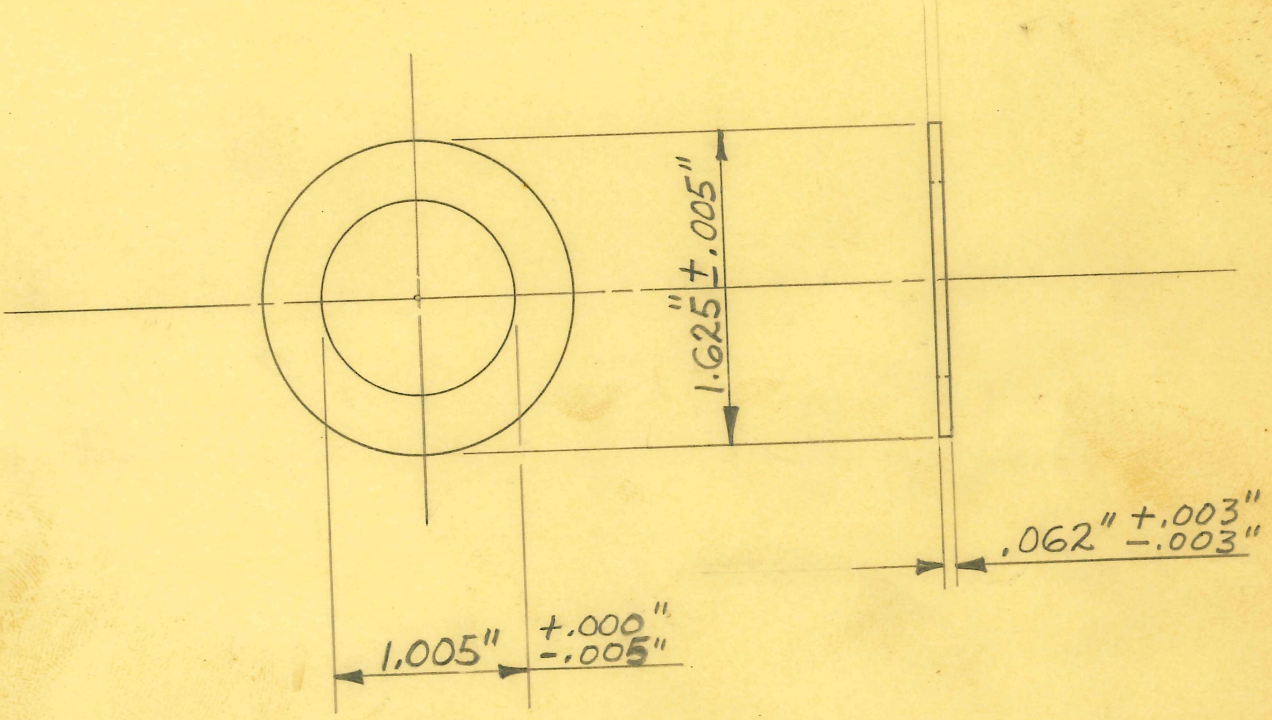

COLD ROLLED STEEL SHEET

SIZE		ISSUE 6-25-47	J.V.W.
KIND		CHANGED	
SHAPE		"	
FINISH		"	
TEMP.		"	
PATT.		"	

TITLE: FISCHER "MP-20" X-RAY UNIT
TRANSF. HEAD FORK SWIVEL RING

H. G. FISCHER & CO.
2335 WABANSIA AVE.
CHICAGO, ILL.

CAT. NO.

PART NO. 16610

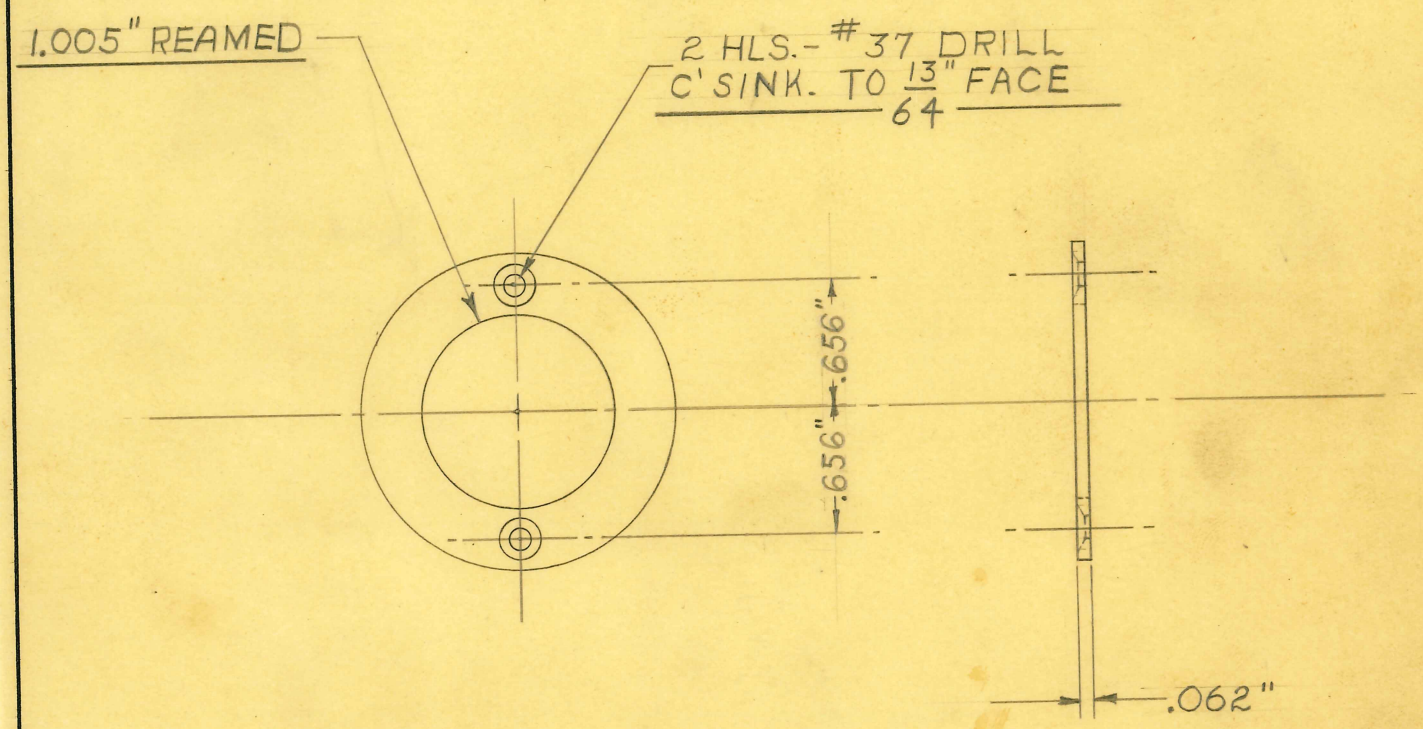

1 REQUIRED

DRILL JIG TOOL #9258

DIMENSIONS
FRACTIONAL ±.015
DECIMAL ±.005
ANGULAR ± 1/2°
UNLESS OTHERWISE SPECIFIED

SIZE	FROM	ISSUE 6-26-47	W.J.
KIND	16610	CHANGED	
SHAPE		"	
FINISH	WH. NICK #13	"	
TEMP.		"	
PATT.		"	

TITLE:
FISCHER "MP-20" X-RAY UNIT
TRANSF. HEAD FORK SWIVEL RING

H. G. FISCHER & CO.
2335 WABANSIA AVE.
CHICAGO, ILL.

CAT. NO.

PART NO. 16610F

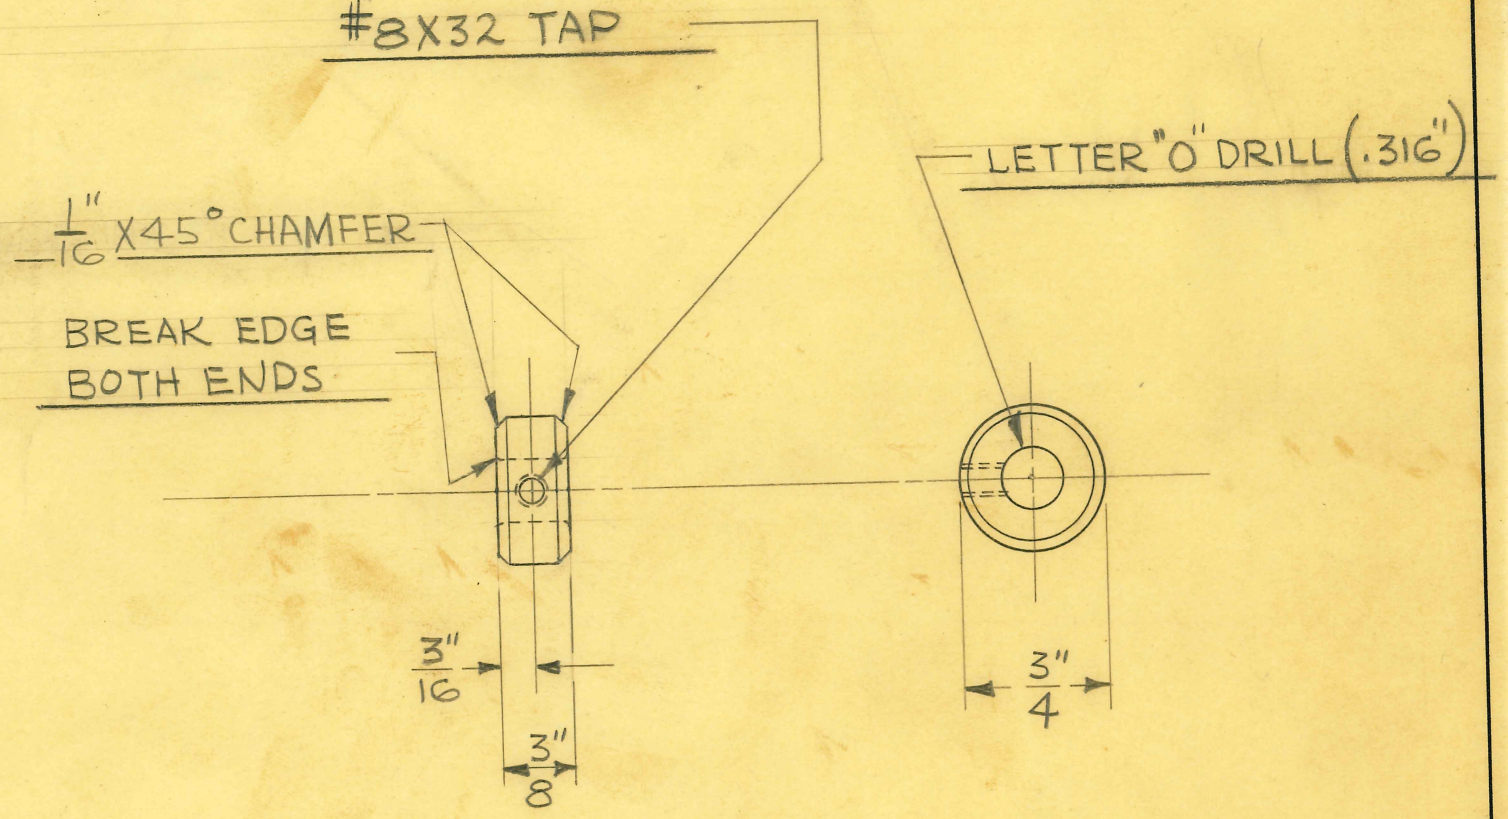

2 REQUIRED

DRILL JIG TOOL #9276 6-6-47 F.O. 184

SIZE	3/4" DIA.	ISSUE 5-20-47	J.V.W.
KIND	C.R. STEEL	CHANGED	
SHAPE	ROD	"	
FINISH	CAD. #23	"	
TEMP.		"	
PATT.		"	

TITLE: FISCHER "MP-20" X-RAY UNIT
VERTICAL SLIDE LOCK SPACER

H. G. FISCHER & CO.
2335 WABANSIA AVE.
CHICAGO, ILL.

CAT. NO.

PART NO. 16623

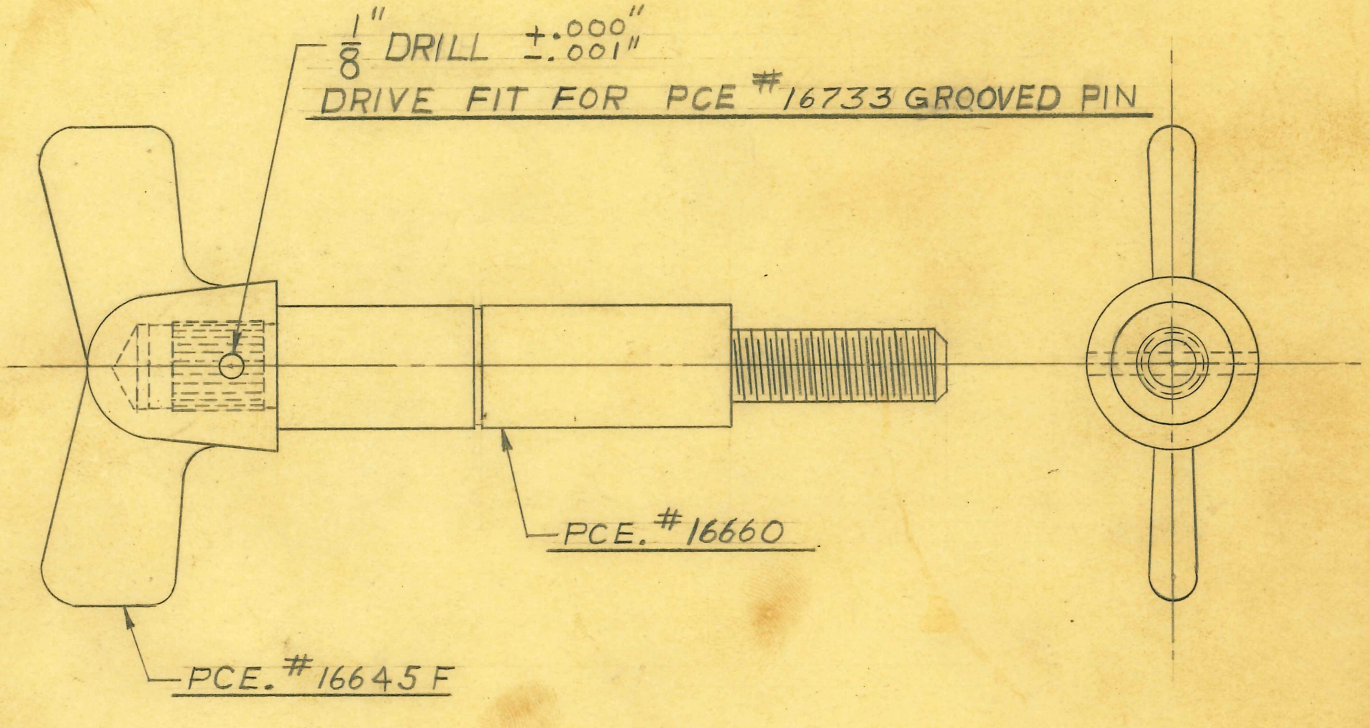

1 REQUIRED

ARBOR PRESS FIXTURE TOOL # 9450

DRILL JIG TOOL # 9309

SIZE		ISSUE 6-19-47	W.J.
KIND		CHANGED	
SHAPE		"	
FINISH		"	
TEMP.		"	
PATT.		"	

TITLE:
FISCHER "MP-20" X-RAY UNIT
UPRIGHT TUBE CLAMP SCREW ASSEMBLY

H. G. FISCHER & CO.
2335 WABANSIA AVE.
CHICAGO, ILL.

CAT. NO.

PART NO. 16625G

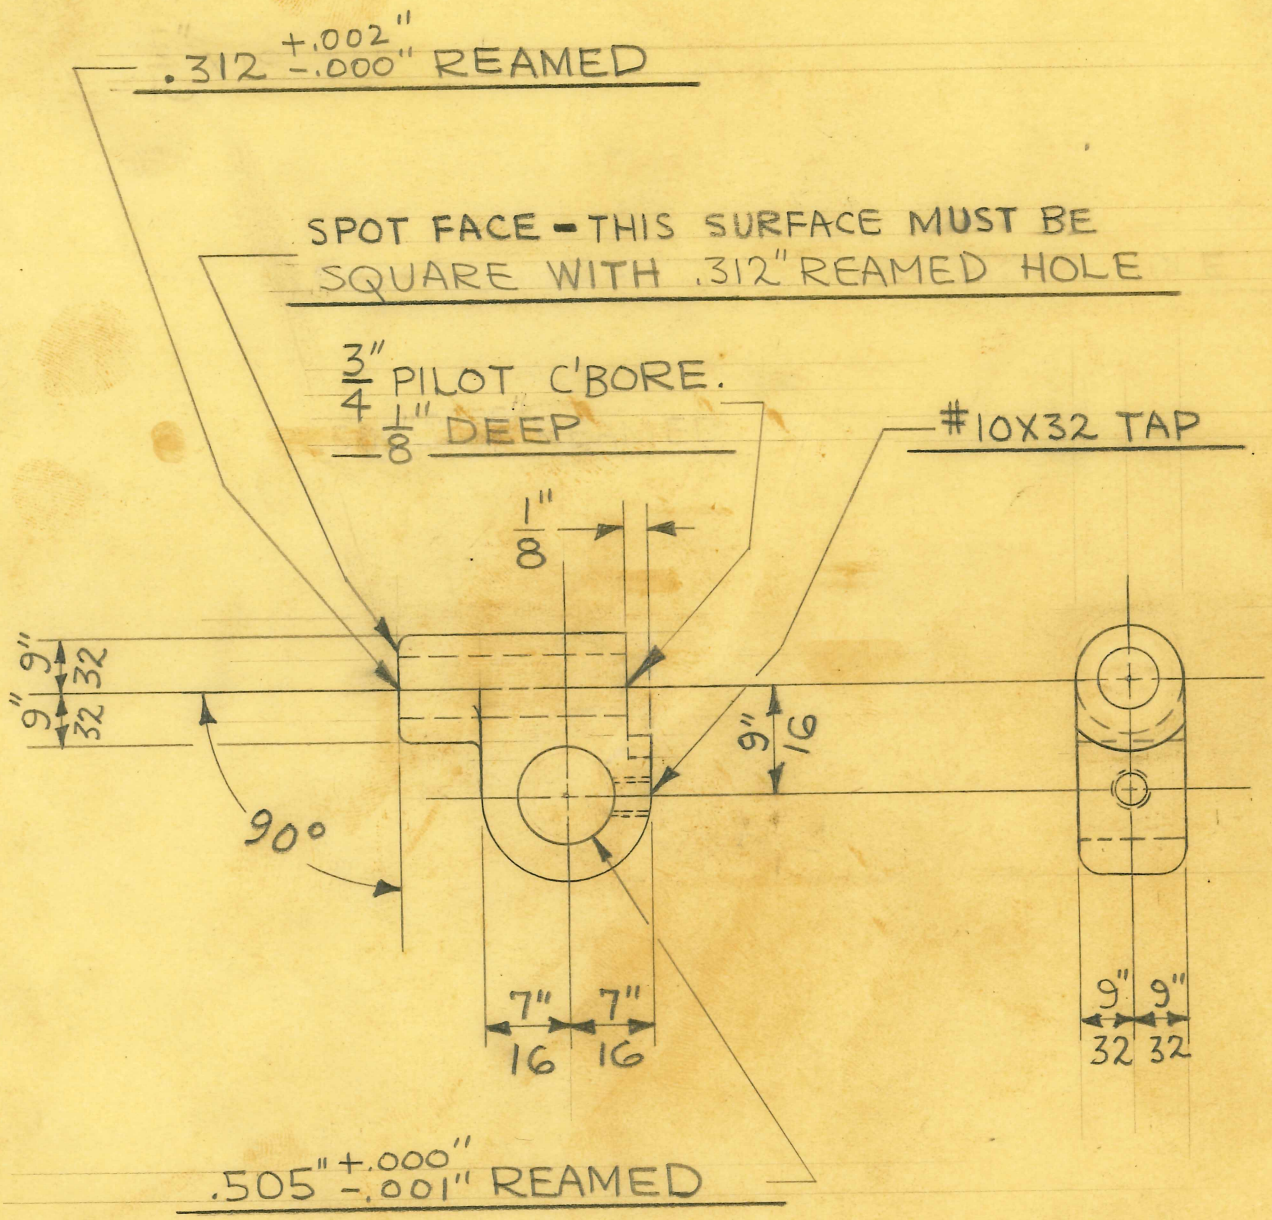

2 REQUIRED

DRILL JIG TOOL #9271 F.O. 179 6-6-47

SIZE	80-10-10	ISSUE 4-24-47	J.V.W.
KIND	BRONZE	CHANGED	
SHAPE		"	
FINISH	CAD. #23	"	
TEMP.		"	
PATT.	2213	"	

TITLE: FISCHER "MP-20" X-RAY UNIT VERTICAL SLIDE LOCK SWIVEL

H. G. FISCHER & CO.
2335 WABANSIA AVE.
CHICAGO, ILL.

CAT. NO.

PART NO. 16642F

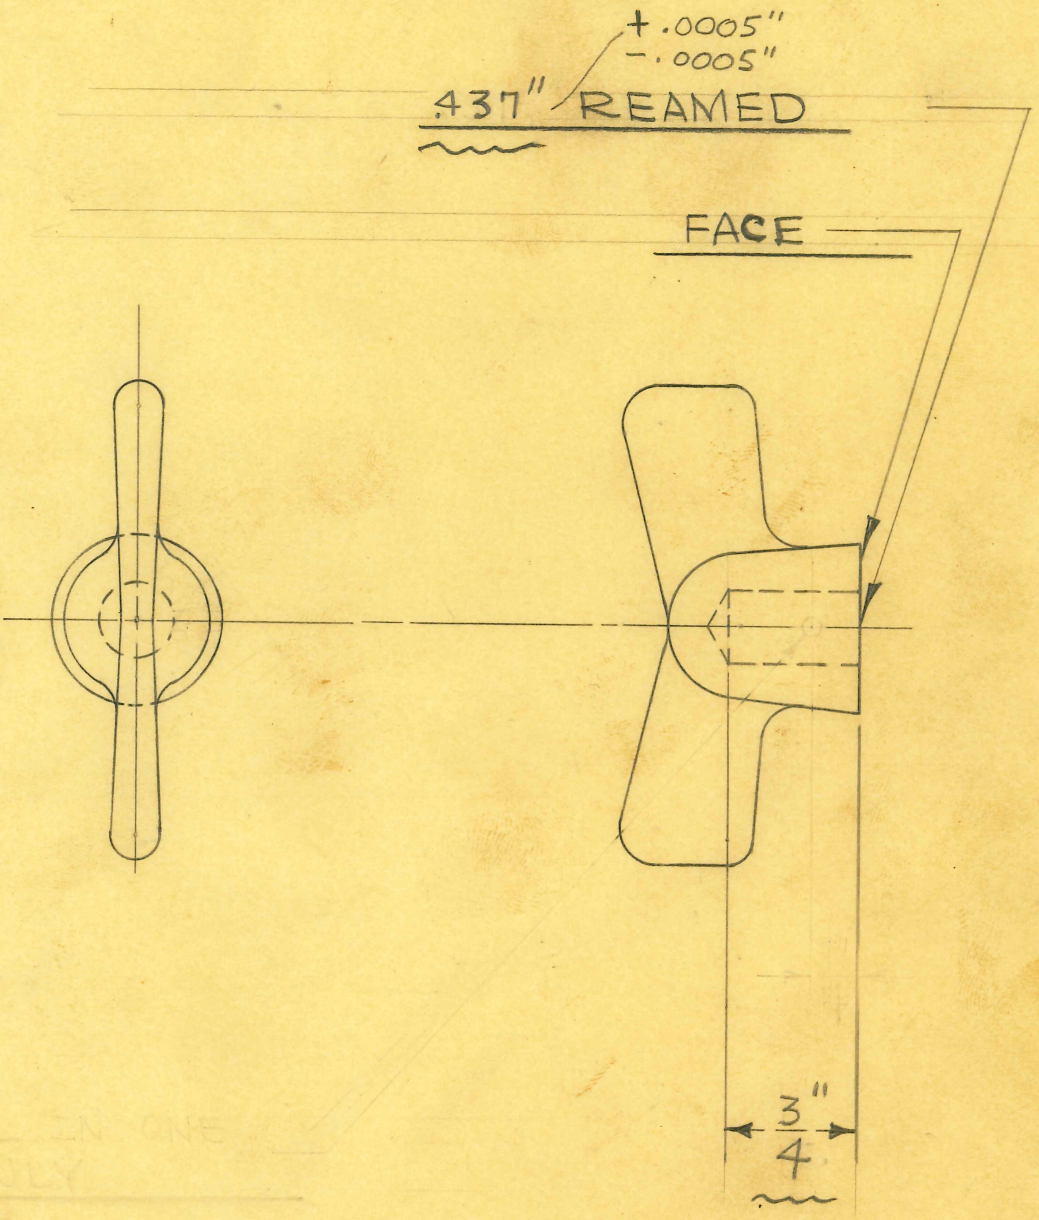

TURNING JAWS TOOL #9310
DRILL JIG TOOL #9309

1 REQUIRED

SIZE	BRASS	ISSUE 5-1-47	J.V.W.
KIND	CASTING	CHANGED	
SHAPE		"	
FINISH	SATIN CHR. #4	"	
TEMP.		"	
PATT.	2218	"	

TITLE:
FISCHER "MP-20" X-RAY UNIT
UPRIGHT TUBE CLAMP SCREW HANDLE

H. G. FISCHER & CO.
2335 WABANSIA AVE.
CHICAGO, ILL.

CAT. NO.

PART NO. 16645F

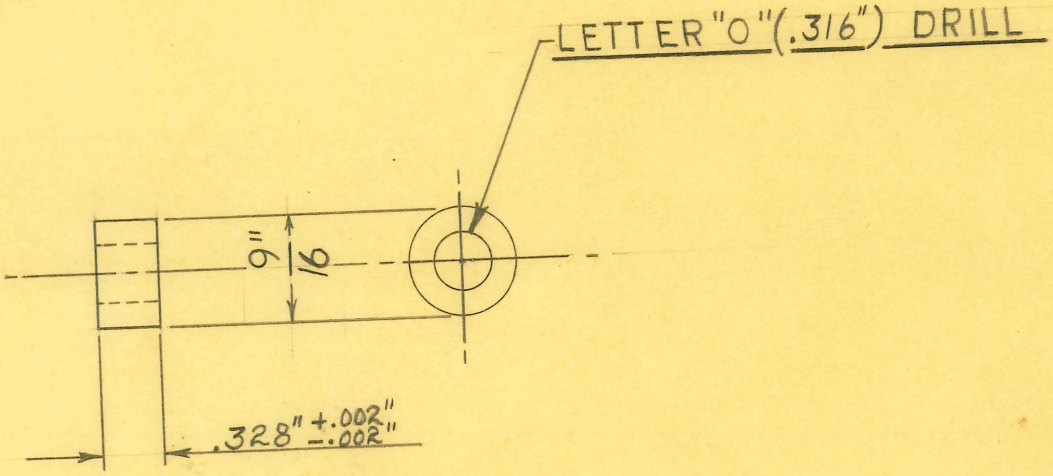

2 REQUIRED

SIZE	9/16" ROD	ISSUE 5-28-47	W.J.
KIND	C.R. STEEL	CHANGED	
SHAPE		"	
FINISH	CAD. #23	"	
TEMP.		"	
		"	

TITLE: FISCHER "MP-20" X-RAY UNIT
PULLEY SPACER ~ REAR

H. G. FISCHER & CO.
2335 WABANSIA AVE.
CHICAGO, ILL.

CAT. NO.

PART NO. 16646

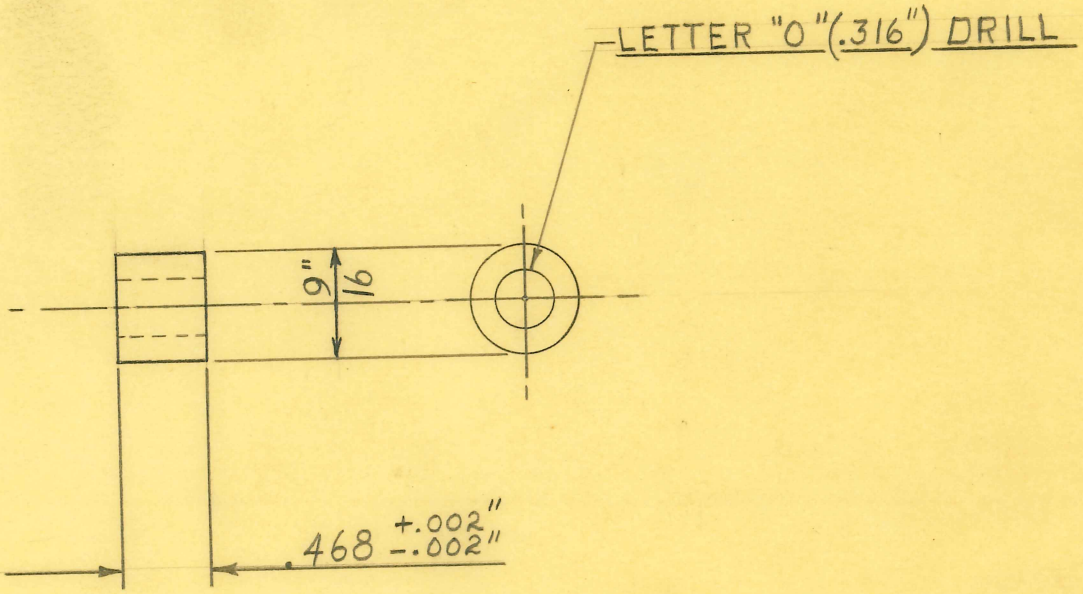

2 REQUIRED

SIZE	9/16" ROD	ISSUE 5-29-47	W.J.
KIND	C.R. STEEL	CHANGED	
SHAPE		"	
FINISH	CAD. #23	"	
TEMP.		"	
PATT.		"	

TITLE: FISCHER "MP-20" X-RAY UNIT
PULLEY SPACER ~ FRONT

H. G. FISCHER & CO.
2335 WABANSIA AVE.
CHICAGO, ILL.

CAT. NO.

PART NO. 16647

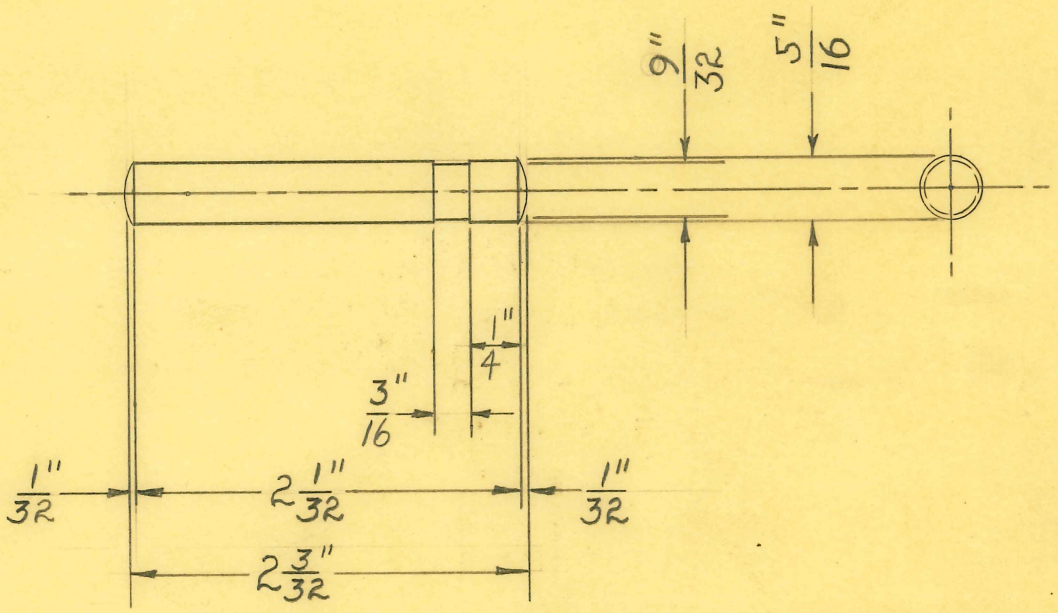

1 REQUIRED

SATIN CHROME #4 ~ SATIN POLISH ENDS ONLY

SIZE	5/16" ROD	ISSUE 5-28-47	W.J.
KIND	C.R. STEEL	CHANGED	
SHAPE		PLATING CHANGED " 4-24-50	J.V.W.
FINISH	CAD. # 23	"	
TEMP.		"	
PATT.		"	

TITLE:
FISCHER "MP-20" X-RAY UNIT
PULLEY SHAFT ~ REAR

H. G. FISCHER & CO.
2335 WABANSIA AVE.
CHICAGO, ILL.

CAT. NO.

PART NO. 16648

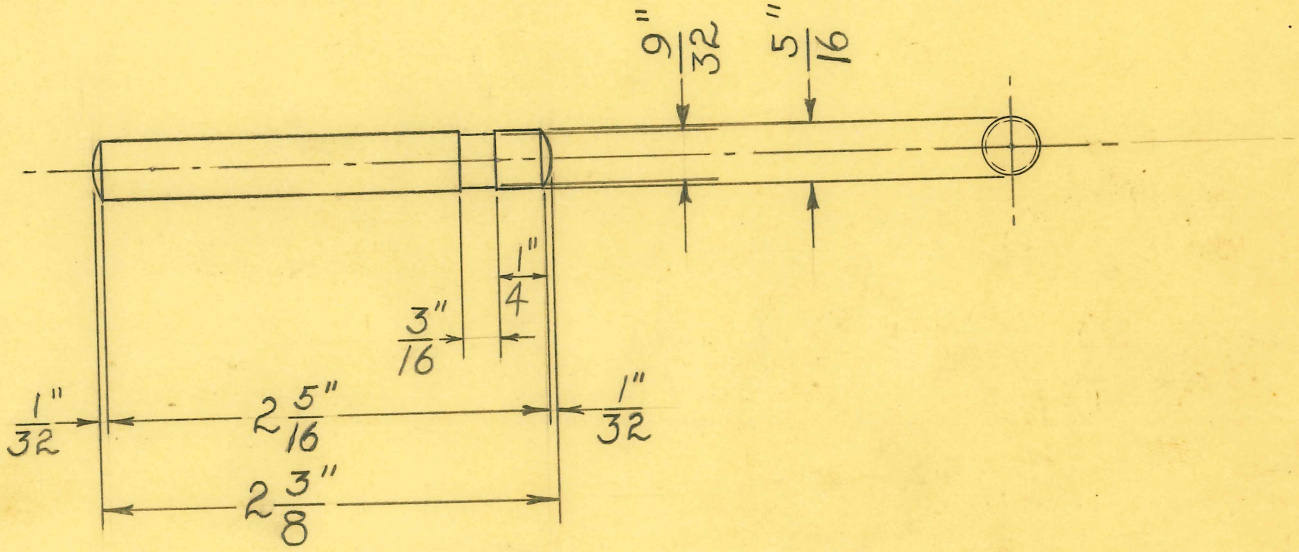

1 REQUIRED

~~SATIN CHROME #4 - SATIN POLISH ENDS ONLY~~

SIZE	5/16" ROD	ISSUE 5-28-47	W.J.
KIND	C.R. STEEL	CHANGED	
SHAPE		" PLATING CHANGED 4-24-50	
FINISH	CAD. #23	"	
TEMP.		"	
PATT.		"	

TITLE: FISCHER "MP-20" X-RAY UNIT
PULLEY SHAFT ~ FRONT

H. G. FISCHER & CO.
2335 WABANSIA AVE.
CHICAGO, ILL.

CAT. NO.

PART NO. 16649

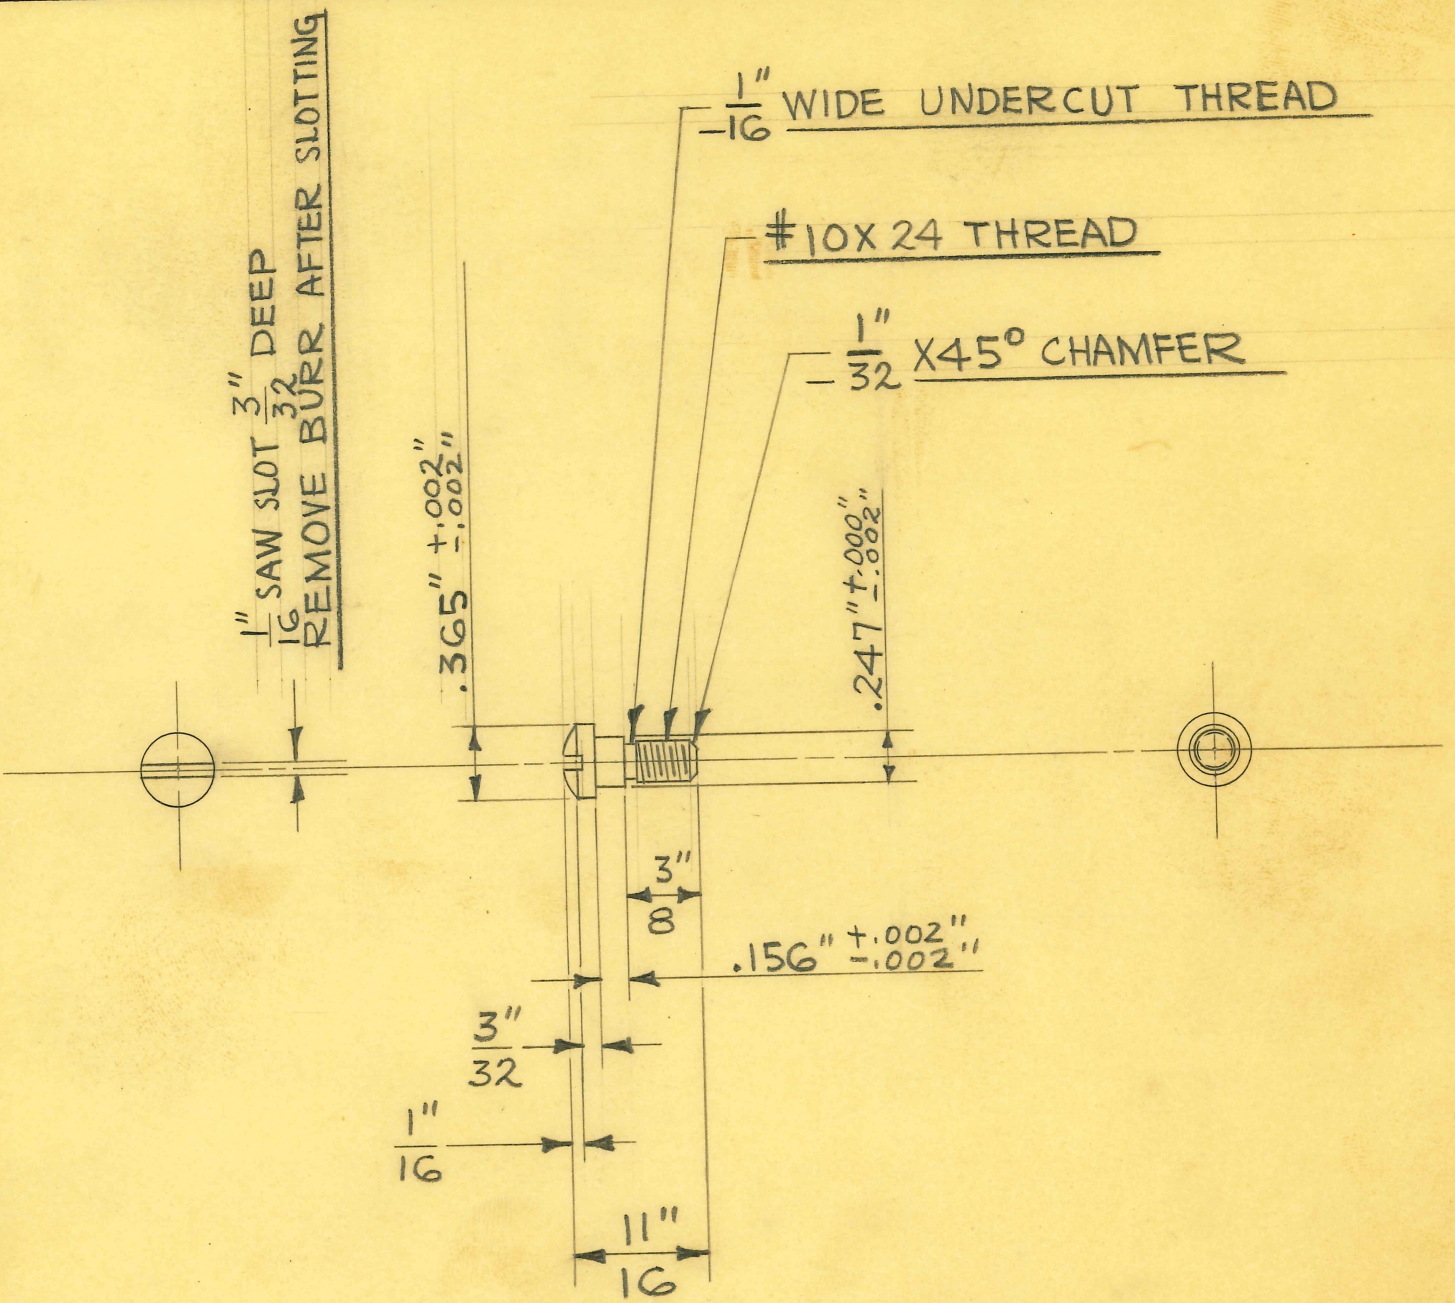

1 REQUIRED

SATIN CHR. #4 - SATIN HEAD ONLY

SIZE	3/8" DIA.	ISSUE 4-24-47	J.V.W.	TITLE: FISCHER "MP-20" X-RAY UNIT FORK LOCK SCREW - FRONT
KIND	C.R. STEEL	CHANGED		
SHAPE	ROD	"		
FINISH	SEE NOTE	"		
TEMP.		"		
PATT.		"		

H. G. FISCHER & CO.
2335 WABANSIA AVE.
CHICAGO, ILL.

CAT. NO.

PART NO. 16652

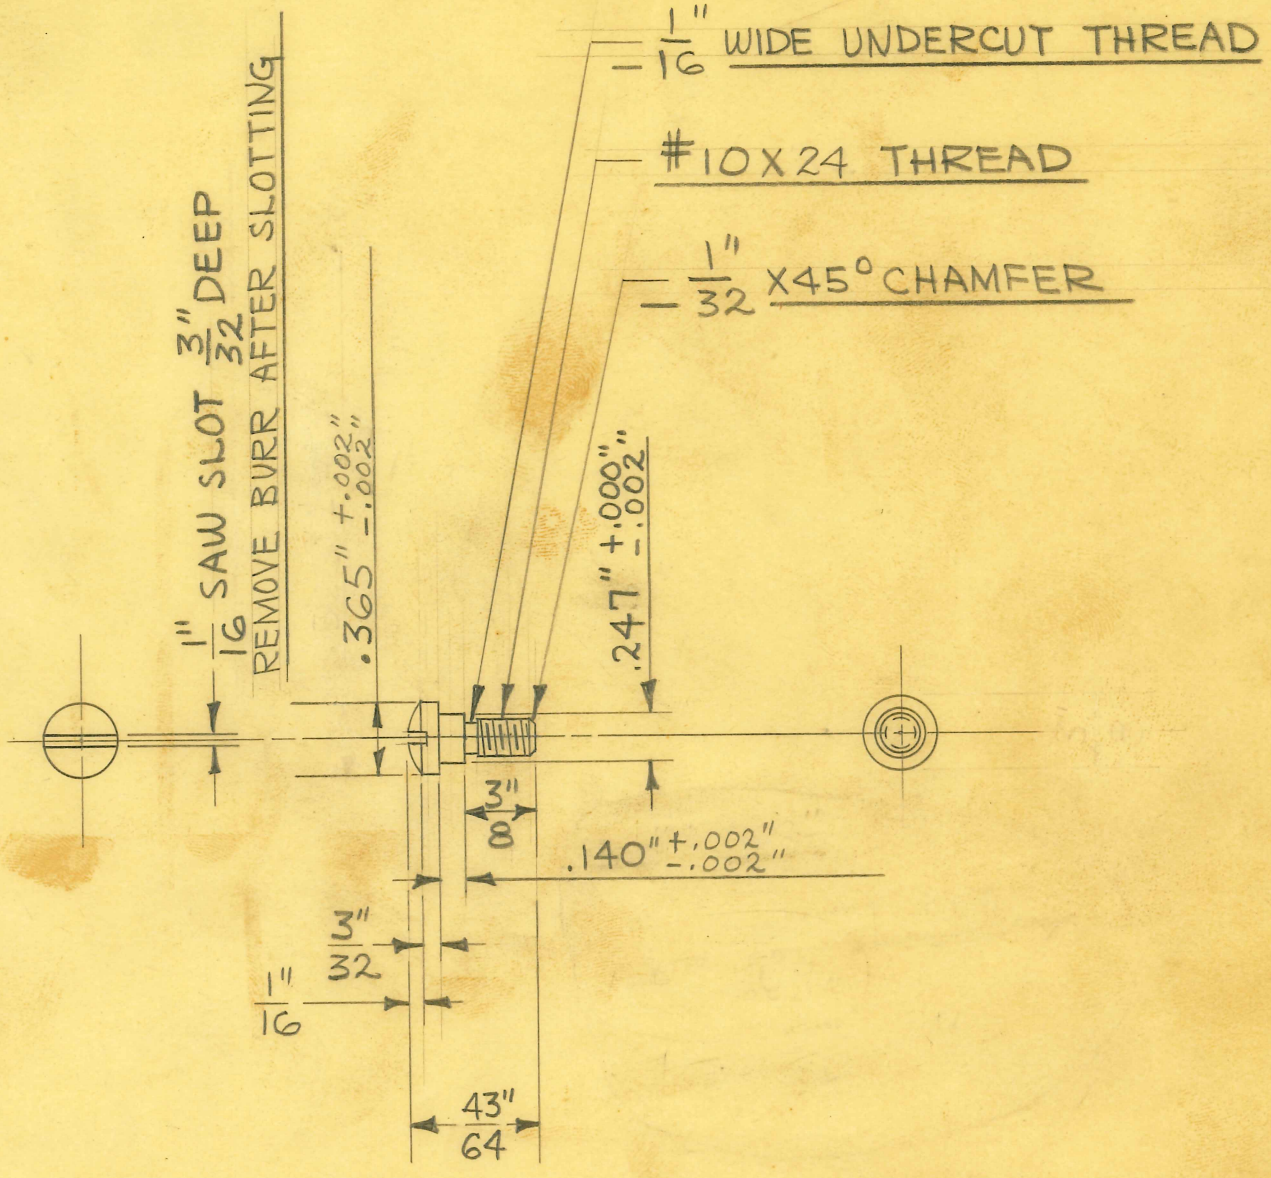

1 REQUIRED

SATIN CHR. #4 - SATIN HEAD ONLY

SIZE	3/8" DIA.	ISSUE 4-10-47	J.V.W.
KIND	C.R. STEEL	CHANGED	
SHAPE	ROD	"	
FINISH	SEE NOTE	"	
TEMP.		"	
PATT.		"	

TITLE: FISCHER "MP-20" X-RAY UNIT
FORK LOCK - SCREW - REAR

H. G. FISCHER & CO.
2338 WABANSIA AVE.
CHICAGO, ILL.

CAT. NO.

PART NO. 16653

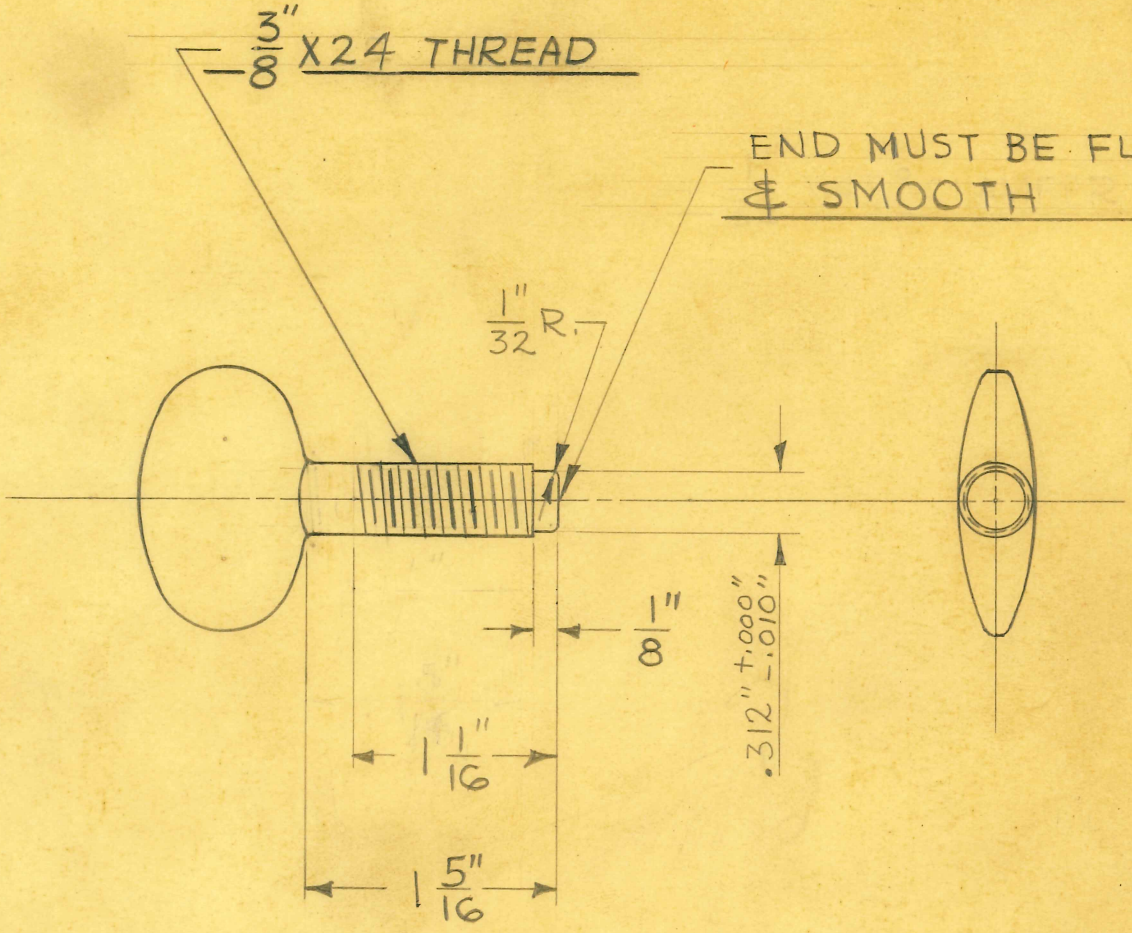

FROM BLANK-PCE. NO. 16654

1 REQUIRED

TURNING JAWS TOOL #9290

SIZE		ISSUE 8-26-46	J.V.W.
KIND		CHANGED	
SHAPE		" 5-11-50	J.V.W.
FINISH	SATIN CHR #4	"	
TEMP.		"	
PATT.		"	

TITLE: FISCHER "MP-20" X-RAY UNIT
FORK SWIVEL-THUMB SCREW

H. G. FISCHER & CO.
2335 WABANSIA AVE.
CHICAGO, ILL.

CAT. NO.

PART NO. 16655

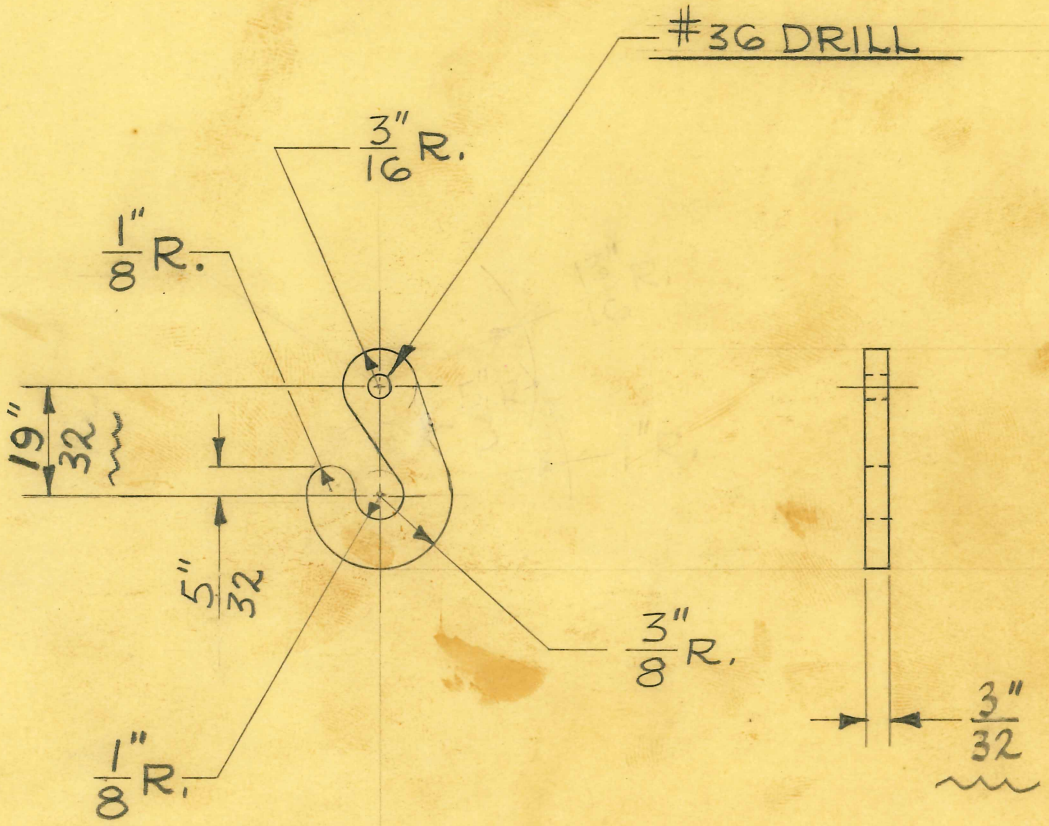

1 REQUIRED

3/32" X 1 3/8" SHEARED C.R. STEEL

4-29-47 F.O. 9590
BLANKING DIE TOOL #9233

SIZE		ISSUE 4-29-47	J.V.W.
KIND		CHANGED	
SHAPE		PLATING CHANGED " 4-24-50	J.V.W.
FINISH		"	
TEMP.		"	
PATT.		"	

TITLE:
FISCHER "MP-20" X-RAY UNIT
CWT. CHAIN HOOK

H. G. FISCHER & CO.
2338 WABANSIA AVE.
CHICAGO, ILL.

CAT. NO.

PART NO. 16656

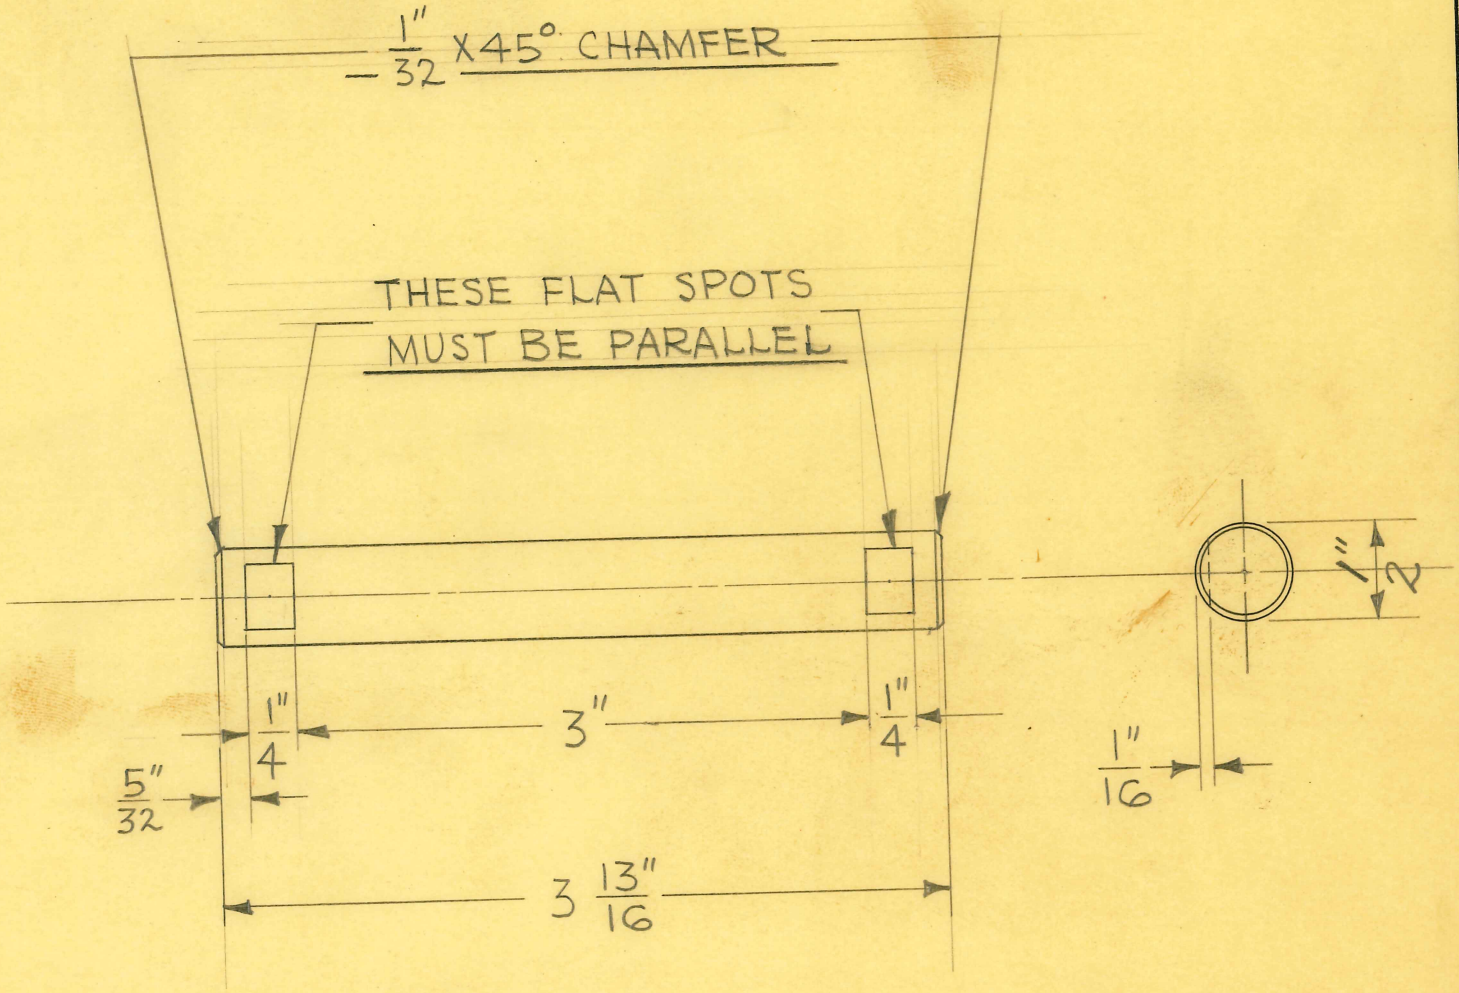

1 REQUIRED

SIZE	1/2" DIA.	ISSUE 4-29-47	J.V.W.
KIND	JEWELERS	CHANGED	
SHAPE	ROD	"	
FINISH	WH.N, #13	"	
TEMP.		"	
PATT.		"	

TITLE: FISCHER "MP-20" X-RAY UNIT
VERTICAL SLIDE LOCK SWIVEL SHAFT

H. G. FISCHER & CO.
2335 WABANSIA AVE.
CHICAGO, ILL.

CAT. NO.

PART NO. 16657

5-22-47 F.O. 9890 FORMING FIXTURE TOOL #9251

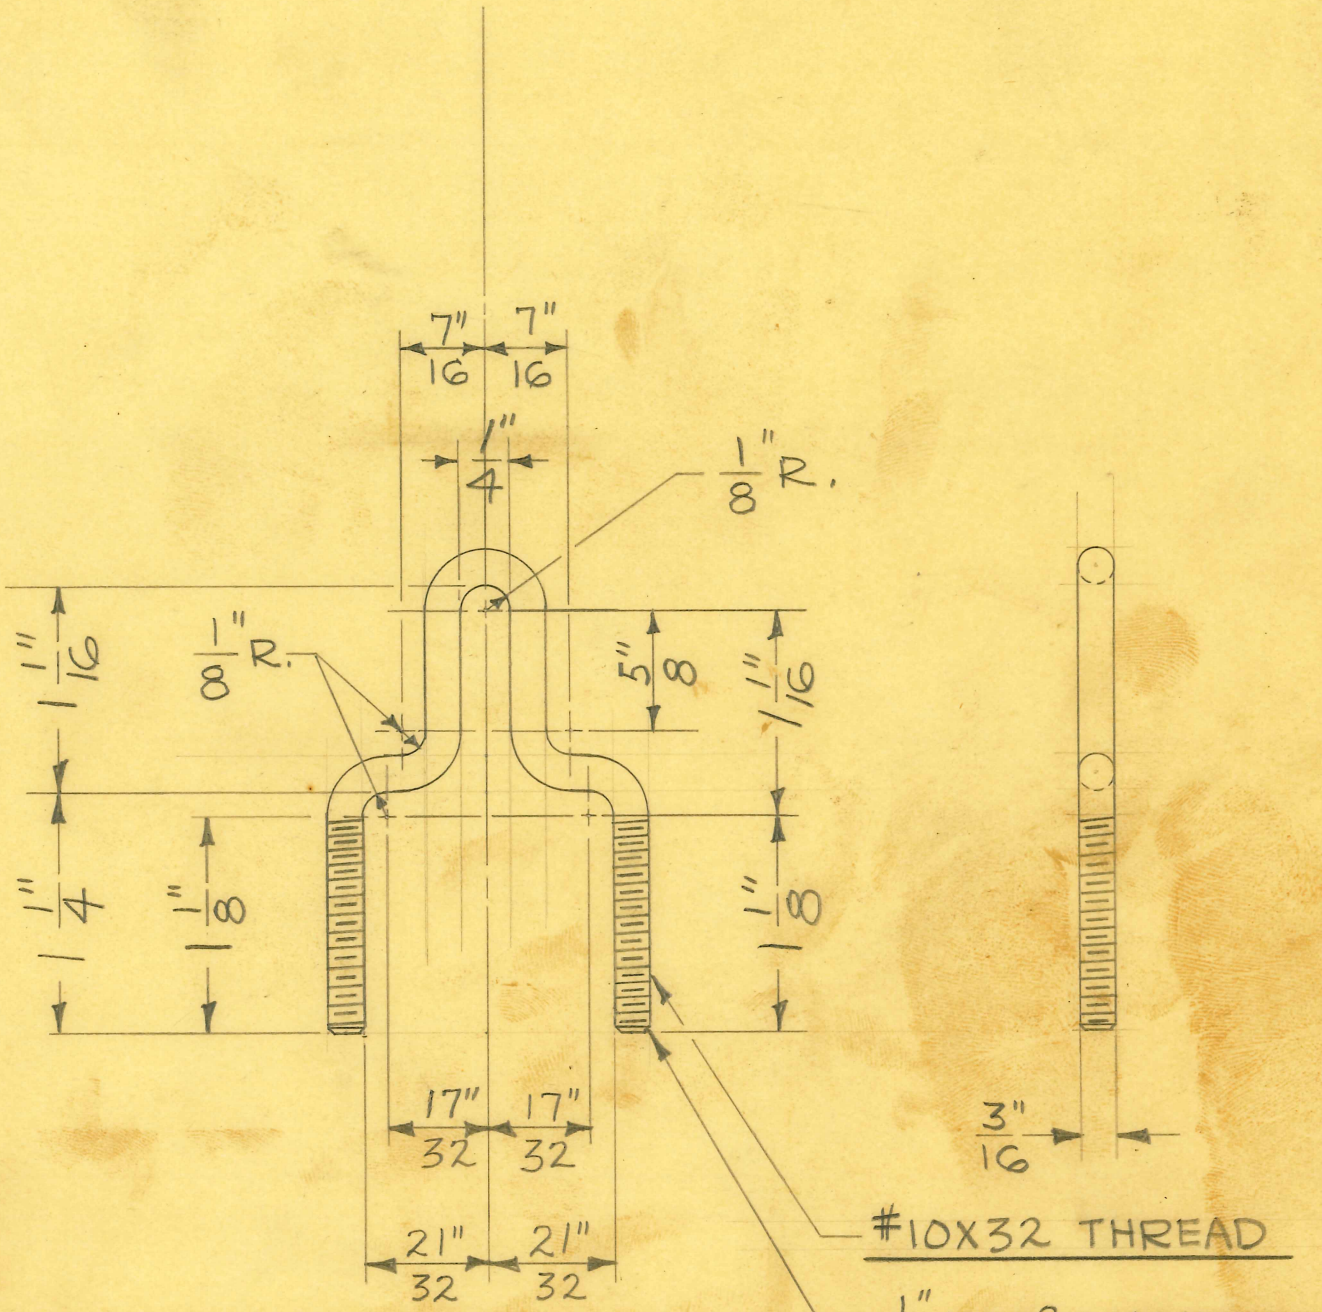

DEVELOPED LENGTH = 5 3/4"

COPPERED BESSEMER ROD 1 REQUIRED

SIZE	3/16" DIA.	ISSUE 4-29-47	J.V.W.	TITLE: FISCHER "MP-20" X-RAY UNIT CWT. CHAIN HOOK CONNECTION
KIND	~~BESSEMER~~	CHANGED		
SHAPE	~~ROD~~	PLATING CHANGED 4-24-50	J.V.W.	
FINISH	CAD. #23	"		
TEMP.		"		
PATT.		"		

H. G. FISCHER & CO.
2335 WABANSIA AVE.
CHICAGO, ILL.

CAT. NO.

PART NO. 16658

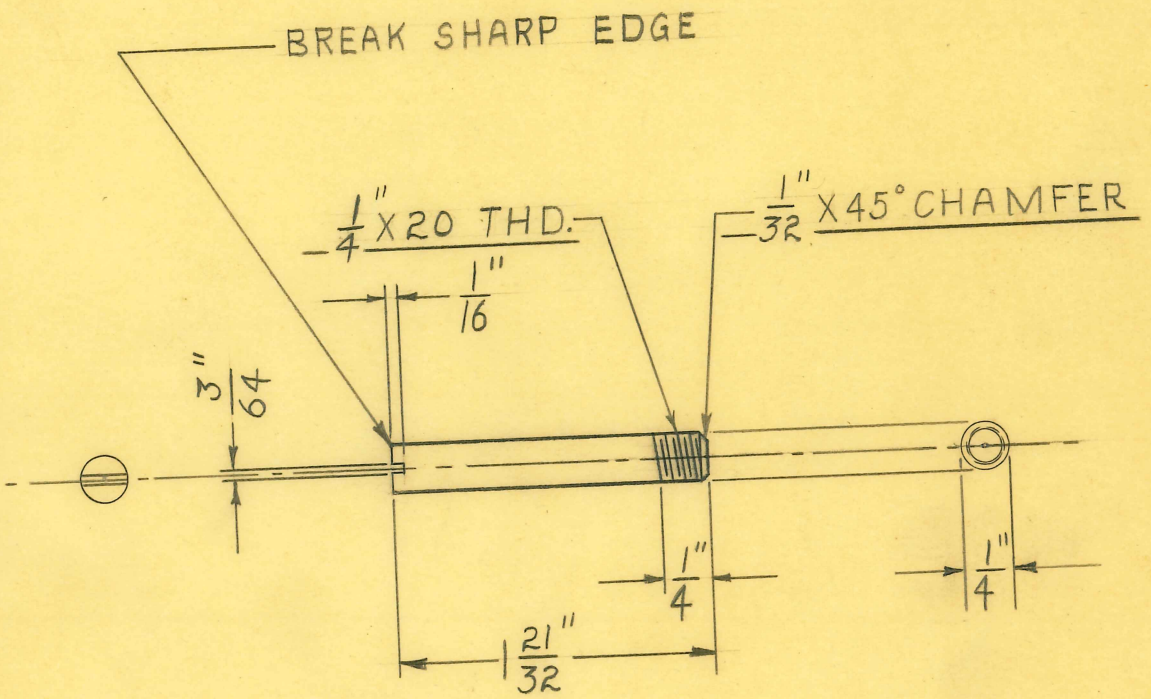

1 REQUIRED

SIZE	1/4" DIA.	ISSUE 5-29-47	W.J.	
KIND	C.R. STEEL	CHANGED		
SHAPE	ROD	"		
FINISH	WH. NICKEL #13	"		
TEMP.		"		
PATT.		"		

TITLE: FISCHER "MP-20" X-RAY UNIT
VERTICAL SLIDE LOCK TRIP LEVER SHAFT

H. G. FISCHER & CO.
2335 WABANSIA AVE.
CHICAGO, ILL.

CAT. NO.

PART NO. 16659

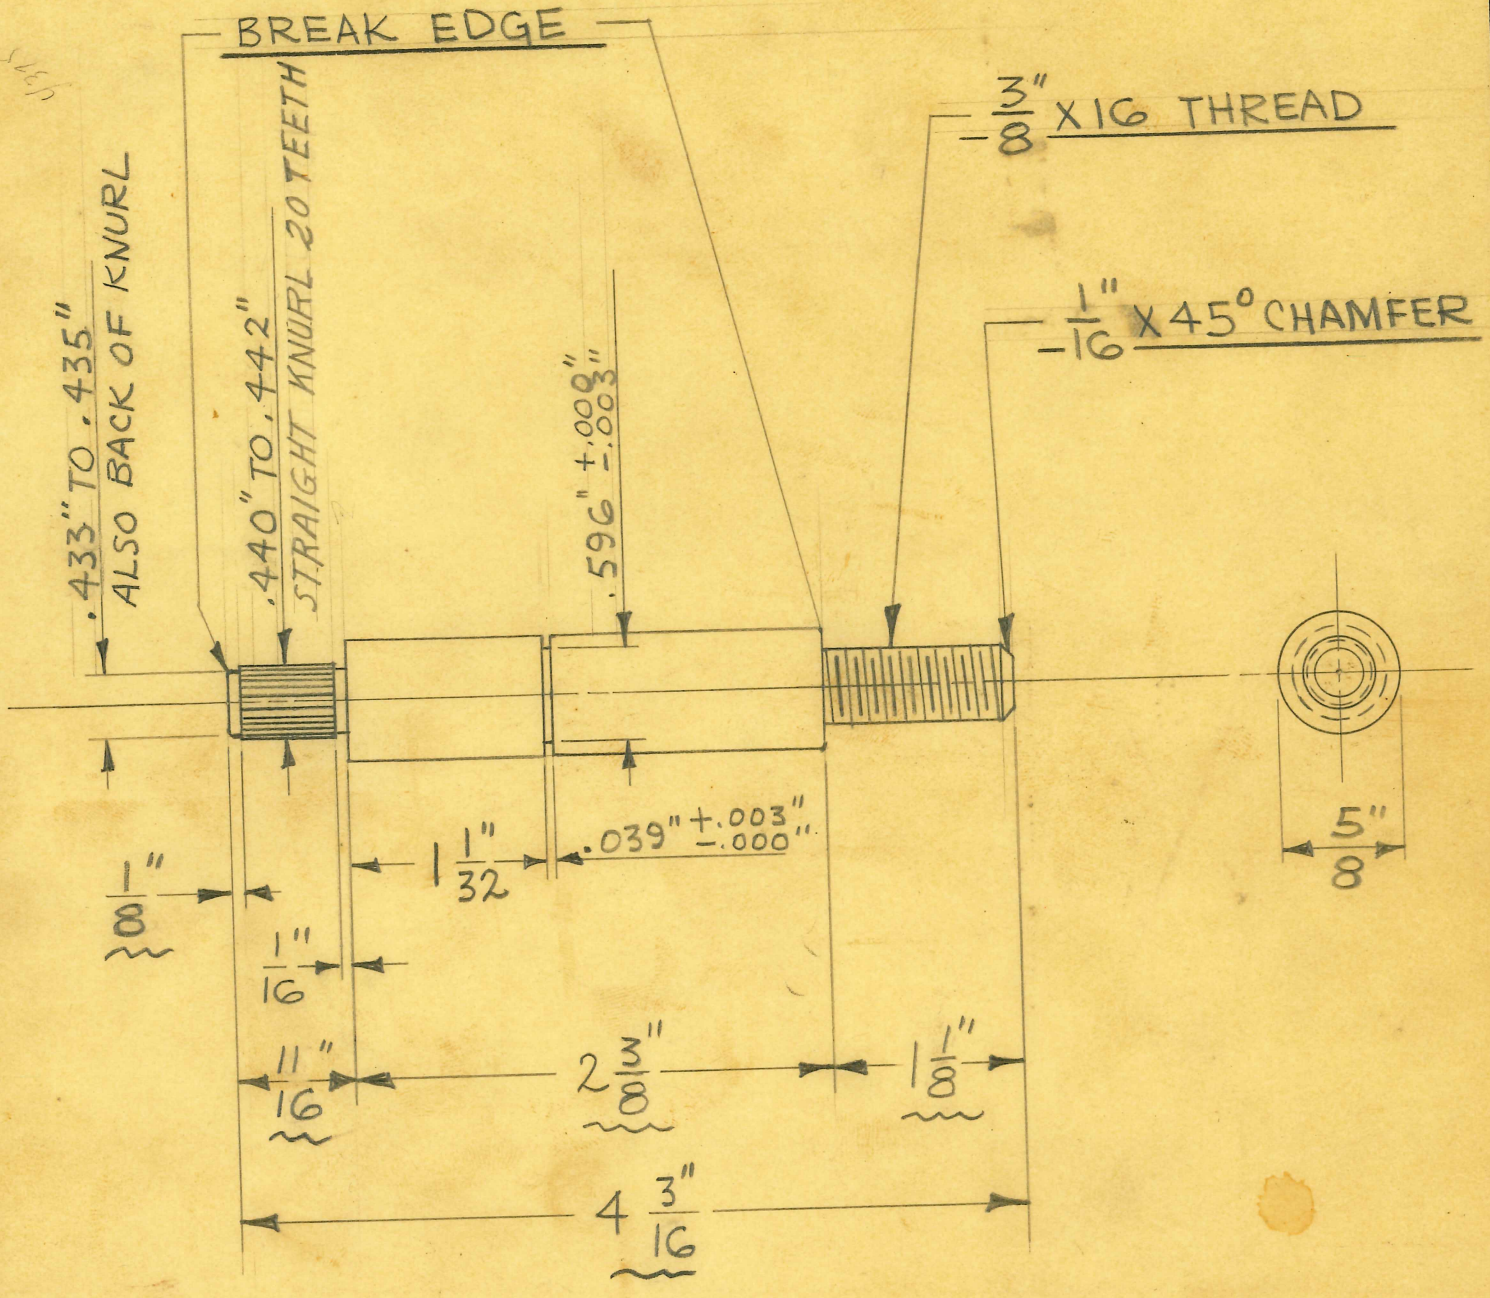

1 REQUIRED

GO-NOGO SNAP GAUGE TOOL #9330

SIZE	5/8" DIA.	ISSUE 5-1-47	J.V.W.
KIND	C.R. STEEL	CHANGED	
SHAPE		"	
FINISH	CAD. #23	"	
TEMP.		"	
PATT.		"	

TITLE: FISCHER "MP-20" X-RAY UNIT
UPRIGHT TUBE CLAMP SCREW

H. G. FISCHER & CO.
2335 WABANSIA AVE.
CHICAGO, ILL.

CAT. NO.

PART NO. 16660

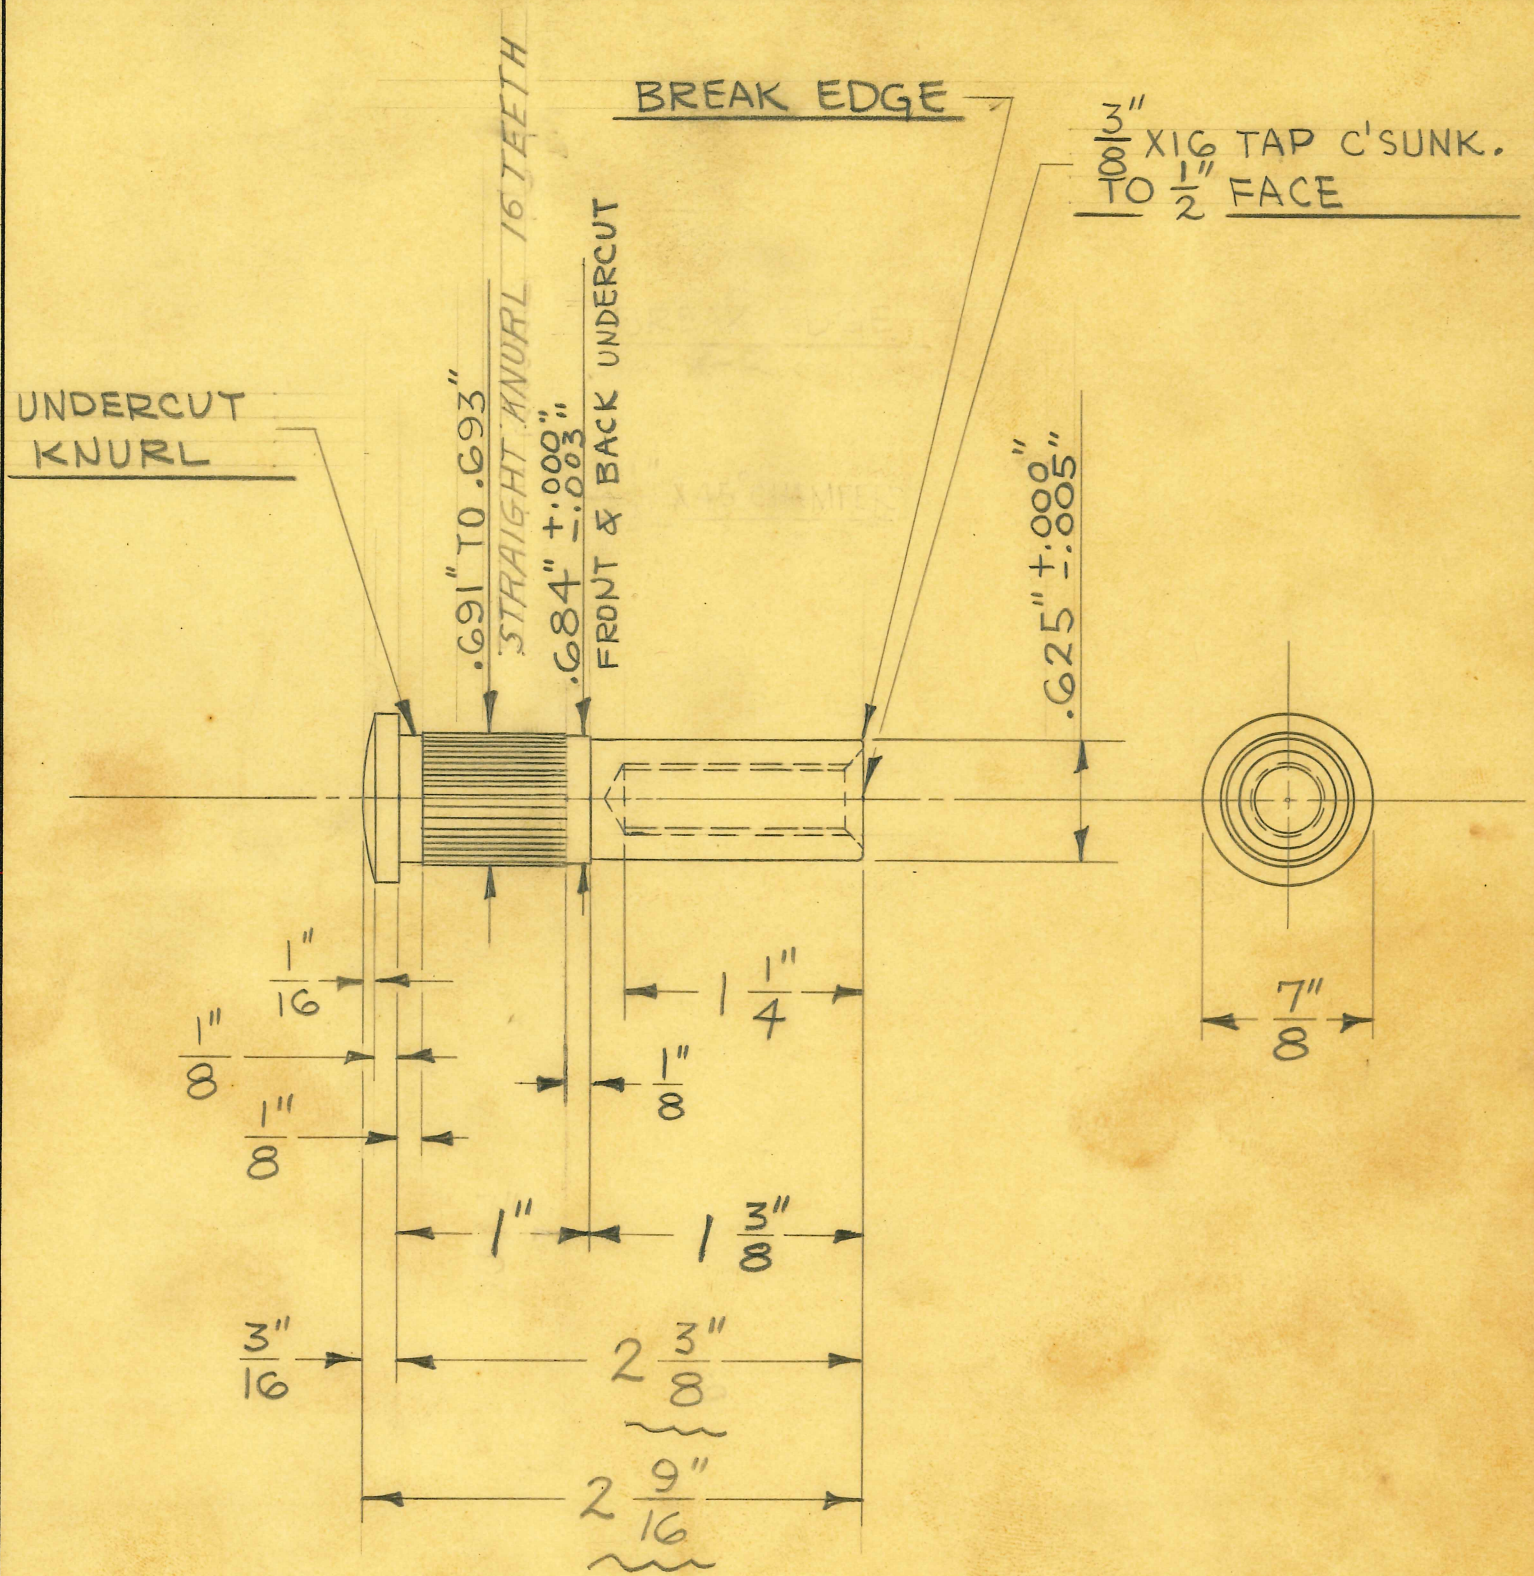

1 REQUIRED

SATIN CHROME #4 – SATIN POLISH TOP & EDGE OF HEAD ONLY

SIZE	7/8" DIA.	ISSUE 5-2-47	J.V.W.
KIND	C.R. STEEL	CHANGED	
SHAPE	ROD	"	
FINISH	SEE NOTE	"	
TEMP.		"	
PATT.		"	

TITLE:
FISCHER "MP-20" X-RAY UNIT
UPRIGHT TUBE CLAMP SHAFT

H. G. FISCHER & CO.
2335 WABANSIA AVE.
CHICAGO, ILL.

CAT. NO.

PART NO. 16661

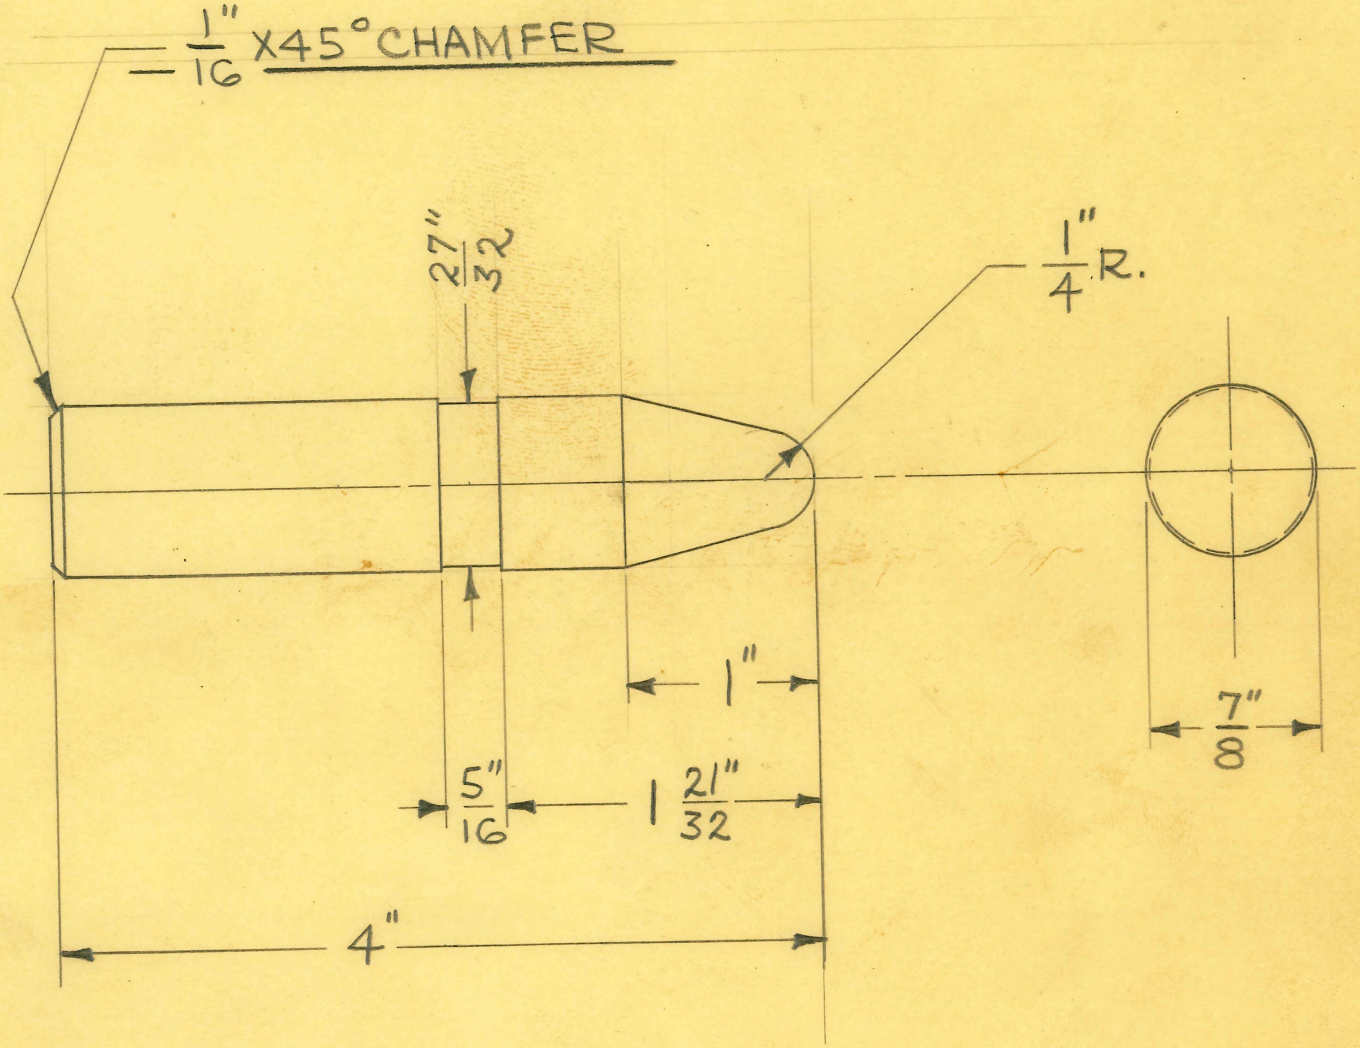

1 REQUIRED

FORM TOOL #9270 6-6-47 F.O. 178

SIZE	7/8" DIA.	ISSUE 6-2-47	J.V.W.
KIND	JEWELER'S	CHANGED	
SHAPE	ROD	"	
FINISH	~~WH. NICKEL #73~~	"	
TEMP.		"	
PATT.		"	

TITLE: FISCHER "MP-20" X-RAY UNIT
CWT. SLIDE TUBE-PLUG-LOWER

H. G. FISCHER & CO.
2335 WABANSIA AVE.
CHICAGO, ILL.

CAT. NO.

PART NO. 16664

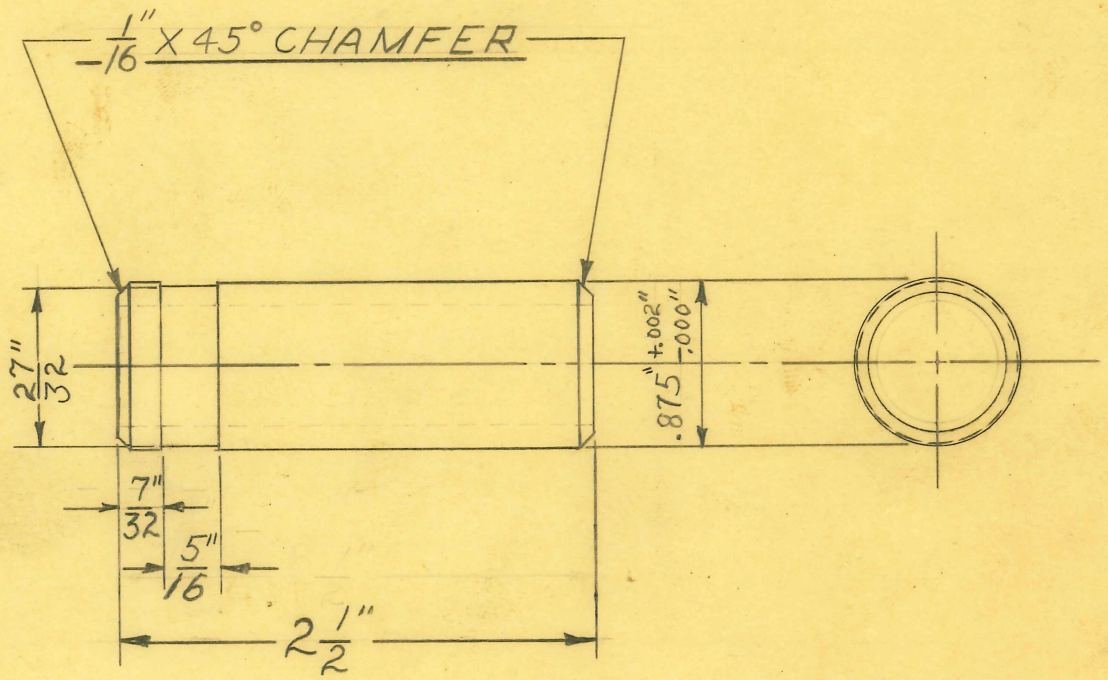

1 REQUIRED

7/8" JEWELERS ROD

SIZE		ISSUE 5-15-47	W.J.
KIND		CHANGED	
SHAPE		"	
FINISH	~~WH. NICKEL PLATE~~	"	
TEMP.		"	
PATT.		"	

TITLE: FISCHER "MP-20" X-RAY UNIT
CWT. SLIDE TUBE - PLUG - UPPER

H. G. FISCHER & CO.
2335 WABANSIA AVE.
CHICAGO, ILL.

CAT. NO.

PART NO. 16665

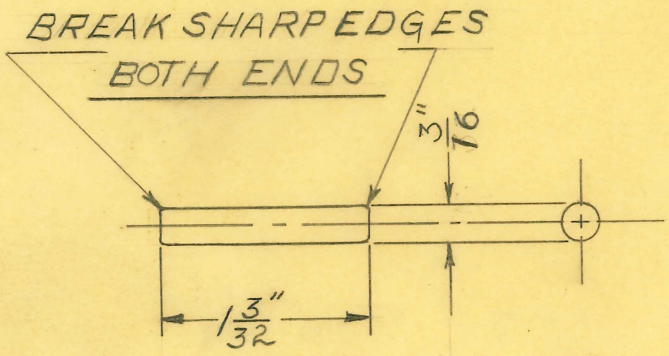

2 REQUIRED

3/16" DIA. C.R. STEEL

SIZE	~~3/16" ROD~~	ISSUE 5-15-47	W.J.
KIND	~~STAINLESS ST.~~	CHANGED	
SHAPE		"	
FINISH		"	
TEMP.		"	
PATT.		"	

TITLE: FISCHER "MP-20" X-RAY UNIT
CWT. SLIDE TUBE-PIN

H. G. FISCHER & CO.
2335 WABANSIA AVE.
CHICAGO, ILL.

CAT. NO.

PART NO. 16666A

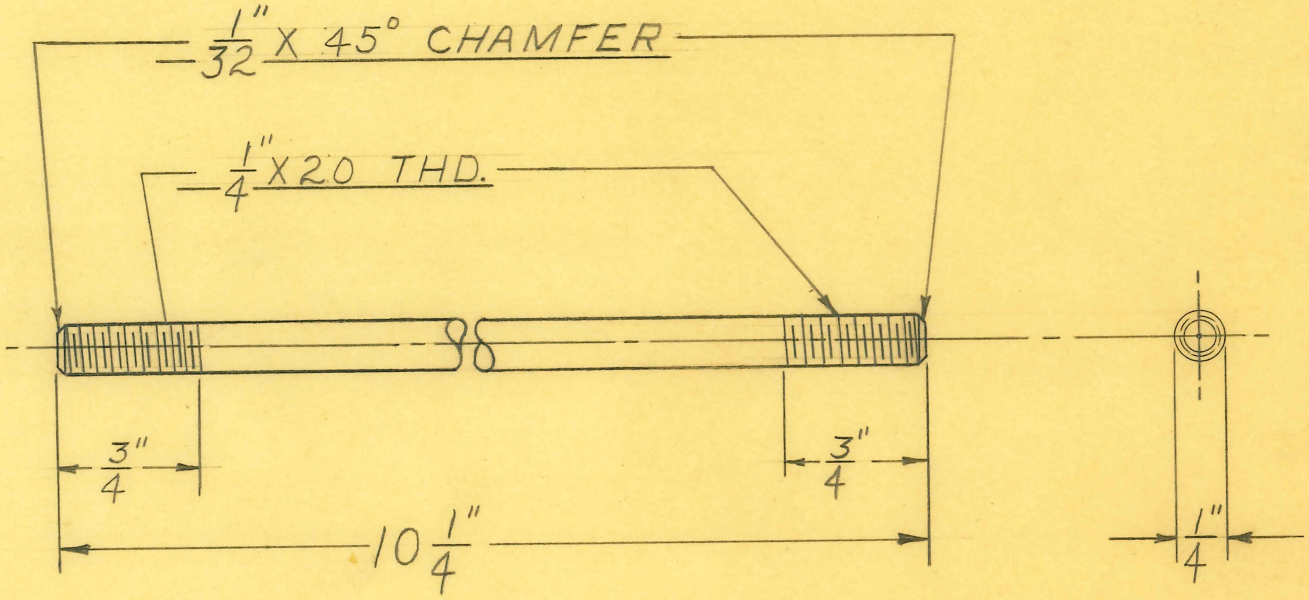

2 REQUIRED

SIZE	1/4" ROD	ISSUE 6-3-47	W.J.
KIND	C.R. STEEL	CHANGED	
SHAPE		"	
FINISH		"	
TEMP.		"	
PATT.		"	

TITLE: FISCHER "MP-10" X-RAY UNIT
CWT. CLAMP ROD

H. G. FISCHER & CO.
2335 WABANSIA AVE.
CHICAGO, ILL.

CAT. NO.

PART NO. 16674

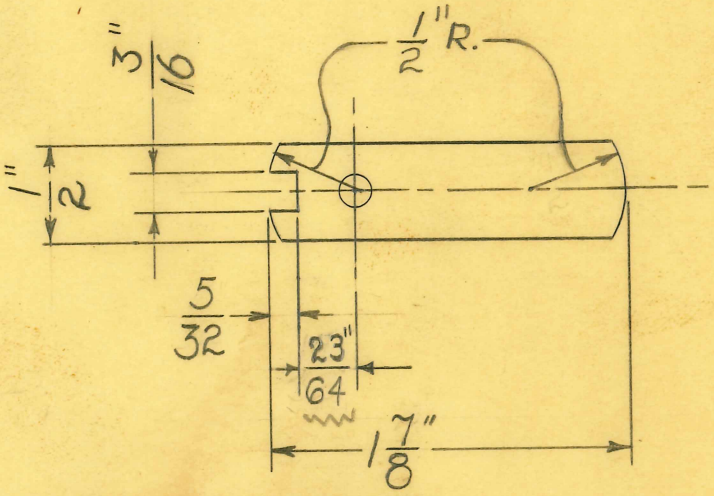

DEVELOPMENT

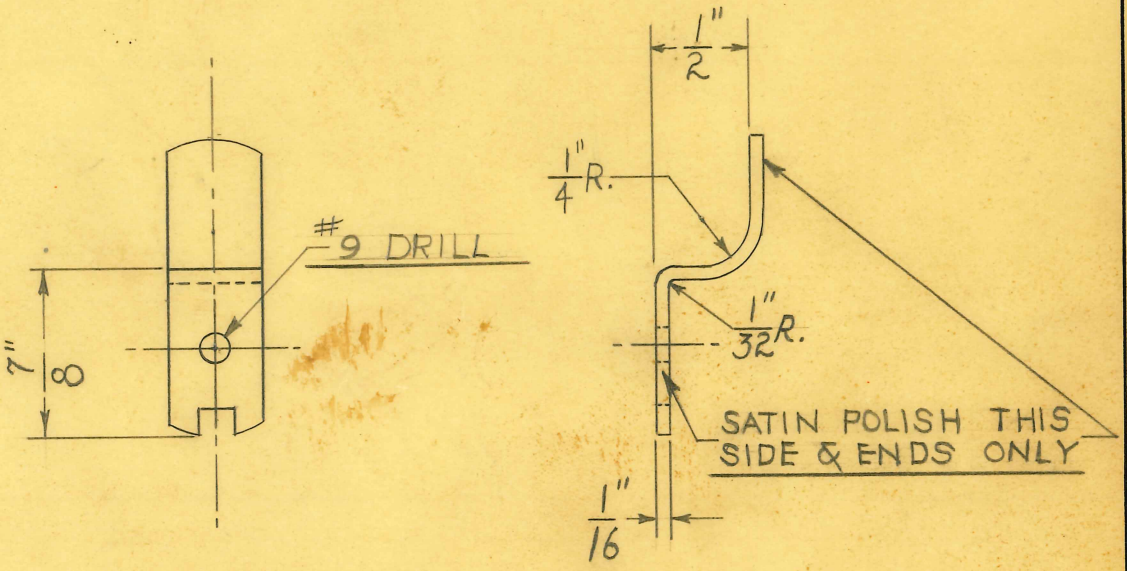

1 REQUIRED

DRILL JIG TOOL #9431

ARBOR PRESS BENDING DIE TOOL #9287 F.O.218

1/16" X 1/2" FLAT WIRE.

SATIN CHROME #4

SIZE		ISSUE 5-28-47	W.J.
KIND		CHANGED	
SHAPE		"	
FINISH	SEE NOTE	"	
TEMP.		"	
PATT.		"	

TITLE:
FISCHER "MP-10" X-RAY UNIT
CABLE SUPPORT

H. G. FISCHER & CO.
2335 WABANSIA AVE.
CHICAGO, ILL.

CAT. NO.

PART NO. 16675

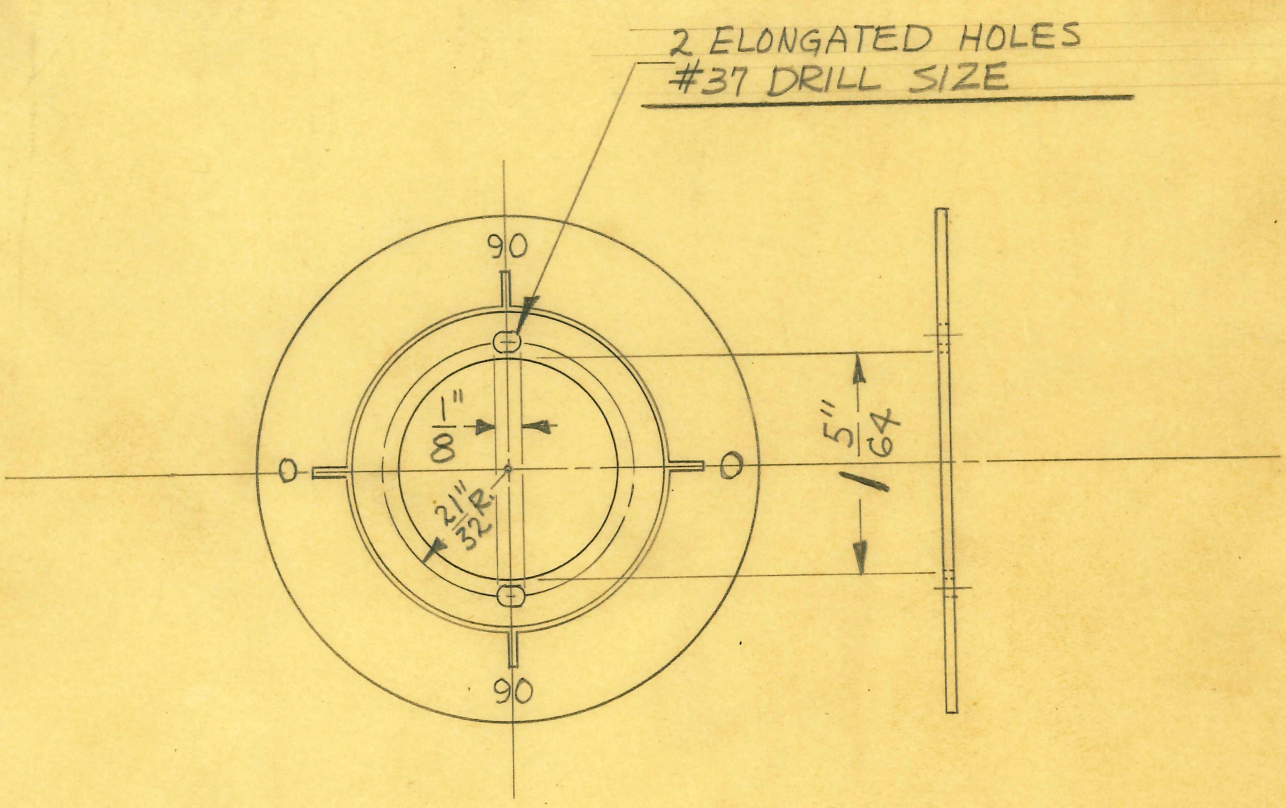

2 REQUIRED FOR TRANSF. HEAD

1 REQUIRED FOR TUBE STAND

SIZE	FROM	ISSUE 4-29-47	J.V.W.
KIND	12321	CHANGED	
SHAPE		"	
FINISH		"	
TEMP.		"	
PATT.		"	

TITLE: FISCHER "MP-10" X-RAY UNIT
ANGLE PLATE

H. G. FISCHER & CO.
2335 WABANSIA AVE.
CHICAGO, ILL.

CAT. NO.

PART NO. 16681

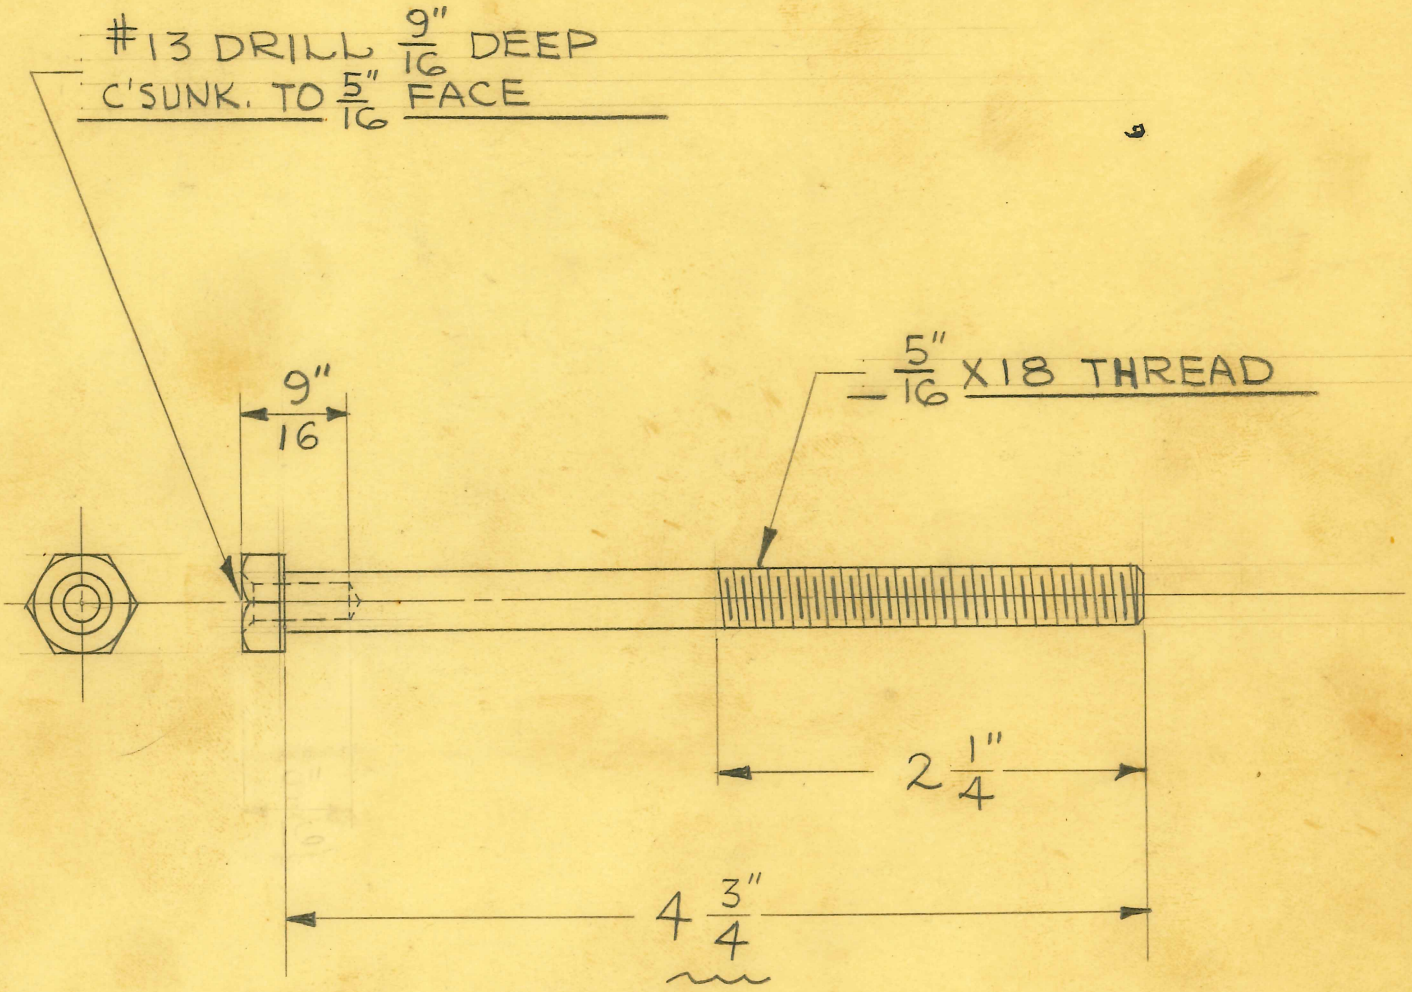

2 REQUIRED

5/16" X18 X 4 3/4" HEX. HD. SEMI-FINISHED MACHINE BOLT

SIZE		ISSUE 5-29-47	J.V.W.
KIND		CHANGED	
SHAPE		"	
FINISH		"	
TEMP.		"	
PATT.		"	

TITLE: FISCHER "MP-20" X-RAY UNIT VERTICAL SLIDE LOCK BOLT

H. G. FISCHER & CO.
2335 WABANSIA AVE.
CHICAGO, ILL.

CAT. NO.

PART NO. 16721F

~~DRILL JIG TOOL #9268 6-6-47 F.O. 176~~ CANCELED

BENDING FIX. TOOL #9269 6-6-47 F.O. 177

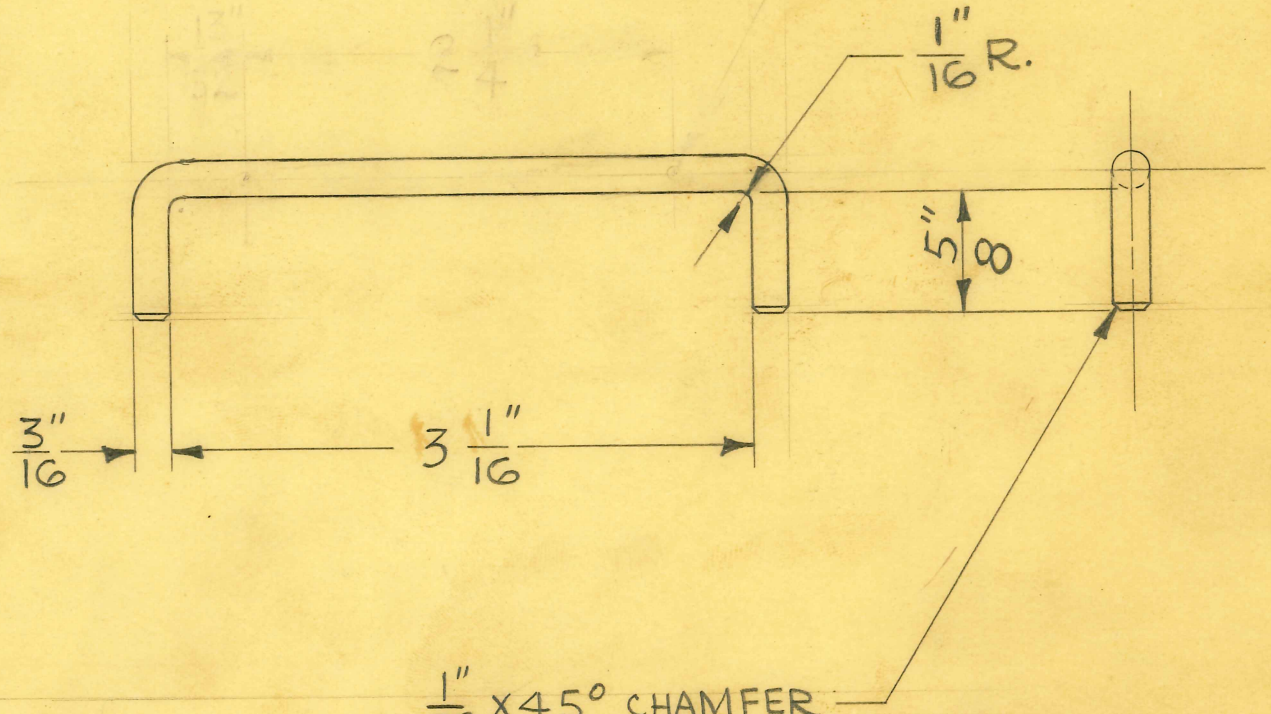

1/32 X 45° CHAMFER BOTH ENDS

DEVELOPED LENGTH = 4 1/2"

1 REQUIRED

SIZE	3/16 DIA.	ISSUE 5-29-47	J.V.W.
KIND	BESSEMER	CHANGED	
SHAPE	ROD	" 10-8-47	JMF
FINISH		"	
TEMP.		"	
PATT.		"	

TITLE: FISCHER "MP-20" X-RAY UNIT
VERTICAL SLIDE LOCK TRIP ROD

H. G. FISCHER & CO.
2335 WABANSIA AVE.
CHICAGO, ILL.

CAT. NO.

PART NO. 16722

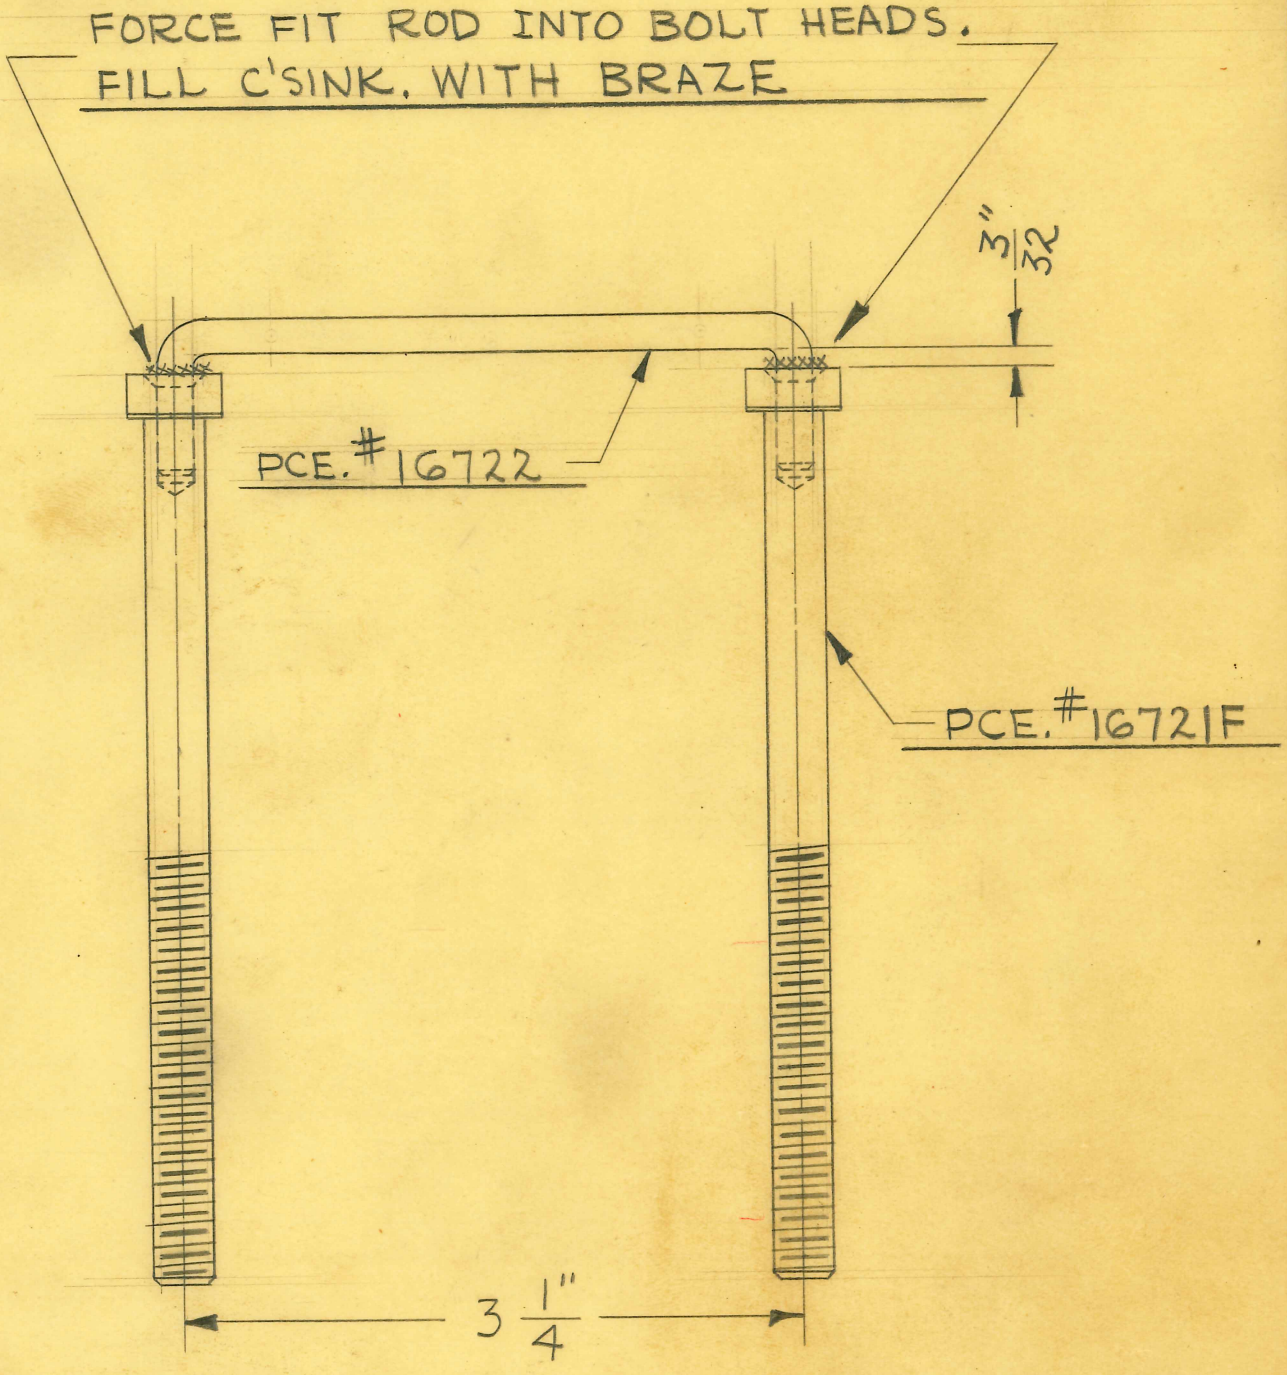

1 REQUIRED

BRAZING FIX. TOOL #9267 6-6-47 F.O. 175

SIZE		ISSUE 6-2-47	J.V.W.	**TITLE:** FISCHER "MP-20" X-RAY UNIT VERTICAL SLIDE LOCK "U" BOLT
KIND		CHANGED		
SHAPE		"		
FINISH	CAD. #23	"		
TEMP.		"		
PATT.		"		

H. G. FISCHER & CO.
2335 WABANSIA AVE.
CHICAGO, ILL.

CAT. NO.

PART NO. 16723G

BENDING FIX. TOOL #9477

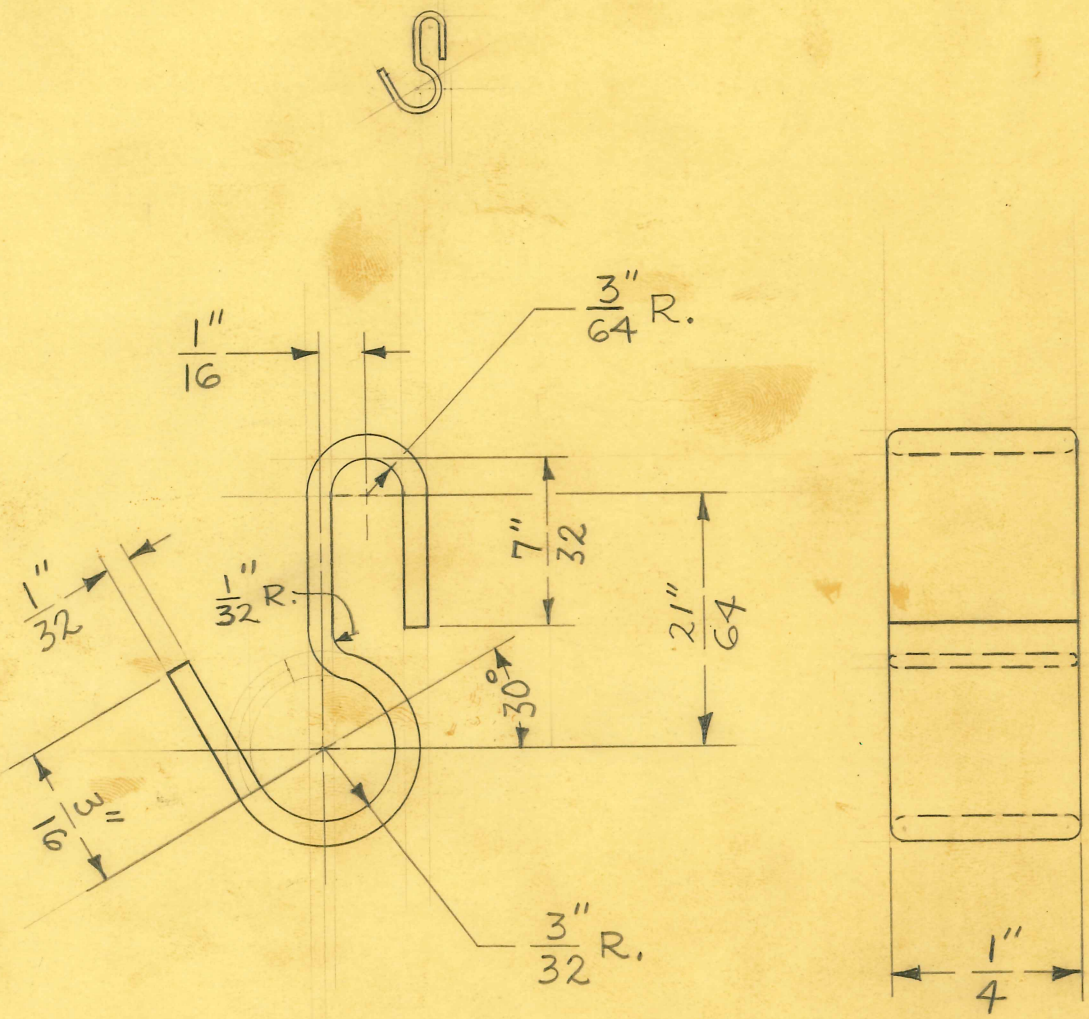

SCALE ~ 4 DIAMETERS

2 REQUIRED

DEVELOPED LENGTH = 1 1/4"

SIZE	1/32" X 1/4"	ISSUE 10-8-47	J.V.W.
KIND	FLAT WIRE	CHANGED	
SHAPE		"	
FINISH	CAD. #23	"	
TEMP.		"	
PATT.		"	

TITLE: FISCHER "MP-10-20" X-RAY VERT. SLIDE LOCK SPRING CLIP

H. G. FISCHER & CO.
2335 WABANSIA AVE.
CHICAGO, ILL.

CAT. NO.

PART NO. 16725

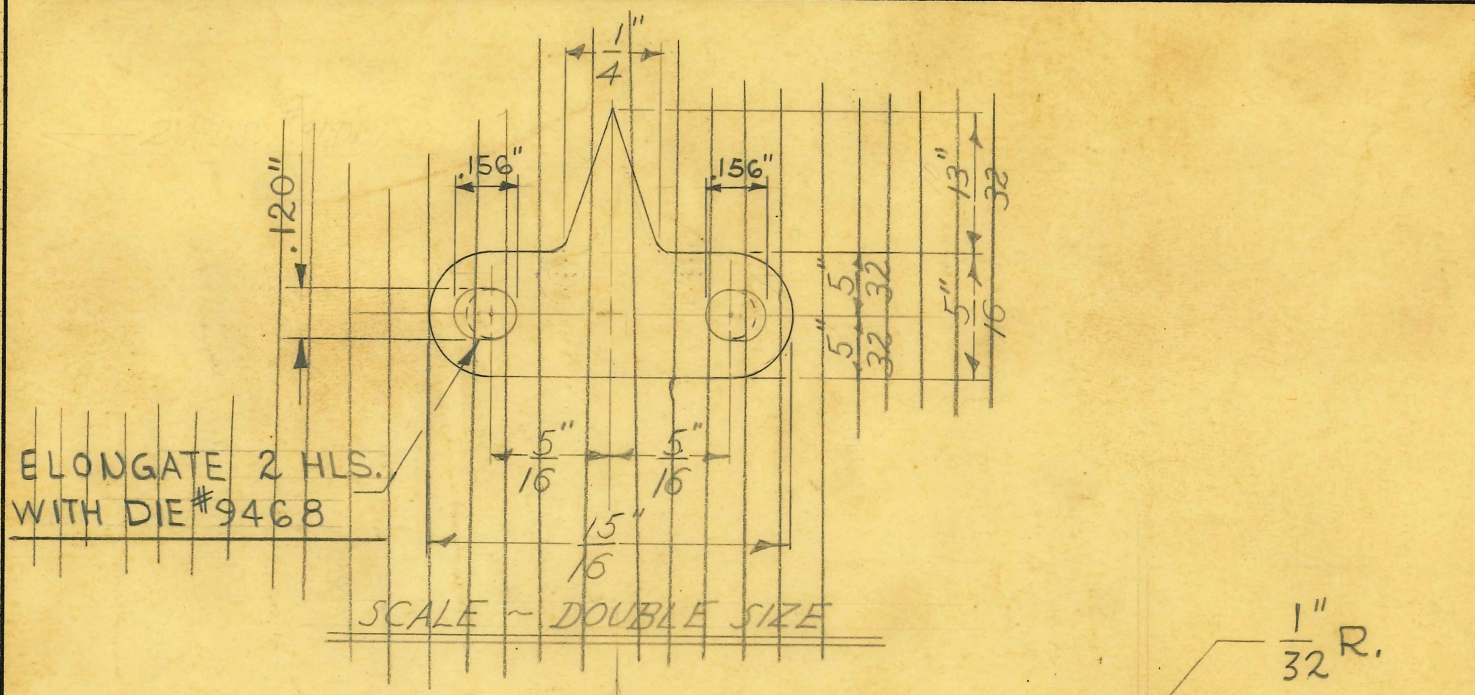

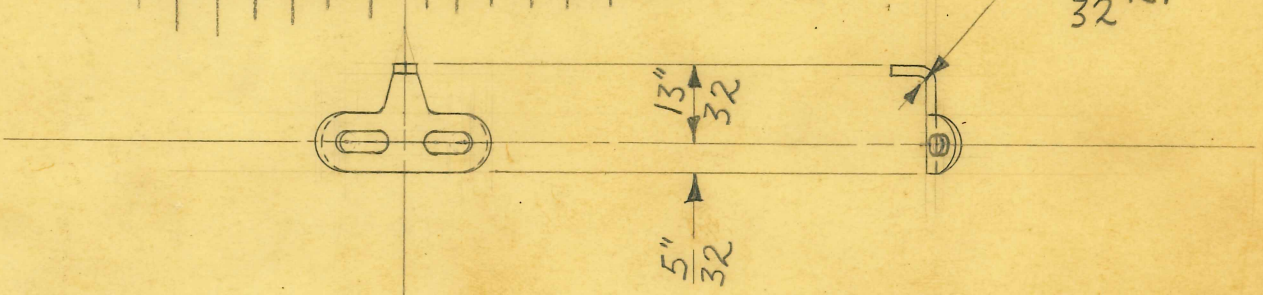

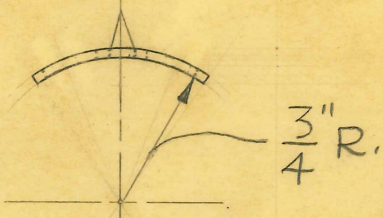

OBSOLETE

WAS REPLACED

BY 8292 CF

11-27-67

SEE BULLETIN #413 SCD.

2 REQUIRED ON "MP-10"

2 REQUIRED ON "MP-20"

~~ELONGATING DIE TOOL #9468~~

FORMING DIE TOOL #9308

RS

SIZE	FROM 8292B	ISSUE 5-29-47	
KIND		CHANGED	
SHAPE		" 1-22-54 WAS 8292	J.V.W.
FINISH	RED AN. #30	"	
TEMP.		"	
PATT.		"	

TITLE:

FISCHER "MP-20" X-RAY UNIT
ANGULATING INDICATOR

H. G. FISCHER & CO. 2335 WABANSIA AVE. CHICAGO, ILL.	CAT. NO.	PART NO. 16726A

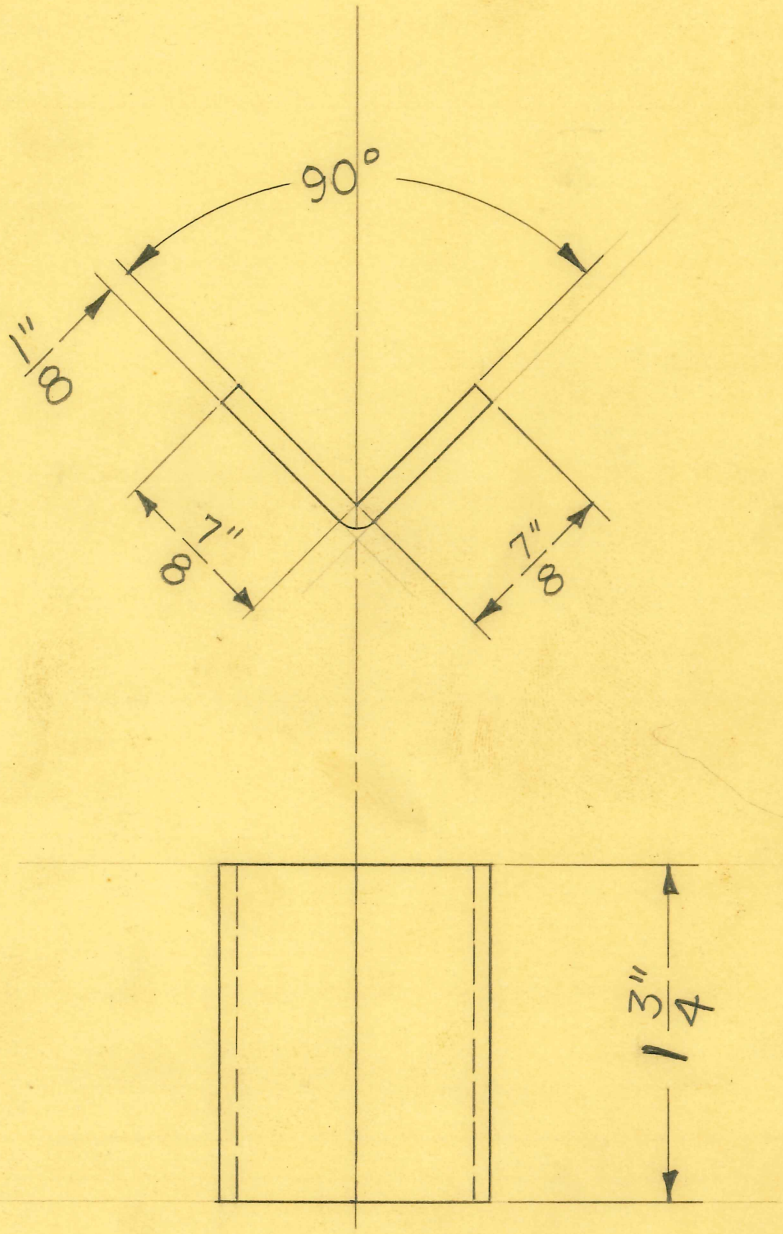

BLANK-CUT $1\frac{3}{4}$" X $1\frac{3}{4}$"

1 REQUIRED

1/8" THICK #60 SERVICE SHEET-UNGRAPHITED

SIZE		ISSUE 6-2-47	J.V.W
KIND		CHANGED	
SHAPE		"	
FINISH		"	
TEMP.		"	
PATT.		"	

TITLE: FISCHER "MP-20" X-RAY UNIT
VERTICAL SLIDE LOCK LINING

H. G. FISCHER & CO.
2335 WABANSIA AVE.
CHICAGO. ILL.

CAT. NO.

PART NO. 16727

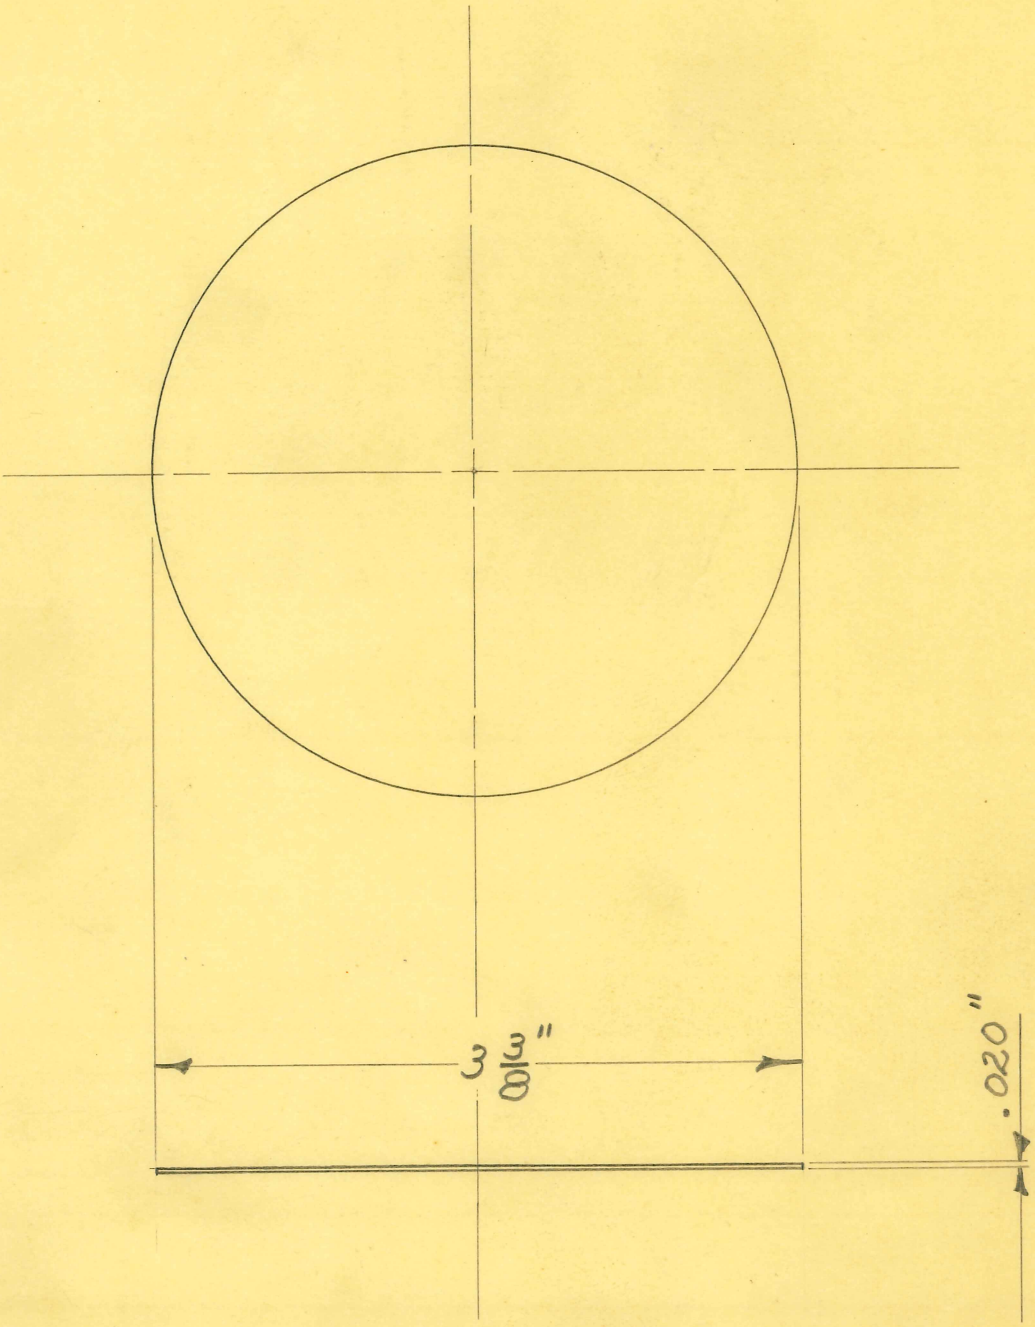

1-REQUIRED

SIZE	.020" SHEET	ISSUE 10-21-47	J.M.F
KIND	ALUMINUM	CHANGED	
SHAPE		"	
FINISH		"	
TEMP.		"	
PATT.		"	

TITLE:
FISCHER MP-10-20 X-RAY UNIT
$\frac{1}{2}$ MM. ALUMINUM FILTER

H. G. FISCHER & CO.
2335 WABANSIA AVE.
CHICAGO, ILL.

CAT. NO.

PART NO. 16731

119

TITLE
FISCHER MP-20 X-RAY UNIT
2 MM FILTER

H. G. FISCHER & CO.
FRANKLIN PARK, ILLINOIS

DATE 9-28-'55 | DR BY RDL | CH'K'D. J.V.W.

PART NO. 16731 1/2

REVISION	DATE	BY

PATTERN | FINISH | SCALE FULL

TOOLS | MATERIAL .080" SHT. ALUM. # 1100-H14

DIMENSIONS UNLESS OTHERWISE SPECIFIED
FRACTIONAL ± .015
DECIMAL ± .005
ANGULAR ± ½°

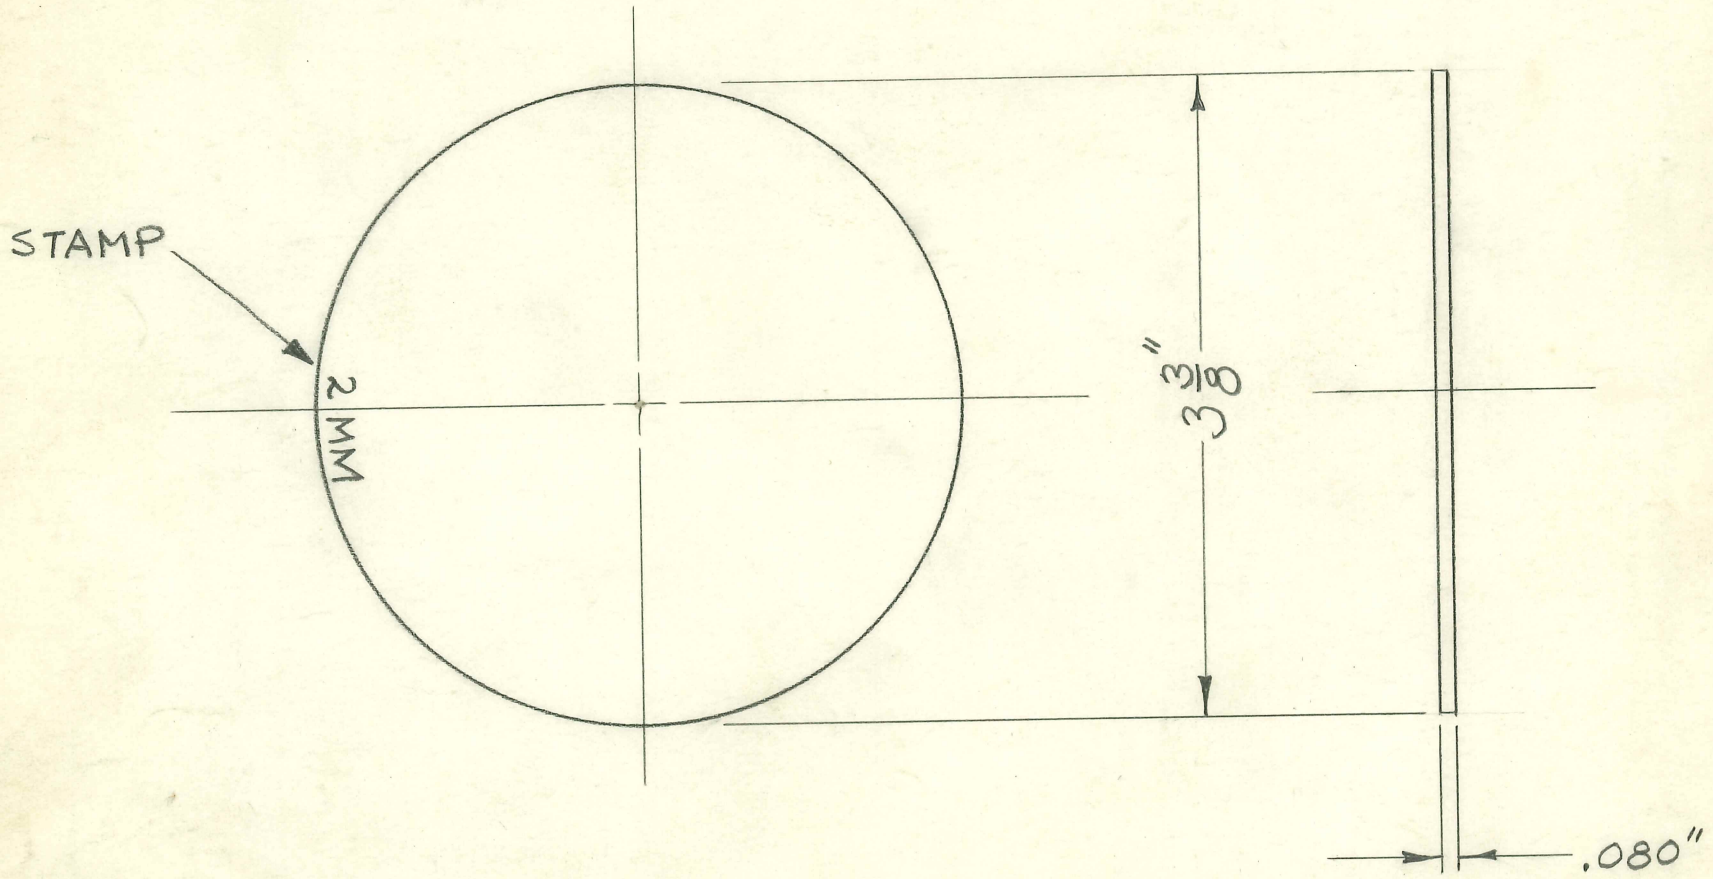

1 REQUIRED

FOLDER #119

TITLE
FISCHER MOD. "200" DIATHERMY PAD ADAPTER - REAR CAP

H. G. FISCHER & CO.
FRANKLIN PARK, ILLINOIS

PART NO. 16746C

DATE 11-23-48 DR. BY J.V.W. CH'K'D. RS.

PATTERN | FINISH | SCALE FULL

TOOLS: DRILL JIG TOOL #9994

MATERIAL: 1/2" SHEET INSUROK GRADE T-815

DIMENSIONS UNLESS OTHERWISE SPECIFIED
FRACTIONAL ± .015
DECIMAL ± .005
ANGULAR ± ½°

	REVISION	DATE	BY
A	REMOVED 33/64" C'BORE FROM CENTER HOLE	10-17-49	W.J.
	WAS ½" SHEET NAT. BAKELITE	4-16-51	J.V.W.

(A)

1 REQUIRED

BREAK SHARP EDGES

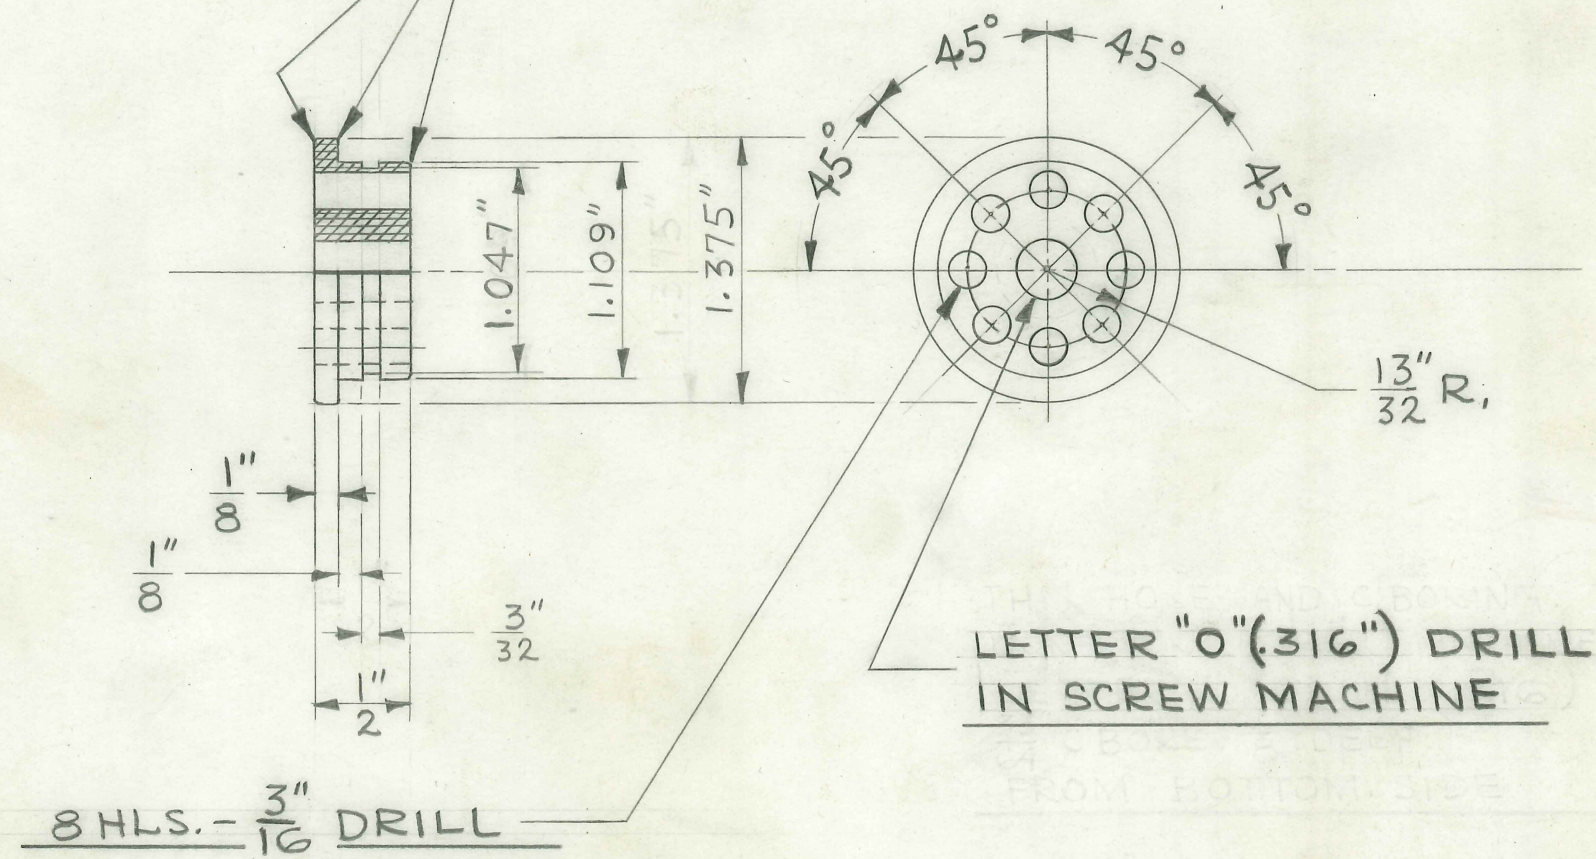

FOLDER #129

TITLE
FISCHER MOD. "200" DIATHERMY
PAD ADAPTER – COIL

H. G. FISCHER & CO.
FRANKLIN PARK, ILLINOIS

PART NO. 16748

DATE 2-9-49 | DR. BY W.J. | CH'K'D. J.V.W.

REVISION	DATE	BY

PATTERN | FINISH | SCALE FULL

DIMENSIONS
FRACTIONAL ± .015
DECIMAL ± .005
ANGULAR ± ½°
UNLESS OTHERWISE SPECIFIED

TOOLS WINDING MANDREL #9992
FORMING FIXTURE #10,059

MATERIAL
#12 GA. (.080") TINNED COPPER WIRE

DEVELOPED LENGTH APPROX. 63"

1 REQUIRED

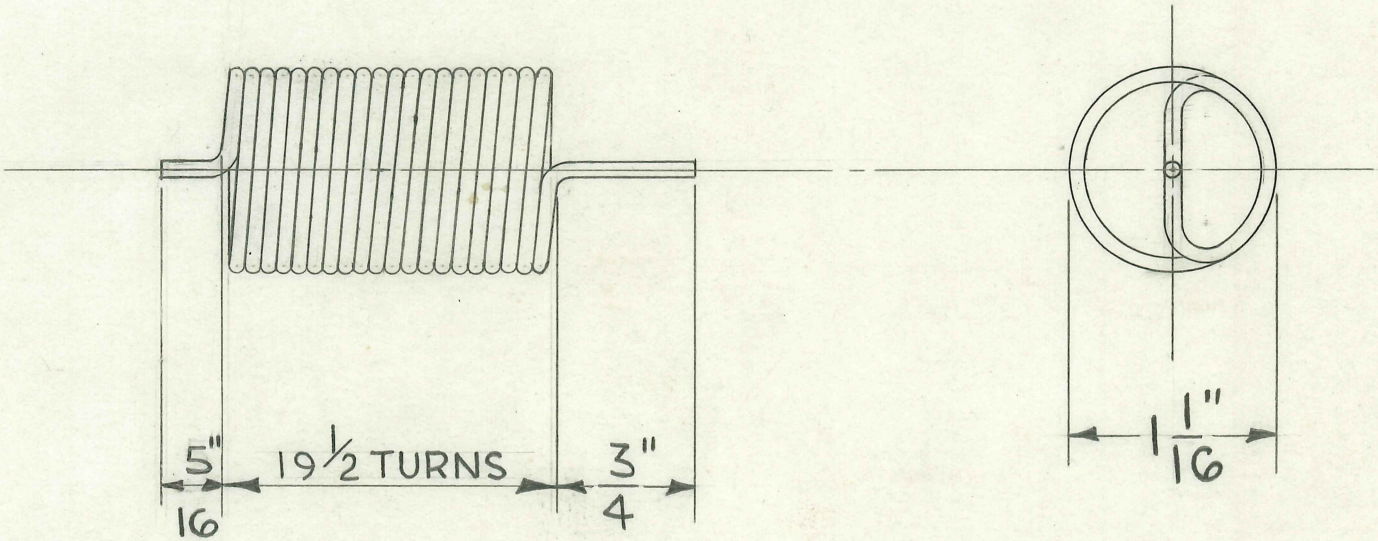

FOLDER #129

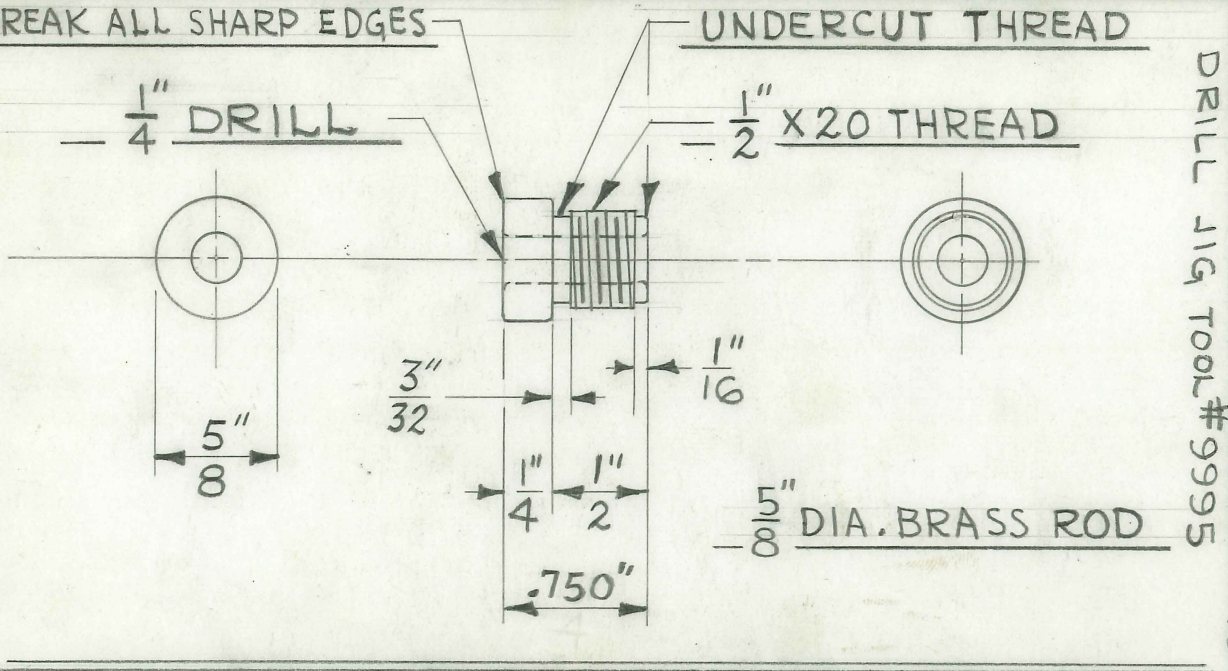

DRILL JIG TOOL #9995

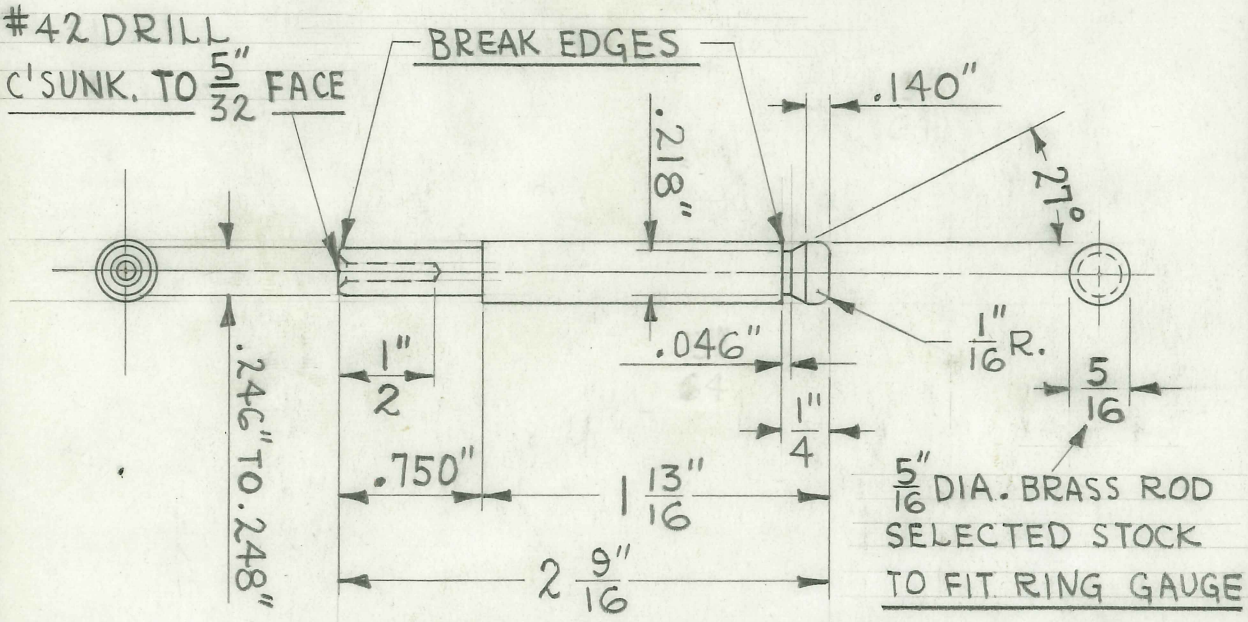

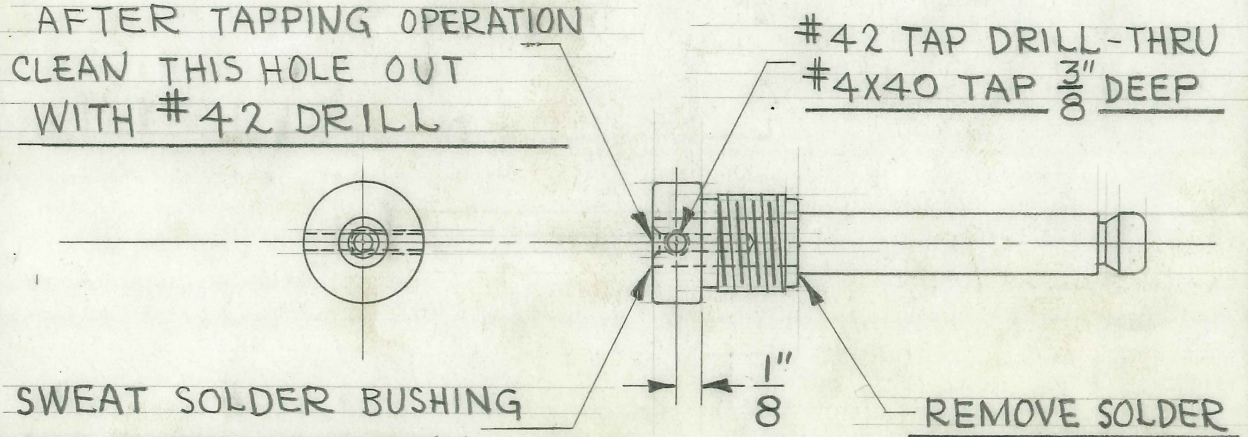

1 REQUIRED

TOOLS .313 GO RING GAUGE TOOL #9806

PATTERN

FINISH WHITE NICKEL #13

SCALE FULL

MATERIAL 5/8" DIA. BRASS ROD 5/16 DIA. BRASS ROD

DIMENSIONS UNLESS OTHERWISE SPECIFIED
FRACTIONAL ±
DECIMAL ± .015 .005
ANGULAR ± 1/2°

DR. BY J.V.W.

CH'K'D.

DATE 11-22-48

TITLE FISCHER MOD. "200" DIATHERMY PAD ADAPTER TIP ASSEMBLY

H. G. FISCHER & CO.
FRANKLIN PARK, ILLINOIS

PART NO. 16750

REVISION	DATE	BY

FOLDER #129

TITLE
FISCHER MOD. "200" DIATHERMY PAD ADAPTER - FRONT CAP

H. G. FISCHER & CO.
FRANKLIN PARK, ILLINOIS

PART NO. 16751B

DATE 11-22-48 | DR. BY J.V.W. | CH'K'D.

PATTERN | FINISH | SCALE FULL

TOOLS | MATERIAL 1/2" SHEET INSUROK GRADE T-815

DIMENSIONS
FRACTIONAL ± .015
DECIMAL ± .005
ANGULAR ± ½°
UNLESS OTHERWISE SPECIFIED

REVISION		DATE	BY
A	GROOVE ADDED		
B	WAS ½" SHEET NAT BAKELITE	4-16-51	J.V.W.

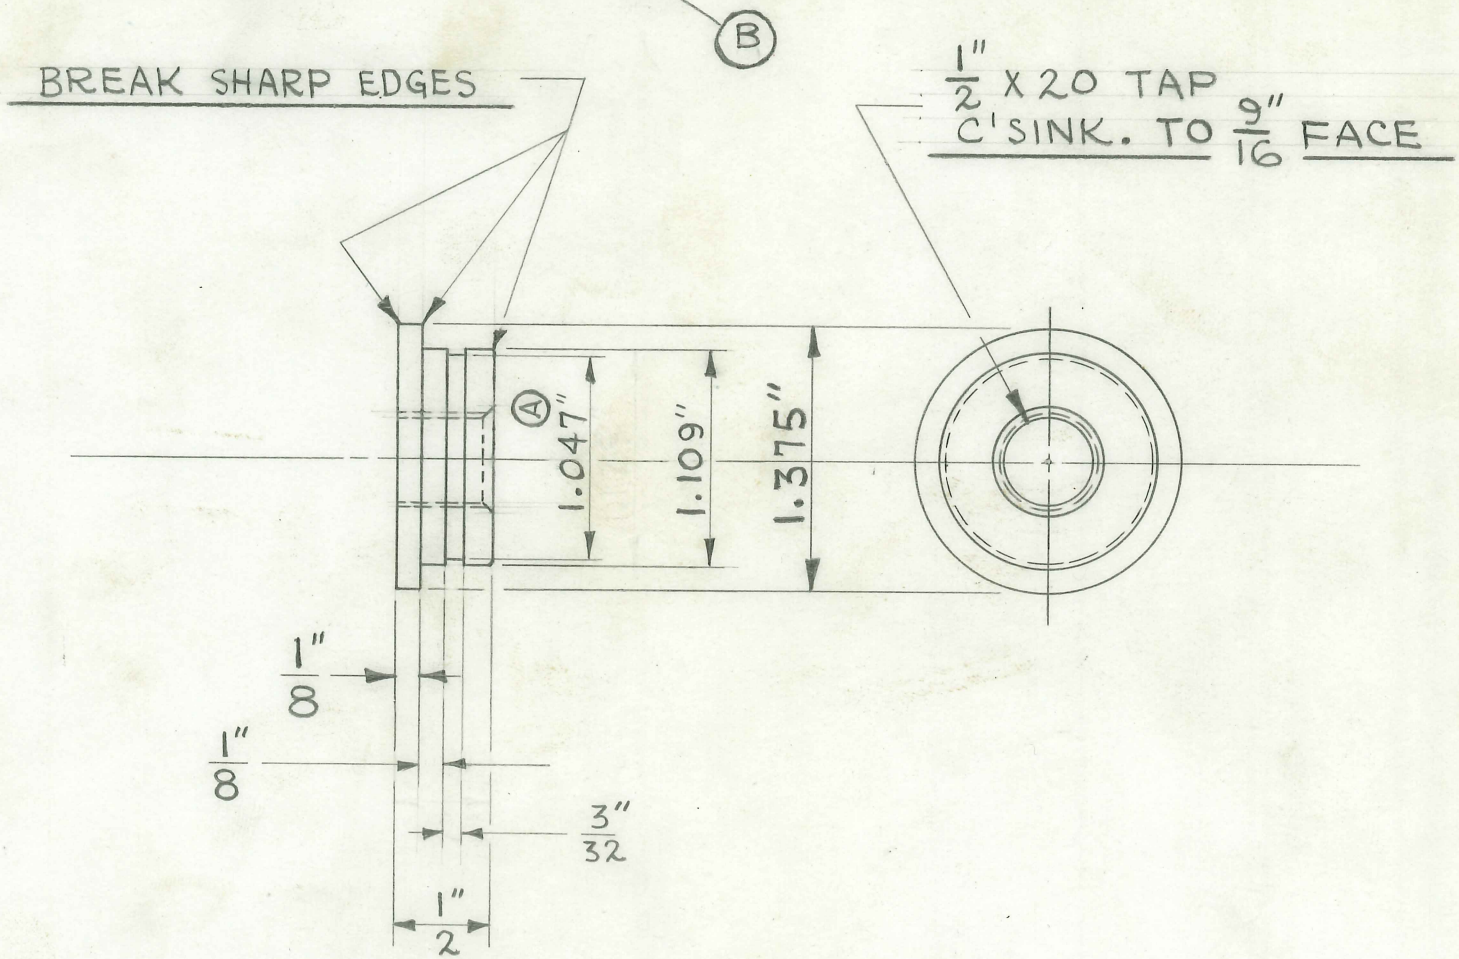

1 REQUIRED

FOLDER #129

TITLE

FISCHER MOD. "200" DIATHERMY CONNECTING CORD SOCKET

H. G. FISCHER & CO.
FRANKLIN PARK, ILLINOIS

PART NO. 16753

DATE 10-18-49 DR. BY W.J. CH'K'D. J.V.W.

REVISION	DATE	BY

PATTERN | FINISH CAD. # 23 | SCALE 1" = 2"

TOOLS | MATERIAL 1/2" BRASS ROD

DIMENSIONS UNLESS OTHERWISE SPECIFIED
FRACTIONAL ± .015
DECIMAL ± .005
ANGULAR ± ½°

1 REQUIRED

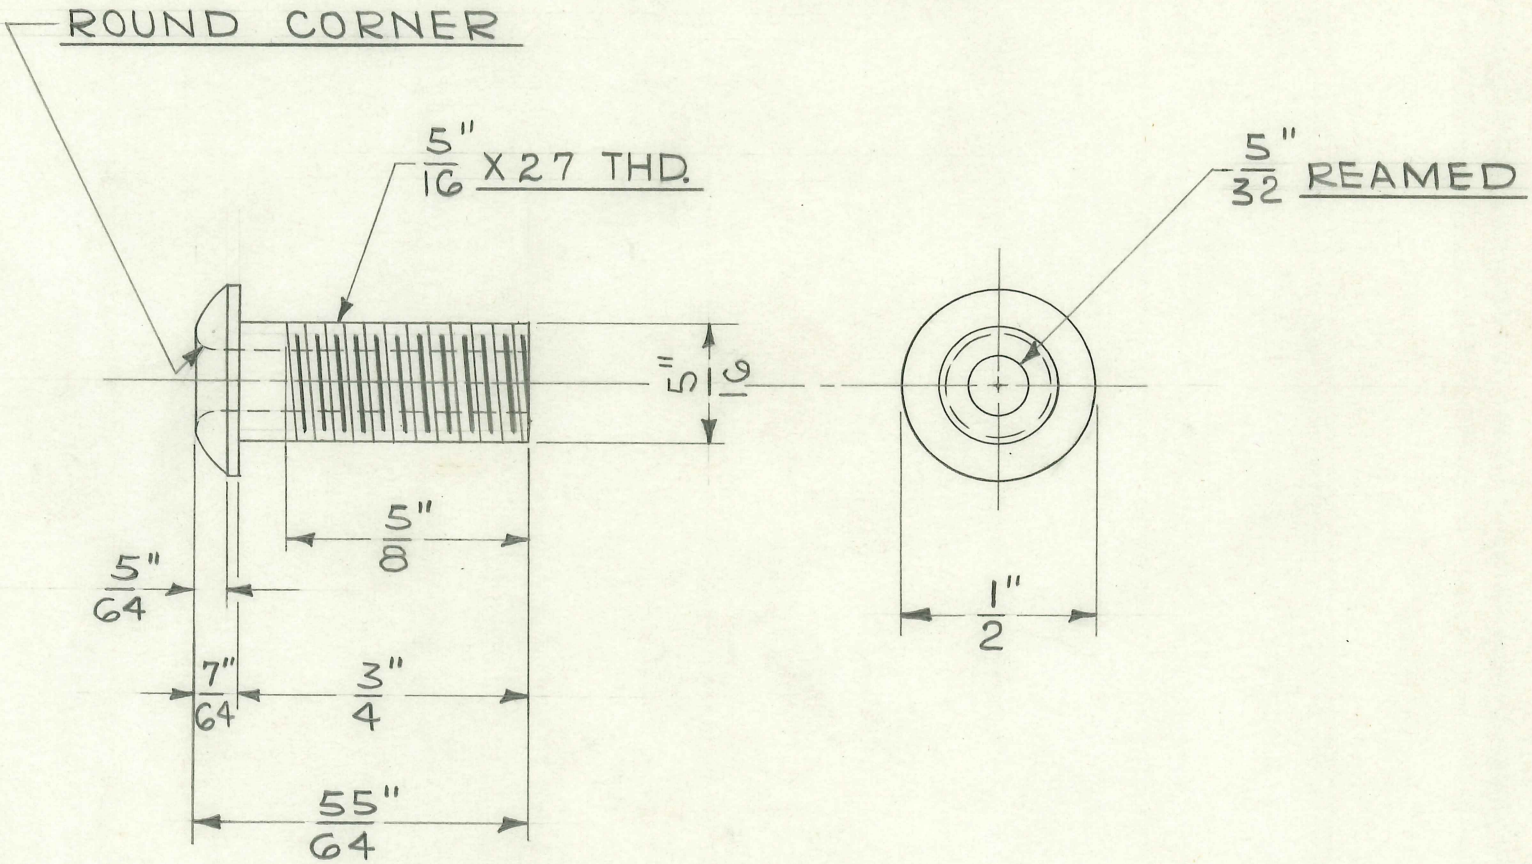

FOLDER #129

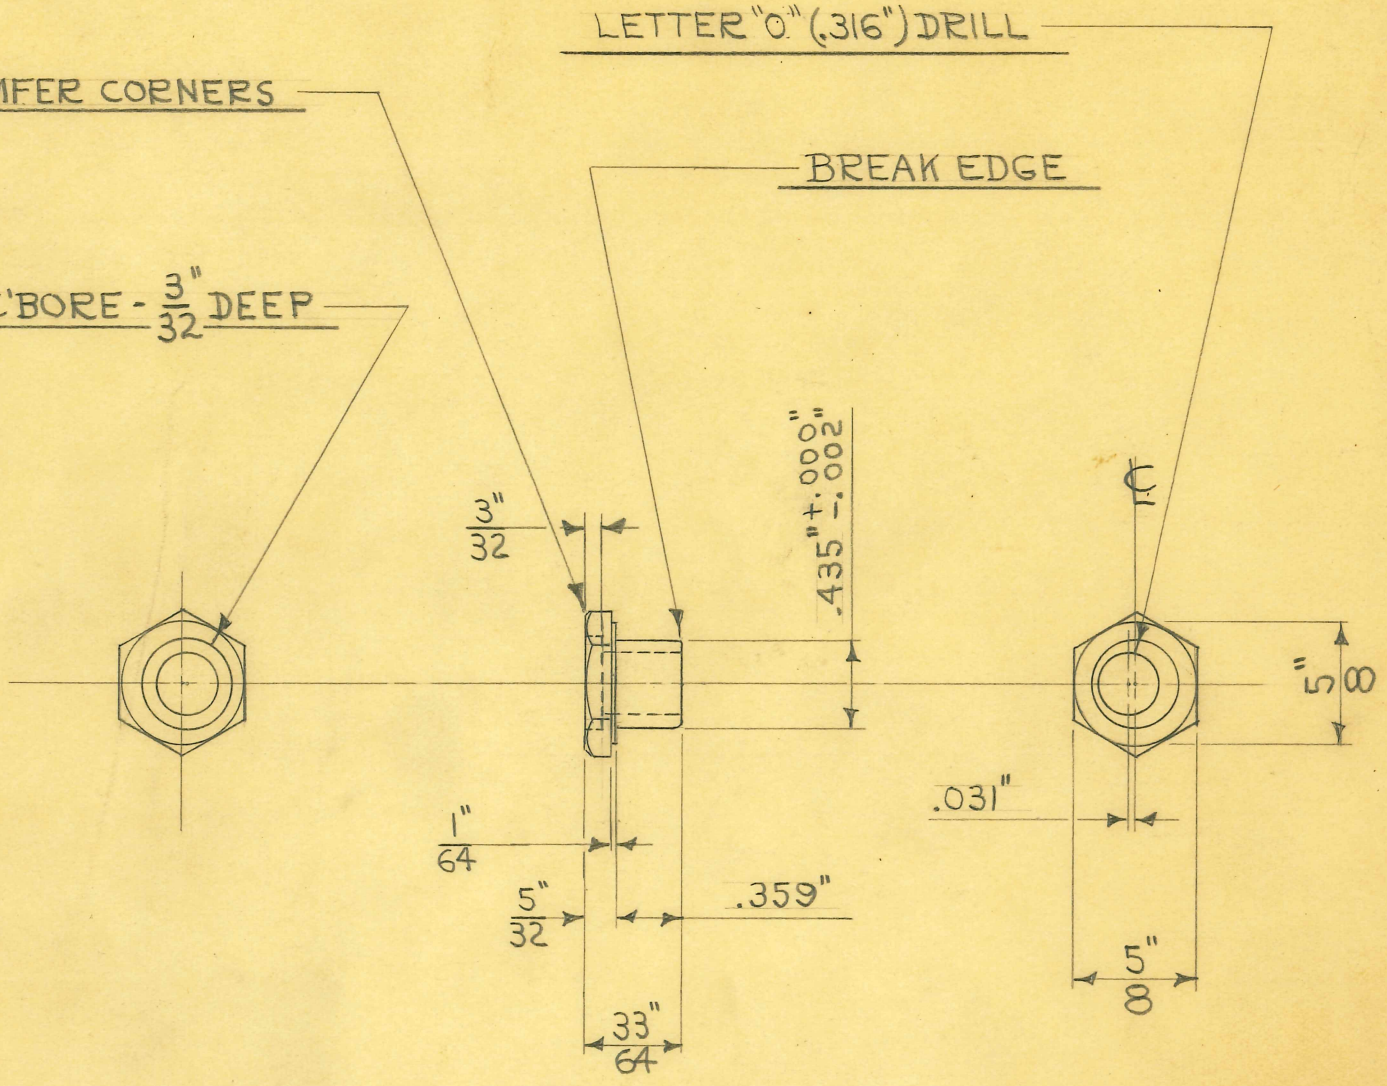

1-REQUIRED

DIMENSIONS	
FRACTIONAL	± .015
DECIMAL	± .005
ANGULAR	± 1/2°

UNLESS OTHERWISE SPECIFIED

SIZE	5/8" HEX.	ISSUE 2-4-48	JNF
KIND	C.R. STEEL	CHANGED	
SHAPE		"	
FINISH	CAD.# 23	"	
TEMP.		"	
PATT.		"	

TITLE:
FISCHER "PRECISION 200" X-RAY UNIT
ECCENTRIC BUSHING

H. G. FISCHER & CO.
2335 WABANSIA AVE.
CHICAGO, ILL.

CAT. NO.

PART NO. 16754

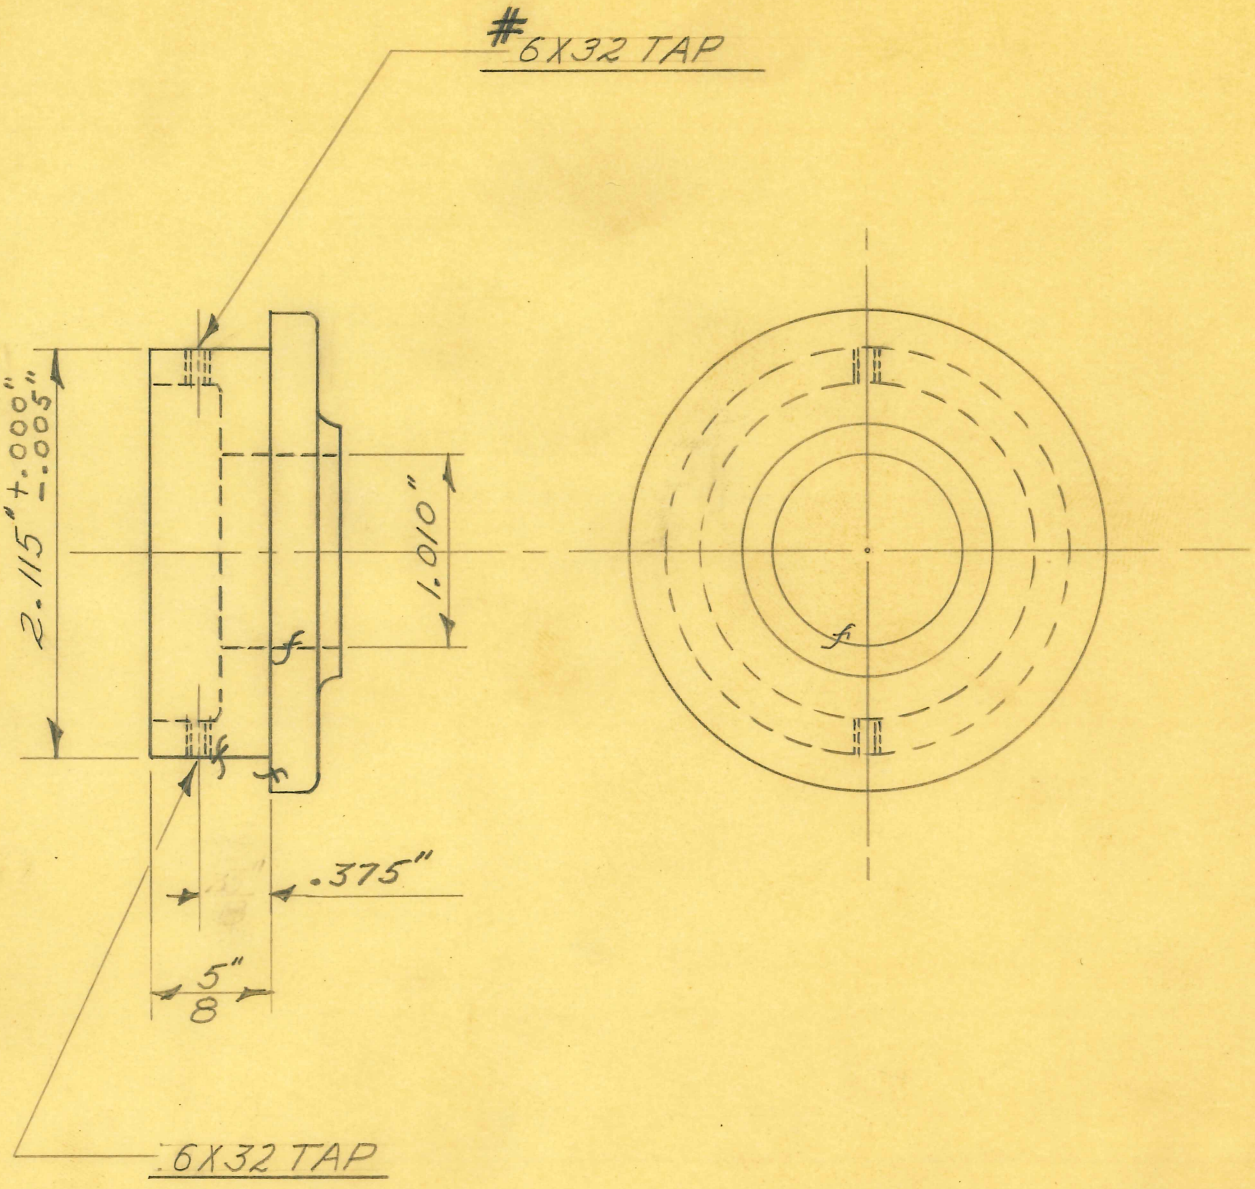

1-REQUIRED

PAINTED-MASKED FINISHED SURFACES

DRILL JIG TOOL #9424

SIZE	MADE	ISSUE 7-25-47	JMF
KIND	FROM	CHANGED	
SHAPE	13354A	"	
FINISH	SEE NOTE	"	
TEMP.		"	
PATT.		"	

TITLE:
FISCHER "PRECISION 200" X-RAY UNIT
CABLE BRACKET SUPPORT BEARING

H. G. FISCHER & CO.
2335 WABANSIA AVE.
CHICAGO, ILL.

CAT. NO.

PART NO. 16790

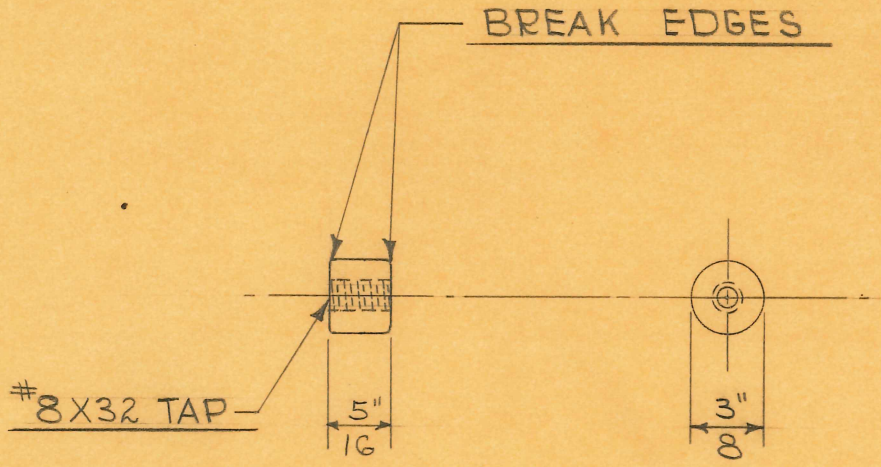

1 REQUIRED

DIMENSIONS	
FRACTIONAL	± .015
DECIMAL	± .005
ANGULAR	± 1/2°

UNLESS OTHERWISE SPECIFIED

SIZE	3/8" DIA.	ISSUE 1-29-48	W.J.
KIND	BRASS	CHANGED	
SHAPE	ROD	"	
FINISH		"	
TEMP.		"	
PATT.		"	

TITLE:
FISCHER PRECISION "200" X-RAY UNIT
STERO SHIFT LOCK RING SPACER

H. G. FISCHER & CO.
2335 WABANSIA AVE.
CHICAGO, ILL.

CAT. NO.

PART NO. 16794

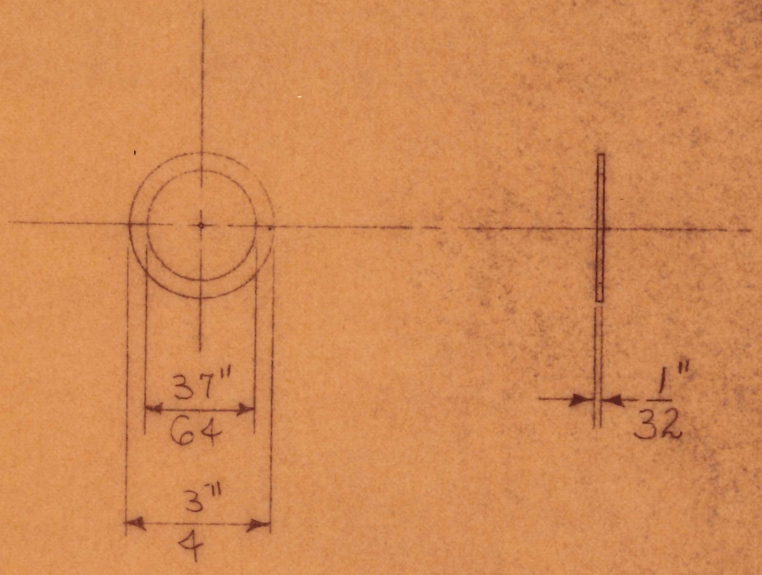

1 REQUIRED

PUNCH & DIE TOOL # 9679

DIMENSIONS	
FRACTIONAL	± .015
DECIMAL	± .005
ANGULAR	± 1/2°

UNLESS OTHERWISE SPECIFIED

SIZE	1/32" SHEET	ISSUE	
KIND	FIBRE	CHANGED	
SHAPE		"	
FINISH		"	
TEMP.		"	
PATT.		"	

TITLE:
FISCHER PRECISION 200 X-RAY UNIT
FRICTION WASHER

H. G. FISCHER & CO.
2535 WABANSIA AVE.
CHICAGO, ILL.

CAT. NO.

PART NO. 16795

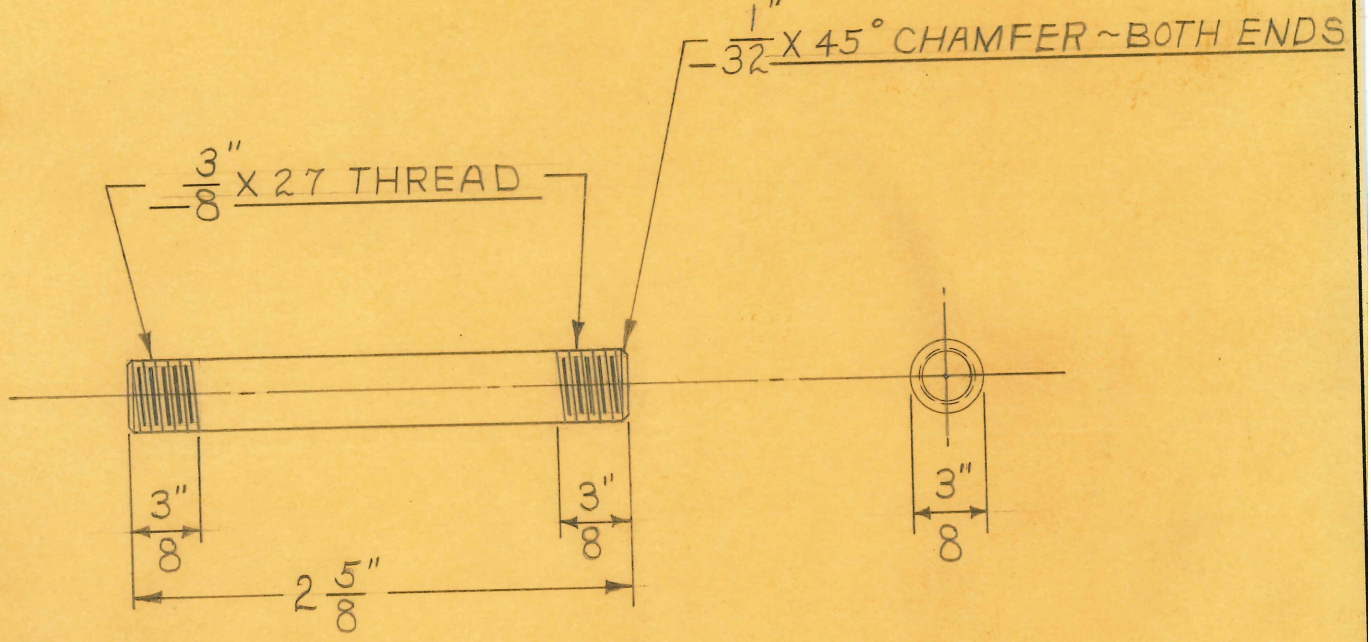

1 REQUIRED

DIMENSIONS	
FRACTIONAL	± .015
DECIMAL	± .005
ANGULAR	± ½°

UNLESS OTHERWISE SPECIFIED

SIZE	3/8" ROD	ISSUE 8-18-47	W.J.
KIND	C.R. STEEL	CHANGED	
SHAPE		"	
FINISH		"	
TEMP.		"	
PATT.		"	

TITLE:

FISCHER "PRESICION 200" X-RAY UNIT
COUNTERWEIGHT PULLEY SHAFT

H. G. FISCHER & CO.
2338 WABANSIA AVE.
CHICAGO, ILL.

CAT. NO.

PART NO. 16797

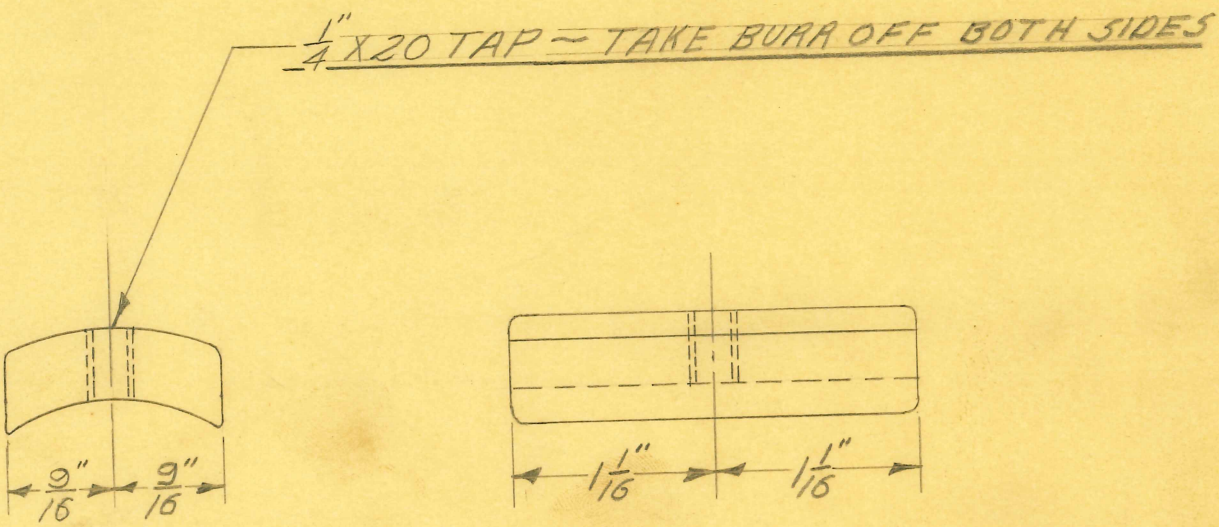

2 REQUIRED

DRILL JIG TOOL #9426

SIZE	CAST IN	ISSUE 7-22-47	J.M.F
KIND	GRAY IRON	CHANGED	
SHAPE	CASTING	"	
FINISH		"	
TEMP.		"	
PATT.	#2152	"	

TITLE: FISCHER "PRECISION 200" X RAY UNIT VERTICAL SPINE UNIT UPRIGHT TUBE CLAMP BLOCK

H. G. FISCHER & CO.
2335 WABANSIA AVE.
CHICAGO, ILL.

CAT. NO.

PART NO. 16807F

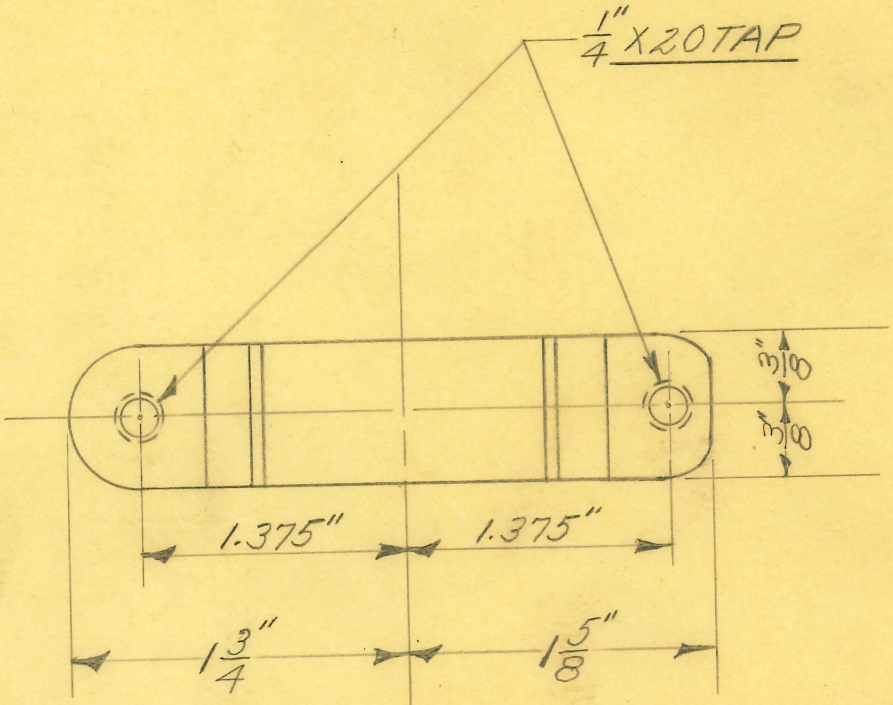

MASK THIS SURFACE ONLY WHEN PAINTING

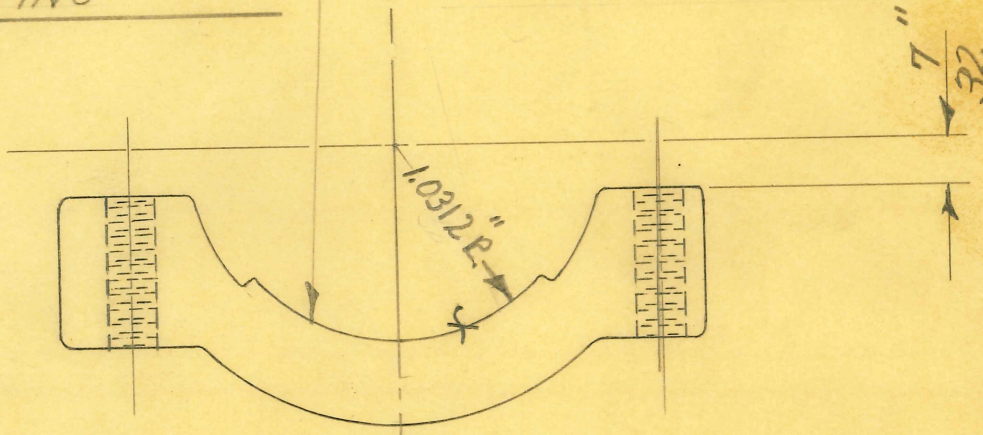

DIMENSIONS	
FRACTIONAL	± .015
DECIMAL	± .005
ANGULAR	± ½°

UNLESS OTHERWISE SPECIFIED

1 REQUIRED

DRILL JIG TOOL # 9406

SIZE	CAST IN	ISSUE 7-21-47	J.M.F
KIND	80-10-10	CHANGED	
SHAPE	BRONZE	"	
FINISH	PAINTED	"	
TEMP.		"	
PATT.	2146	"	

TITLE: FISCHER "PRECISION 200" X RAY UNIT VERTICAL SPINE UNIT BUCKY LOCK TAPPED

H. G. FISCHER & CO.
2335 WABANSIA AVE.
CHICAGO, ILL.

CAT. NO.

PART NO. 16832 F

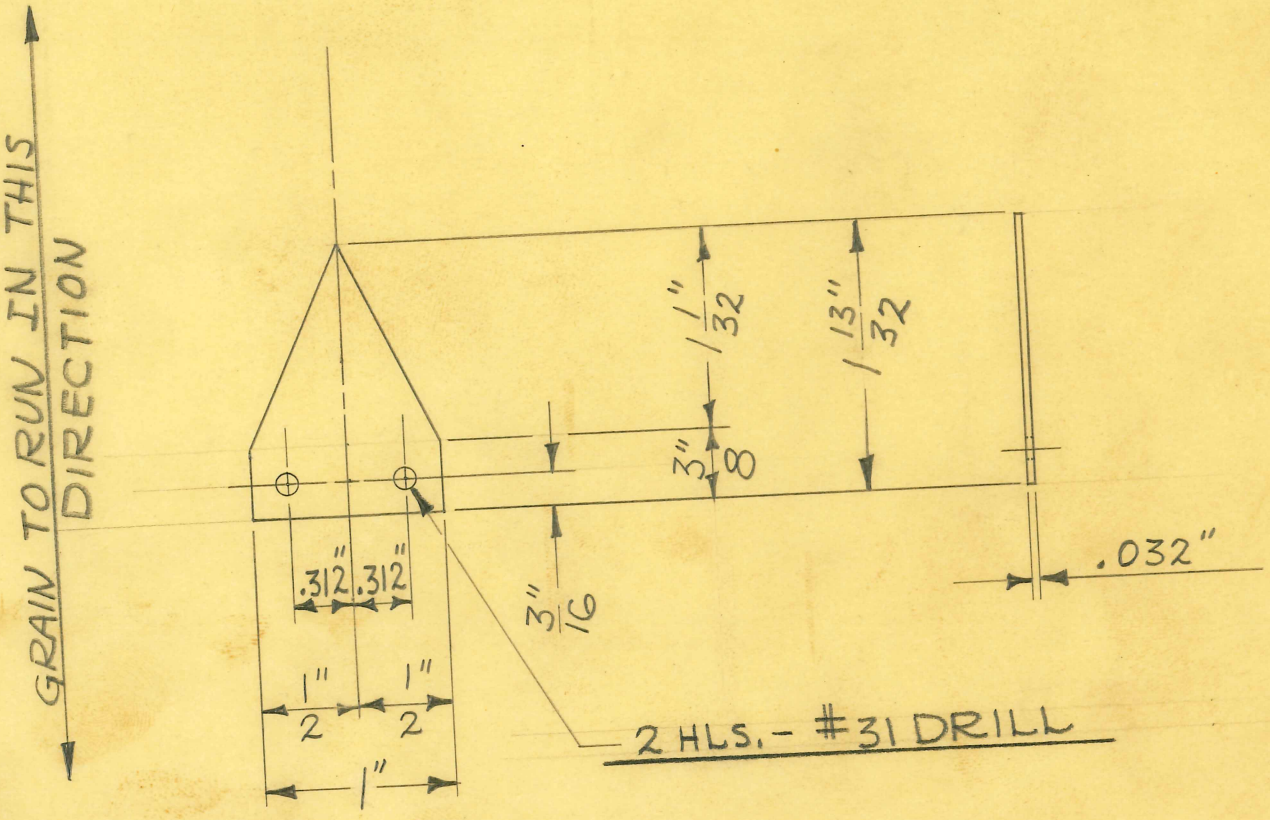

BLANK

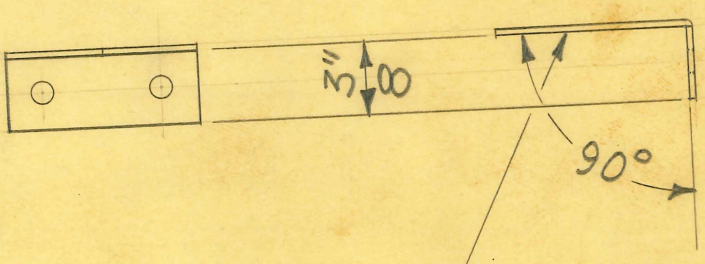

CHROME POLISH THIS SURFACE AND EDGES ONLY

FORM FIXTURE # 9465

DRILL JIG TOOL #9381

1 REQUIRED

DIMENSIONS
FRACTIONAL ± .015
DECIMAL ± .005
ANGULAR ± ½°
UNLESS OTHERWISE SPECIFIED

SIZE	#20 GA. (.032")	ISSUE 7-7-47	J.V.W.
KIND	SHEET BRASS	CHANGED	
SHAPE		"	
FINISH	CHROME #2	"	
FINISH TEMP.	SEE POLISHING NOTE ABOVE	"	
		"	

TITLE: FISCHER "PRECISION 200" X-RAY STEREOSCOPIC SHIFT POINTER

H. G. FISCHER & CO.
2335 WABANSIA AVE.
CHICAGO, ILL.

CAT. NO.

PART NO. 16844

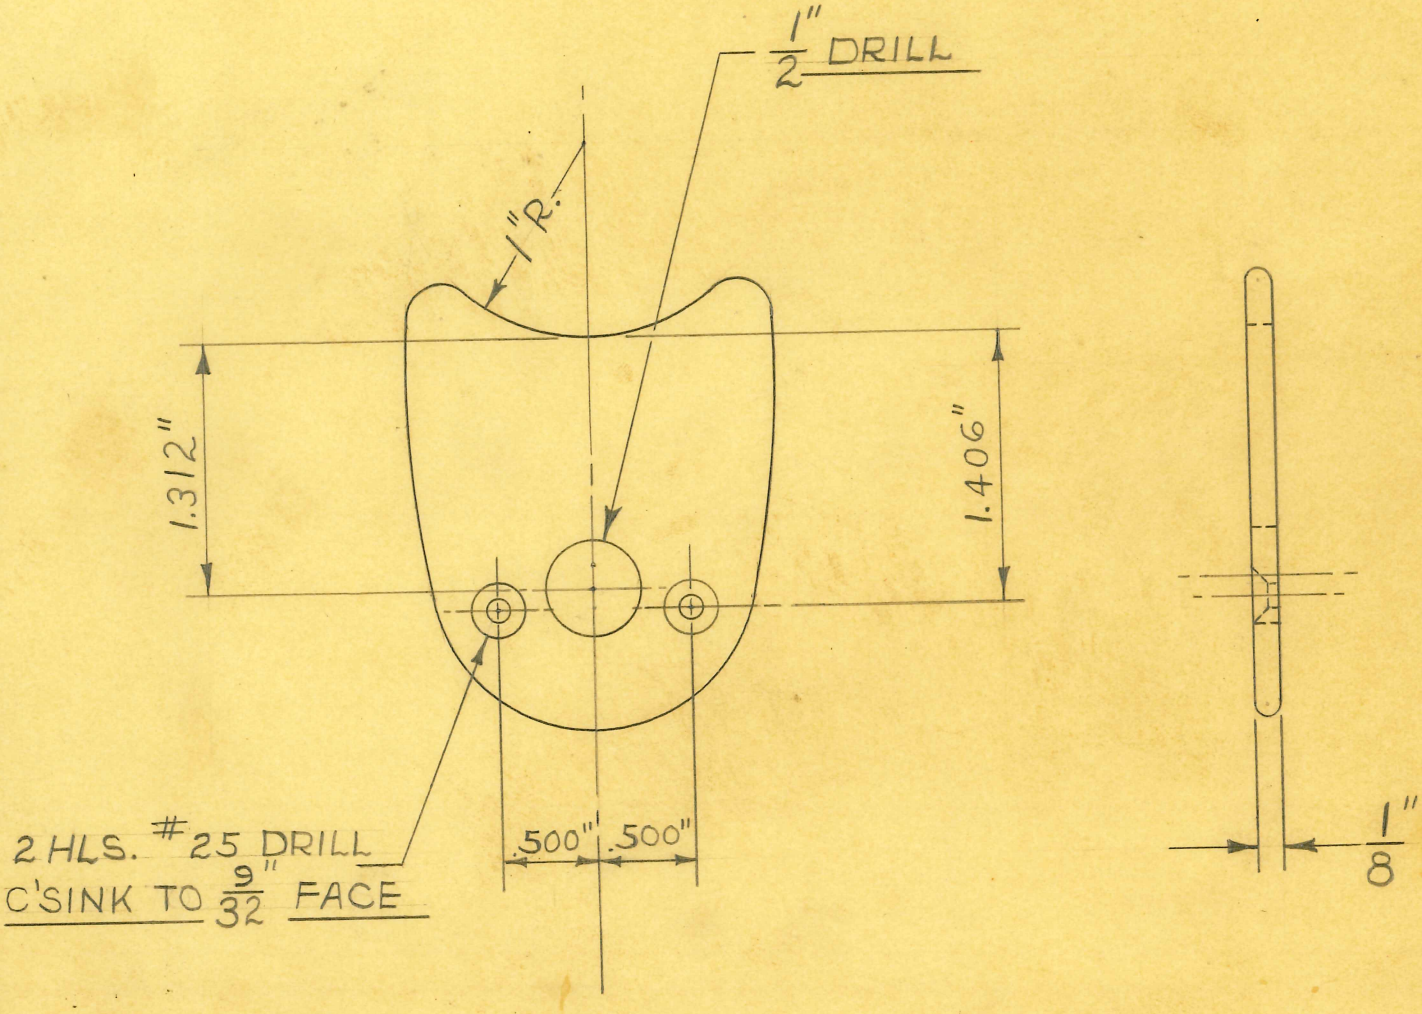

2 REQUIRED

DRILL JIG TOOL # 9393

SIZE		ISSUE 9-19-47	W.J.
KIND	#12 ALUM	CHANGED	
SHAPE	CASTING	"	
FINISH	PAINTED	"	
TEMP.		"	
PATT.	2235	"	

TITLE: FISCHER "PRECISION 200" X-RAY PULLEY SUPP. COVER PLATE

H. G. FISCHER & CO.
2335 WABANSIA AVE.
CHICAGO. ILL.

CAT. NO.

PART NO. 16848FA

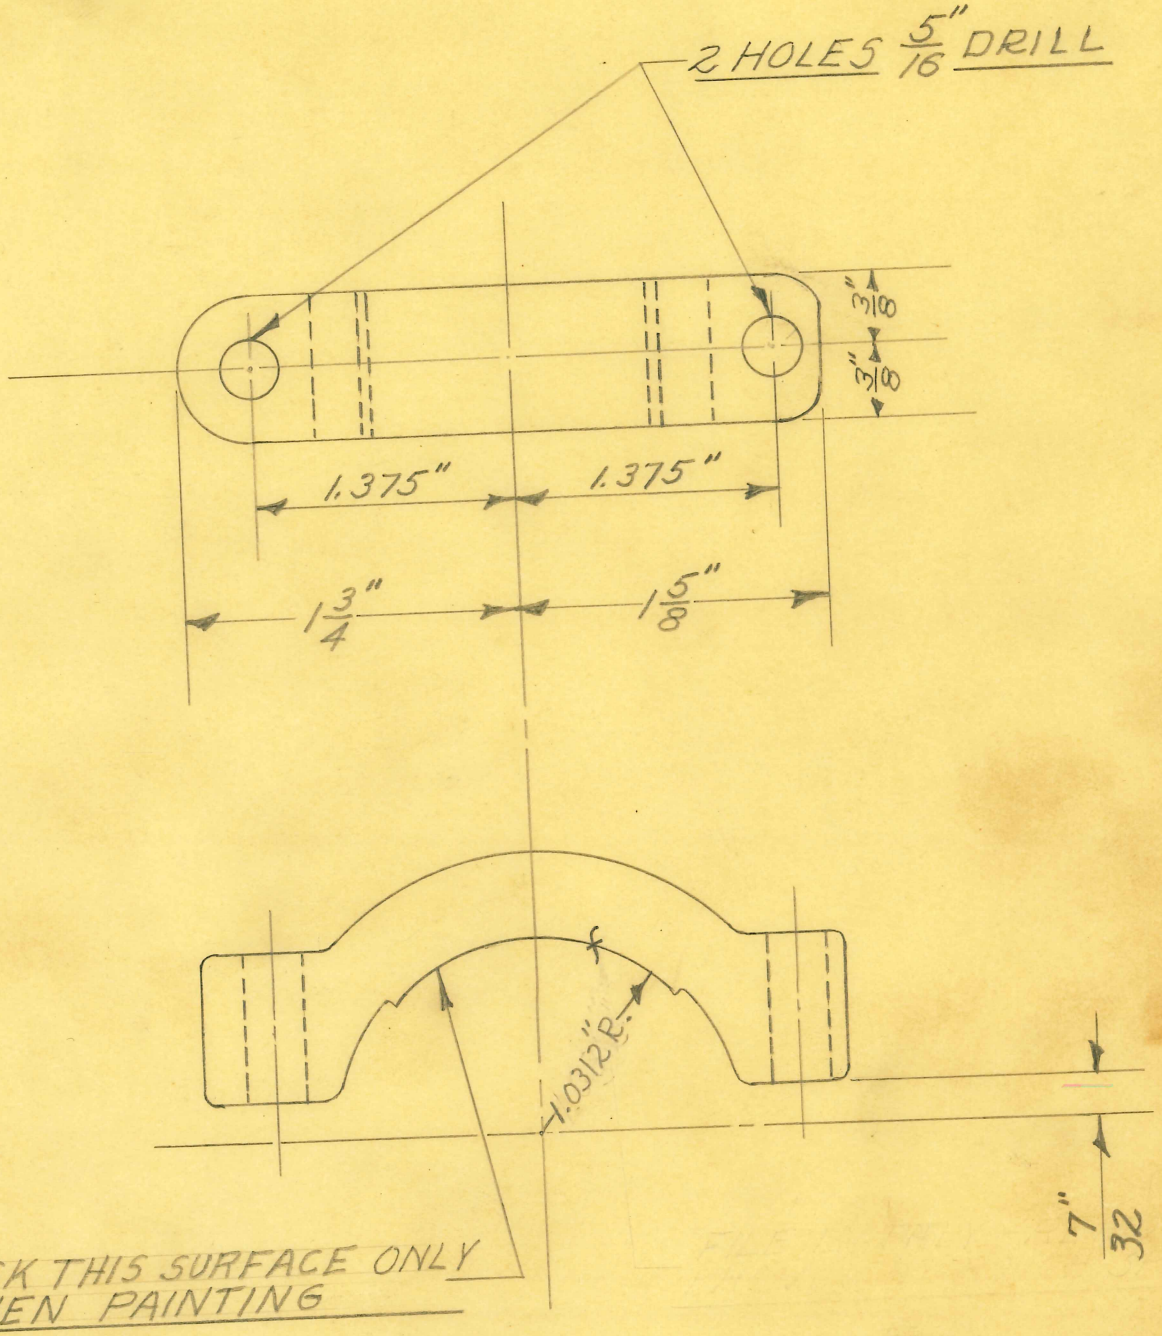

MASK THIS SURFACE ONLY WHEN PAINTING

DIMENSIONS	
FRACTIONAL	± .015
DECIMAL	± .005
ANGULAR	± ½°

UNLESS OTHERWISE SPECIFIED

1 REQUIRED

Drill Jig Tool # 9406

SIZE	CAST IN	ISSUE 7-21-47	J.M.F
KIND	80-10-10	CHANGED	
SHAPE	BRONZE	"	
FINISH	PAINTED	"	
TEMP.		"	
PATT.	2146	"	

TITLE: FISCHER "PRECISION 200" X RAY UNIT VERTICAL SPINE UNIT BUCKY LOCK CLEARANCE

H. G. FISCHER & CO.
2335 WABANSIA AVE.
CHICAGO. ILL.

CAT. NO.

PART NO. 16849

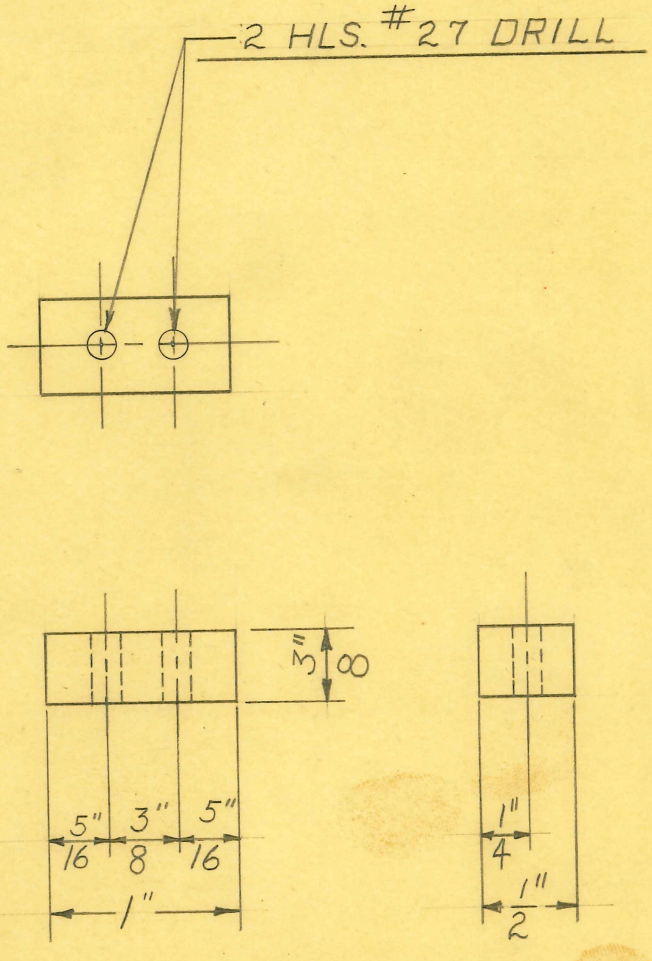

4 REQUIRED

3/8" SHEET NATURAL BAKELITE XX

DRILL JIG TOOL #9359

SIZE		ISSUE 6-12-47	W.J.
KIND		CHANGED	
SHAPE		"	
FINISH		"	
TEMP.		"	
PATT.		"	

TITLE:
FISCHER "PRECISION 200" X-RAY UNIT
VALVE TUBE CLIP MOUNTING BLOCK

H. G. FISCHER & CO.
2335 WABANSIA AVE.
CHICAGO, ILL.

CAT. NO.

PART NO. 16883

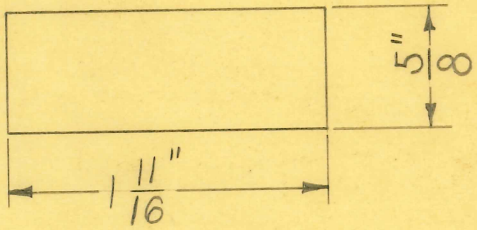

LENGTH OF DEVELOPMENT

4 HLS. #27 DRILL

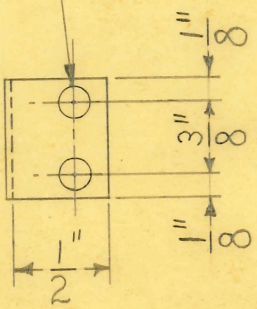

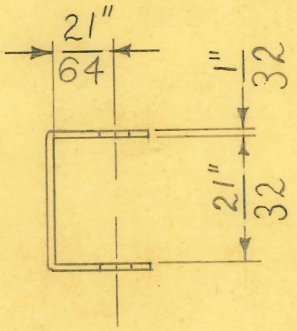

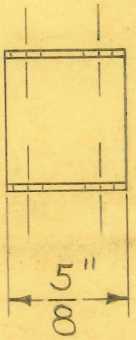

4 REQUIRED

DRILL JIG TOOL #9361
FORMING FIXTURE TOOL #9362

SIZE	1/32" SHEET	ISSUE 8-22-47	W. J.
KIND	BRASS	CHANGED	
SHAPE		"	
FINISH		"	
TEMP.		"	
PATT.		"	

TITLE:
FISCHER "PRECISION 200" X-RAY UNIT
VALVE TUBE CLIP CLAMP

H. G. FISCHER & CO.
2335 WABANSIA AVE.
CHICAGO, ILL.

CAT. NO.

PART NO. 16884

TITLE

36" BUCKY STAND CWT. CHAIN ASSEM.

H. G. FISCHER & CO.
FRANKLIN PARK, ILLINOIS

PART NO. 16892G

DATE 12-14-48 DR. BY W.J. CH'K'D. J.V.W.

REVISION	DATE	BY

PATTERN | FINISH | SCALE FULL

TOOLS | MATERIAL

DIMENSIONS
FRACTIONAL ± .015
DECIMAL ± .005
ANGULAR ± ½°
UNLESS OTHERWISE SPECIFIED

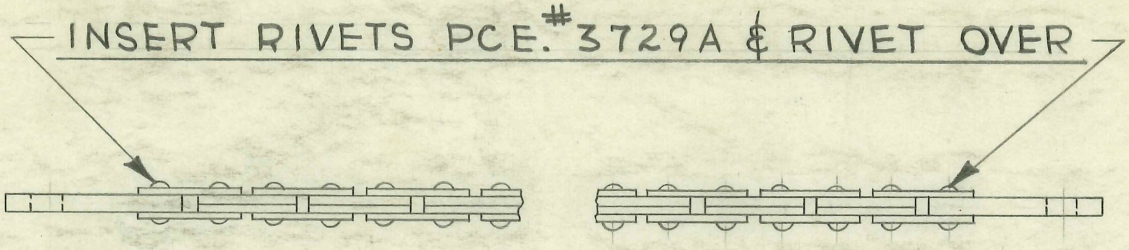

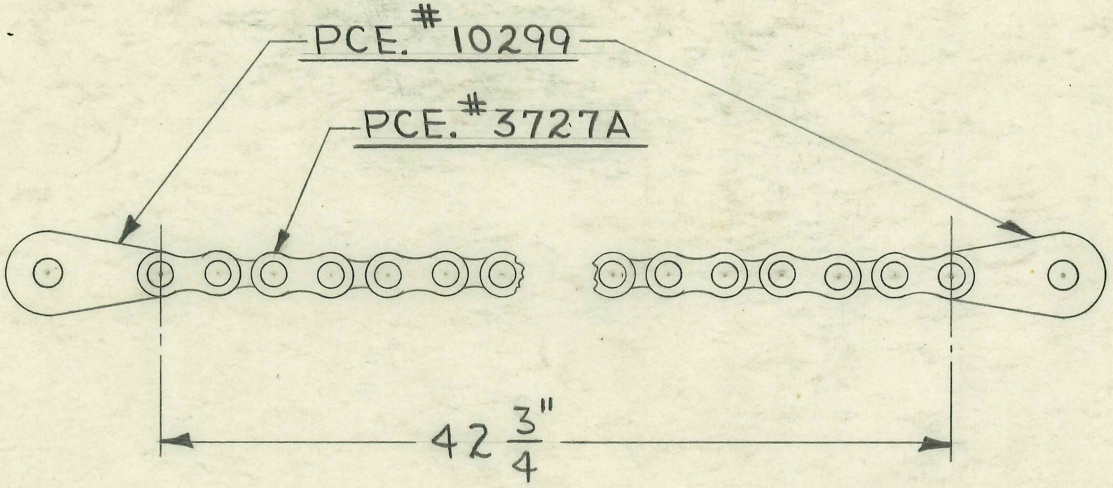

2 REQUIRED

FOLDER #124

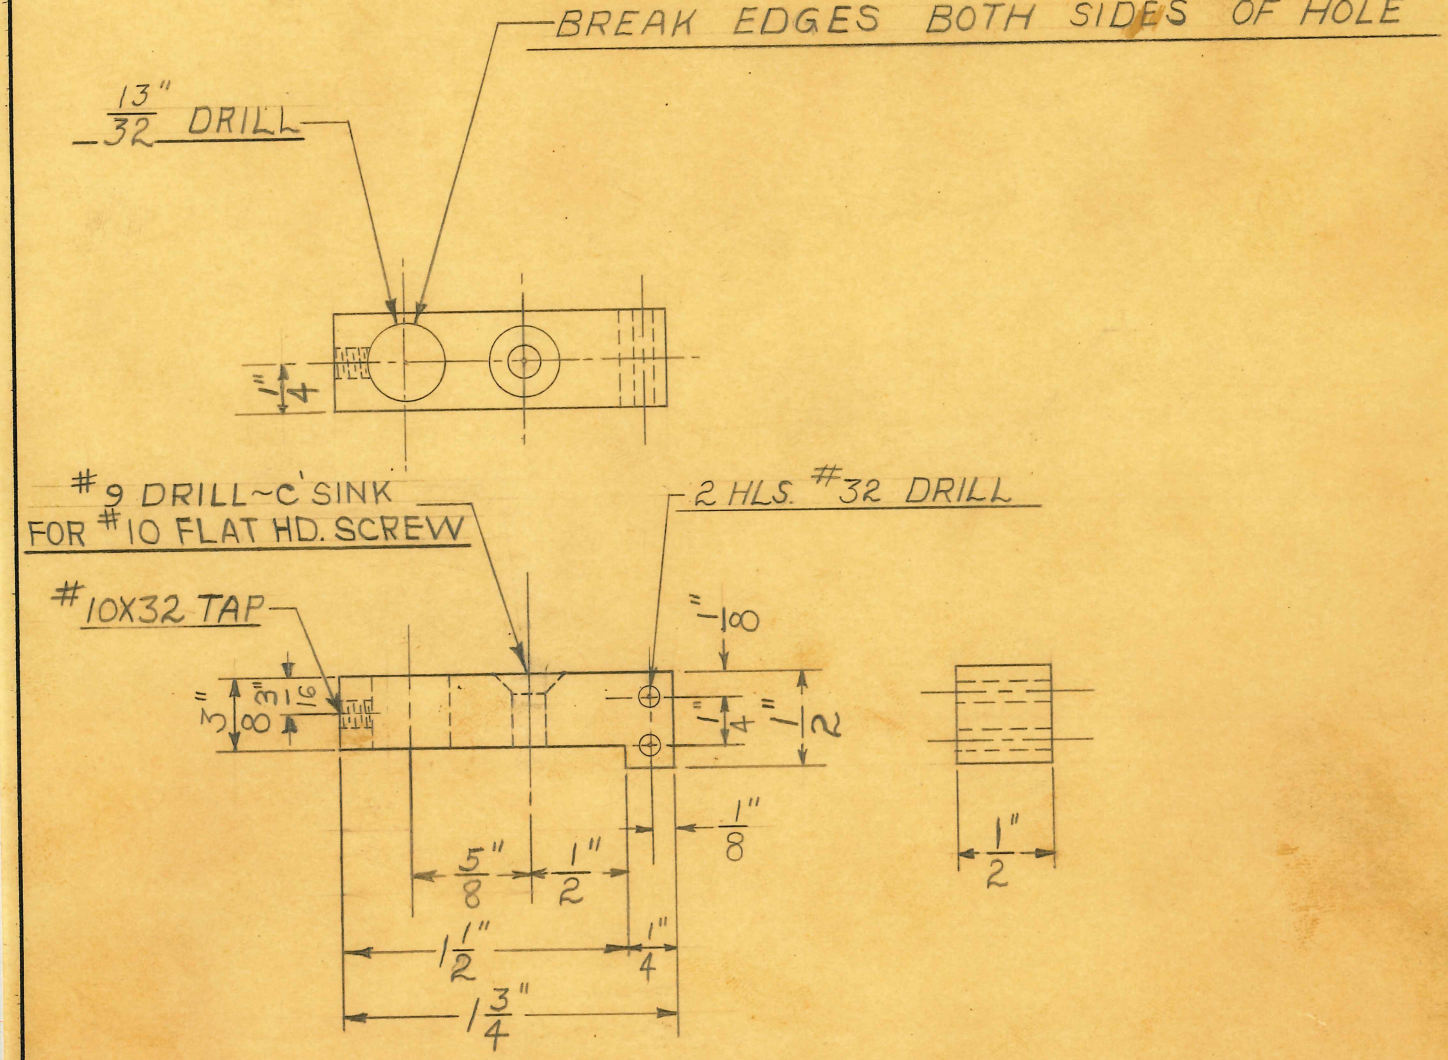

8 REQUIRED

BOX TOOL SECTION
DRILL JIG TOOL #9335
MILLING FIXTURE TOOL #9336

1/2" X 1/2" SQUARE BRASS ROD

SIZE		ISSUE 6-12-47	W.J.
KIND		CHANGED	
SHAPE		"	
FINISH		"	
TEMP.		"	
PATT.		"	

TITLE:
FISCHER "PRECISION 200" X-RAY UNIT
VALVE TUBE SOCKET

H. G. FISCHER & CO.
2335 WABANSIA AVE.
CHICAGO, ILL.

CAT. NO.

PART NO. 16894

TITLE: FISCHER PRECISION "200" X-RAY BUCKY LEVELING SUPP. TUBE CLAMP PLATE	H. G. FISCHER & CO. FRANKLIN PARK, ILLINOIS		PART NO. 16973A
	DATE 9-2-48	DR. BY J.B.G.	CH'K'D.
PATTERN	FINISH CAD. #23	SCALE FULL	DIMENSIONS: FRACTIONAL ± .015; DECIMAL ± .005; ANGULAR ± ½°; UNLESS OTHERWISE SPECIFIED
TOOLS: DRILL JIG TOOL #9855	MATERIAL $\frac{1}{8}$" X $\frac{7}{16}$" FLAT WIRE		

REVISION	DATE	BY

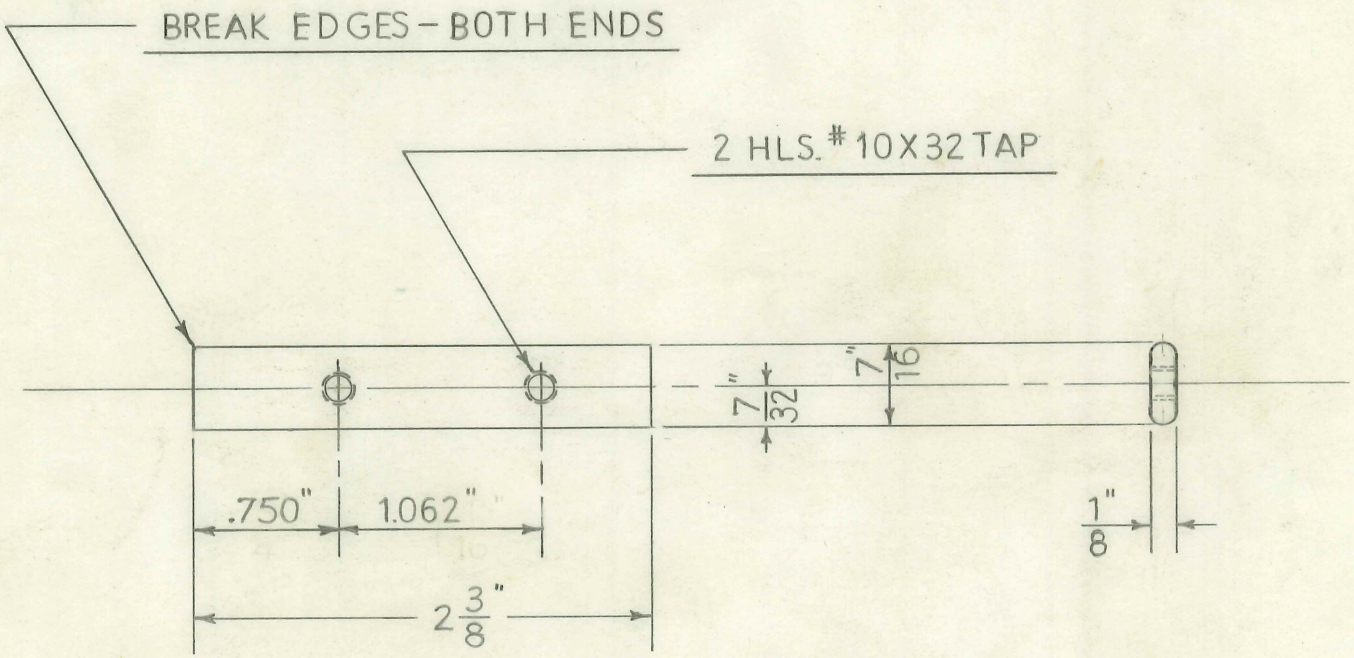

2 - REQUIRED

123 FOLDER #123

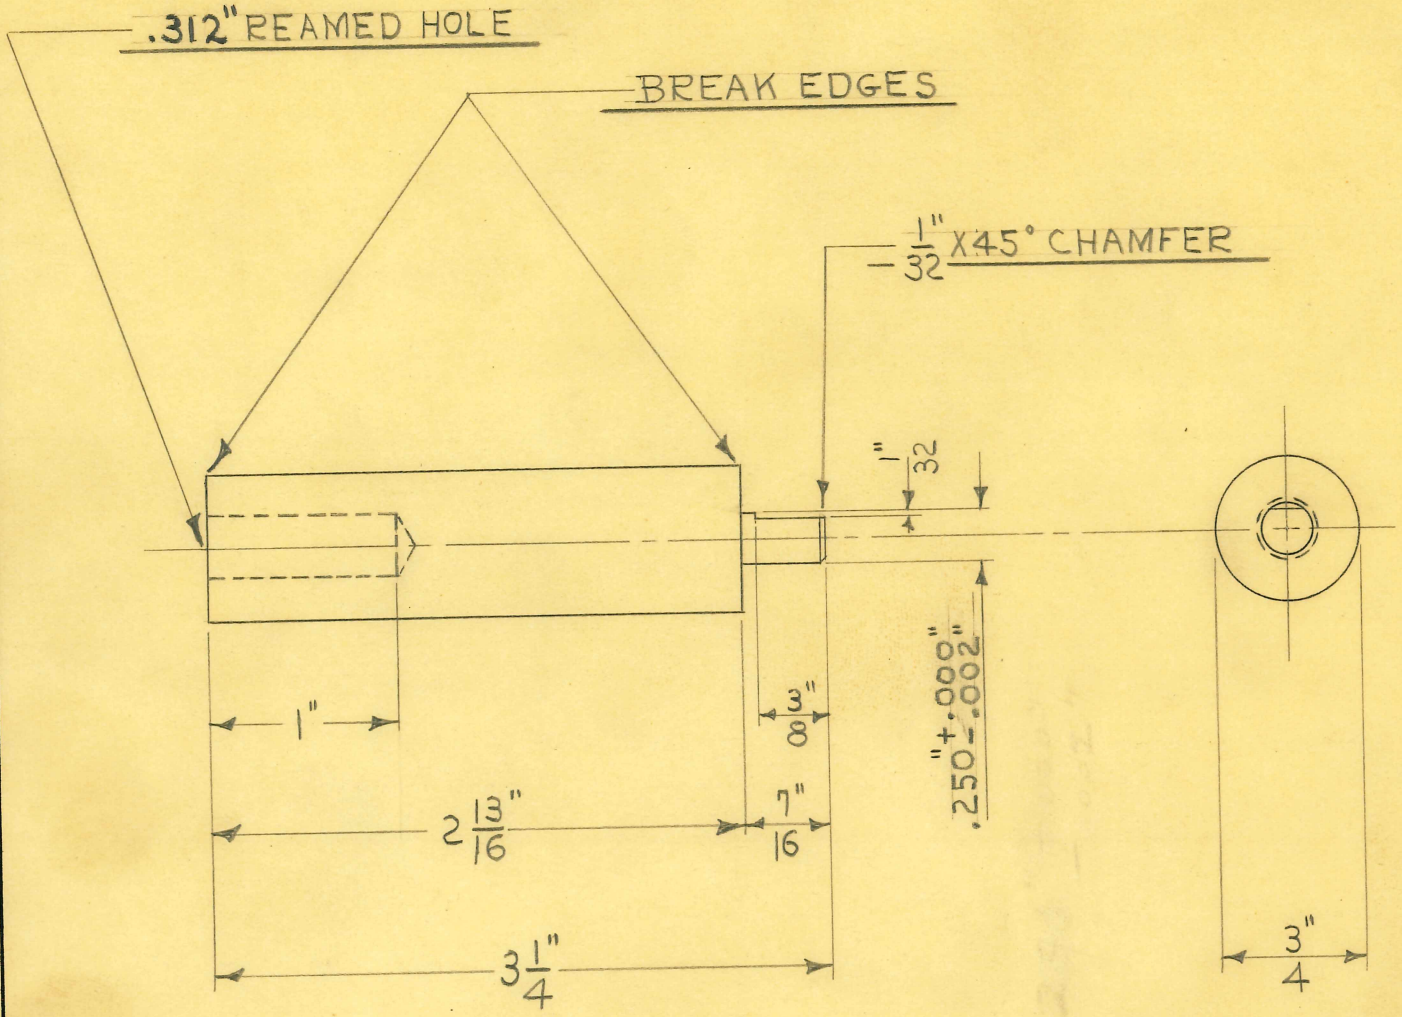

1-REQUIRED

DIMENSIONS	
FRACTIONAL	± .015
DECIMAL	± .005
ANGULAR	± 1/2°

UNLESS OTHERWISE SPECIFIED

SIZE	3/4" DIAM.	ISSUE 1-15-48	J.M.F
KIND	C.R. STEEL	CHANGED	
SHAPE	ROD	"	
FINISH	CAD #23	"	
TEMP.		"	
PATT.		"	

TITLE:
FISCHER PRECISION "200" X-RAY UNIT
BUCKY LEVELING SCREW SHOULDER SHAFT

H. G. FISCHER & CO.
2335 WABANSIA AVE.
CHICAGO, ILL.

CAT. NO.

PART NO. 16974

TITLE: FISCHER PRECISION "200" X-RAY BUCKY LEVELING SCREW	H. G. FISCHER & CO. FRANKLIN PARK, ILLINOIS		PART NO. 16975
	DATE 9-2-48	DR. BY J.B.G.	CH'K'D.
PATTERN	FINISH CAD. #23	SCALE FULL	DIMENSIONS: FRACTIONAL ± .015; DECIMAL ± .005; ANGULAR ± ½°; UNLESS OTHERWISE SPECIFIED
TOOLS	MATERIAL 5/16" DIA. C.R. STEEL ROD		

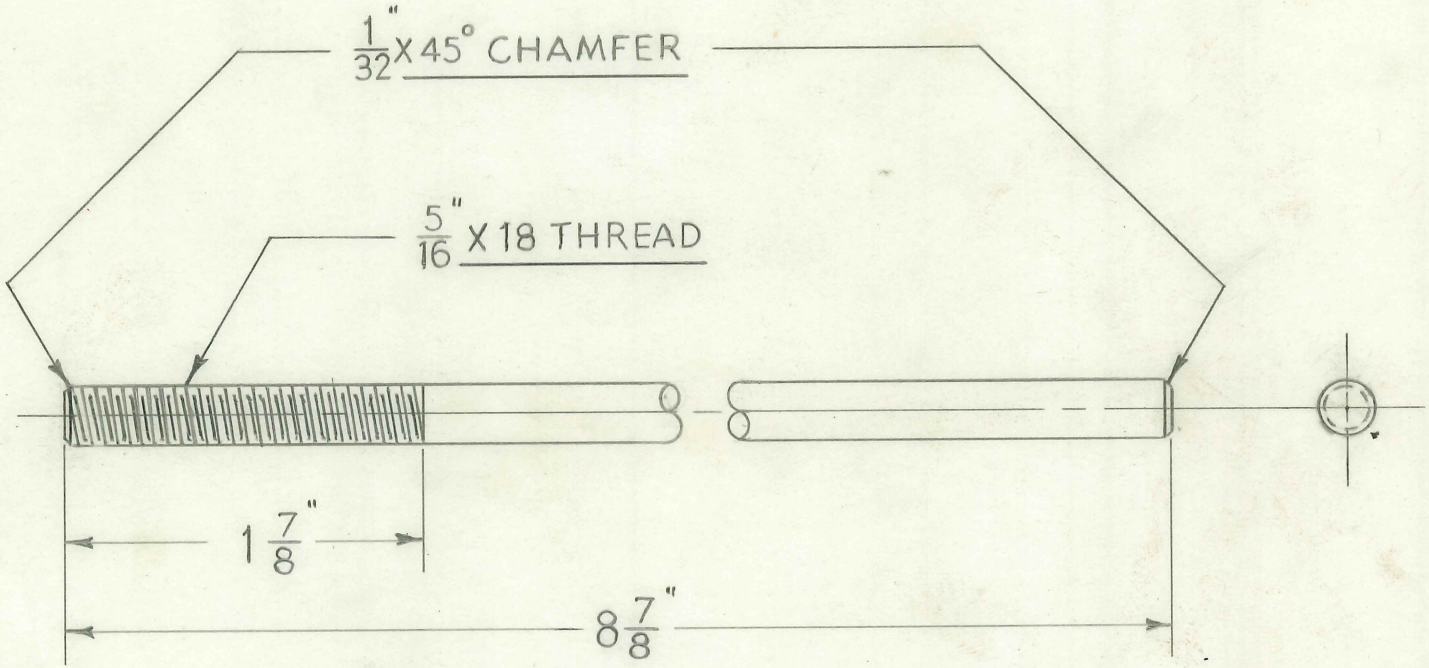

1-REQUIRED

123 FOLDER # 123

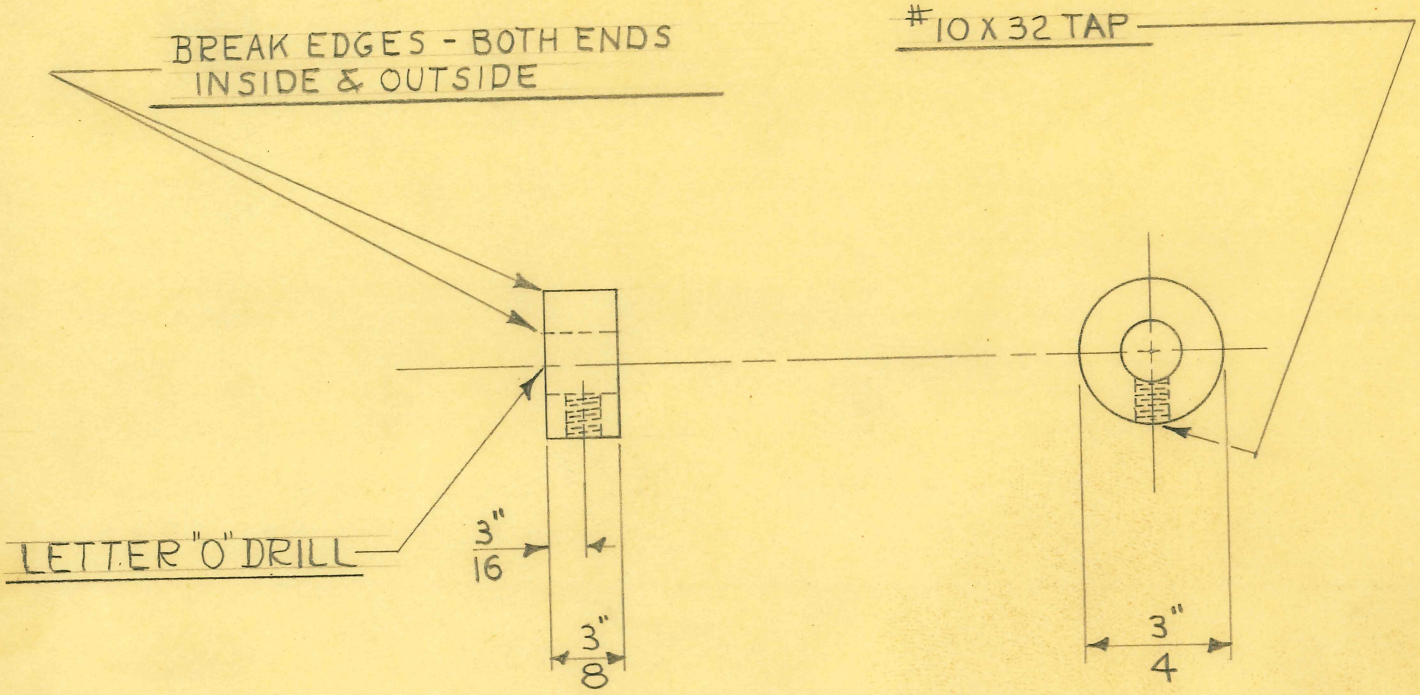

1-REQUIRED

DRILL JIG #10000

DIMENSIONS	
FRACTIONAL	± .015
DECIMAL	± .005
ANGULAR	± 1/2°

UNLESS OTHERWISE SPECIFIED

SIZE	3/4" DIAM.	ISSUE 1-14-48	J.M.F
KIND	C.R. STEEL	CHANGED	
SHAPE	ROD	"	
FINISH	CAD #23	"	
TEMP.		"	
PATT.		"	

TITLE:
FISCHER PRECISION "200" X-RAY UNIT
BUCKY LEVELING SCREW STOP

H. G. FISCHER & CO.
2335 WABANSIA AVE.
CHICAGO, ILL.

CAT. NO.

PART NO. 16976

TITLE
FISCHER PRECISION "200" X-RAY UNIT
BUCKY LEVELING SUPP. BAR PLATE

H. G. FISCHER & CO.
FRANKLIN PARK, ILLINOIS

PART NO. 16979

DATE 9-28-48 | DR. BY W. J. | CH'K'D. J.V.W.

REVISION	DATE	BY

PATTERN | FINISH CAD. # 23 | SCALE FULL

TOOLS: DRILL JIG TOOL # 9903

MATERIAL:

DIMENSIONS UNLESS OTHERWISE SPECIFIED
FRACTIONAL ± .015
DECIMAL ± .005
ANGULAR ± ½°

1/8" X 1 1/8" C.R. STEEL FLAT - PREFERED
SUBSTITUTE - 1/8" X 2" C.R. STEEL FLAT

BREAK ALL CORNERS & EDGES

4 HLS. # 25 DRILL

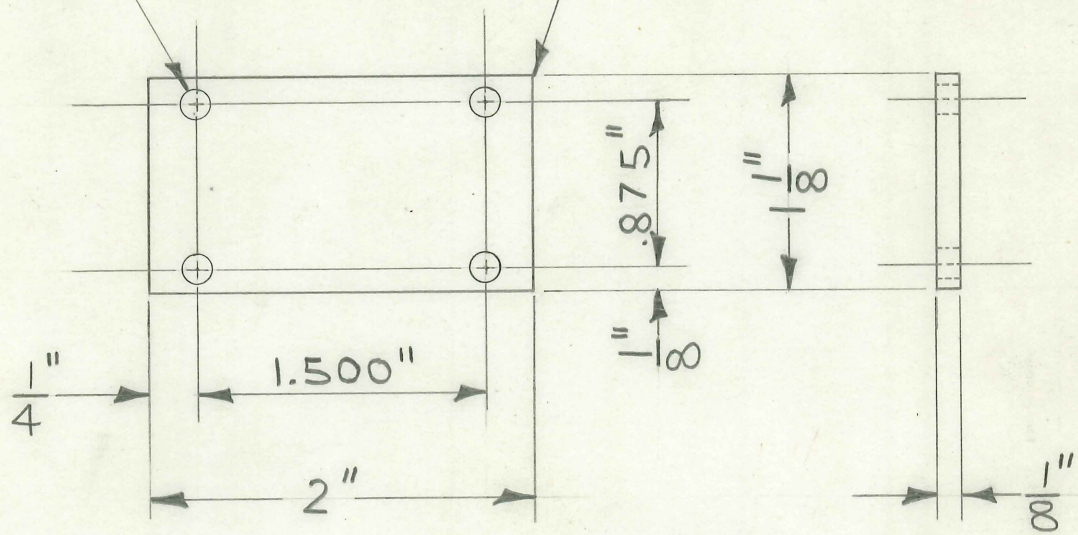

2 REQUIRED

FOLDER #123

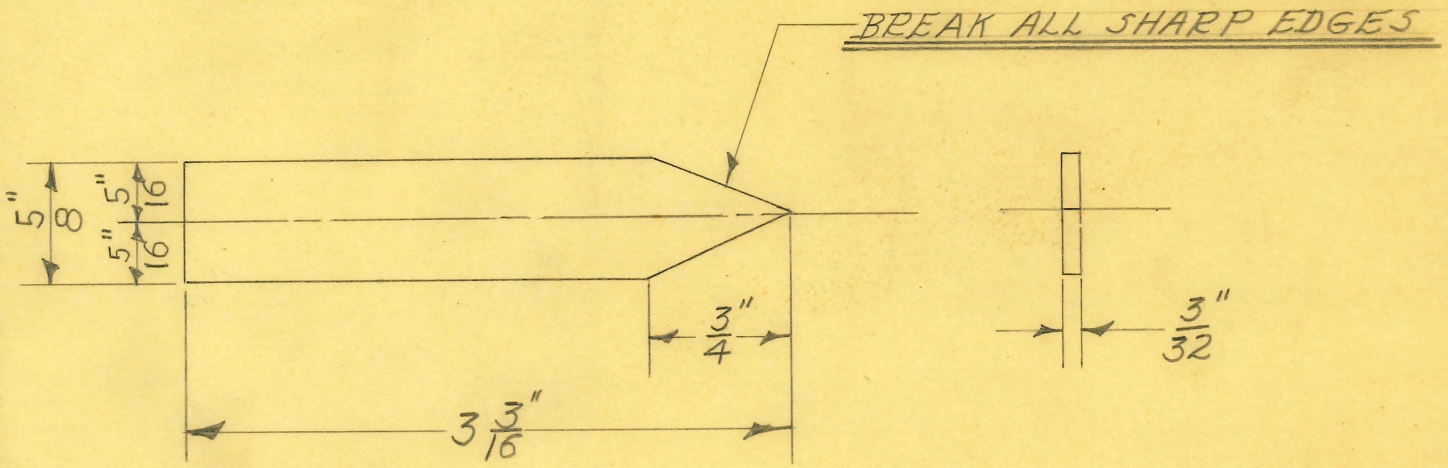

DEVELOPMENT OF PIECE

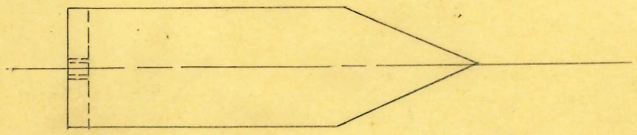

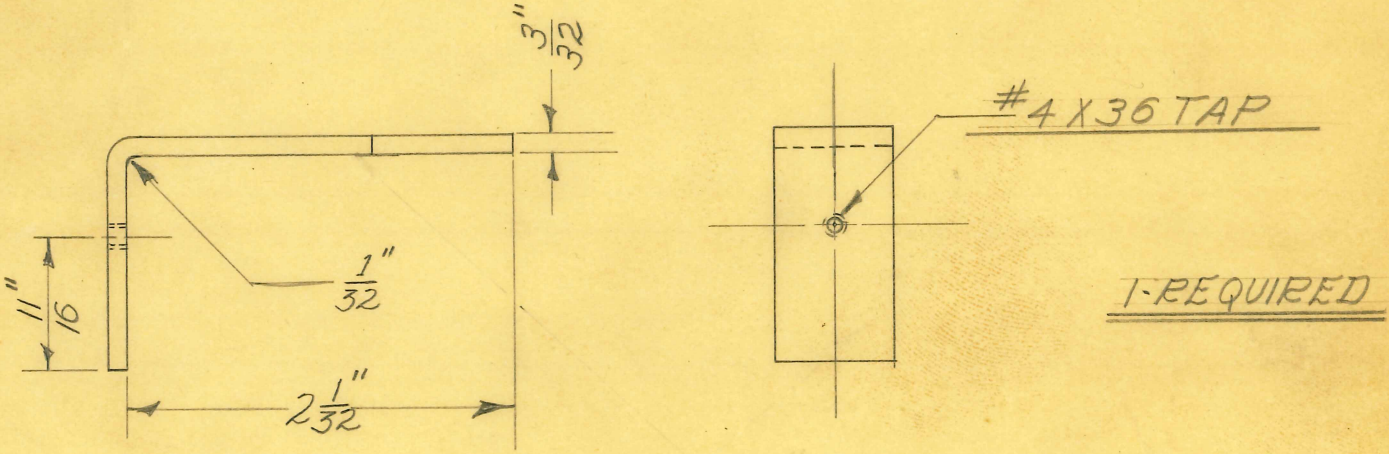

DRILL JIG TOOL #9441

SIZE	3/32" X 5/8"	ISSUE 9-26-47	J.M.F.	TITLE: FISCHER "PRECISION 200" X-RAY BUCKY SCALE POINTER
KIND	C.R. STEEL	CHANGED		
SHAPE	FLAT WIRE	"		
FINISH	CHROME #3	"		
TEMP.		"		
PATT.		"		

H. G. FISCHER & CO.
2335 WABANSIA AVE.
CHICAGO, ILL.

CAT. NO.

PART NO. 16981

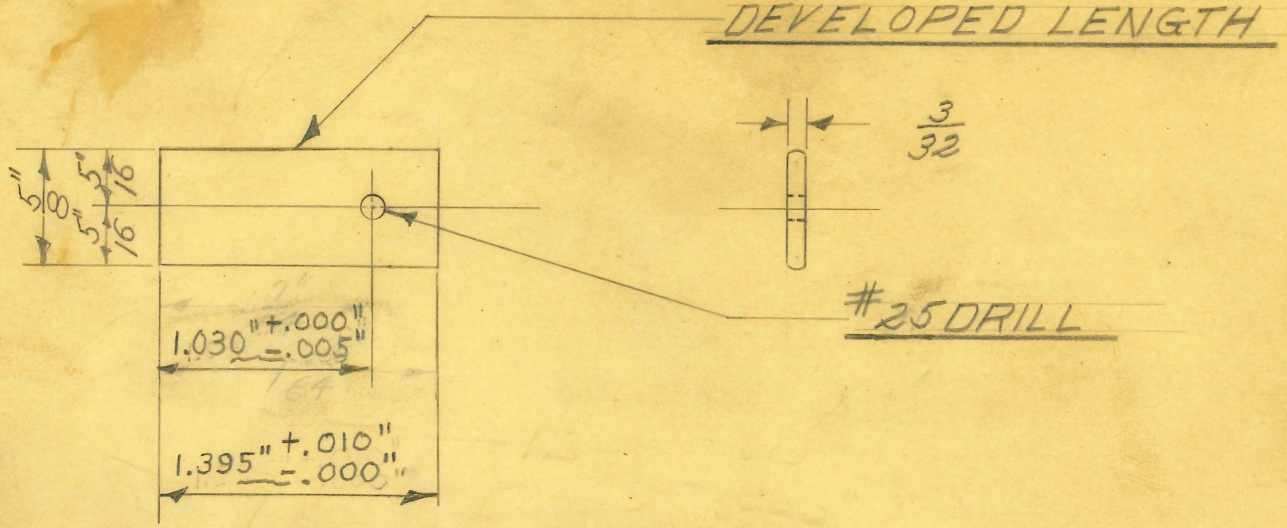

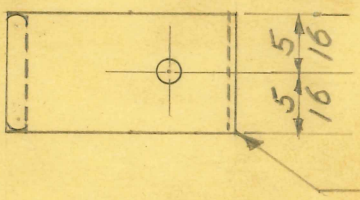

BREAK ALL SHARP EDGES & CORNERS

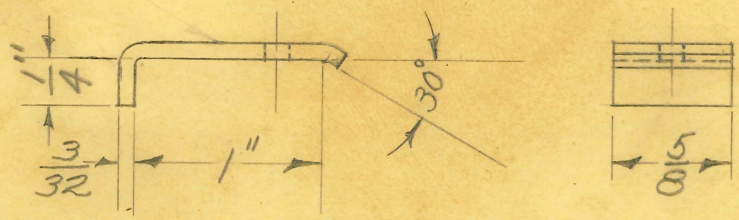

1-REQUIRED

FORM FIXTURE Tool # 9440
DRILL JIG Tool # 9439

SIZE	3/32" X 5/8"	ISSUE 9-5-47	J.M.F
KIND	FLAT WIRE	CHANGED	
SHAPE		"	
FINISH	CHROME #3	"	
TEMP.		"	
PATT.		"	

TITLE:
FISCHER" PRECISION 200 X-RAY BUCKY SCALE POINTER CLAMP

H. G. FISCHER & CO.
2335 WABANSIA AVE.
CHICAGO, ILL.

CAT. NO.

PART NO. 16982

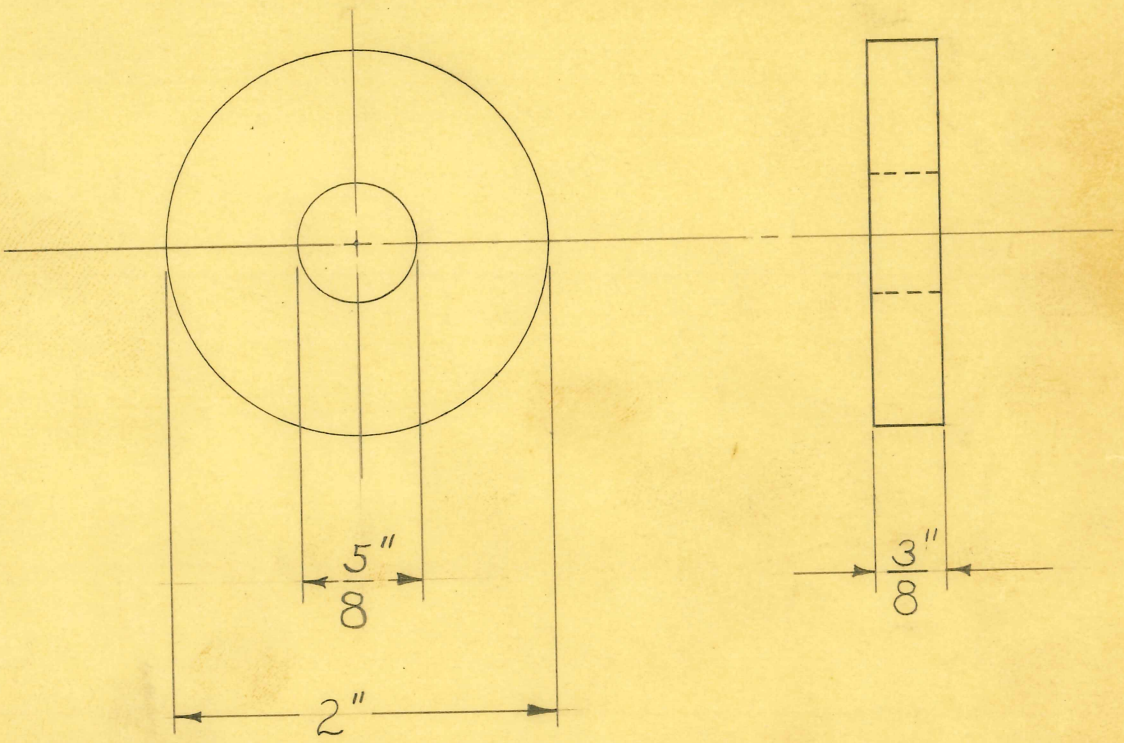

2 REQUIRED

SIZE	3/8" SHEET	ISSUE 9-4-47	W.J.
KIND	FELT	CHANGED	
SHAPE		"	
FINISH		"	
TEMP.		"	
PATT.		"	

TITLE: FISCHER "PRECISION 200" X-RAY UNIT
BUCKY STAND CWT. BUMPER

H. G. FISCHER & CO.
2335 WABANSIA AVE.
CHICAGO, ILL.

CAT. NO.

PART NO. 16983

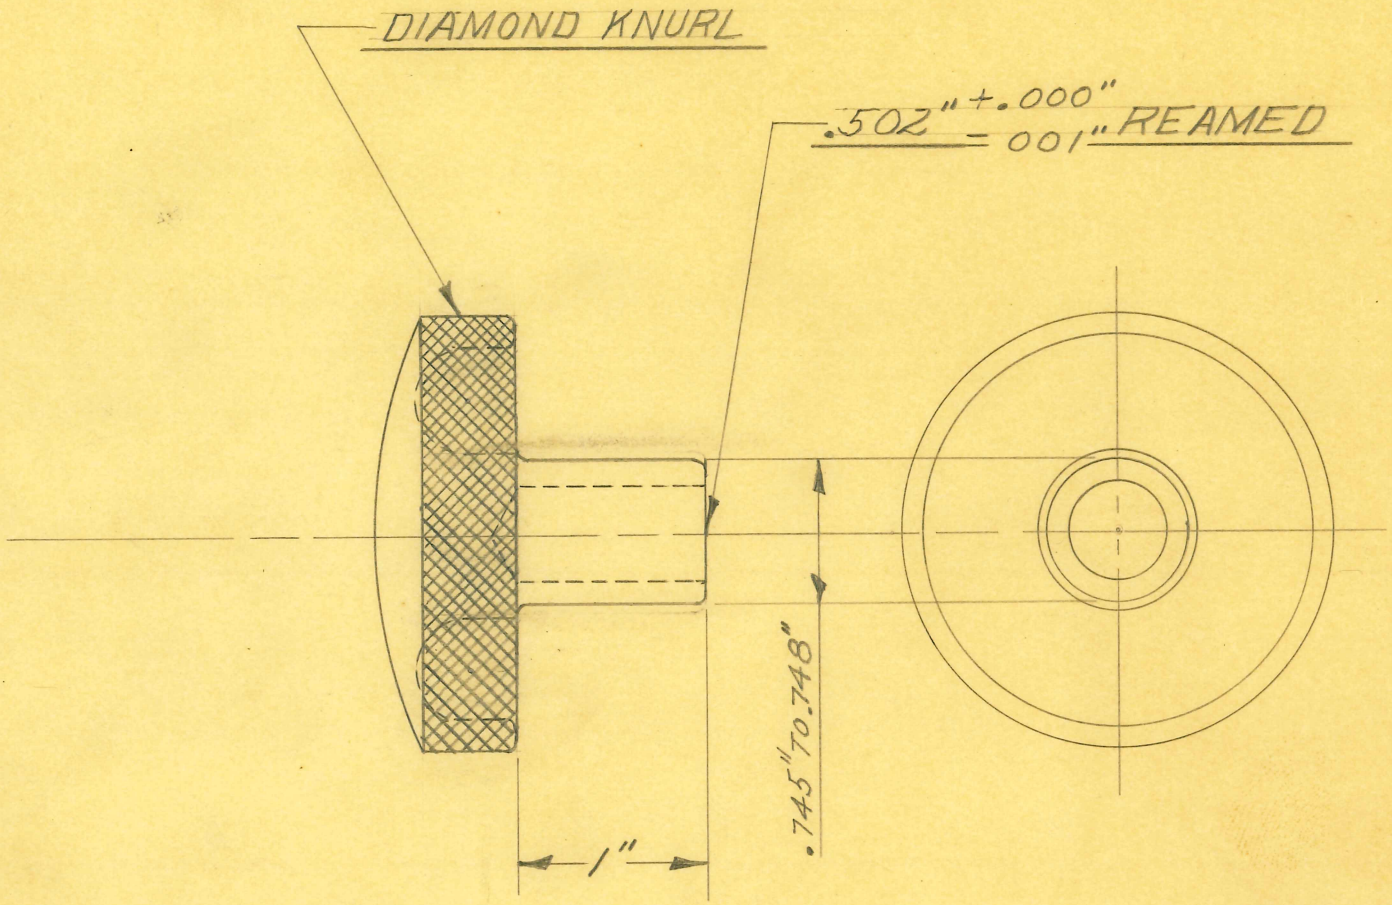

DIMENSIONS	
FRACTIONAL	± .015
DECIMAL	± .005
ANGULAR	± ½°

UNLESS OTHERWISE SPECIFIED

1 REQUIRED

SIZE	MADE	ISSUE 7-23-47	J.M.F
KIND	FROM	CHANGED	
SHAPE	13381	"	
FINISH		"	
TEMP.		"	
PATT.		"	

TITLE: FISCHER "PRECISION 200 X RAY UNIT VERTICAL BUCKY STAND ADJUSTMENT ROD KNOB

H. G. FISCHER & CO.
2335 WABANSIA AVE.
CHICAGO, ILL.

CAT. NO.

PART NO. 16985

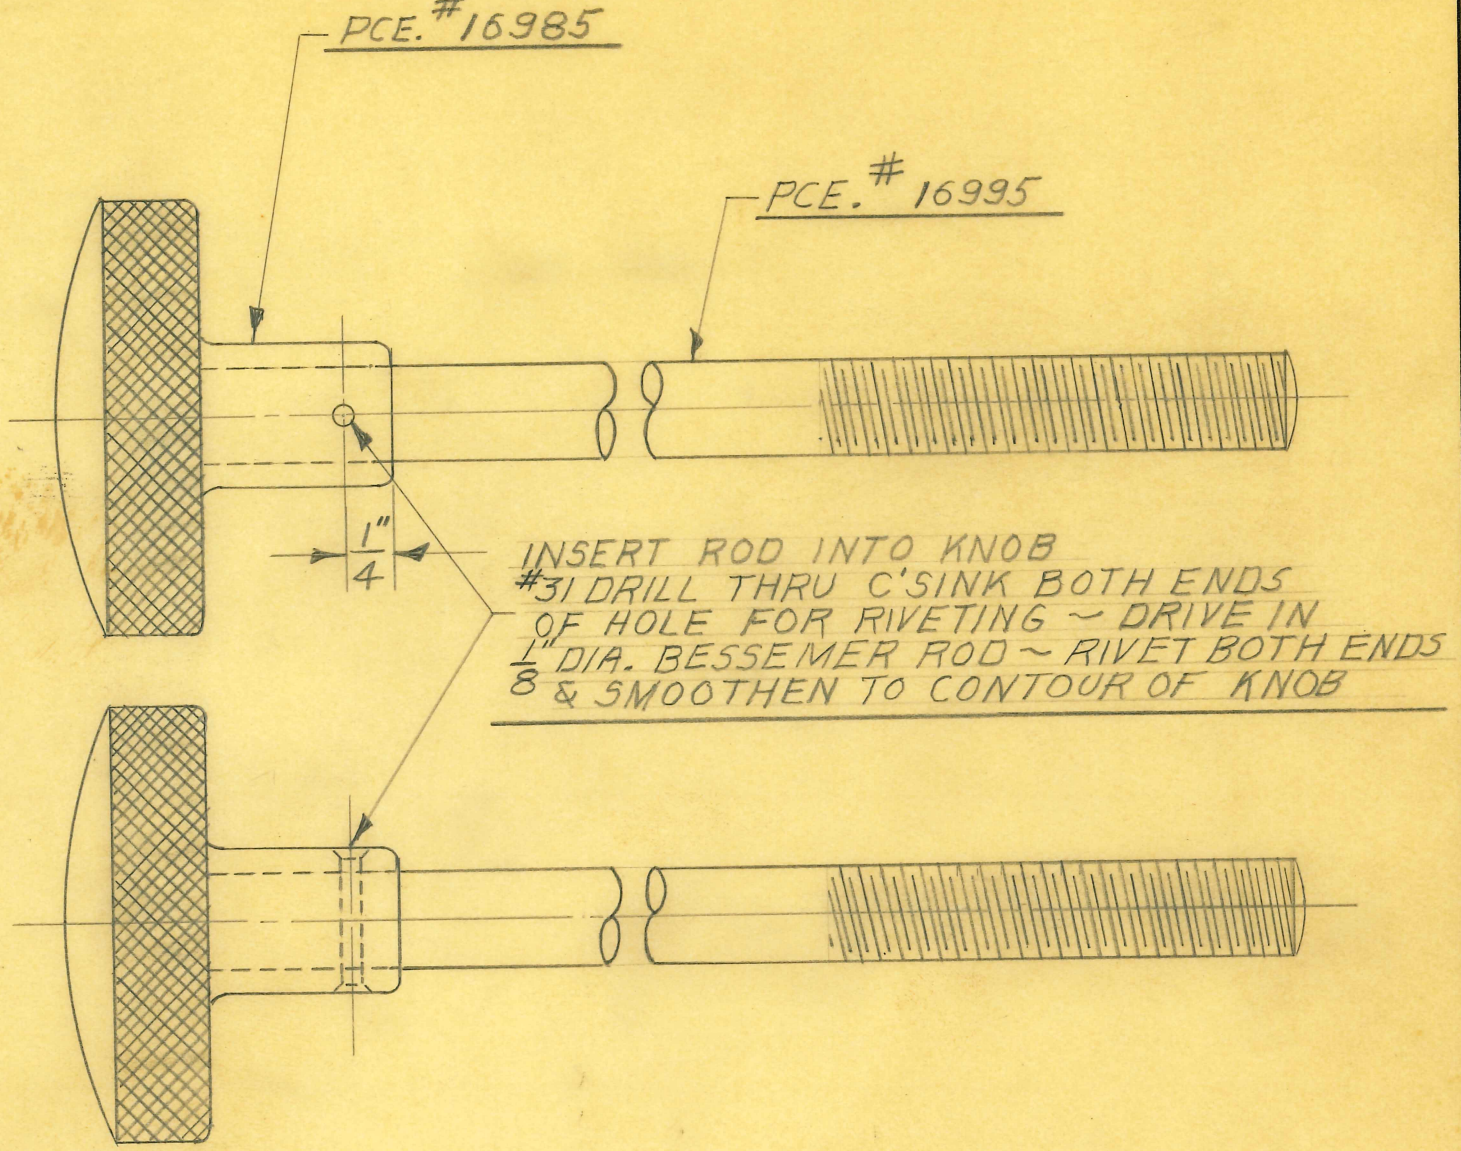

1 REQUIRED

Drill Jig Tool #9430

SIZE		ISSUE 7-22-47	J.M.F
KIND		CHANGED	
SHAPE		"	
FINISH		"	
TEMP.		"	
PATT.		"	

TITLE: FISCHER "PRECISION 200" X RAY UNIT VERTICAL BUCKY STAND ADJUSTMENT SCREW & KNOB ASSEMBLY

H. G. FISCHER & CO.
2335 WABANSIA AVE.
CHICAGO, ILL.

CAT. NO.

PART NO. 16987 G

TITLE
FISCHER "PREC. 200" X-RAY UNIT
VERTICAL SPINE UNIT BUCKY LOCK ASSEMBLY

H. G. FISCHER & CO.
FRANKLIN PARK, ILLINOIS

PART NO. 16988GA

DATE 8-31-50 DR. BY W. J. CH'K'D.

REVISION	DATE	BY

PATTERN | FINISH | SCALE FULL

TOOLS: DRILL JIG # 9429

MATERIAL: PCE. # 16993 PCE. # 16999 PCE. # 16734

DIMENSIONS
FRACTIONAL ± .015
DECIMAL ± .005
ANGULAR ± ½°
UNLESS OTHERWISE SPECIFIED

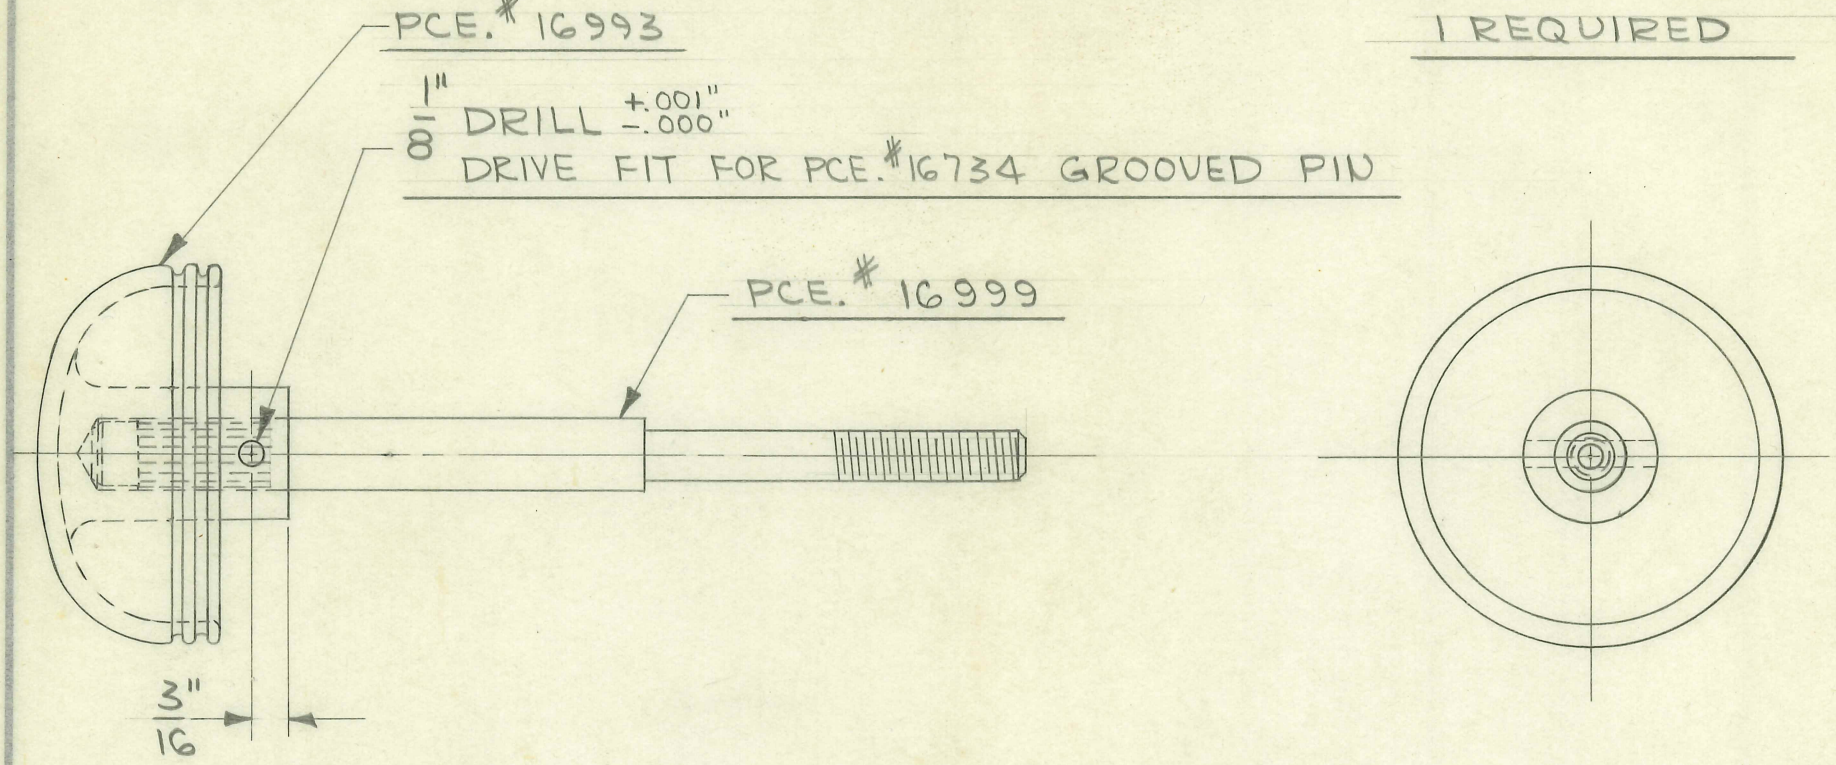

1 REQUIRED

FOLDER #126

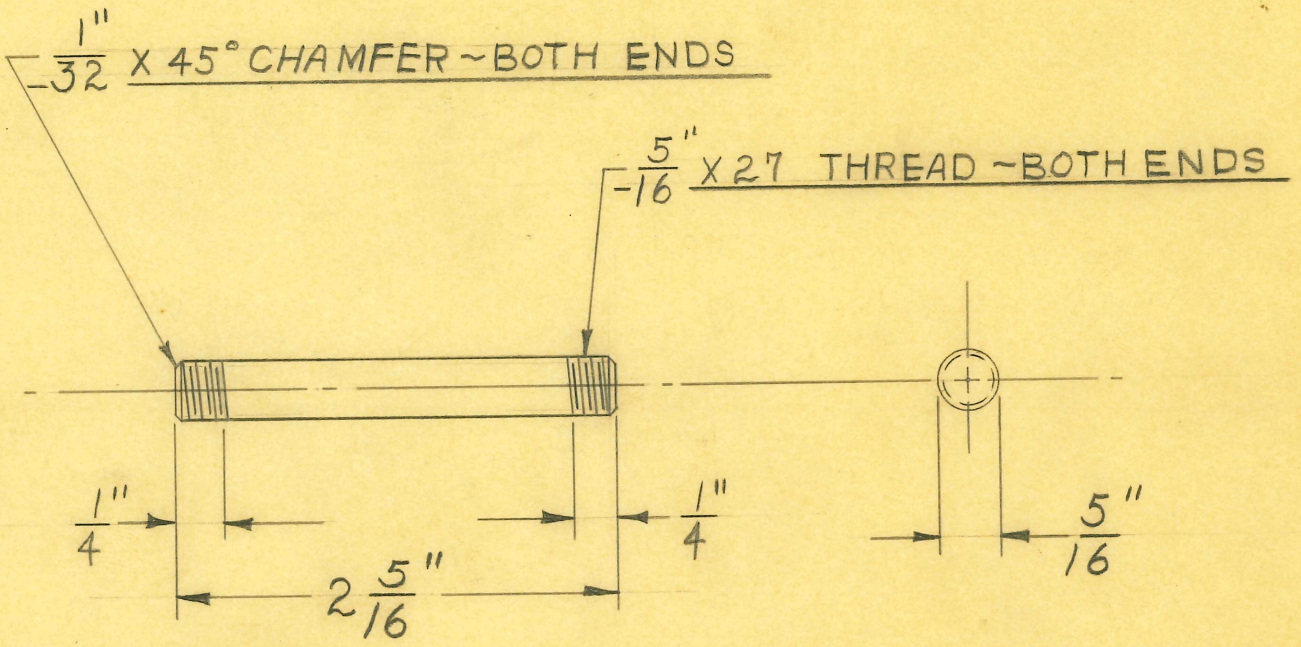

2 REQUIRED

DIMENSIONS	
FRACTIONAL	± .015
DECIMAL	± .003
ANGULAR	± ½°

UNLESS OTHERWISE SPECIFIED

SIZE	5/16" DIA.	ISSUE 7-23-47	W.J.
KIND	C.R. STEEL	CHANGED	
SHAPE	ROD	"	
FINISH	CAD. #23	"	
TEMP.		"	
PATT.		"	

TITLE:
FISCHER "PRECISION 200" X-RAY UNIT
BUCKY STAND COUNTERWEIGHT PULLEY SHAFT

H. G. FISCHER & CO.
2335 WABANSIA AVE.
CHICAGO, ILL.

CAT. NO.

PART NO. 16991

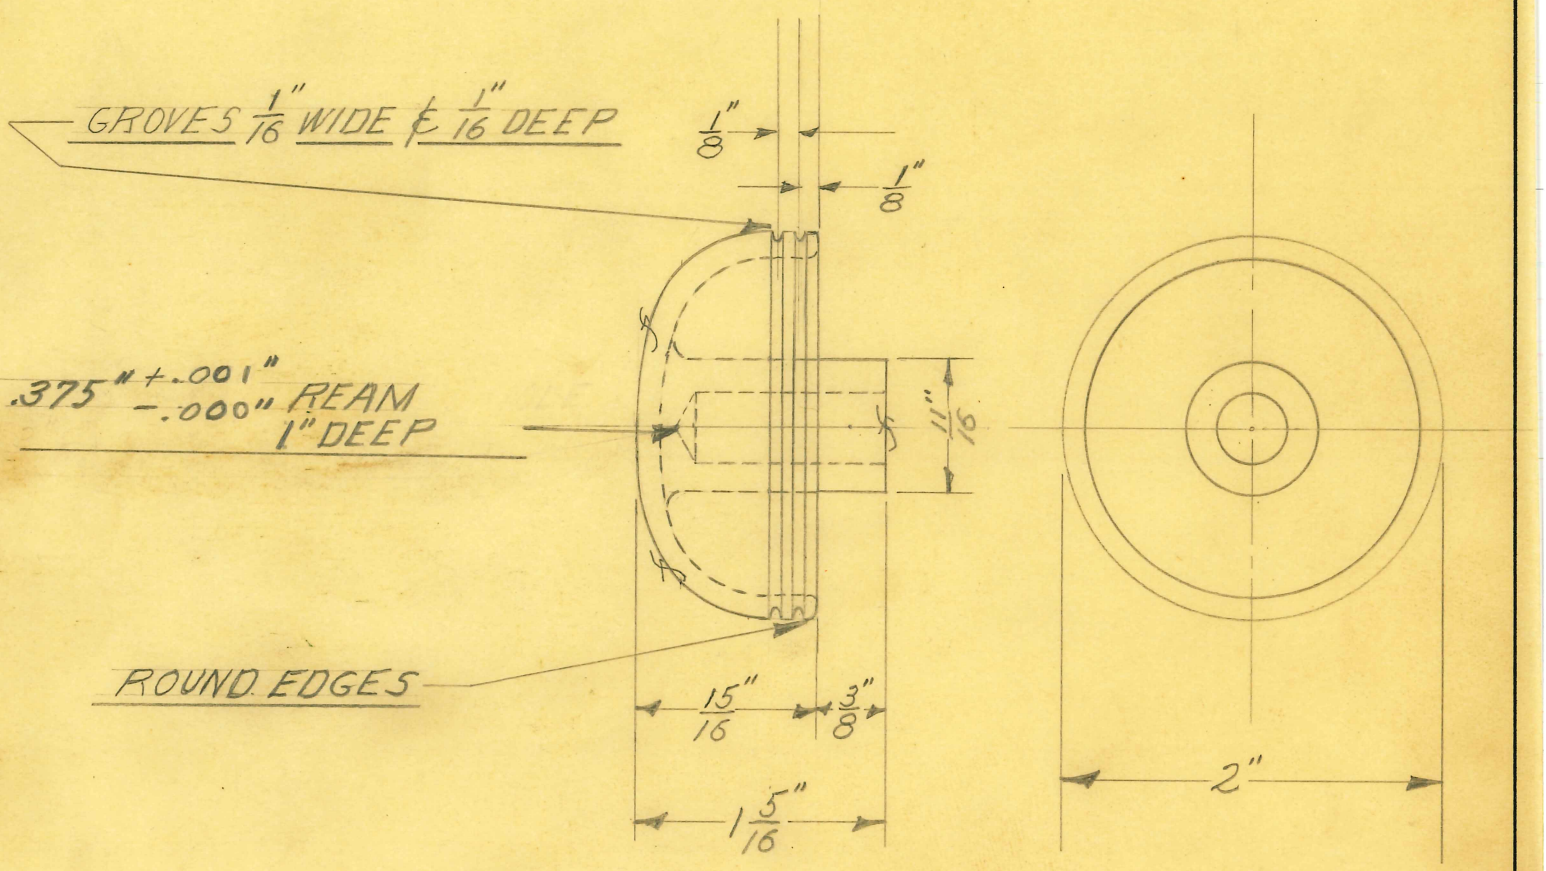

1 REQUIRED

DIMENSIONS	
FRACTIONAL	± .015
DECIMAL	± .005
ANGULAR	± ½°
UNLESS OTHERWISE SPECIFIED	

SIZE	MADE	ISSUE 7-22-47	J.M.F.
KIND	FROM	CHANGED	
SHAPE	8399	"	
FINISH	POLISH	"	
TEMP.		"	
PATT.		"	

TITLE:
FISCHER "PRECISION 200" X RAY UNIT
VERTICAL SPINE UNIT BUCKY
LOCK KNOB

H. G. FISCHER & CO.
2335 WABANSIA AVE.
CHICAGO, ILL.

CAT. NO.

PART NO. 16993

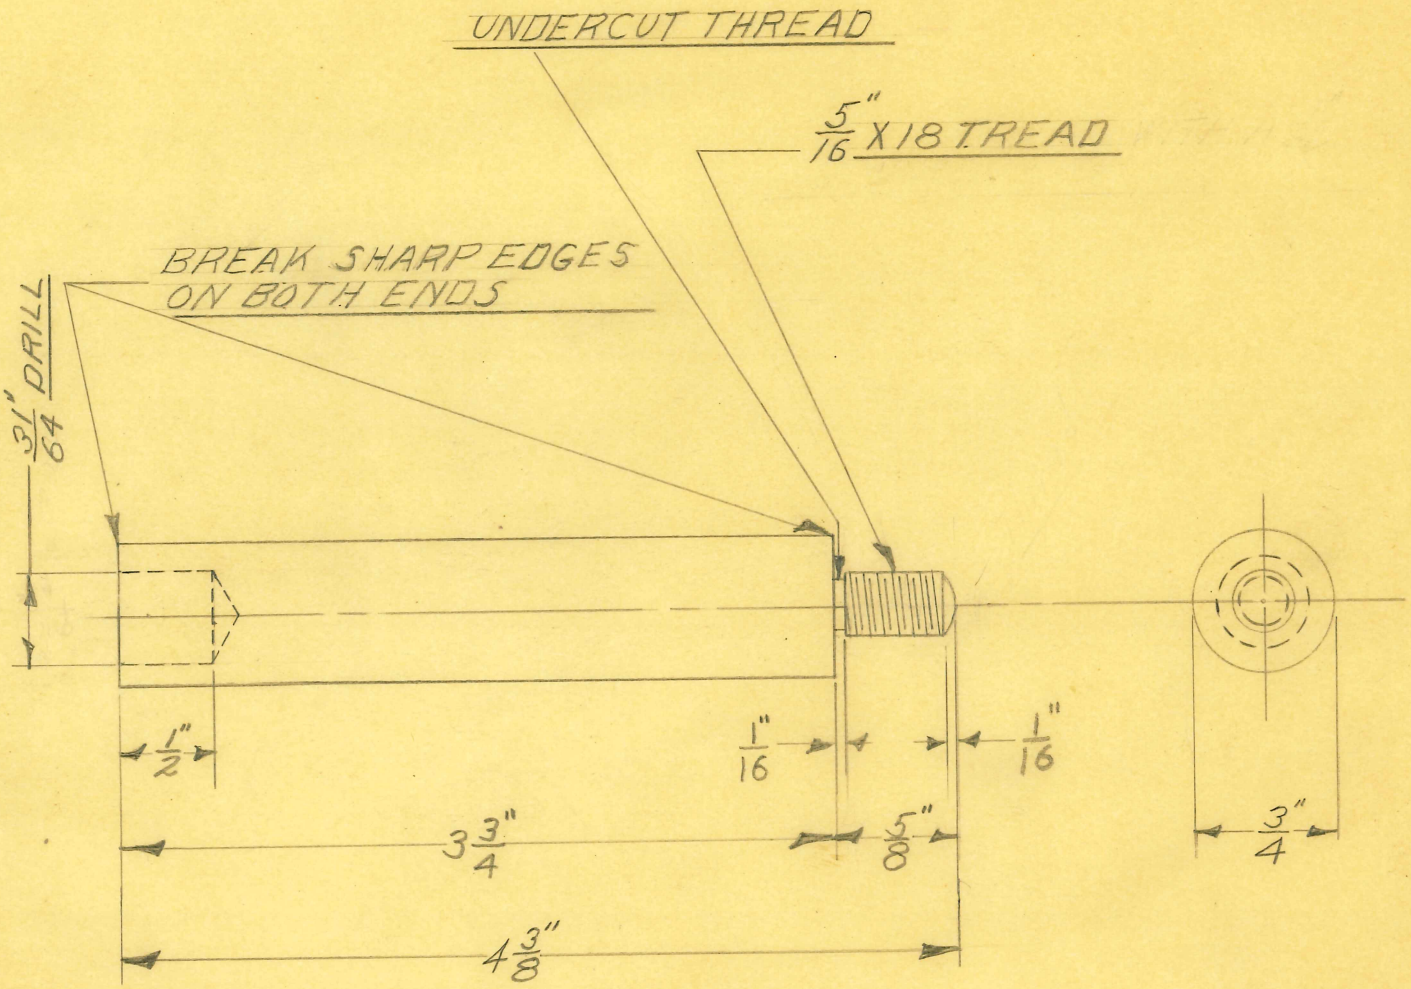

1 REQUIRED

SIZE	3/4" DIA.	ISSUE 7-22-47	J.M.F
KIND	C.R. STEEL	CHANGED	
SHAPE		"	
FINISH	CAD. #23	"	
TEMP.		"	
PATT.		"	

TITLE:
FISCHER "PRECISION 200" X RAY UNIT
BUCKY BUMPER SPACER

H. G. FISCHER & CO.
2335 WABANSIA AVE.
CHICAGO. ILL.

CAT. NO.

PART NO. 16994

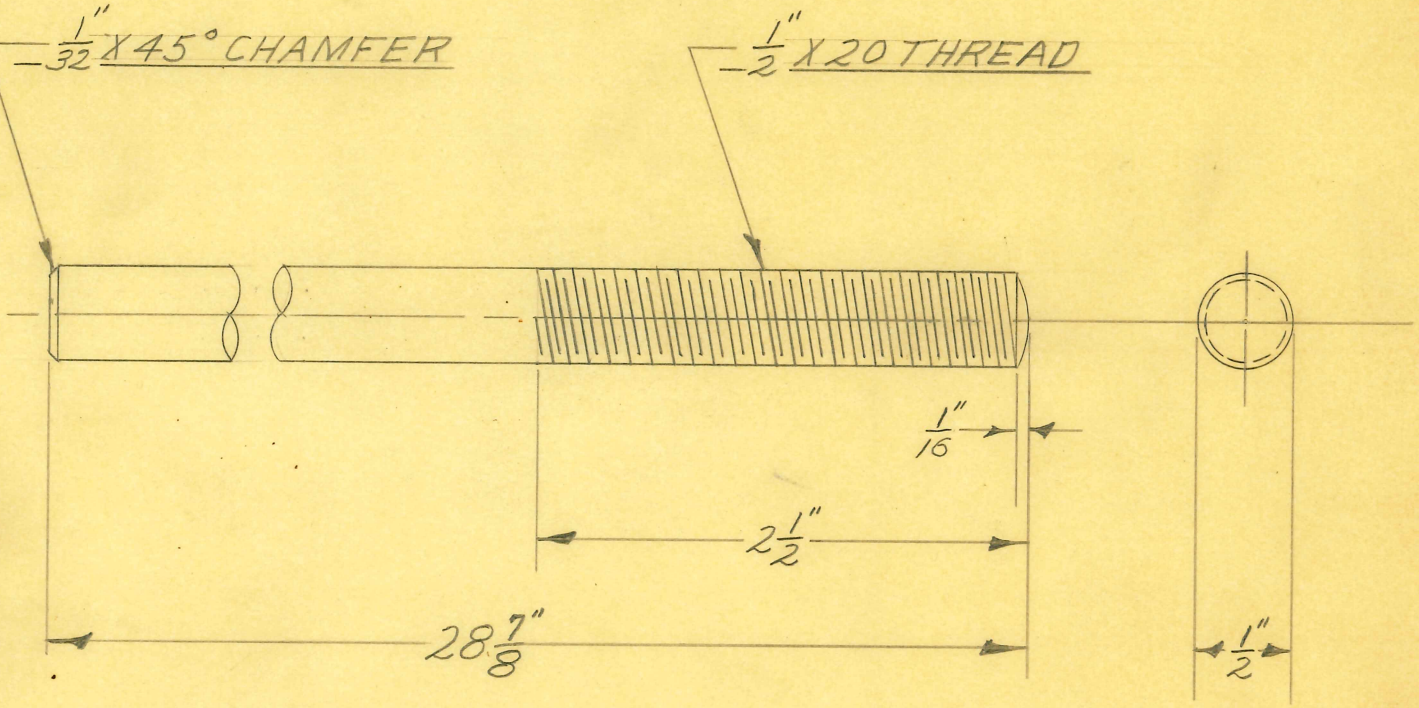

1 REQUIRED

SIZE	1/2" DIA.	ISSUE 7-23-47	J.M.F
KIND	C.R. STEEL	CHANGED	
SHAPE		"	
FINISH	CAD #23	"	
TEMP.		"	
PATT.		"	

TITLE:
FISCHER "PRECISION 200" X RAY UNIT
VERTICAL BUCKY STAND ADJUSTMENT
SCREW

H. G. FISCHER & CO.
2335 WABANSIA AVE.
CHICAGO, ILL.

CAT. NO.

PART NO. 16995

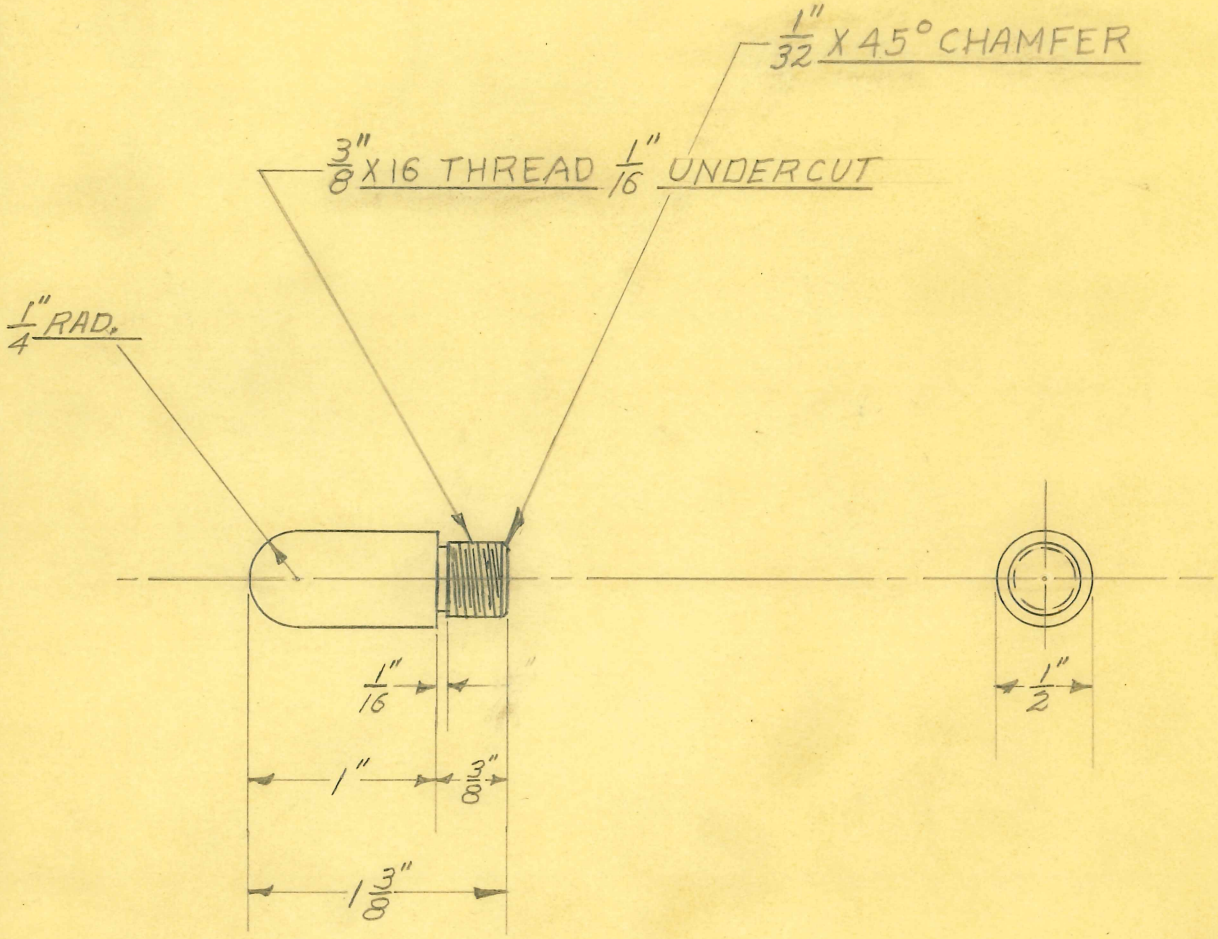

1 REQUIRED

SIZE	1½ ROUND	ISSUE 7-18-47	J.M.F
KIND	C.R.STEEL	CHANGED	
SHAPE	ROD	"	
FINISH	CAD.#23	"	
TEMP.		"	
PATT.		"	

TITLE:
FISCHER "PRECISION 200" X RAY UNIT
COUNTERPOISE PULLEY SUPPORT
WALL BRACKET PIN

H. G. FISCHER & CO.
2335 WABANSIA AVE.
CHICAGO, ILL.

CAT. NO.

PART NO. 16997

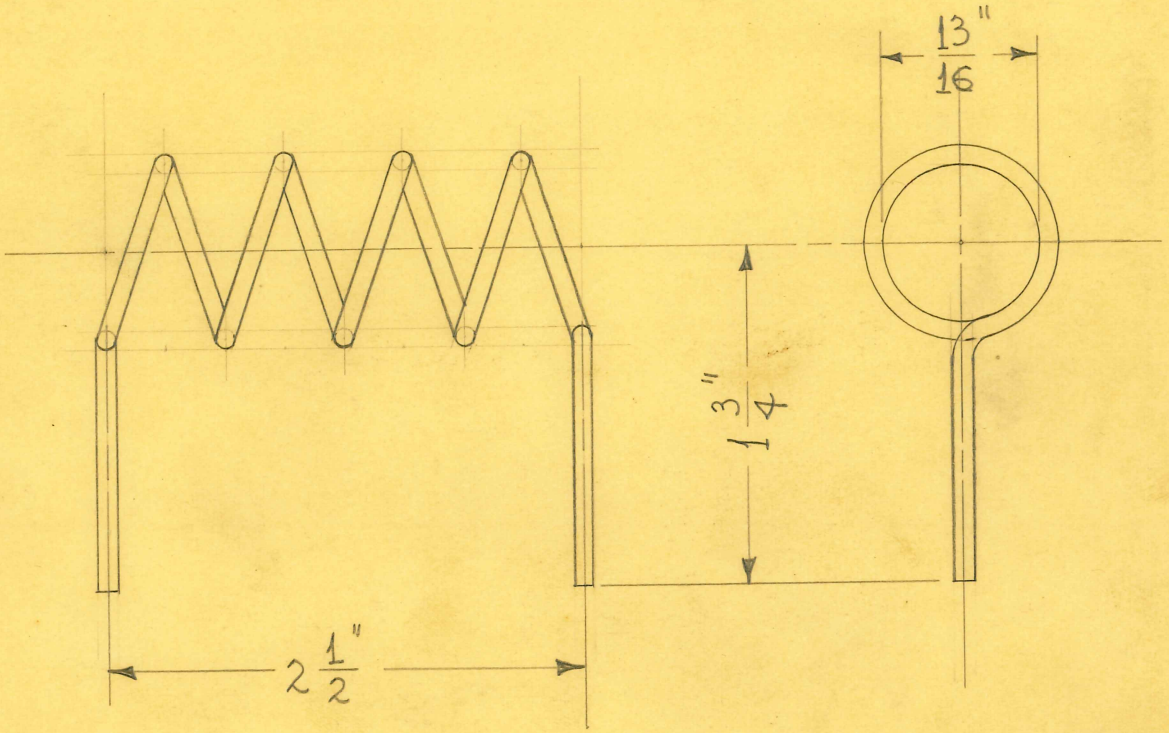

1 REQUIRED

4 TURNS

SIZE	#10 TINNED	ISSUE 10-29-42	HE.	TITLE: U.S. NAVY SHORT WAVE ~ GRID COIL
KIND	COPPER WIRE	CHANGED		
SHAPE		"		
FINISH		"		
TEMP.		"		
PATT.		"		

H. G. FISCHER & CO.
2338 WABANSIA AVE.
CHICAGO, ILL.

CAT. NO.

PART NO. 15256

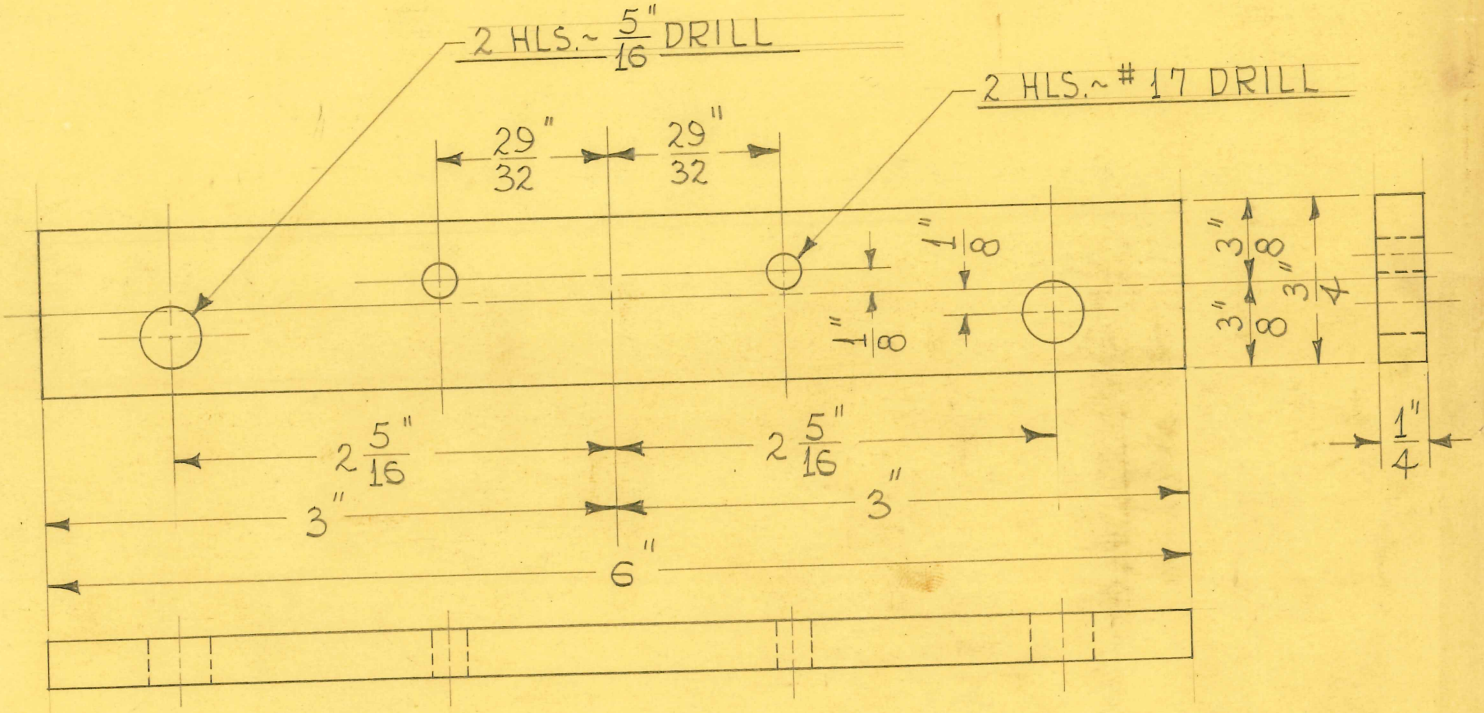

1 REQUIRED

SIZE	1/4" BLACK	ISSUE	10-30-42	H. E.
KIND	BAKELITE	CHANGED		
SHAPE	SHEET	"		
FINISH		"		
TEMP.		"		
PATT.		"		

TITLE: U.S. NAVY SHORT WAVE ~ AUTO-CONTROL TERMINAL BOARD

H. G. FISCHER & CO.
2335 WABANSIA AVE.
CHICAGO, ILL.

CAT. NO.

PART NO. 15257

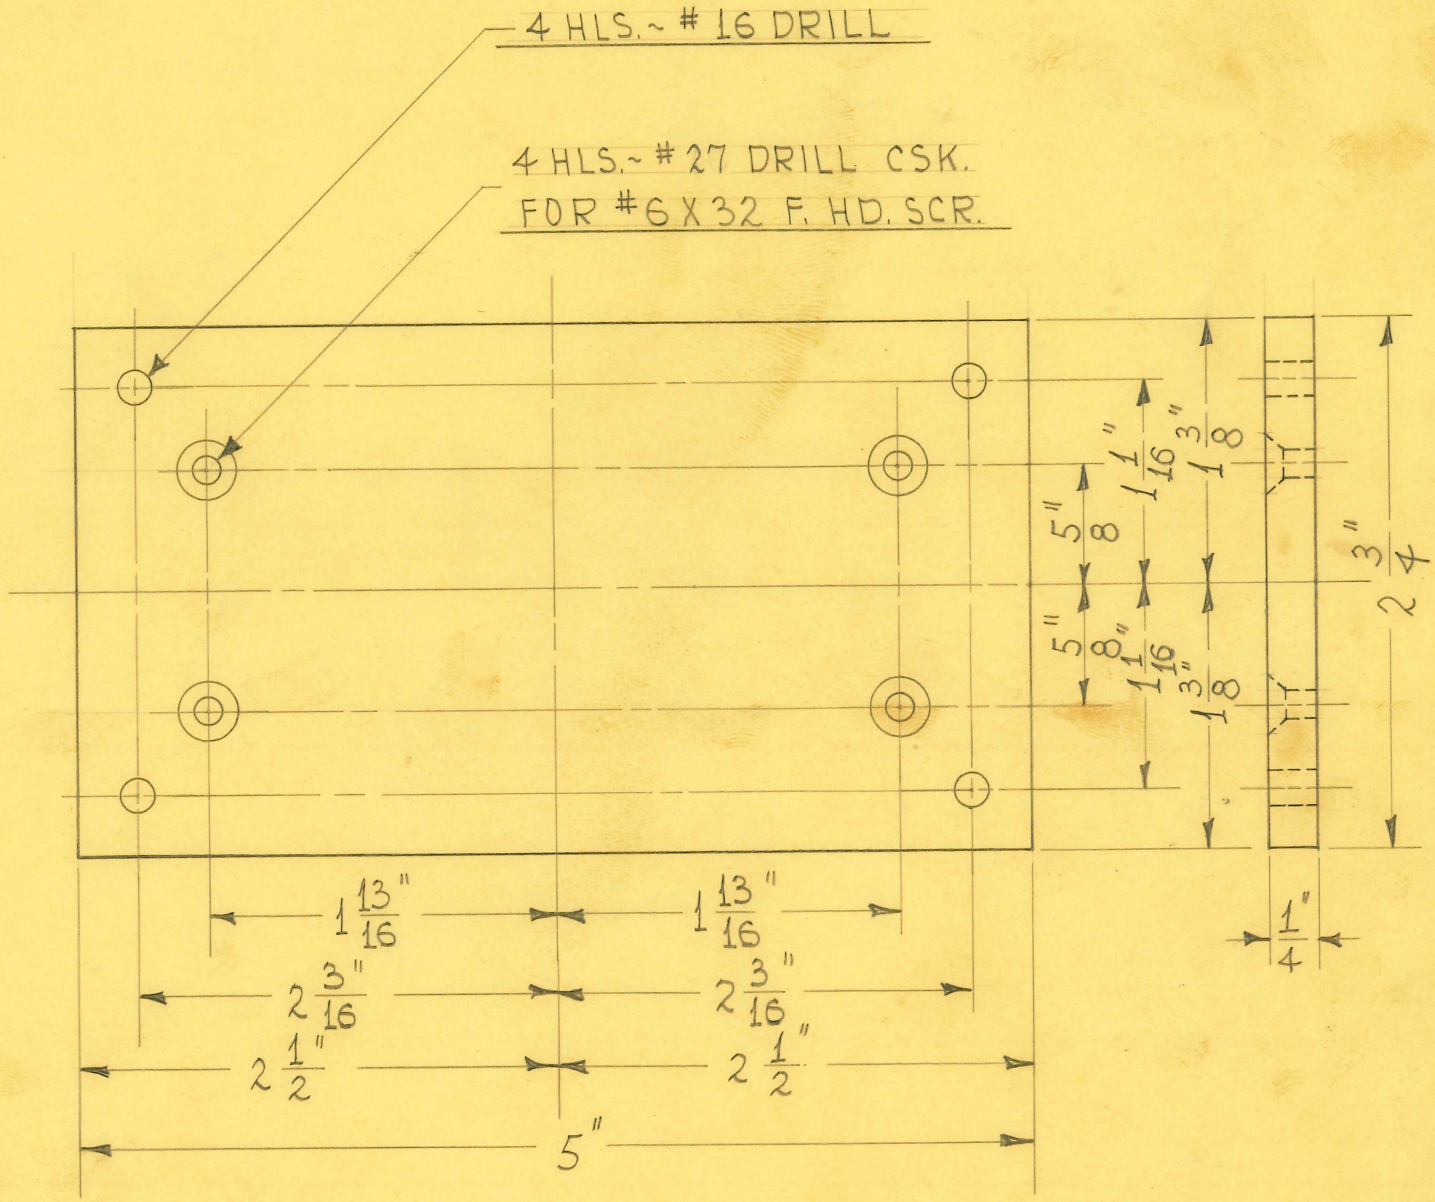

1 REQUIRED

SIZE	1/4 BLACK	ISSUE 10-29-42	HE.
KIND	BAKELITE	CHANGED	
SHAPE	SHEET	"	
FINISH		"	
TEMP.		"	
PATT.		"	

TITLE: U.S. NAVY SHORT WAVE~ CHOKE COIL BASE

H. G. FISCHER & CO.
2335 WABANSIA AVE.
CHICAGO, ILL.

CAT. NO.

PART NO. 15262

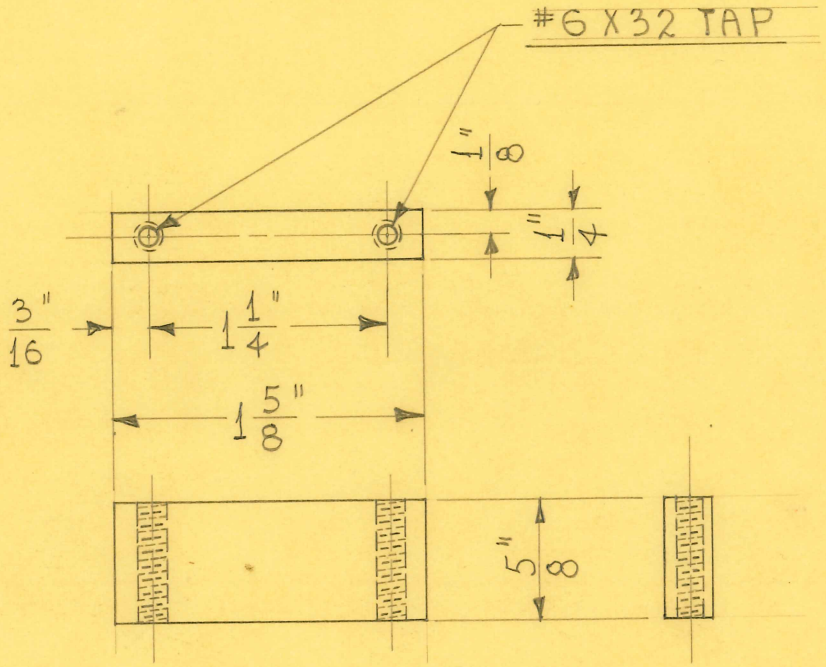

1 REQUIRED

SIZE	1/4" BLACK	ISSUE 10-30-42	HE.
KIND	BAKELITE	CHANGED	
SHAPE	SHEET	"	
FINISH		"	
TEMP.		"	
PATT.		"	

TITLE: U. S. NAVY SHORT WAVE ~ CHOKE COIL SUPPORT

H. G. FISCHER & CO.
2335 WABANSIA AVE.
CHICAGO, ILL.

CAT. NO.

PART NO. 15263

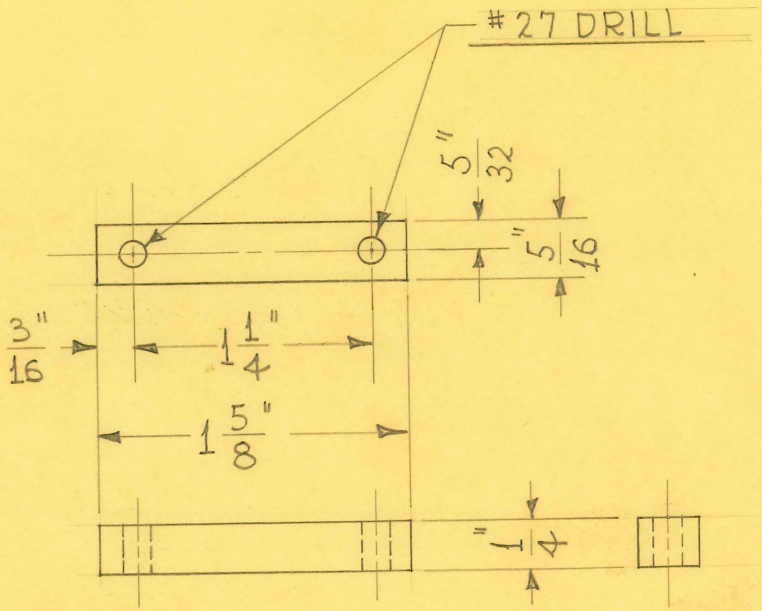

1 REQUIRED

SIZE	1/4" BLACK	ISSUE 10-30-42	HE.
KIND	BAKELITE	CHANGED	
SHAPE	SHEET	"	
FINISH		"	
TEMP.		"	
PATT.		"	

TITLE: U.S. NAVY SHORT WAVE ~ CHOKE COIL CLAMP

H. G. FISCHER & CO.
2338 WABANSIA AVE.
CHICAGO, ILL.

CAT. NO.

PART NO. 15264

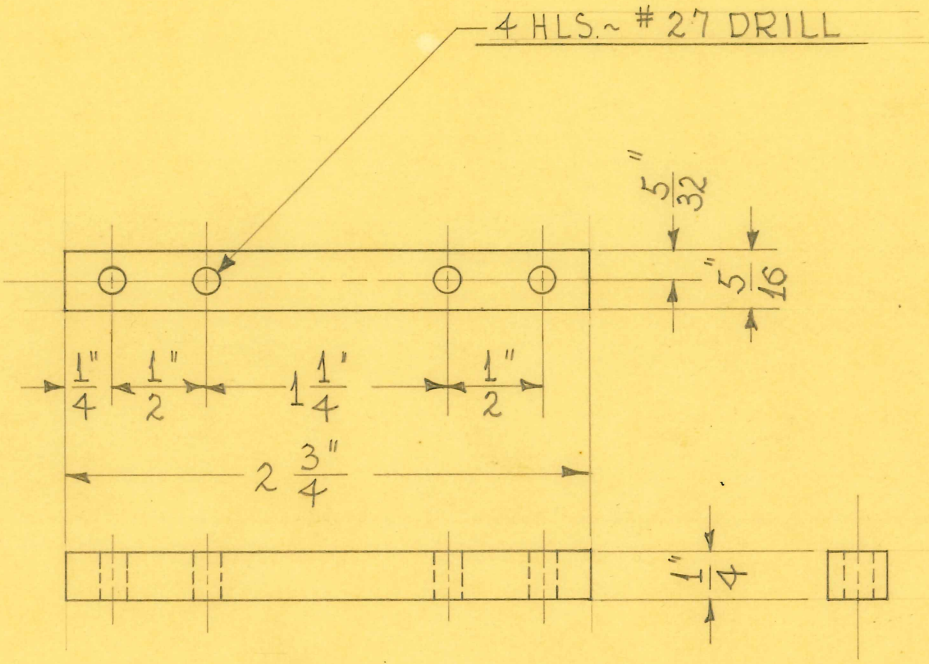

1 REQUIRED

SIZE	1/4" BLACK	ISSUE 10-30-42	HE.	**TITLE:** U.S. NAVY SHORT WAVE~ CHOKE COIL TERM. STRIP & CLAMP
KIND	BAKELITE	CHANGED		
SHAPE	SHEET	"		
FINISH		"		
TEMP.		"		
PATT.		"		

H. G. FISCHER & CO.
2335 WABANSIA AVE.
CHICAGO, ILL.

CAT. NO.

PART NO. 15265

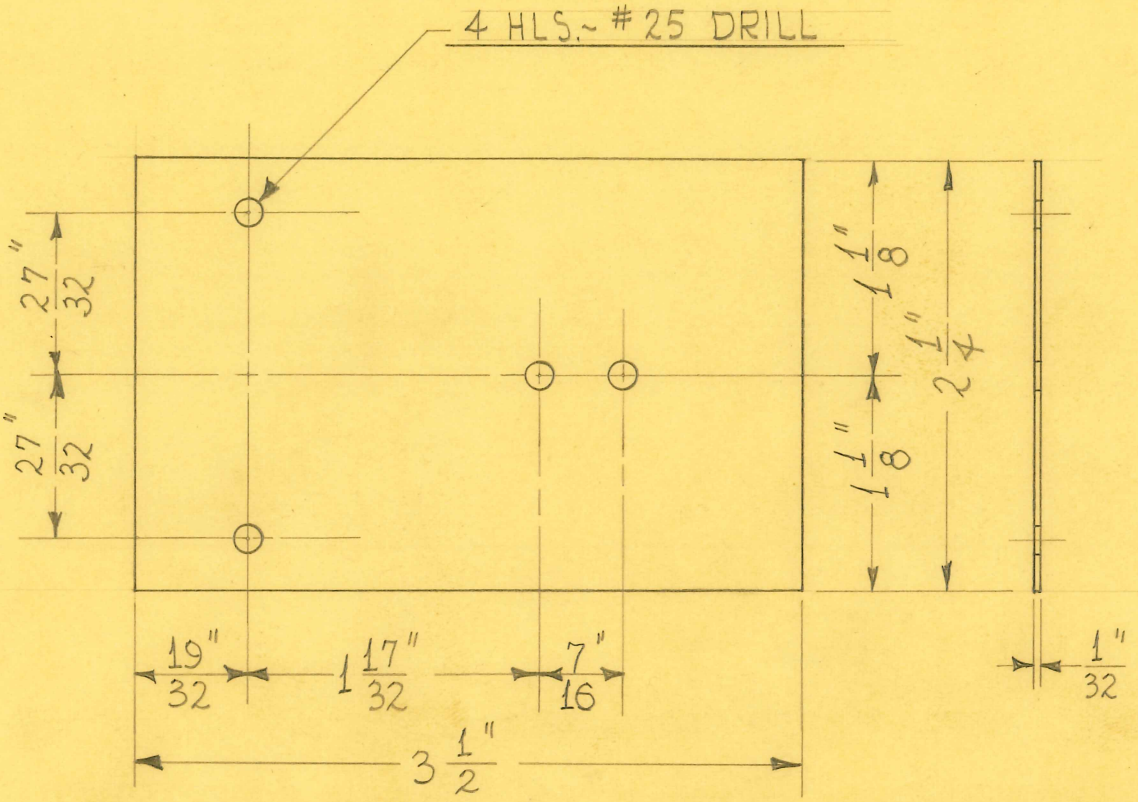

2 REQUIRED

SIZE	1/32" BLACK	ISSUE 10-30-42	HE.
KIND	LINEN-BASE	CHANGED	
SHAPE	BAKELITE	"	
FINISH		"	
TEMP.		"	
PATT.		"	

TITLE:
U. S. NAVY SHORT WAVE ~
RECTIFIER TUBE SOCKET INSULATOR

H. G. FISCHER & CO.
2335 WABANSIA AVE.
CHICAGO, ILL.

CAT. NO.

PART NO. 15268

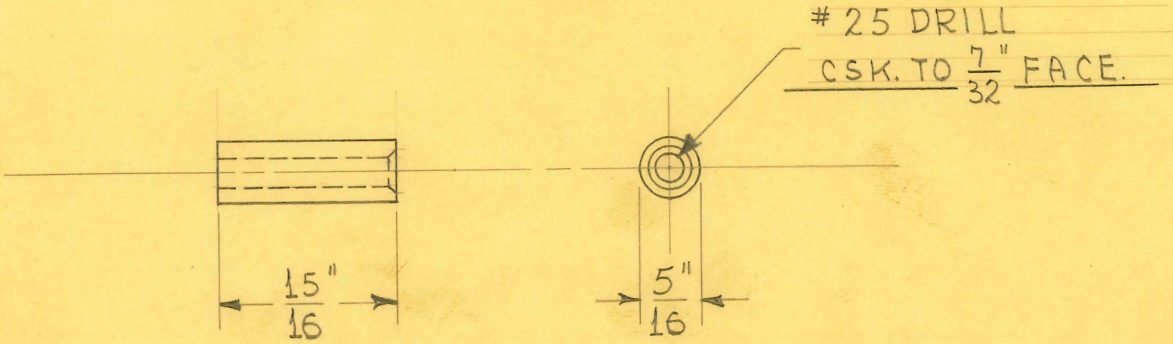

3 REQUIRED

SIZE	5/16" DIAM.	ISSUE 10-31-42	HE.
KIND	BRASS ROD	CHANGED	
SHAPE		"	
FINISH		"	
TEMP.		"	
PATT.		"	

TITLE: U.S. NAVY SHORT WAVE ~
LINE & PLATE SWITCH SPACER

H. G. FISCHER & CO.
2333 WABANSIA AVE.
CHICAGO, ILL.

CAT. NO.

PART NO. 15270

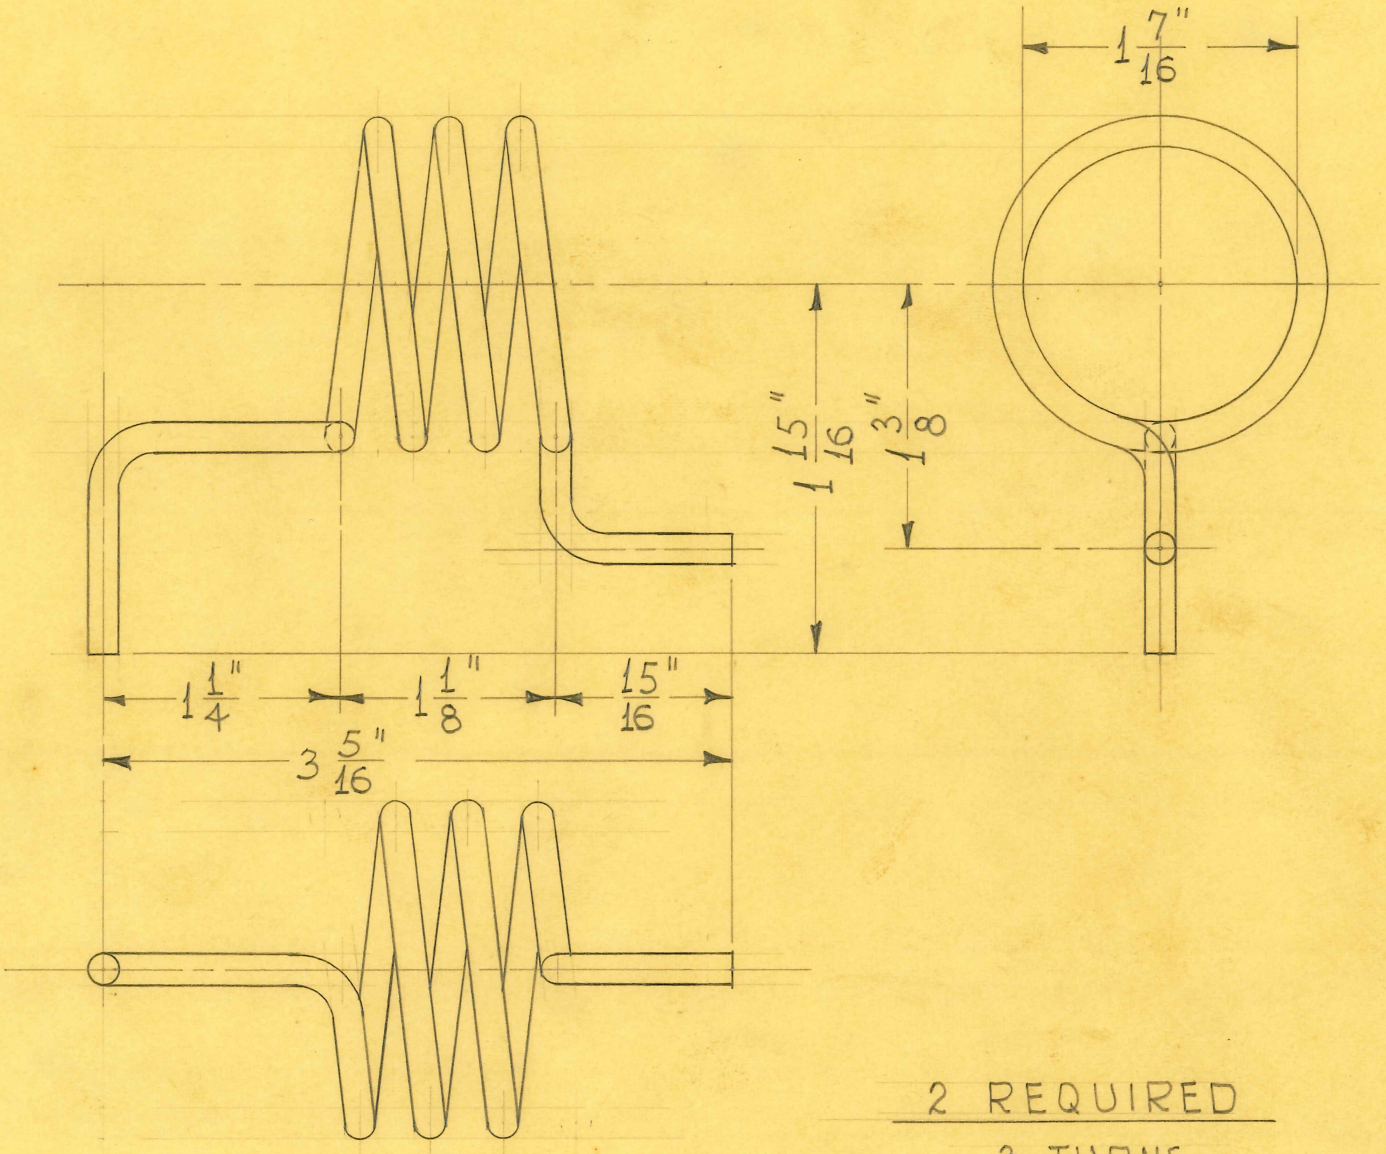

2 REQUIRED

3 TURNS

SIZE	#6 BARE	ISSUE 10-29-42	HE.
KIND	COPPER WIRE	CHANGED	
SHAPE		"	
FINISH		"	
TEMP.		"	
PATT.		"	

TITLE:

U.S. NAVY SHORT WAVE
OSCILLATING COIL

H. G. FISCHER & CO.
2335 WABANSIA AVE.
CHICAGO, ILL.

CAT. NO.

PART NO. 15272

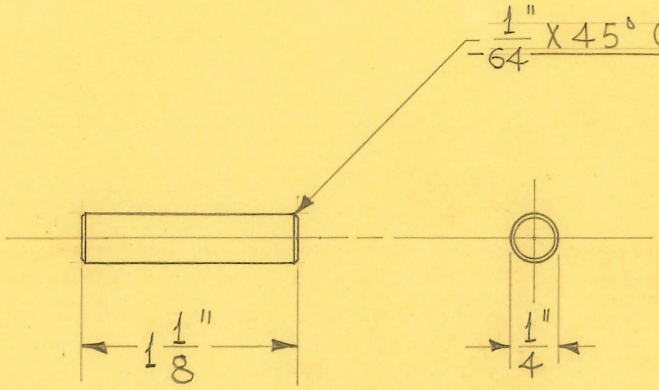

1 REQUIRED

SIZE	1/4" DIAM.	ISSUE 10-30-42	HE.
KIND	BRASS ROD	CHANGED	
SHAPE		"	
FINISH		"	
TEMP.		"	
PATT.		"	

TITLE: U.S. NAVY SHORT WAVE - ROTOR SHAFT EXTENSION

H. G. FISCHER & CO.
2335 WABANSIA AVE.
CHICAGO, ILL.

CAT. NO.

PART NO. 15273

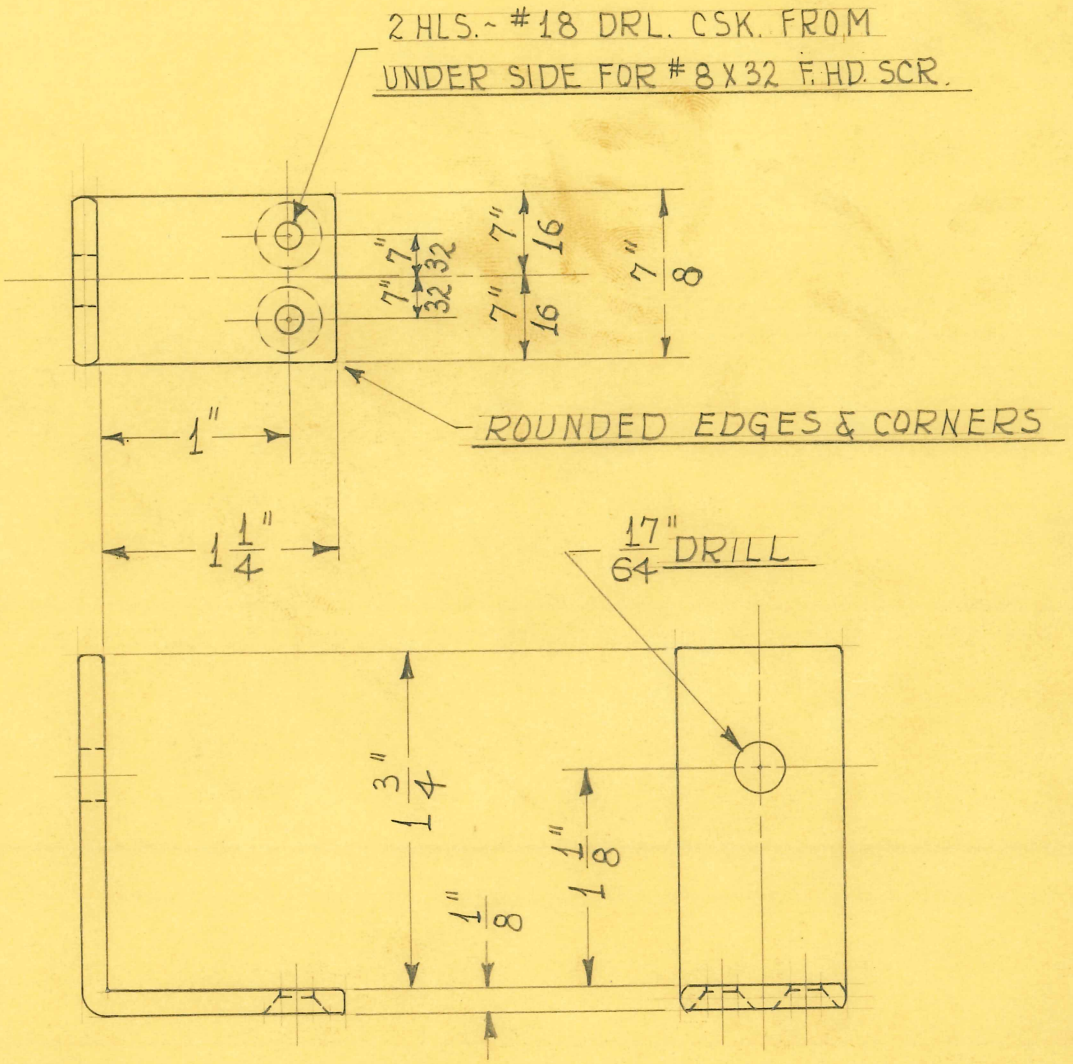

DEVELOPED LENGTH - 3 1/16"

2 REQUIRED

SIZE	7/8" X 1/8"	ISSUE 10-31-42	HE.
KIND	FLAT WIRE	CHANGED	
SHAPE		"	
FINISH	BLACK #80	"	
TEMP.		"	
PATT.		"	

TITLE:
U.S. NAVY SHORT WAVE -
R.F. CHOKE BRACKET

H. G. FISCHER & CO.
2335 WABANSIA AVE.
CHICAGO, ILL.

CAT. NO.

PART NO. 15274

GRAIN TO RUN IN THIS DIRECTION

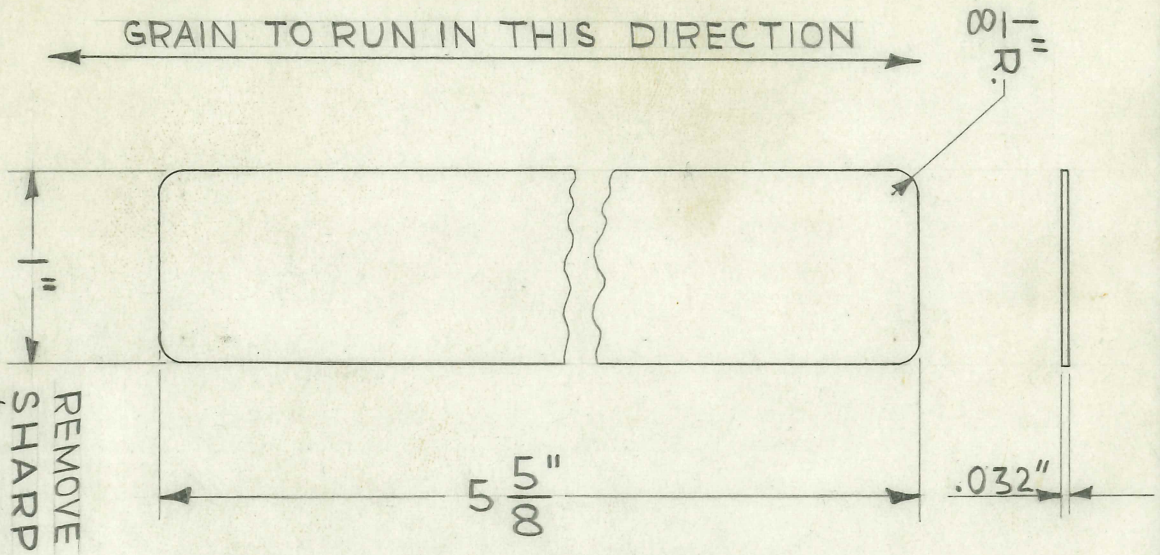

DEVELOPMENT

REMOVE ALL SHARP EDGES & CORNERS

1 REQUIRED

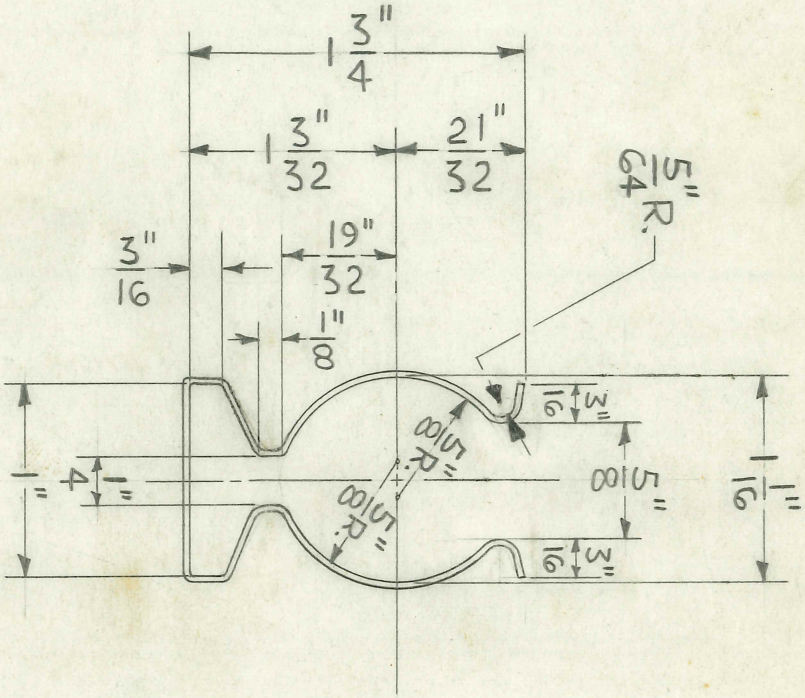

TITLE	FISCHER INDUCTION ELECTRODE CLAMP SPRING
PATTERN	
FINISH	WHITE NICKEL #13
SCALE	FULL
TOOLS	BENDING FIX. #11014
MATERIAL	20 GA.(.032") PHOS. BRONZE
DATE	5-18-49
DR. BY	W.J.
CH'K'D.	J.V.W.
DIMENSIONS	FRACTIONAL ±.015 DECIMAL ±.005 ANGULAR ±½° UNLESS OTHERWISE SPECIFIED

H. G. FISCHER & CO.
FRANKLIN PARK, ILLINOIS

PART NO. 16208

REVISION	DATE	BY

FOLDER #118

TITLE HINGED INDUCTION ELECTRODE SPRING CONNECTION LINK

H. G. FISCHER & CO.
FRANKLIN PARK, ILLINOIS

PART NO. 16209

DATE 2-18-52 DR. BY W.J. CH'K'D.

REVISION	DATE	BY

PATTERN

FINISH SILVER #6 1/2

SCALE FULL

DIMENSIONS
FRACTIONAL ± .015
DECIMAL ± .005
ANGULAR ± ½°
UNLESS OTHERWISE SPECIFIED

TOOLS CUT OFF DIE #721 Y-5
BENDING FIX. # 11674

MATERIAL .020" SPRING BRASS

2 HLS. RE-DRILL WITH #10 DRILL

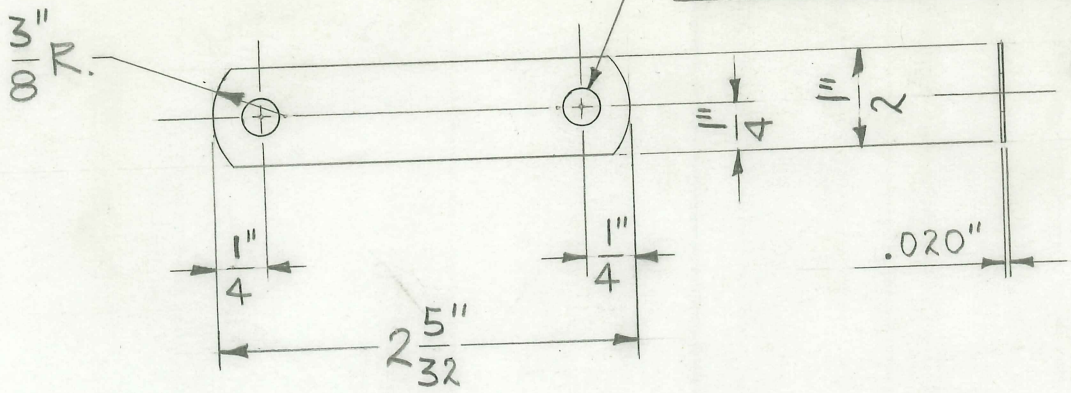

GRAIN TO RUN IN THIS DIRECTION

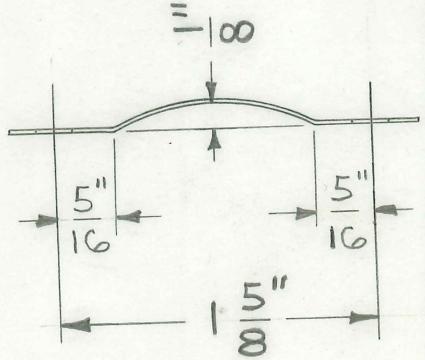

1 REQUIRED

FOLDER #118

TITLE FISCHER ADJUSTABLE INDUCTION ELECT. SPRING CONN. LINK - LARGE HOLE

H. G. FISCHER & CO.
FRANKLIN PARK, ILLINOIS

PART NO. 16209 1/2 A

DATE 8-25-52 DR BY J.V.W. CH'K'D. RS

REVISION	DATE	BY
A HLS. WELLE 5/16 DIA.	10-4-67	J.V.W.

PATTERN | FINISH SILVER #6 1/2 | SCALE FULL

TOOLS CUT-OFF DIE #721 (Y-5)
~~PERF. DIE # 3193 (G5)~~
~~NEST PCE. # 16209 1/2~~
BENDING FIX #11674

MATERIAL .020" SPRING BRASS SHEET

DIMENSIONS UNLESS OTHERWISE SPECIFIED
FRACTIONAL ± .015
DECIMAL ± .005
ANGULAR ± 1/2°

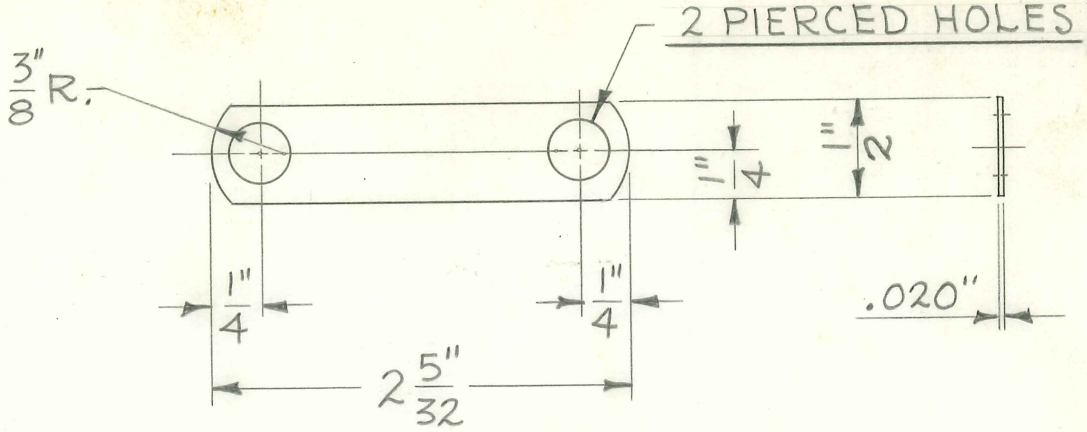

QTY	1
USED ON	#15870GH

GRAIN TO RUN IN THIS DIRECTION

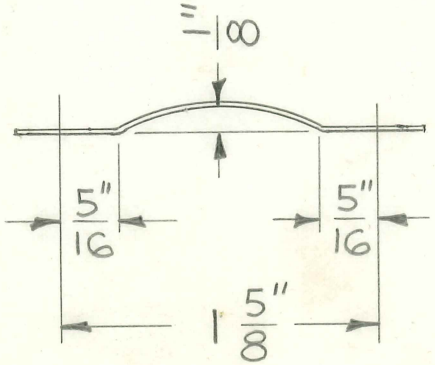

1 REQUIRED

FOLDER #118

TITLE

FISCHER ADJUSTABLE CONDENSER ELECTRODE — CONTACT SPRING

H. G. FISCHER & CO.
FRANKLIN PARK, ILLINOIS

PART NO. 16216

REVISION	DATE	BY

DATE 3-3-53 | DR. BY J.V.W. | CH'K'D.

PATTERN | FINISH | SCALE FULL

DIMENSIONS
FRACTIONAL ± .015
DECIMAL ± .005
ANGULAR ± ½°
UNLESS OTHERWISE SPECIFIED

TOOLS CUT-OFF DIE #708 (BIN 0-3)
PERFORATING DIE #11872

MATERIAL .016" SHEET PHOS. BRONZE

BENDING FIXTURE #11874

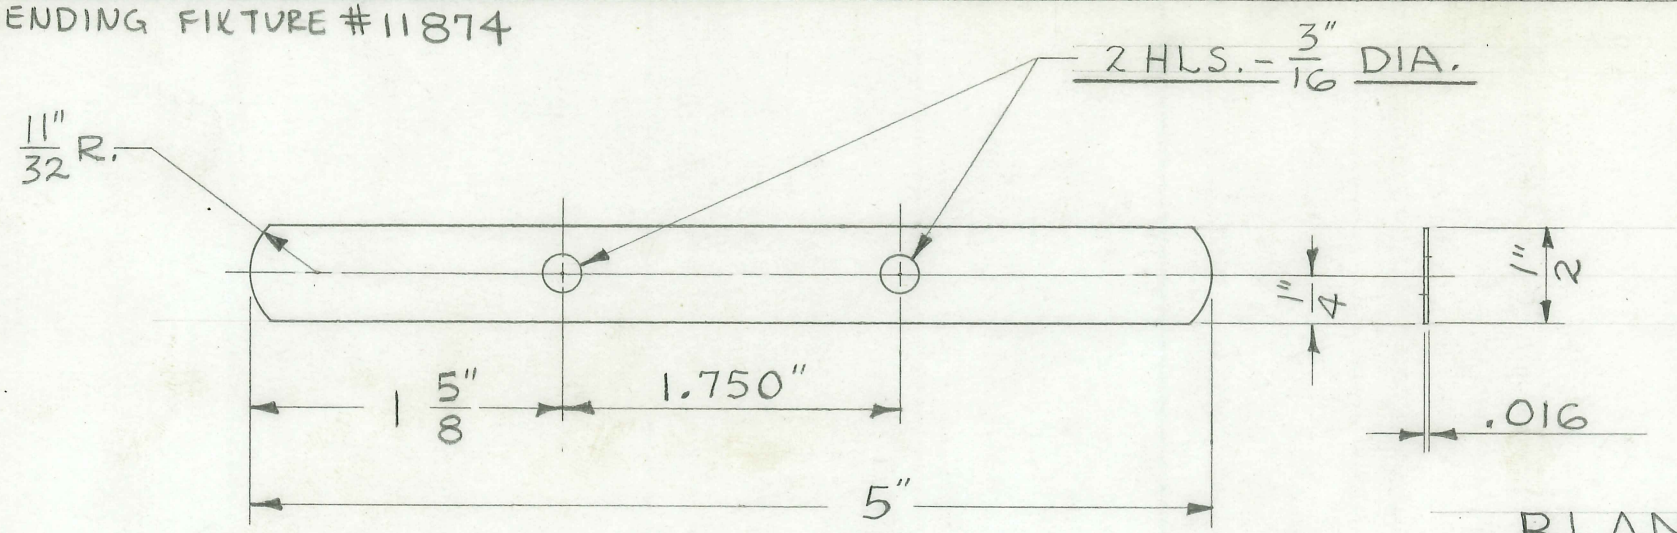

BLANK

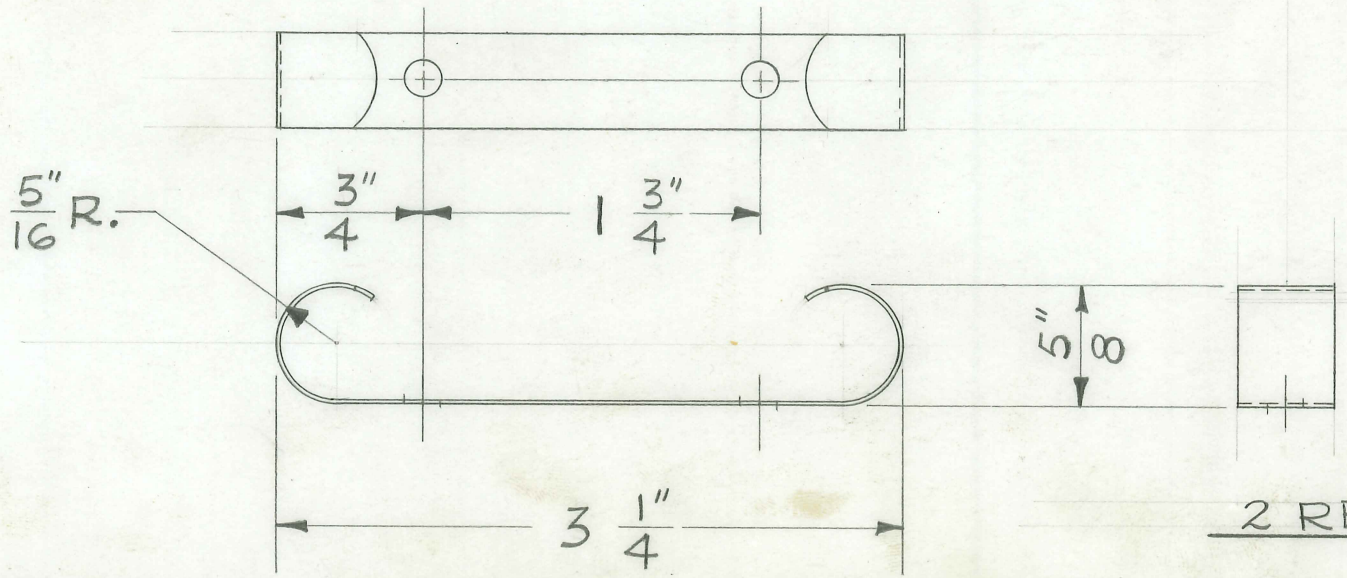

2 REQUIRED

FOLDER #118

TITLE: FISCHER ADJ. CONDENSER ELECT. CORD TIP SLEEVE

H. G. FISCHER & CO.
FRANKLIN PARK, ILLINOIS

PART NO. 16221

DATE 3-23-53 | DR BY J.N.W. | CH'K'D.

REVISION	DATE	BY

PATTERN | FINISH | SCALE FULL

DIMENSIONS
FRACTIONAL ± .015
DECIMAL ± .005
ANGULAR ± ½°
UNLESS OTHERWISE SPECIFIED

TOOLS: FORM TOOL # 6816

MATERIAL: $\frac{7}{8}$" DIA. POLISHED HARD RUBBER ROD

BREAK ALL SHARP EDGES

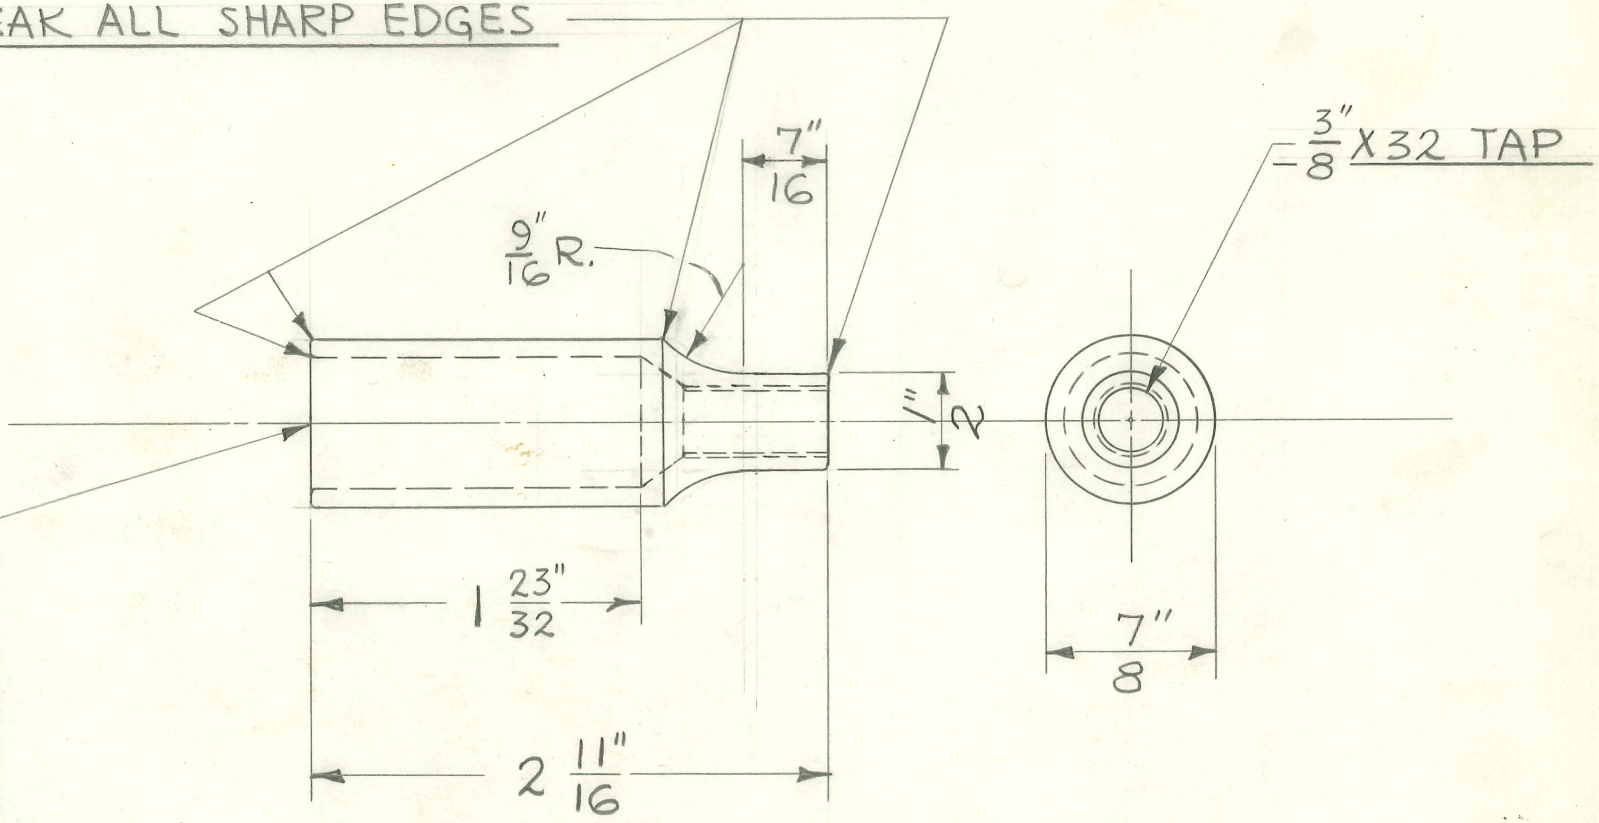

GRIND POINT OF DRILL TO 72° INC. ANGLE 23/32 DIA. DRILL

2 REQUIRED

FOLDER # 118

TITLE

INSULATING BEAD

H. G. FISCHER & CO.
FRANKLIN PARK, ILLINOIS

PART NO. 16234A

DATE 2-22-51 | DR. BY J.V.W. | CH'K'D.

REVISION	DATE	BY

PATTERN | FINISH | SCALE 1" = 1/8"

TOOLS: MOLD #1832 AT SUPPLIER

MATERIAL: STEATITE

DIMENSIONS UNLESS OTHERWISE SPECIFIED

FRACTIONAL	± .015
DECIMAL	± .005
ANGULAR	± ½°

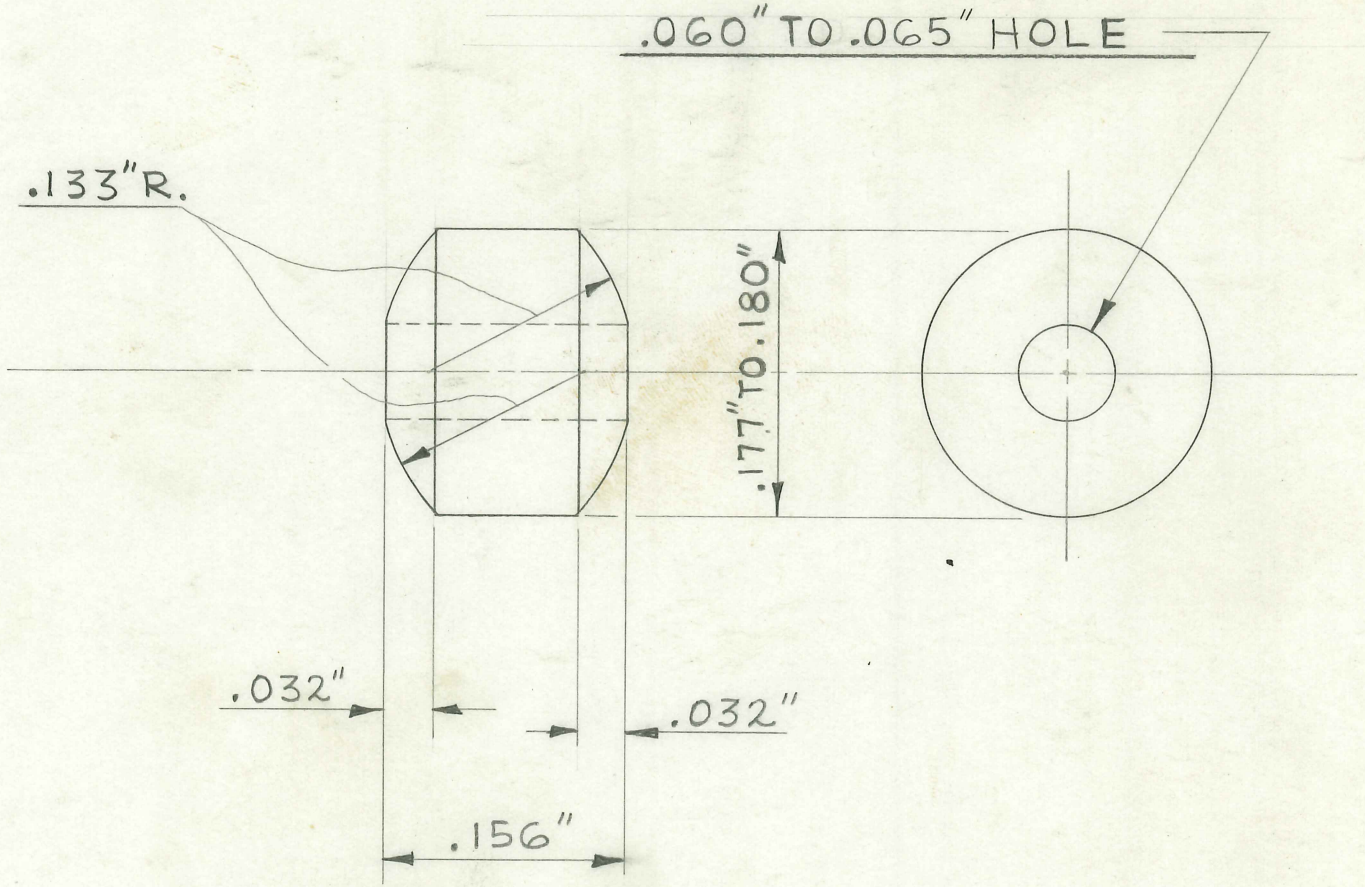

FOLDER #128

TITLE

MODEL "400" FISCHER DELUXE DIA. FARRADAY PICK UP LOOP TUBE - SHORT

H. G. FISCHER & CO.
FRANKLIN PARK, ILLINOIS

PART NO. 16235

DATE 3-7-49 | DR. BY W. J. | CH'K'D. J.V.W.

REVISION	DATE	BY

PATTERN | FINISH | SCALE FULL

TOOLS: RADIUS c'BORE. #11039

MATERIAL: .250" O.D. X .030" WALL SOFT COPPER TUBING

DIMENSIONS
FRACTIONAL ± .015
DECIMAL ± .005
ANGULAR ± ½°
UNLESS OTHERWISE SPECIFIED

2 REQUIRED

TRIM TO DIMENSION & ROUND EDGES INSIDE & OUT - BOTH ENDS

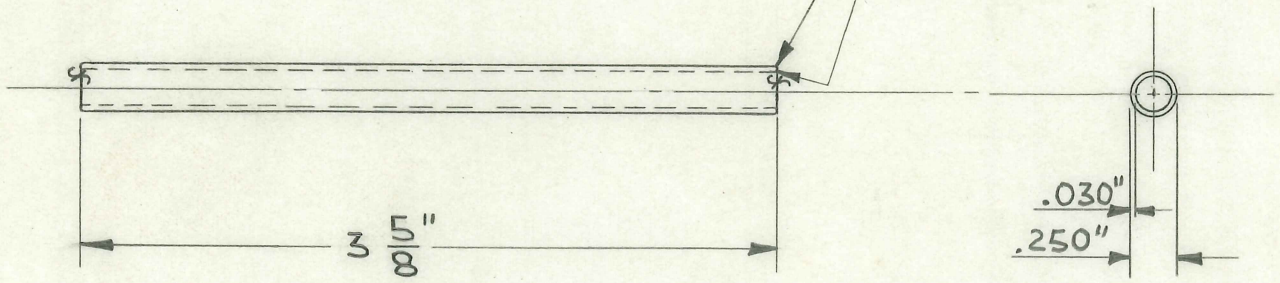

FOLDER #128

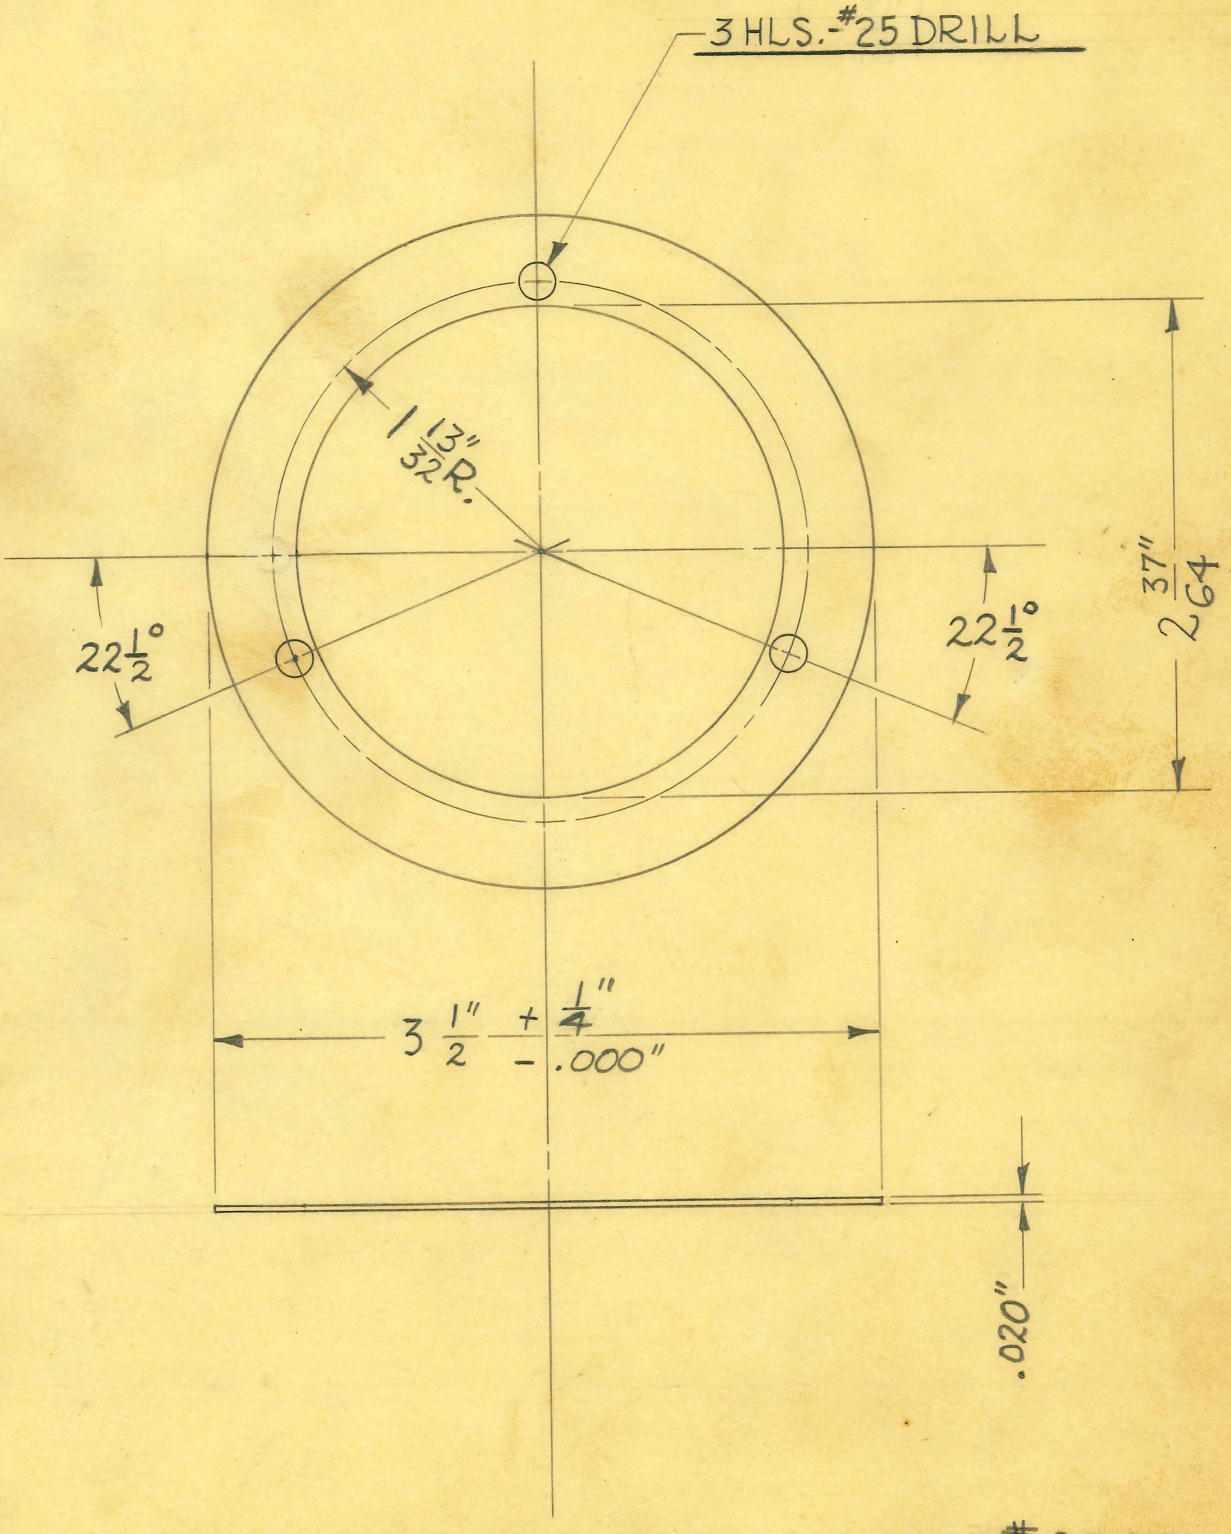

DRILL JIG TOOL #9743

SIZE	.020" SHEET	ISSUE 2-4-47	J.V.W.
KIND	ALUMINUM	CHANGED	
SHAPE		"	
FINISH		"	
TEMP.		"	
PATT.		"	

TITLE: FISCHER "FCW" SHORT WAVE OUTFIT
TIMER RING

H. G. FISCHER & CO.
2335 WABANSIA AVE.
CHICAGO, ILL.

CAT. NO.

PART NO. 16239

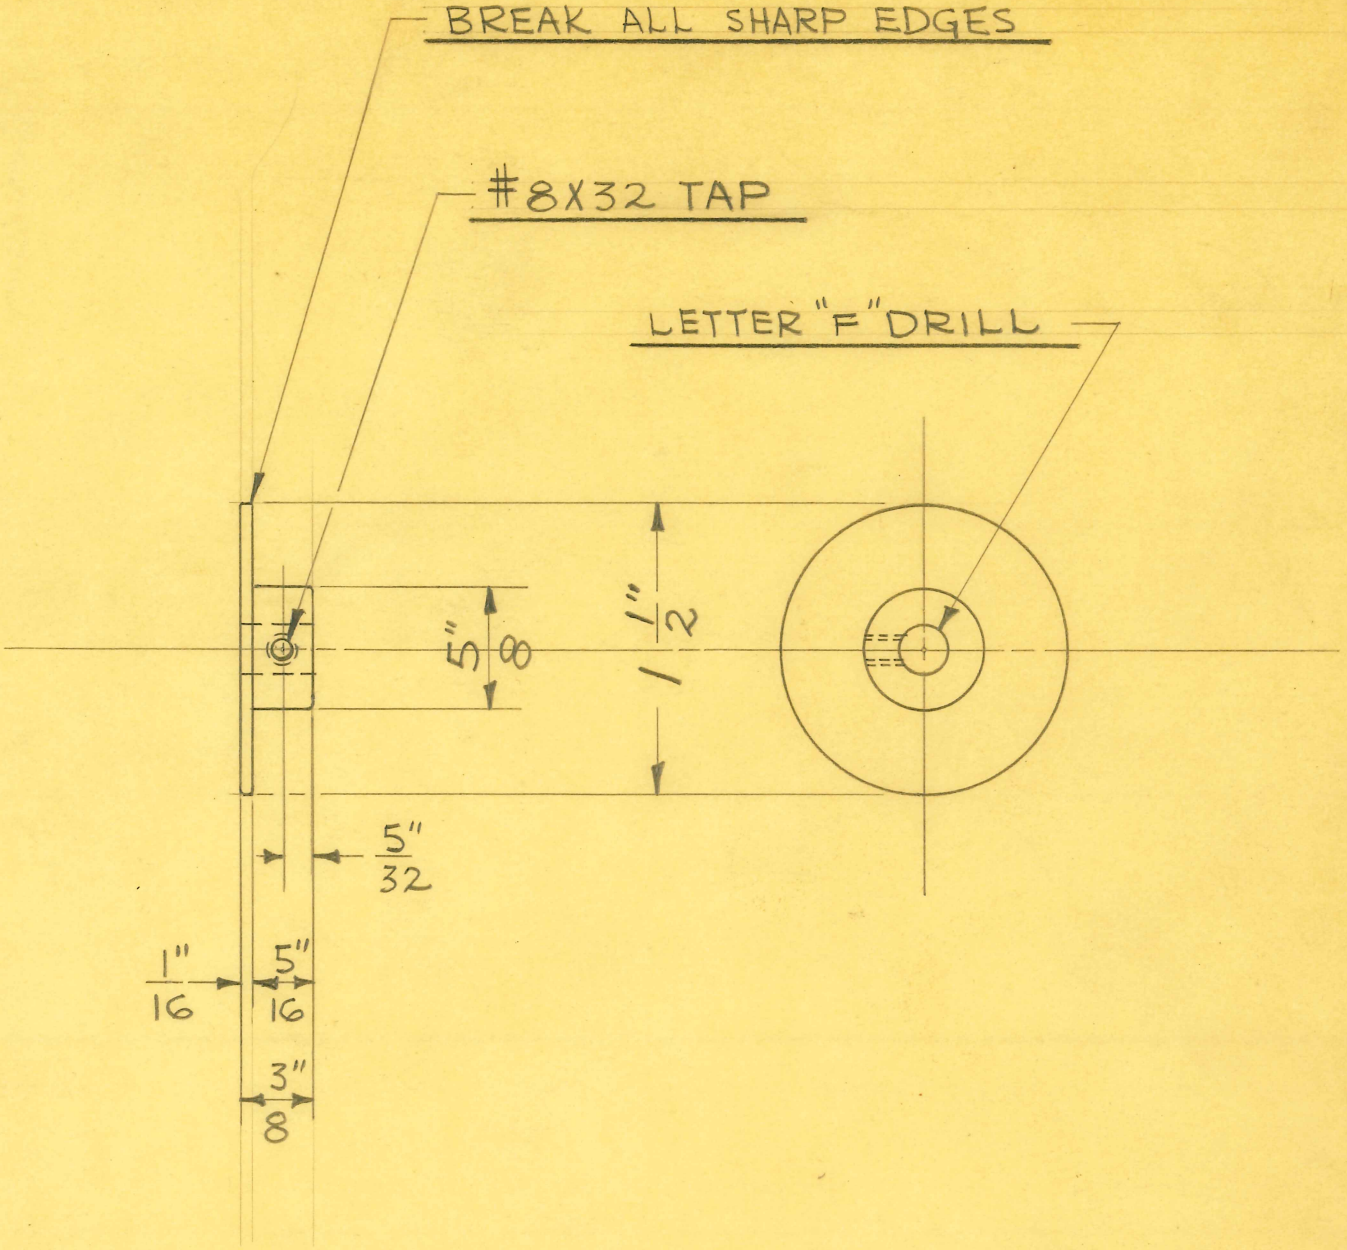

1 REQUIRED

SIZE	1½" DIA.	ISSUE 9-16-46	J.V.W.
KIND	BRASS ROD	CHANGED	
SHAPE		"	
FINISH		"	
TEMP.		"	
PATT.		"	

TITLE: FISCHER "FCW" SHORT WAVE OUTFIT TUNING CONDENSER GROUND DISC

H. G. FISCHER & CO.
2335 WABANSIA AVE.
CHICAGO, ILL.

CAT. NO.

PART NO. 16243

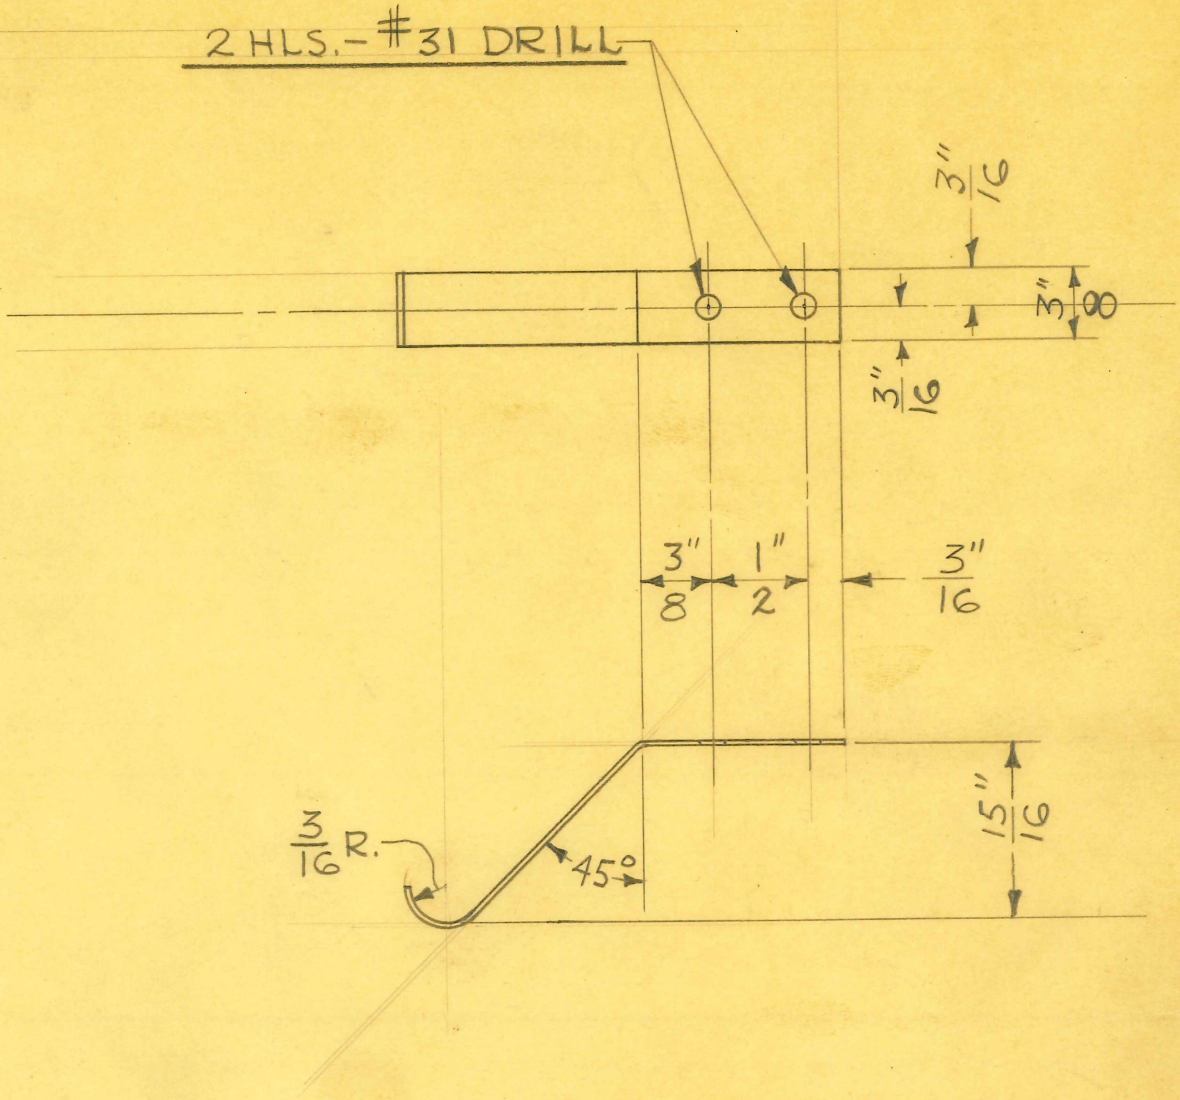

DEVELOPED LENGTH- 2 7/8"

1 REQUIRED

SIZE	#26 GA. (.016")	ISSUE 9-16-46	J.V.W.
KIND	PHOS. BRONZE	CHANGED	
SHAPE		"	
FINISH		"	
TEMP.		"	
PATT.		"	

TITLE:
FISCHER "FCW" SHORT WAVE OUTFIT
TUNING CONDENSER GROUND CONTACT

H. G. FISCHER & CO.
2335 WABANSIA AVE.
CHICAGO, ILL.

CAT. NO.

PART NO. 16244

#25 DRILL

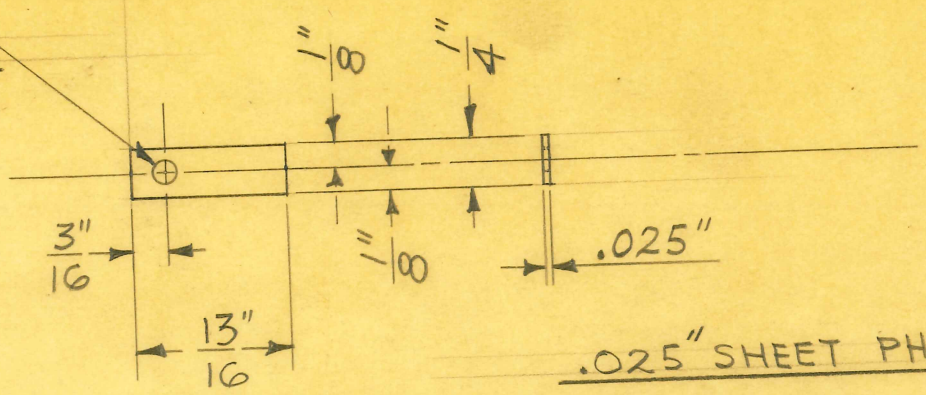

.025" SHEET PHOS. BRONZE

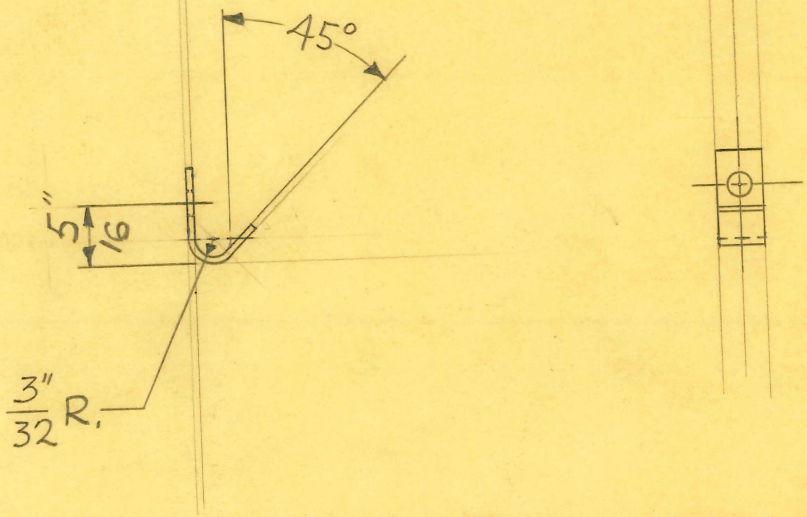

2 REQUIRED

SIZE	.025" SHEET	ISSUE 9-13-46	J.V.W.
KIND	PHOS. BRONZE	CHANGED	
SHAPE		"	
FINISH		"	
TEMP.		"	
PATT.		"	

TITLE: FISCHER "FCW" SHORT WAVE OUTFIT
OSCILLATING UNIT BAFFLE PLATE-TOP- CLIP

H. G. FISCHER & CO.
2335 WABANSIA AVE.
CHICAGO, ILL.

CAT. NO.

PART NO. 16245

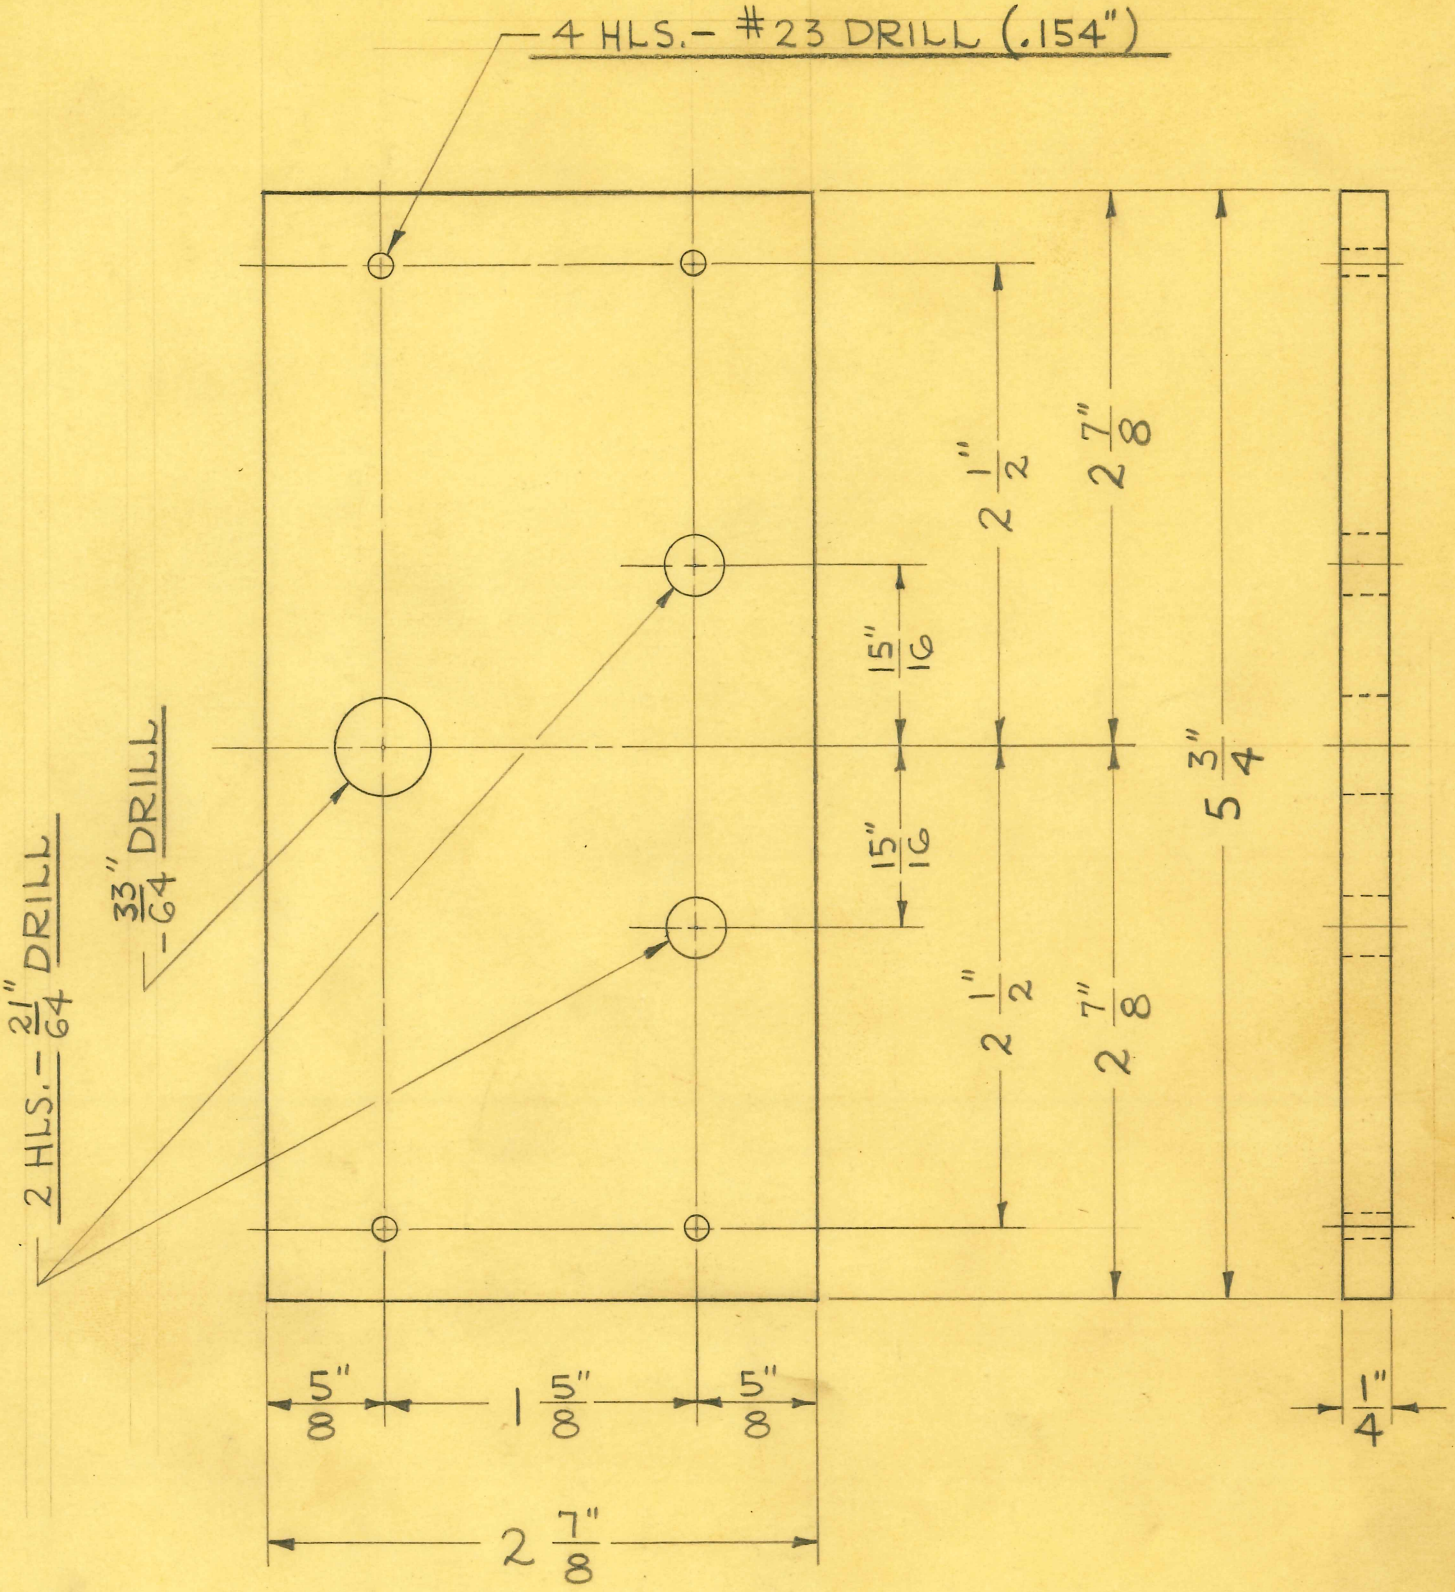

2 REQUIRED

SIZE	1/4" SHEET	ISSUE 5-6-46	J.V.W.
KIND	MYKROY	CHANGED	
SHAPE		"	
FINISH		"	
TEMP.		"	
PATT.		"	

TITLE:
FISCHER "FCW" SHORT WAVE OUTFIT
CORD SOCKET MOUNTING BOARD

H. G. FISCHER & CO.
2335 WABANSIA AVE.
CHICAGO, ILL.

CAT. NO.

PART NO. 16248

TITLE X-RAY CONTROL KNOB

H. G. FISCHER & CO.
FRANKLIN PARK, ILLINOIS

PART NO. 16264

DATE 4-8-67 | DR. BY RCT | CH'K'D.

REVISION	DATE	BY

PATTERN | FINISH | SCALE FULL

MATERIAL PURCHASE
OHMITE # 5112 W/2 SET SCREWS

TOOLS

DIMENSIONS—UNLESS OTHERWISE SPECIFIED:

FRACTIONAL	± .015	THREAD CHAMFER
DECIMAL	± .005	UP TO 5/16 D.- 1/32 X 45°
ANGULAR	± 1/2°	3/8 D. & OVER - 1/16 X 45°

REMOVE ALL BURRS & SHARP CORNERS

USED ON	QTY.	USED ON	QTY.
35862	1	21574G	2
38050G	2	21535G	2
21500G	2	21499G	2
21590G	2	21549½G	2

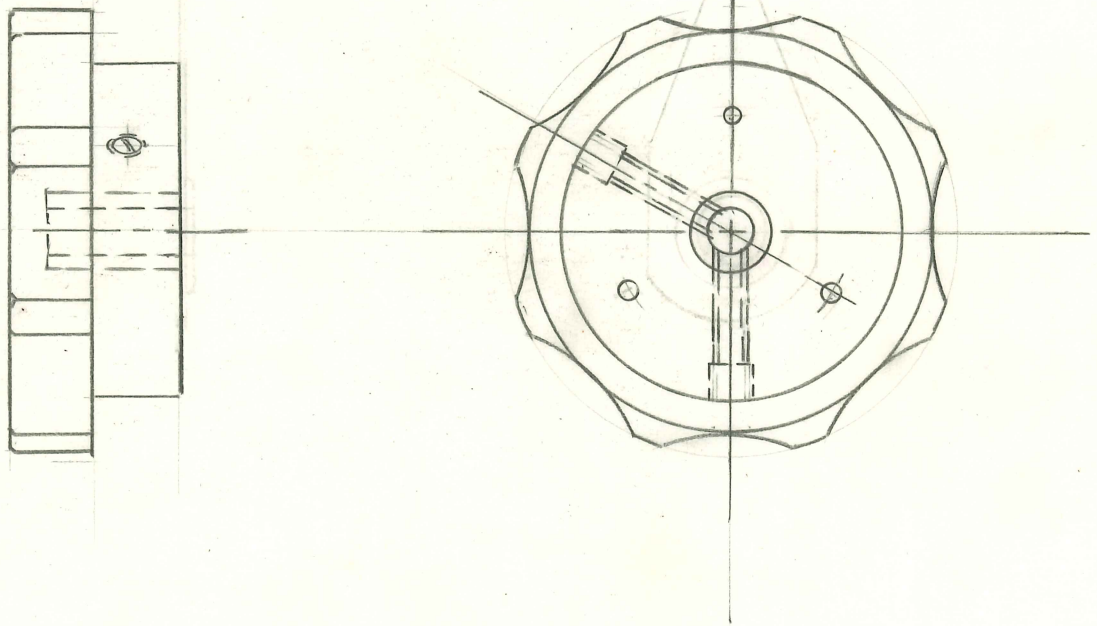

DO NOT SCALE DRAWING.

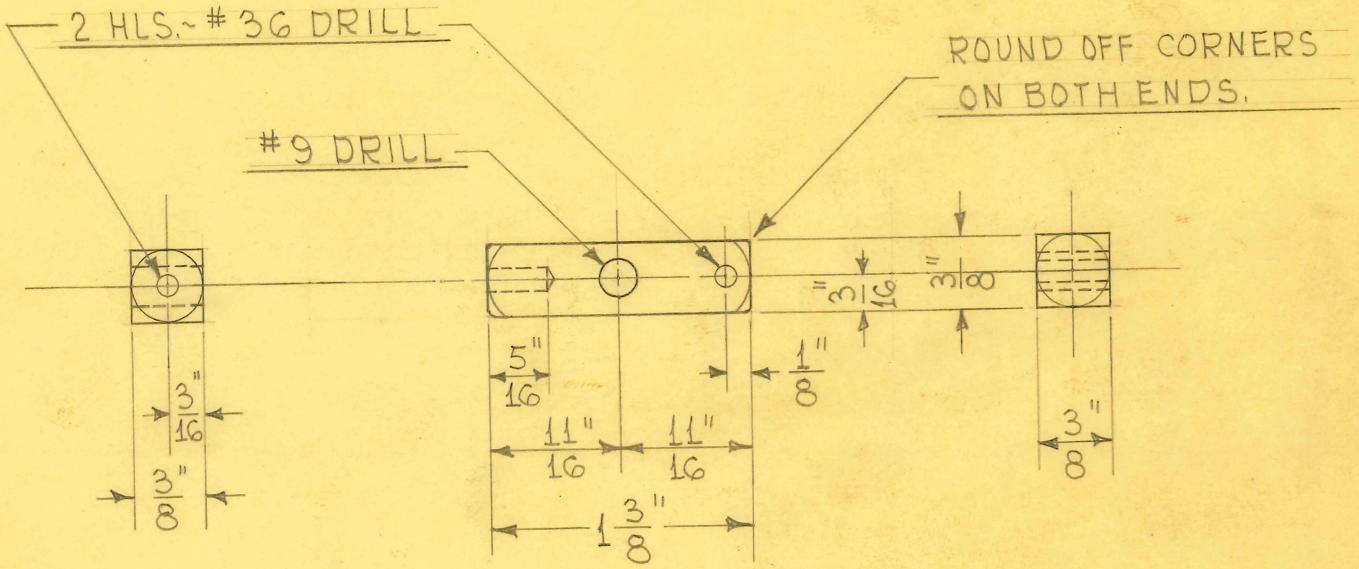

2 REQUIRED

SIZE	3/8" SQ.	ISSUE 9-24-45	H.E.
KIND	BRASS ROD	CHANGED	
SHAPE		"	
FINISH	CAD. #23	"	
TEMP.		"	
PATT.		"	

TITLE: FISCHER "FCW" SHORT WAVE OUTFIT- GRID COIL CONNECTION

H. G. FISCHER & CO.
2335 WABANSIA AVE.
CHICAGO, ILL.

CAT. NO.

PART NO. 16271

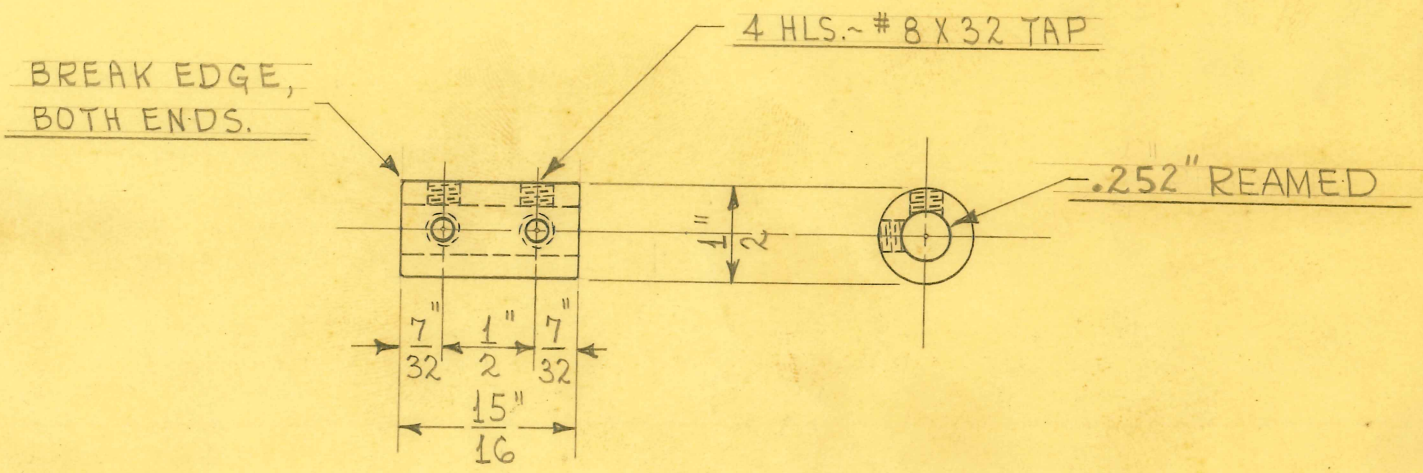

1 REQUIRED

SIZE	1/2" DIAM.	ISSUE 9-27-45	H.E.
KIND	BRASS ROD	CHANGED	
SHAPE		"	
FINISH		"	
TEMP.		"	
PATT.		"	

TITLE: FISCHER "FCW" SHORT WAVE OUTFIT- TUNING CONDENSER COUPLING

H. G. FISCHER & CO.
2335 WABANSIA AVE.
CHICAGO, ILL.

CAT. NO.

PART NO. 16297

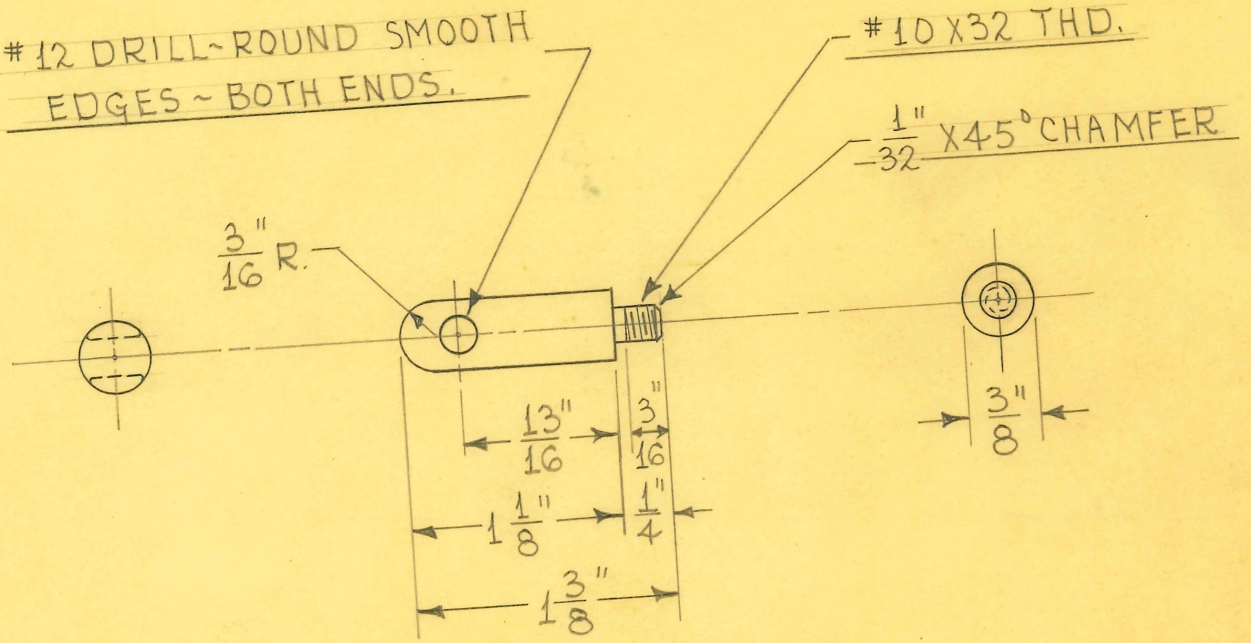

1 REQUIRED

SIZE	3/8" DIA.	ISSUE 9-27-45	HE.
KIND	BRASS	CHANGED	
SHAPE	ROD	"	
FINISH	CHR. #2	"	
TEMP.		"	
		"	

TITLE: FISCHER "FCW" SHORT WAVE OUTFIT~ CABINET ~ SWITCH CORD EYELET

H. G. FISCHER & CO.
2338 WABANSIA AVE.
CHICAGO, ILL.

CAT. NO.

PART NO. 16299

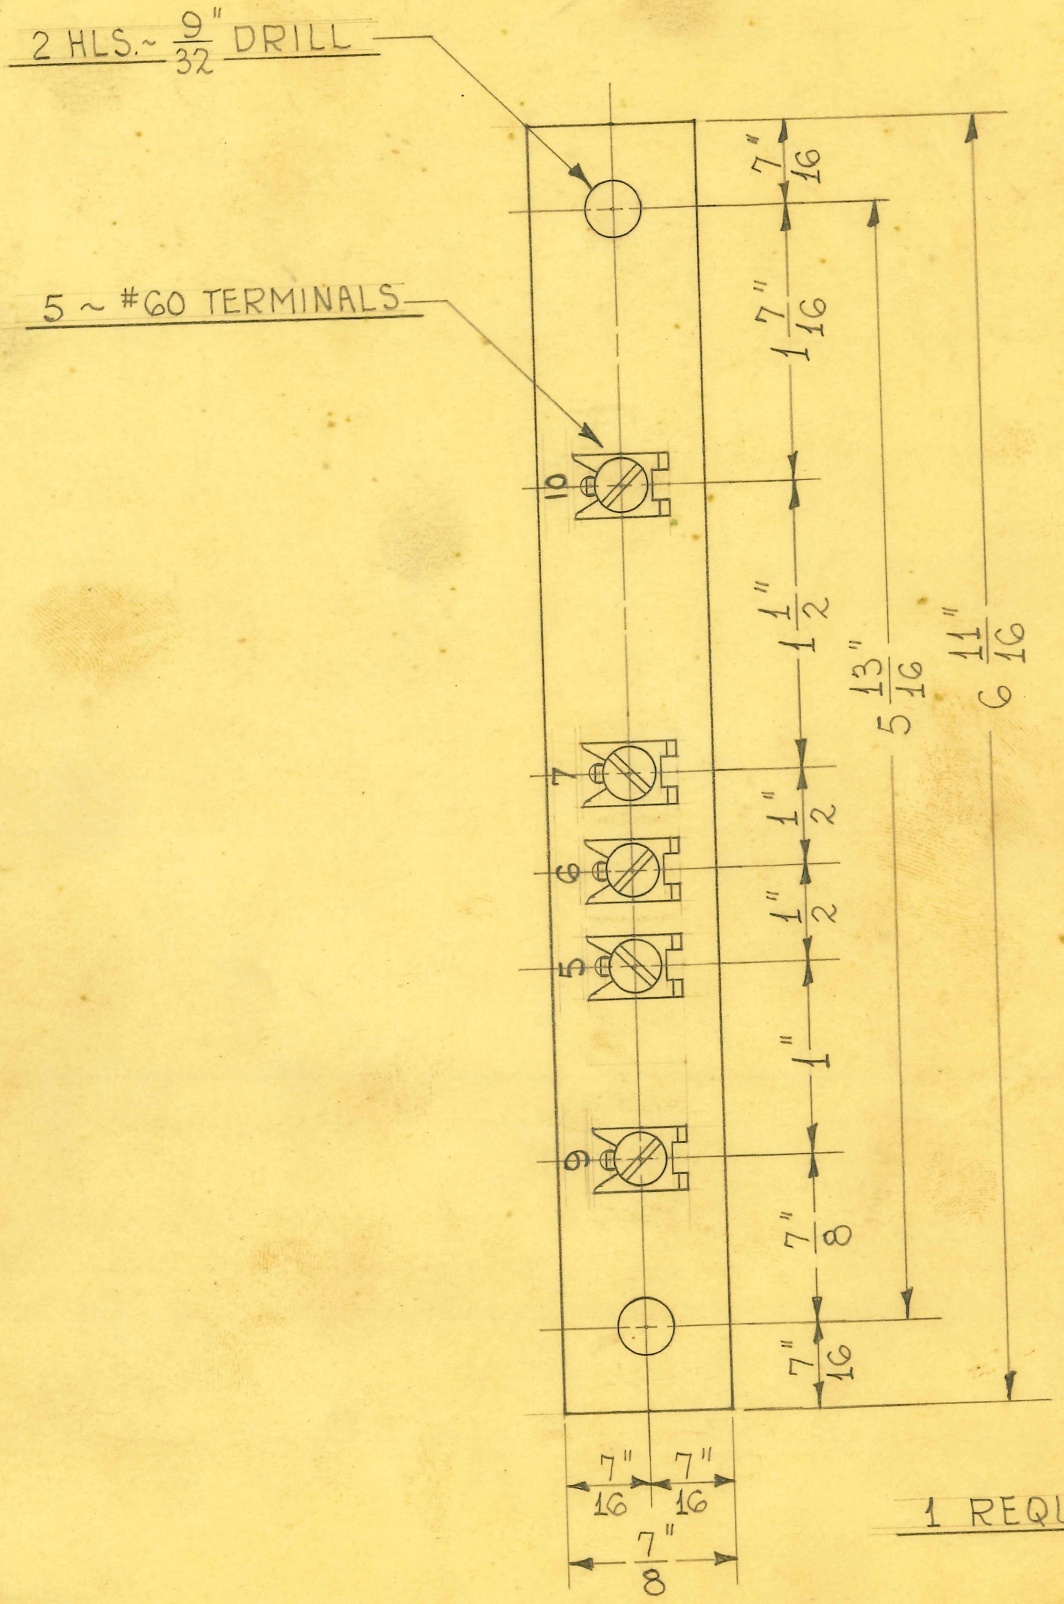

1 REQUIRED

SIZE	1/8" X 7/8"	ISSUE 9-14-45	HE.
KIND	XP BAKELITE	CHANGED	
SHAPE	STRIP	"	
FINISH		"	
TEMP.		"	
PATT.		"	

TITLE: FISCHER "FCW" SHORT WAVE OUTFIT- POWER TRANSF. TERMINAL STRIP (RIGHT)

H. G. FISCHER & CO.
2338 WABANSIA AVE.
CHICAGO. ILL.

CAT. NO.

PART NO. 16304G

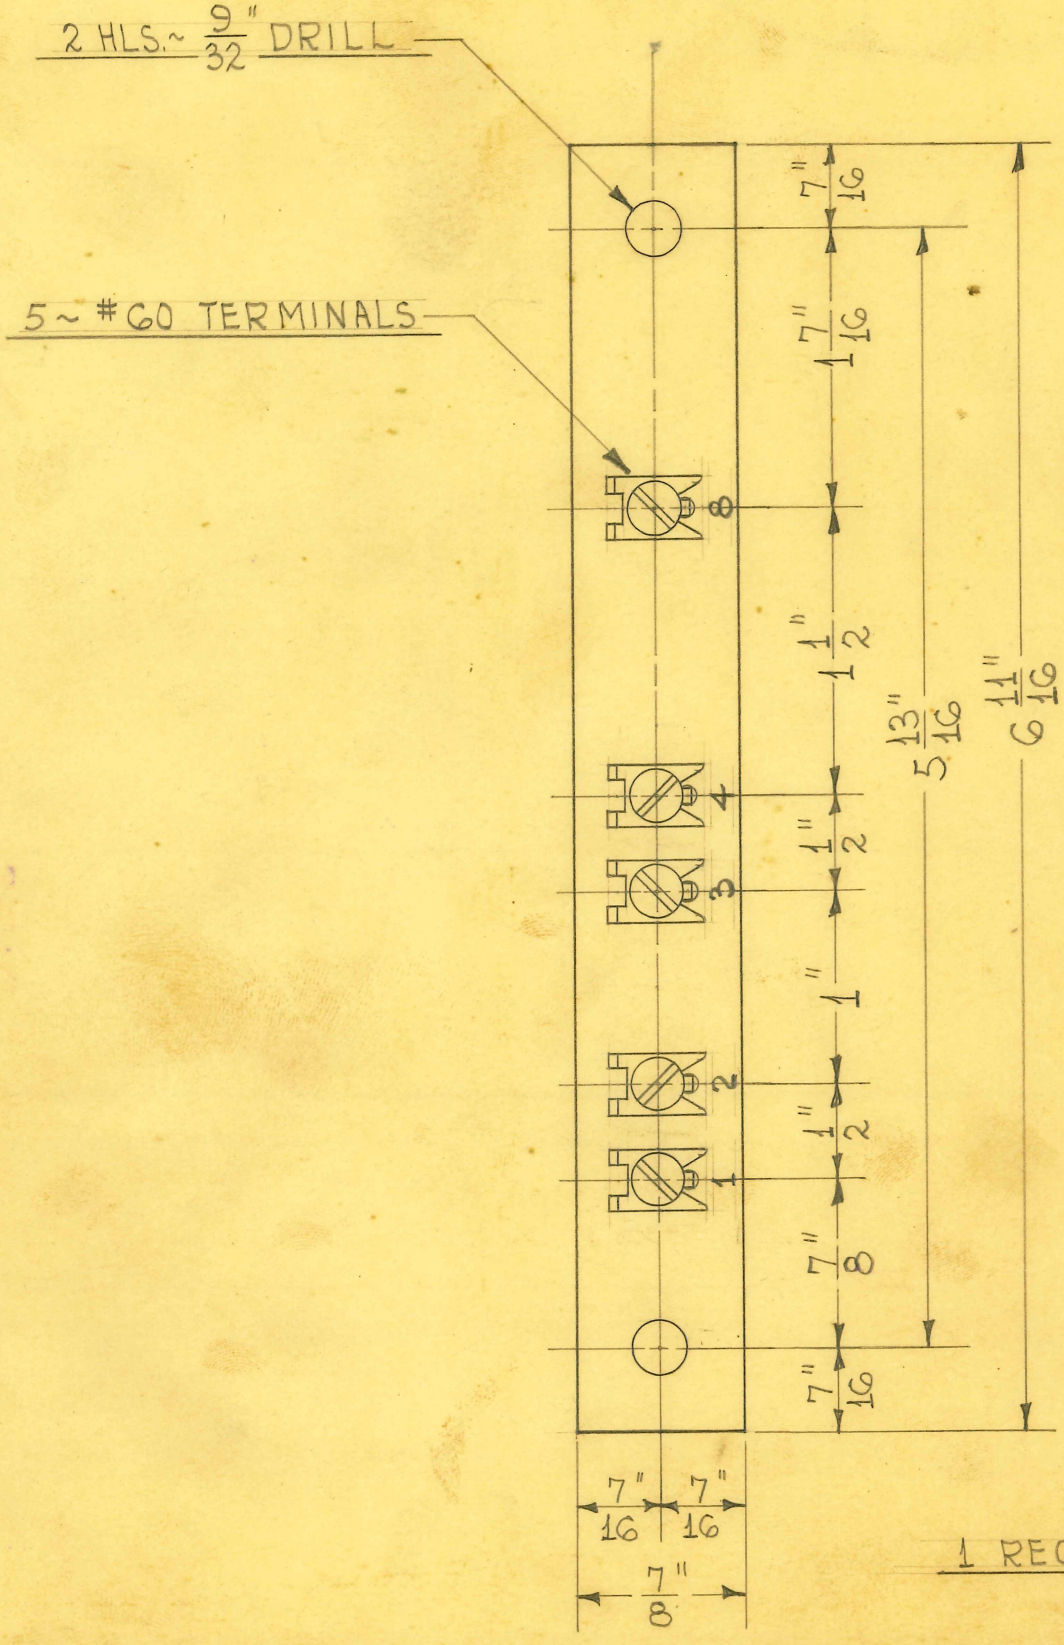

1 REQUIRED

SIZE	1/8" X 7/8"	ISSUE 9-14-45	HE.
KIND	XP BAKELITE	CHANGED	
SHAPE	STRIP	"	
FINISH		"	
TEMP.		"	
PATT.		"	

TITLE: FISCHER "FCW" SHORT WAVE OUTFIT~ POWER TRANSF. TERMINAL STRIP (LEFT)

H. G. FISCHER & CO.
2335 WABANSIA AVE.
CHICAGO, ILL.

CAT. NO.

PART NO. 163066

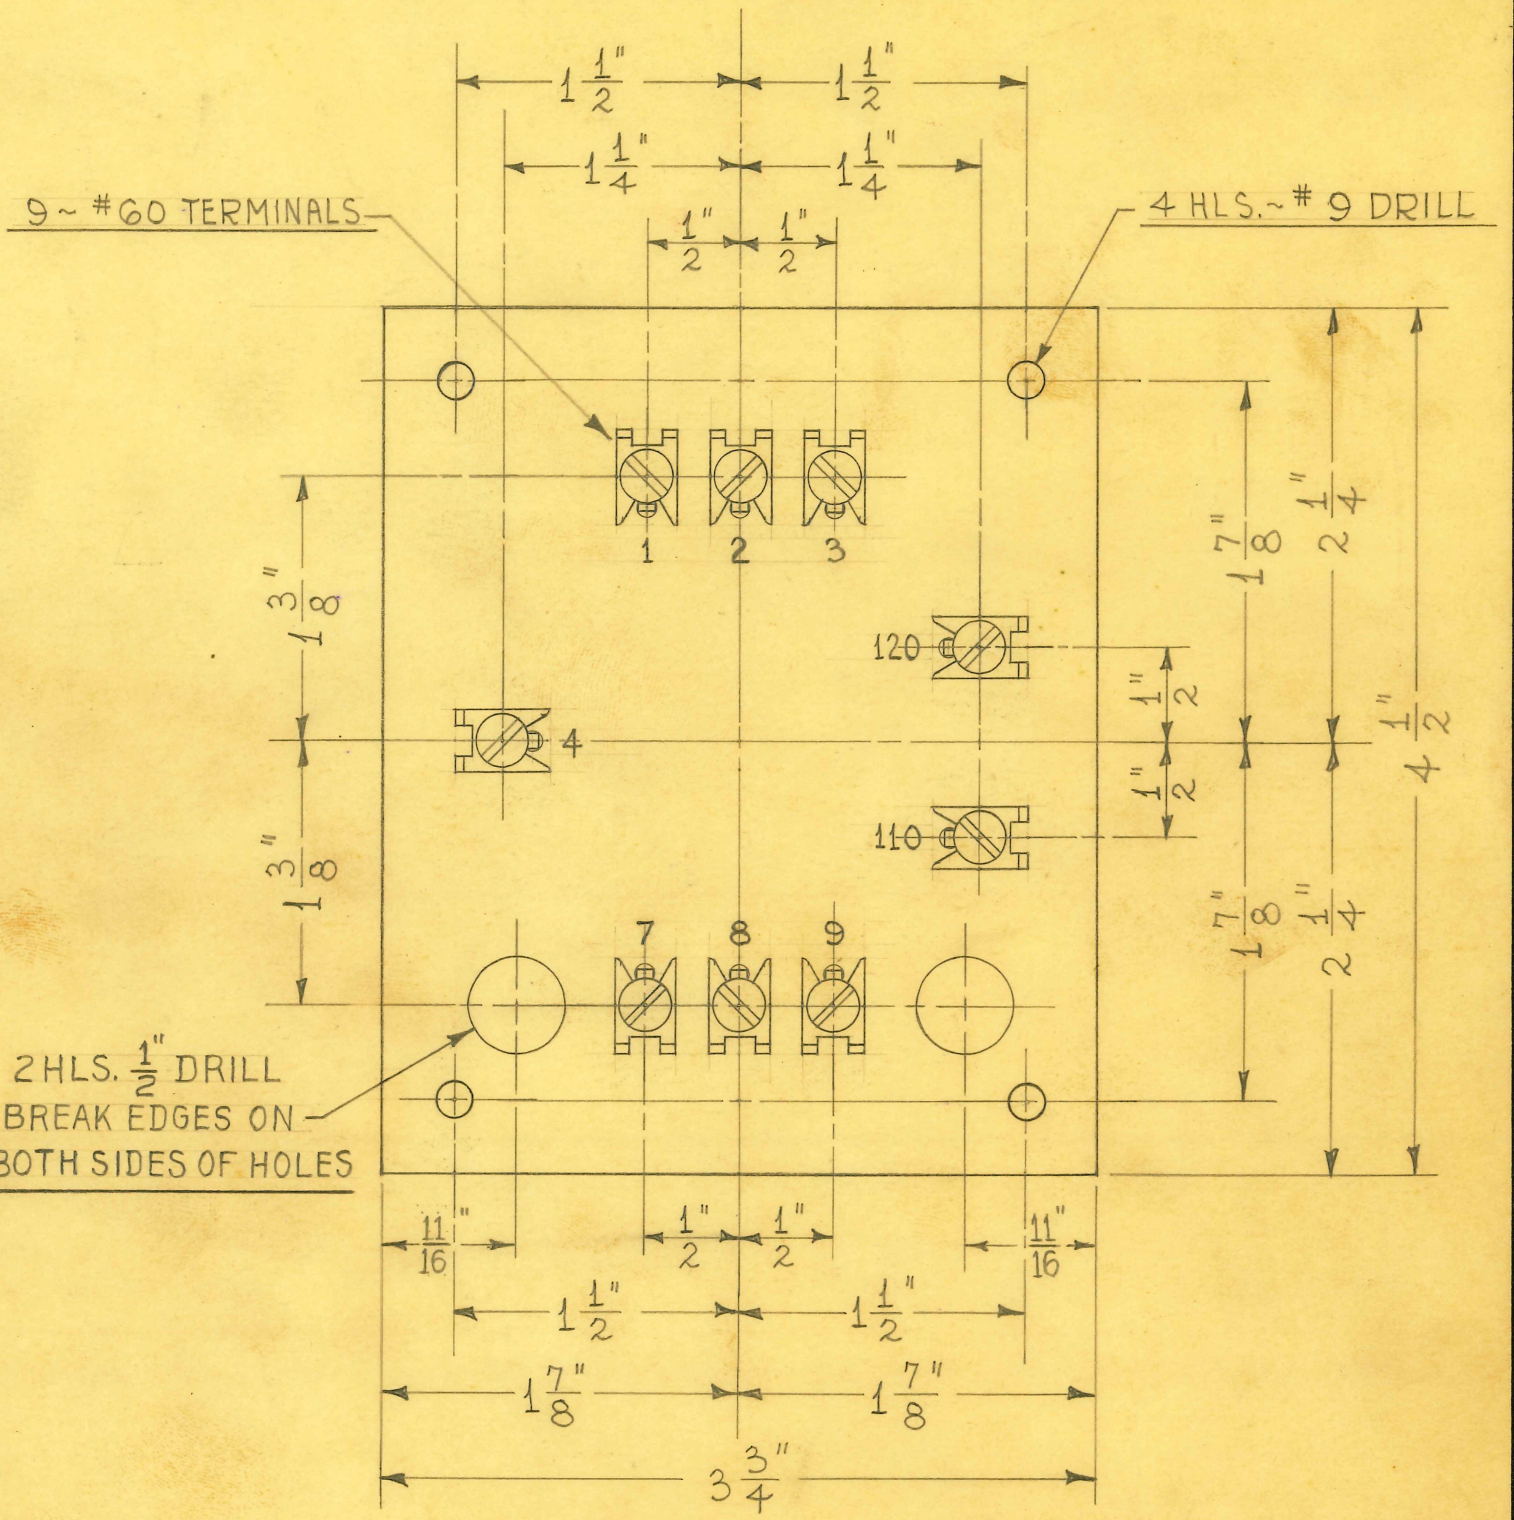

1- REQUIRED

SIZE	1/8"	ISSUE 9-14-45	HE
KIND	XP BAKELITE	CHANGED	
SHAPE	SHEET	" 5-12-48	J.B.G.
FINISH		"	
TEMP.		"	
PATT.		"	

TITLE: MOD."400" FISCHER "DELUXE DIATHERMY
FISCHER "FCW" SHORT WAVE OUTFIT~
FILAMENT TRANSF. TERMINAL BOARD

H. G. FISCHER & CO.
2335 WABANSIA AVE.
CHICAGO, ILL.

CAT. NO.

PART NO. 16311A

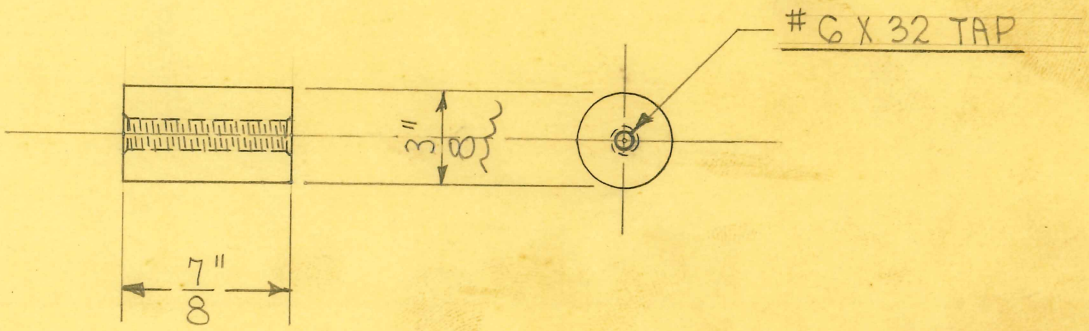

SIZE	3/8" DIAM.	ISSUE 9-28-45	HE.
KIND	BLK. BAKELITE	CHANGED	
SHAPE	ROD	per J. KOZINSKI 11-1-45	J.V.W.
FINISH		"	
TEMP.		"	
PATT.		"	

TITLE: FISCHER "FCW" SHORT WAVE OUTFIT- RECT. TUBE SOCKET SPACER

H. G. FISCHER & CO.
2335 WABANSIA AVE.
CHICAGO, ILL.

CAT. NO.

PART NO. 16312

TITLE
MODEL "400" FISCHER DELUXE DIA.
FARRADAY PICK UP LOOP TUBE - LONG FINISHED

H. G. FISCHER & CO.
FRANKLIN PARK, ILLINOIS

DATE 3-4-49 | DR. BY W.J. | CH'K'D. J.V.W.

PART NO. 16329

REVISION	DATE	BY

PATTERN | FINISH | SCALE FULL

TOOLS
RADIUS c'BORE # 11039

MATERIAL .250" O.D. X .030" WALL
SOFT COPPER TUBING

DIMENSIONS
FRACTIONAL ± .015
DECIMAL ± .005
ANGULAR ± ½°
UNLESS OTHERWISE SPECIFIED

2 REQUIRED

TRIM TO DIMENSION & ROUND EDGES INSIDE & OUT AS SHOWN - BOTH ENDS

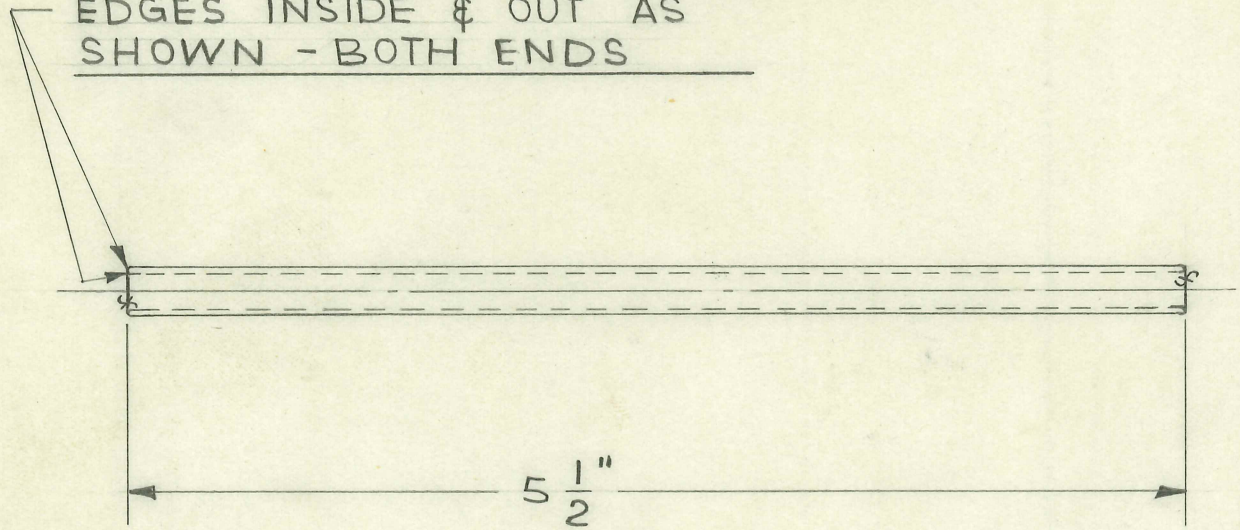

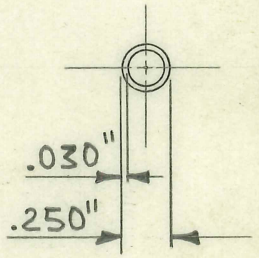

FOLDER # 128

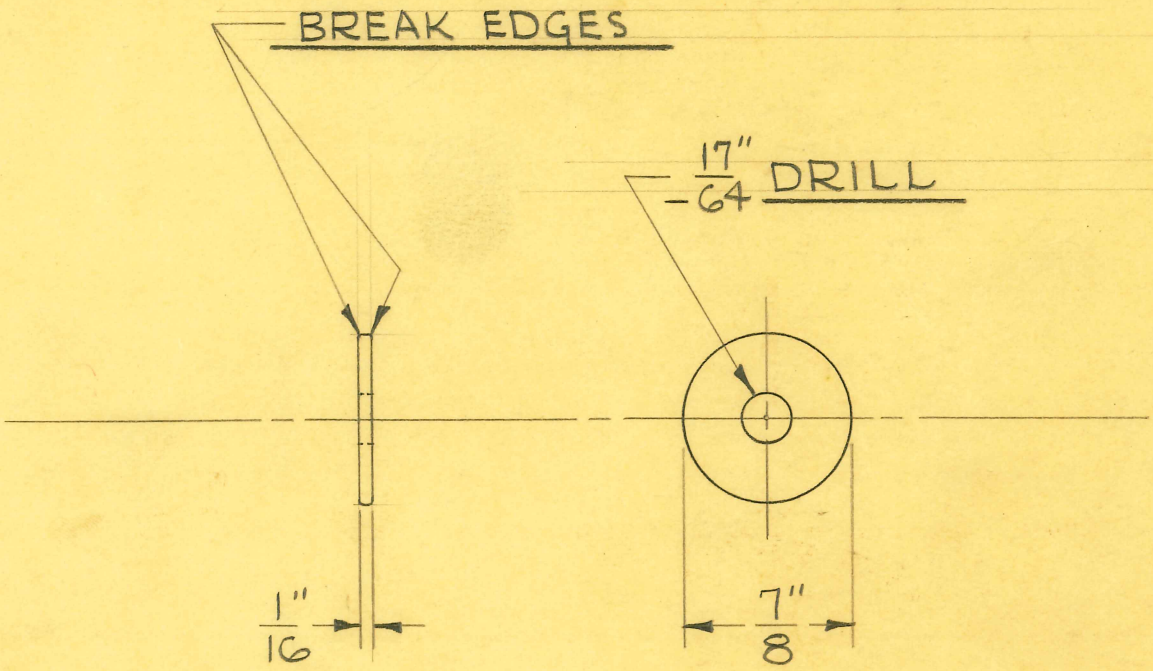

2 REQUIRED

SIZE	7/8" DIA.	ISSUE 2-1-46	J.V.W.
KIND	#17 S.T.	CHANGED	
SHAPE	ALUMINUM	"	
[redacted]	ROD	"	
TEMP.		"	
PATT.		"	

TITLE:
FISCHER "FCW" SHORT WAVE OUTFIT
1/4" ALUMINUM WASHER 7/8" O.D.

H. G. FISCHER & CO.
2335 WABANSIA AVE.
CHICAGO, ILL.

CAT. NO.

PART NO. 16331

TITLE
FISCHER MOD. "10" DIATHERMY
FARRADAY COIL TUBE - FINISHED

H. G. FISCHER & CO.
FRANKLIN PARK, ILLINOIS

PART NO. 16334

DATE 3-2-49 | DR. BY W.J. | CH'K'D J.V.W.

REVISION	DATE	BY

PATTERN | FINISH | SCALE FULL

TOOLS
FLATTENING DIE # 10090

MATERIAL ½" O.D. X #20 GA. (.035") WALL HARD DRAWN SEAMLESS COPPER TUBING

DIMENSIONS UNLESS OTHERWISE SPECIFIED
FRACTIONAL ± .015
DECIMAL ± .005
ANGULAR ± ½°

1 REQUIRED

TRIM TO DIMENSION & ROUND EDGES INSIDE & OUT AS SHOWN BOTH ENDS

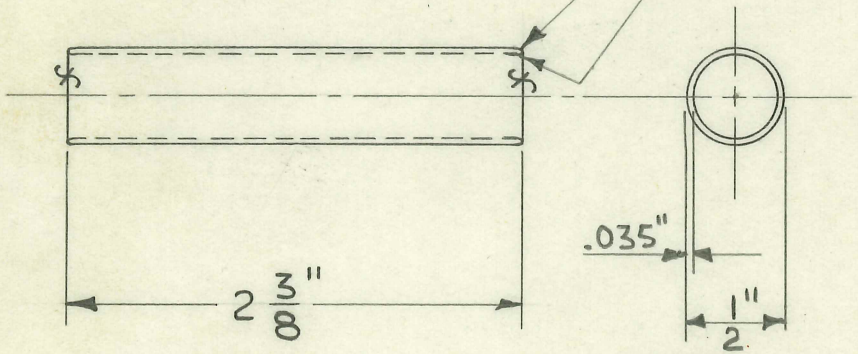

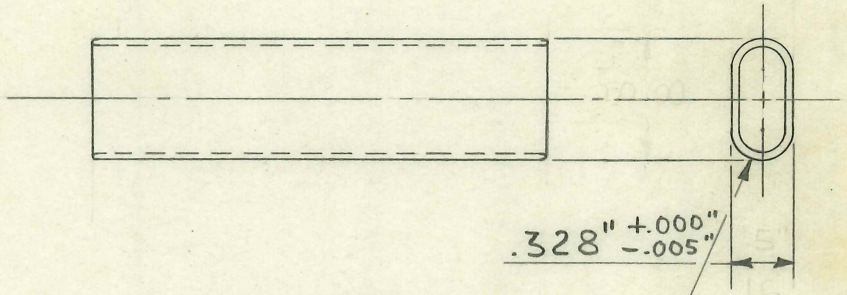

AFTER TRIMING & ROUNDING EDGES FLATTEN TO THIS SHAPE

FOLDER #132

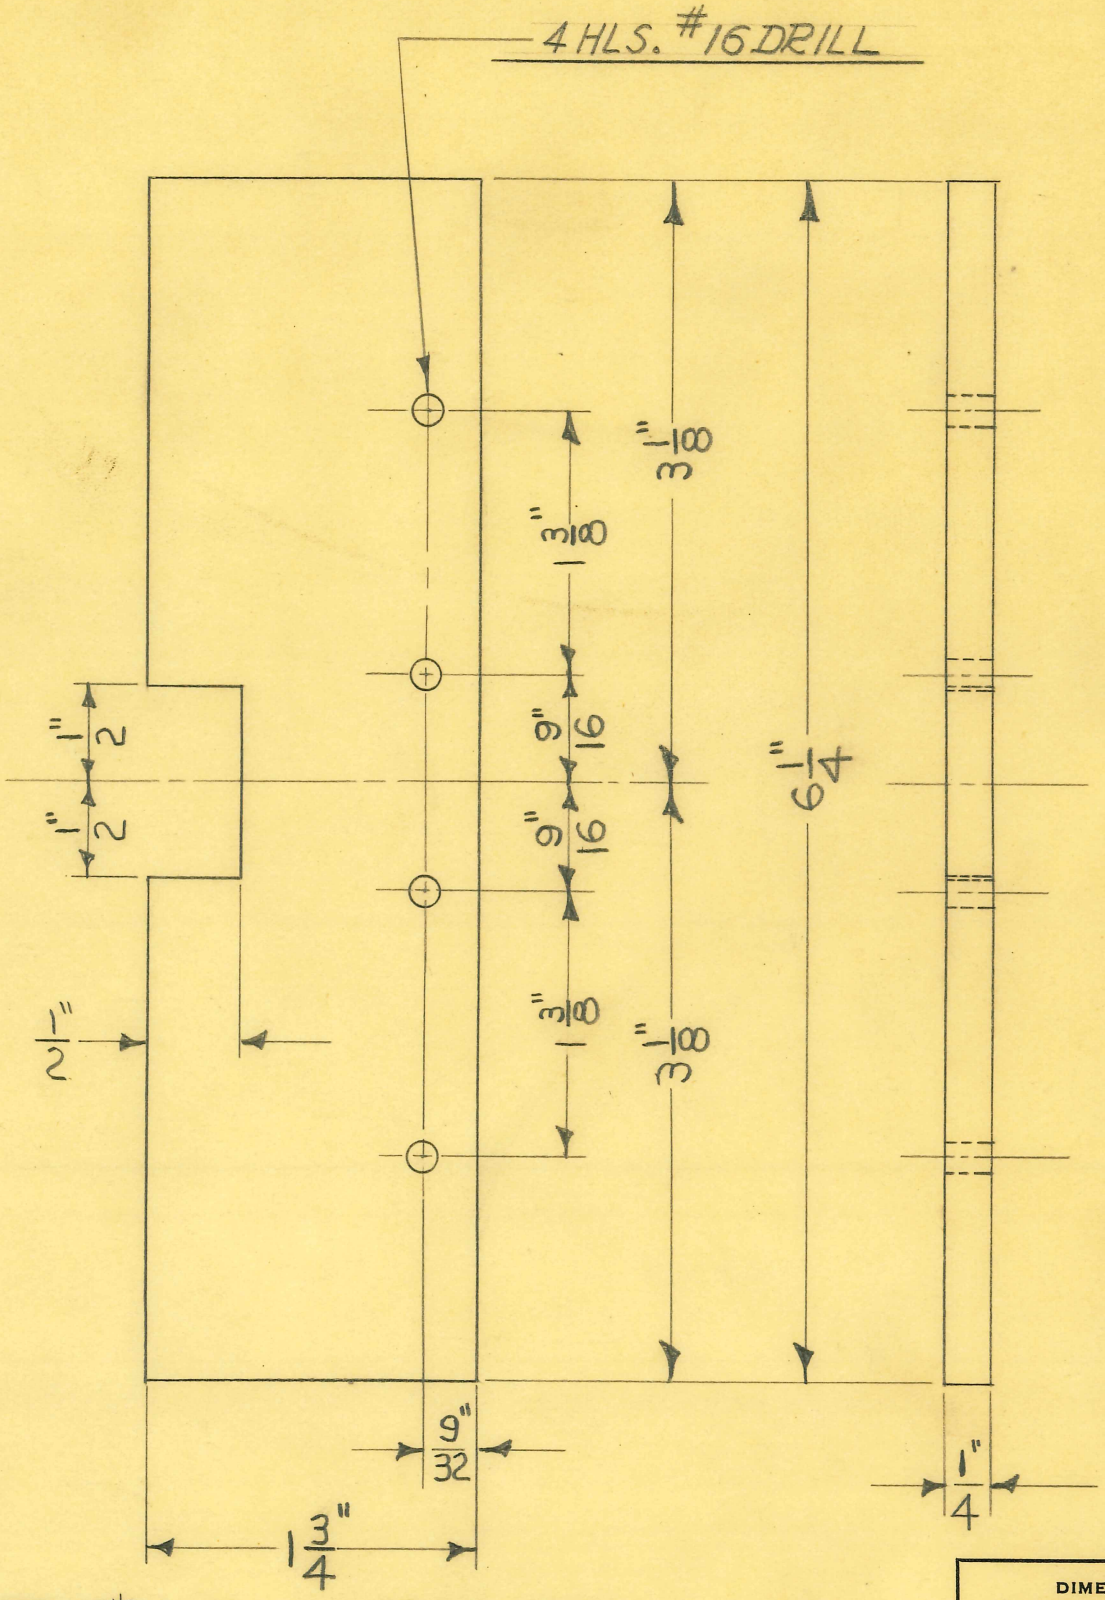

MILLING JAWS Tool #9682

1-REQUIRED

DIMENSIONS	
FRACTIONAL	± .015
DECIMAL	± .005
ANGULAR	± 1/2°

UNLESS OTHERWISE SPECIFIED

SIZE	MYKROY	ISSUE 1-28-48	JF
KIND		CHANGED	
SHAPE		"	
FINISH		"	
TEMP.		"	
PATT.		"	

TITLE:
MODEL "400" FISCHER DELUXE DIATHERMY
PICKUP COIL INSULATING BOARD

H. G. FISCHER & CO.
2335 WABANSIA AVE.
CHICAGO, ILL.

CAT. NO.

PART NO. 16355

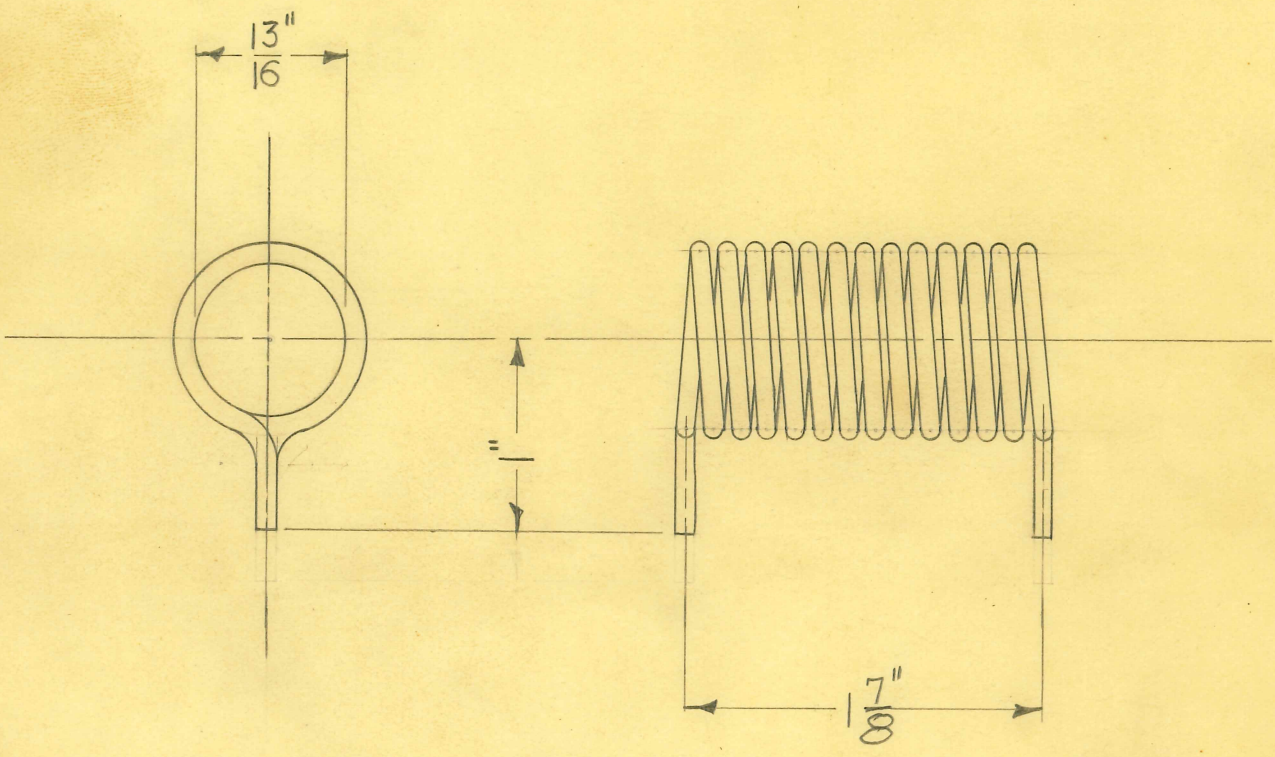

13 TURNS

2-REQUIRED

DEVELOPED LENGTH = 39"
MANDREL PCE.# 16272 A
BENDING FIX. TOOL # 9011

DIMENSIONS	
FRACTIONAL	± .015
DECIMAL	± .005
ANGULAR	± 1/2°

UNLESS OTHERWISE SPECIFIED

SIZE	#10 TINNED	ISSUE 12-3-47	J.M.F
KIND	COPPER WIRE	CHANGED	
SHAPE		"	
FINISH		"	
TEMP.		"	
PATT.		"	

TITLE: MODEL 400 FISCHER DELUXE DIATHERMY – PATIENTS TUNING COIL

H. G. FISCHER & CO.
2335 WABANSIA AVE.
CHICAGO, ILL.

CAT. NO.

PART NO. 16356

TITLE	H. G. FISCHER & CO.	PART NO.
MODEL 400 DELUXE DIATHERMY PARALLEL TUNING COIL	FRANKLIN PARK, ILLINOIS	16357 B
	DATE 10-13-52 DR BY W.J. CH'K'D, J.V.W.	REVISION / DATE / BY
PATTERN / FINISH / SCALE FULL	DIMENSIONS: FRACTIONAL ± .015; DECIMAL ± .005; ANGULAR ± ½°; UNLESS OTHERWISE SPECIFIED	
TOOLS MANDRELL #9023 FORMING FIX. #9999	MATERIAL # 8 BARE COPPER WIRE	

1 REQUIRED

DEVELOPED LENGTH =

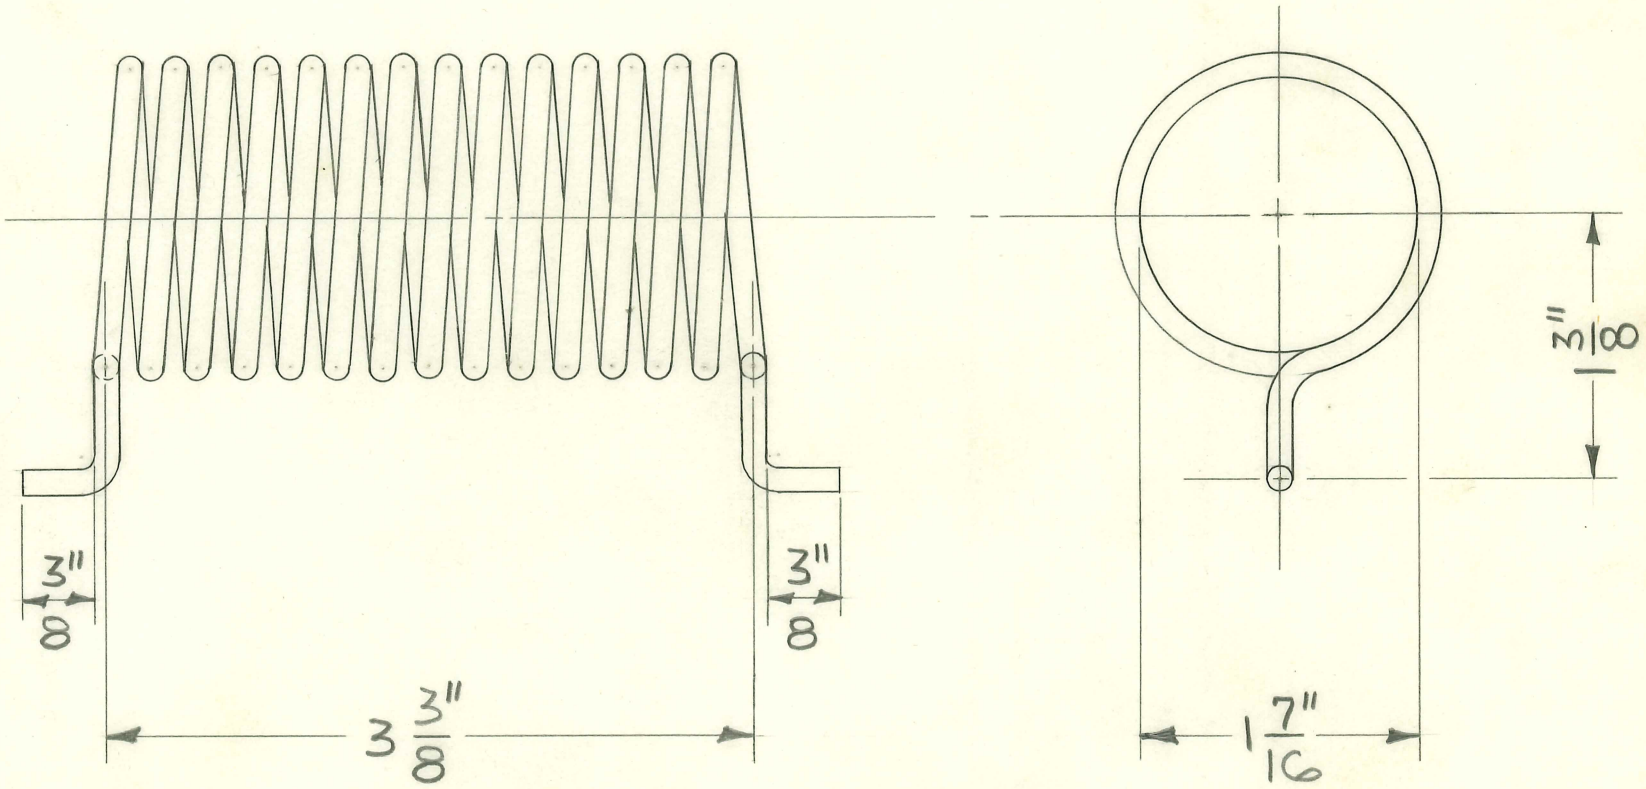

14 TURNS

FOLDER #128

TITLE
MODEL "400" FISCHER DELUXE DIA.
OSCILLATING COIL CONNECTION

H. G. FISCHER & CO.
FRANKLIN PARK, ILLINOIS

PART NO. 16361AF

DATE 4-5-49 | DR. BY W.J. | CH'K'D. J.V.W.

REVISION	DATE	BY
A WAS FINISHED PATTERN CHANGED	3-13-51	J.V.W.

PATTERN 2312 | FINISH | SCALE FULL

TOOLS SANDING GAGE #9710
VISE JAWS #11,033

MATERIAL
CAST IN BRASS

DIMENSIONS UNLESS OTHERWISE SPECIFIED
FRACTIONAL ± .015
DECIMAL ± .005
ANGULAR ± ½°

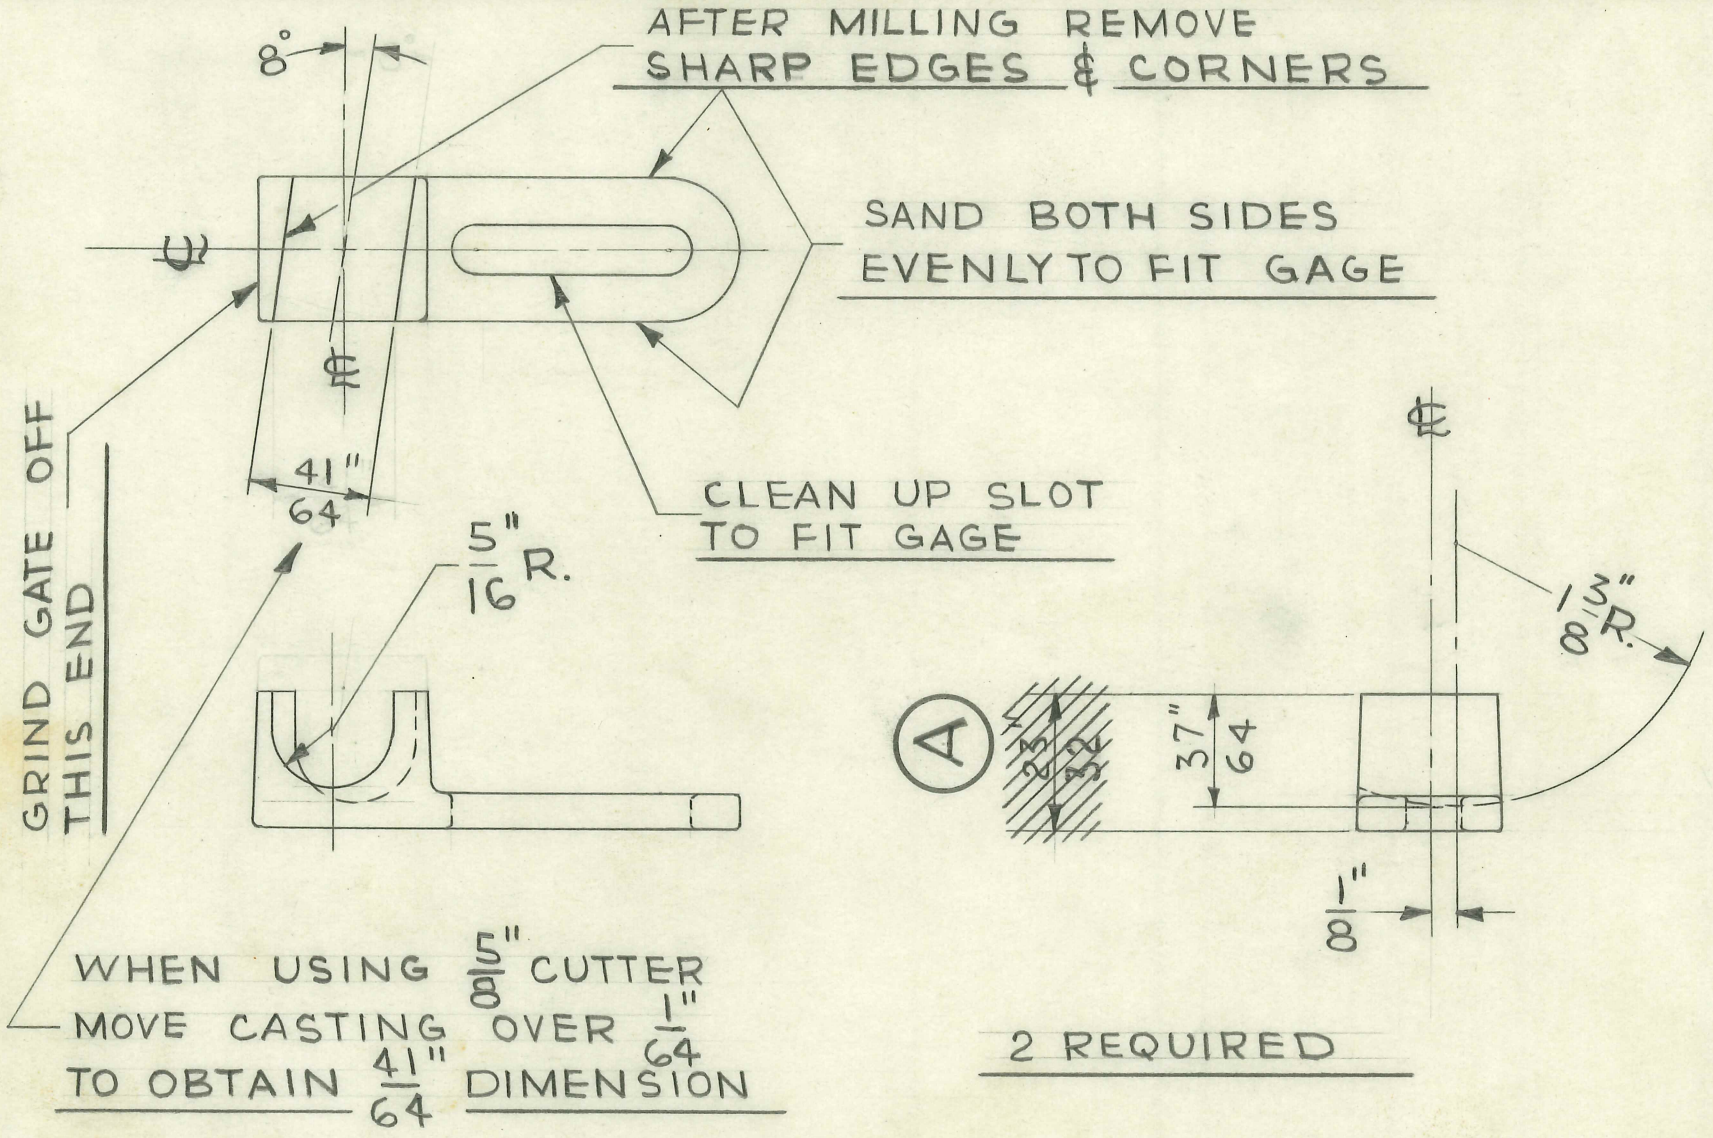

FOLDER #128

TITLE

FISCHER MOD. 400 DELUXE DIATHERMY

KEEPER STRIP

H. G. FISCHER & CO.
FRANKLIN PARK, ILLINOIS

DATE 10-6-50 | DR. BY W. J. | CH'K'D J.V.W.

PART NO. 16363

REVISION	DATE	BY

PATTERN | FINISH | SCALE FULL

TOOLS: CUT OFF & PERF. DIE # 721 Y-5

MATERIAL: 1/8" X 1/2" HARD C.R. STEEL

DIMENSIONS UNLESS OTHERWISE SPECIFIED

FRACTIONAL	± .015
DECIMAL	± .005
ANGULAR	± ½°

4 REQUIRED

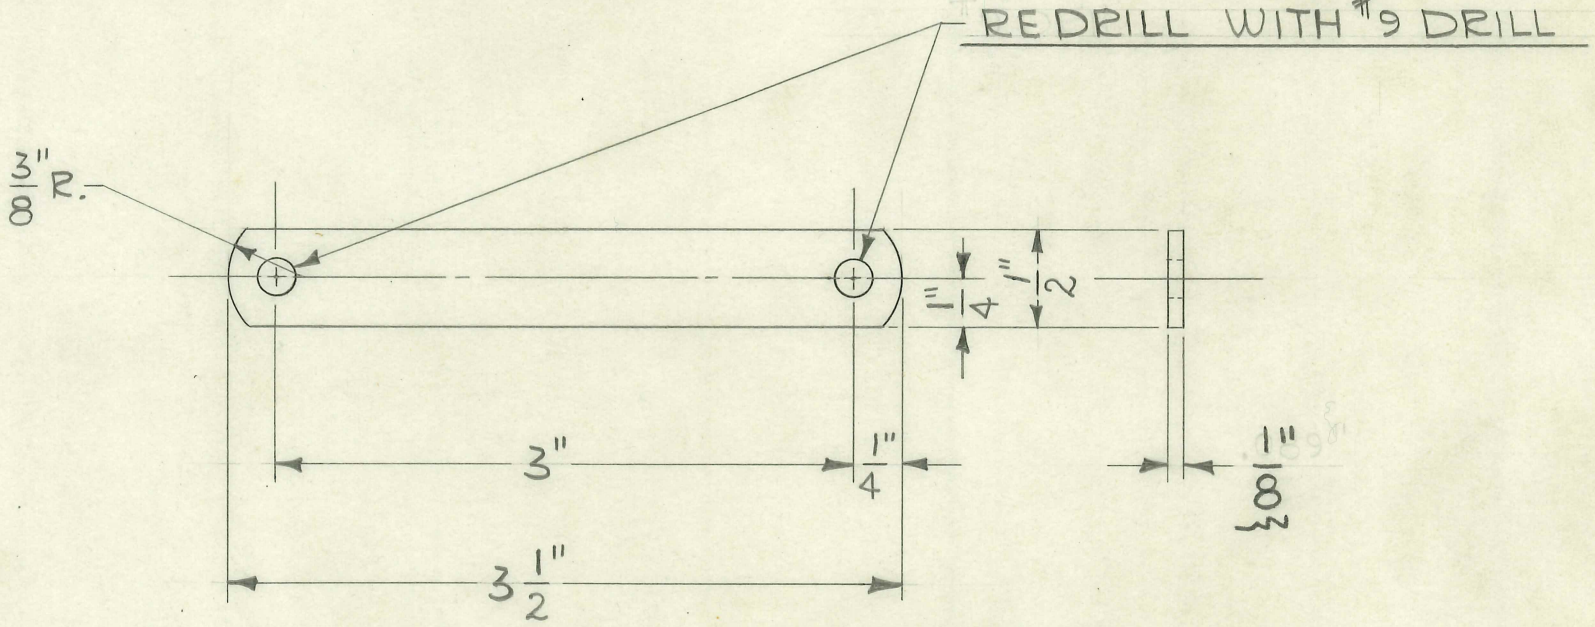

FOLDER # 128

TITLE
FISCHER MOD. "400" DELUXE DIATHERMY
JUNCTION RECEPTACLE INSULATOR

H. G. FISCHER & CO.
FRANKLIN PARK, ILLINOIS

PART NO. 16368

DATE 12-28-48 DR. BY J.V.W. CH'K'D.

REVISION	DATE	BY

PATTERN | FINISH | SCALE FULL

TOOLS: DRILL JIG TOOL #10040

MATERIAL: 1/16" SHEET BLACK FIBRE

DIMENSIONS UNLESS OTHERWISE SPECIFIED
FRACTIONAL ± .015
DECIMAL ± .005
ANGULAR ± ½°

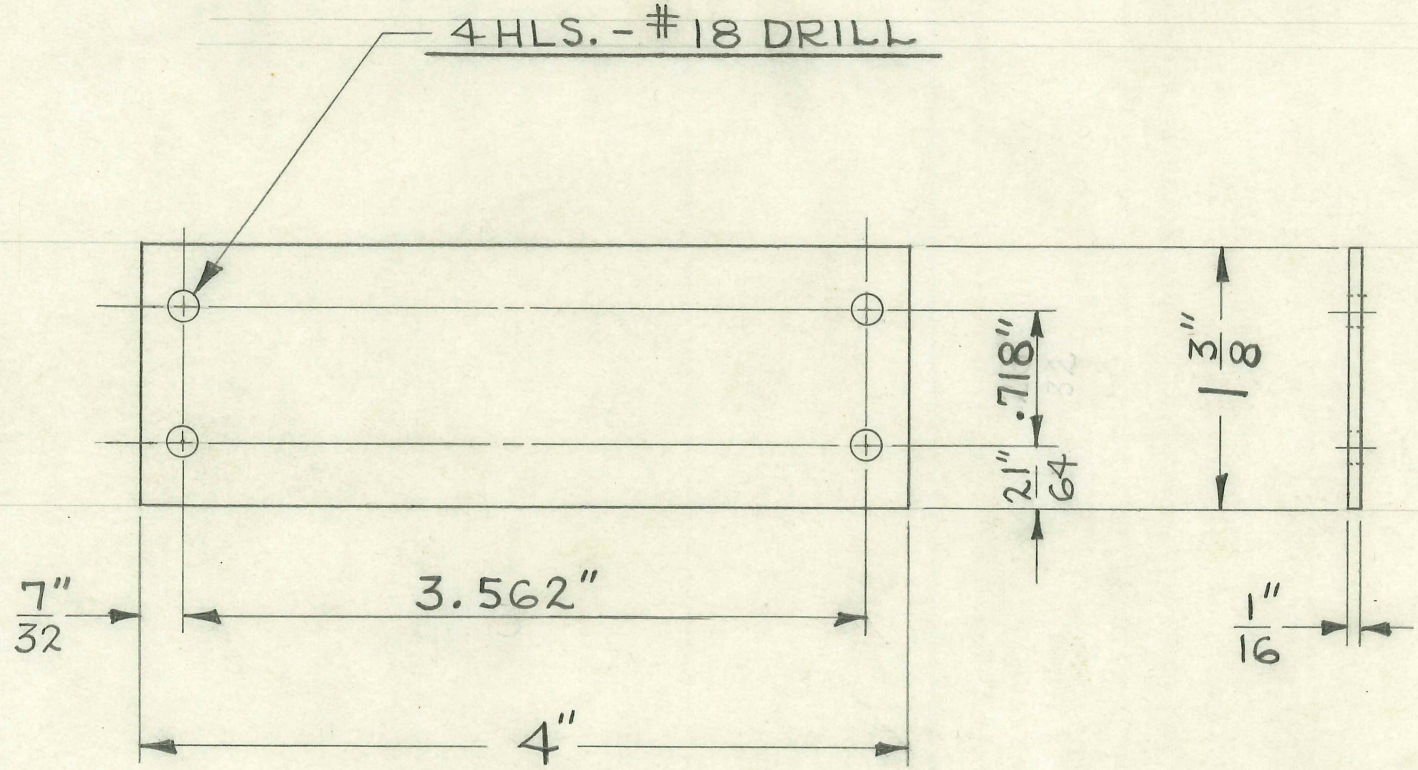

1 REQUIRED

FOLDER #128

TITLE

FISCHER MOD. "400" DIATHERMY LEAD-IN BUSHING CONTACTOR

H. G. FISCHER & CO.
FRANKLIN PARK, ILLINOIS

PART NO. 16369

DATE 4-13-49 | DR. BY W. J. | CH'K'D. J.V.W.

REVISION	DATE	BY

PATTERN | FINISH | SCALE FULL

TOOLS

MATERIAL
5/16" O.D. X 1/4" I.D. BRASS TUBING

DIMENSIONS
FRACTIONAL ± .015
DECIMAL ± .005
ANGULAR ± ½°
UNLESS OTHERWISE SPECIFIED

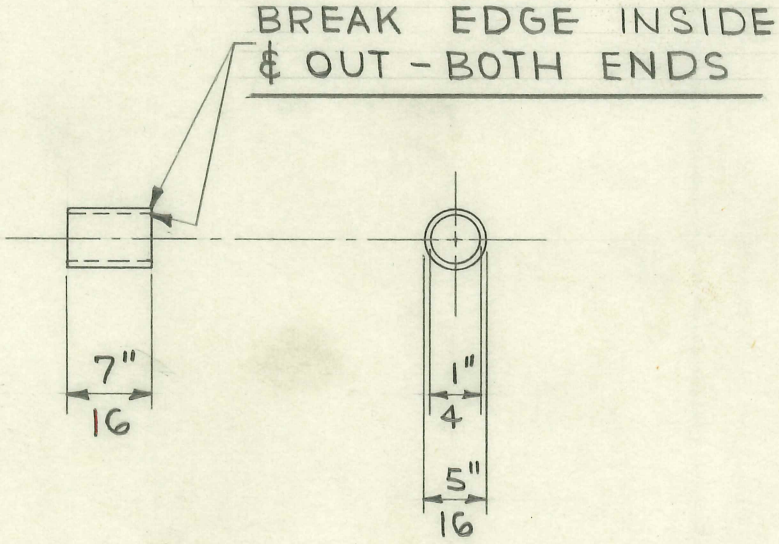

1 REQUIRED

FOLDER #128

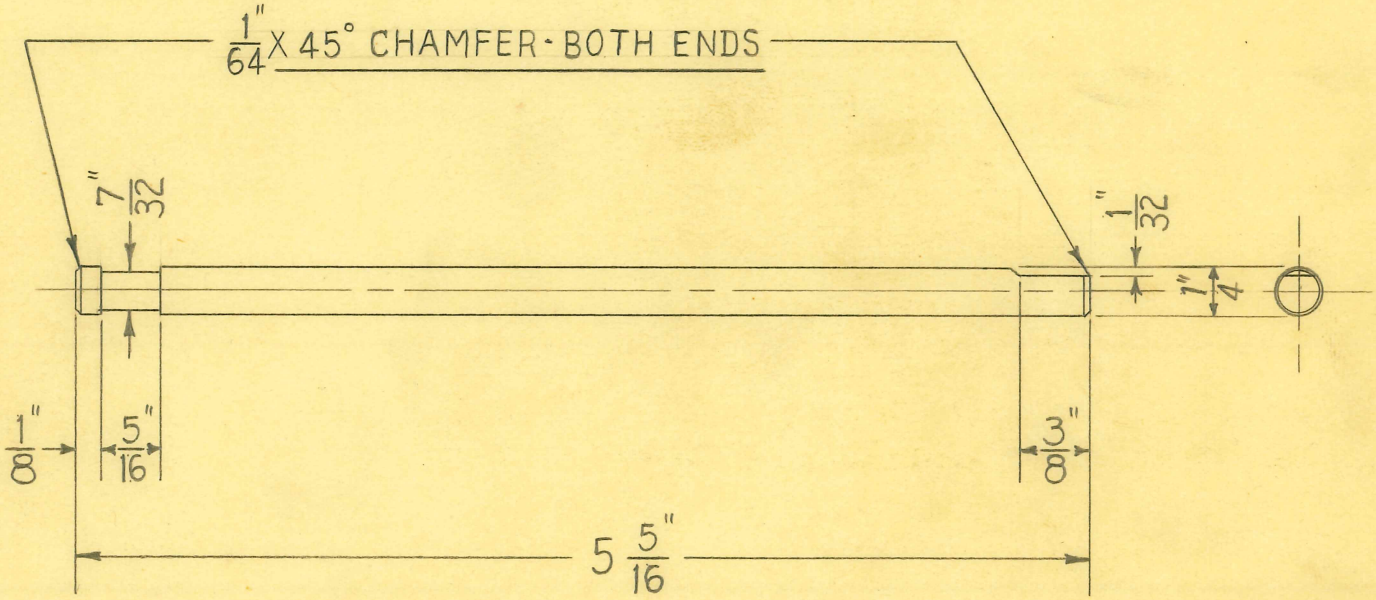

1 - REQUIRED

DIMENSIONS	
FRACTIONAL	± .015
DECIMAL	± .005
ANGULAR	± 1/2°

UNLESS OTHERWISE SPECIFIED

SIZE	1/4" DIA.	ISSUE 5-26-48	J.B.G.
KIND	C.R. STEEL	CHANGED	
SHAPE	ROD	"	
FINISH	CAD. #23	"	
TEMP.		"	
PATT.		"	

TITLE:
MODEL "400" FISCHER DELUXE DIATHERMY
TUNING CONDENSER EXTENSION SHAFT

H. G. FISCHER & CO.
2335 WABANSIA AVE.
CHICAGO, ILL.

CAT. NO.

PART NO. 16376A

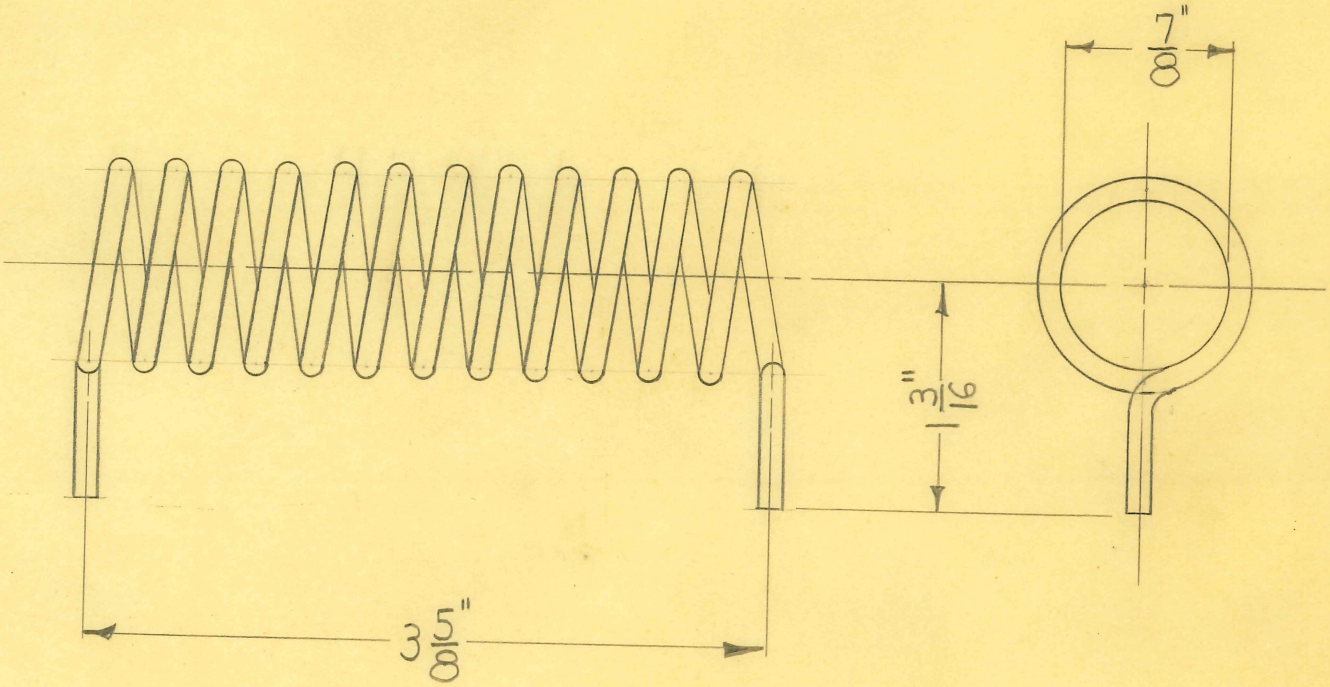

12 TURNS

1-REQUIRED

DEVELOPED LENGTH 39 1/2" LONG

MANDRELL PCE. # 16268

DIMENSIONS	
FRACTIONAL	± .015
DECIMAL	± .005
ANGULAR	± 1/2°

UNLESS OTHERWISE SPECIFIED

SIZE	#10 TINNED	ISSUE 12-11-47	J.M.F
KIND	COPPER WIRE	CHANGED	
SHAPE		"	
FINISH		"	
TEMP.		"	
PATT.		"	

TITLE: MODEL "400" FISCHER DELUXE DIATHERMY GRID COIL

H. G. FISCHER & CO.
2335 WABANSIA AVE.
CHICAGO, ILL.

CAT. NO.

PART NO. 16381

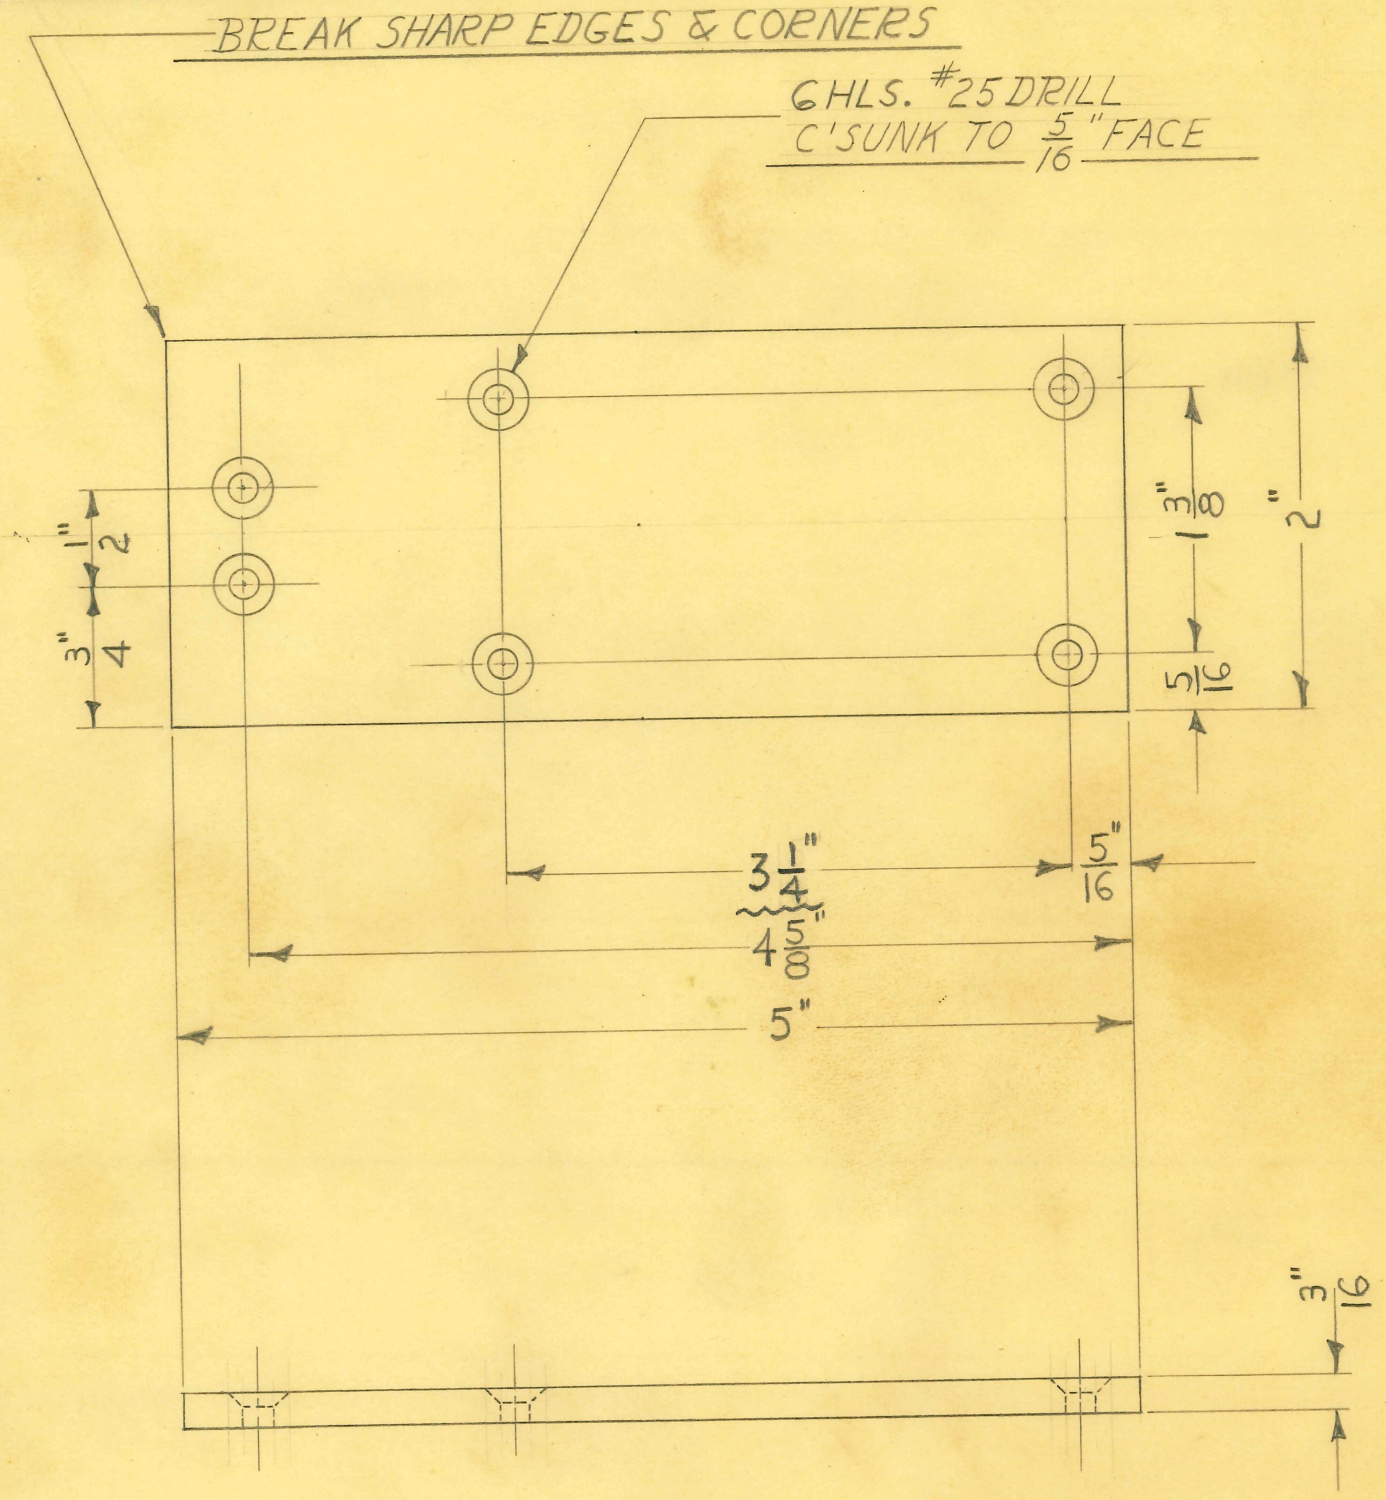

1-REQUIRED

DIMENSIONS	
FRACTIONAL	± .015
DECIMAL	± .005
ANGULAR	± 1/2°

UNLESS OTHERWISE SPECIFIED

3/16" SHEET BLACK BAKELITE XX - DRILL JIG TOOL # 9605

SIZE		ISSUE 12-11-47	J.M.F
KIND		CHANGED	
SHAPE		" 11-5-48	J.V.W.
FINISH		"	
TEMP.		"	
PATT.		"	

TITLE: MODEL "400" FISCHER DELUXE DIATHERMY PLATE CONTACT SUPPORT

H. G. FISCHER & CO.
2335 WABANSIA AVE.
CHICAGO, ILL.

CAT. NO.

PART NO. 16382A

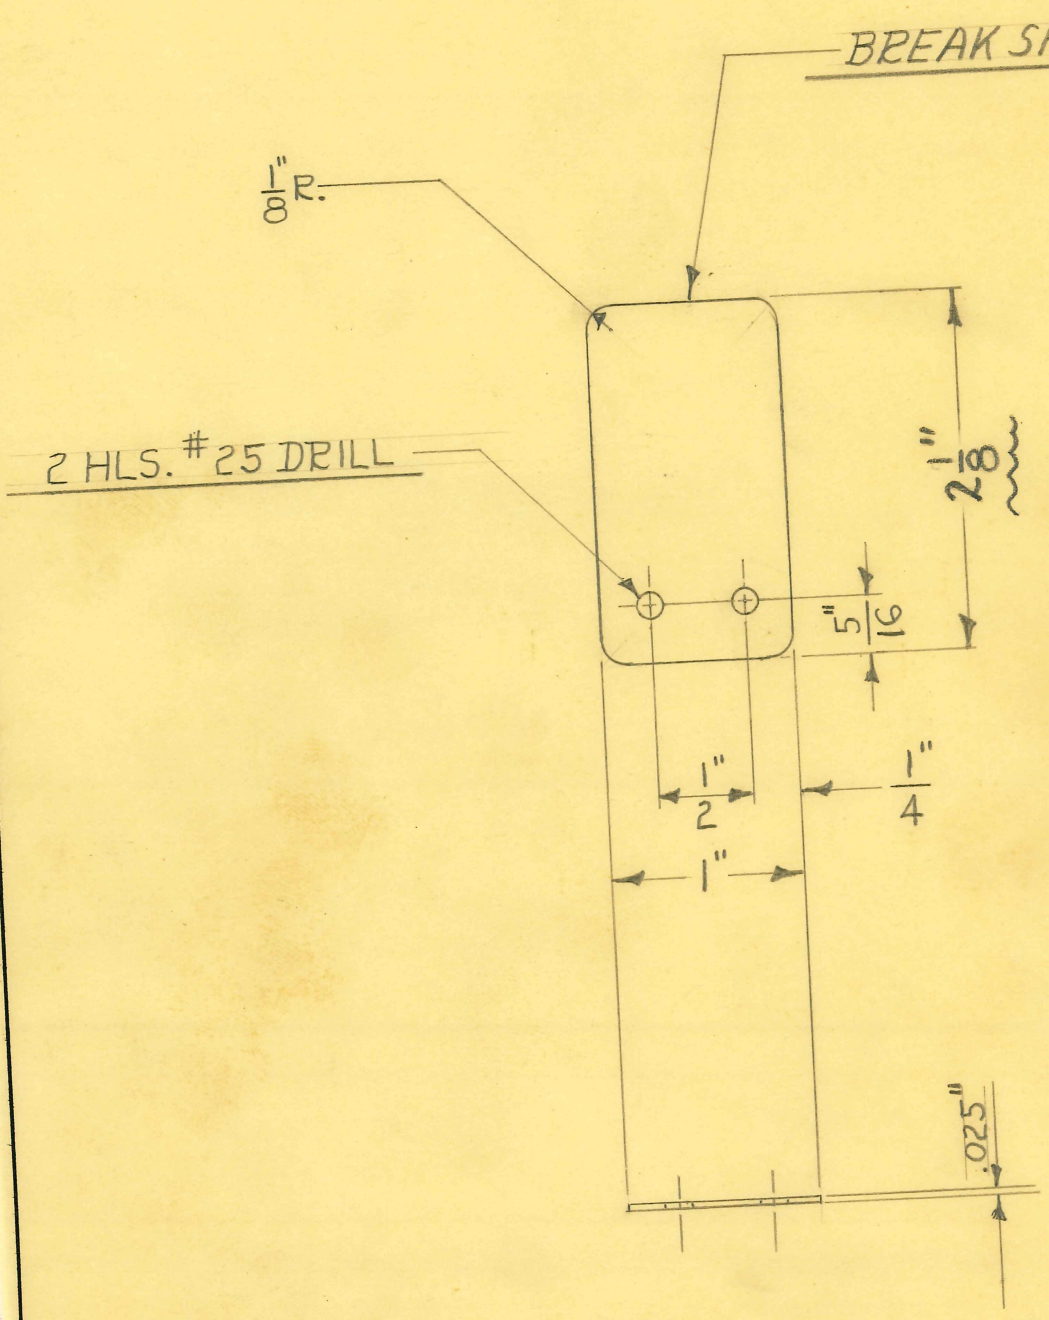

1-REQUIRED

DRILL JIG TOOL # 9604
#22 GA. (.025") SHEET PHOS. BRONZE

DIMENSIONS	
FRACTIONAL	± .015
DECIMAL	± .005
ANGULAR	± 1/2°

UNLESS OTHERWISE SPECIFIED

SIZE		ISSUE 12-11-47	J.M.F
KIND		CHANGED	
SHAPE		" 11-5-48	J.V.W.
FINISH		"	
TEMP.		"	
PATT.		"	

TITLE: MODEL "400" FISCHER DELUXE DIATHERMY
CONTACT PLATE

H. G. FISCHER & CO.
2335 WABANSIA AVE.
CHICAGO, ILL.

CAT. NO.

PART NO. 16383A

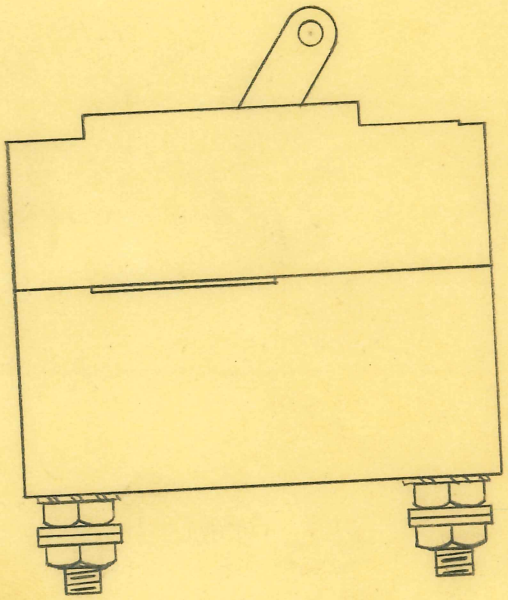

CAT. NO. AM12 NO COIL

HEINEMAN CIRCUIT BREAKER CO. TRENTON N. J.

DIMENSIONS	
FRACTIONAL	± .015
DECIMAL	± .005
ANGULAR	± 1/2°

UNLESS OTHERWISE SPECIFIED

SIZE		ISSUE 2-23-48	J.V.W.
KIND		CHANGED	
SHAPE		"	
FINISH		"	
TEMP.		"	

TITLE: MODEL "400" FISCHER DELUXE DIATHERMY
LINE SWITCH

H. G. FISCHER & CO.
2335 WABANSIA AVE.
CHICAGO, ILL.

CAT. NO.

PART NO. 16384

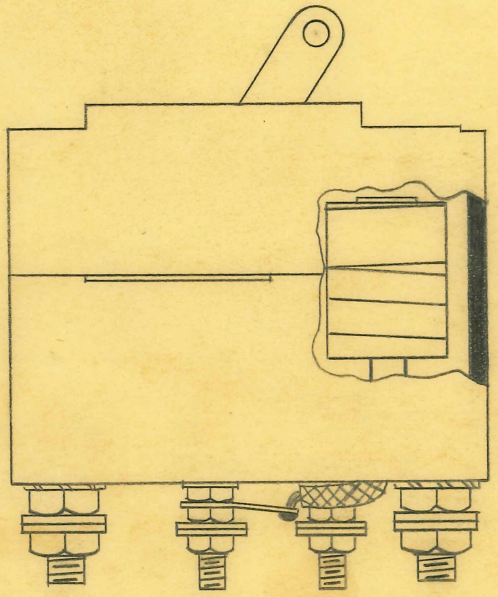

CAT. NO. ~~AM1 RS~~ PM 12 RSK

6 V. DC.

BATTERY CURRENT

TRIPPING RANGE
485 TO 560 M.A.–D.C.

~~TRIP AMPS 0.4 DCXXX~~

CONTACTS 110 V. AC.

HEINEMAN CIRCUIT BREAKER CO. TRENTON N. J.

DIMENSIONS	
FRACTIONAL	± .015
DECIMAL	± .005
ANGULAR	± 1/2°

UNLESS OTHERWISE SPECIFIED

SIZE		ISSUE 2-20-48	J.V.W.
KIND		CHANGED	
SHAPE		J.K. " 10-28-48	J.V.W.
FINISH		" 11-4-48	I.S.
TEMP.		"	
PATT.		"	

TITLE: MODEL "400" FISCHER DELUXE DIATHERMY CIRCUIT BREAKER

H. G. FISCHER & CO.
2335 WABANSIA AVE.
CHICAGO, ILL.

CAT. NO.

PART NO. 16385

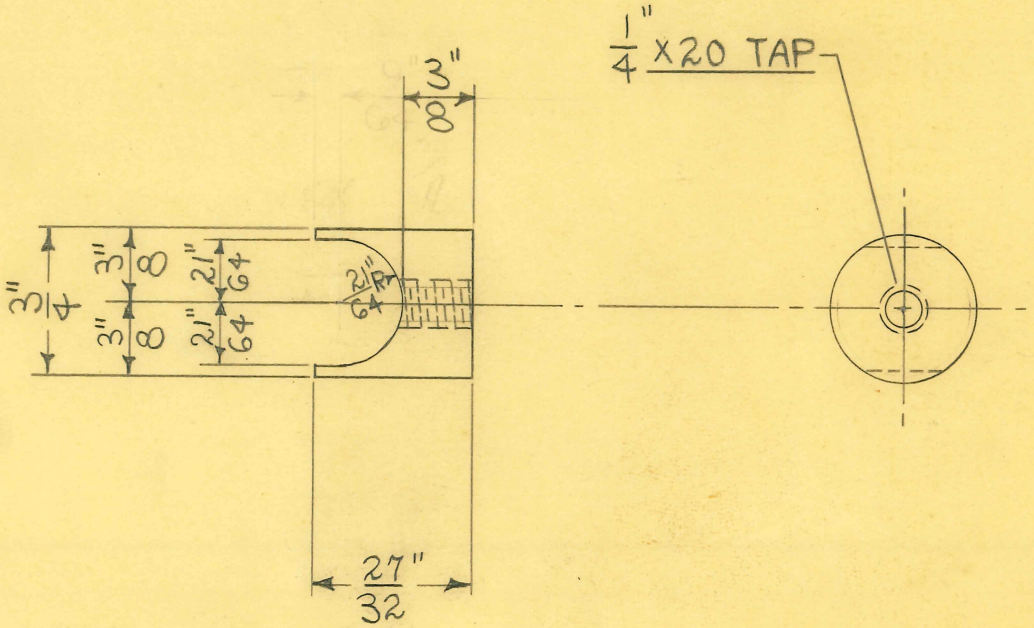

1 REQUIRED

MILLING FIXTURE TOOL # 9609

DIMENSIONS	
FRACTIONAL	± .015
DECIMAL	± .005
ANGULAR	± 1/2°

UNLESS OTHERWISE SPECIFIED

SIZE	3/4" DIA.	ISSUE 12-6-47	W.J.
KIND	BRASS	CHANGED	
SHAPE	ROD	"	
FINISH		"	
TEMP.		"	
PATT.		"	

TITLE: MODEL "400" FISCHER DELUXE DIATHERMY OSCILLATING COIL CENTER SUPP.

H. G. FISCHER & CO.
2335 WABANSIA AVE.
CHICAGO, ILL.

CAT. NO.

PART NO. 16388

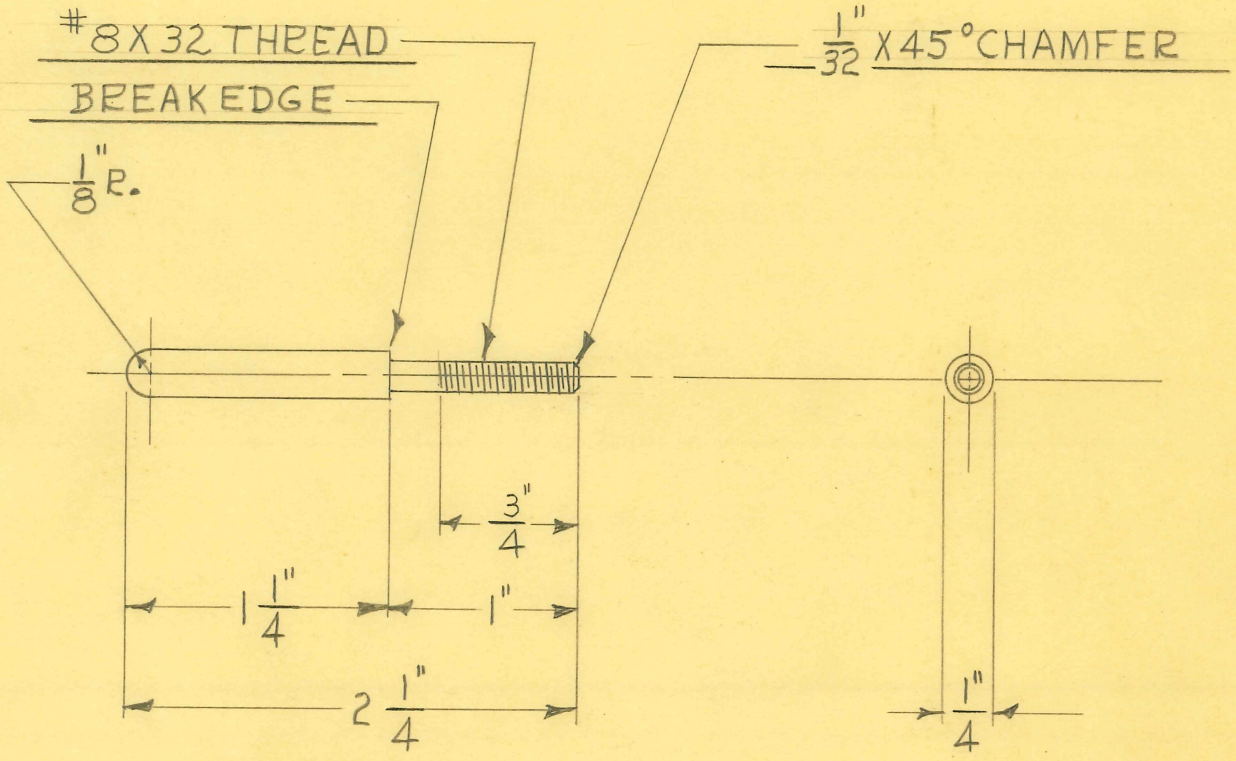

1-REQUIRED

DIMENSIONS	
FRACTIONAL	± .015
DECIMAL	± .005
ANGULAR	± 1/2°

UNLESS OTHERWISE SPECIFIED

SIZE	1/4" DIAM.	ISSUE 12-11-47	J.M.F
KIND	BRASS ROD	CHANGED	
SHAPE		"	
FINISH		"	
TEMP.		"	
PATT.		"	

TITLE: MODEL "400" FISCHER DELUXE DIATHERMY LEAD IN BUSHING CONTACT

H. G. FISCHER & CO.
2335 WABANSIA AVE.
CHICAGO, ILL.

CAT. NO.

PART NO. 16394

TITLE

MODEL "400" FISCHER DELUXE DIA.
PARRALLEL TUNING COIL CONN.

H. G. FISCHER & CO.
FRANKLIN PARK, ILLINOIS

DATE 9-22-48 | DR. BY W. J. | CH'K'D. J.V.W.

PART NO. 16395A

REVISION	DATE	BY

PATTERN	FINISH	SCALE FULL
TOOLS	MATERIAL 3/8" HEX. BRASS ROD	

DIMENSIONS
FRACTIONAL ± .015
DECIMAL ± .005
ANGULAR ± ½°
UNLESS OTHERWISE SPECIFIED

FOR JOHSON COND. ONLY

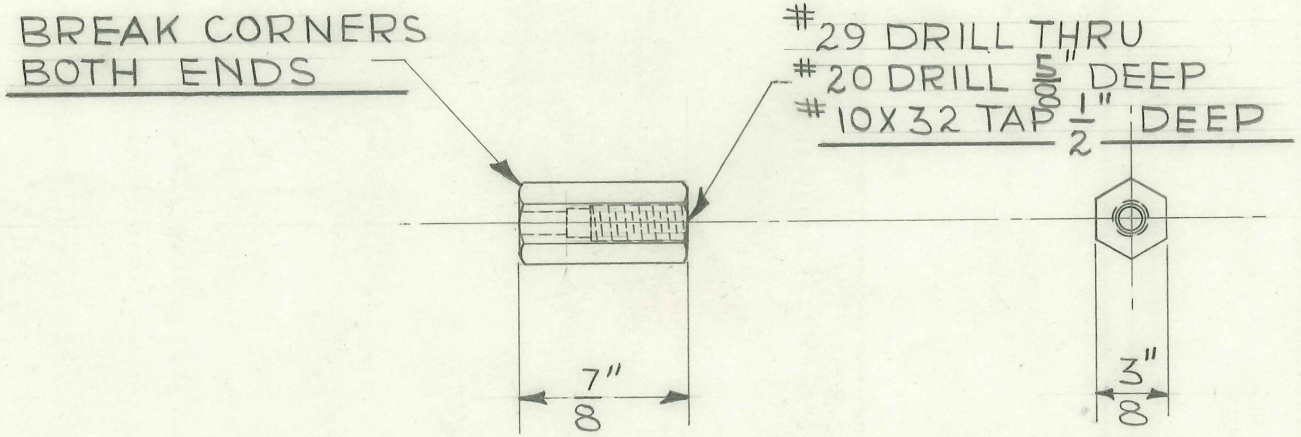

2 REQUIRED

FOLDER #128

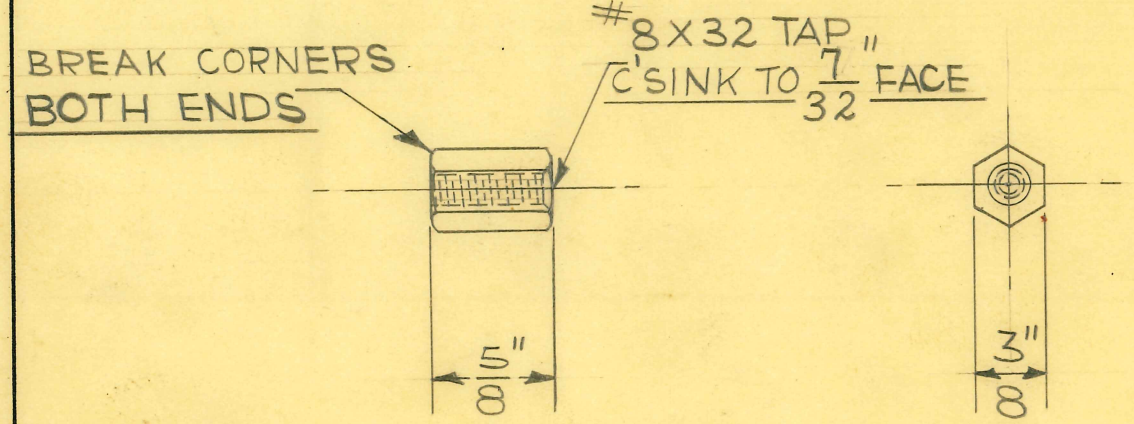

2 REQUIRED

FOR MILLEN COND. ONLY

DIMENSIONS	
FRACTIONAL	± .015
DECIMAL	± .005
ANGULAR	± 1/2°

UNLESS OTHERWISE SPECIFIED

SIZE	3/8" HEX	ISSUE 7-19-48	W.J.
KIND	BRASS	CHANGED	
SHAPE	ROD	"	
FINISH		"	
TEMP.		"	
PATT.		"	

TITLE: MODEL "400" FISCHER DELUXE PARRALLEL TUNING COIL CONN. DIA.

H. G. FISCHER & CO.
2335 WABANSIA AVE.
CHICAGO, ILL.

CAT. NO.

PART NO. 16395 1/2

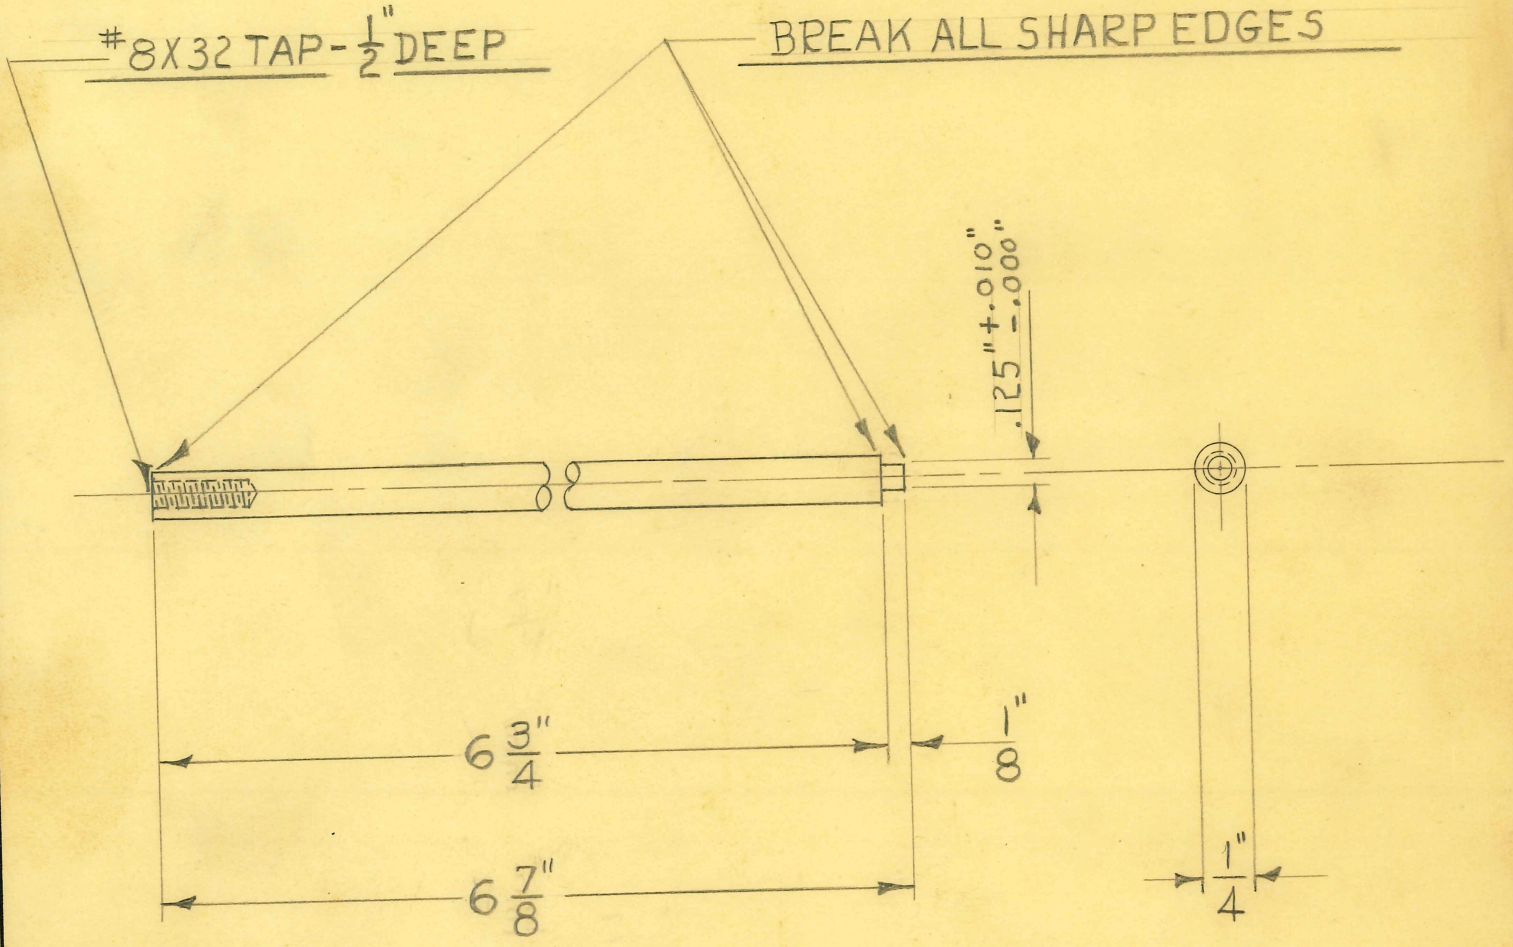

2-REQUIRED

DIMENSIONS	
FRACTIONAL	± .015
DECIMAL	± .005
ANGULAR	± 1/2°

UNLESS OTHERWISE SPECIFIED

SIZE	1/4" DIAM	ISSUE 12-12-47	J.M.F
KIND	BRASS	CHANGED	
SHAPE	ROD	" 4-23-48	J.B.G.
FINISH	CAD #23	"	
TEMP.		"	
PATT.		"	

TITLE: MODEL "400" FISCHER DELUXE DIATHERMY OSCIL. UNIT BASE SPACING ROD

H. G. FISCHER & CO.
2335 WABANSIA AVE.
CHICAGO, ILL.

CAT. NO.

PART NO. 16397A

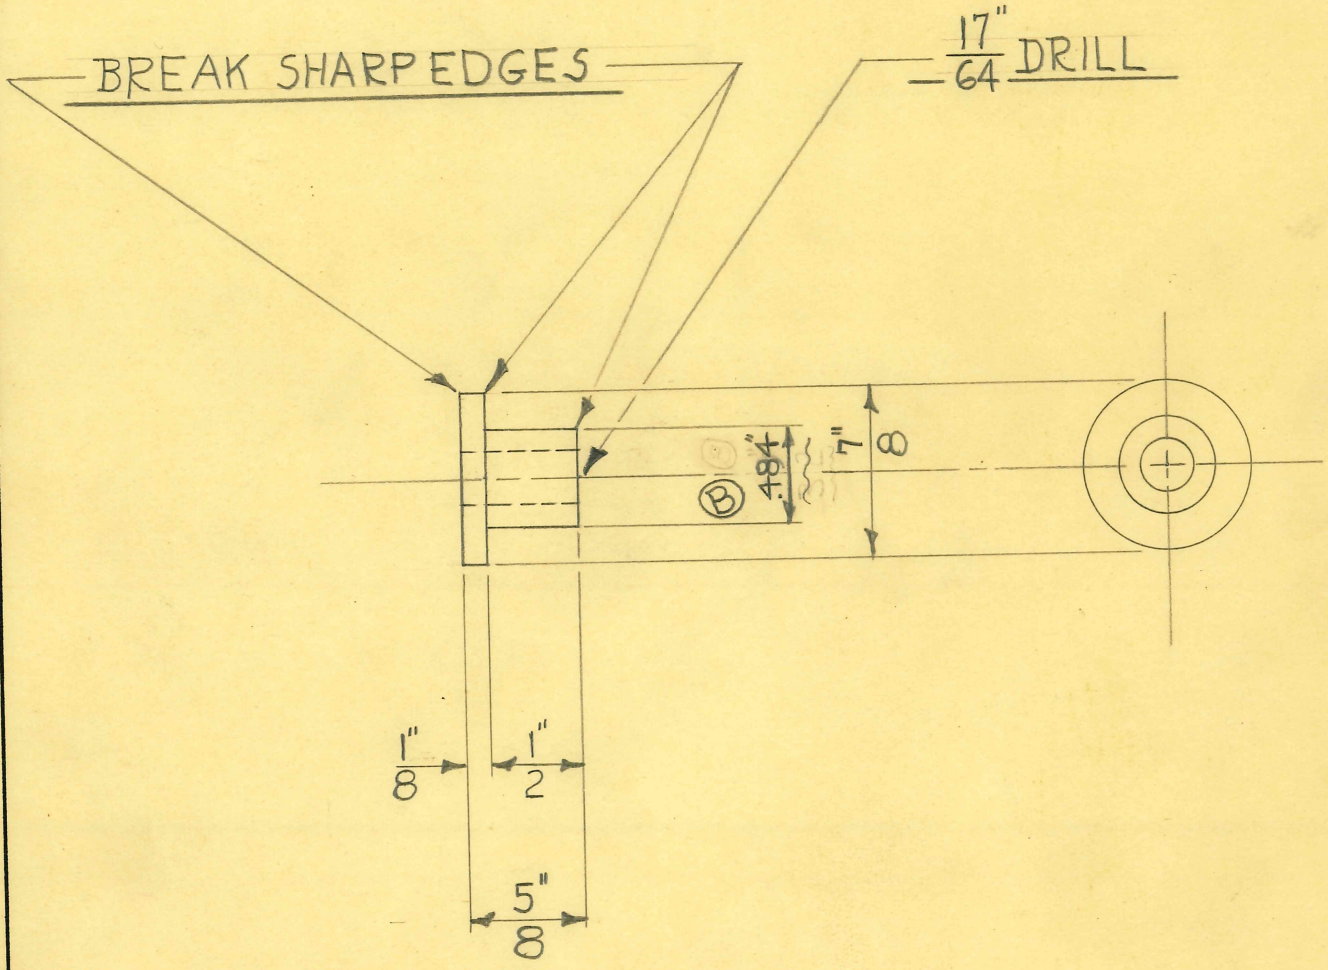

1-REQUIRED

DIMENSIONS	
FRACTIONAL	± .015
DECIMAL	± .005
ANGULAR	± 1/2°

UNLESS OTHERWISE SPECIFIED

7/8" DIA. BLACK BAKELITE ROD X X

SIZE		ISSUE 12-12-47	J.M.F
KIND		CHANGED 1-16-63	—
SHAPE		Ⓑ .. WAS 19/32	R.W.
FINISH		..	
TEMP.		..	
PATT.		..	

TITLE: MODEL "400" FISCHER DELUXE DIATHERMY CONDENSER SHAFT INS. BUSHING

H. G. FISCHER & CO.
2335 WABANSIA AVE.
CHICAGO, ILL.

CAT. NO.

PART NO. 16398B

TITLE: FISCHER MOD. "400" DIATHERMY APPROVAL NUMBER

H. G. FISCHER & CO.
FRANKLIN PARK, ILLINOIS

PART NO. 16399 1/2

DATE 4-2-51 | DR. BY J.N.W. | CH'K'D.

REVISION	DATE	BY

PATTERN | FINISH | SCALE FULL

TOOLS | MATERIAL: METAL-CAL

DIMENSIONS
FRACTIONAL ± .015
DECIMAL ± .005
ANGULAR ± ½°
UNLESS OTHERWISE SPECIFIED

D-500-IN BLACK ANODIZED.
BACKGROUND-PLAIN
ANODIZED ALUMINUM
SATIN FINISH.
LETTERING MUST BE STYLE SHOWN.

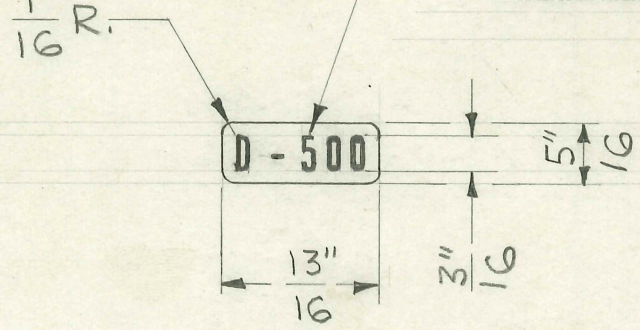

FOLDER #128

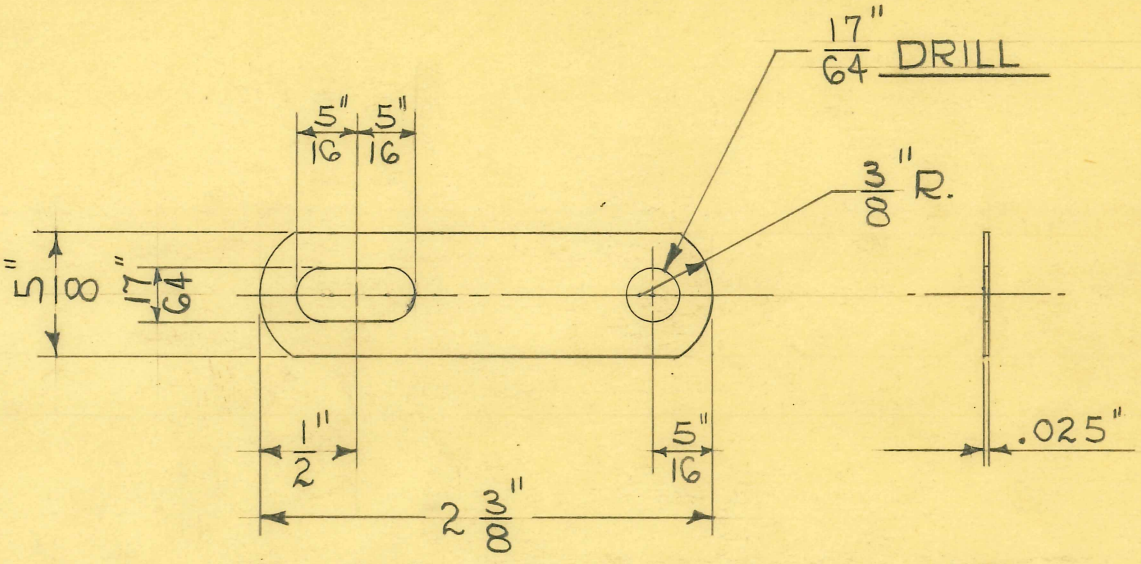

GRAIN TO RUN IN THIS DIRECTION

DEVELOPMENT

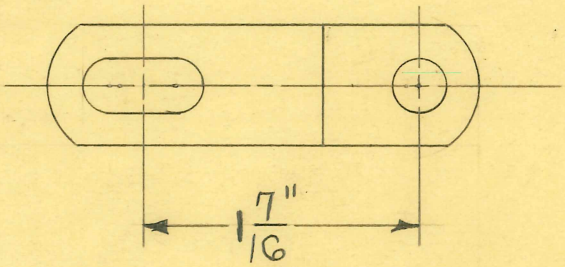

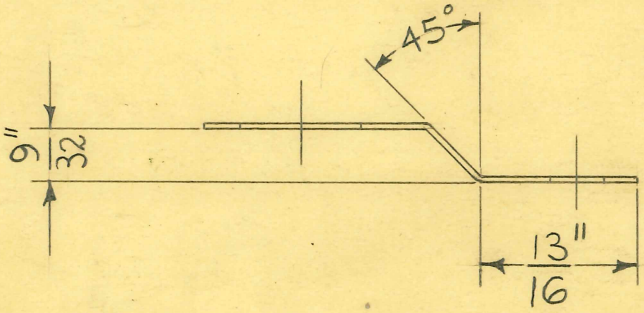

REQUIRED

PIERCING DIE TOOL #9688
BENDING FIXTURE TOOL #9689
GAUGE FOR CUT OFF DIE - TOOL # 9690

DIMENSIONS	
FRACTIONAL	± .015
DECIMAL	± .005
ANGULAR	± 1/2°

UNLESS OTHERWISE SPECIFIED

#22 GA.(.025") PHOS BRONZE SHEET

SIZE		ISSUE 12-13-47	W. J.
KIND		CHANGED	
SHAPE		"	
FINISH		"	
TEMP.		"	
PATT.		"	

TITLE:
MODEL "400" FISCHER DELUXE DIATHERMY
PLATE CONNECTOR FROM PATIENTS DECK TO TUBE DECK

H. G. FISCHER & CO.
2335 WABANSIA AVE.
CHICAGO. ILL.

CAT. NO.

PART NO. 16400

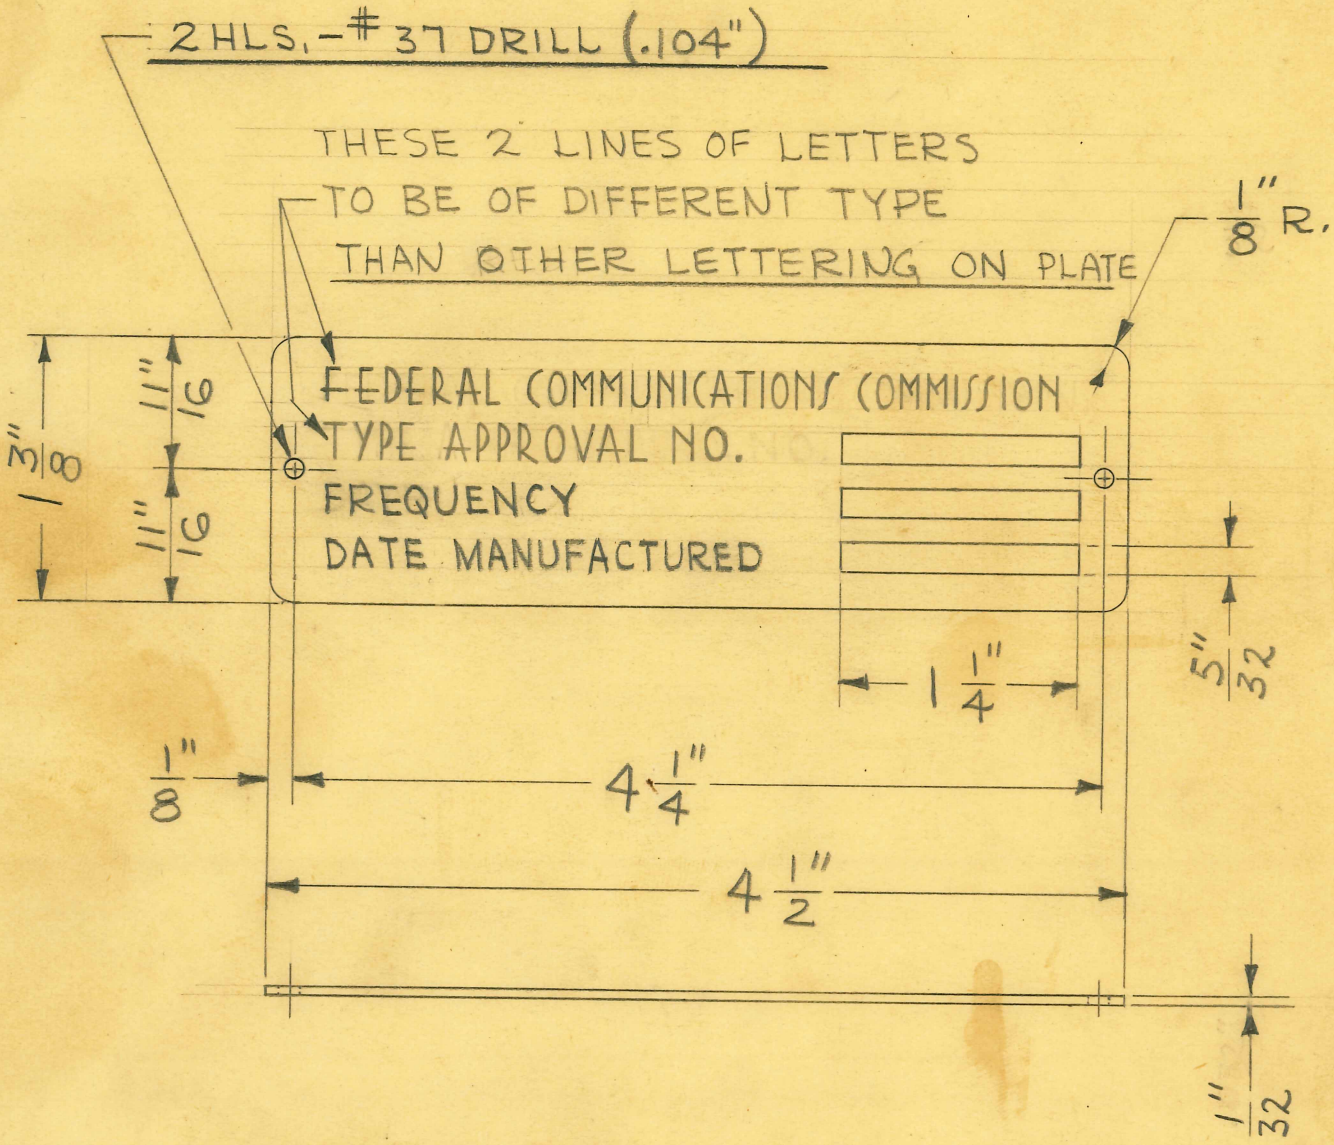

1 REQUIRED

APPROVED 1-30-48

DIMENSIONS	
FRACTIONAL	± .015
DECIMAL	± .005
ANGULAR	± 1/2°

UNLESS OTHERWISE SPECIFIED

SIZE		ISSUE 1-30-48	J.V.W.
KIND		CHANGED	
SHAPE		"	
FINISH		"	
TEMP.		"	
PATT.		"	

TITLE:
FISCHER DIATHERMY
FCC. APPROVAL PLATE

H. G. FISCHER & CO.
2335 WABANSIA AVE.
CHICAGO, ILL.

CAT. NO.

PART NO. 16401

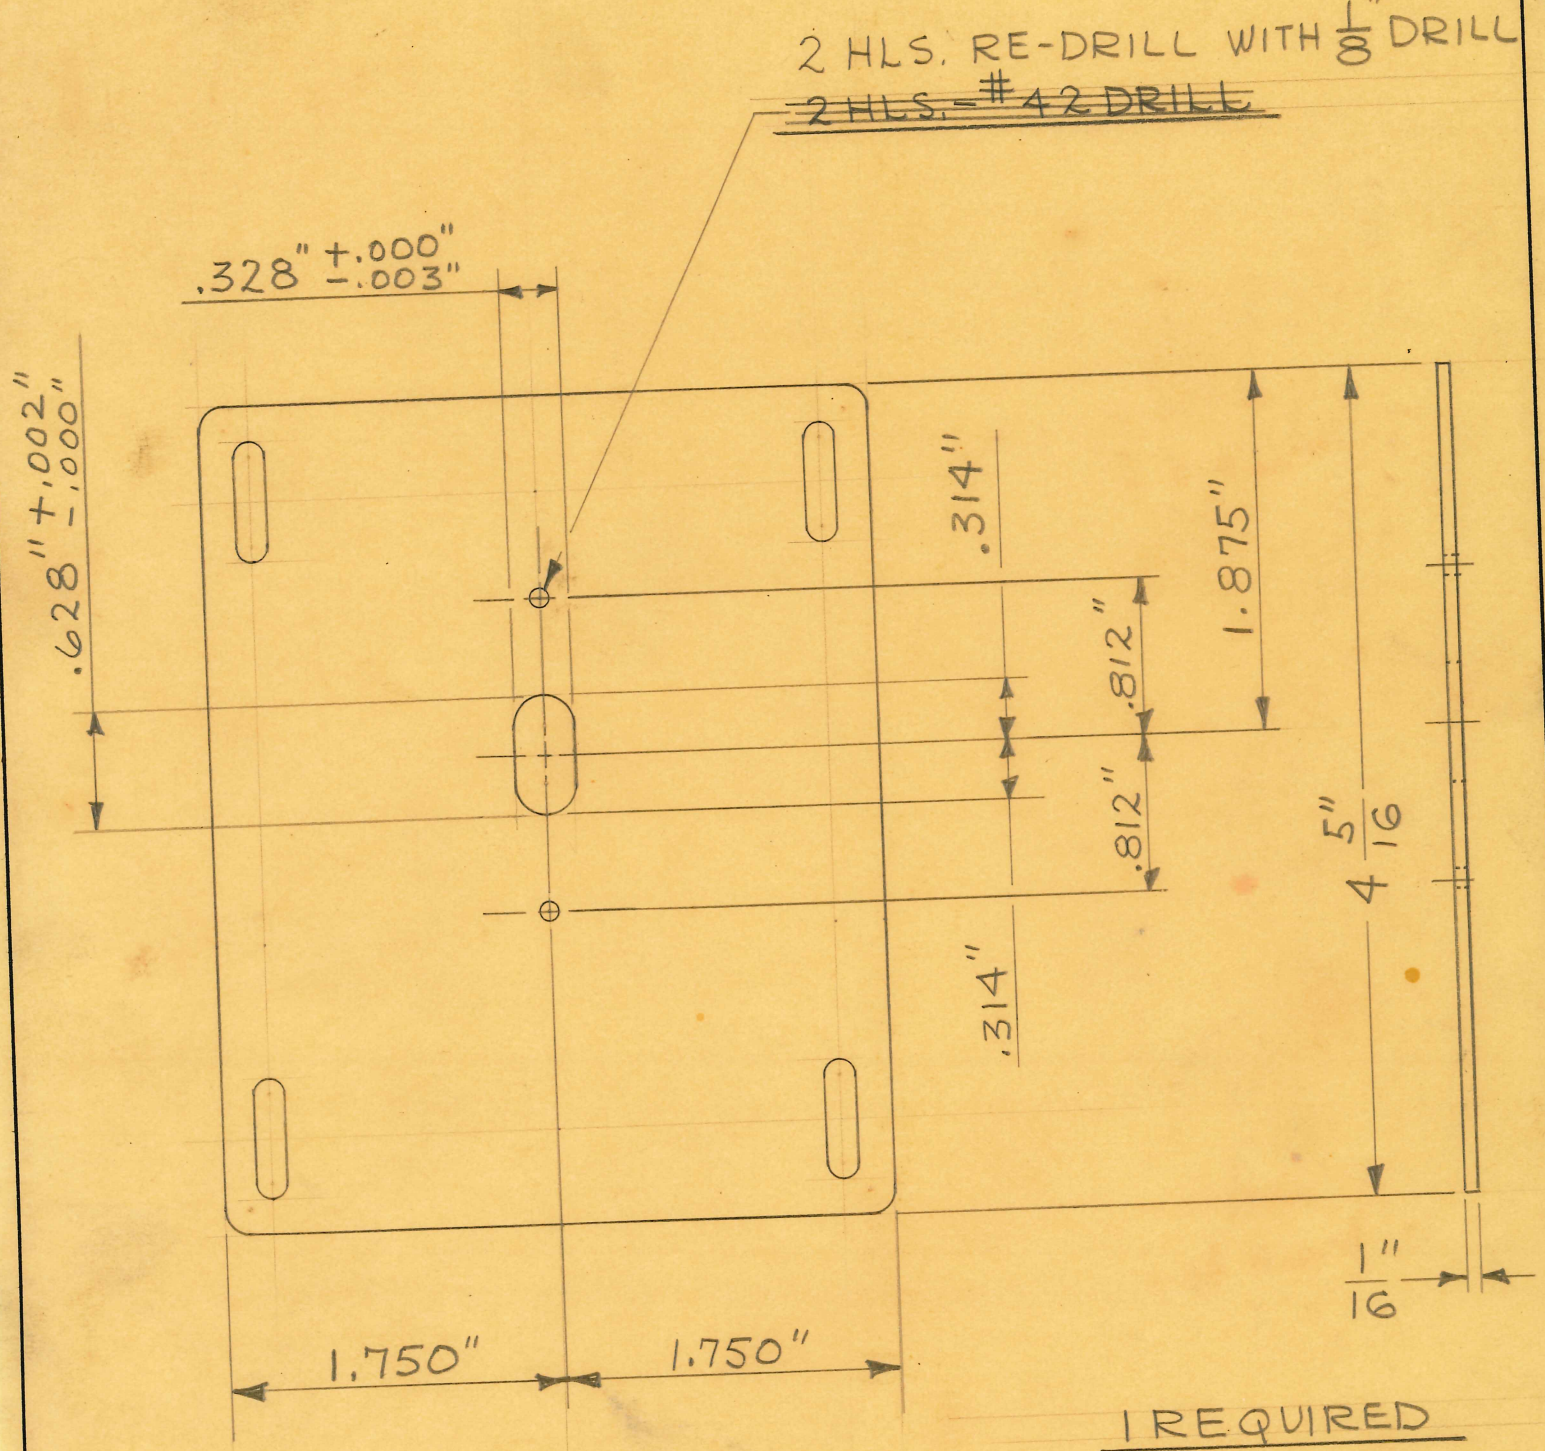

1 REQUIRED

SLOTTING DIE TOOL # 9875
PIERCING & SLOTTING DIE TOOL # 9812

DIMENSIONS	
FRACTIONAL	± .015
DECIMAL	± .005
ANGULAR	± 1/2°

UNLESS OTHERWISE SPECIFIED

SIZE	FROM	ISSUE 5-6-48	J.V.W.
~~KIND~~	16412A	CHANGED	
SHAPE		"	
FINISH		"	
TEMP.		"	
PATT.		"	

TITLE: FISCHER MOD. "400" DELUXE DIATHERMY JUNCTION BOX FRONT COVER PLATE

H. G. FISCHER & CO.
2335 WABANSIA AVE.
CHICAGO. ILL.

CAT. NO.

PART NO. 16412AF

TITLE
FISCHER PAINT PUMP ELECTRIC MOTOR LINE CORD PLUG

H. G. FISCHER & CO.
FRANKLIN PARK, ILLINOIS

PART NO. 16413

PATTERN	FINISH	SCALE FULL

MATERIAL: PURCHASED

TOOLS:

DATE 12-24-67 | DR. BY SCD | CH'K'D. AJB

DIMENSIONS—UNLESS OTHERWISE SPECIFIED:

		THREAD CHAMFER
FRACTIONAL	± .015	UP TO 5/16 D. - 1/32 X 45°
DECIMAL	± .005	3/8 D. & OVER - 1/16 X 45°
ANGULAR	± 1/2°	

REMOVE ALL BURRS & SHARP CORNERS

USED ON	QTY.	USED ON	QTY.
40481-G	1		

REVISION	DATE	BY

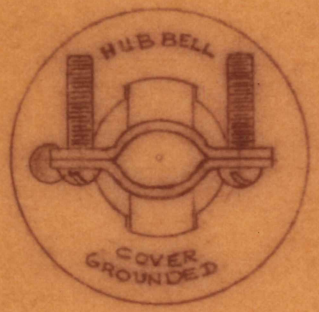

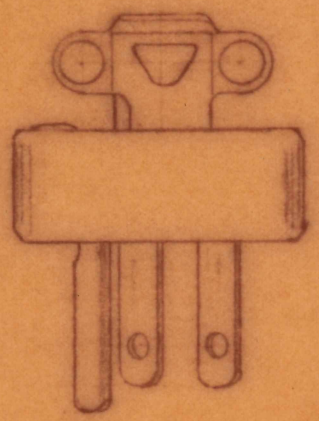

SOURCE:
ELECTRIC SUPPLY
628-630 W. JACKSON BLVD.
CHICAGO 6, ILLINOIS

5264 HUBBELL PLUG

DO NOT SCALE DRAWING.

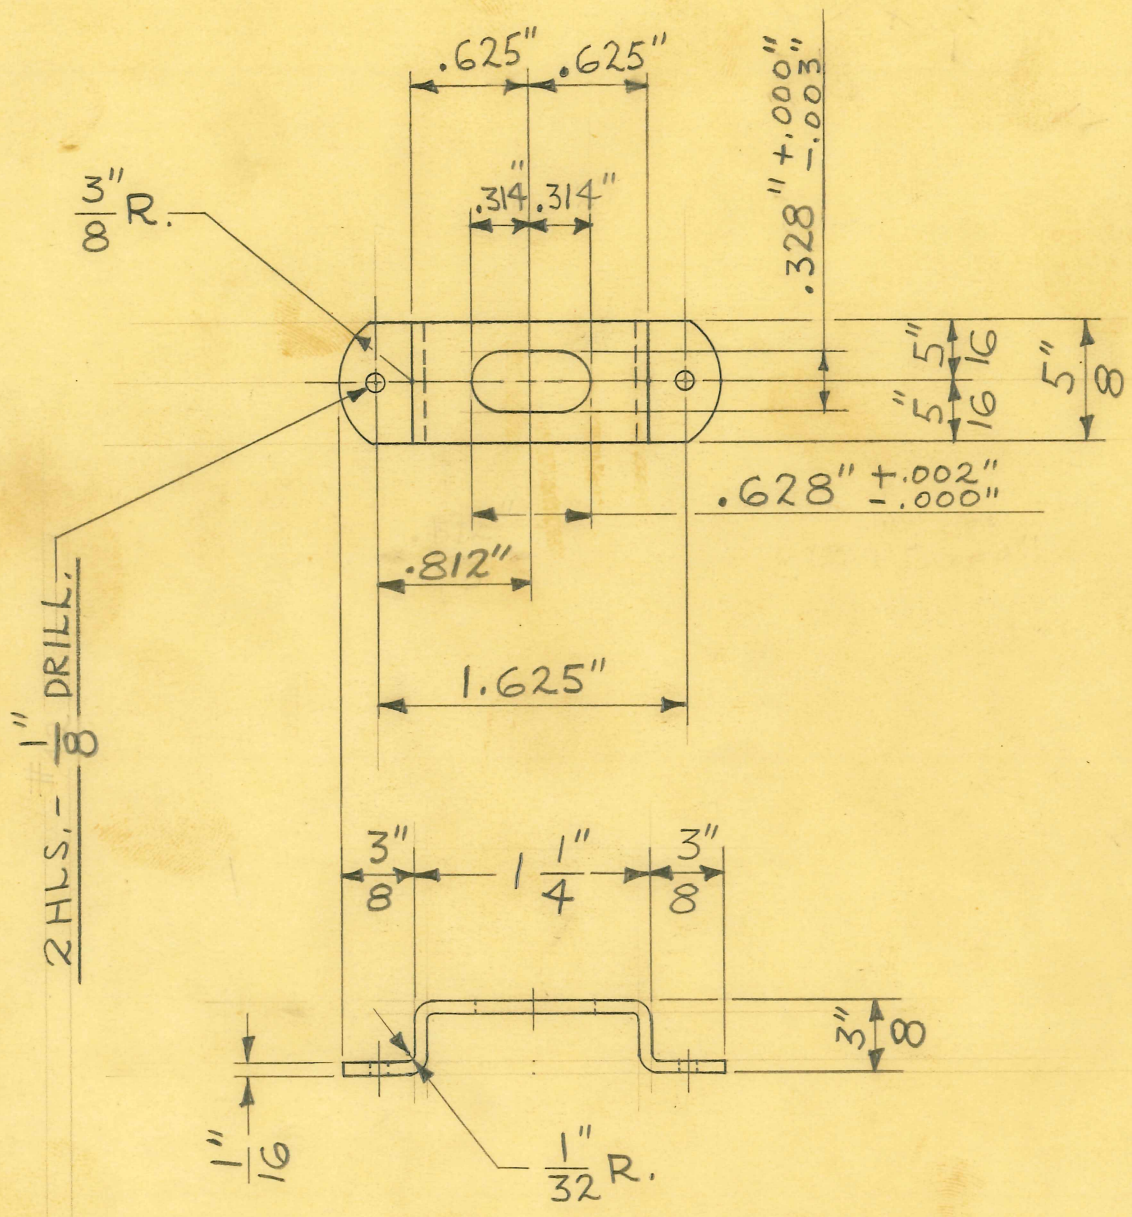

DEVELOPED LENGTH = 2 1/2"

CUT OFF DIE TOOL #3045.
DRILL JIG TOOL #9811.
SLOTTING DIE TOOL #9812.
BENDING DIE TOOL #9813.

1 REQUIRED

1/16" X 5/8" SHEARED H. H. BRASS

DIMENSIONS	
FRACTIONAL	± .015
DECIMAL	± .005
ANGULAR	± 1/2°

UNLESS OTHERWISE SPECIFIED

SIZE		ISSUE 5-4-48	J.V.W.
KIND		CHANGED	
SHAPE		"	
FINISH		"	
TEMP.		"	
PATT.		"	

TITLE: FISCHER MOD. "400" DELUXE DIATHERMY PICKUP LOOP SUPP. BRKT.

H. G. FISCHER & CO.
2335 WABANSIA AVE.
CHICAGO, ILL.

CAT. NO.

PART NO. 16422

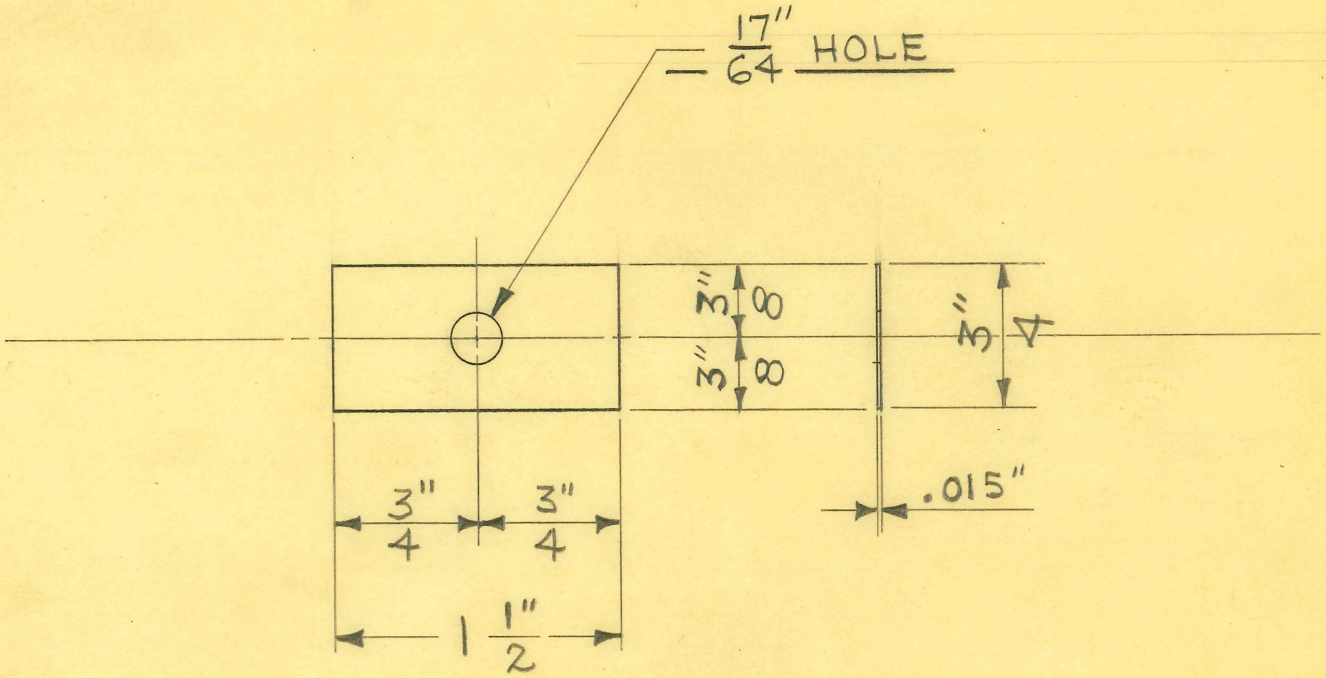

BLANK

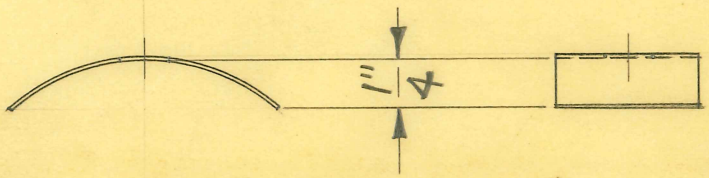

WRAP AROUND 1" DIAMETER

2-REQUIRED

PIERCING PUNCH TOOL # 4608

DIMENSIONS	
FRACTIONAL	± .015
DECIMAL	± .005
ANGULAR	± 1/2°

UNLESS OTHERWISE SPECIFIED

SIZE	.015" SHEET	ISSUE 6-1-48	J.V.W.
KIND	PHOS. BRONZE	CHANGED	
SHAPE		"	
FINISH		"	
TEMP.		"	
PATT.		"	

TITLE: FISCHER DELUXE "400" DIATHERMY CONDENSER CONTACT PLATE

H. G. FISCHER & CO.
2335 WABANSIA AVE.
CHICAGO, ILL.

CAT. NO.

PART NO. 16423

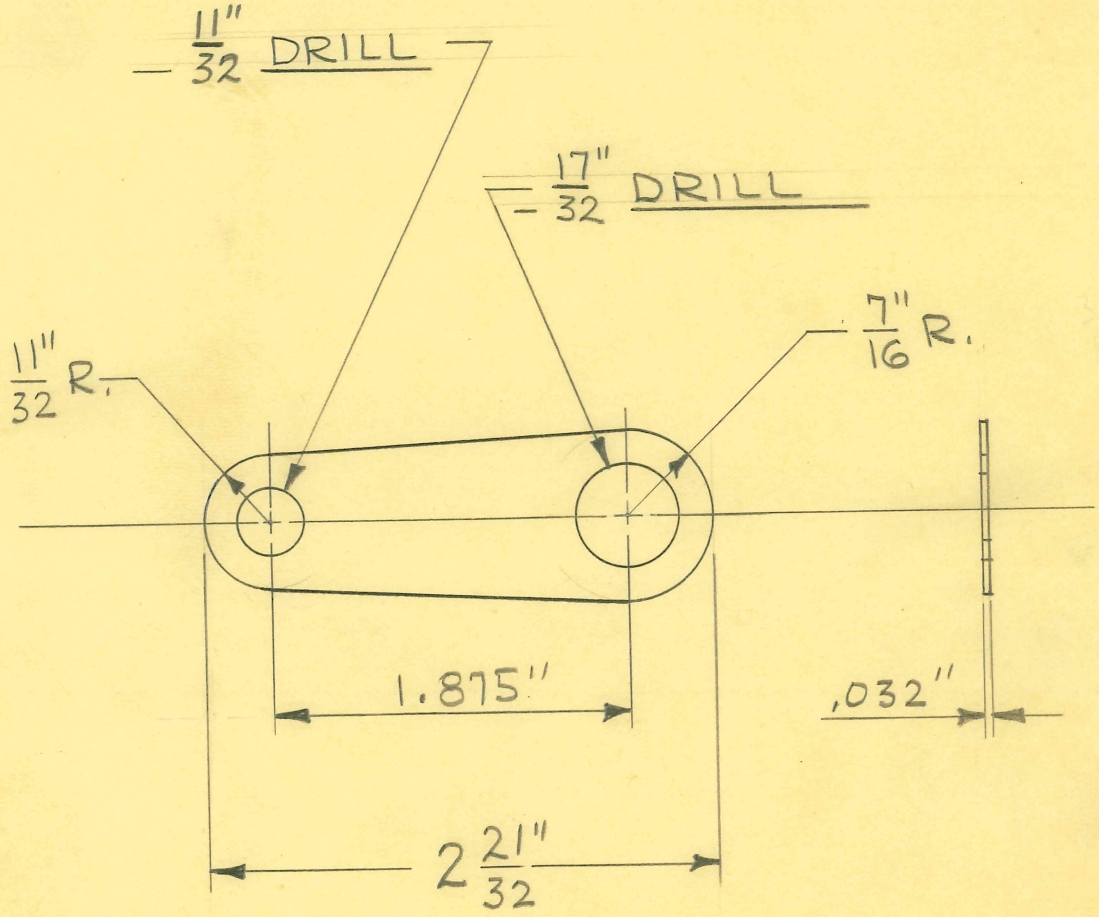

2 - REQUIRED

BLANKING & PIERCING DIE TOOL #9840.

DIMENSIONS	
FRACTIONAL	± .015
DECIMAL	± .005
ANGULAR	± 1/2°

UNLESS OTHERWISE SPECIFIED

#20GA.(.032") X 3" SHEARED BRASS H.H.

SIZE		ISSUE 6-17-48	J.V.W.
KIND		CHANGED	
SHAPE		"	
FINISH		"	
TEMP.		"	
PATT.		"	

TITLE: FISCHER DELUXE "400" DIATHERMY PLUGIN SOCKETS CONN. LINK

H. G. FISCHER & CO.
2335 WABANSIA AVE.
CHICAGO, ILL.

CAT. NO.

PART NO. 16426

TITLE
"MODIFIED" MODEL "400" FISCHER DELUXE DIA. VACUUM CONDENSER CONN. CLAMP

H. G. FISCHER & CO.
FRANKLIN PARK, ILLINOIS

PART NO. 16427

DATE 2-3-49 | DR. BY W. J. | CH'K'D. J.V.W.

REVISION	DATE	BY

PATTERN | FINISH | SCALE FULL

DIMENSIONS
FRACTIONAL ± .015
DECIMAL ± .005
ANGULAR ± ½°
UNLESS OTHERWISE SPECIFIED

TOOLS
BENDING FIX. # 10054

MATERIAL
1/32" SOFT SHEET COPPER

NEST FOR DIE # 3193 TOOL # 10,058
RAD. DIE # 7642

DEVELOPED LENGTH = 4 1/32"

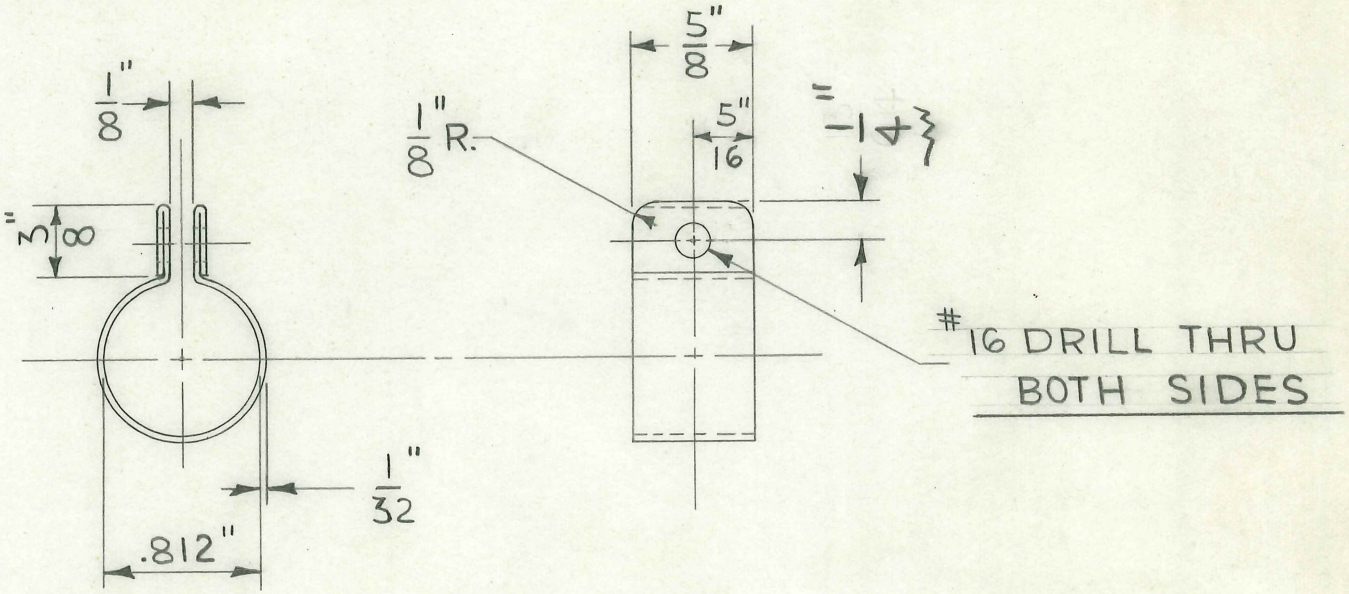

2 REQUIRED

FOLDER #128

TITLE
MODIFIED MOD. "400" FISCHER DELUXE DIA. VACUUM CONDENSER CONN. CLAMP BLOCK

H. G. FISCHER & CO.
FRANKLIN PARK, ILLINOIS

PART NO. 16428

DATE 2-3-49 | DR. BY W. J. | CH'K'D. J.V.W.

REVISION	DATE	BY

PATTERN | FINISH | SCALE FULL

TOOLS: DRILL JIG # 10,057

MATERIAL: 5/16" X 3/4" BRASS BAR

DIMENSIONS UNLESS OTHERWISE SPECIFIED
FRACTIONAL ± .015
DECIMAL ± .005
ANGULAR ± ½°

USED ON MODEL 10

ROUND OFF ALL CORNERS & EDGES

#10 X 32 TAP

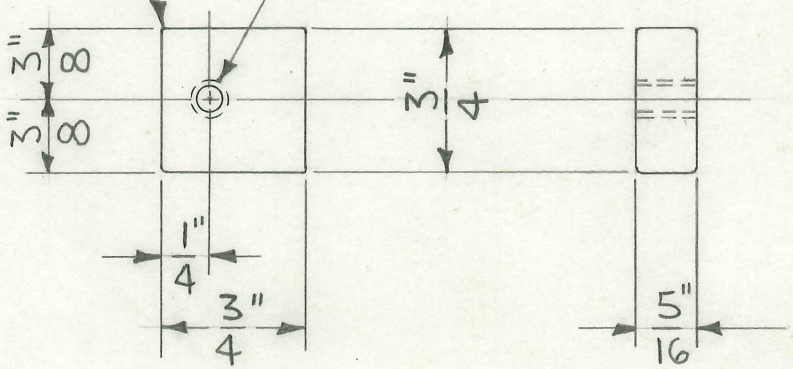

2 REQUIRED

FOLDER #128

TITLE
MODIFIED MOD. "400" FISCHER DELUXE DIA. VACUUM CONDENSER CONN. CLAMP ASSEM.

H. G. FISCHER & CO.
FRANKLIN PARK, ILLINOIS

DATE 2-4-49 | DR. BY W. J. | CH'K'D. J.V.W.

PART NO. 16429 G

REVISION	DATE	BY

PATTERN | FINISH SILVER #6 ½ | SCALE FULL

TOOLS # BRAZING FIX. 10056 | MATERIAL

DIMENSIONS
FRACTIONAL ± .015
DECIMAL ± .005
ANGULAR ± ½°
UNLESS OTHERWISE SPECIFIED

2 REQUIRED

USED ON MODEL 10

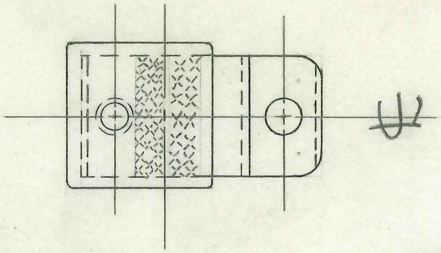

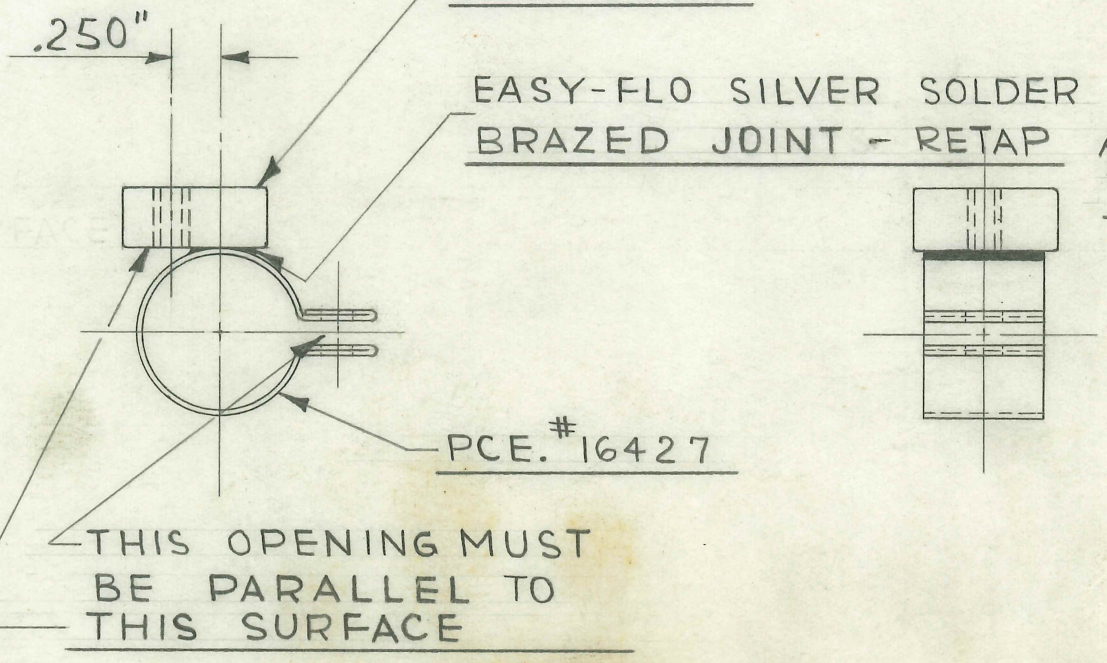

NOTE:
AFTER BRAZING CLEAN INSIDE SURFACE WITH EMERY CLOTH

FOLDER #128

TITLE
MODIFIED MOD. "400" FISCHER DELUXE DIA. BIMETAL COMPENSATOR BLANK

H. G. FISCHER & CO.
FRANKLIN PARK, ILLINOIS

PART NO. 16430

DATE 2-3-49 | DR. BY W. J. | CH'K'D. J.V.W.

REVISION	DATE	BY

PATTERN | FINISH | SCALE FULL

TOOLS | MATERIAL .0625" #3300 CHASE THERMOSTATIC BIMETAL

DIMENSIONS UNLESS OTHERWISE SPECIFIED
FRACTIONAL ± .015
DECIMAL ± .005
ANGULAR ± ½°

AFTER PIECE IS COMPLETE
HEAT TREAT. 700° F. FOR 3 HOURS

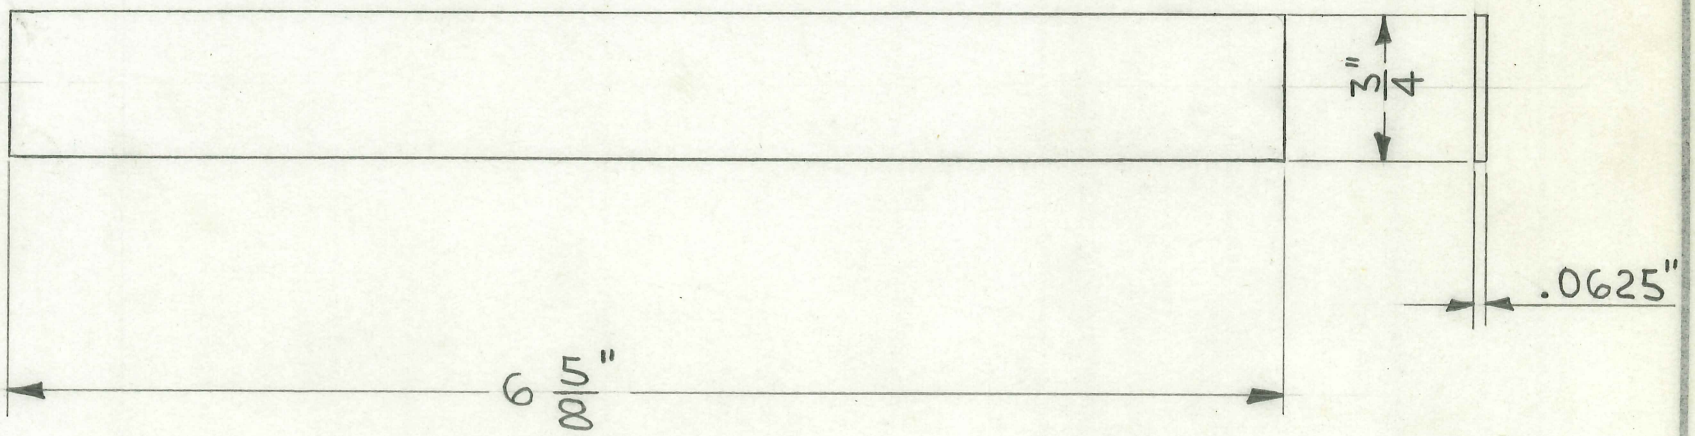

1 REQUIRED

FOLDER #128

TITLE "MODIFIED"
MODEL "400" FISCHER DELUXE DIA.
BIMETAL COMPENSATOR

H. G. FISCHER & CO.
FRANKLIN PARK, ILLINOIS

PART NO. 16430F

DATE 2-2-49 | DR. BY W. J. | CH'K'D. J.V.W.

REVISION	DATE	BY

PATTERN | FINISH | SCALE FULL

TOOLS: DRILL JIG # 10055

MATERIAL: FROM 16430

DIMENSIONS UNLESS OTHERWISE SPECIFIED
FRACTIONAL ± .015
DECIMAL ± .005
ANGULAR ± ½°

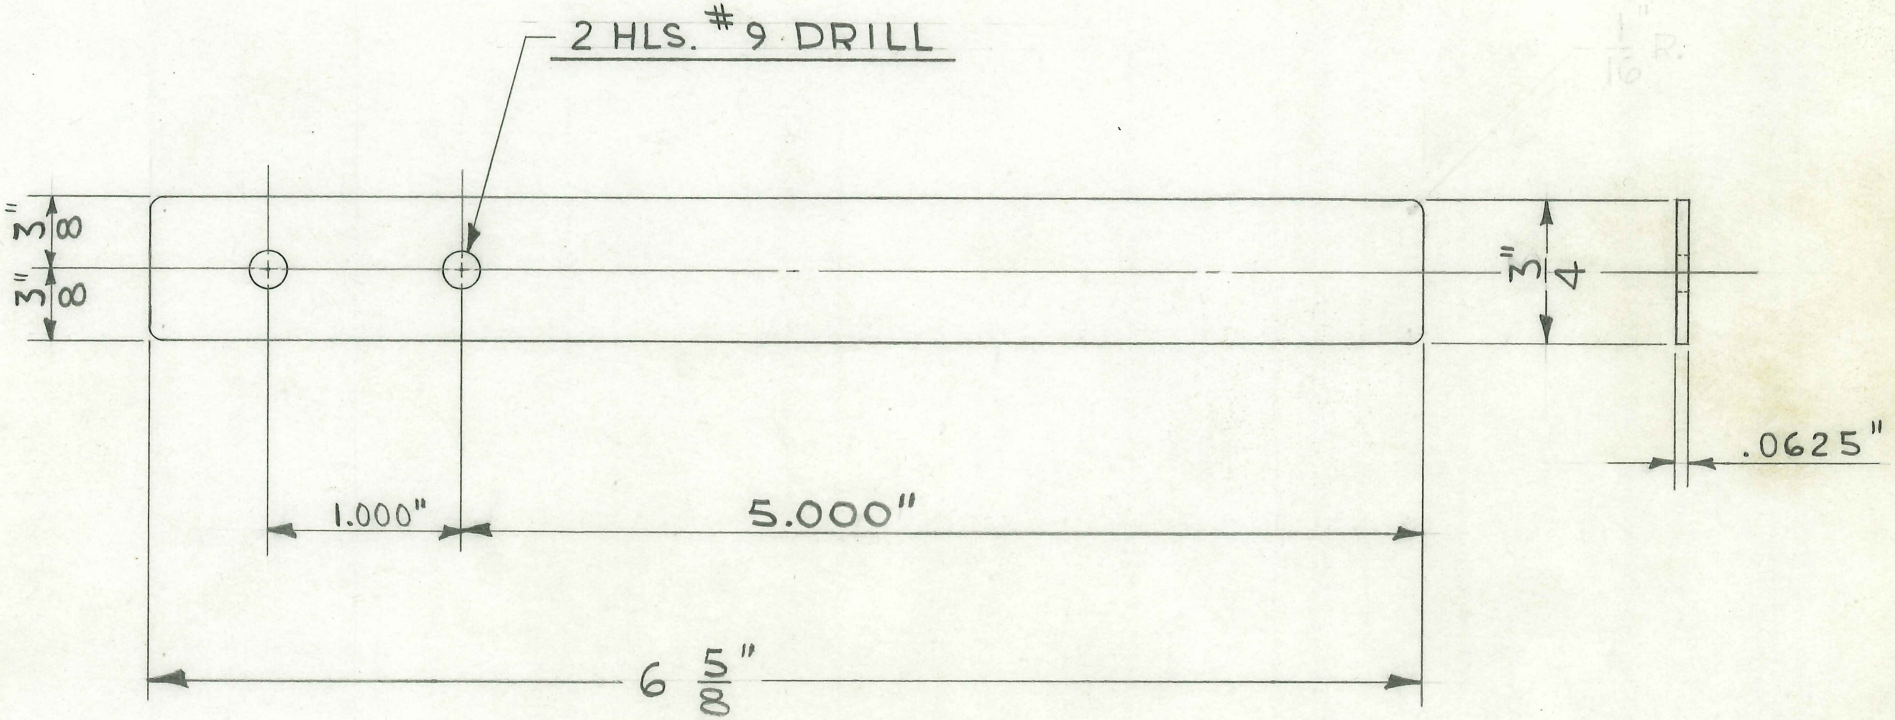

1 REQUIRED

FOLDER # 128

TITLE "MODIFIED"
MODEL "400" FISCHER DELUXE DIA.
COMPENSATING BAR FOR BIMETAL

H. G. FISCHER & CO.
FRANKLIN PARK, ILLINOIS

PART NO. 16431

DATE 2-2-49 | DR. BY W.J. | CH'K'D. J.V.W.

REVISION	DATE	BY

PATTERN | FINISH | SCALE FULL

TOOLS: DRILL JIG # 10055

MATERIAL: $\frac{1}{8}$" X $\frac{3}{4}$" BRASS BAR

DIMENSIONS UNLESS OTHERWISE SPECIFIED
FRACTIONAL ± .015
DECIMAL ± .005
ANGULAR ± ½°

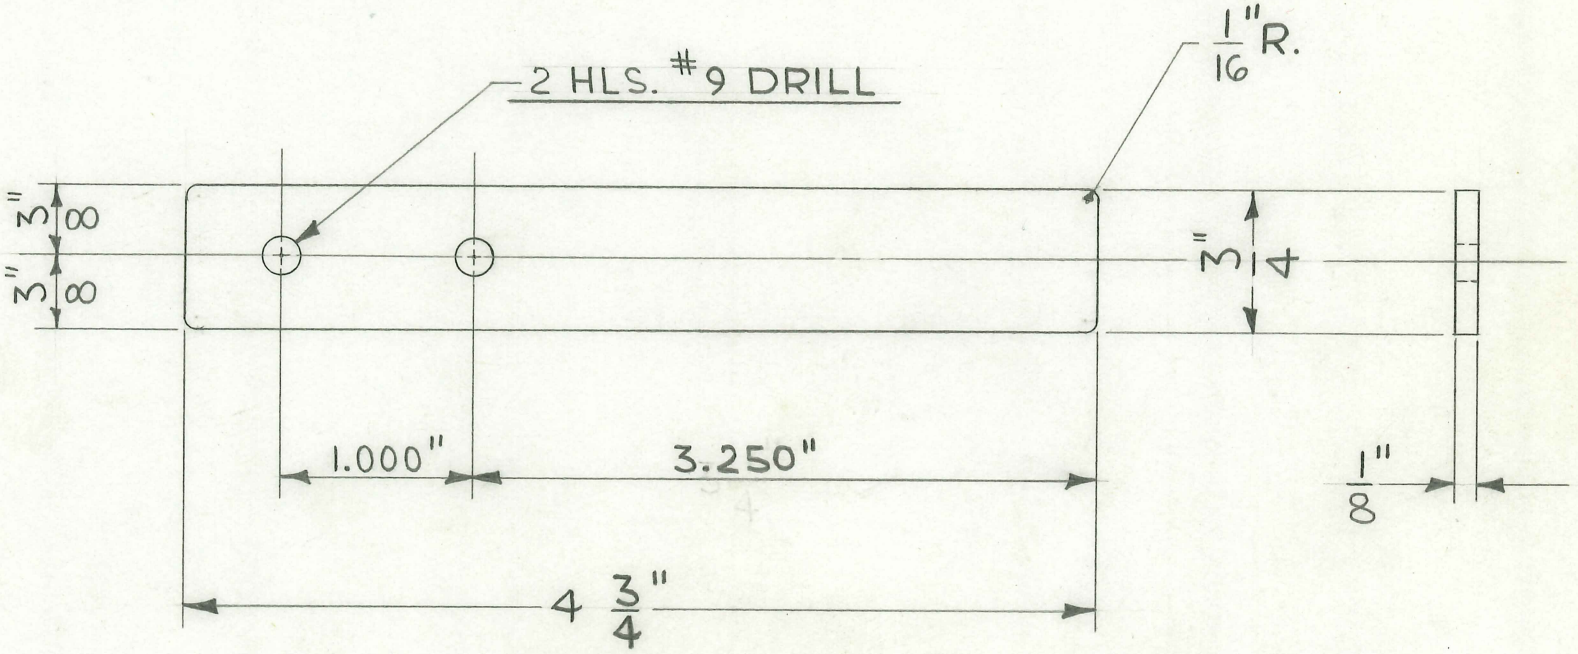

1 REQUIRED

FOLDER #128

TITLE "MODIFIED" MODEL 400" FISCHER DELUXE DIA. BIMETAL CLAMPING BAR - BOTTOM

H. G. FISCHER & CO.
FRANKLIN PARK, ILLINOIS

PART NO. 16432

DATE 2-2-49 | DR. BY W.J. | CH'K'D. J.V.W.

REVISION	DATE	BY

PATTERN | FINISH | SCALE FULL

TOOLS: DRILL JIG # 10055

MATERIAL: $\frac{1}{8}$" X $\frac{3}{4}$" BRASS BAR

DIMENSIONS UNLESS OTHERWISE SPECIFIED
FRACTIONAL ± .015
DECIMAL ± .005
ANGULAR ± ½°

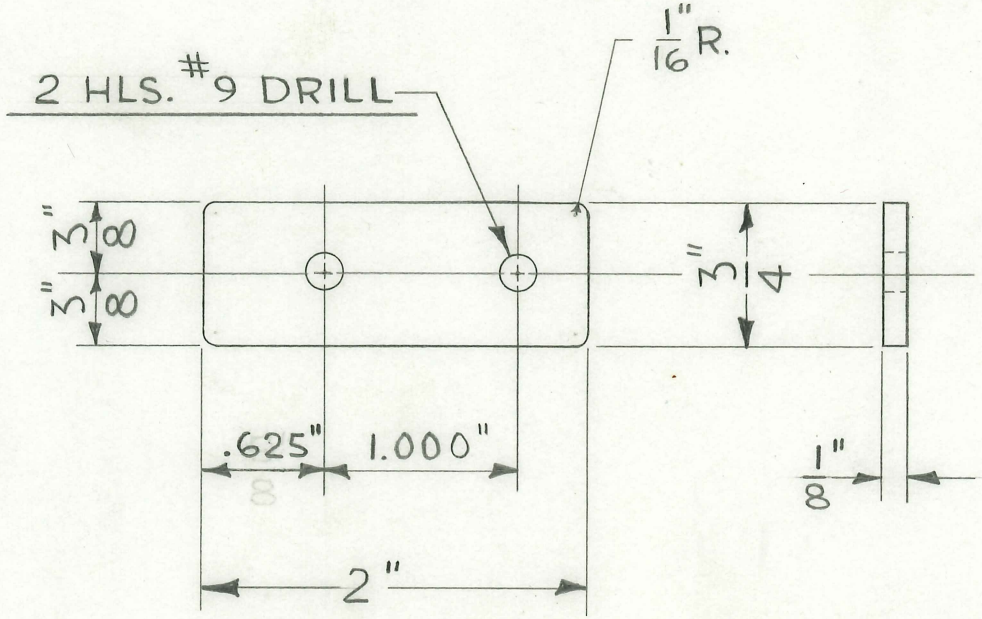

1 REQUIRED

FOLDER #128

TITLE "MODIFIED"
MODEL 400 FISCHER DELUXE DIA.
BIMETAL CLAMPING BAR - TOP

H. G. FISCHER & CO.
FRANKLIN PARK, ILLINOIS

PART NO. 16433

DATE 2-2-49 | DR. BY W. J. | CH'K'D. J.V.W.

REVISION	DATE	BY

PATTERN | FINISH | SCALE FULL

TOOLS: DRILL JIG # 10055

MATERIAL: $\frac{1}{4}$" X $\frac{3}{4}$" BRASS BAR

DIMENSIONS
FRACTIONAL ± .015
DECIMAL ± .005
ANGULAR ± ½°
UNLESS OTHERWISE SPECIFIED

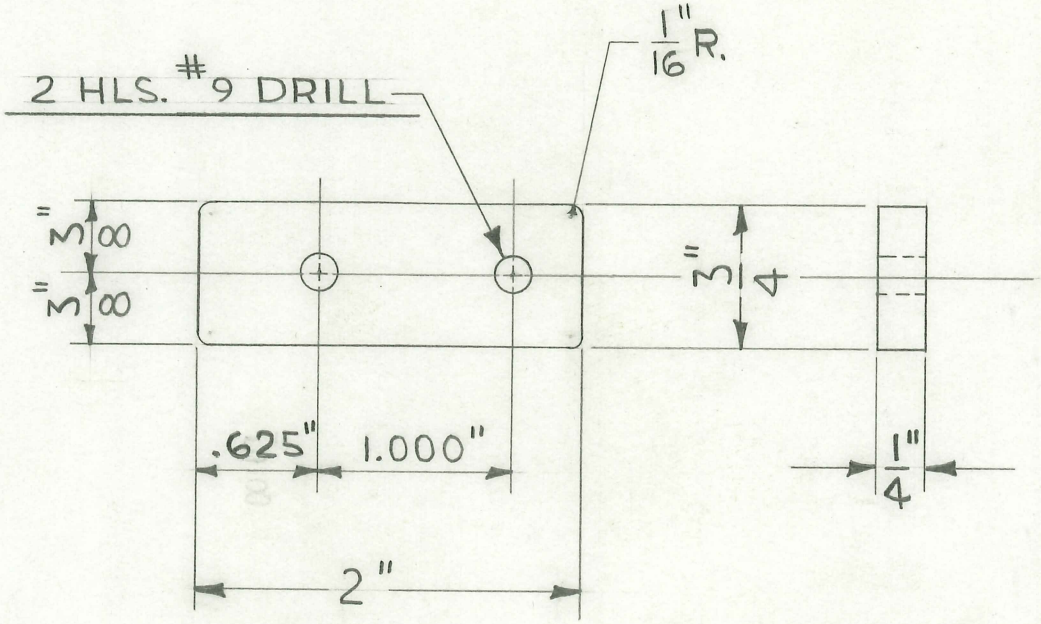

1 REQUIRED

FOLDER #128

TITLE

FISCHER MOD. "400" DIATHERMY CASTER STUD CLAMP BUSHING

H. G. FISCHER & CO.
FRANKLIN PARK, ILLINOIS

PART NO. 16446

DATE 6-25-54 DR BY J.V.W. CH'K'D.

REVISION	DATE	BY

PATTERN | FINISH | SCALE FULL

TOOLS | MATERIAL $\frac{7}{8}$" DIA. C.R. STEEL

DIMENSIONS
FRACTIONAL ± .015
DECIMAL ± .005
ANGULAR ± ½°
UNLESS OTHERWISE SPECIFIED

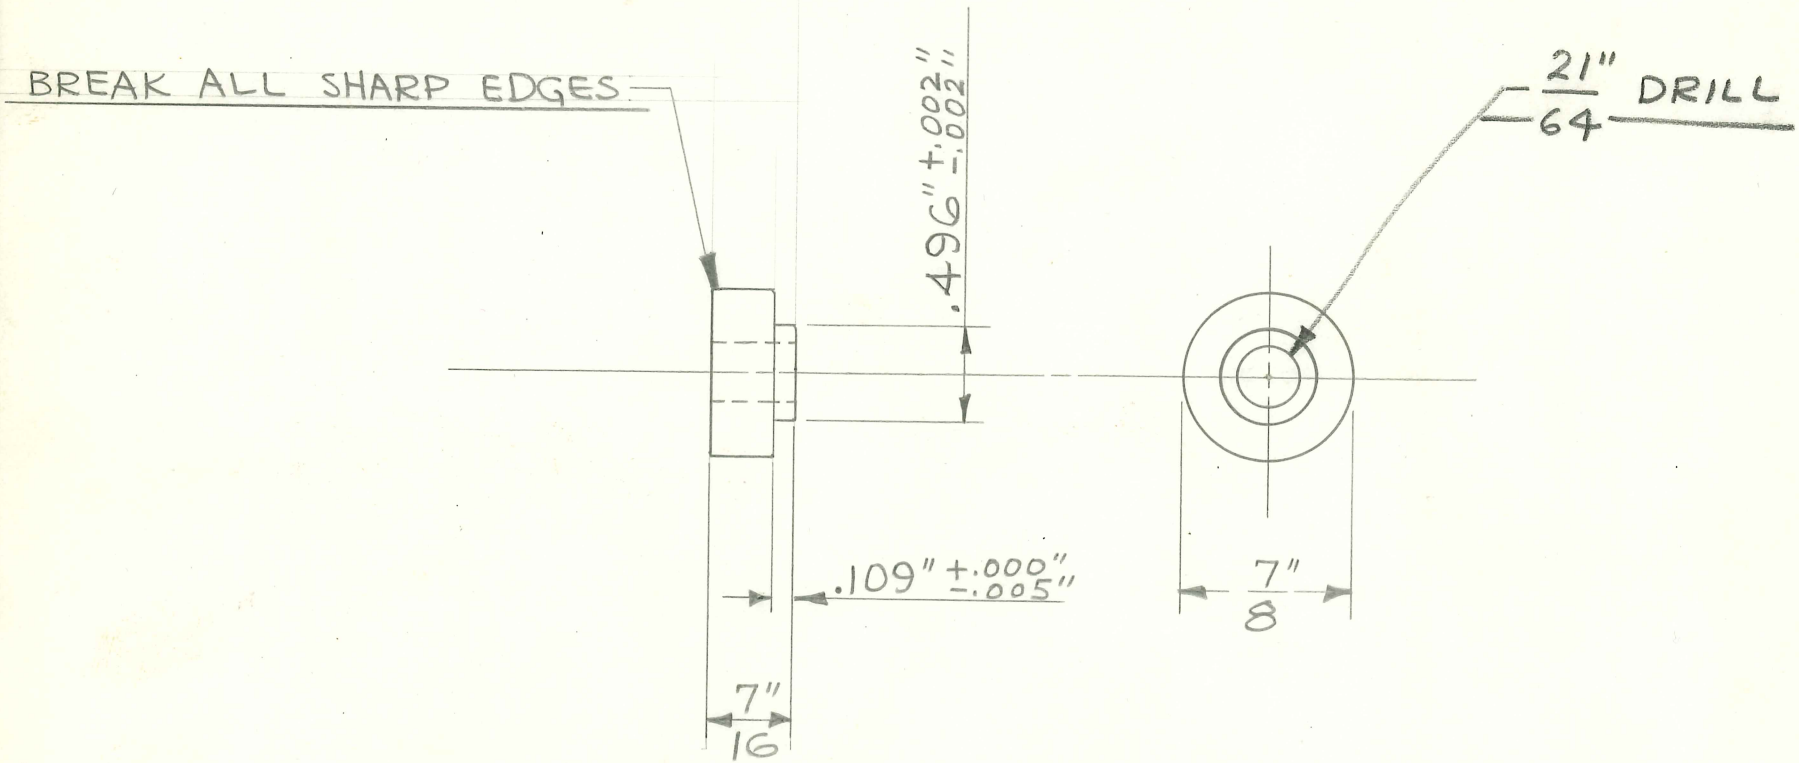

4 REQUIRED

FOLDER #128

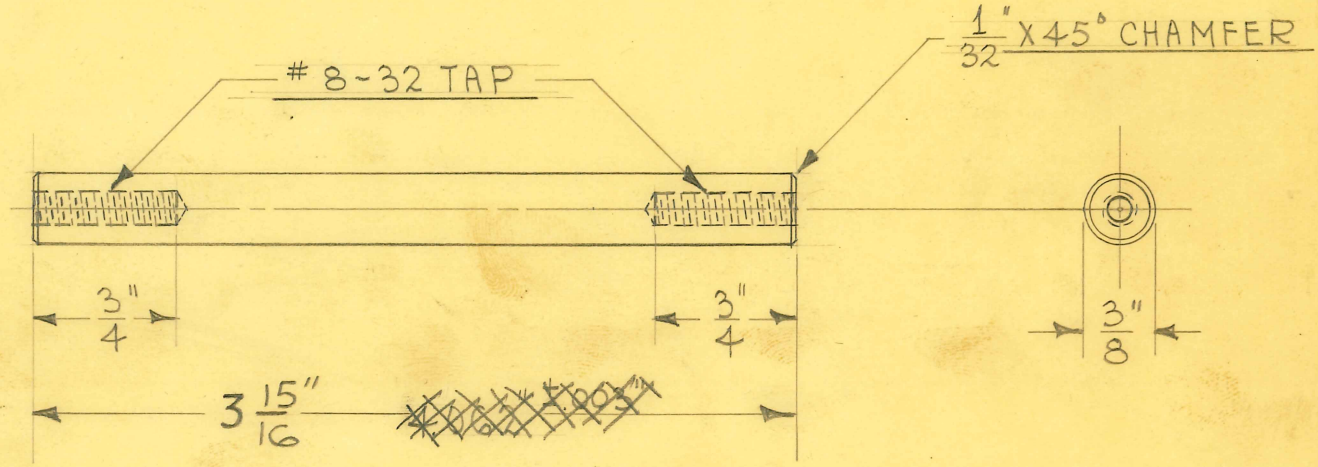

4 REQUIRED

SIZE	3/8" DIAM.	ISSUE 9-18-44	HE.
KIND	BRASS ROD	CHANGED	
SHAPE		" 7-8-46	J.W.
FINISH		"	
TEMP.		"	
PATT.		"	

TITLE: LIEBEL-FLARSHEIM 1/20 SECOND TIMER HOUSING COVER SUPP. SPACER

H. G. FISCHER & CO.
2335 WABANSIA AVE.
CHICAGO, ILL.

CAT. NO.

PART NO. 15692

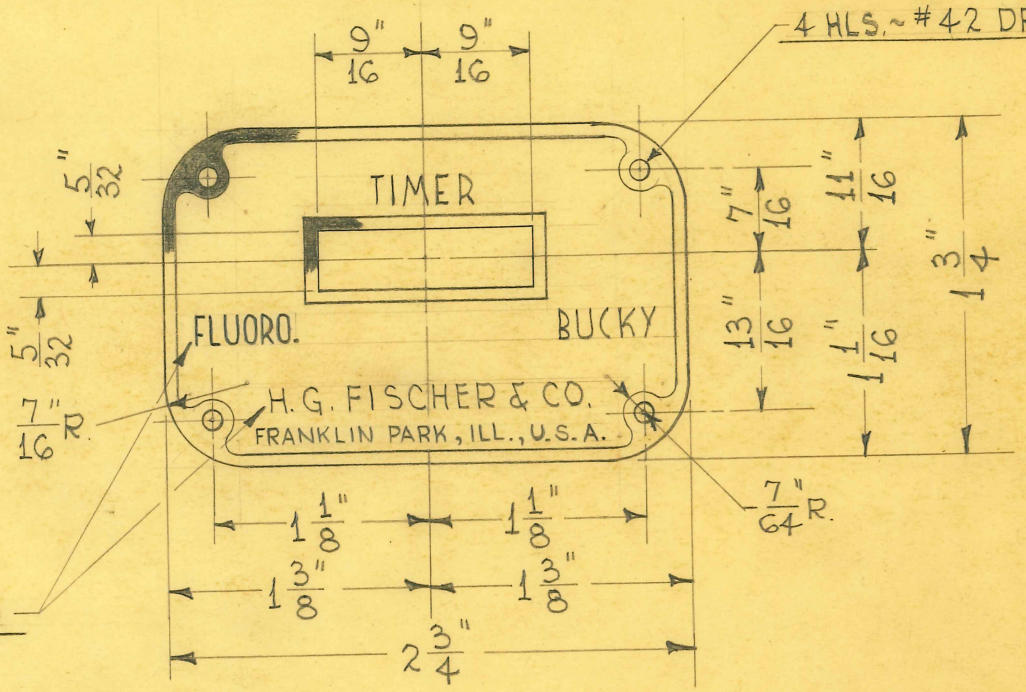

1 REQUIRED

SIZE		ISSUE 6-6-44	HE.
KIND		CHANGED	
SHAPE		" 1-26-50	W.J.
FINISH		"	
TEMP.		"	
PATT.		"	

TITLE: LIEBEL-FLARSHEIM TIMER - SELECTOR SWITCH PLATE

H. G. FISCHER & CO.
2335 WABANSIA AVE.
CHICAGO. ILL.

CAT. NO.

PART NO. 15699A

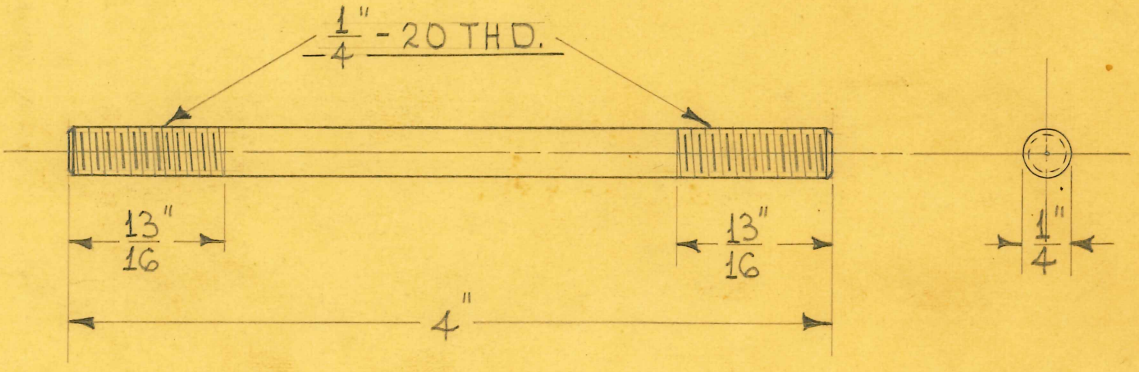

4 REQUIRED

SIZE	1/4" DIAM.	ISSUE 5-19-44	HE.
KIND	C.R. STEEL	CHANGED	
SHAPE	ROD	"	
FINISH		"	
TEMP.		"	
PATT.		"	

TITLE: MOD. "RF-100" X-RAY UNIT ~ CONTROL BOX ~ AUTO TRANSF. CLAMP STUD

H. G. FISCHER & CO.
2338 WABANSIA AVE.
CHICAGO, ILL.

CAT. NO.

PART NO. 15714

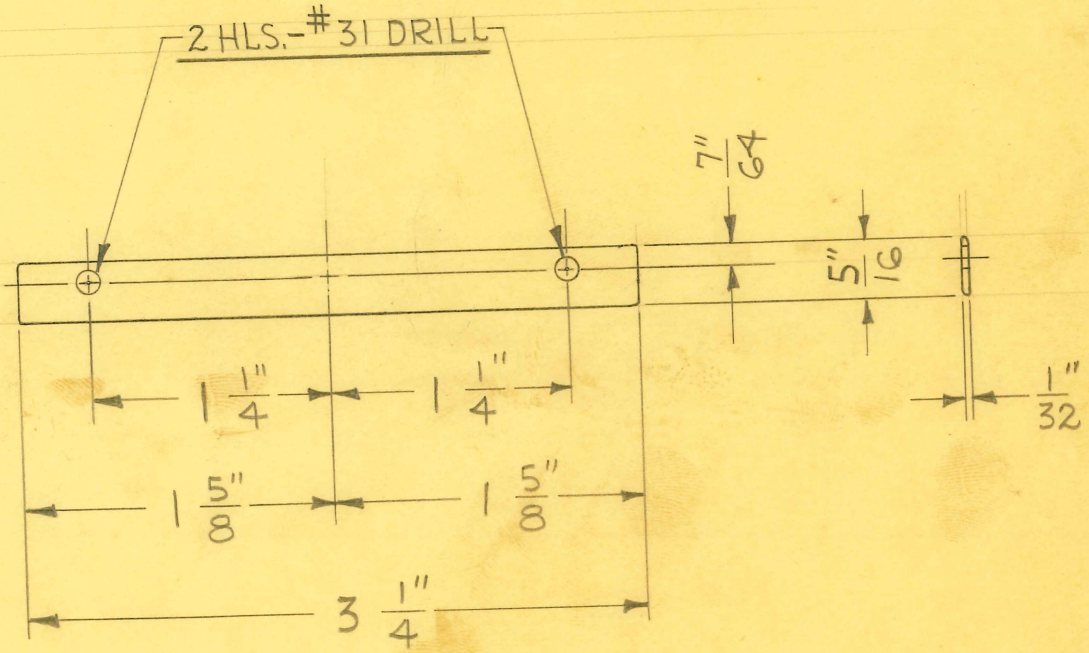

8 REQUIRED

SIZE	1/32" X 5/16"	ISSUE 11-14-45	J.V.W.	TITLE: MOD. "RF-100" X-RAY UNIT CONTROL HOUSING VENT. GRILL MTG. STRIP
KIND	FLAT WIRE	CHANGED		
SHAPE		"		
FINISH	CAD. #23	"		
TEMP.		"		
PATT.		"		

H. G. FISCHER & CO.
2335 WABANSIA AVE.
CHICAGO, ILL.

CAT. NO.

PART NO. 15716A

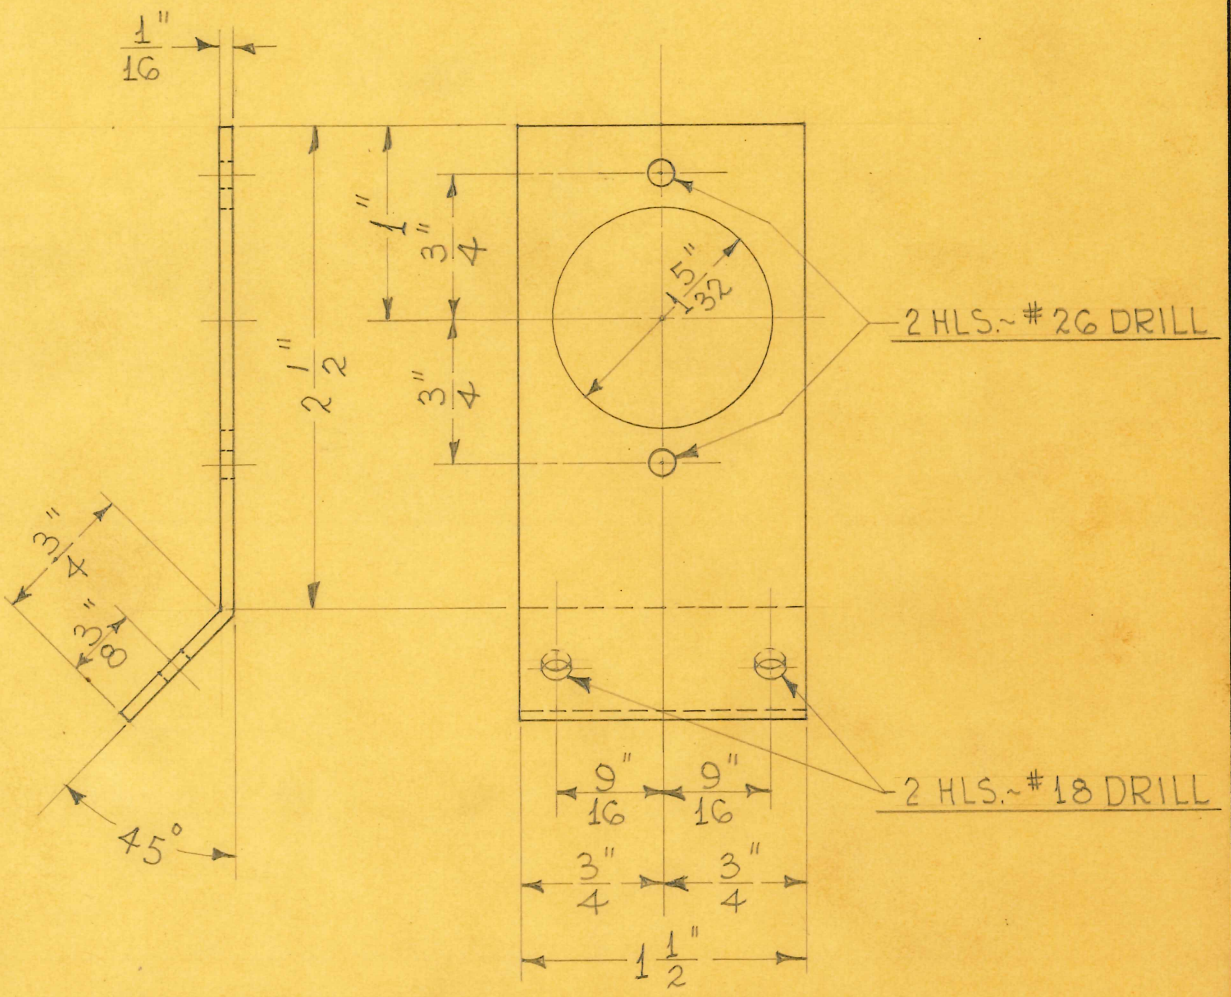

DEVELOPED LENGTH~ 3 1/4"

1 REQUIRED

SIZE	1/16 X 1 1/2"	ISSUE 6-14-44	HE.
KIND	C.R. STEEL	CHANGED	
SHAPE	STRIP	"	
FINISH	BLACK #80	"	
TEMP.		"	
PATT.		"	

TITLE: MOD. "RF-100" X-RAY UNIT ~ CONT. BOX ~ VOLTAGE REG. TUBE SOCKET MTG. BRACKET

H. G. FISCHER & CO.
2338 WABANSIA AVE.
CHICAGO, ILL.

CAT. NO.

PART NO. 15722

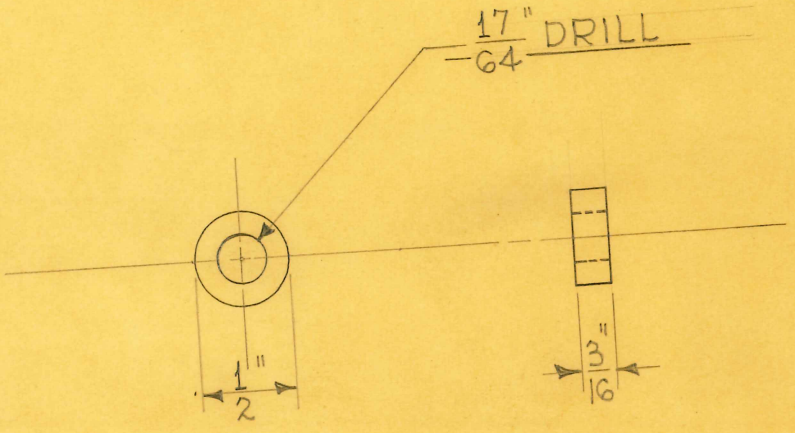

6 REQUIRED

SIZE	1/2" DIA.	ISSUE 6-19-44	HE.
KIND	BRASS ROD	CHANGED	
SHAPE		"	
FINISH		"	
TEMP.		"	
PATT.		"	

TITLE: FISCHER "RF-100" CONTROL BOX - CIRCUIT BREAKER TERMINAL SPACER

H. G. FISCHER & CO.
2335 WABANSIA AVE.
CHICAGO. ILL.

CAT. NO.

PART NO. 15728

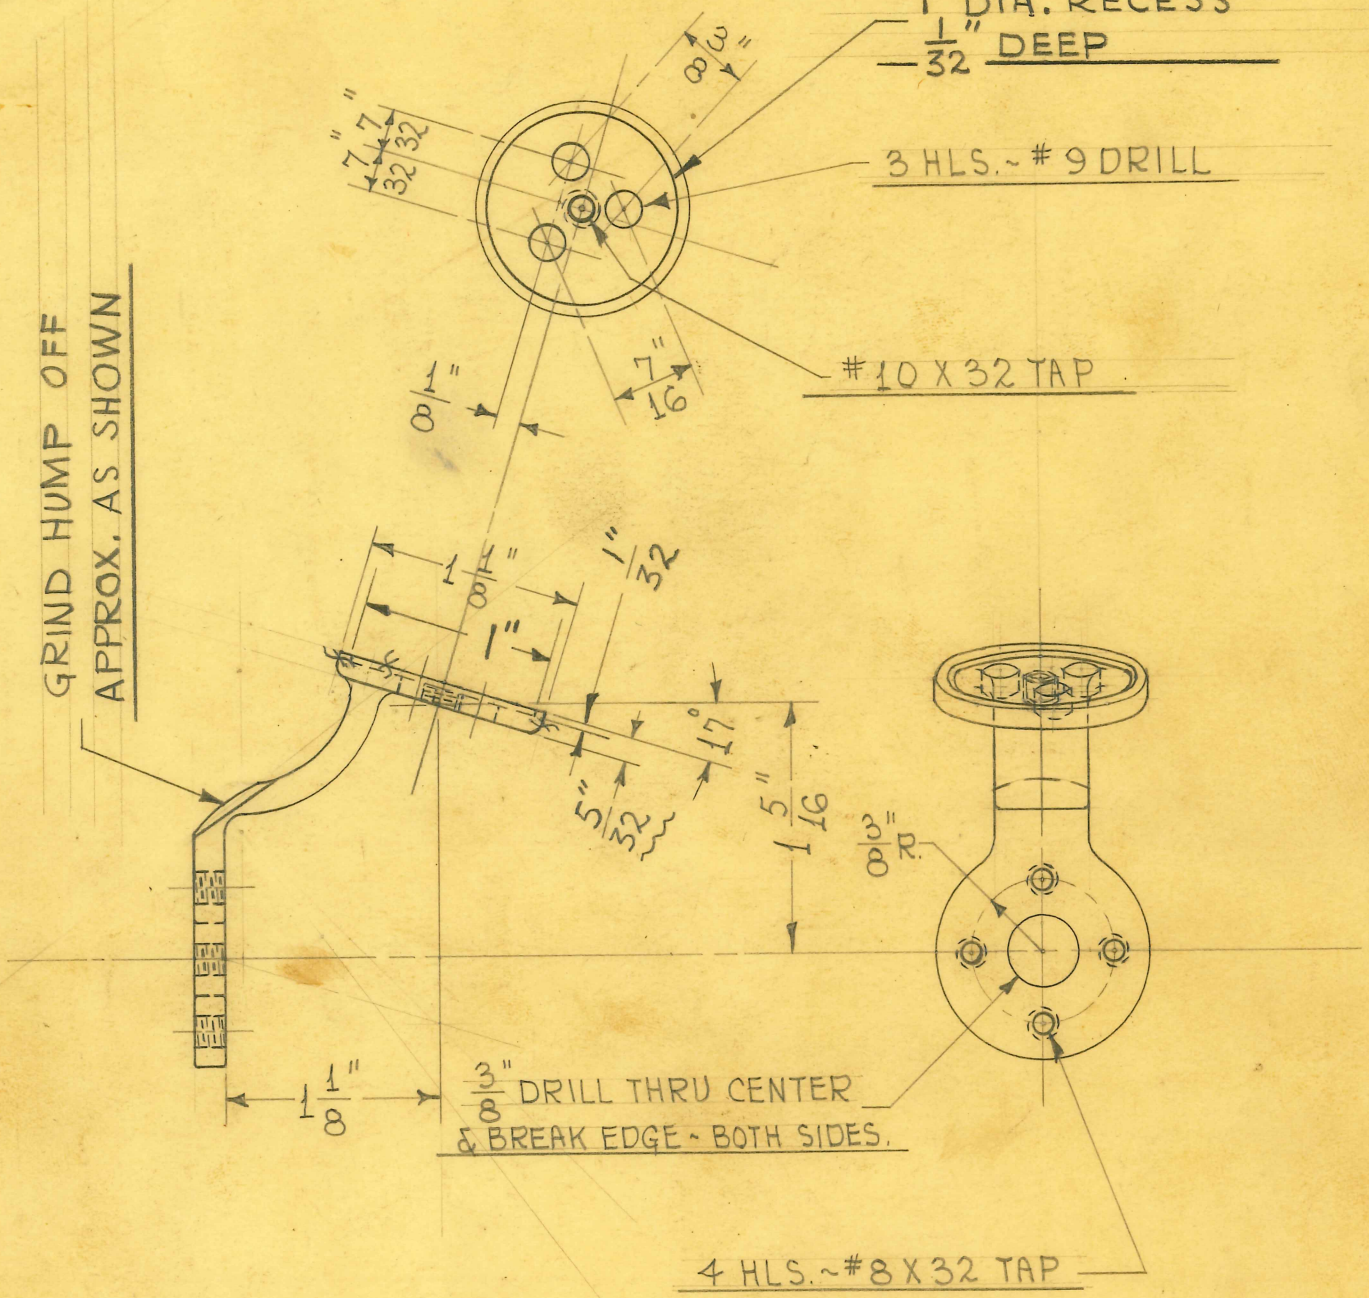

1 REQUIRED

RS

SIZE		ISSUE 6-1-45	HE.
KIND	BRASS CASTING	CHANGED	
SHAPE		"	
FINISH		"	
TEMP.		"	
PATT.	2017	"	

TITLE: FISCHER MOD. "RF-100" X-RAY APPARATUS-
X-RAY TUBE ANODE END SUPPORT

H. G. FISCHER & CO.
2335 WABANSIA AVE.
CHICAGO, ILL.

CAT. NO.

PART NO. 15746 1/2 F

TITLE
FISCHER MOD. "RF-100" X-RAY UNIT
X-RAY TUBE CATHODE END SUPP.- EUREKA

H. G. FISCHER & CO.
FRANKLIN PARK, ILLINOIS

PART NO. 15748B

DATE 7-3-53 | DR BY W. J. | CH'K'D.

REVISION	DATE	BY

PATTERN | FINISH | SCALE FULL

DIMENSIONS UNLESS OTHERWISE SPECIFIED
FRACTIONAL ± .015
DECIMAL ± .005
ANGULAR ± ½°

TOOLS DRILL JIG #8873
CUT FIX. #8875
GAUGE #8874
TURNING FIX. #8874
C'BORE FIX. # 11971

MATERIAL 1/4" SHEET BLACK BAKELITE

1 REQUIRED

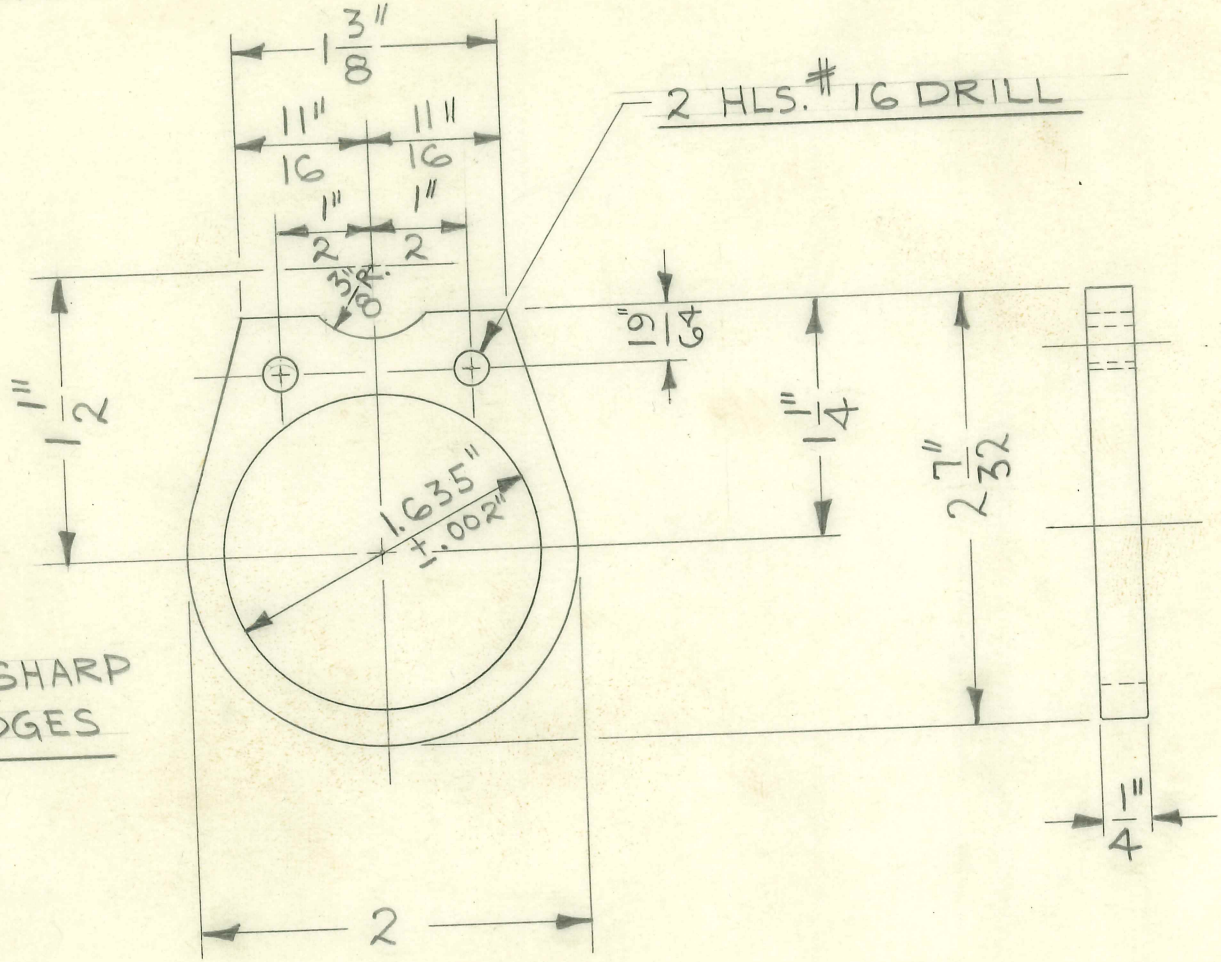

REMOVE ALL SHARP CORNERS & EDGES

FOLDER # 107

TITLE
FISCHER MOD. "RF-100" X-RAY UNIT
X-RAY TUBE CATHODE END SUPP.- DUNLEE

H. G. FISCHER & CO.
FRANKLIN PARK, ILLINOIS

PART NO. 15748 1/4 A

DATE 7-3-53 DR BY W. J. CH'K'D

REVISION | DATE | BY

PATTERN | FINISH | SCALE FULL

DIMENSIONS
FRACTIONAL ± .015
DECIMAL ± .005
ANGULAR ± 1/2°
UNLESS OTHERWISE SPECIFIED

TOOLS DRILL JIG # 8873
CUT FIX. # 8875

MATERIAL 1/4" SHEET BLACK BAKELITE

GAUGE # 11684
TURNING FIX. # 8874
CUTTING TEMPLATE PCE. # 15748 1/4 TO BE USED WITH FIX. # 8875
C'BORE FIX. # 11971

1 REQUIRED

2 HLS. # 16 DRILL

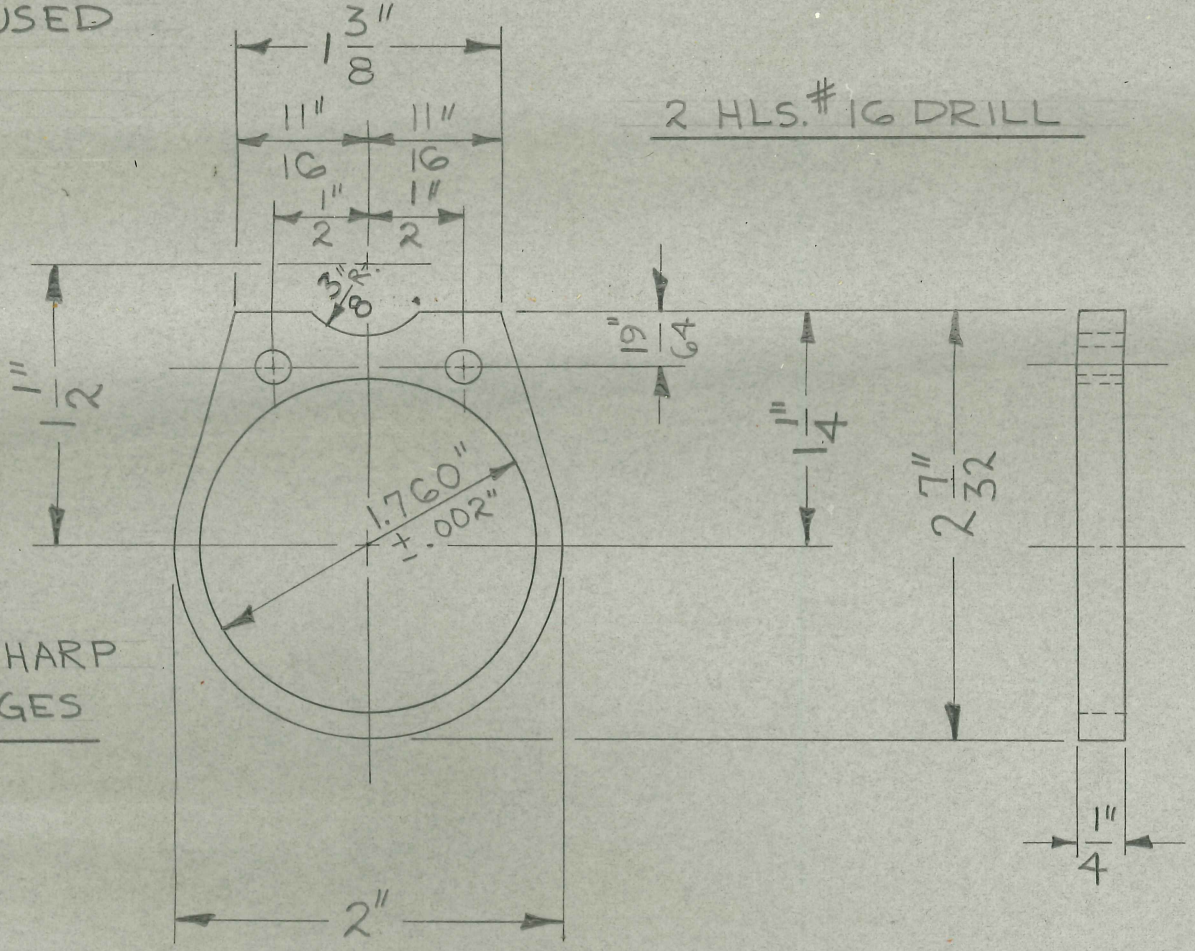

REMOVE ALL SHARP CORNERS & EDGES

FOLDER # 107

3/8" HAND PUNCH #15759 USE WITH PUNCH #14534 11/16" O.D.

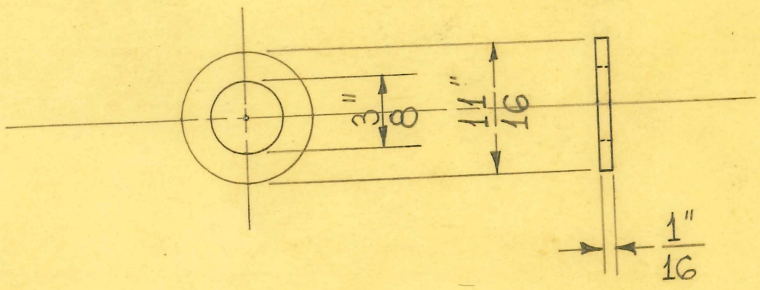

1 REQUIRED

1/16" SHEET NEOPRENE #2065-#70 DUROMETER TEST

RJ

SIZE	~~1/16" SHEET~~	ISSUE 7-3-45	HE,
KIND	~~NEOPRENE~~	CHANGED	
SHAPE		"	
FINISH		"	
TEMP.		"	
PATT.		"	

TITLE: FISCHER MOD. "100-9G" DIAG. S.P. X-RAY TUBE HEAD BELLOWS SUPPORT-GASKET

H. G. FISCHER & CO.
2335 WABANSIA AVE.
CHICAGO, ILL.

CAT. NO.

PART NO. 15759

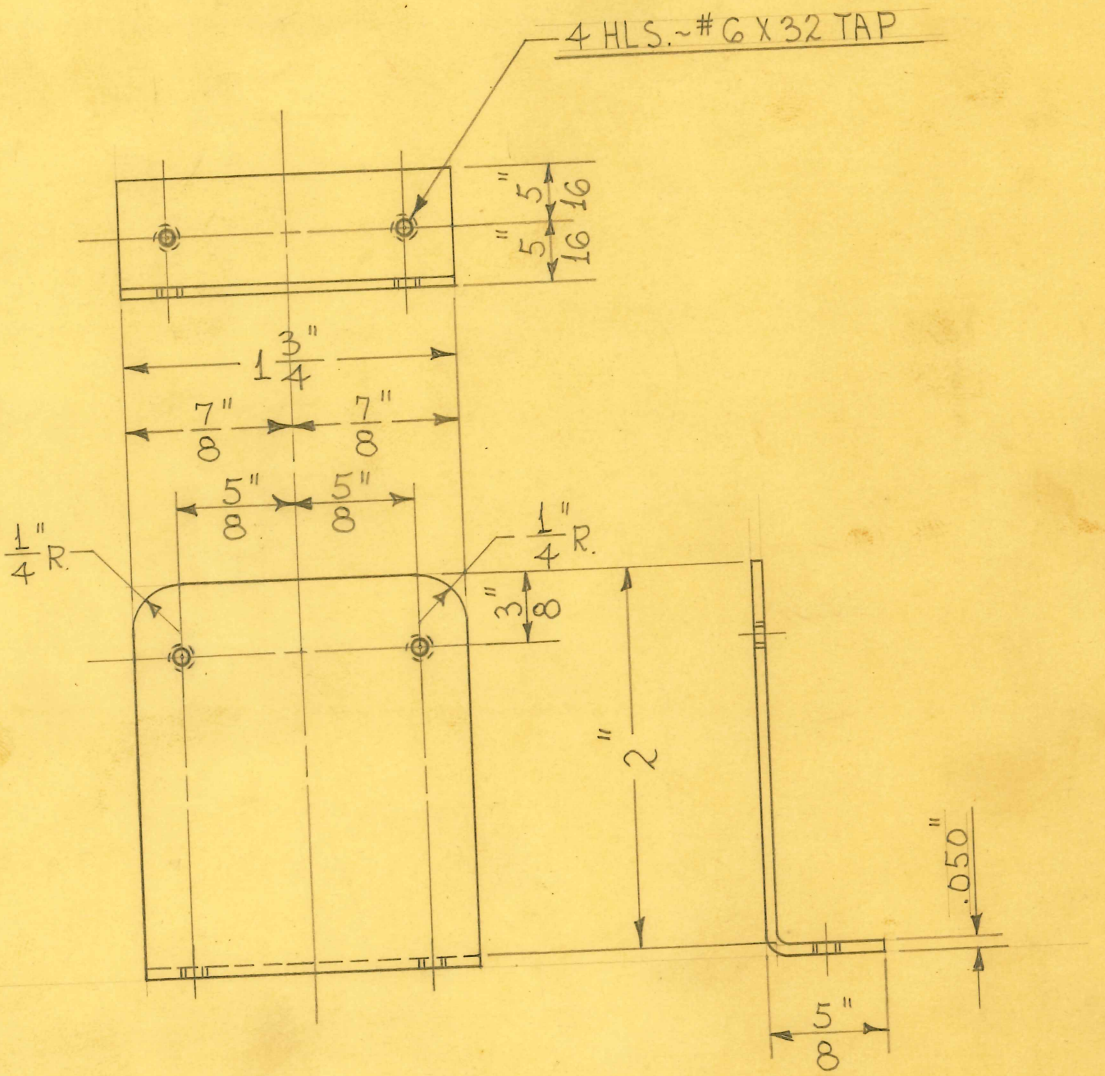

DEVELOPED LENGTH - 2 19/32"

1 REQUIRED

SIZE	.050" X 1 3/4"	ISSUE 6-21-45	HE
KIND	SHEARED	CHANGED	
SHAPE	C.R. STEEL	"	
FINISH	PAINTED	"	
TEMP.		"	
PATT.		"	

TITLE: FISCHER "RF-100" X-RAY APPARATUS
FOCAL DISTANCE SCALE SUPPORT BRACKET

H. G. FISCHER & CO.
2335 WABANSIA AVE.
CHICAGO, ILL.

CAT. NO.

PART NO. 15777 1/2

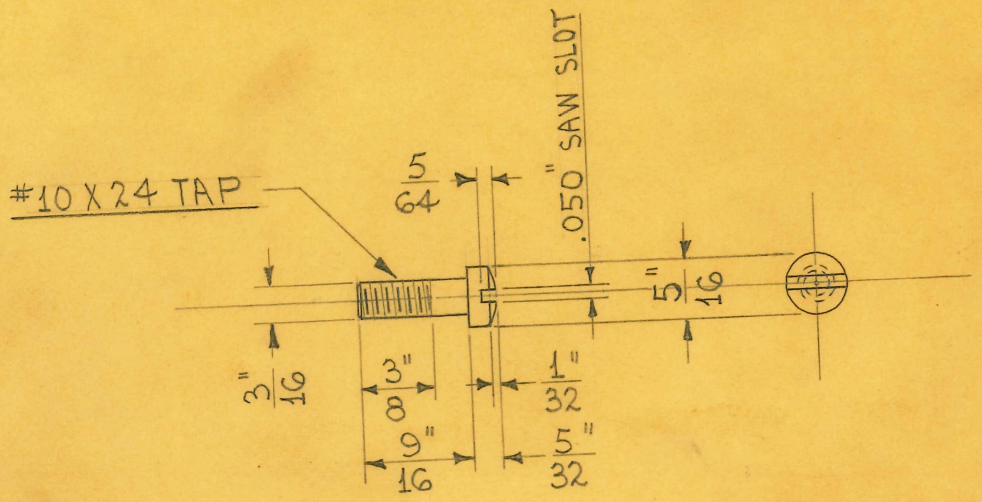

16 REQUIRED

SIZE	5/16" DIAM.	ISSUE 2-2-45	HE.
KIND	SCR. STOCK	CHANGED	
SHAPE		"	
FINISH	WH. CHR. #3	"	
TEMP.		"	
PATT.		"	

TITLE: FISCHER MOD. "RF-100" X-RAY UNIT - TUBE HOUSING END CAP SCREW

H. G. FISCHER & CO.
2335 WABANSIA AVE.
CHICAGO. ILL.

CAT. NO.

PART NO. 15792

2-HLS.—#6X32 TAP

2-HLS.—#18 DRILL
C'SUNK. TO $\frac{9}{32}$" FACE.

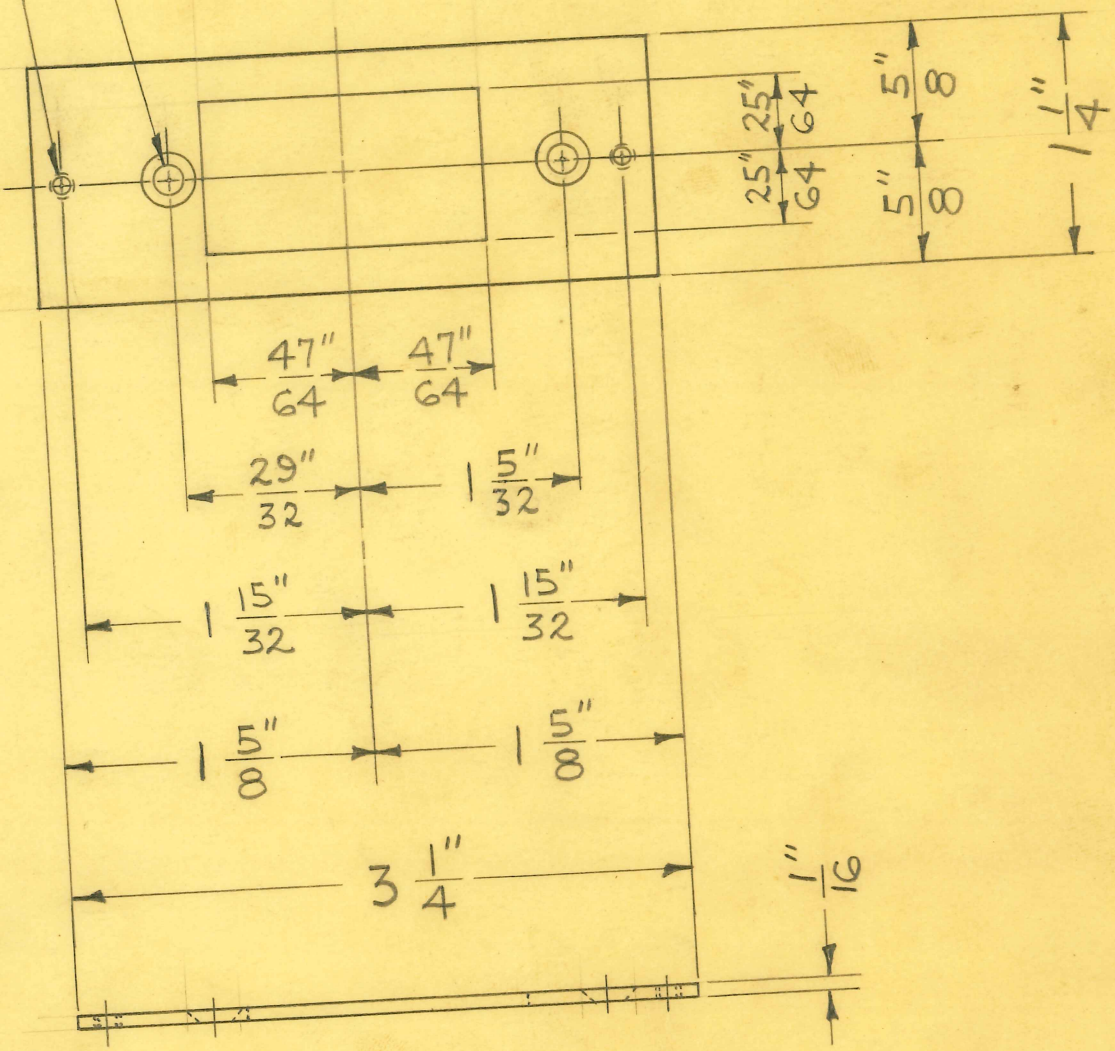

1 REQUIRED

SIZE	1/16" X 1 1/4"	ISSUE	
KIND	FLAT WIRE	CHANGED	
SHAPE		"	
FINISH	CAD. #23	"	
TEMP.		"	
PATT.		"	

TITLE: STABILIZED WALL MODEL DENTAL-X
CIRCUIT BREAKER MOUNTING PLATE

H. G. FISCHER & CO.
2335 WABANSIA AVE.
CHICAGO, ILL.

CAT. NO.

PART NO. 15805

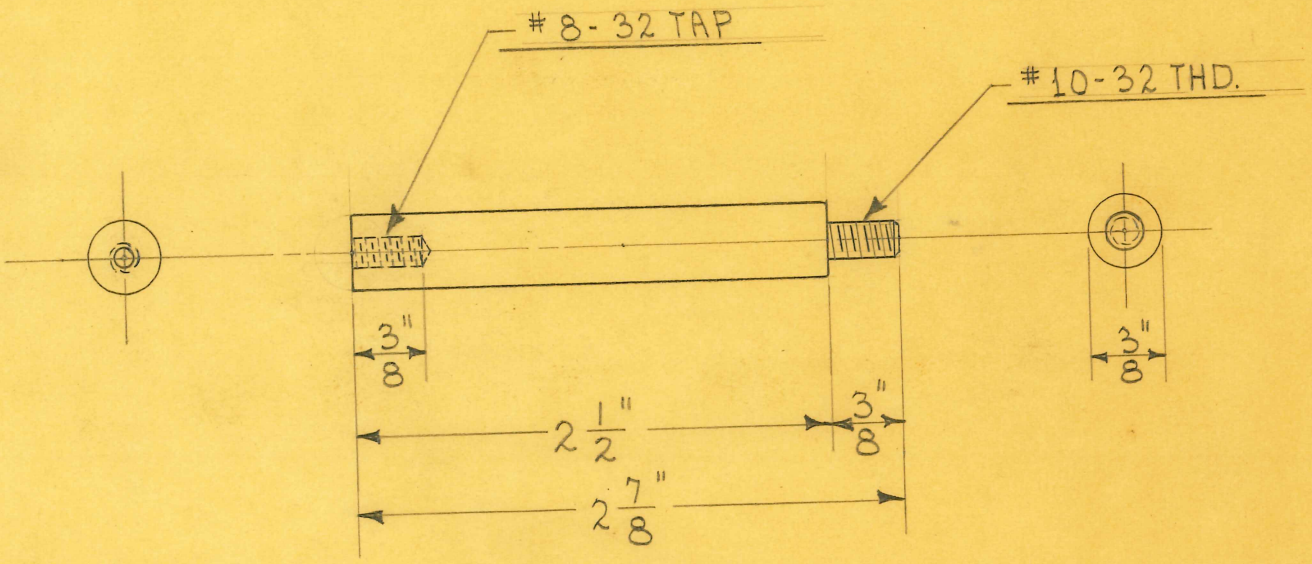

2 REQUIRED

SIZE	3/8" DIAM.	ISSUE 5-5-44	HE.
KIND	BRASS ROD	CHANGED	
SHAPE		"	
FINISH		"	
TEMP.		"	
PATT.		"	

TITLE: WALL MODEL DENTAL X-RAY UNIT-
CONTROL BOX TRANSF. SUPPORT SPACER

H. G. FISCHER & CO.
2335 WABANSIA AVE.
CHICAGO. ILL.

CAT. NO.

PART NO. 15807

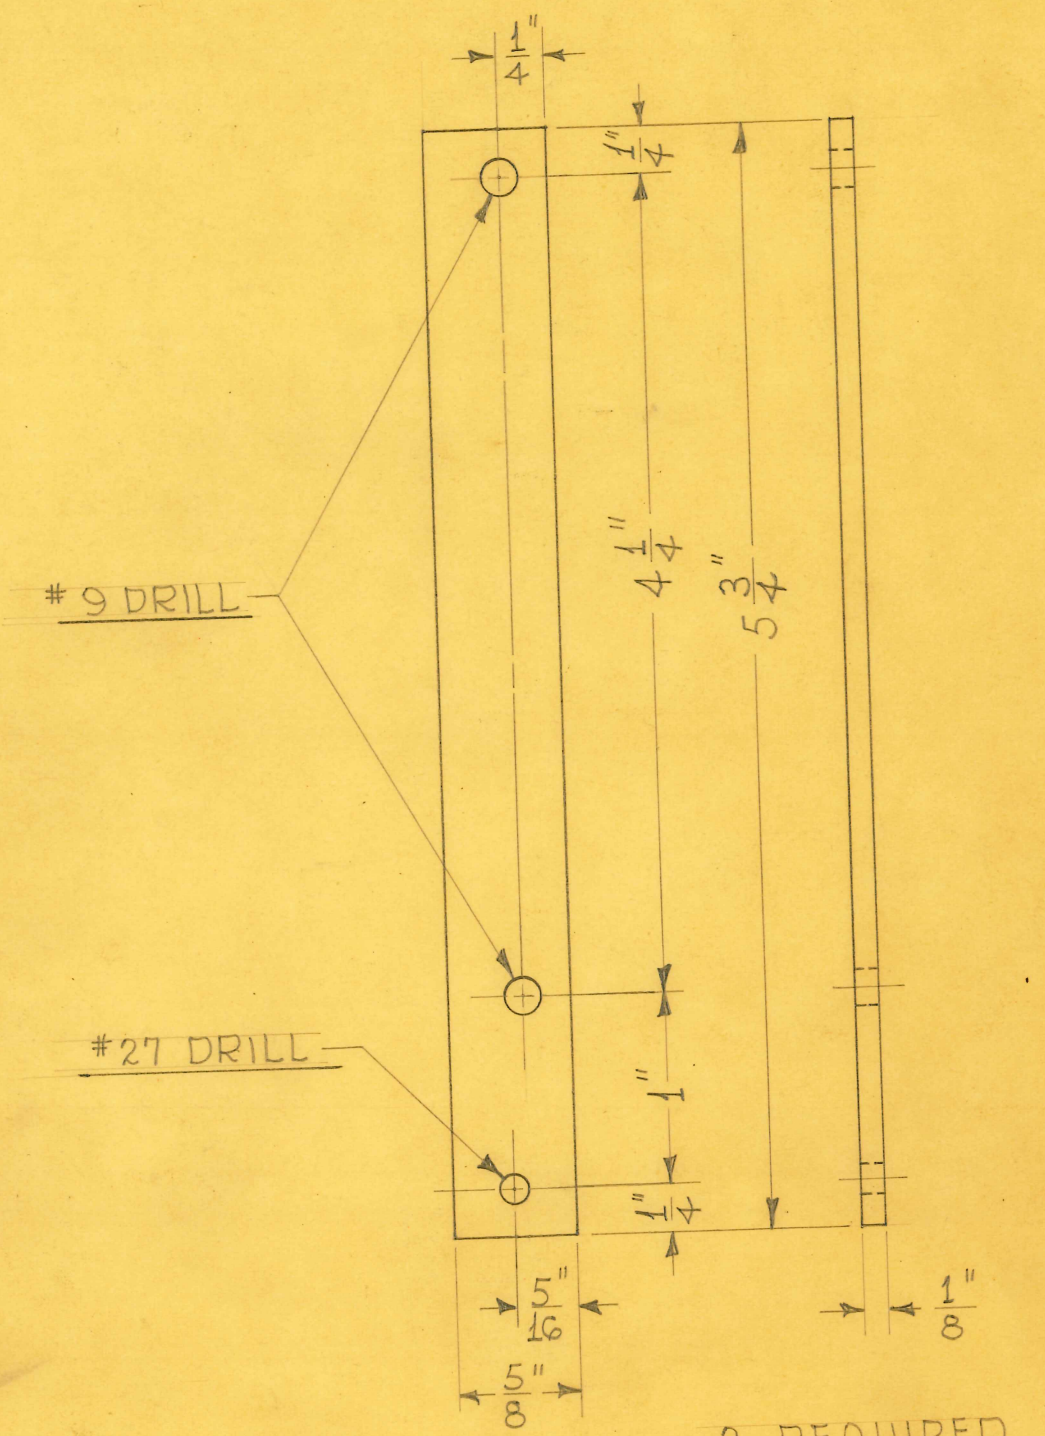

SIZE	1/8" X 5/8"	ISSUE 8-3-44	E.
KIND	FLAT COLD	CHANGED	
SHAPE	DRAWN STL.	"	
FINISH	BLACK #80	"	
TEMP.		"	
PATT.		"	

TITLE: WALL MODEL DENTAL X-RAY UNIT ~ AUTO TRANSF. CLAMP STRIP

H. G. FISCHER & CO.
2335 WABANSIA AVE.
CHICAGO, ILL.

CAT. NO.

PART NO. 15811

CUT OFF PIN TO 1" DIM.
& ROUND THE EDGE

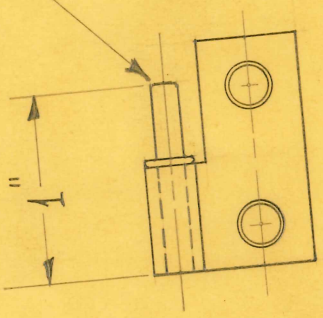

1 REQUIRED

SIZE	FROM 1581GG	ISSUE 8-30-44	HE.
KIND		CHANGED	
SHAPE		"	
FINISH	WH. CHR. #3	"	
TEMP.		"	
PATT.		"	

TITLE: WALL MODEL DENTAL X-RAY UNIT
CONTROL BOX HINGE - UPPER

H. G. FISCHER & CO.
2335 WABANSIA AVE.
CHICAGO. ILL.

CAT. NO.

PART NO. 158

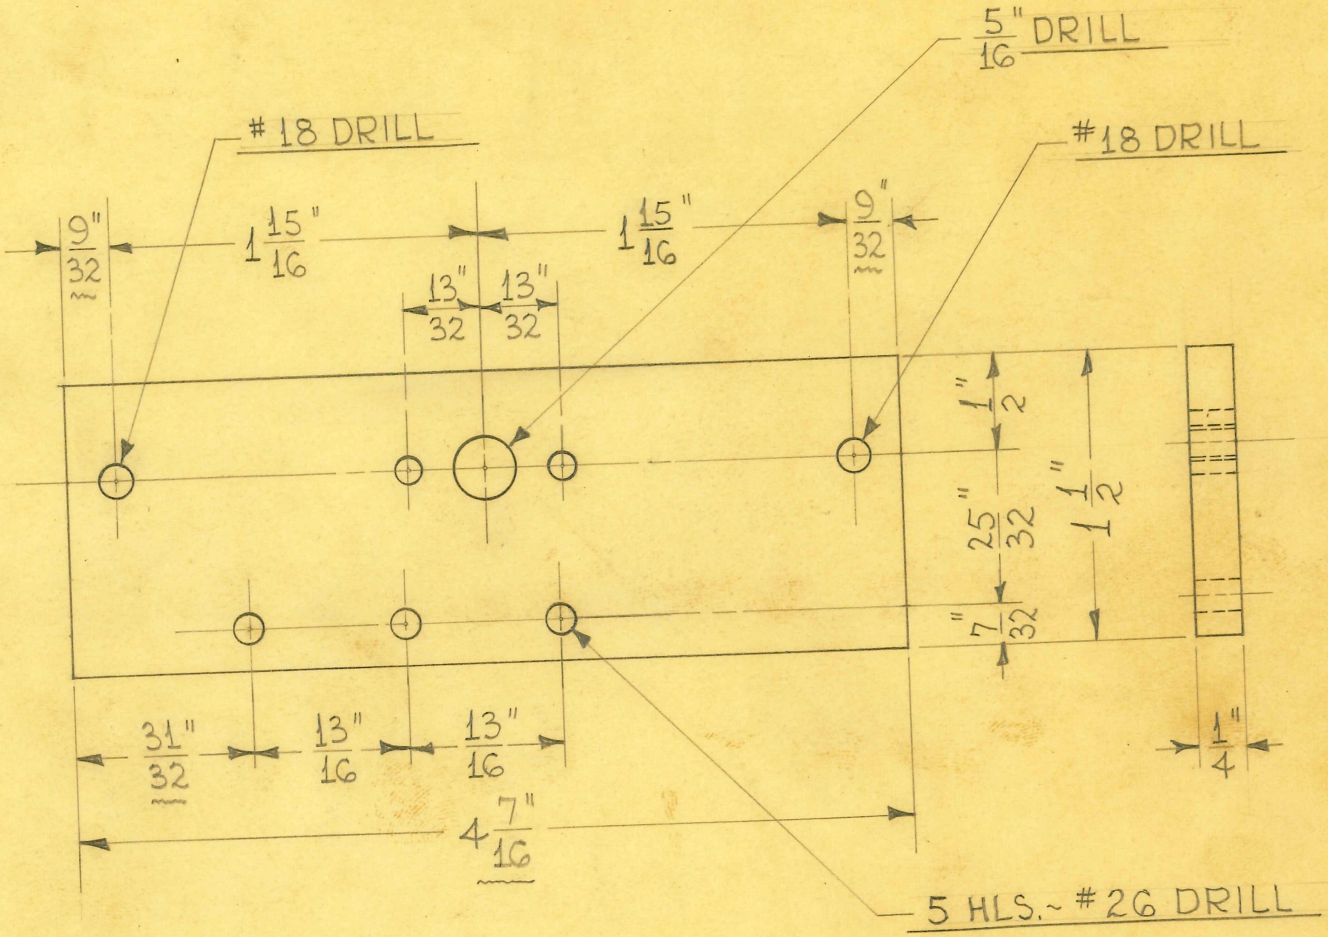

1 REQUIRED

SIZE	1/4" SHEET	ISSUE 9-12-44	HE
KIND	BLK. BAKELITE	CHANGED	
SHAPE		"	
FINISH		"	
TEMP.		"	
PATT.		"	

TITLE: STABILIZED WALL MODEL DENTAL "X" - VOLTAGE STABILIZER BASE.

H. G. FISCHER & CO.
2338 WABANSIA AVE.
CHICAGO. ILL.

CAT. NO.

PART NO. 15821

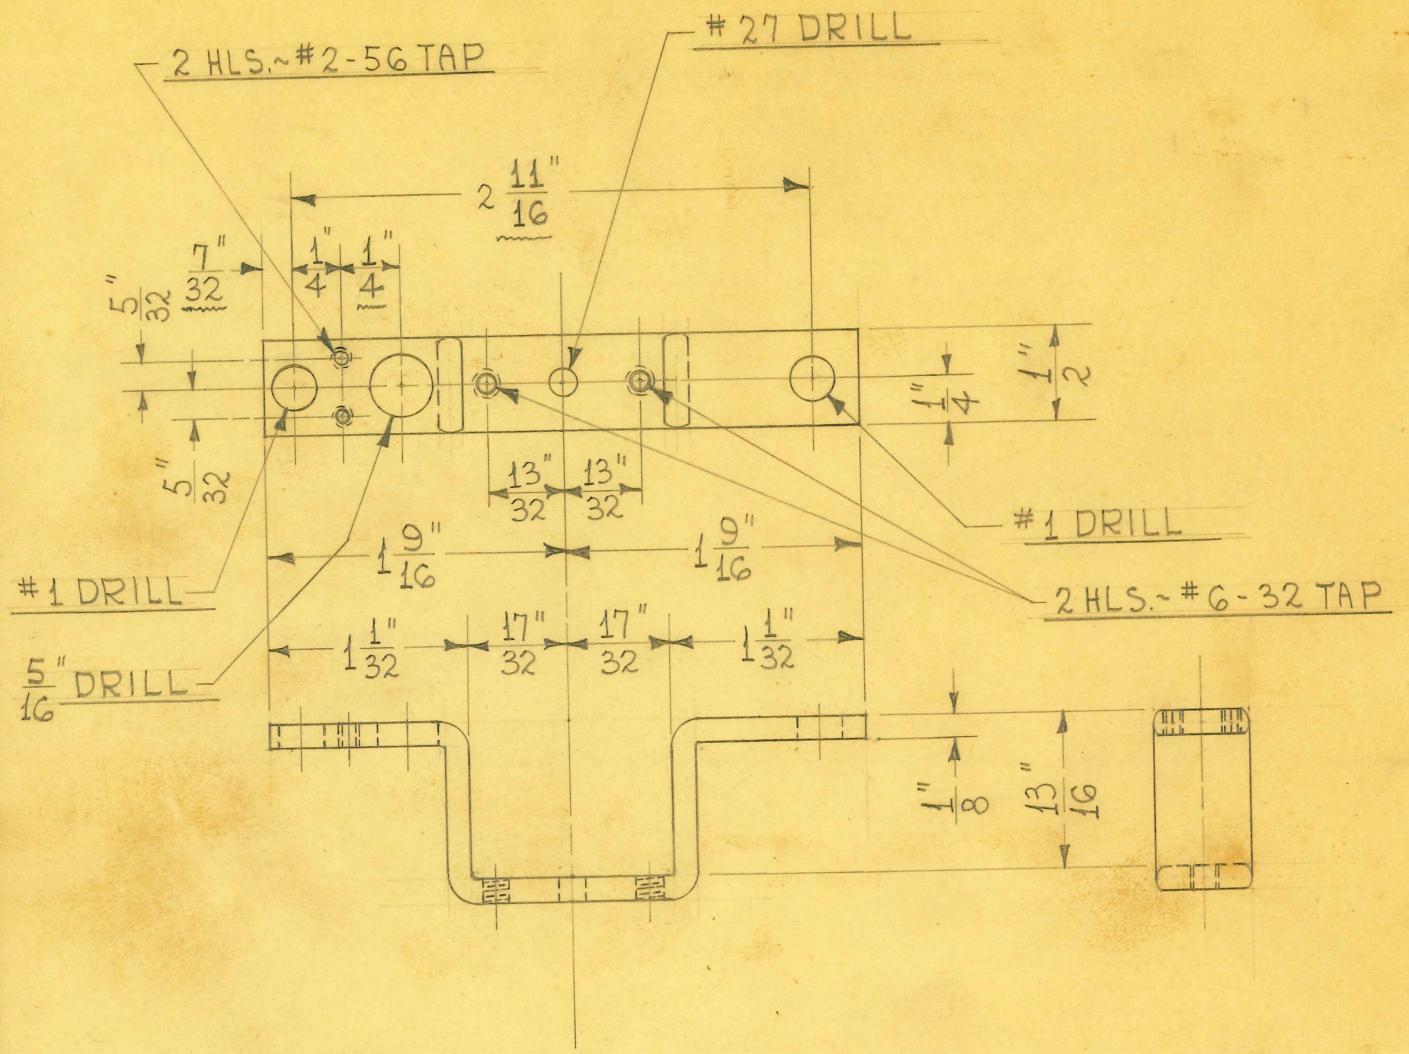

DEVELOPED LENGTH = 4 19/32"

1 REQUIRED

SIZE	1/8" X 1/2"	ISSUE 9-13-44	HE.
KIND	FLAT WIRE	CHANGED	
SHAPE		"	
FINISH	BLACK #80	"	
TEMP.		"	
PATT.		"	

TITLE: STABILIZED WALL MODEL DENTAL "X" - VOLTAGE STABILIZER VIBRATOR SUPPORT

H. G. FISCHER & CO.
2335 WABANSIA AVE.
CHICAGO, ILL.

CAT. NO.

PART NO. 15822

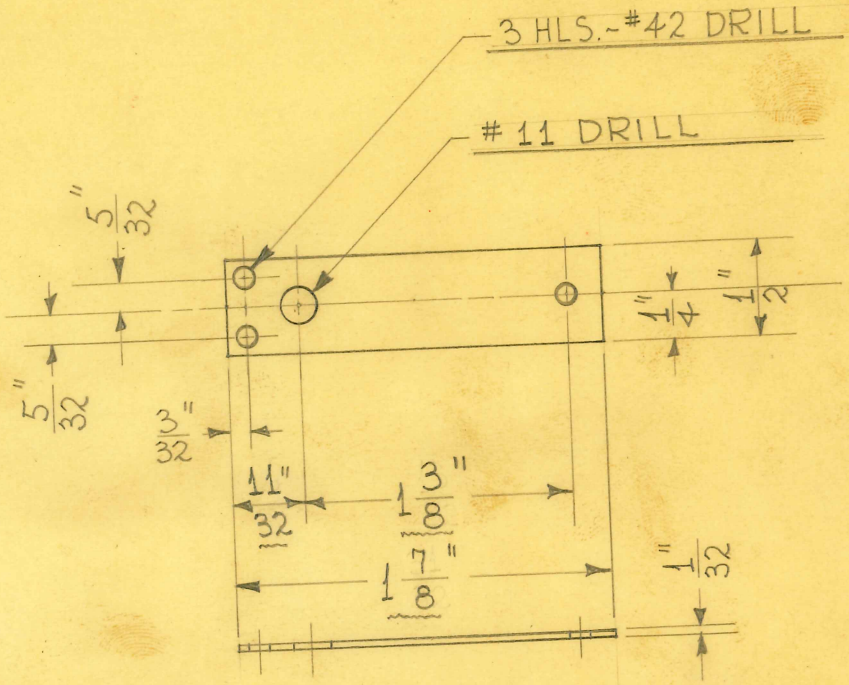

1 REQUIRED

SIZE	1/32" X 1/2"	ISSUE 9-12-44	HE.
KIND	FLAT SPRING	CHANGED	
~~SHAPE~~	STEEL	"	
FINISH		"	
TEMP.		"	
PATT.		"	

TITLE: STABILIZED WALL MODEL DENTAL "X" ~ VOLTAGE STABILIZER VIBRATOR

H. G. FISCHER & CO.
2335 WABANSIA AVE.
CHICAGO. ILL.

CAT. NO.

PART NO. 15823

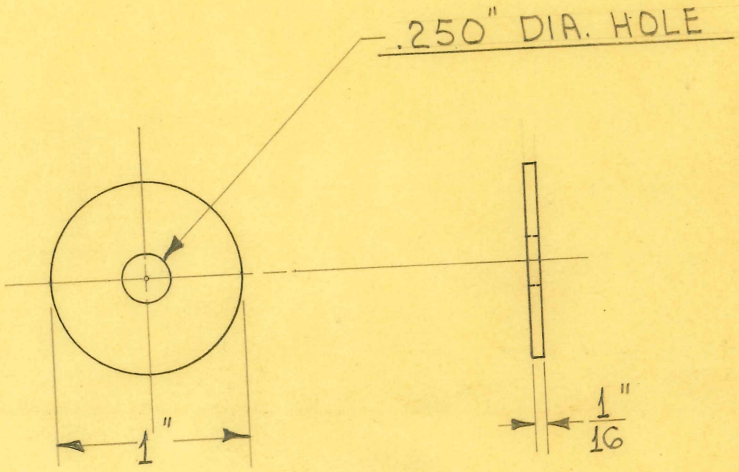

2 REQUIRED

SIZE	1/16" SHEET	ISSUE 9-11-44	HE.
KIND	CANVAS BASE	CHANGED	
SHAPE	BLK. BAKELITE	"	
FINISH		"	
TEMP.		"	
PATT.		"	

TITLE: STABILIZED WALL MODEL DENTAL "X" - VOLTAGE STABILIZER - SPOOL FLANGE

H. G. FISCHER & CO.
2335 WABANSIA AVE.
CHICAGO. ILL.

CAT. NO.

PART NO. 15824

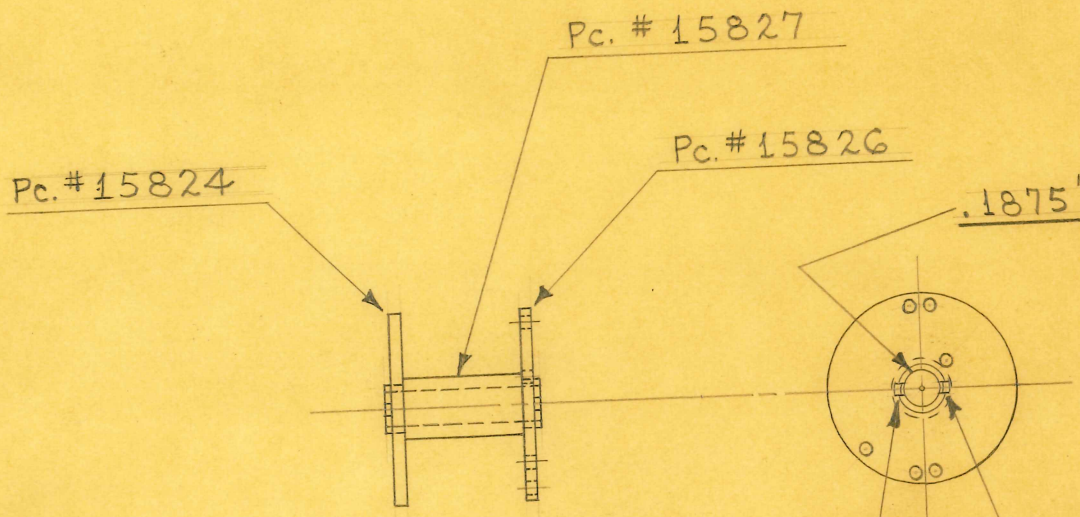

BUMP ENDS OF BODY AFTER ASSEM. TO HOLD FLANGES IN PLACE

1 REQUIRED

SIZE		ISSUE 9-15-44	HE.
KIND		CHANGED	
SHAPE		"	
FINISH		"	
TEMP.		"	
PATT.		"	

TITLE: STABILIZED WALL MODEL DENTAL "X" VOLTAGE STABILIZER COIL SPOOL

H. G. FISCHER & CO.
2335 WABANSIA AVE.
CHICAGO. ILL.

CAT. NO.

PART NO. 15825

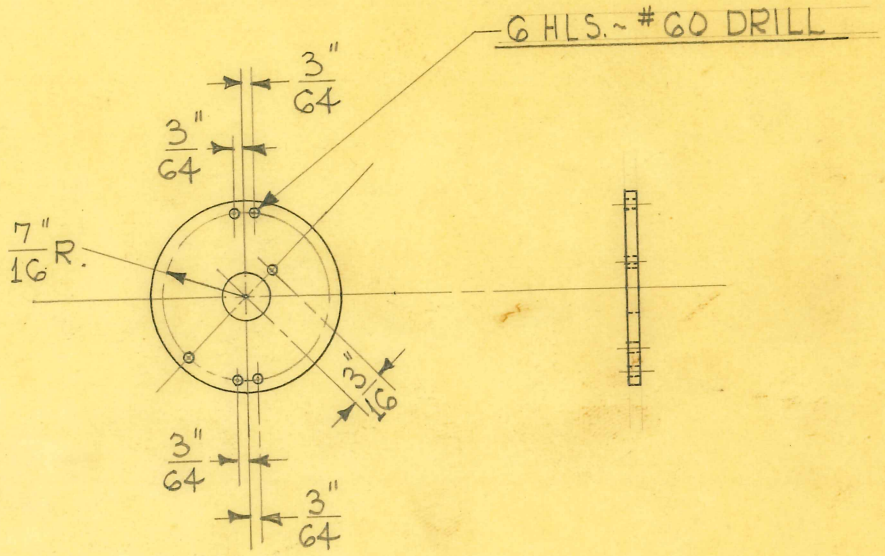

1 REQUIRED

SIZE	FROM 15824	ISSUE 9-11-44	HE.
KIND		CHANGED	
SHAPE		"	
FINISH		"	
TEMP.		"	
PATT.		"	

TITLE: STABILIZED WALL MODEL DENTAL "X" - VOLTAGE STABILIZER - SPOOL FLANGE (DRILLED

H. G. FISCHER & CO.
2338 WABANSIA AVE.
CHICAGO. ILL.

CAT. NO.

PART NO. 15826

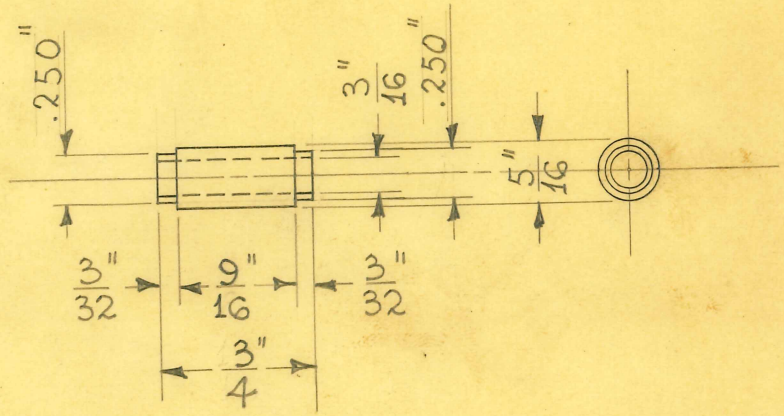

1 REQUIRED

SIZE	3/16" I.D. X 5/16" O.D.	ISSUE 9-11-44	H.E.
KIND	GREY FIBRE	CHANGED	
SHAPE	TUBING	"	
FINISH		"	
TEMP.		"	
PATT.		"	

TITLE: STABILIZED WALL MODEL DENTAL "X" - VOLTAGE STABILIZER - SPOOL BODY

H. G. FISCHER & CO.
2335 WABANSIA AVE.
CHICAGO. ILL.

CAT. NO.

PART NO. 15827

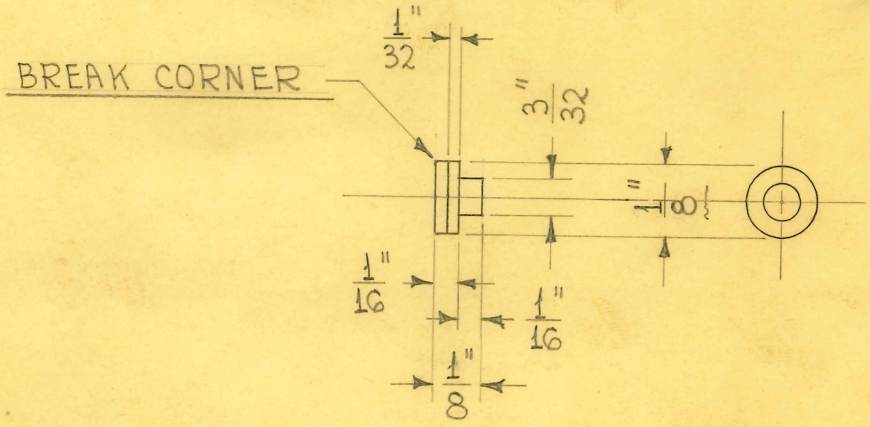

1 REQUIRED

SCALE ~ 1" = 1/2"

FANSTEEL STD. PART No. 73-A-1259

SIZE		ISSUE	
KIND	TUNGSTEN	CHANGED	
SHAPE		"	
FINISH		"	
TEMP.		"	
PATT.		"	

TITLE: STABILIZED WALL MODEL DENTAL "X" - VOLTAGE STABILIZER - CONTACT POINT

H. G. FISCHER & CO.
2338 WABANSIA AVE.
CHICAGO, ILL.

CAT. NO.

PART NO. 15828

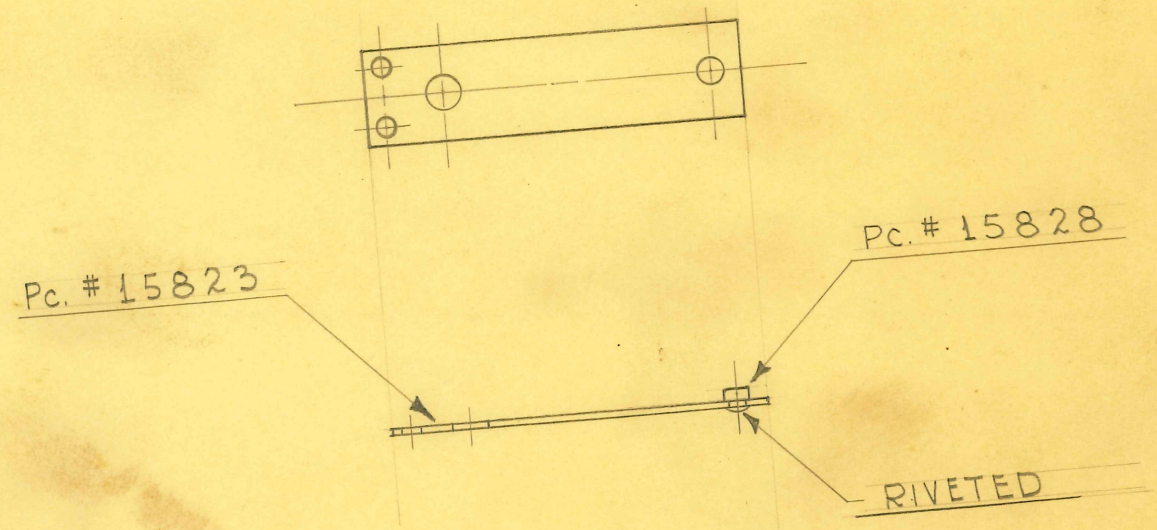

1 REQUIRED

SIZE		ISSUE 9-15-44	HE.
KIND		CHANGED	
SHAPE		"	
FINISH		"	
TEMP.		"	
PATT.		"	

TITLE: STABILIZED WALL MODEL DENTAL "X
VOLTAGE STABILIZER - VIBRATOR ASSE

H. G. FISCHER & CO.
2335 WABANSIA AVE.
CHICAGO. ILL.

CAT. NO.

PART NO. 158

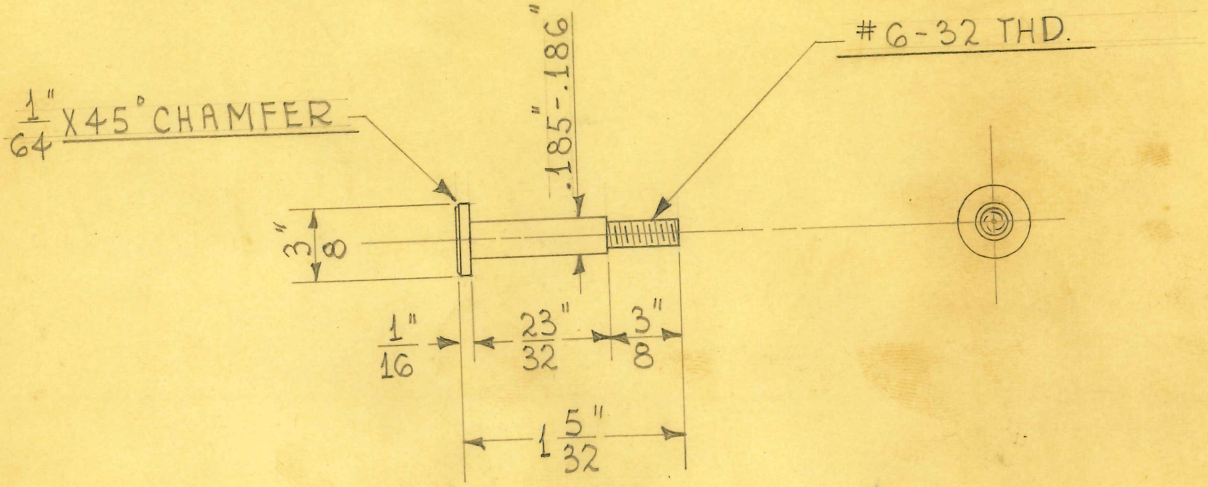

1 REQUIRED

SIZE	3/8" DIA.	ISSUE 9-13-44	H.
KIND	C.R. STEEL	CHANGED	
SHAPE	ROD	"	
FINISH	CAD. #23	"	
TEMP.		"	
PATT.		"	

99

TITLE: STABILIZED WALL MODEL DENTAL "X" - VOLTAGE STABILIZER - COIL SPOOL STUD

H. G. FISCHER & CO.
2335 WABANSIA AVE.
CHICAGO, ILL.

CAT. NO.

PART NO. 15831

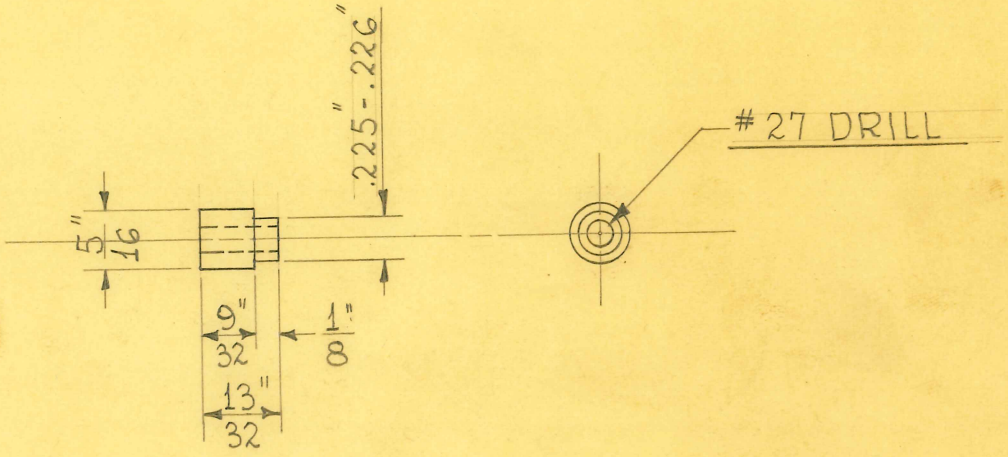

2 REQUIRED

SIZE	5/16" DIAM.	ISSUE 9-13-44	HE.
KIND	BLK. BAKELITE	CHANGED	
SHAPE	ROD	"	
FINISH		"	
TEMP.		"	
PATT.		"	

TITLE: STABILIZED WALL MODEL DENTAL "X" - VOLTAGE STABILIZER - ADJ. CONT. ARM SPACER

H. G. FISCHER & CO.
2335 WABANSIA AVE.
CHICAGO, ILL.

CAT. NO.

PART NO. 15832

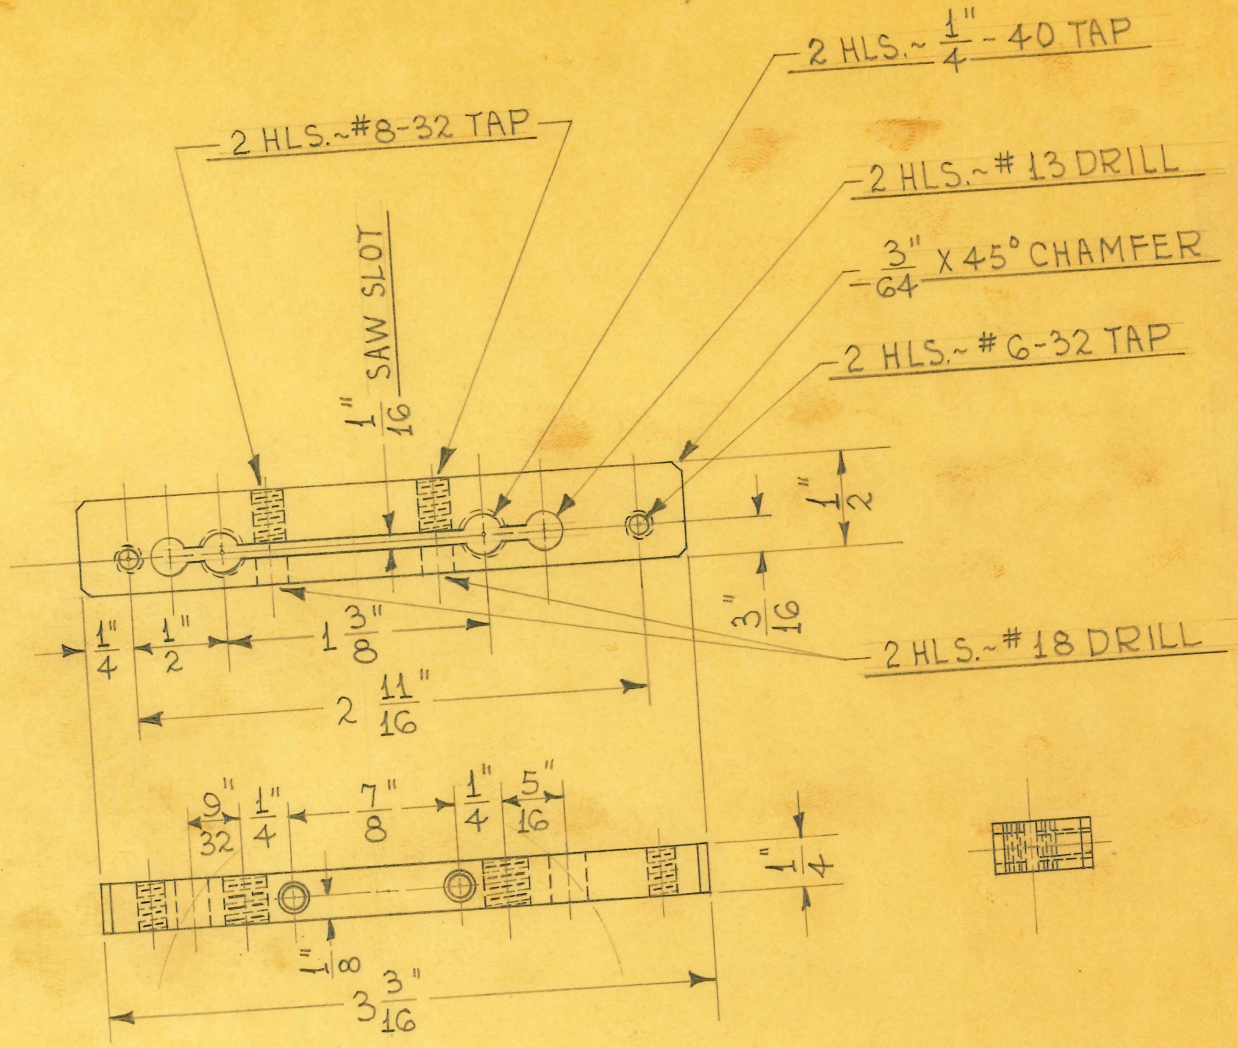

1 REQUIRED

SIZE	1/4" X 1/2"	ISSUE 10-10-44	HE.
KIND	BRASS BAR	CHANGED	
SHAPE		"	
FINISH		"	
TEMP.		"	
PATT.		"	

TITLE: STABILIZED WALL MODEL DENTAL "X" VOLTAGE STABILIZER-ADJ. CONTACT AR

H. G. FISCHER & CO.
2335 WABANSIA AVE.
CHICAGO. ILL.

CAT. NO.

PART NO. 1583

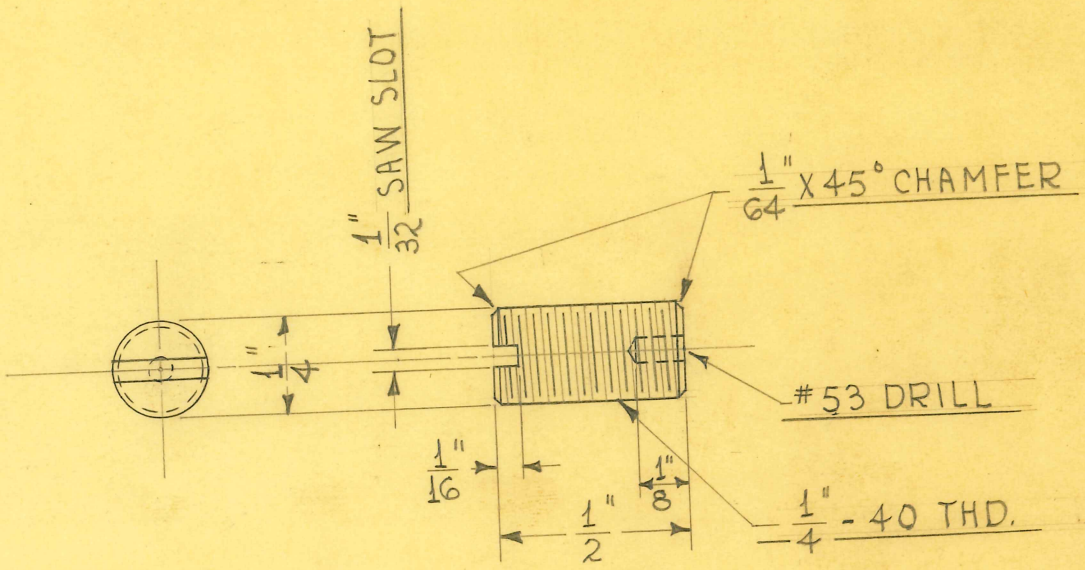

SCALE ~ 1" = 1/2"

1 REQUIRED

SIZE	1/4" DIAM.	ISSUE 9-11-44	HE.
KIND	BRASS ROD	CHANGED	
SHAPE		"	
FINISH		"	
TEMP.		"	
PATT.		"	

TITLE: STABILIZED WALL MODEL DENTAL "X" - VOLTAGE STABILIZER - ADJUSTABLE CONTACT SCRE

H. G. FISCHER & CO.
2338 WABANSIA AVE.
CHICAGO. ILL.

CAT. NO.

PART NO. 15834

99

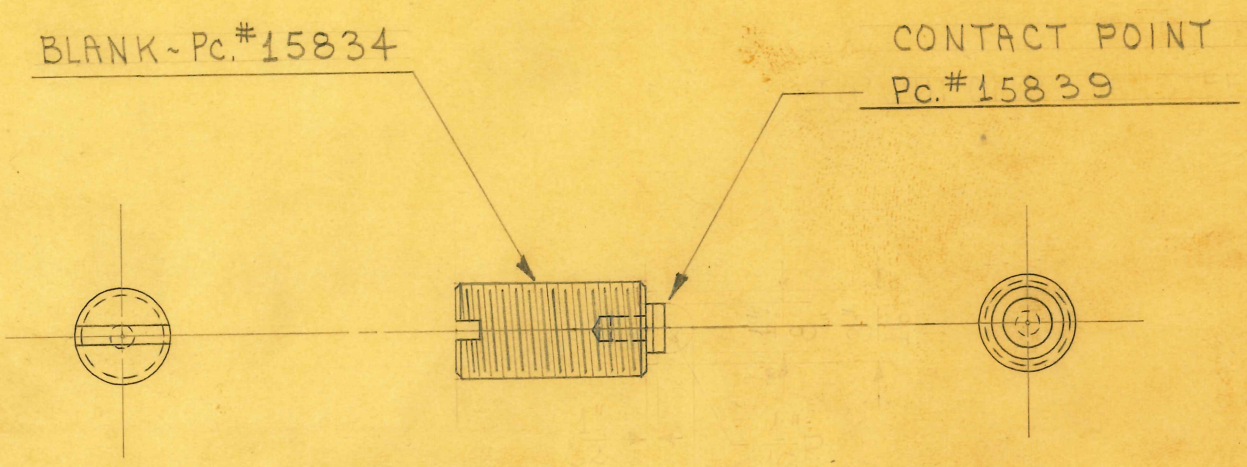

1 REQUIRED

SCALE ~ 1" = 1/2"

SIZE		ISSUE 9-8-44	HE.
KIND		CHANGED	
SHAPE		"	
FINISH		"	
TEMP.		"	
PATT.		"	

TITLE: STABILIZED WALL MODEL DENTAL "X" ~ VOLTAGE STABILIZER ~ ADJUSTABLE CONTACT

H. G. FISCHER & CO.
2335 WABANSIA AVE.
CHICAGO. ILL.

CAT. NO.

PART NO. 15835G

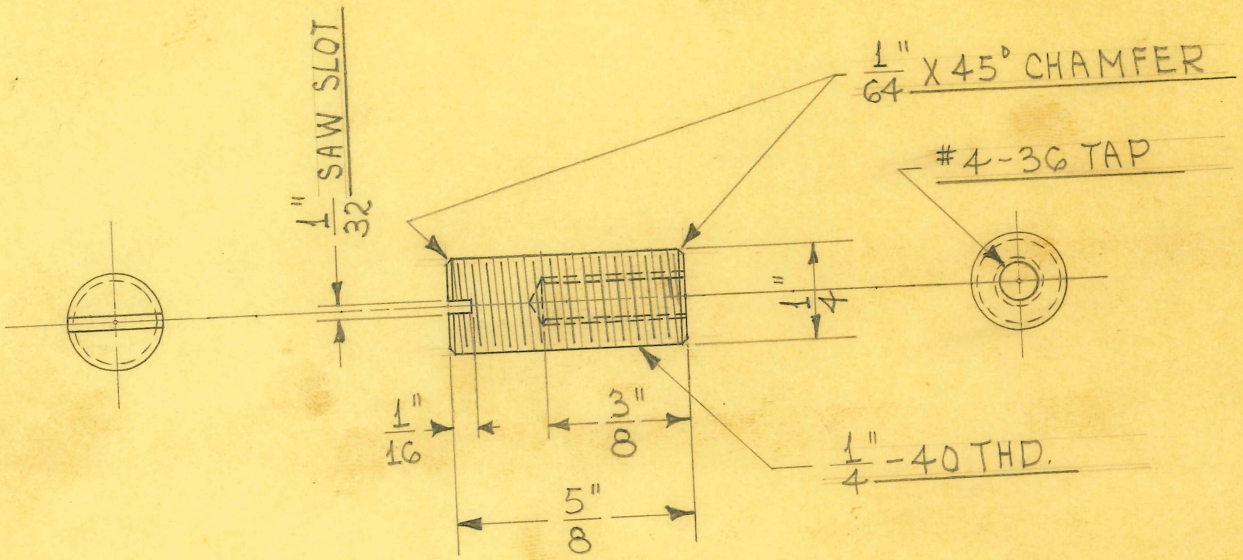

SCALE ~ 1" = 1"
2

1 REQUIRED

SIZE	1/4" DIAM.	ISSUE 9-14-44	HE.
KIND	BRASS ROD	CHANGED	
SHAPE		"	
FINISH		"	
TEMP.		"	
PATT.		"	

TITLE: STABILIZED WALL MODEL DENTAL "X" - VOLTAGE STABILIZER - VIBRATOR TENSION SCR

H. G. FISCHER & CO.
2335 WABANSIA AVE.
CHICAGO. ILL.

CAT. NO.

PART NO. 15836

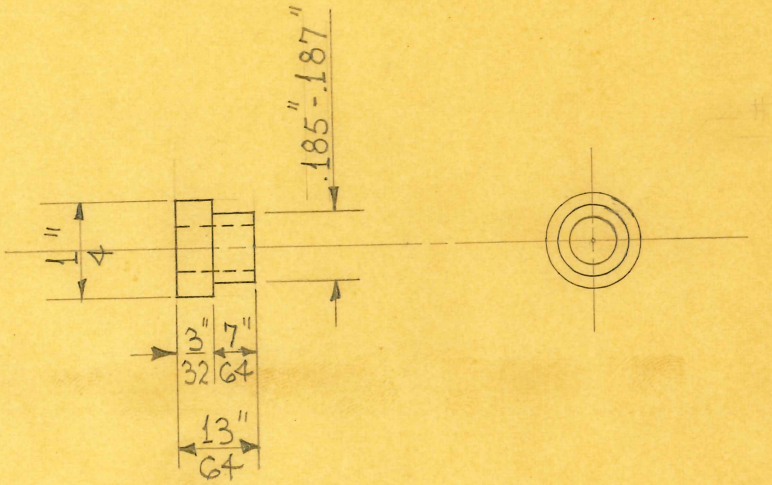

SCALE ~ 1" = 1/2"

1 REQUIRED

1/4" O.D. X 1/8" I.D. FABRIC BASE BAKELITE TUBING

SIZE	~~1/4" DIAM.~~	ISSUE 9-15-44	HE.	TITLE: STABILIZED WALL MODEL DENTAL "X" ~ VOLTAGE STABILIZER ~ VIBRATOR TENSION SCR. INS.
KIND	~~GREY FIBRE~~	CHANGED		
SHAPE	~~ROD~~	" 1-24-45	J.V.W.	
FINISH		"		
TEMP.		"		
PATT.		"		

H. G. FISCHER & CO.
2338 WABANSIA AVE.
CHICAGO. ILL.

CAT. NO.

PART NO. 15837A

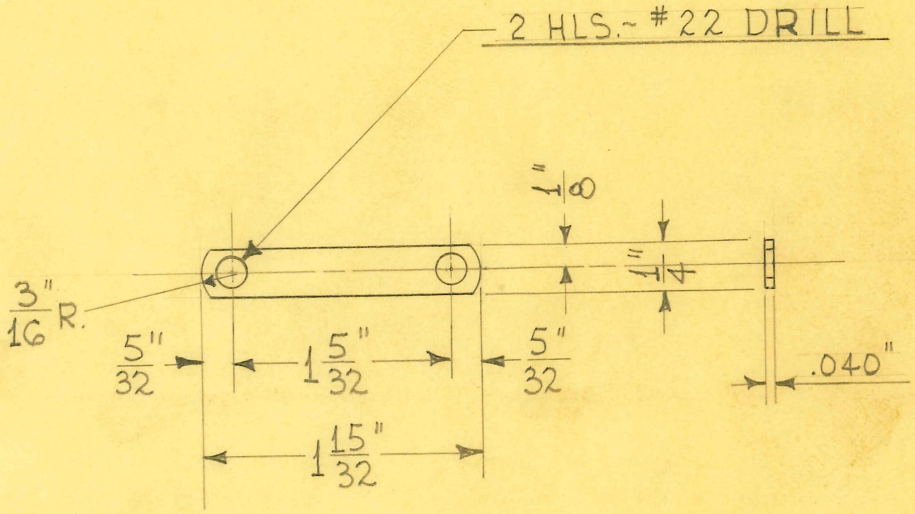

1 REQUIRED

SIZE	#18 GA. (.040)	ISSUE 9-15-44	HE.
KIND	SHEET BRASS	CHANGED	
SHAPE		"	
FINISH		"	
TEMP.		"	
PATT.		"	

TITLE: STABILIZED WALL MODEL DENTAL "X" ~ VOLTAGE STABILIZER ~ CONN. LINK

H. G. FISCHER & CO.
2335 WABANSIA AVE.
CHICAGO. ILL.

CAT. NO.

PART NO. 15838

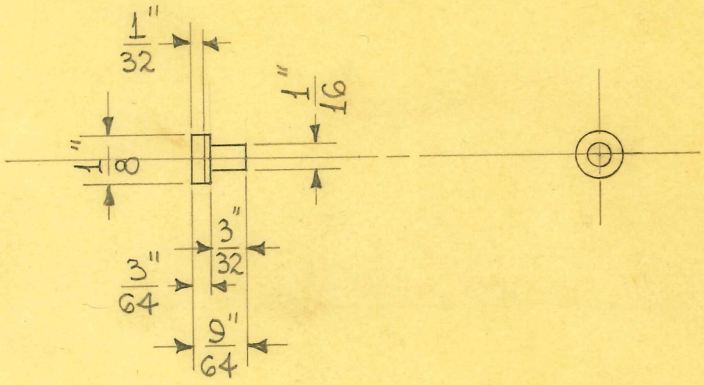

1 REQUIRED

SCALE ~ 1" = 1/2"

FANSTEEL STD. PART No. C 73 A-1516

SIZE		ISSUE 10-18-44	HE.
KIND	TUNGSTEN	CHANGED	
SHAPE		"	
FINISH		"	
TEMP.		"	
PATT.		"	

TITLE: STABILIZED WALL MODEL DENTAL "X" - VOLTAGE STABILIZER - ADJUSTABLE CONTACT POINT

H. G. FISCHER & CO.
2335 WABANSIA AVE.
CHICAGO, ILL.

CAT. NO.

PART NO. 15839

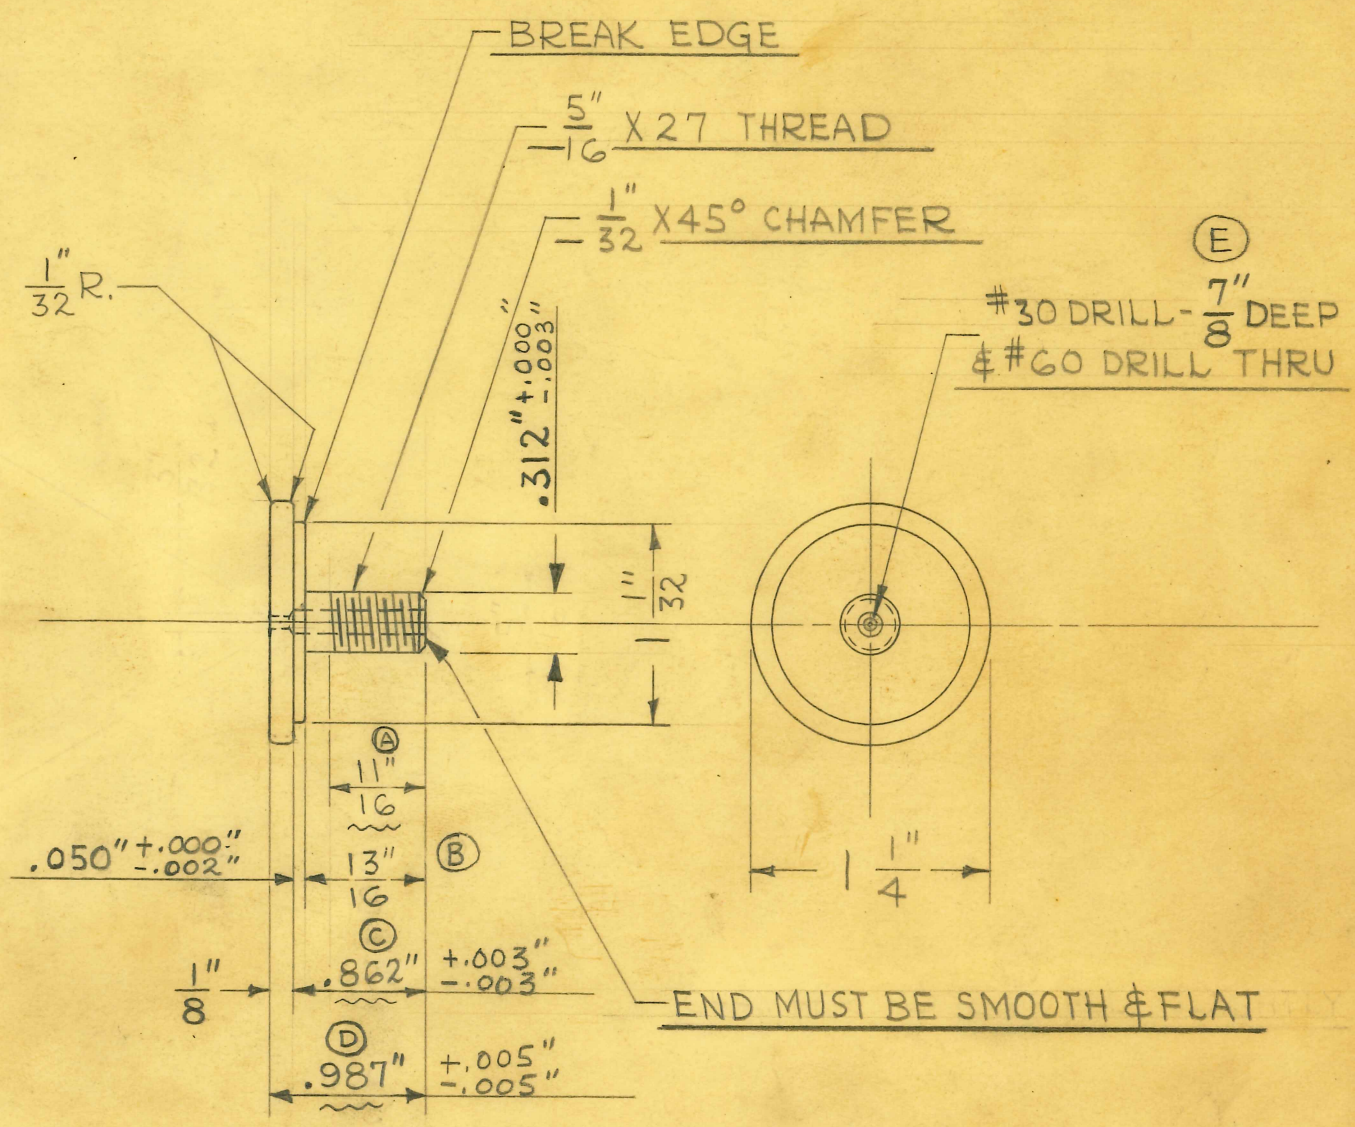

REVISION		DATE	BY
A	WAS 1/2"	2-1-50	J.V.W.
B	WAS 5/8"		
C	WAS .675"		
D	WAS .800"		
E	WAS 11/16" DEEP		

2 REQUIRED "WMDX"

4 REQUIRED "TC-30-96"

2 REQUIRED "MPA"

3 REQUIRED "MP-30"

SIZE	1¼" DIA.	ISSUE 3-19-46	J.V.W.
KIND	BRASS ROD	CHANGED	
SHAPE		"	
FINISH		"	
TEMP.		"	
PATT.		"	

TITLE:
WALL MODEL DENTAL X-RAY UNIT
TRANSFORMER BELLOWS - SUPPORT BOLT

H. G. FISCHER & CO.
2338 WABANSIA AVE.
CHICAGO, ILL.

CAT. NO.

PART NO. 15842

TITLE

FISCHER "CMDX" DENTAL X TRANSFORMER BELLOWS-SUPPORT BOLT

H. G. FISCHER & CO.
FRANKLIN PARK, ILLINOIS

PART NO. 15842 1/4

DATE 3-28-50 | DR. BY J.V.W. | CH'K'D.

REVISION	DATE	BY

PATTERN | FINISH | SCALE FULL

TOOLS | MATERIAL 1 1/4" DIA. BRASS ROD

DIMENSIONS UNLESS OTHERWISE SPECIFIED

FRACTIONAL	± .015
DECIMAL	± .005
ANGULAR	± ½°

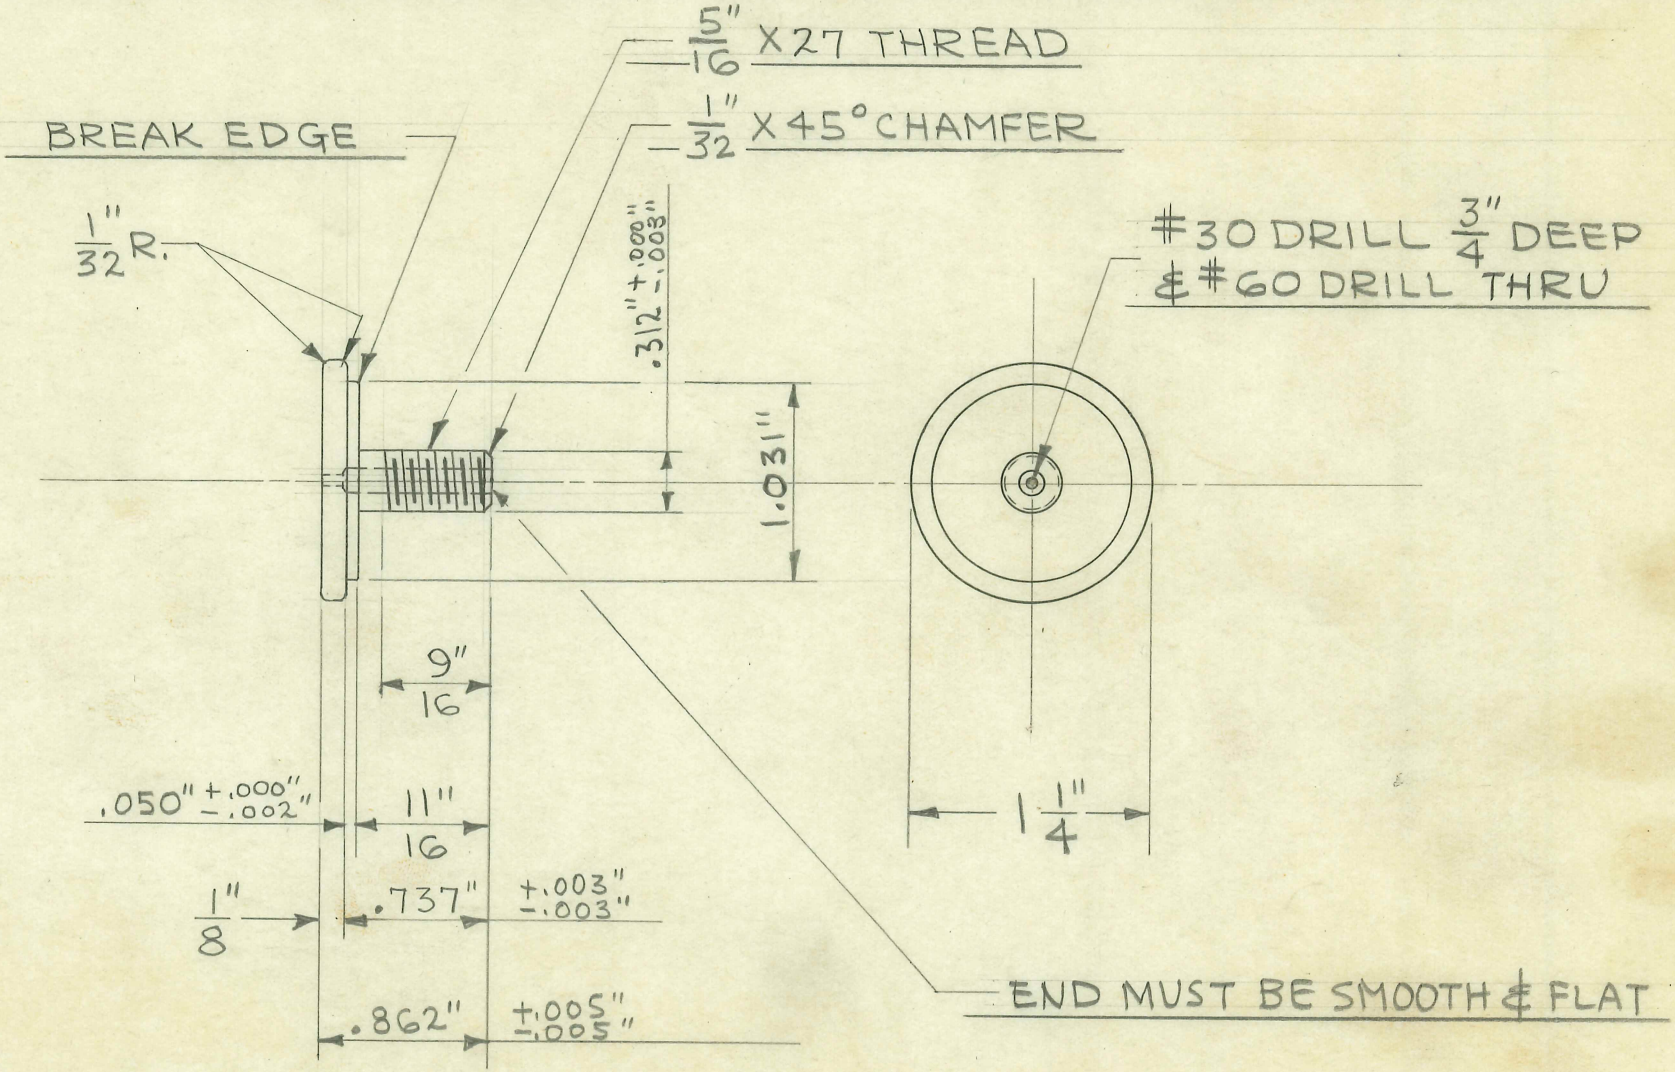

2 REQUIRED

FOLDER # 99A

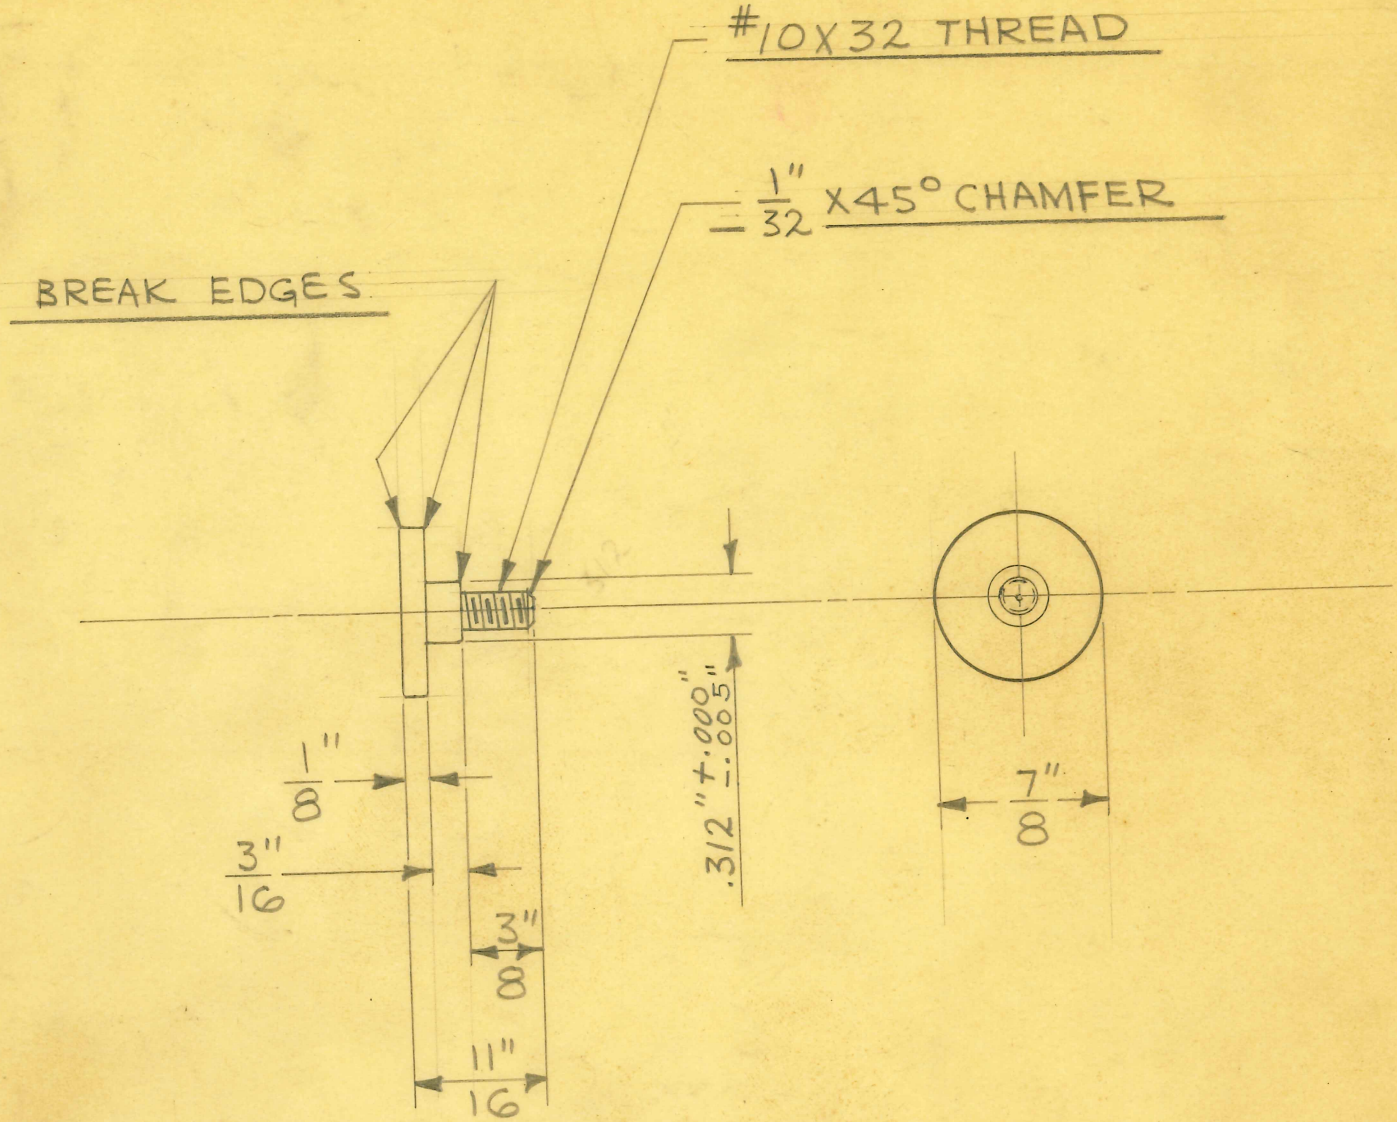

7 REQUIRED

SIZE	7/8" DIA.	ISSUE 9-9-47	W. J.
KIND	BRASS ROD	CHANGED	
SHAPE		"	
FINISH		"	
TEMP.		"	
PATT.		"	

TITLE: FISCHER "MP-20" X-RAY UNIT
BELLOWS HOLE PLUG

H. G. FISCHER & CO.
2335 WABANSIA AVE.
CHICAGO, ILL.

CAT. NO.

PART NO. 15842

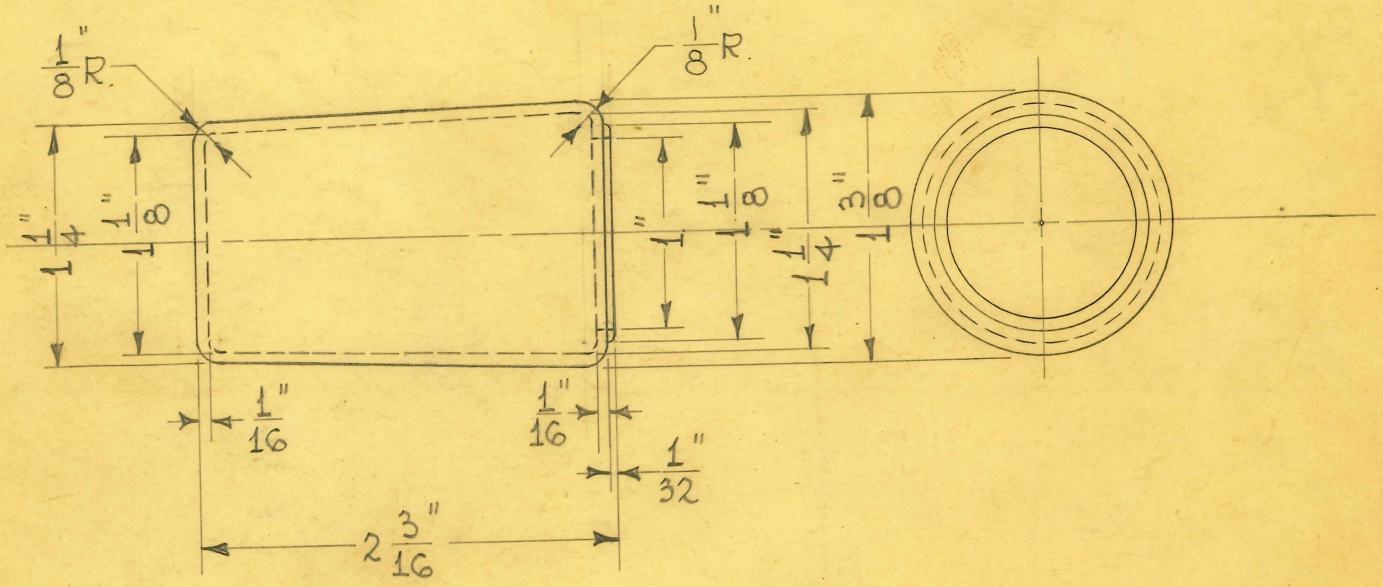

SIZE		ISSUE 5-29-45	HE.
KIND	SIRVENE 4500	CHANGED	
SHAPE	MOLDED	"	
FINISH		"	
TEMP.		"	
PATT.		"	

TITLE: WALL MODEL DENTAL X-RAY UNIT - TRANSFORMER BELLOWS

H. G. FISCHER & CO.
2335 WABANSIA AVE.
CHICAGO, ILL.

CAT. NO.

PART NO. 15843

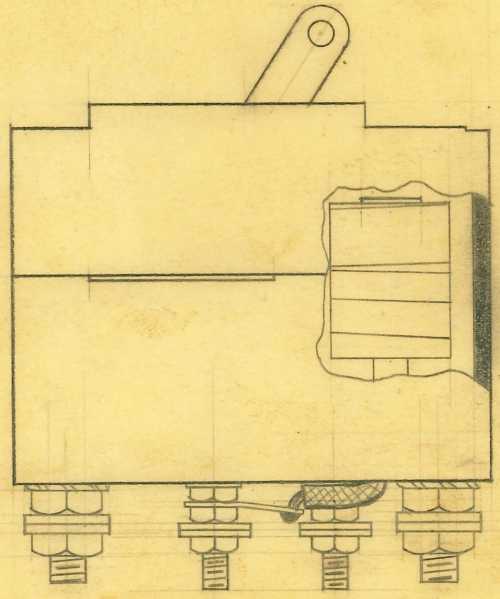

CAT. NO. AM12RS-13

VOLTS 120 AC

CURVE 3 HP

CONTIN. AMPS 13

TRIP AMPS

546

HEINEMAN CIRCUIT BREAKER CO. TRENTON N.J.

DIMENSIONS	
FRACTIONAL	± .015
DECIMAL	± .005
ANGULAR	± 1/2°

UNLESS OTHERWISE SPECIFIED

915

SIZE		ISSUE 2-19-48	J.V.W.	TITLE: FISCHER "CMDX" CIRCUIT BREAKER
KIND		CHANGED		
SHAPE		"		
FINISH		"		
TEMP.		"		
PATT.		"		

H. G. FISCHER & CO.
2335 WABANSIA AVE.
CHICAGO, ILL.

CAT. NO.

PART NO. 15849

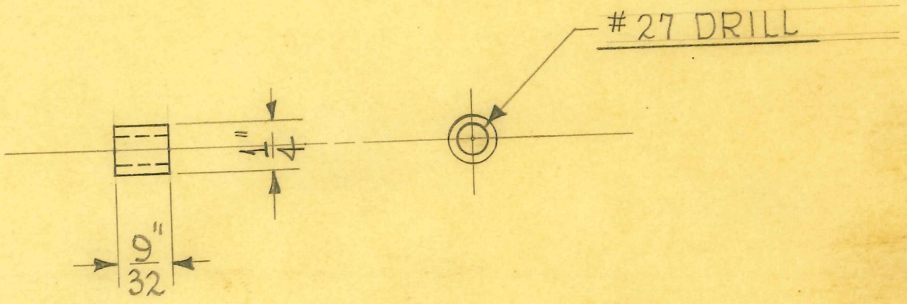

2 REQUIRED

SIZE	1/4" DIAM.	ISSUE 9-28-44	HE.
KIND	C.R. STEEL	CHANGED	
SHAPE	ROD	"	
FINISH		"	
TEMP.		"	
PATT.		"	

TITLE: FISCHER WALL MODEL DENTAL X-RAY UNIT
TRANSF. BELLOWS STOP STRIP SPACER

H. G. FISCHER & CO.
2335 WABANSIA AVE.
CHICAGO. ILL.

CAT. NO.

PART NO. 15851

REVISION	DATE	BY
A WAS 6 9/16"	1-23-51	J.W.
B WAS 3/8"	1-23-51	J.W.

BREAK ALL SHARP EDGES & CORNERS

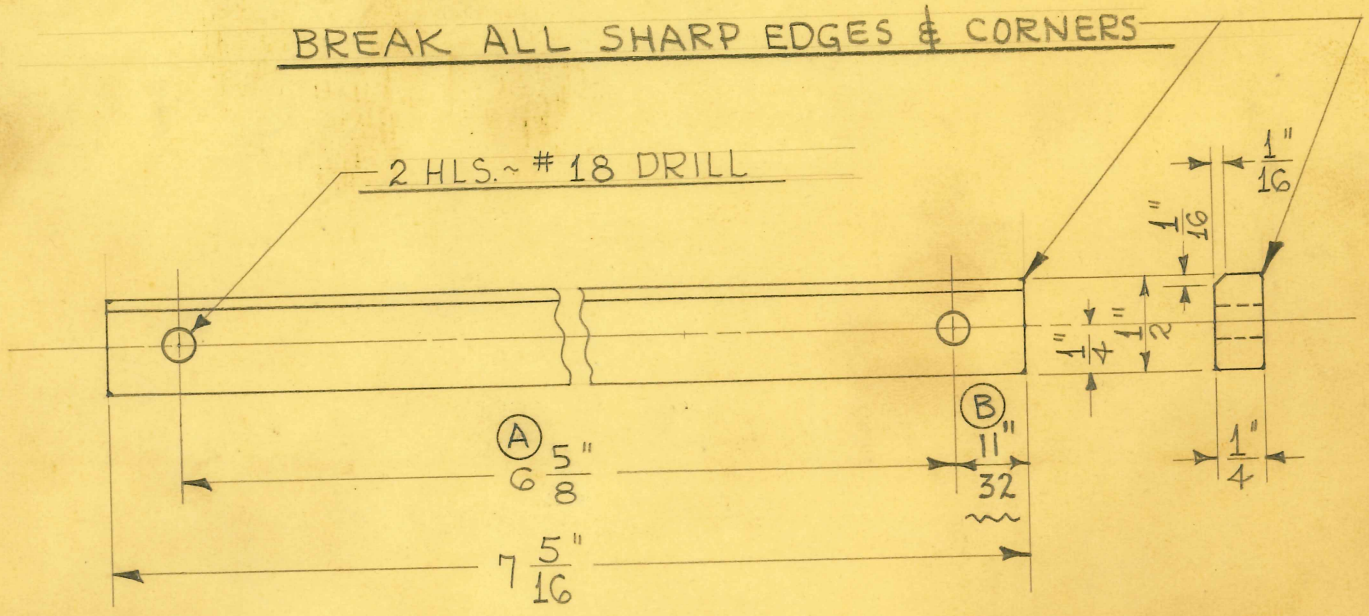

1 REQUIRED

SIZE	1/4" SHEET	ISSUE 9-28-44	HE.
KIND	BLK. BAKELITE	CHANGED	
SHAPE		"	
FINISH		"	
TEMP.		"	
PATT.		"	

TITLE: FISCHER WALL MODEL DENTAL X-RAY UNIT-
TRANSFORMER BELLOWS STOP STRIP

H. G. FISCHER & CO.
2335 WABANSIA AVE.
CHICAGO. ILL.

CAT. NO.

PART NO. 15852

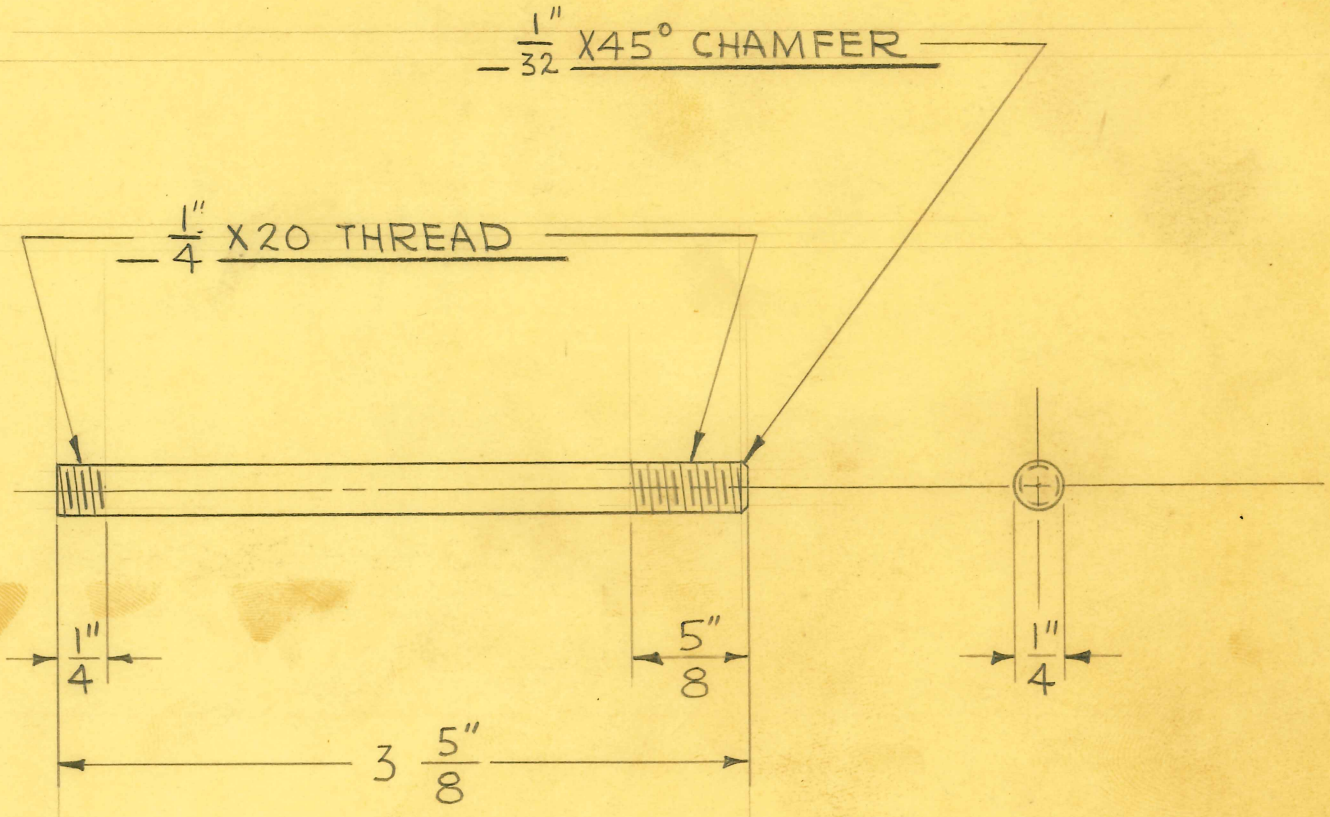

4 REQUIRED

SIZE	1/4" DIA.	ISSUE 3-26-46	J.V.W.
KIND	C.R. STEEL	CHANGED	
SHAPE		"	
FINISH		"	
TEMP.		"	
PATT.		"	

99

TITLE: FISCHER "CMDX" DENTAL X-RAY UNIT VOLTAGE STABILIZER SUPPORT STUD

H. G. FISCHER & CO.
2335 WABANSIA AVE.
CHICAGO, ILL.

CAT. NO.

PART NO. 15853

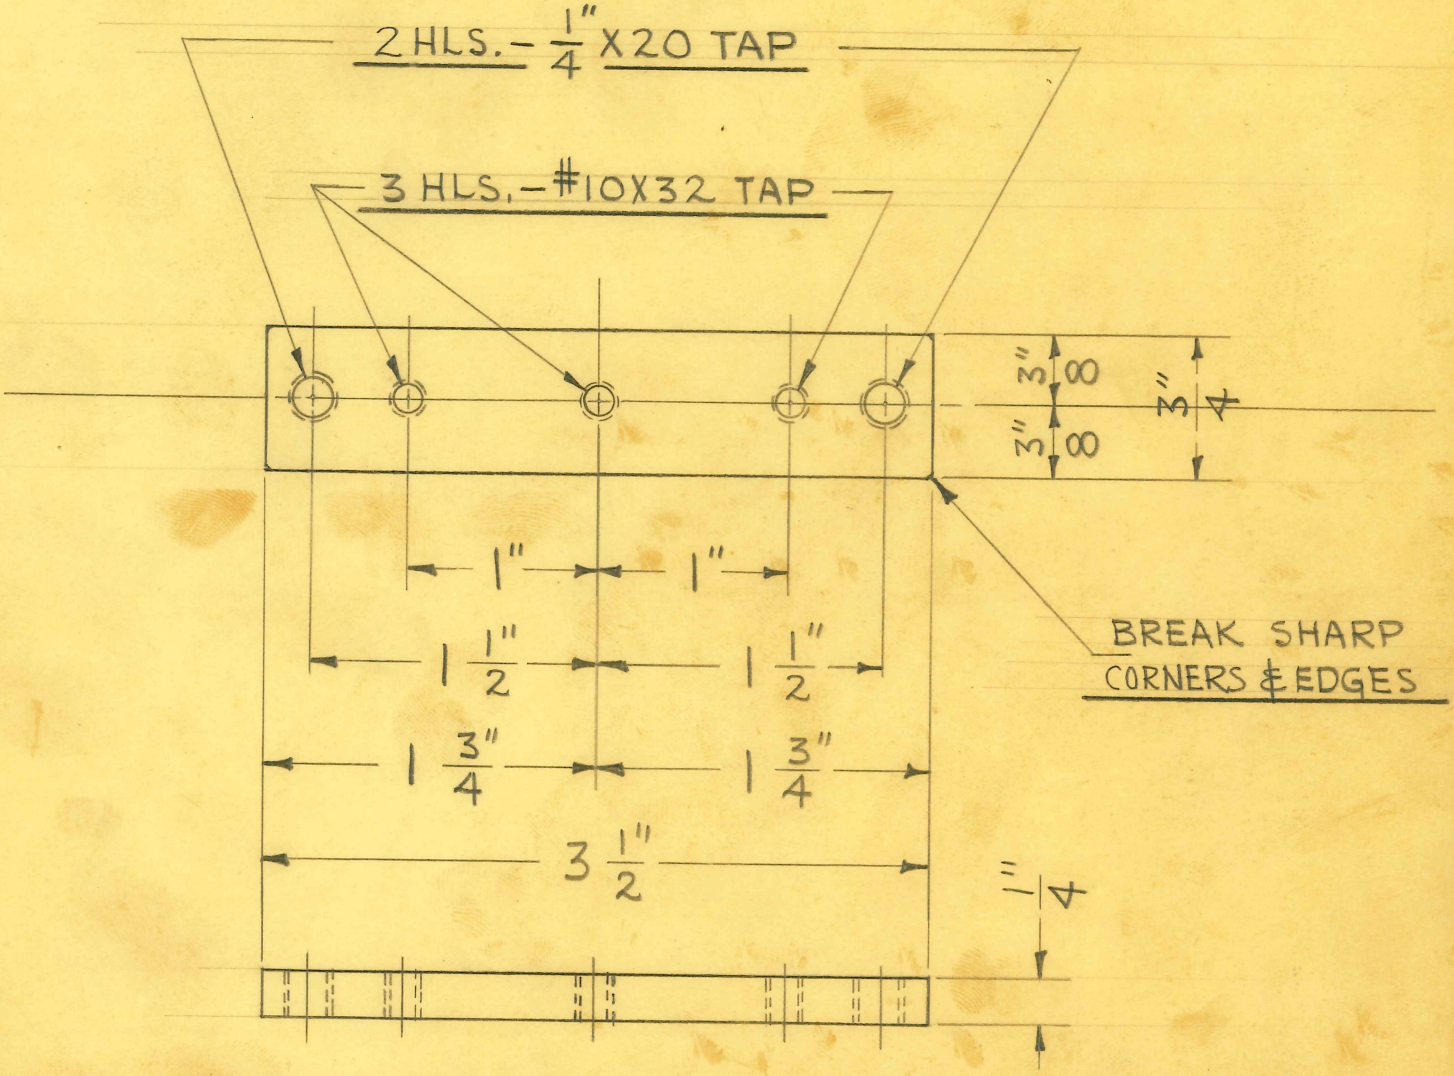

2 REQUIRED

SIZE	1/4" X 3/4"	ISSUE 3-26-46	J.V.W.
KIND	C.R. STEEL	CHANGED	
SHAPE	BAR	"	
FINISH		"	
TEMP.		"	
PATT.		"	

TITLE:
FISCHER "CMDX" DENTAL X-RAY UNIT
VOLTAGE STABILIZER SUPPORT STRAP

H. G. FISCHER & CO.
2335 WABANSIA AVE.
CHICAGO, ILL.

CAT. NO.

PART NO. 15854

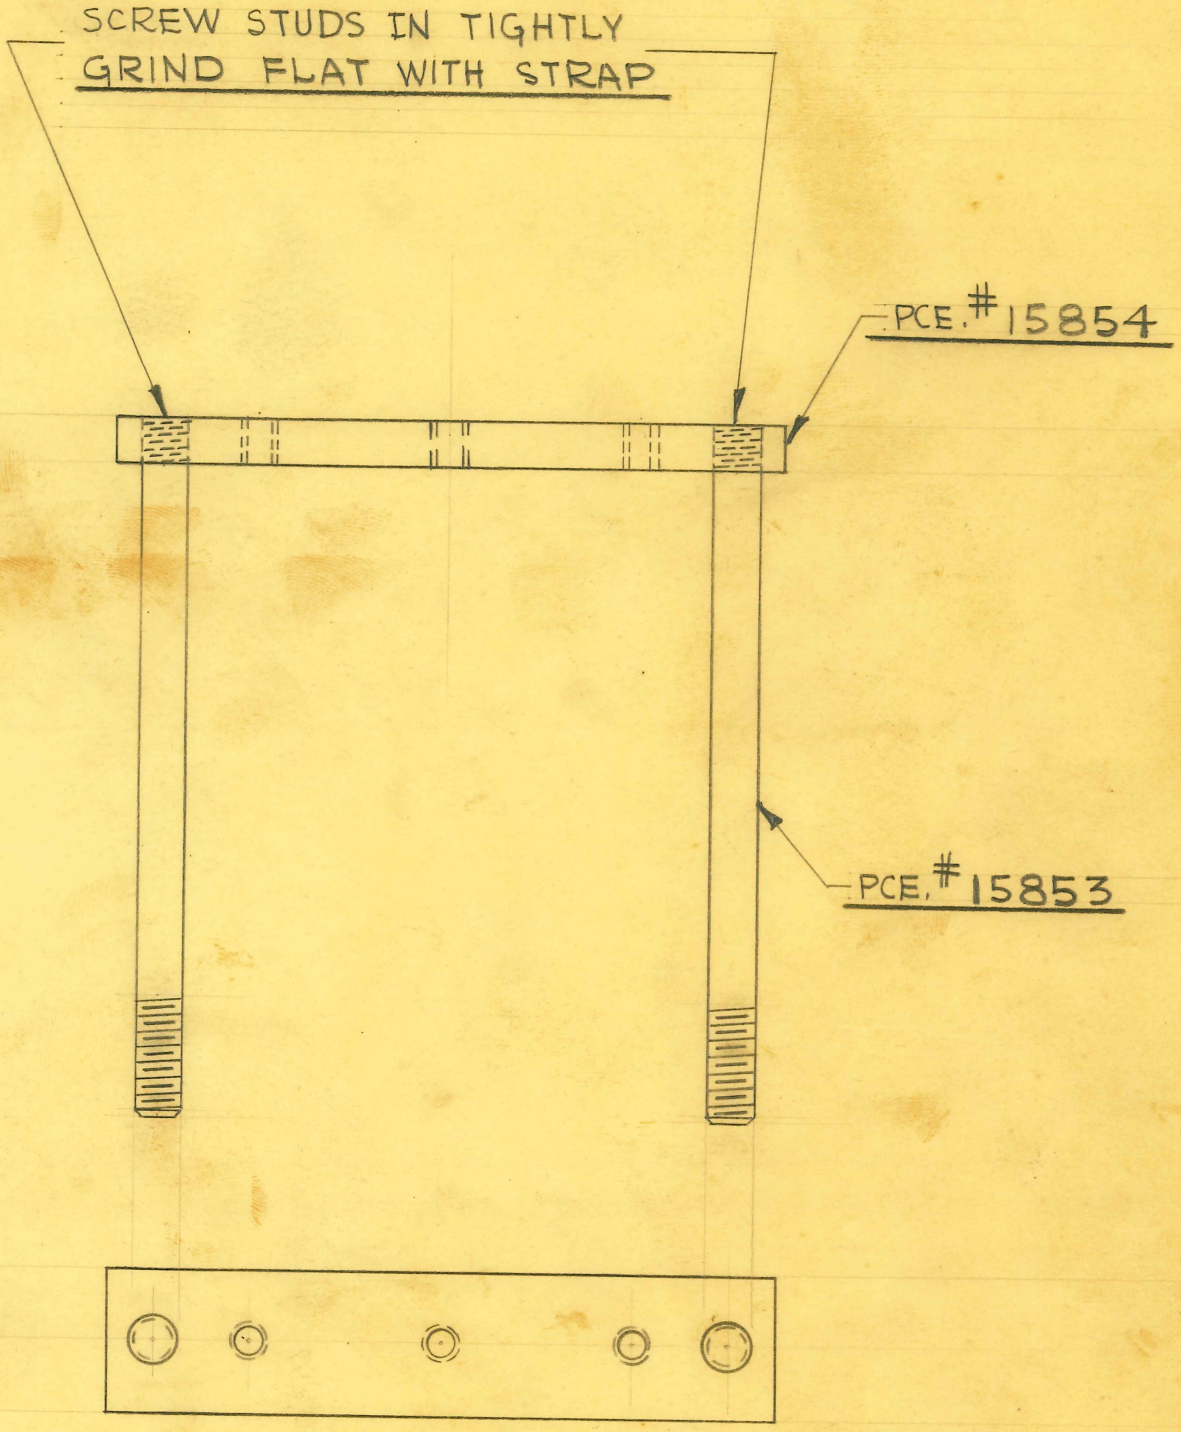

2 REQUIRED

SIZE		ISSUE 3-27-46	J.V.W.
KIND		CHANGED	
SHAPE		"	
FINISH	CAD. #23	"	
TEMP.		"	
PATT.		"	

TITLE:
FISCHER "CMDX." DENTAL X-RAY UNIT
VOLTAGE STABILIZER SUPPORT

H. G. FISCHER & CO.
2335 WABANSIA AVE.
CHICAGO, ILL.

CAT. NO.

PART NO. 15855G

BREAK CORNERS & EDGES

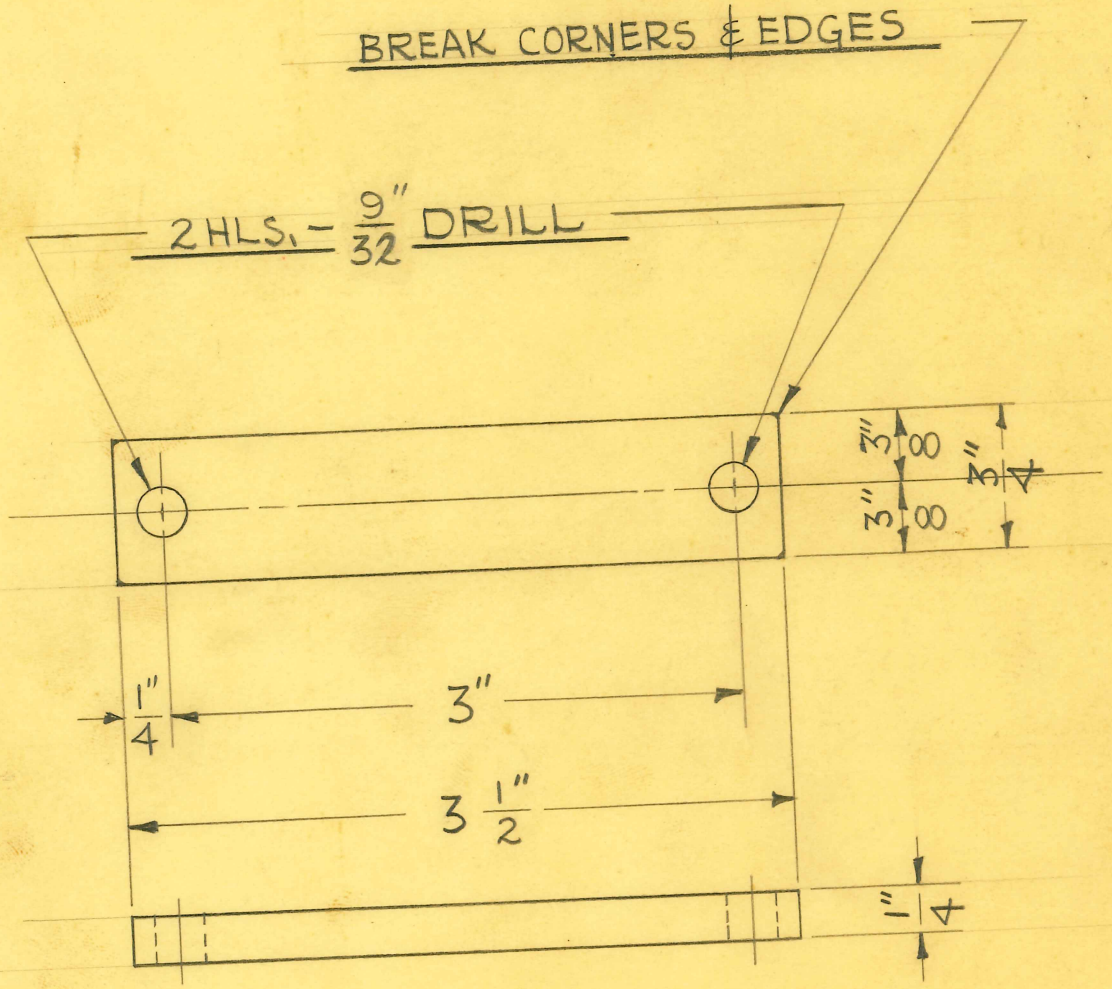

2 REQUIRED

SIZE	1/4" X 3/4"	ISSUE 3-27-46	J.V.W.
KIND	C.R. STEEL	CHANGED	
SHAPE	BAR	"	
FINISH	CAD. #23	"	
TEMP.		"	
PATT.		"	

TITLE: FISCHER "CMDX" DENTAL X-RAY UNIT
VOLTAGE STABILIZER CLAMP STRAP

H. G. FISCHER & CO.
2335 WABANSIA AVE.
CHICAGO, ILL.

CAT. NO.

PART NO. 15856

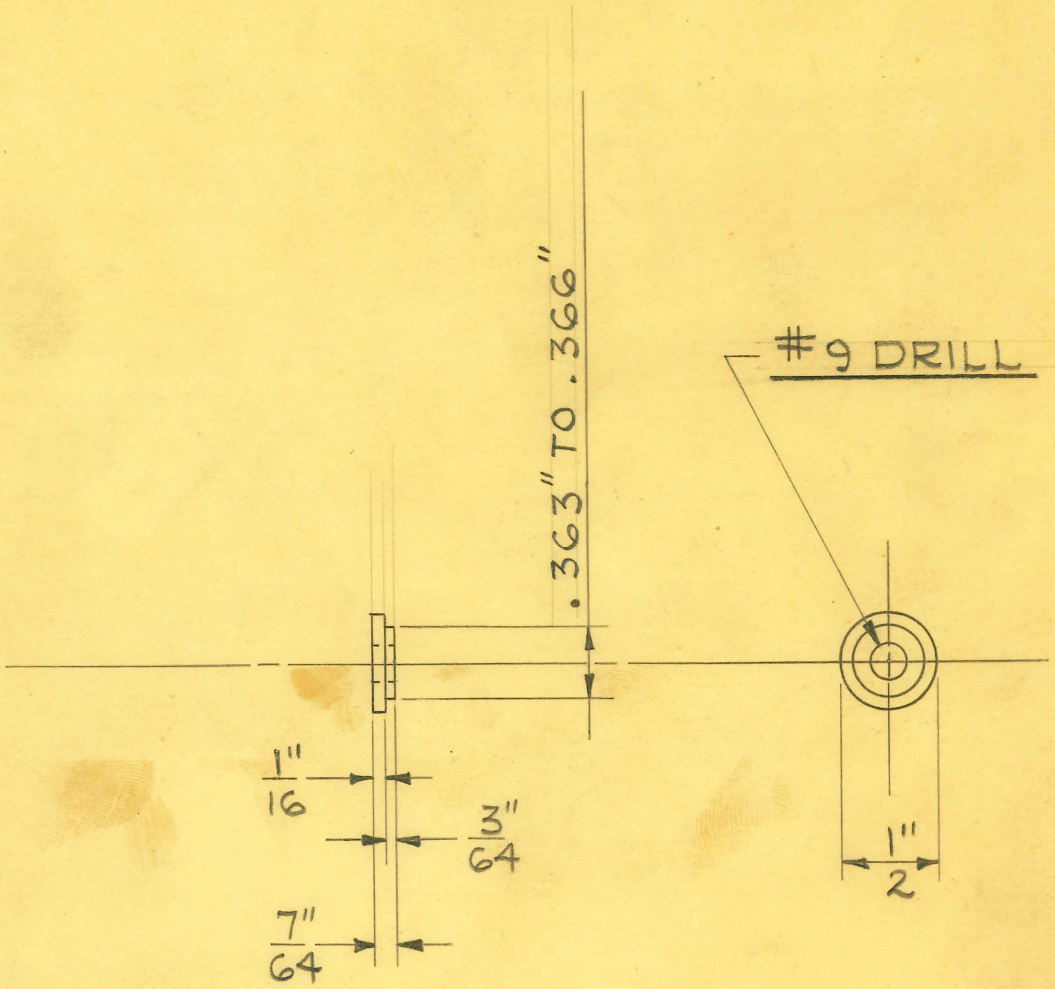

4 REQUIRED

SIZE	1/2" DIA.	ISSUE 3-26-46	J.V.W.
KIND	C.R. STEEL	CHANGED	
SHAPE		"	
FINISH	CAD. #23	"	
TEMP.		"	
PATT.		"	

TITLE:
FISCHER "CMDX" DENTAL X-RAY UNIT
VOLTAGE STABILIZER SCREW BUSHING

H. G. FISCHER & CO.
2335 WABANSIA AVE.
CHICAGO, ILL.

CAT. NO.

PART NO. 15857

TITLE FISCHER ADJUSTABLE INDUCTION ELECT. COIL CONN. LINK-LEFT

H. G. FISCHER & CO.
FRANKLIN PARK, ILLINOIS

PART NO. 15860C

DATE 8-22-52 | DR. BY J.V.W. | CH'K'D.

REVISION	DATE	BY

PATTERN | FINISH SILVER #6 1/2 | SCALE FULL

TOOLS: FORMING DIE #9086 (Y-2)

MATERIAL: FROM #16194B

DIMENSIONS
FRACTIONAL ± .015
DECIMAL ± .005
ANGULAR ± ½°
UNLESS OTHERWISE SPECIFIED

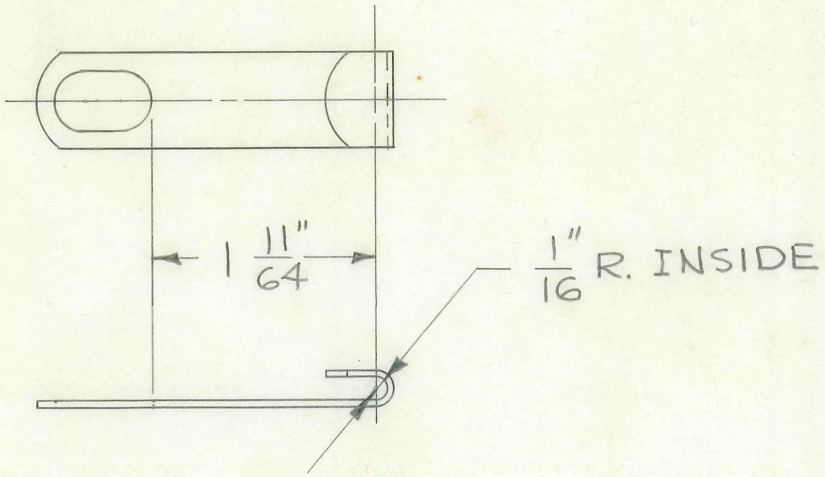

2 REQUIRED

FOLDER #118

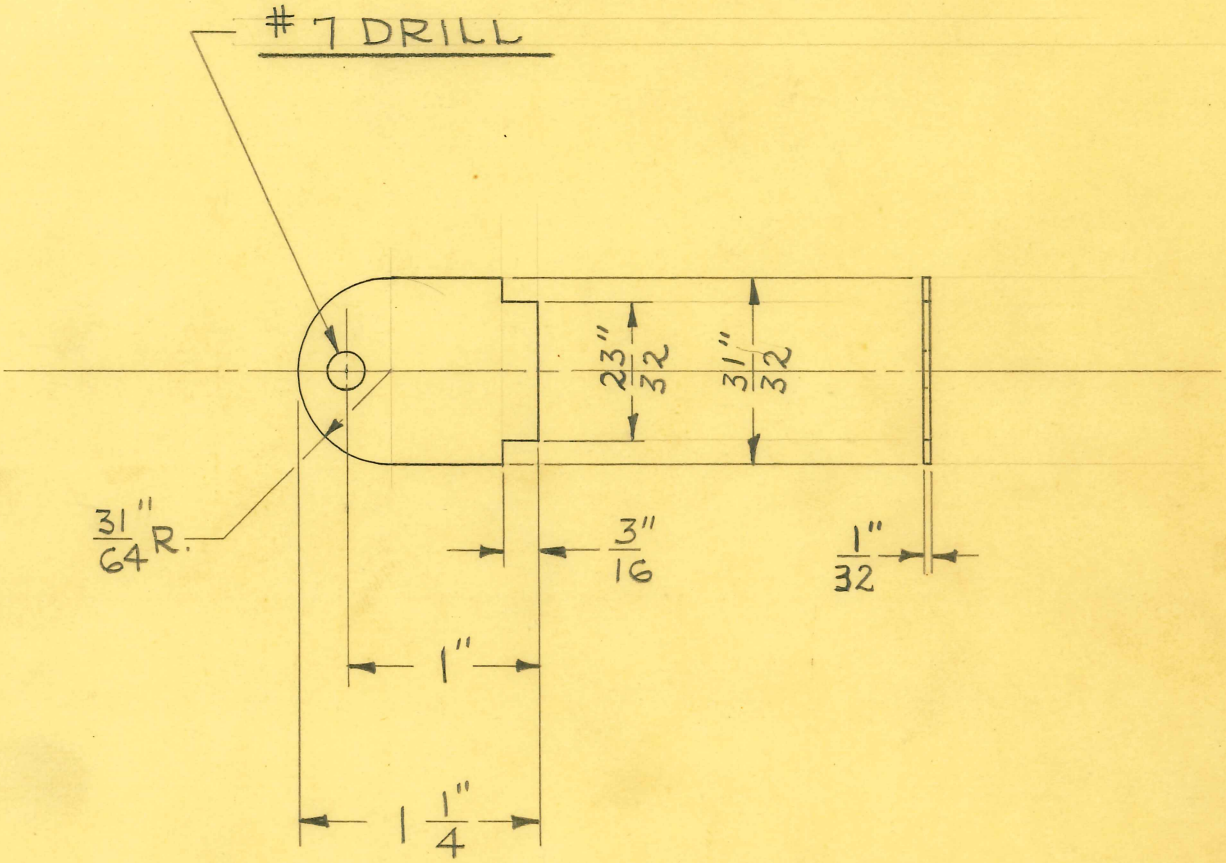

2 REQUIRED

BLANK & PERF. DIE #9080 (Y-2)

SIZE	1/32" SHEET	ISSUE 2-7-46	J.V.W.
KIND	CANVAS BASE	CHANGED	
SHAPE	BLK. BAKELITE	"	
FINISH		"	
TEMP.		"	
PATT.		"	

TITLE: FISCHER ADJUSTABLE INDUCTION ELECT. COIL CONN. LINK INSULATOR

H. G. FISCHER & CO.
2335 WABANSIA AVE.
CHICAGO, ILL.

CAT. NO.

PART NO. 15861

TITLE: FISCHER ADJUSTABLE IND. ELECT. COIL CONN. LINK INSULATOR-LARGE HOLE

H. G. FISCHER & CO.
FRANKLIN PARK, ILLINOIS

PART NO. 15861 1/2

DATE 8-22-52 | DR BY J.V.W. | CH'K'D.

REVISION	DATE	BY

PATTERN | FINISH | SCALE FULL

TOOLS PERF. DIE # 3193 (G 3)
NEST PCE. # 15861 1/2

MATERIAL: FROM #15861

DIMENSIONS
FRACTIONAL ± .015
DECIMAL ± .005
ANGULAR ± ½°
UNLESS OTHERWISE SPECIFIED

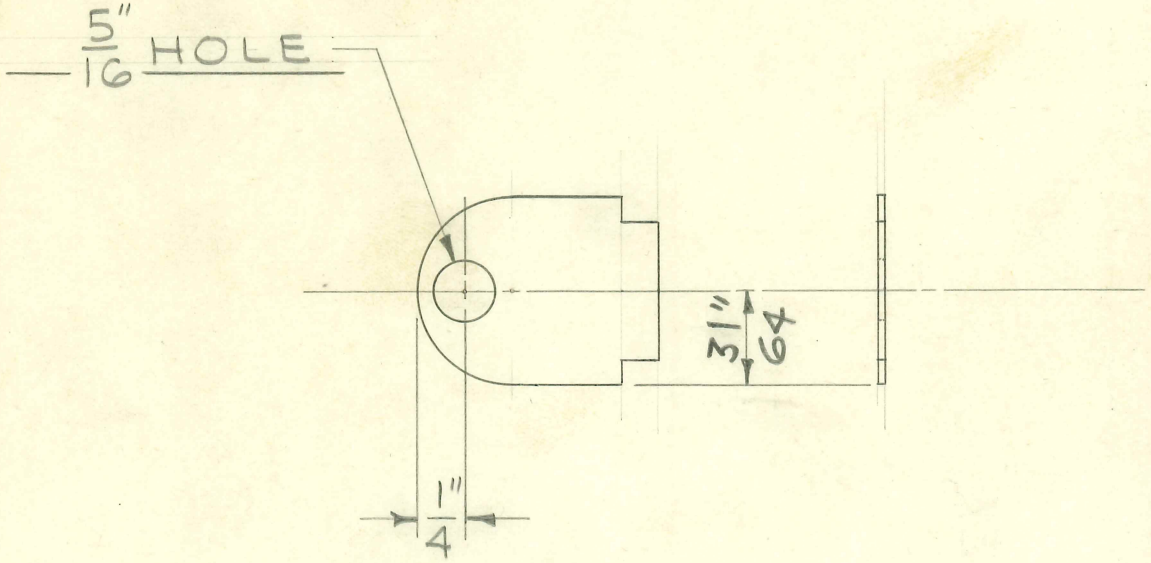

2 REQUIRED

FOLDER # 118

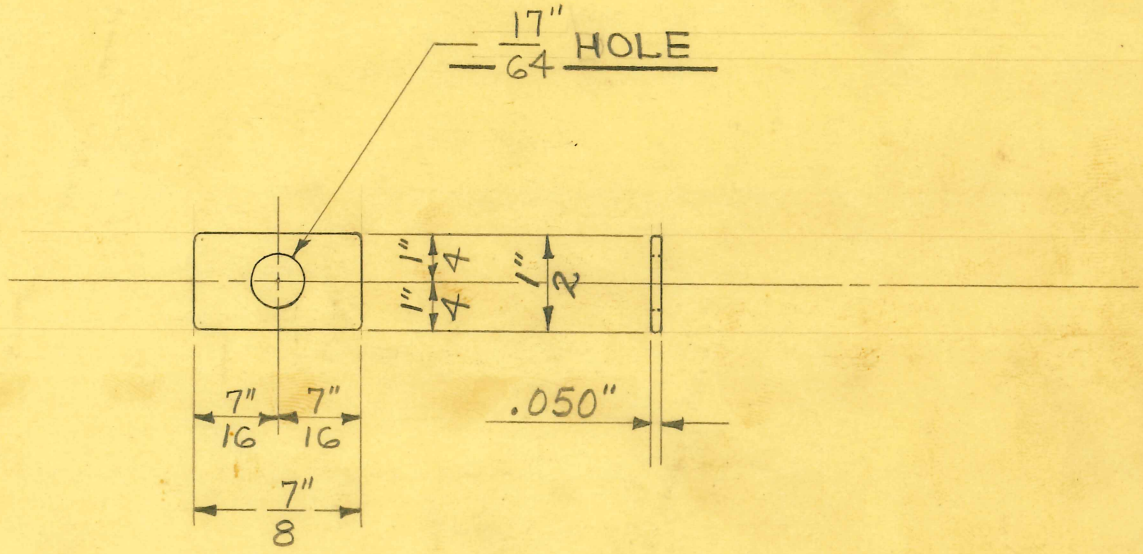

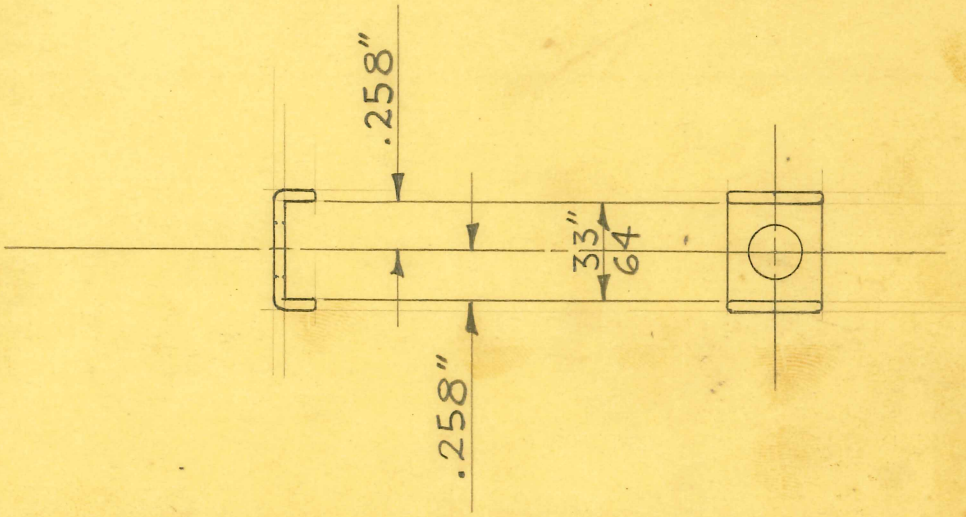

1 REQUIRED

SIZE	.050" SHEET	ISSUE 11-6-45	J.V.W.	**TITLE:** HINGED INDUCTION ELECTRODE MTG. SWIVEL LOCK NUT PIN RETAINER
KIND	C.R. STEEL	CHANGED		
SHAPE		"		
FINISH	CAD. #23	"		
TEMP.		"		
PATT.		"		

H. G. FISCHER & CO.
2335 WABANSIA AVE.
CHICAGO, ILL.

CAT. NO.

PART NO. 15863

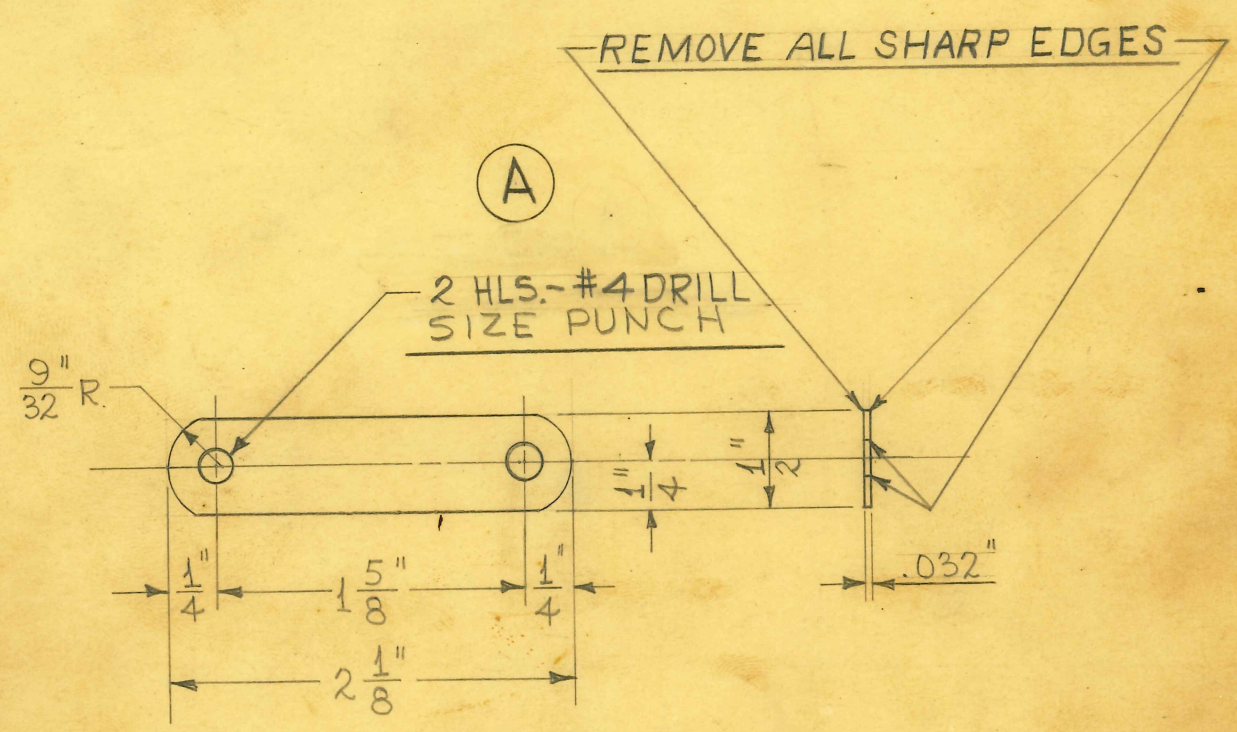

1 REQUIRED

BLANK & PIERCE DIE # 9049 (Y-4)

PUT THRU FLATTENING DIE AFTER BLANKING & PIERCING.

FINISH - SILVER # C 1/2

REVISION	DATE	BY
A WAS #9 DR.	2-8-52	J.V.W.

SIZE	#20 GA. (.032)	ISSUE 10-5-45	H.E.
KIND	STRIP BRASS	CHANGED	
SHAPE		"	
FINISH		"	
TEMP.		"	
PATT.		"	

TITLE: HINGED INDUCTION ELECTRODE - CONNECTION LINK

H. G. FISCHER & CO.
2335 WABANSIA AVE.
CHICAGO, ILL.

CAT. NO.

PART NO. 15865A

TITLE FISCHER ADJUSTABLE INDUCTION ELECT. COIL MOUNTING CLIP

H. G. FISCHER & CO.
FRANKLIN PARK, ILLINOIS

PART NO. 15866A

DATE 2-12-52 | DR. BY J.V.W. | CH'K'D.

REVISION	DATE	BY

PATTERN | FINISH | SCALE 1" = 1/2"

TOOLS MILLING FIX. # 11675

MATERIAL 1/4" HEX. BRASS ROD

DIMENSIONS
FRACTIONAL ± .015
DECIMAL ± .005
ANGULAR ± 1/2°
UNLESS OTHERWISE SPECIFIED

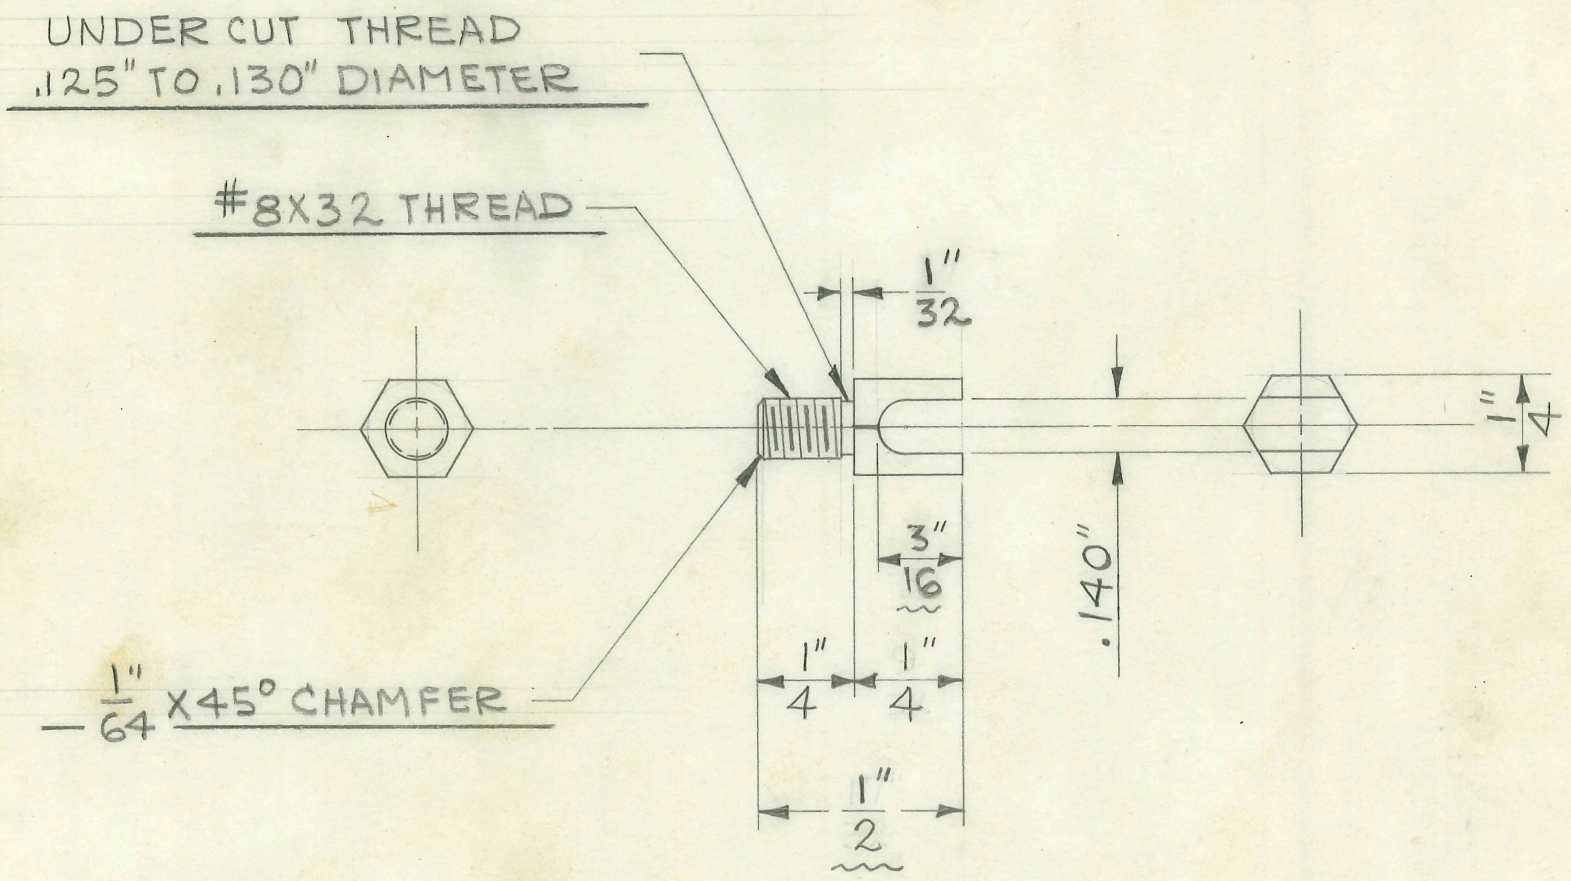

ANNEAL AFTER MACHINING

14 REQUIRED

FOLDER # 118

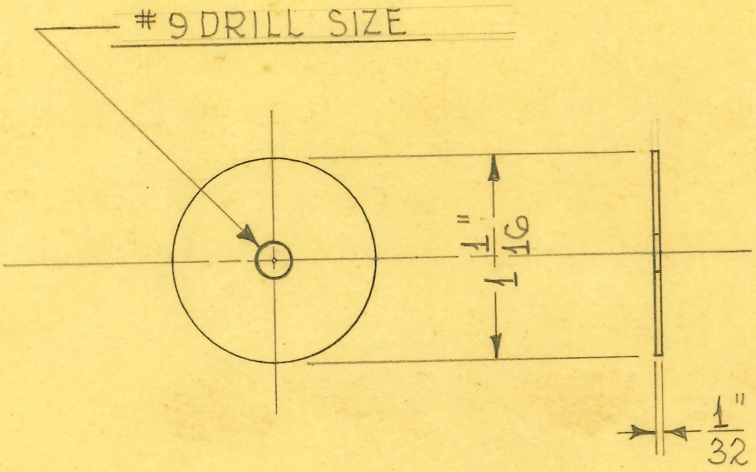

6 REQUIRED

RS.

SIZE	1/32" SHEET	ISSUE 10-5-45	HE.
KIND	BLK. FIBRE	CHANGED	
SHAPE		"	
FINISH		"	
TEMP.		"	
PATT.		"	

TITLE: HINGED INDUCTION ELECTRODE FRICTION WASHER

H. G. FISCHER & CO.
2335 WABANSIA AVE.
CHICAGO, ILL.

CAT. NO.

PART NO. 15868

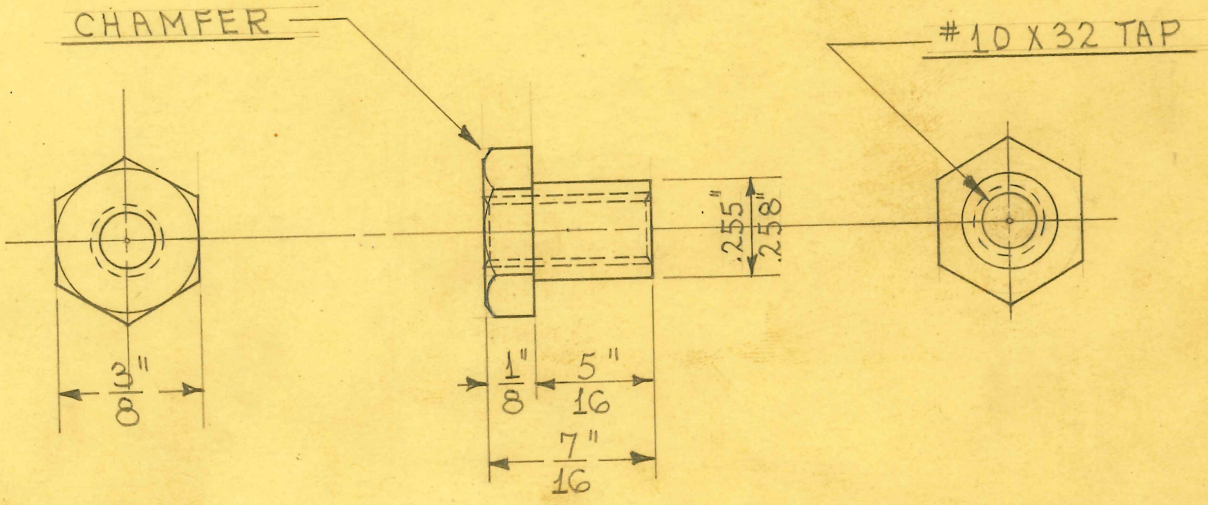

SCALE ~ 1" = 1/2"

2 REQUIRED

SIZE	3/8" HEX.	ISSUE 10-5-45	HE.
KIND	BRASS ROD	CHANGED	
SHAPE		"	
FINISH		"	
TEMP.		"	
PATT.		"	

TITLE: HINGED INDUCTION ELECTRODE ~ HINGE ~ CONN. LINK SIDE - NUT

H. G. FISCHER & CO.
2335 WABANSIA AVE.
CHICAGO, ILL.

CAT. NO.

PART NO. 15871

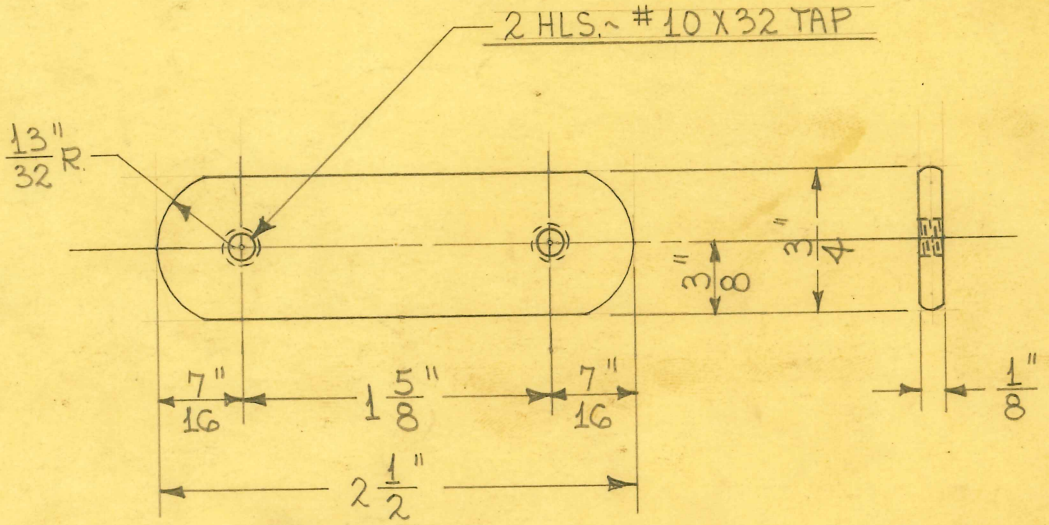

1 REQUIRED

1/8" X 3/4" BRASS BAR

SIZE	~~1/8" X 3/4"~~	ISSUE 10-5-45	HE.
KIND	~~FLAT WIRE~~	CHANGED 5-21-47	W.J.
SHAPE		"	
FINISH		"	
TEMP.		"	
PATT.		"	

TITLE: HINGED INDUCTION ELECTRODE ~ HINGE ~ DEAD SIDE ~ NUT STRIP

H. G. FISCHER & CO.
2335 WABANSIA AVE.
CHICAGO, ILL.

CAT. NO.

PART NO. 15872A

TITLE
FISCHER ADJUSTABLE INDUCT. ELECTRODE
DEAD SIDE NUT STRIP SPACER

H. G. FISCHER & CO.
FRANKLIN PARK, ILLINOIS

PART NO. 15873A

DATE 3-25-53 | DR. BY W.J. | CH'K'D. J.V.W.

REVISION	DATE	BY

PATTERN | FINISH | SCALE FULL

TOOLS

MATERIAL 7/16" DIA. BLACK FIBRE ROD

DIMENSIONS
FRACTIONAL ± .015
DECIMAL ± .005
ANGULAR ± ½°
UNLESS OTHERWISE SPECIFIED

BREAK EDGES BOTH ENDS

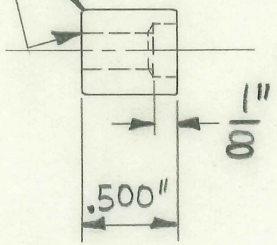

#7 DRILL - THEN C'BORE WITH 9/32" DRILL 1/8" DEEP

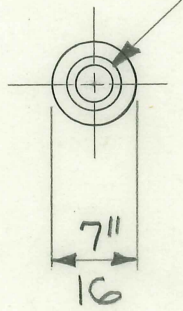

4 REQUIRED ON CONDENSER ELECTRODE
2 REQUIRED ON INDUCTION ELECTRODE

FOLDER #118

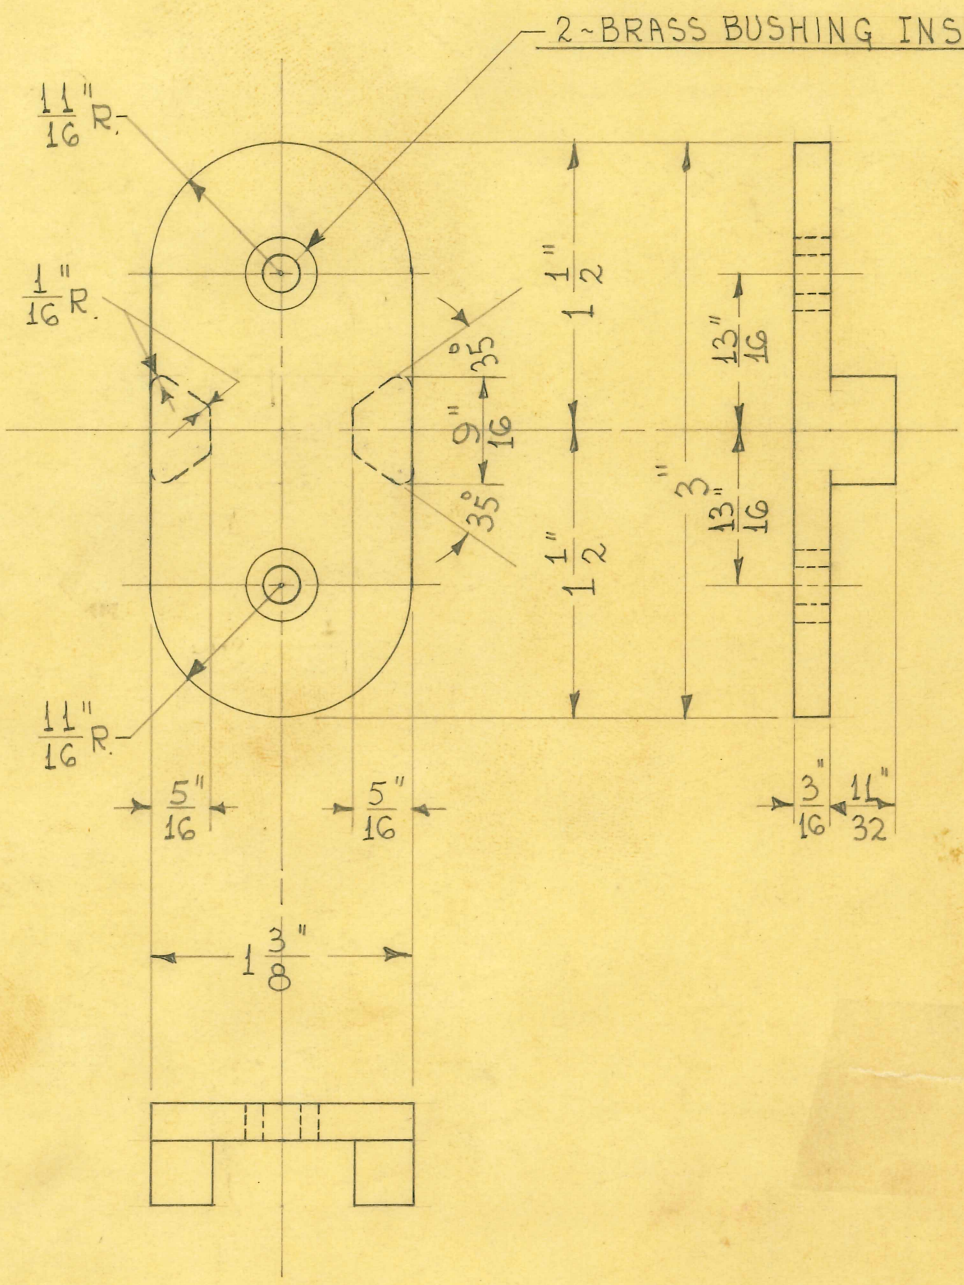

2 REQUIRED

DUREZ #2271 BLACK PHENOLIC

H.G.F. & CO. MOLD #1822

SIZE		ISSUE 11-14-44	HE.
KIND	BLK. BAKELITE	CHANGED	
SHAPE	MOLDED	"	
FINISH		"	
TEMP.		"	
PATT.		"	

TITLE: HINGED INDUCTION ELECTRODE - HINGE PLATE

H. G. FISCHER & CO.
2335 WABANSIA AVE.
CHICAGO, ILL.

CAT. NO.

PART NO. 15877

TITLE HINGED INDUCTION ELECTRODE HINGE PLATE

H. G. FISCHER & CO.
FRANKLIN PARK, ILLINOIS

PART NO. 15877 F

DATE 3-15-65 | DR BY T. T. | CH'K'D. RWS

REVISION	DATE	BY

PATTERN | FINISH | SCALE FULL

TOOLS DRILL JIG 13884

MATERIAL PART # 15877

DIMENSIONS
FRACTIONAL ± .015
DECIMAL ± .005
ANGULAR ± ½°
UNLESS OTHERWISE SPECIFIED

USED ON	QTY.
15870 GE	2

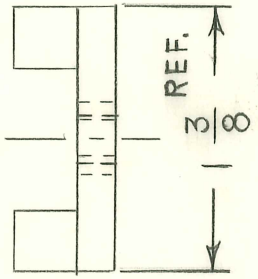

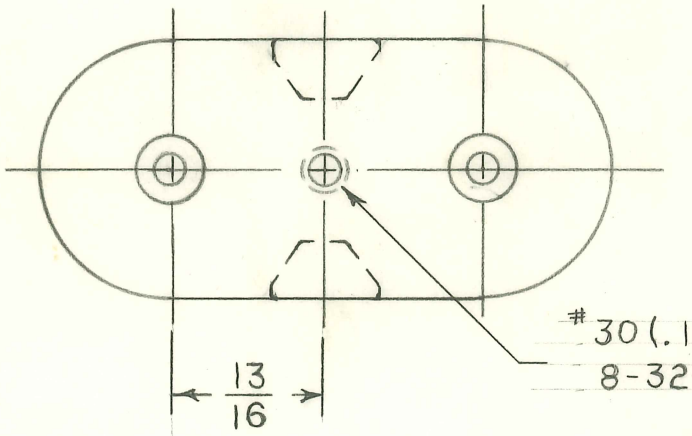

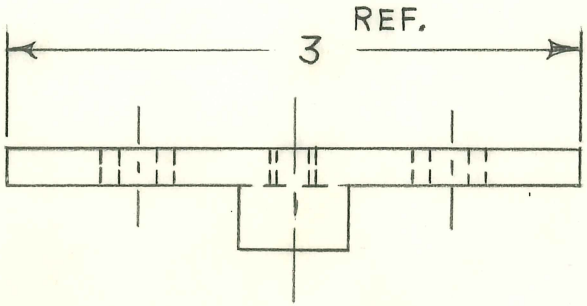

TITLE

END PLATE FOR HINGED INDUCTION ELECTRODE HINGE PLATE COVER

H. G. FISCHER & CO.
FRANKLIN PARK, ILLINOIS

PART NO. 15880

DATE 3-15-65 | DR BY T. T. | CH'K'D. RWS

REVISION	DATE	BY

PATTERN | FINISH | SCALE FULL

DIMENSIONS
FRACTIONAL ± .015
DECIMAL ± .005
ANGULAR ± ½°
UNLESS OTHERWISE SPECIFIED

TOOLS DRILL JIG 13885
RADIUS FIXTURE 13886

MATERIAL
¼ THICK BLACK BAKELITE

USED ON	QTY.
15870 GH	2

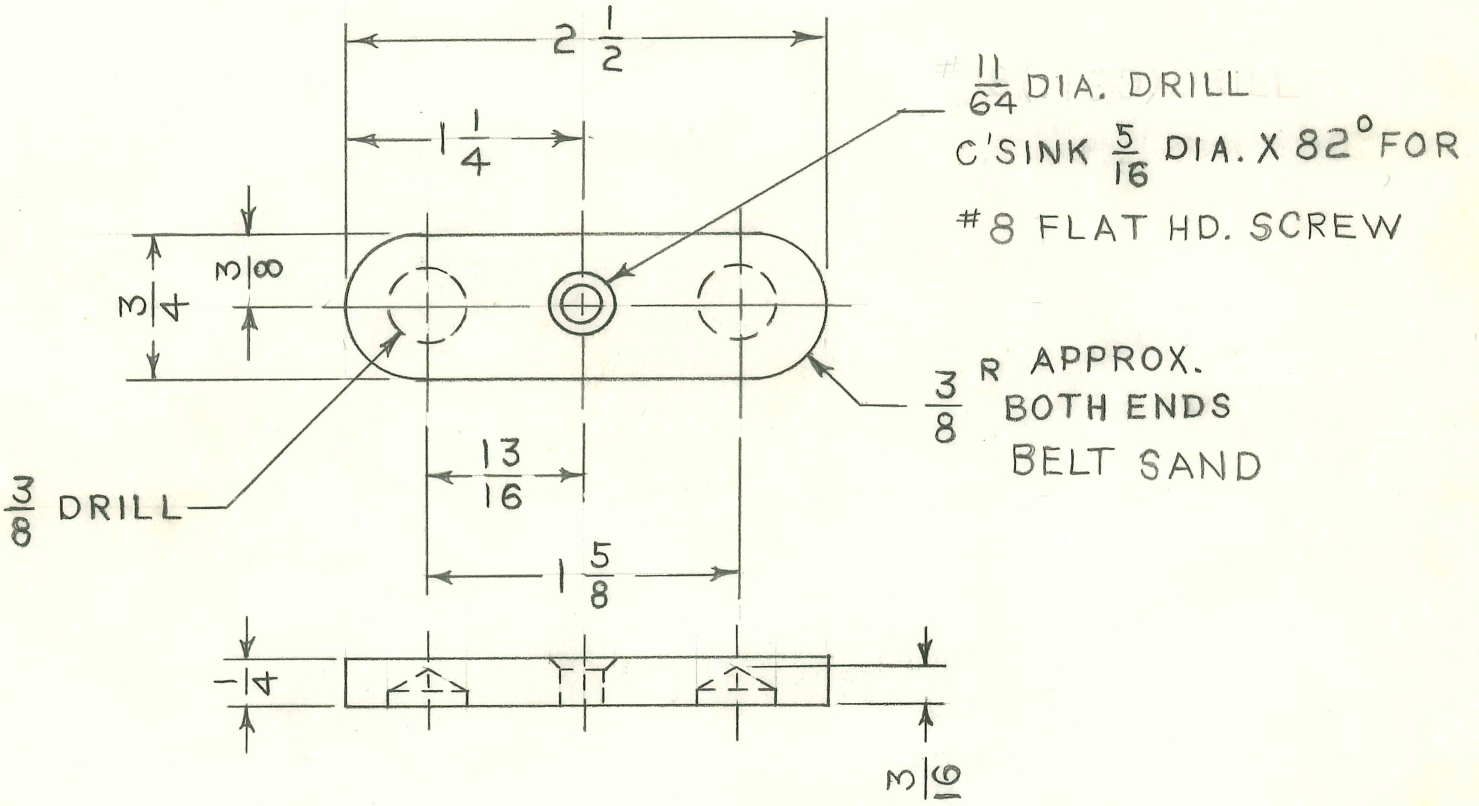

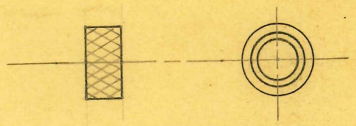

FULL SIZE

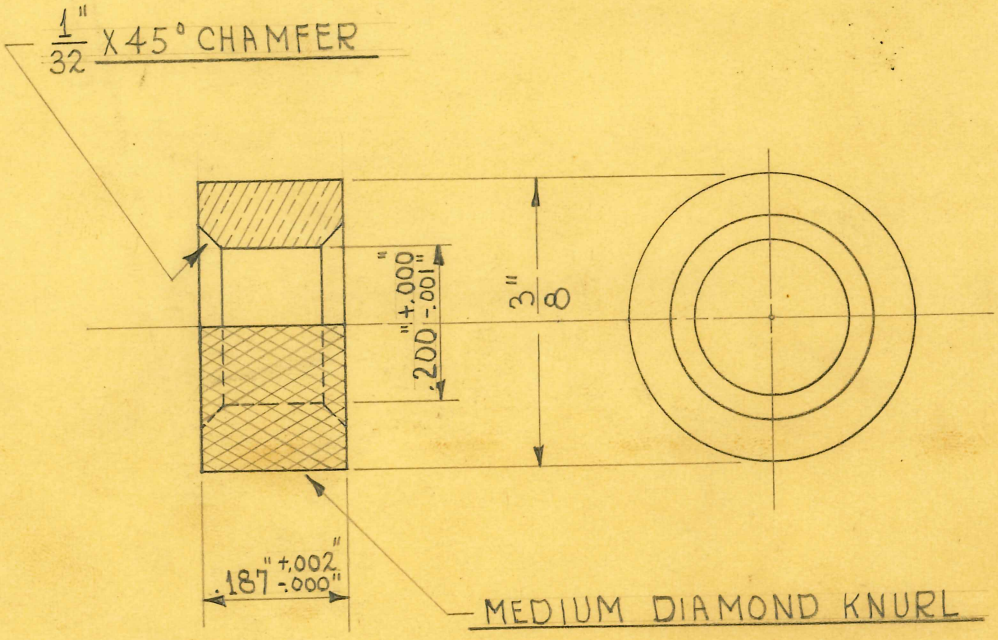

SCALE ~ 1" = 1/4"

2 REQUIRED

NOTE:
INSERT MUST BE CLEAN AND FREE FROM CHIPS, BURRS & OIL.

TOLERANCES
UNLESS OTHERWISE SPECIFIED:
DECIMAL DIMENSIONS + OR - .005"
FRACTIONAL DIMENSIONS + OR - .010"

SIZE	3/8" DIAM.	ISSUE 3-27-45	HE.
KIND	BRASS ROD	CHANGED	
SHAPE		"	
FINISH		"	
TEMP.		"	
PATT.		"	

TITLE: HINGED INDUCTION ELECTRODE HINGE PLATE INSERT

H. G. FISCHER & CO.
2335 WABANSIA AVE.
CHICAGO, ILL.

CAT. NO.

PART NO. 15881

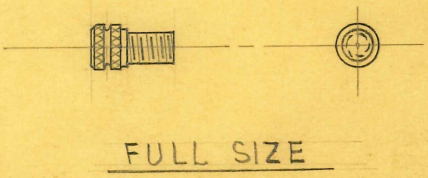

FULL SIZE

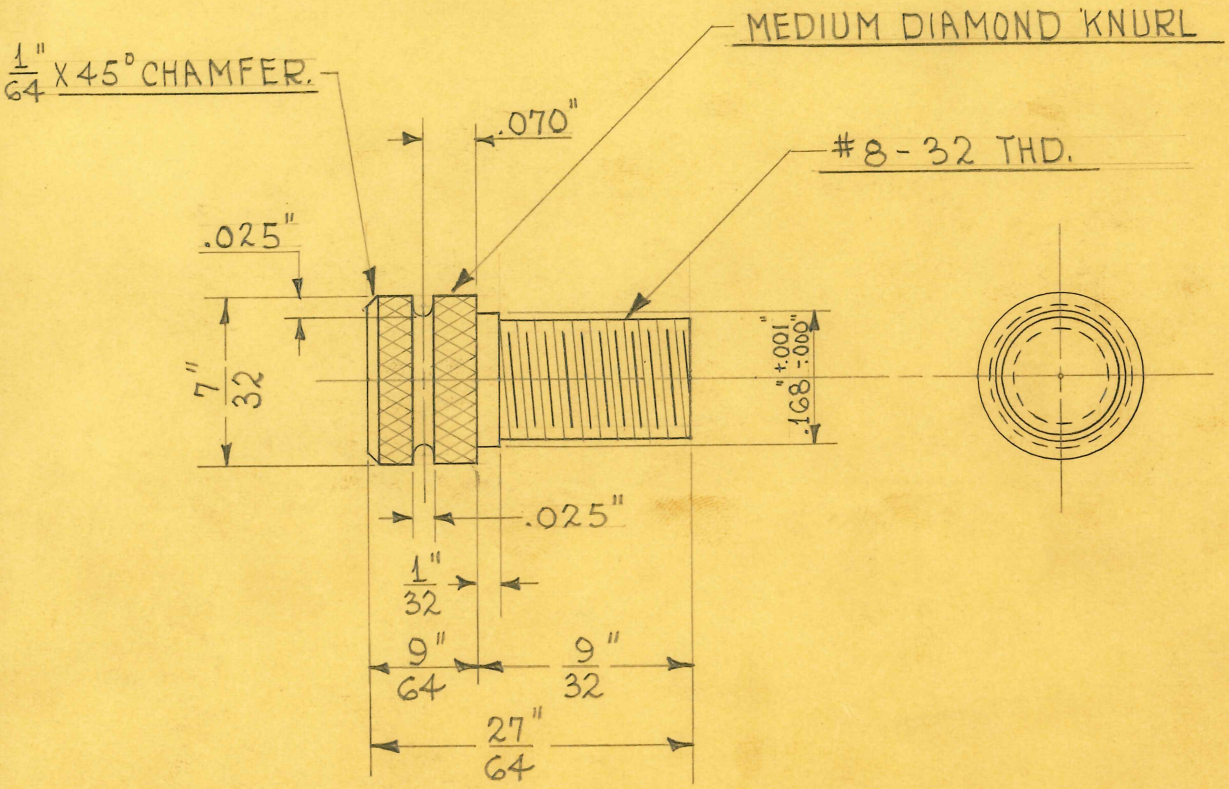

SCALE ~ 1" = 1/4"

10 REQUIRED

NOTE:~

INSERT MUST BE CLEAN AND FREE FROM CHIPS, BURRS & OIL.

TOLERANCES

UNLESS OTHERWISE SPECIFIED:
DECIMAL DIMENSIONS + OR - .005"
FRACTIONAL DIMENSIONS + OR - .010"

SIZE	7/32" DIAM.	ISSUE 3-27-45	HE.
KIND	BRASS ROD	CHANGED	
SHAPE		"	
FINISH		"	
TEMP.		"	
PATT.		"	

TITLE: HINGED INDUCTION ELECTRODE HOUSING COVER INSERT

H. G. FISCHER & CO.
2335 WABANSIA AVE.
CHICAGO, ILL.

CAT. NO.

PART NO. 15882

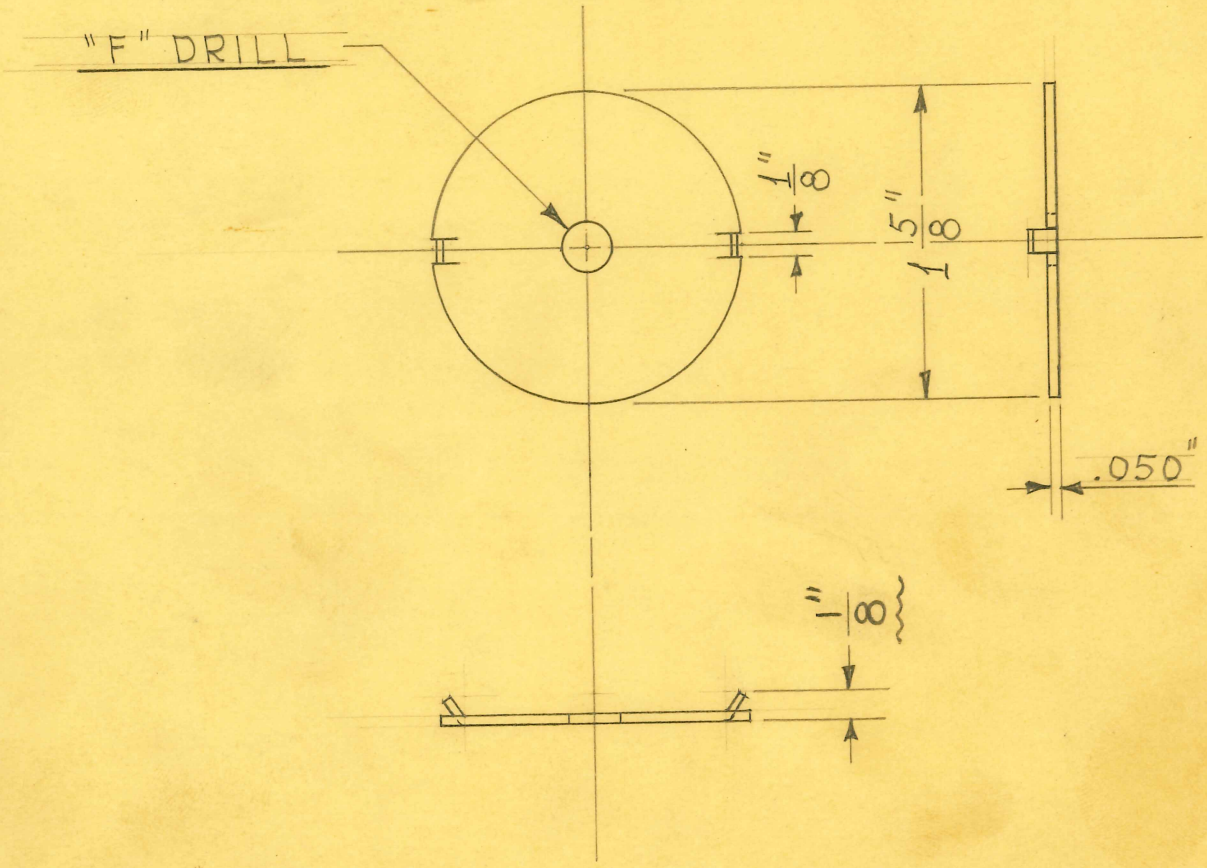

1 REQUIRED

TOOL # 9015

SIZE	.050" (#18 GA.)	ISSUE 10-18-45	HE.
KIND	C.R. STEEL	CHANGED	
SHAPE	SHEET	"	
FINISH	CAD. #23	"	
TEMP.		"	
PATT.		"	

TITLE: HINGED INDUCTION ELECTRODE ~ MTG. SWIVEL SPRING WASHER-LOCATING DISC

H. G. FISCHER & CO.
2335 WABANSIA AVE.
CHICAGO, ILL.

CAT. NO.

PART NO. 15884

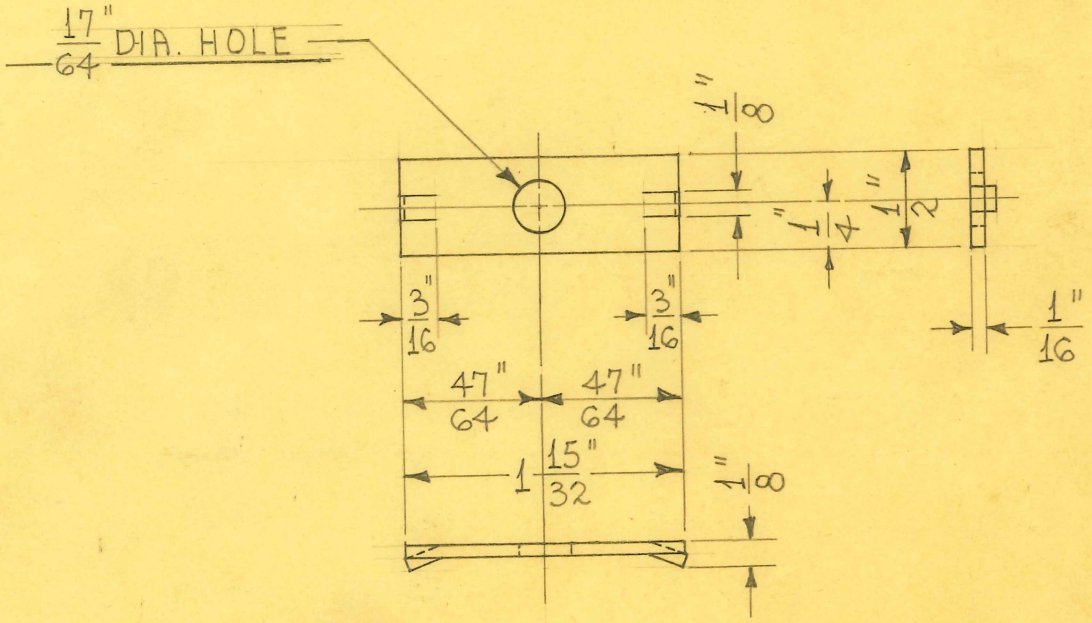

1 REQUIRED

SIZE	1/16" X 1/2"	ISSUE 10-18-45	HE.
KIND	C.R. STEEL	CHANGED	
SHAPE	STRIP	"	
FINISH		"	
TEMP.		"	
PATT.		"	

TITLE: HINGED INDUCTION ELECTRODE ~ MTG. SWIVEL LOCK NUT STRIP

H. G. FISCHER & CO.
2335 WABANSIA AVE.
CHICAGO. ILL.

CAT. NO.

PART NO. 15886

RETAP $\frac{1}{4}$" X 28

SPOT WELD

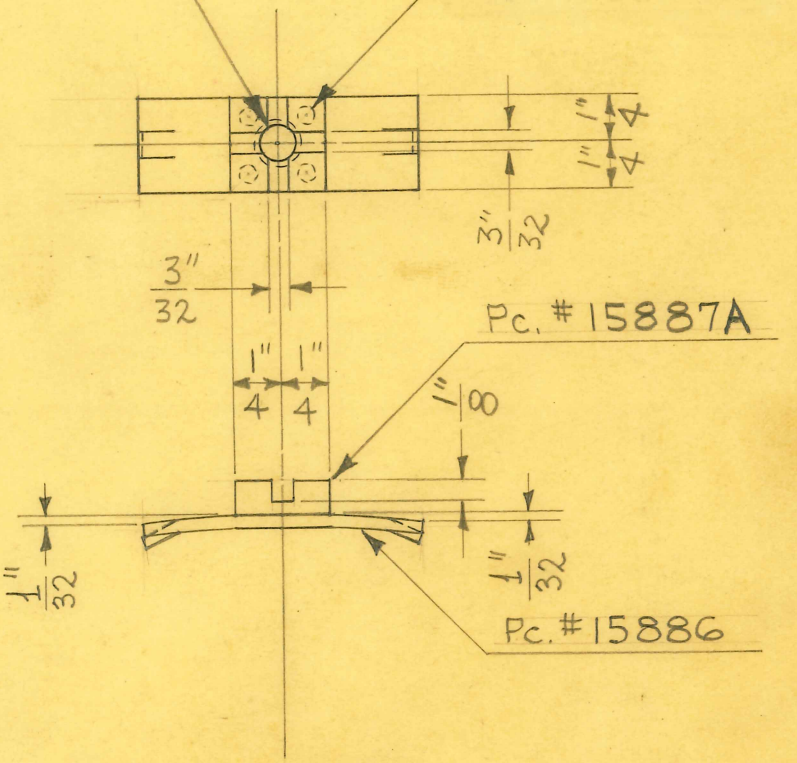

1 REQUIRED

MILLING FIXTURE TOOL #9099

SIZE		ISSUE 10-18-45	HE.
KIND		CHANGED	
SHAPE		"	
FINISH	CAD. #23	"	
TEMP.		"	
PATT.		"	

TITLE: HINGED INDUCTION ELECTRODE - MTG. SWIVEL LOCK NUT ASSEM.

H. G. FISCHER & CO.
2335 WABANSIA AVE.
CHICAGO, ILL.

CAT. NO.

PART NO. 15888GA

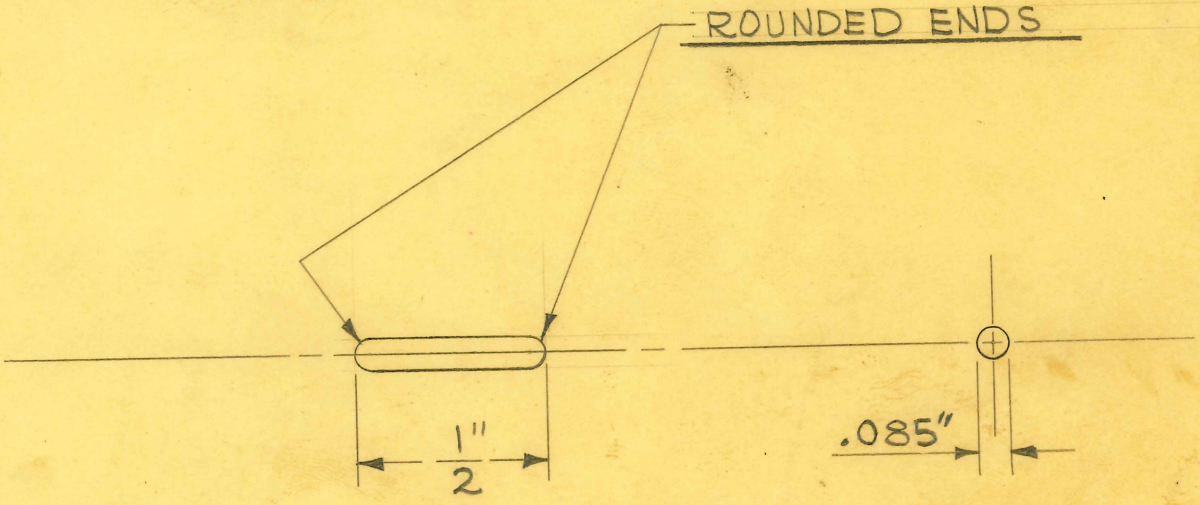

SCALE ~ DOUBLE SIZE

1 REQUIRED

#44 (.085") DRILL ROD

SIZE		ISSUE 11-5-45	J.V.W.	TITLE: HINGED INDUCTION ELECTRODE MTG. SWIVEL LOCK NUT PIN
KIND		CHANGED		
SHAPE		"		
FINISH		"		
TEMP.		"		
PATT.		"		

H. G. FISCHER & CO.
2335 WABANSIA AVE.
CHICAGO. ILL.

CAT. NO.

PART NO. 15889

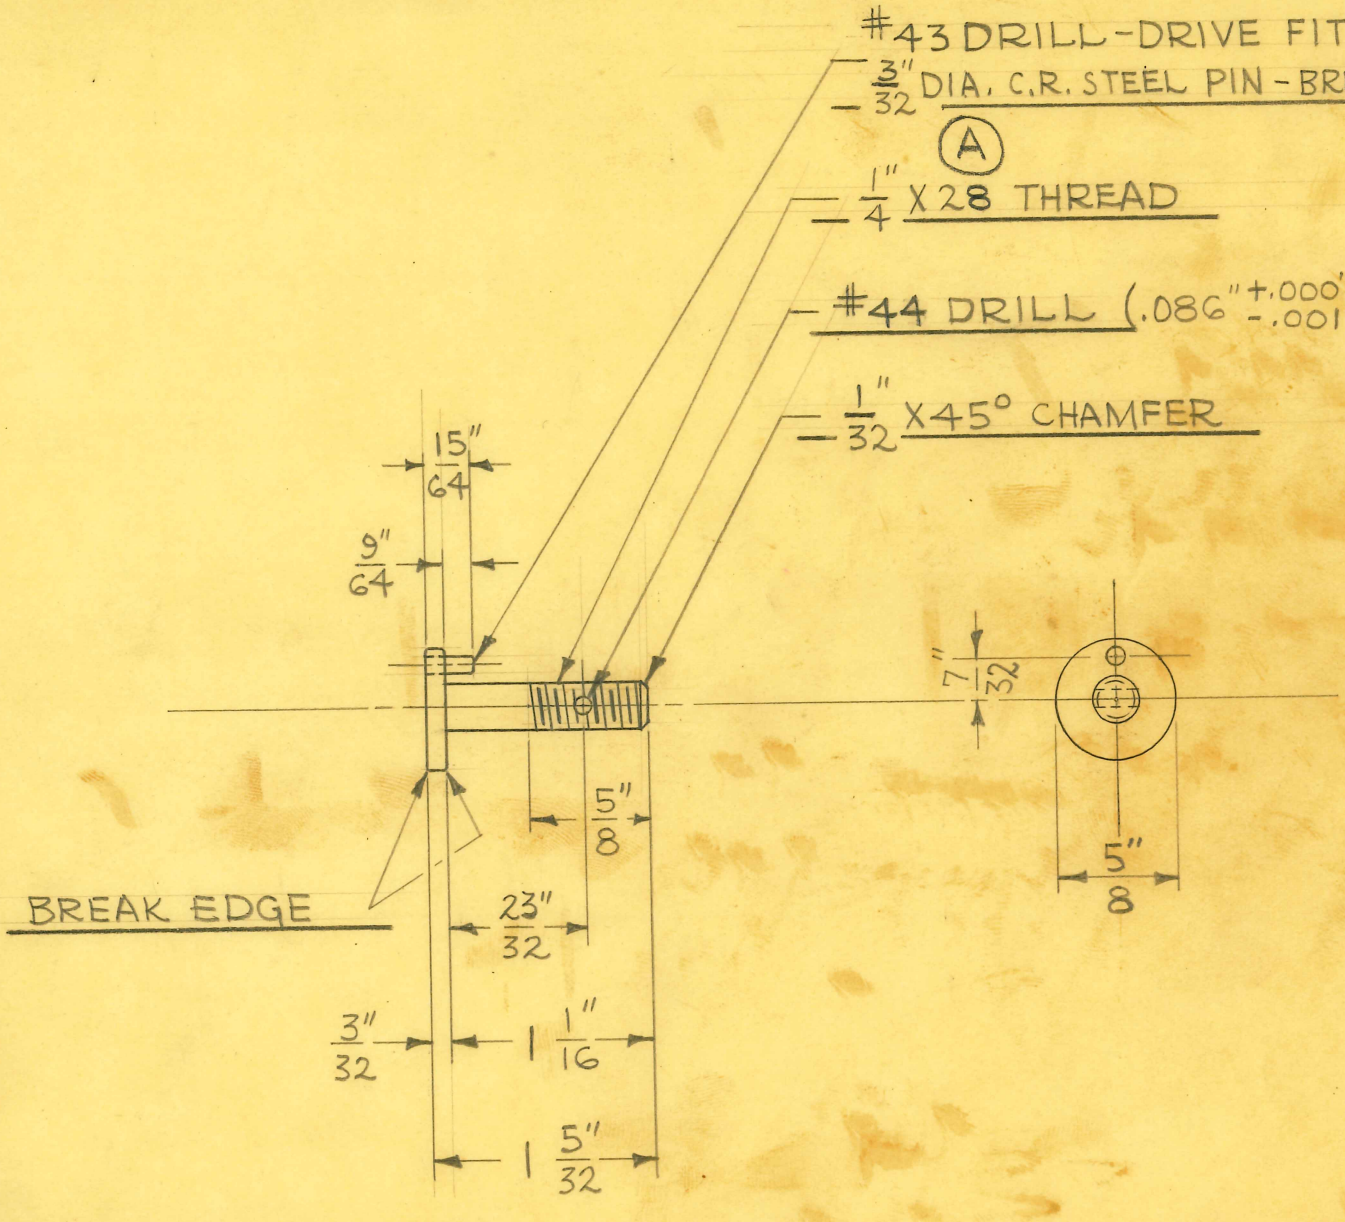

1 REQUIRED

SIZE	5/8" & 3/32"	ISSUE 11-5-45	J.V.W.	**TITLE:** HINGED INDUCTION ELECTRODE MOUNTING STUD
KIND	C.R. STEEL	CHANGED		
SHAPE	ROD	(A) " WAS 27 12-10-53	W.J.	
FINISH	CAD. #23	"		
TEMP.		"		
PATT.		"		

H. G. FISCHER & CO.
2335 WABANSIA AVE.
CHICAGO, ILL.

CAT. NO.

PART NO. 15890GA

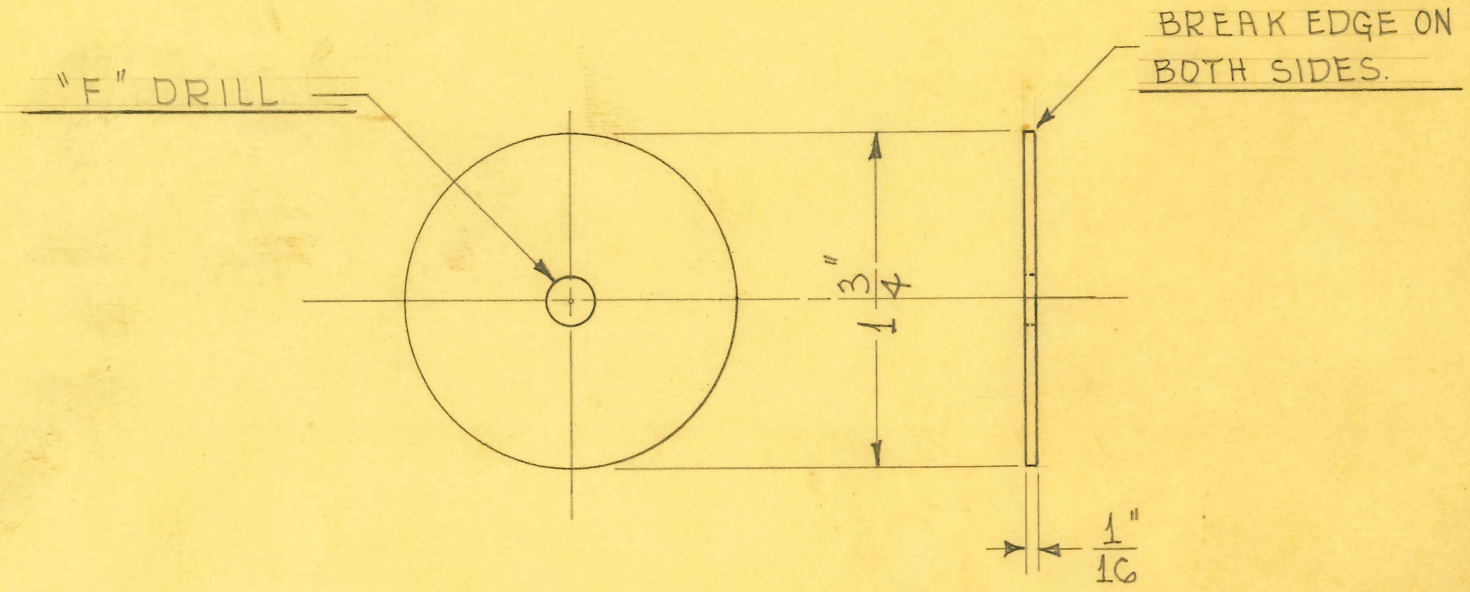

2 REQUIRED

SIZE	1/16" SHEET	ISSUE 10-18-45	HE.
KIND	BLK. FIBRE	CHANGED	
SHAPE		"	
FINISH		"	
TEMP.		"	
PATT.		"	

TITLE: HINGED INDUCTION ELECTRODE ~ MOUNTING SWIVEL FRICTION WASHER

H. G. FISCHER & CO.
2335 WABANSIA AVE.
CHICAGO. ILL.

CAT. NO.

PART NO. 15891

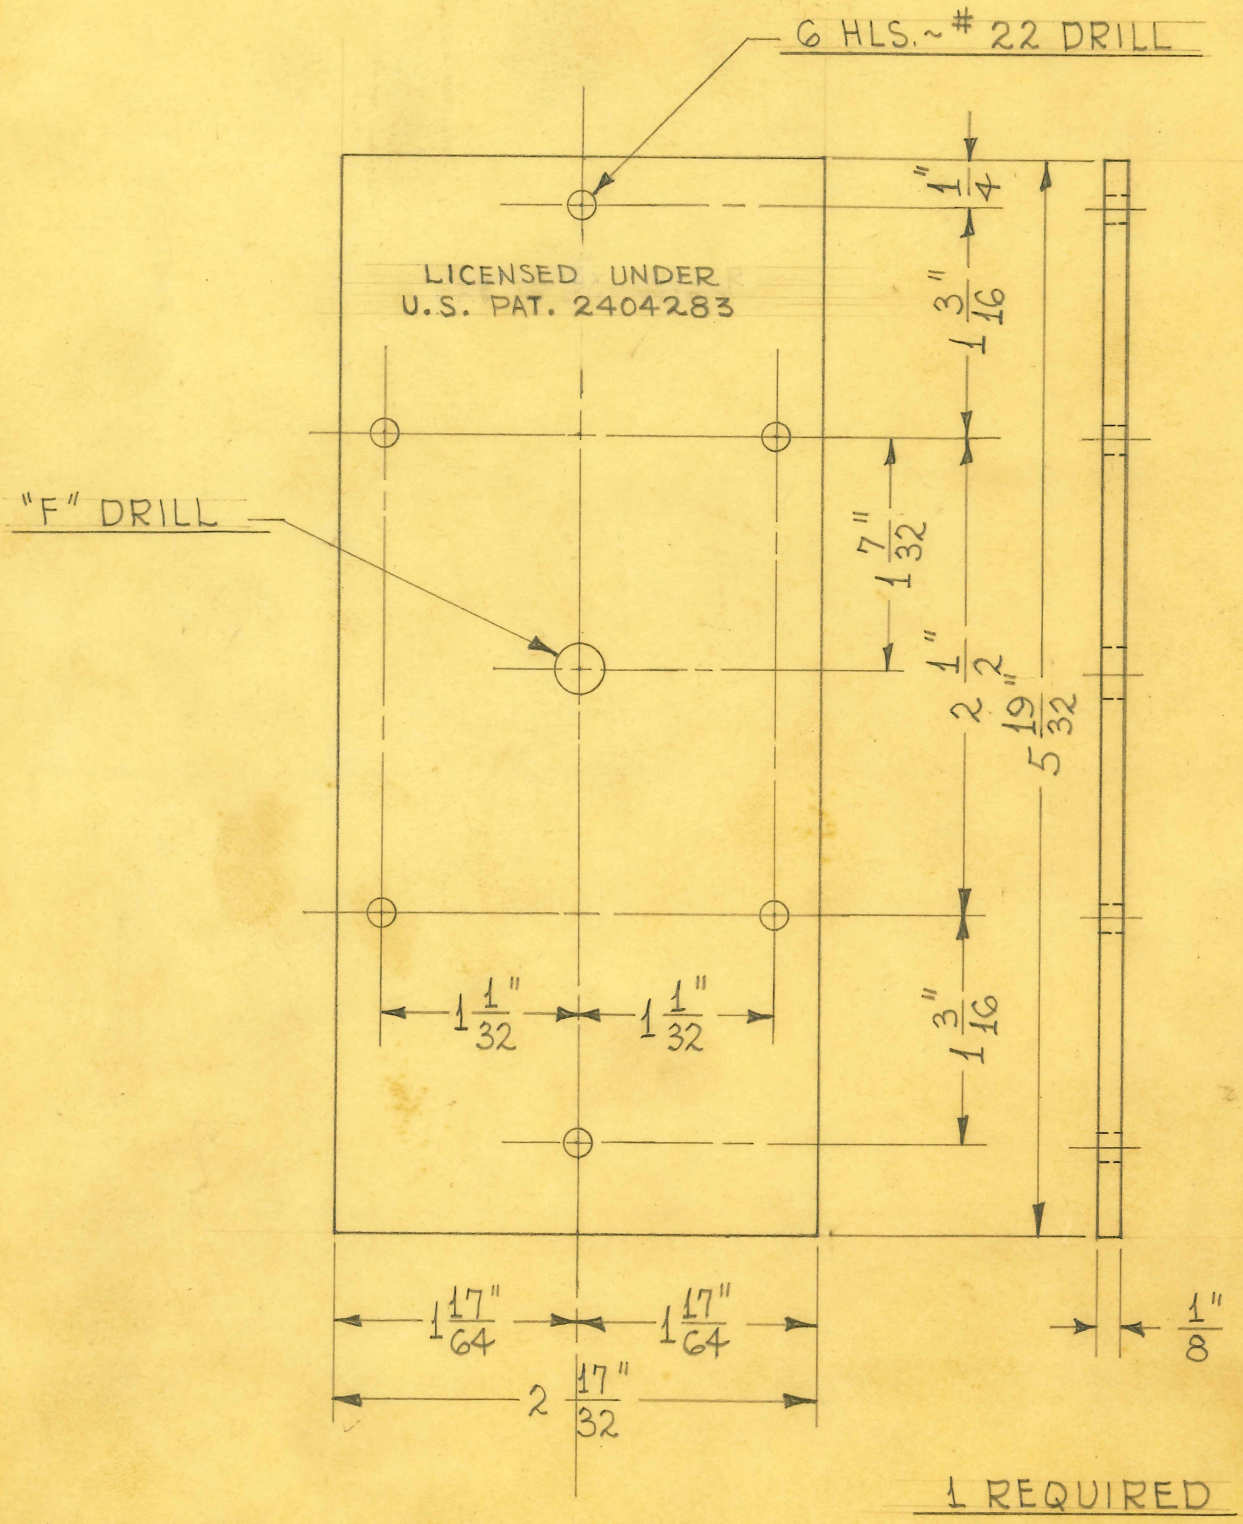

1 REQUIRED

1/8 SHEET-XX BAKELITE SATIN FINISH

SIZE	1/8" SHEET	ISSUE 10-18-45	HE.
KIND	XX BAKELITE	CHANGED	
SHAPE		"	
FINISH	SATIN	"	
TEMP.		"	
PATT.		"	

TITLE: HINGED INDUCTION ELECTRODE HINGE BOX COVER

H. G. FISCHER & CO.
2335 WABANSIA AVE.
CHICAGO, ILL.

CAT. NO.

PART NO. 15892F

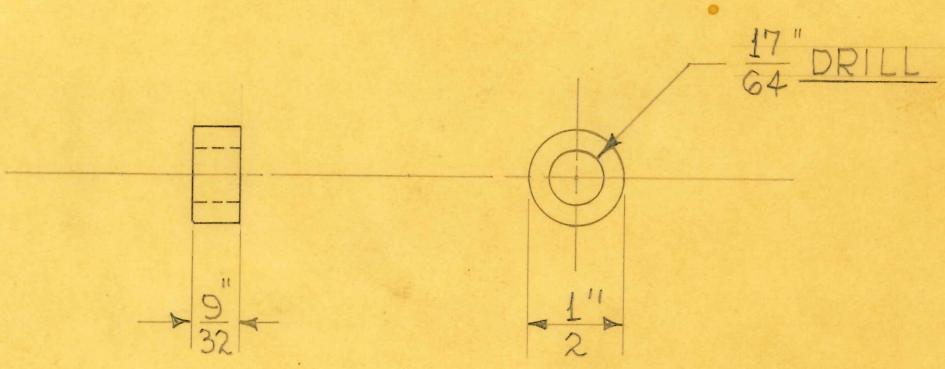

4 REQUIRED

SIZE	1/2" DIA.	ISSUE 7-27-44	HE.
KIND	BRASS	CHANGED	
SHAPE	ROD	"	
FINISH		"	
TEMP.		"	
PATT.		"	

TITLE: FISCHER MOD. "S" SHORT WAVE OUTFIT- TRANSF. TERMINAL STRIP SPACER

H. G. FISCHER & CO.
2335 WABANSIA AVE.
CHICAGO, ILL.

CAT. NO.

PART NO. 15904

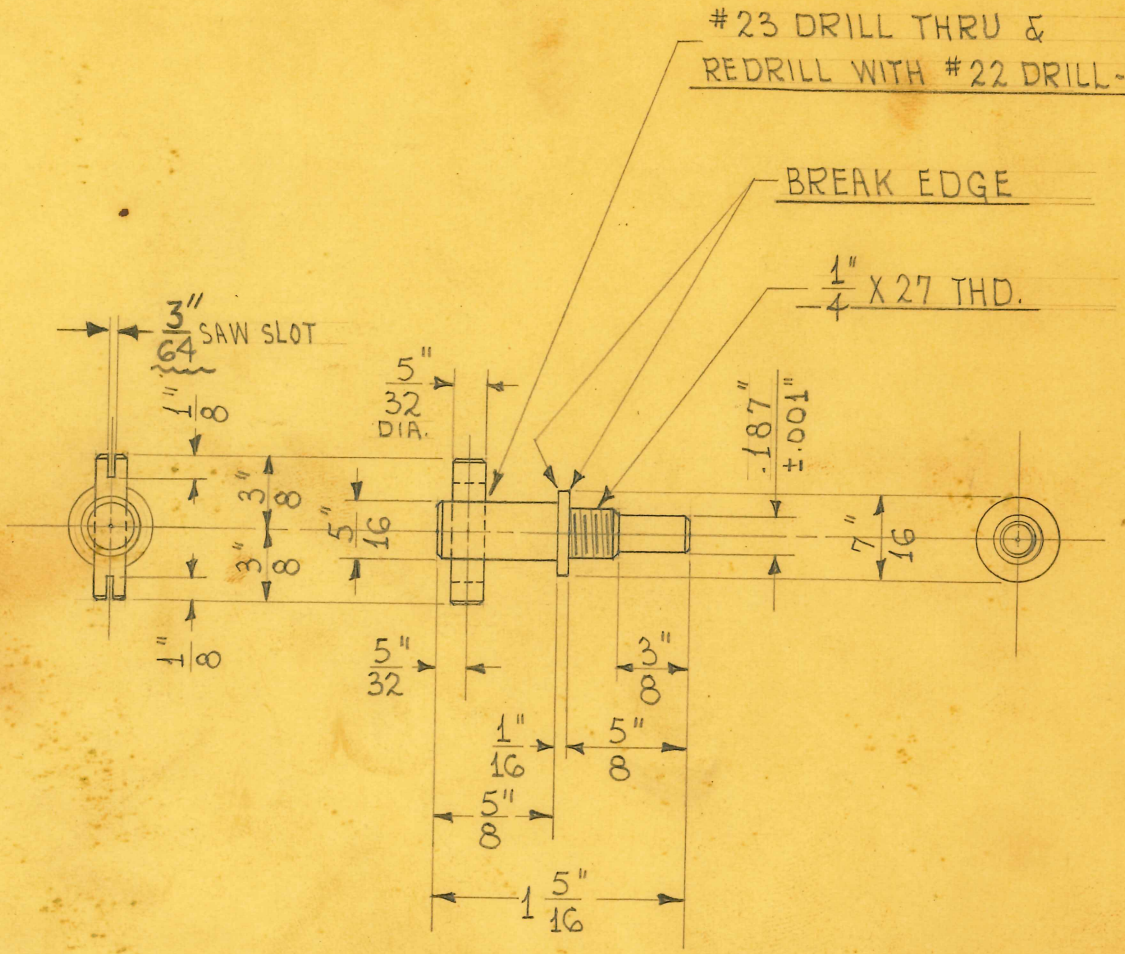

1 REQUIRED

SIZE	5/32" & 7/16" D.	ISSUE 2-22-45	HE.
KIND	BRASS ROD	CHANGED	
SHAPE		"	
FINISH		"	
TEMP.		"	
PATT.		"	

TITLE: SHORT WAVE COND. TYPE ELECTRODE - CORD CONNECTOR

H. G. FISCHER & CO.
2335 WABANSIA AVE.
CHICAGO. ILL.

CAT. NO.

PART NO. 159266

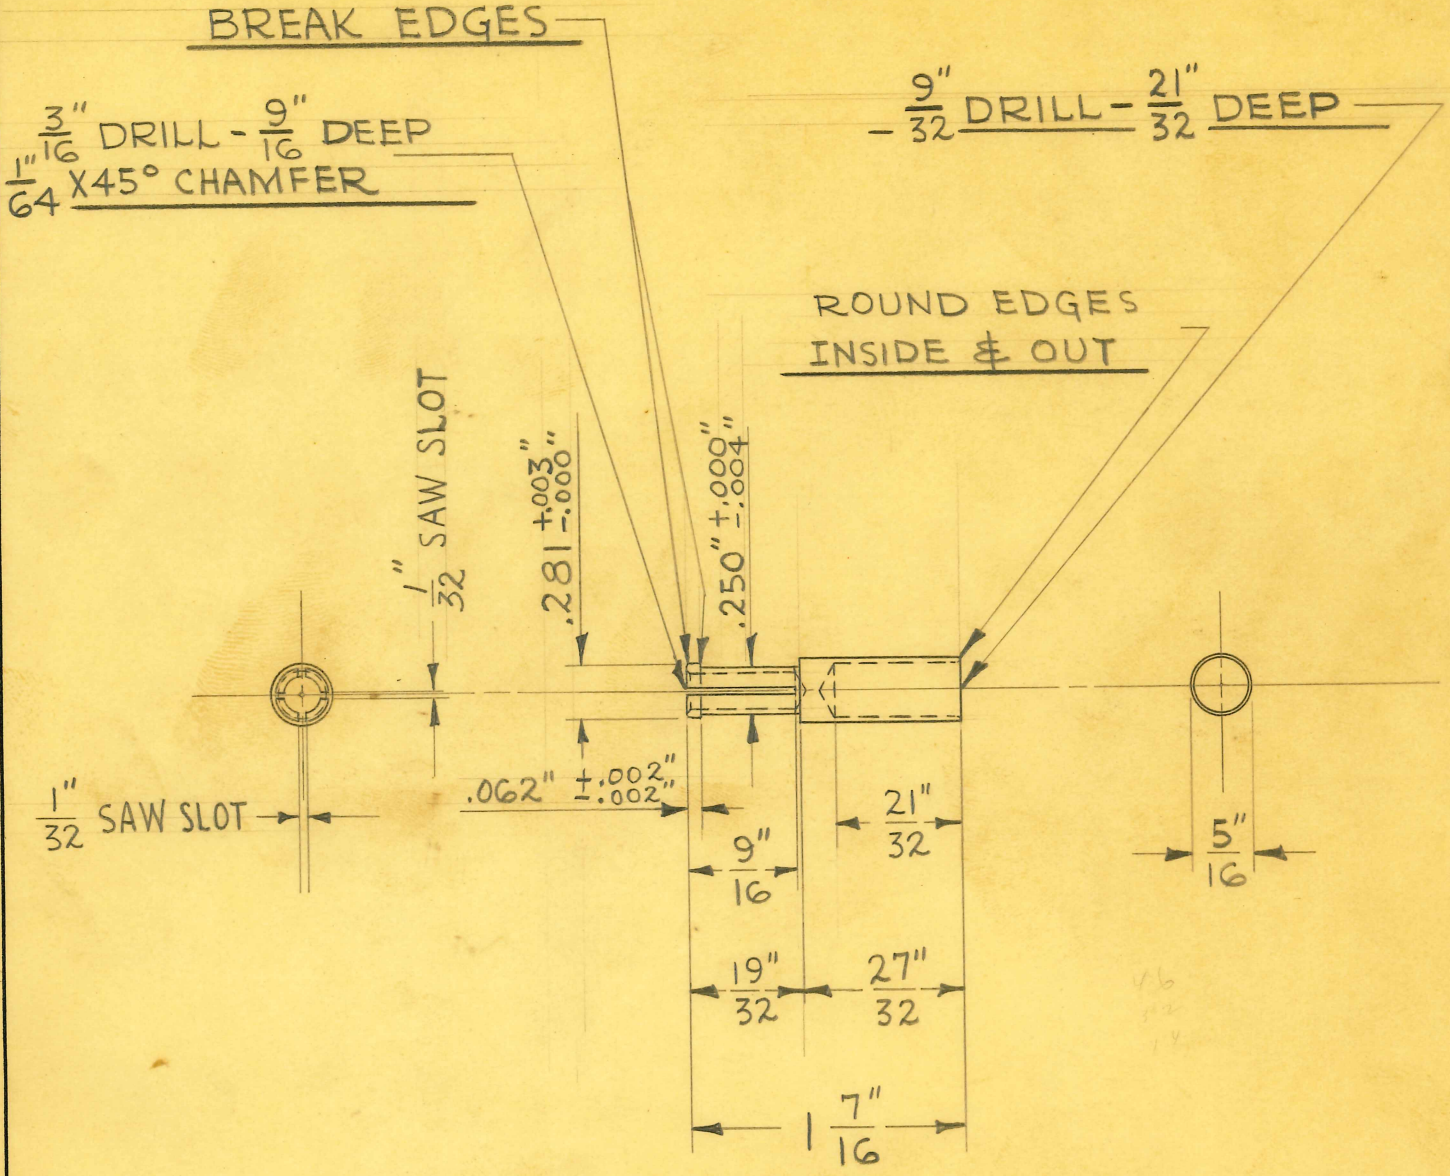

1 REQUIRED

SIZE	5/16" DIA.	ISSUE 12-13-46	J.V.W.
KIND	BRASS ROD	CHANGED	
SHAPE		"	
FINISH		"	
TEMP.		"	
PATT.		"	

TITLE: SHORT WAVE COND. TYPE ELECTRODE CORD CONNECTOR SOCKET

H. G. FISCHER & CO.
2338 WABANSIA AVE.
CHICAGO, ILL.

CAT. NO.

PART NO. 15927A

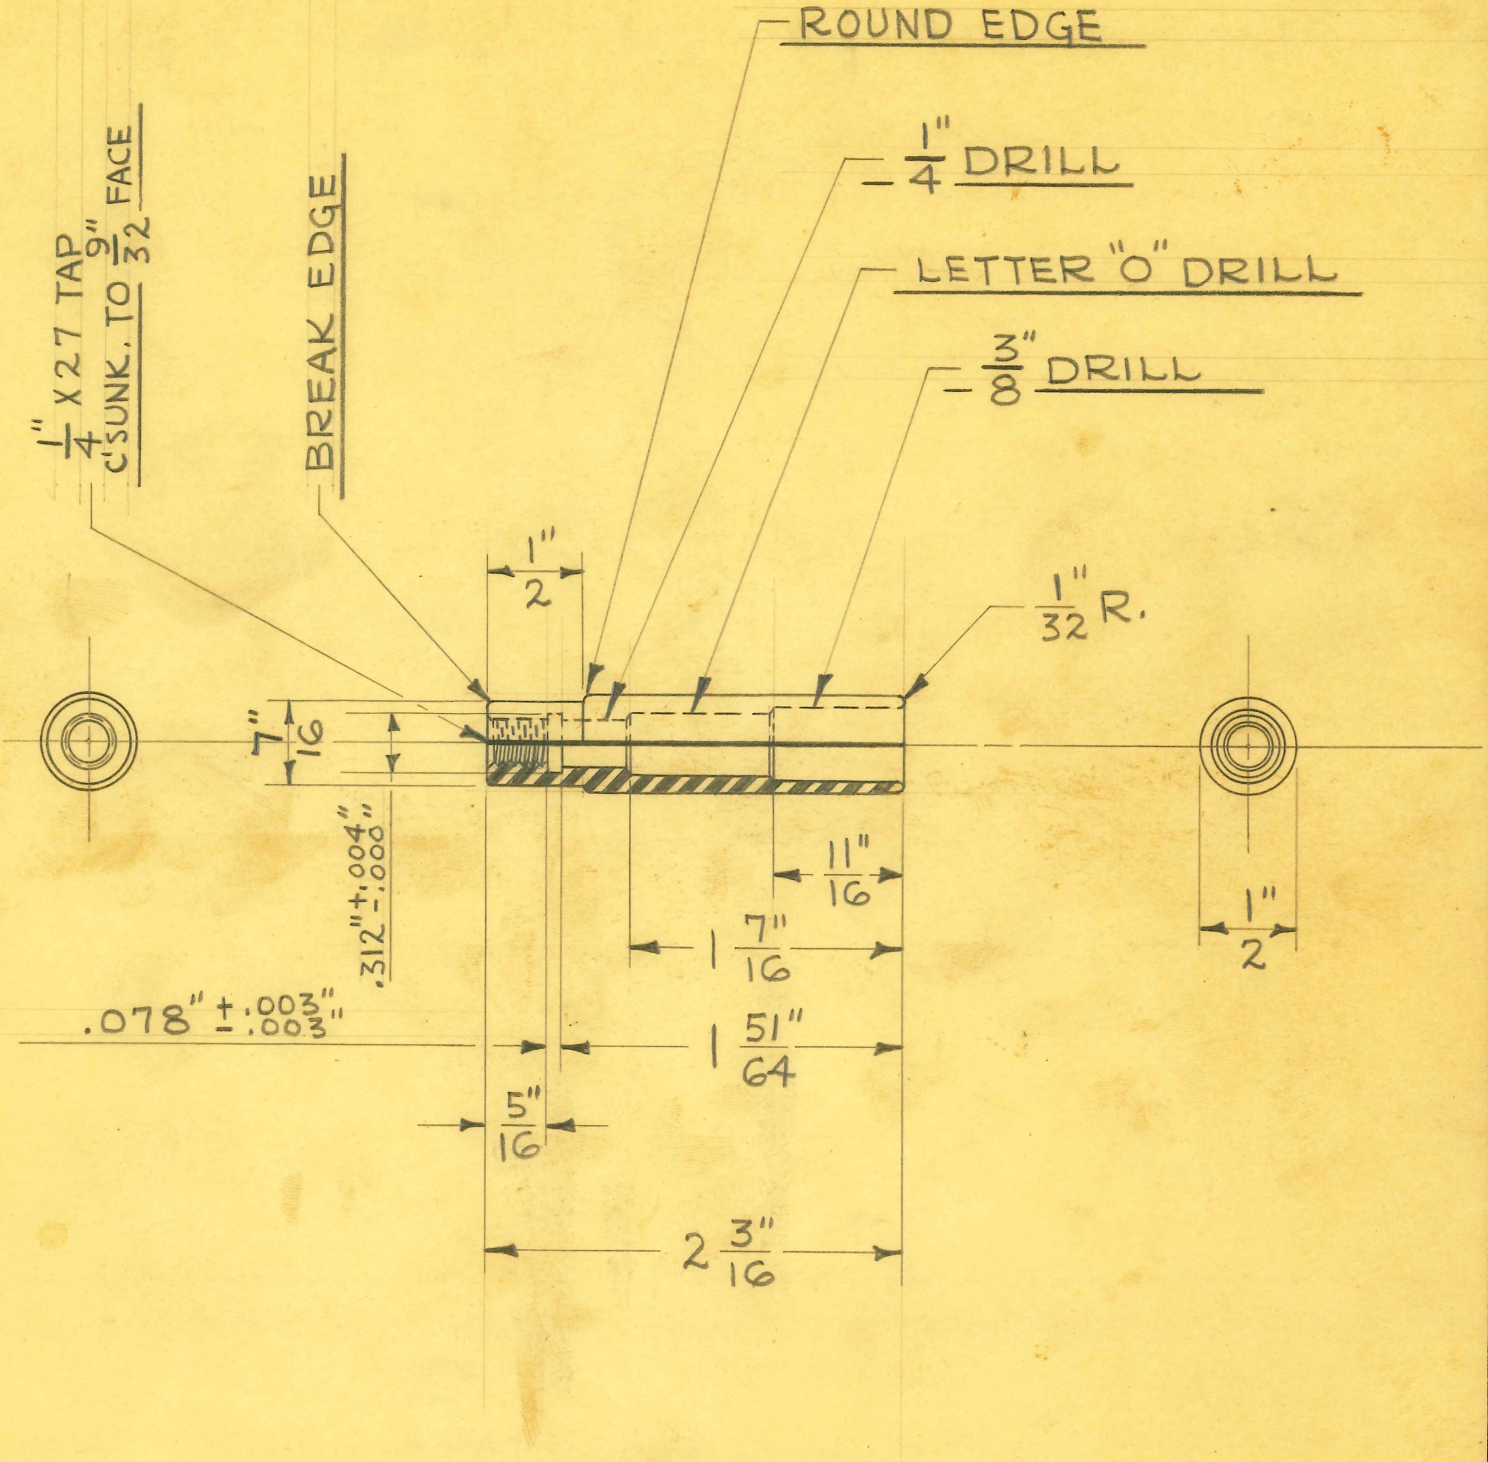

1 REQUIRED

SIZE	½" DIA.	ISSUE 12-13-46	J.V.W.
KIND	POL. HARD	CHANGED	
SHAPE	RUBBER ROD	"	
FINISH		"	
TEMP.		"	
PATT.		"	

TITLE: SHORT WAVE COND. TYPE ELECTRODE CORD CONNECTOR SOCKET INSULATOR

H. G. FISCHER & CO.
2335 WABANSIA AVE.
CHICAGO, ILL.

CAT. NO.

PART NO. 15928A

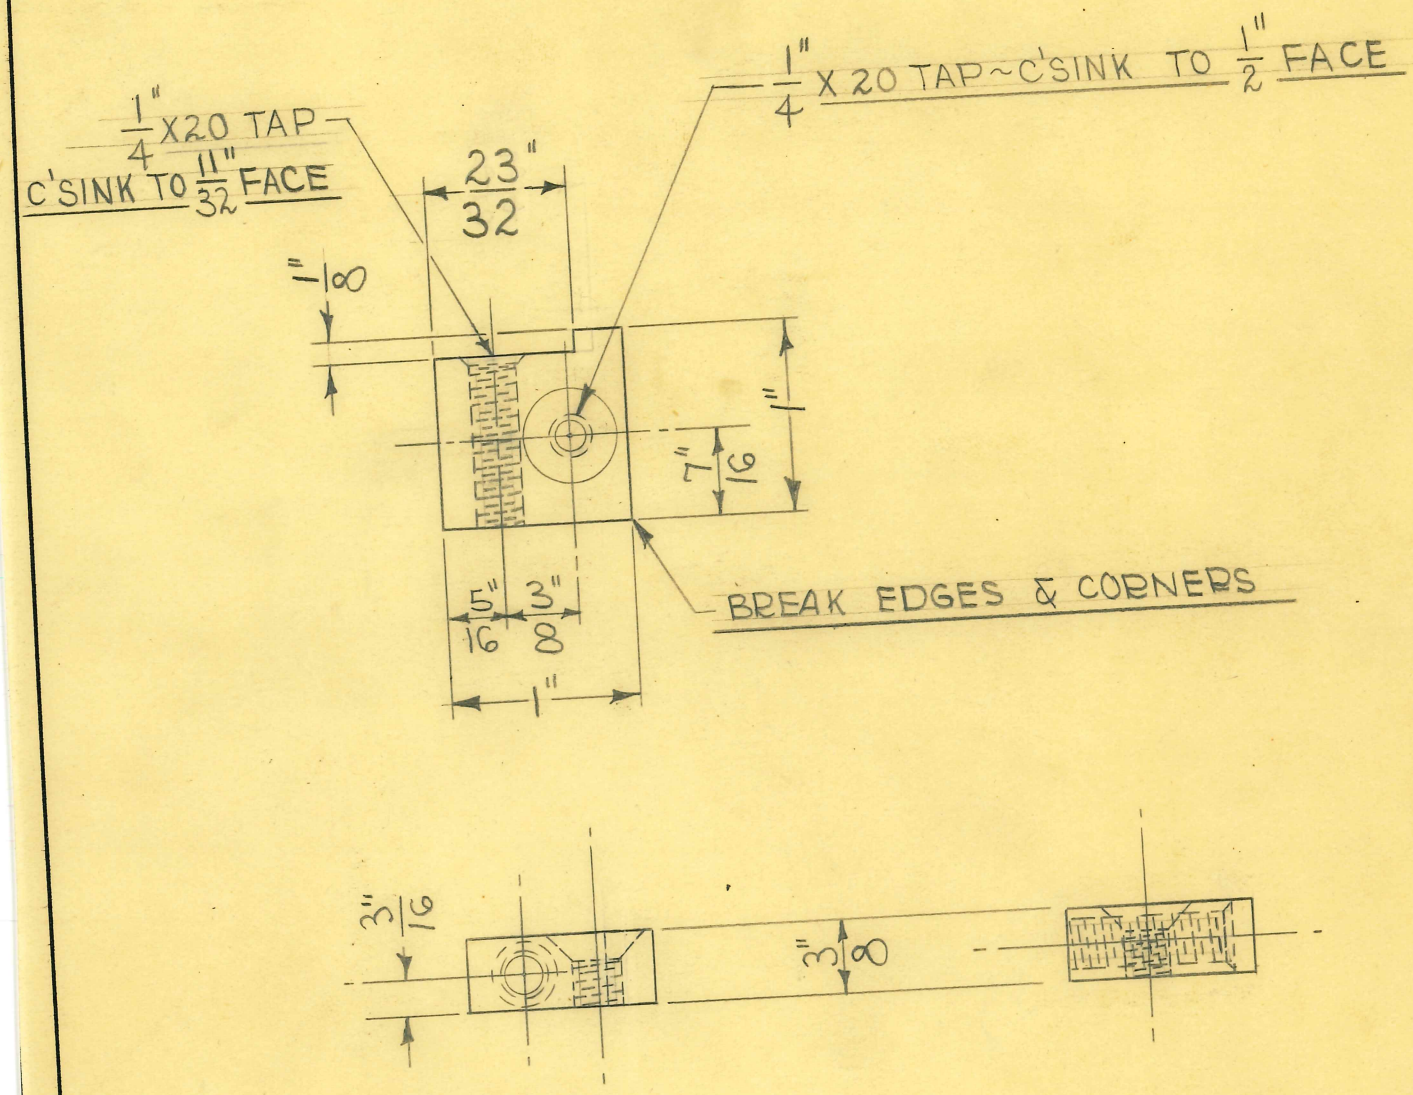

1 REQUIRED

MILLING FIXTURE TOOL # 9669
DRILL JIG TOOL # 9668

DIMENSIONS	
FRACTIONAL	± .015
DECIMAL	± .005
ANGULAR	± 1/2°

UNLESS OTHERWISE SPECIFIED

SIZE	3/8" X 1"	ISSUE 1-7-48	W. J.	
KIND	BRASS	CHANGED		
SHAPE	BAR	"		
FINISH		"		
TEMP.		"		
PATT.		"		

TITLE: FISCHER "MODEL 200" PORTABLE DIATHERMY
TANK COIL SUPP. ~ FRONT

H. G. FISCHER & CO.
2335 WABANSIA AVE.
CHICAGO, ILL.

CAT. NO.

PART NO. 17056

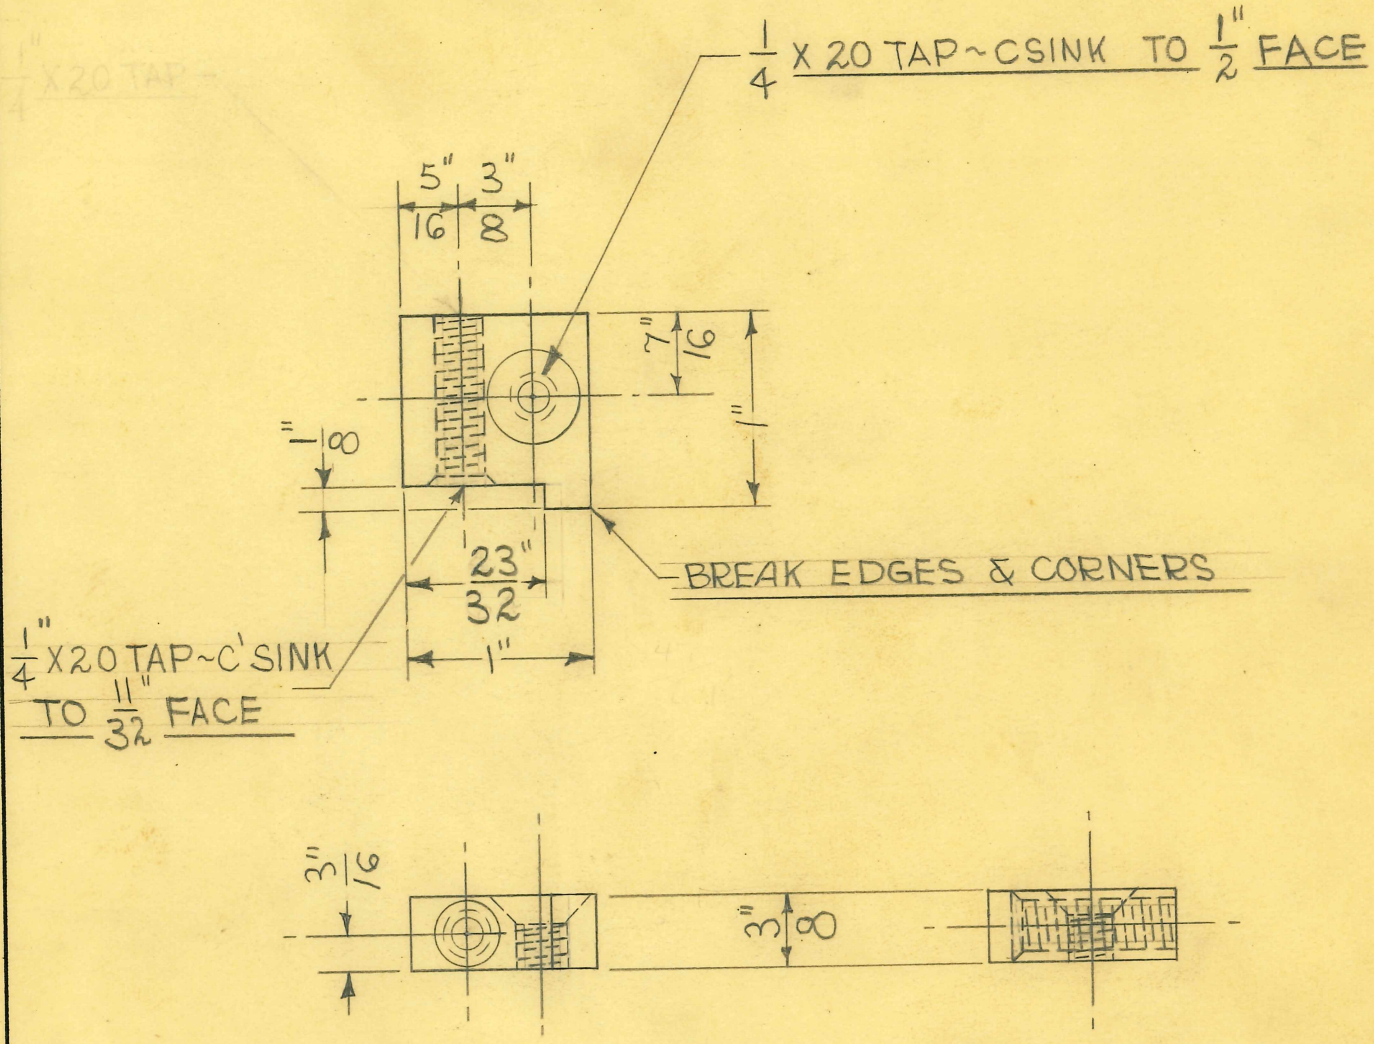

1 REQUIRED

MILLING FIXTURE TOOL # 9669
DRILL JIG TOOL # 9668

DIMENSIONS	
FRACTIONAL	± .015
DECIMAL	± .005
ANGULAR	± 1/2°

UNLESS OTHERWISE SPECIFIED

SIZE	3/8" X 1"	ISSUE 1-7-48	W.J.
KIND	BRASS	CHANGED	
SHAPE	BAR	"	
FINISH		"	
TEMP.		"	
PATT.		"	

TITLE:
FISCHER "MODEL 200" PORTABLE DIATHERMY
TANK COIL SUPP. ~ BACK

H. G. FISCHER & CO.
2335 WABANSIA AVE.
CHICAGO, ILL.

CAT. NO.

PART NO. 17057

BREAK INSIDE & OUTSIDE EDGES - BOTH ENDS

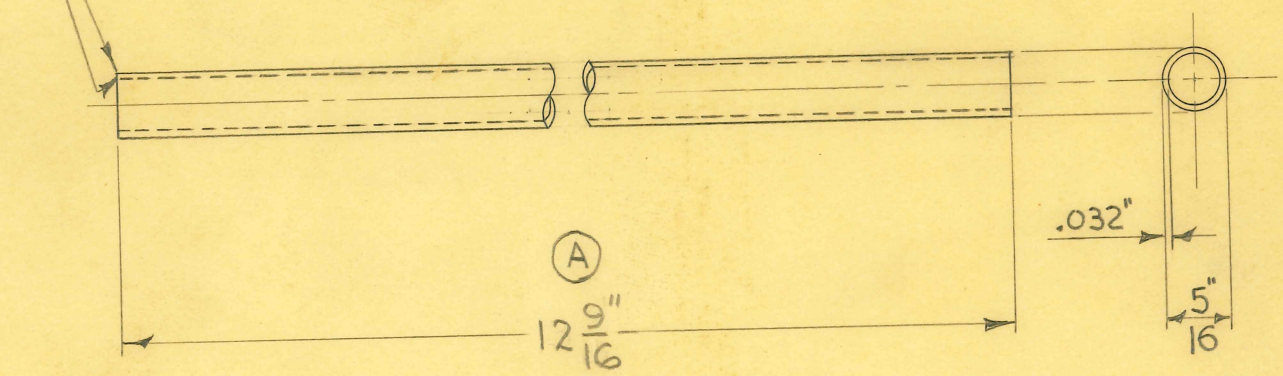

1-REQUIRED

REVISION		DATE	BY
A	WAS 13 1/16"	4-13-50	J.V.W.

5/16" O.D. X 21GA. (.032") WALL SEAMLESS STEEL TUBING

DIMENSIONS	
FRACTIONAL	± .015
DECIMAL	± .005
ANGULAR	± 1/2°

UNLESS OTHERWISE SPECIFIED

		ISSUE		
SIZE		ISSUE	1-8-48	J.M.F
KIND		CHANGED		
SHAPE		"	4-15-48	J.B.G.
FINISH		"		
TEMP.		"		
PATT.		"		

TITLE: FISCHER MODEL "200" PORTABLE DIATHERMY CABINET LEAD TUBE

H. G. FISCHER & CO.
2335 WABANSIA AVE.
CHICAGO. ILL.

CAT. NO.

PART NO. 17058A

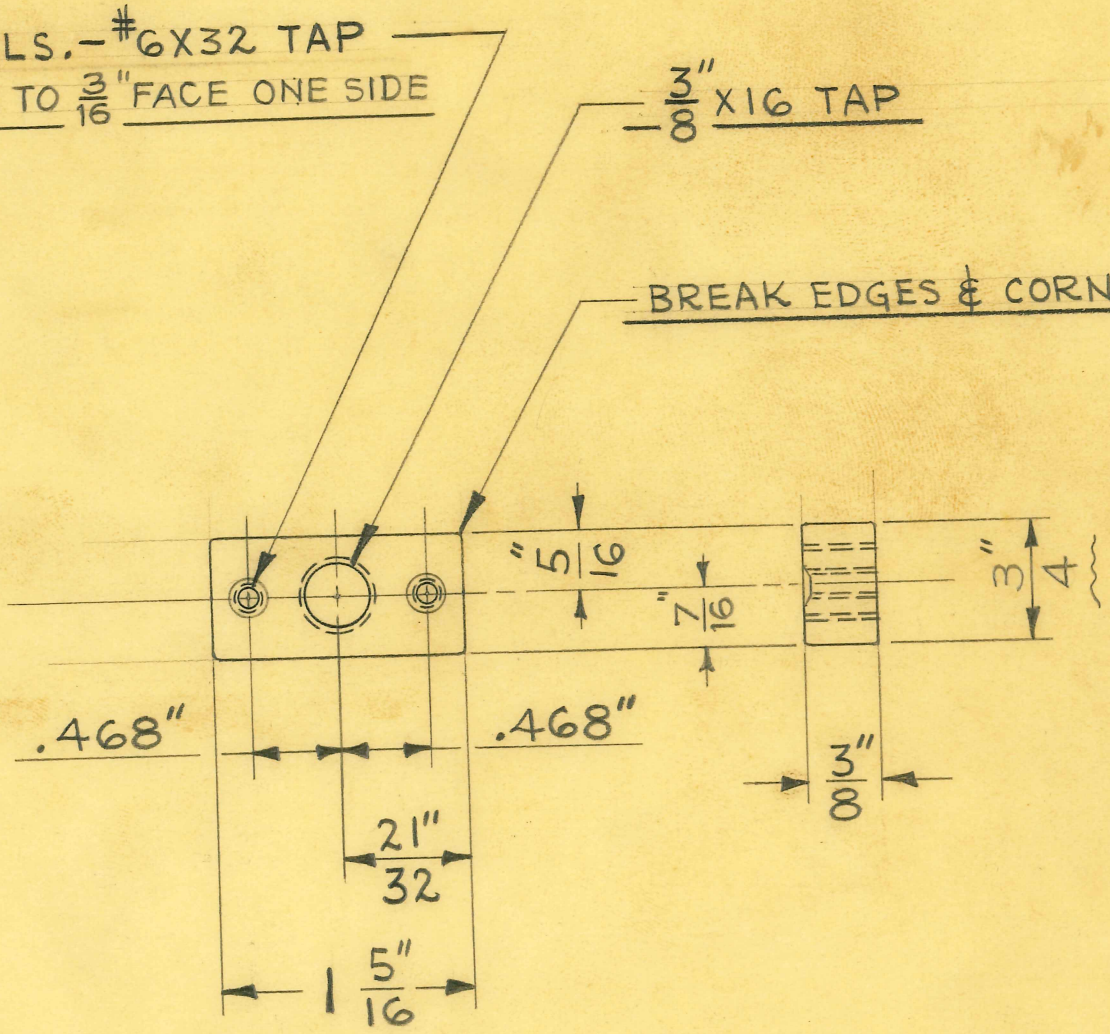

1 REQUIRED

DIMENSIONS	
FRACTIONAL	± .015
DECIMAL	± .005
ANGULAR	± 1/2°

UNLESS OTHERWISE SPECIFIED

DRILL JIG TOOL #9670

SIZE	3/8" X 3/4"	ISSUE 2-6-48	J.V.W.
KIND	C.R. STEEL	CHANGED	
SHAPE	BAR	" 4-15-48	J.B.G.
FINISH	CAD. #23	"	
TEMP.		"	
PATT.		"	

TITLE: FISCHER MODEL "200" TABLE DIATHERMY ELECTRODE ARM CABINET CLAMP PAD

H. G. FISCHER & CO.
2335 WABANSIA AVE.
CHICAGO, ILL.

CAT. NO.

PART NO. 17059

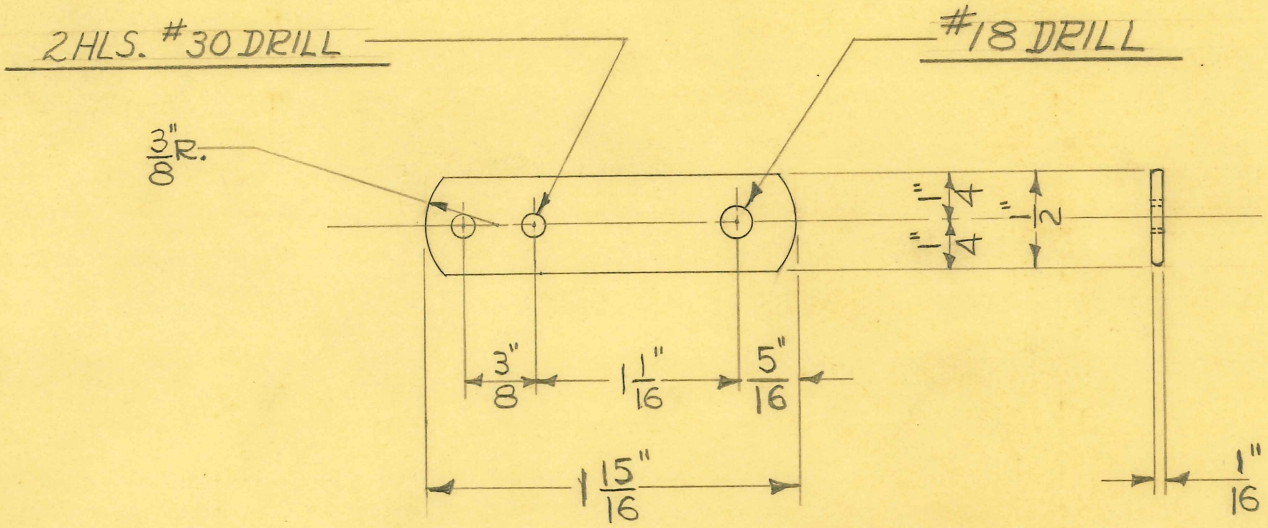

DEVELOPED LENGTH

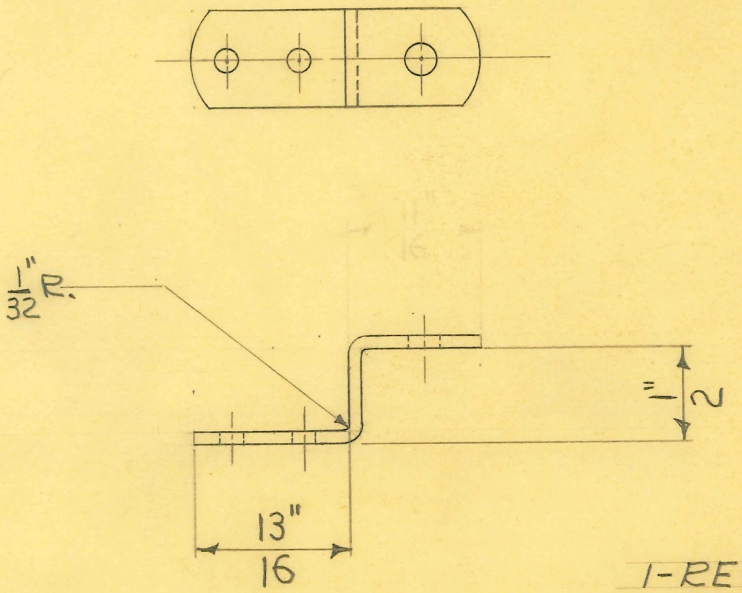

1-REQUIRED

FORMING FIXTURE TOOL # 9672
DRILL JIG TOOL # 9671

DIMENSIONS	
FRACTIONAL	± .015
DECIMAL	± .005
ANGULAR	± 1/2°

UNLESS OTHERWISE SPECIFIED

SIZE	1/16" X 1/2"	ISSUE 1-7-48	J.M.F
KIND	FLAT WIRE	CHANGED	
SHAPE		"	
FINISH	CAD #23	"	
TEMP.		"	
PATT.		"	

TITLE:
FISCHER MODEL "200" PORTABLE DIATHERMY
CHOKE COIL SUPPORT

H. G. FISCHER & CO.
2335 WABANSIA AVE.
CHICAGO, ILL.

CAT. NO.

PART NO. 17060

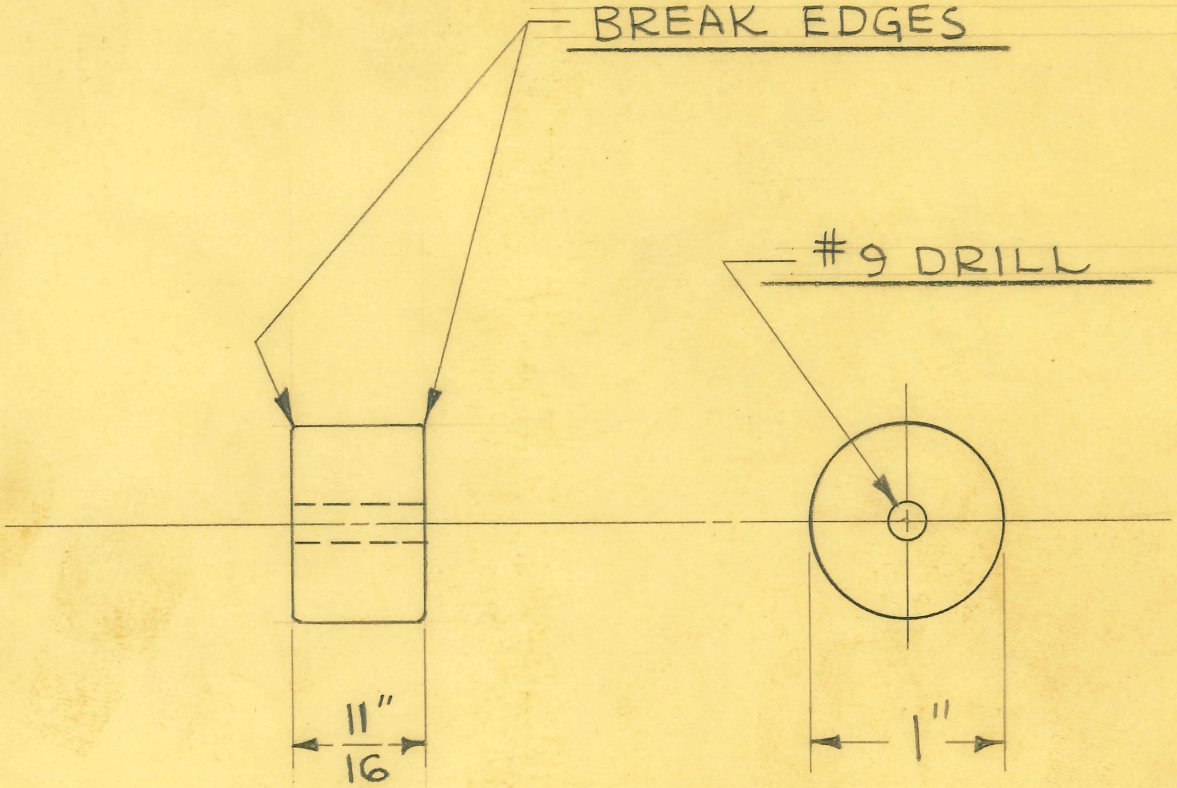

4 REQUIRED

DIMENSIONS	
FRACTIONAL	± .015
DECIMAL	± .005
ANGULAR	± 1/2°

UNLESS OTHERWISE SPECIFIED

SIZE	1" DIA.	ISSUE 2-17-48	J.V.W.
KIND	C.R. STEEL	CHANGED	
SHAPE	ROD	"	
FINISH	CAD. #23	"	
TEMP.		"	
PATT.		"	

TITLE: FISCHER MODEL "200" TABLE DIATHERMY CABINET GLIDE

H. G. FISCHER & CO.
2335 WABANSIA AVE.
CHICAGO, ILL.

CAT. NO.

PART NO. 17061

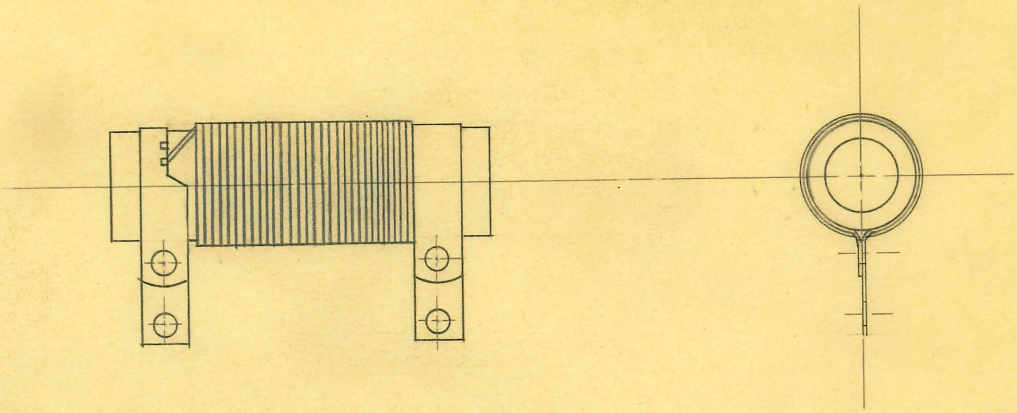

OHMITE SPEC. # 26627

2 REQUIRED

DIMENSIONS	
FRACTIONAL	± .015
DECIMAL	± .005
ANGULAR	± 1/2°

UNLESS OTHERWISE SPECIFIED

STOCK NO. Z-26
MAX. AMPS. 5

SIZE		ISSUE 2-6-48 J.V.W.	
KIND		CHANGED	
SHAPE		"	
FINISH		"	
TEMP.		"	
PATT.		"	

TITLE: FISCHER MOD. "200" TABLE DIATHERMY OSCILLATING TUBE R.F. CHOKE

H. G. FISCHER & CO.
2335 WABANSIA AVE.
CHICAGO, ILL.

CAT. NO.

PART NO. 17068

TITLE FISCHER TABLE MOD. "200" DIATHERMY ELECTRODE ARM TUBE SPACING BLOCK

H. G. FISCHER & CO.
FRANKLIN PARK, ILLINOIS

PART NO. 17073

DATE 10-18-48 | DR. BY K.F.S. | CH'K'D. J.V.W.

REVISION	DATE	BY

PATTERN | FINISH | SCALE FULL

TOOLS | MATERIAL $\frac{3}{8}$" X $\frac{1}{2}$" BRASS BAR

DIMENSIONS
FRACTIONAL ± .015
DECIMAL ± .005
ANGULAR ± ½°
UNLESS OTHERWISE SPECIFIED

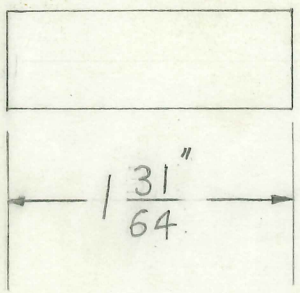

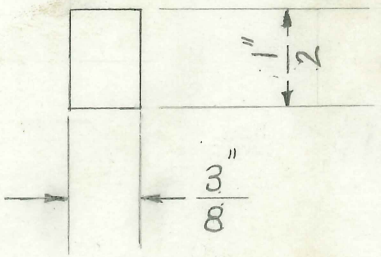

1 REQUIRED

FOLDER #129

TITLE: FISCHER MOD. "200" DIATHERMY PAD ADAPTER - INSULATOR TUBE	H. G. FISCHER & CO. FRANKLIN PARK, ILLINOIS	PART NO. 17079	
	DATE 11-24-48 DR. BY J.V.W. CH'K'D.	REVISION	DATE / BY
PATTERN / FINISH / SCALE	DIMENSIONS: FRACTIONAL ± .015; DECIMAL ± .005; ANGULAR ± ½°; UNLESS OTHERWISE SPECIFIED		
TOOLS	MATERIAL: ALSIMAG - A35 U-20471 TUBE		

1 REQUIRED

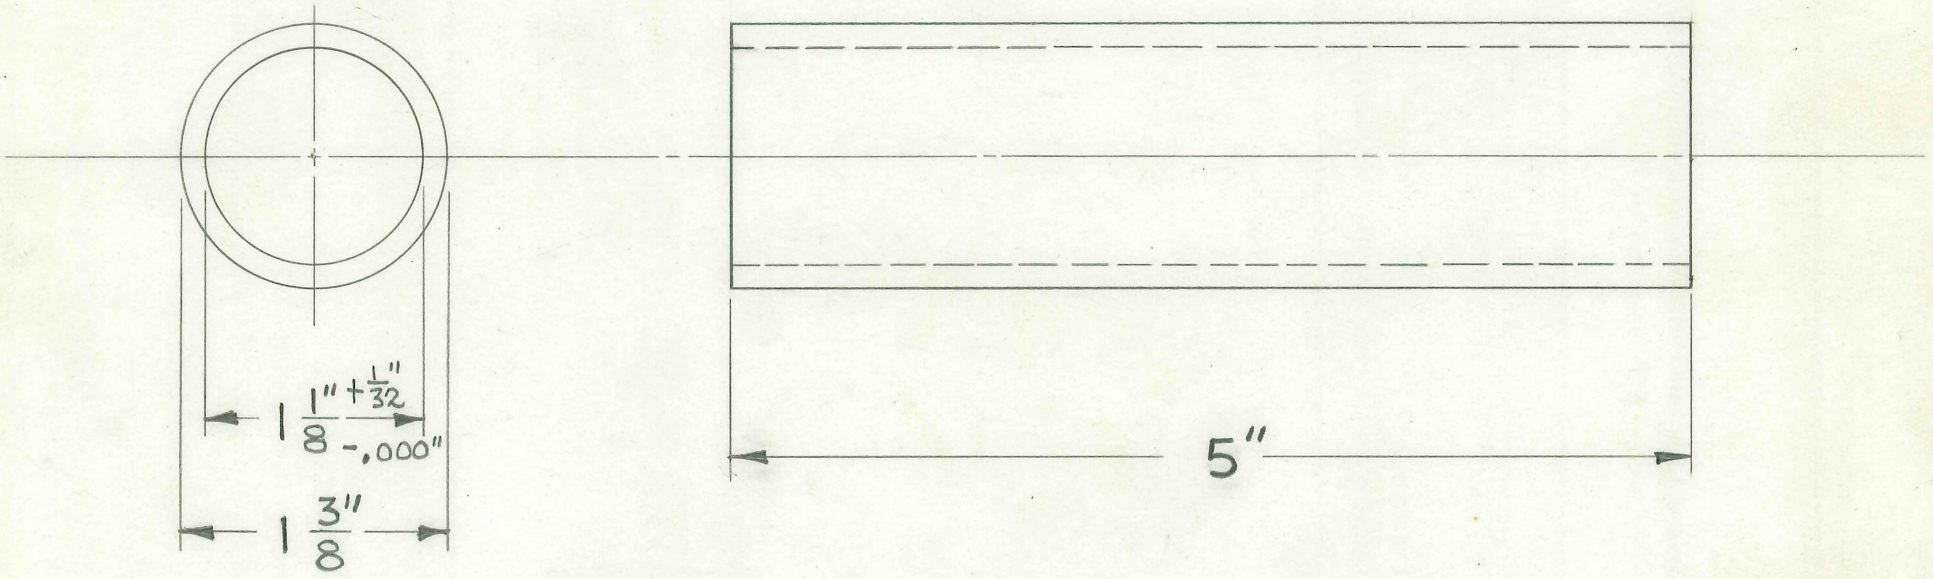

FOLDER #129

BREAK CORNERS & EDGES - BOTH ENDS.

2 HLS. - $\frac{17}{64}$" DRILL

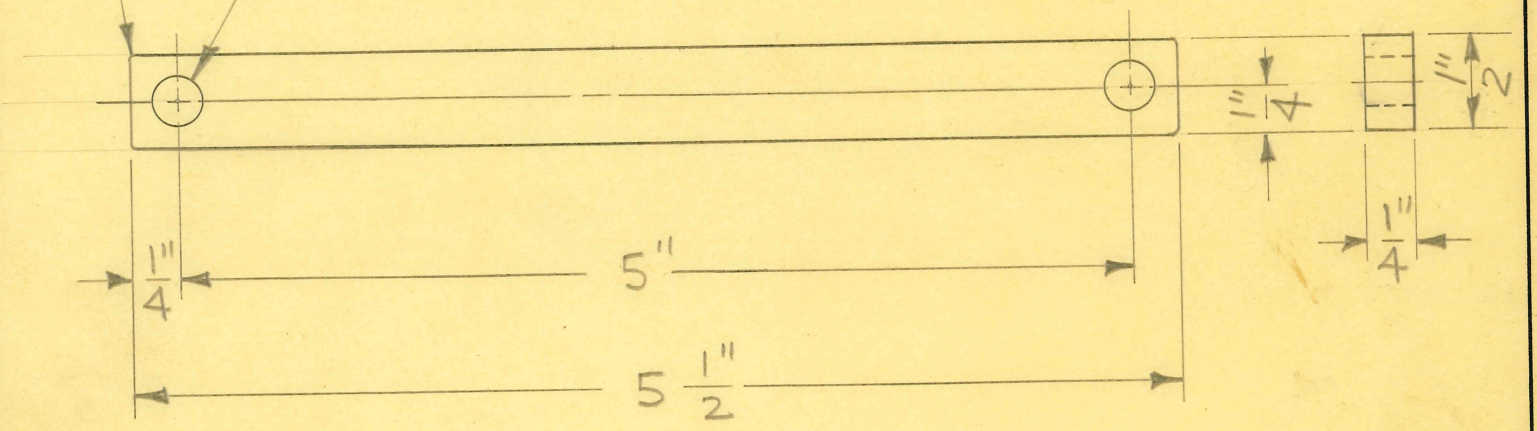

4 REQUIRED

DRILL JIG TOOL # 9842

DIMENSIONS	
FRACTIONAL	± .015
DECIMAL	± .005
ANGULAR	± 1/2°

UNLESS OTHERWISE SPECIFIED

SIZE	1/4" X 1/2"	ISSUE 6-22-48	J.V.W.
KIND	C.R. STEEL	CHANGED	
SHAPE	BAR	"	
FINISH		"	
TEMP.		"	
PATT.		"	

TITLE: FISCHER TABLE MOD. "200" DIATHERMY (FOREIGN) FIL. TRANSF. CLAMP

H. G. FISCHER & CO.
2335 WABANSIA AVE.
CHICAGO, ILL.

CAT. NO.

PART NO. 17081

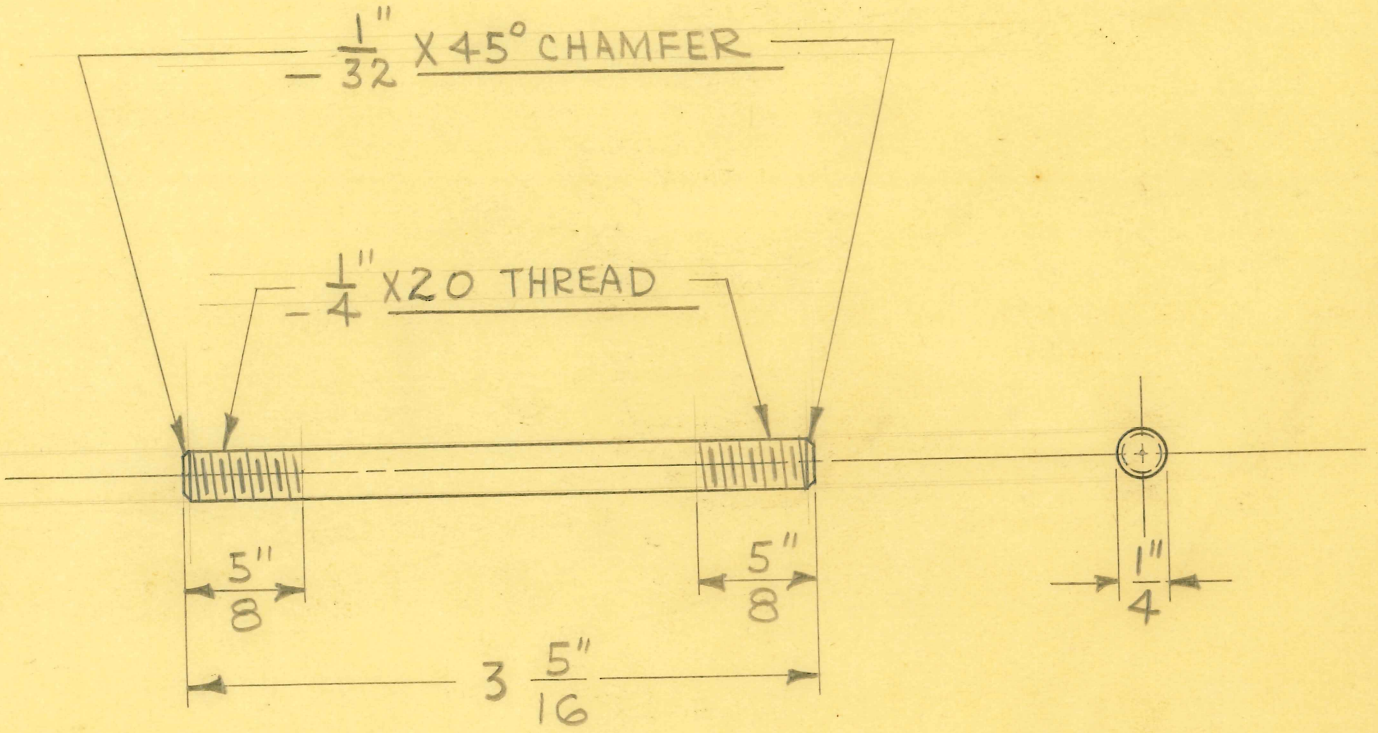

4 REQUIRED

DIMENSIONS	
FRACTIONAL	± .015
DECIMAL	± .005
ANGULAR	± 1/2°

UNLESS OTHERWISE SPECIFIED

SIZE	1/4" DIA.	ISSUE 6-22-48	J.V.W.
KIND	SCREW STOCK	CHANGED	
SHAPE		"	
FINISH		"	
TEMP.		"	
PATT.		"	

TITLE: FISCHER TABLE MOD. "200" DIATHERMY (FOREIGN) FIL. TRANSF. STUD

H. G. FISCHER & CO.
2335 WABANSIA AVE.
CHICAGO, ILL.

CAT. NO.

PART NO. 17082

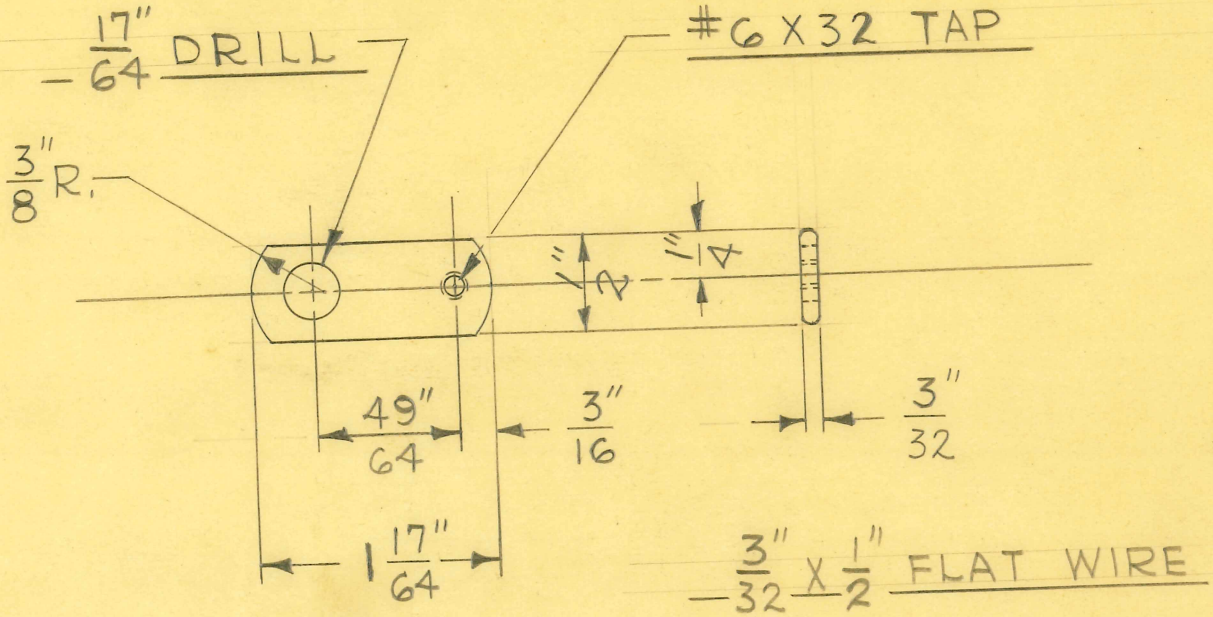

3/32 X 1/2 FLAT WIRE

BLANK

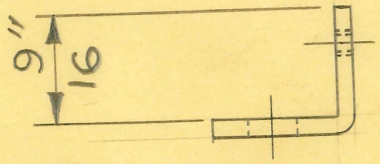

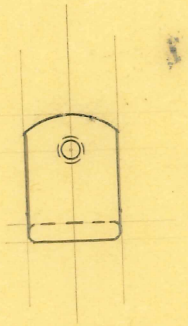

4 REQUIRED

DRILL JIG TOOL #9843 0-3
CUT-OFF DIE TOOL #708 F-4
BENDING DIE TOOL #4662

DIMENSIONS	
FRACTIONAL	± .015
DECIMAL	± .005
ANGULAR	± 1/2°

UNLESS OTHERWISE SPECIFIED

3/32 x 1/2 FLAT WIRE

SIZE		ISSUE 6-21-48	J.V.W.
KIND		CHANGED	
SHAPE		"	
FINISH		"	
TEMP.		"	
PATT.		"	

TITLE: FISCHER TABLE MOD. "200" DIATHERMY (FOREIGN) TERM. BD. BRACKET

H. G. FISCHER & CO.
2335 WABANSIA AVE.
CHICAGO, ILL.

CAT. NO.

PART NO. 17083

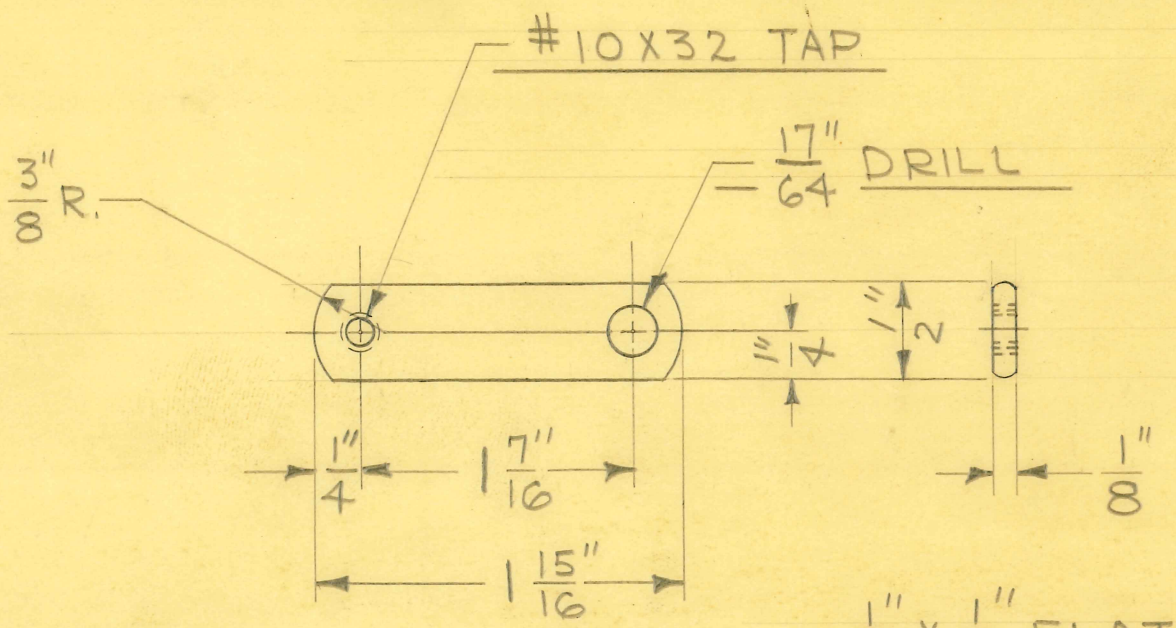

1/8" X 1/2" FLAT WIRE

BLANK

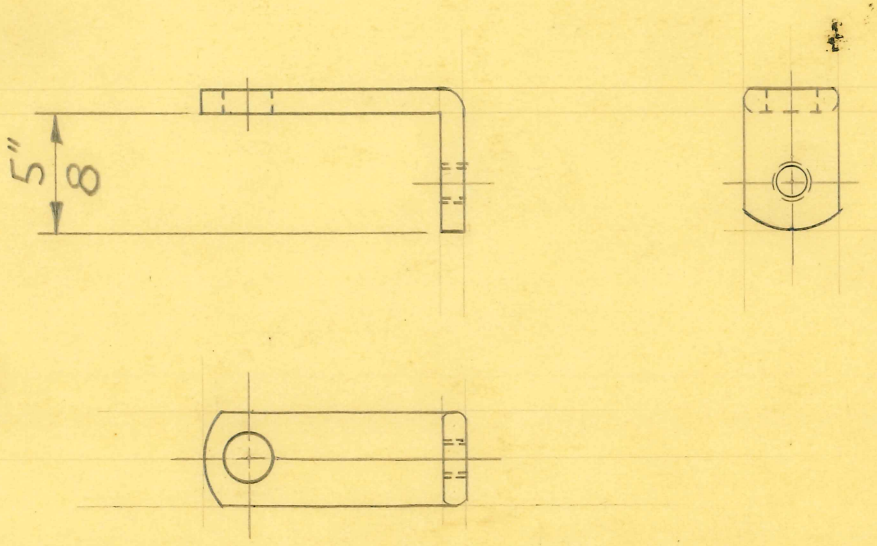

4 REQUIRED

DRILL JIG TOOL #9844 0-3
CUT-OFF DIE TOOL #708 F-4
BENDING DIE TOOL #4662

DIMENSIONS	
FRACTIONAL	± .015
DECIMAL	± .005
ANGULAR	± 1/2°

UNLESS OTHERWISE SPECIFIED

SIZE	1/8" X 1/2"	ISSUE 6-22-48	J.V.W.
KIND	FLAT WIRE	CHANGED	
SHAPE		"	
FINISH		"	
TEMP.		"	
PATT.		"	

TITLE: FISCHER TABLE MOD. "200" DIATHERMY (FOREIGN) FIL. TRANSF. SUPP. BRKT.

H. G. FISCHER & CO.
2335 WABANSIA AVE.
CHICAGO, ILL.

CAT. NO.

PART NO. 17084

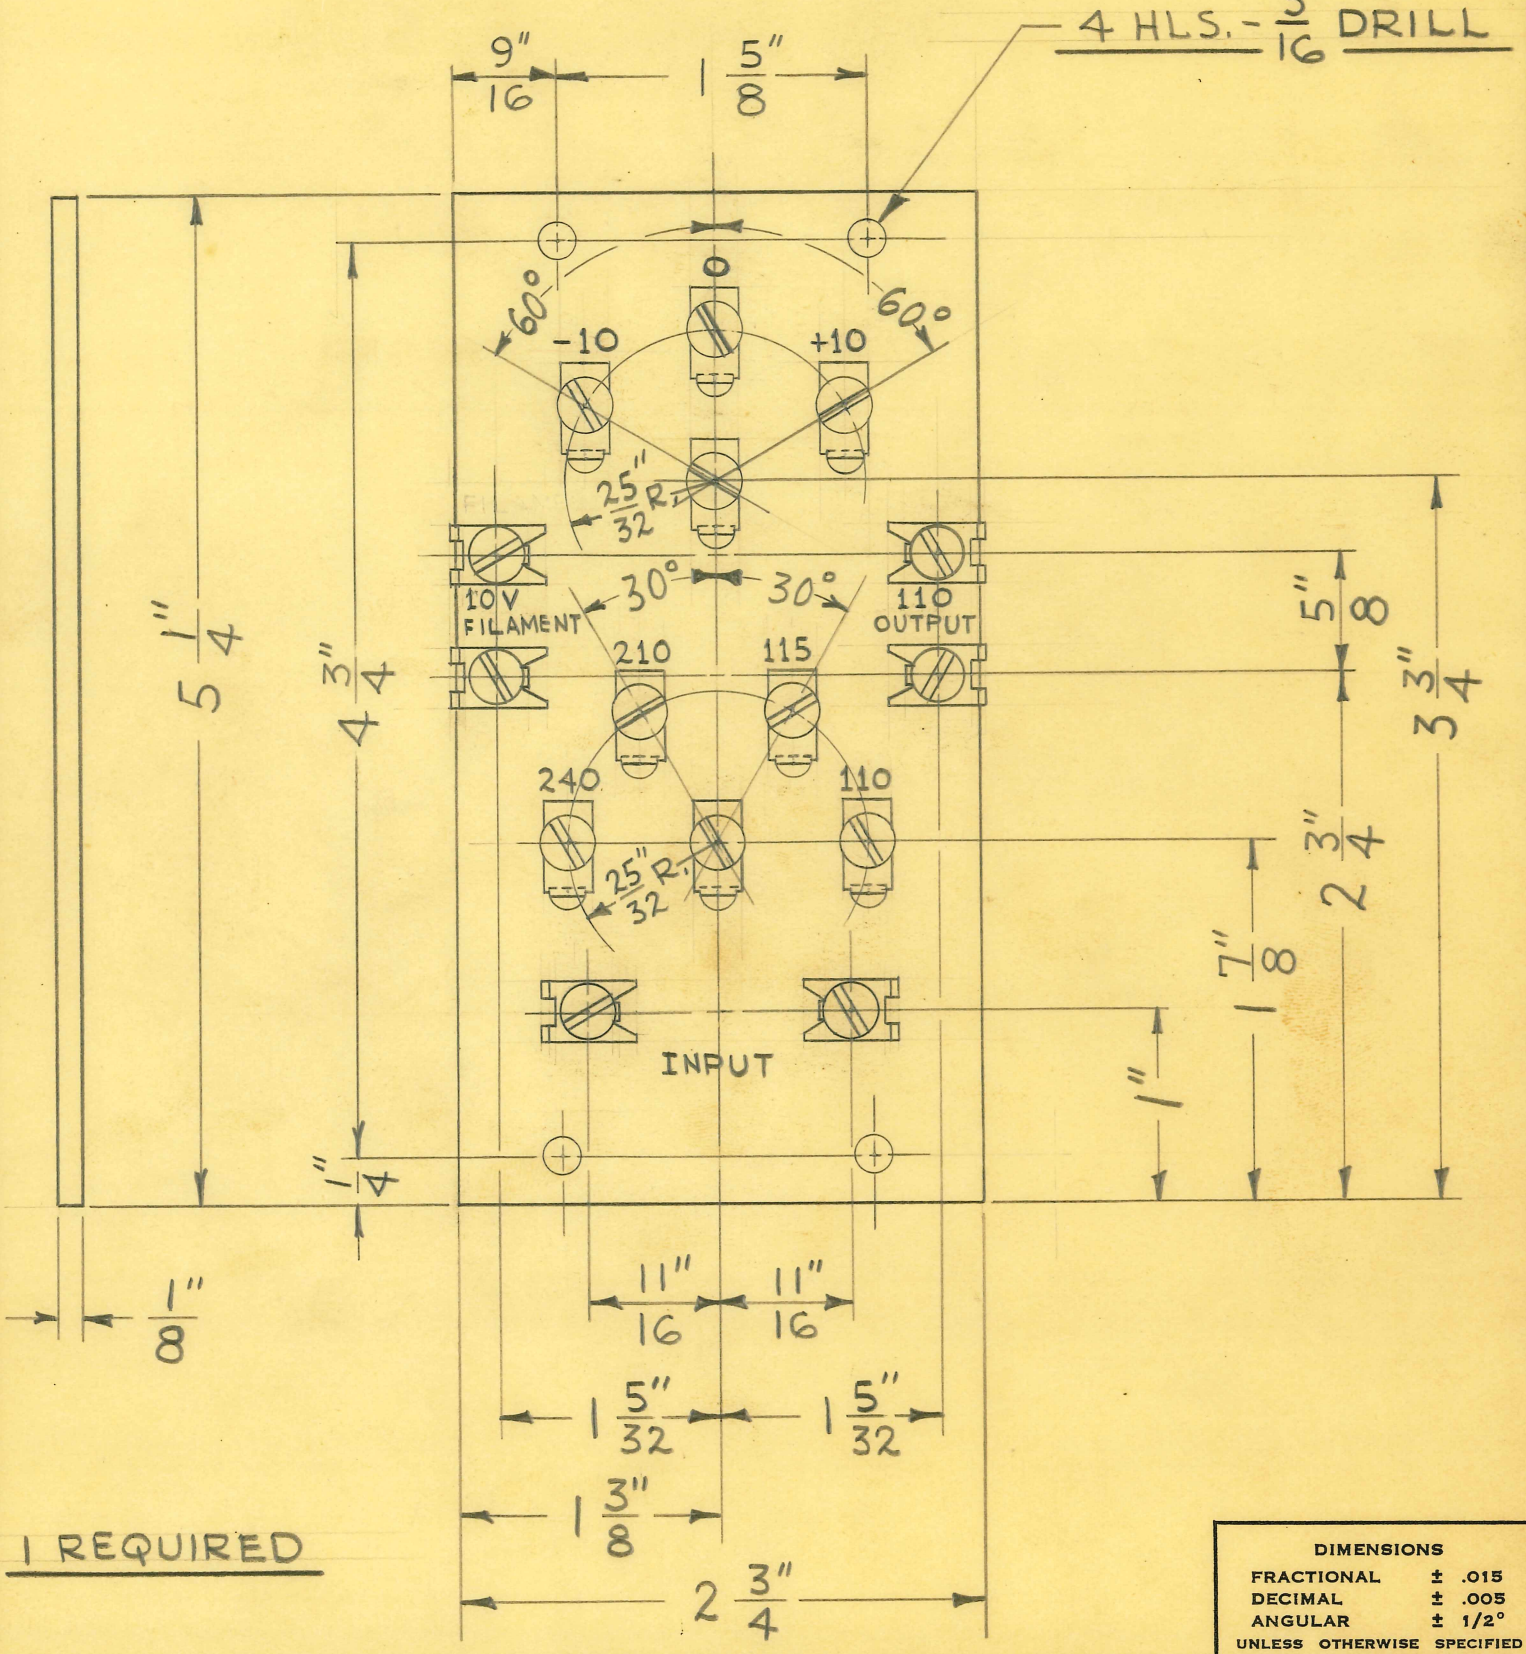

1 REQUIRED

DIMENSIONS	
FRACTIONAL	± .015
DECIMAL	± .005
ANGULAR	± 1/2°

UNLESS OTHERWISE SPECIFIED

SIZE		ISSUE 6-19-48	J.V.W.
KIND		CHANGED	
SHAPE		"	
FINISH		"	
TEMP.		"	
PATT.		"	

TITLE: FISCHER TABLE MOD. "200" DIATHERMY (FOREIGN) TERMINAL BOARD

H. G. FISCHER & CO.
2335 WABANSIA AVE.
CHICAGO, ILL.

CAT. NO.

PART NO. 17085

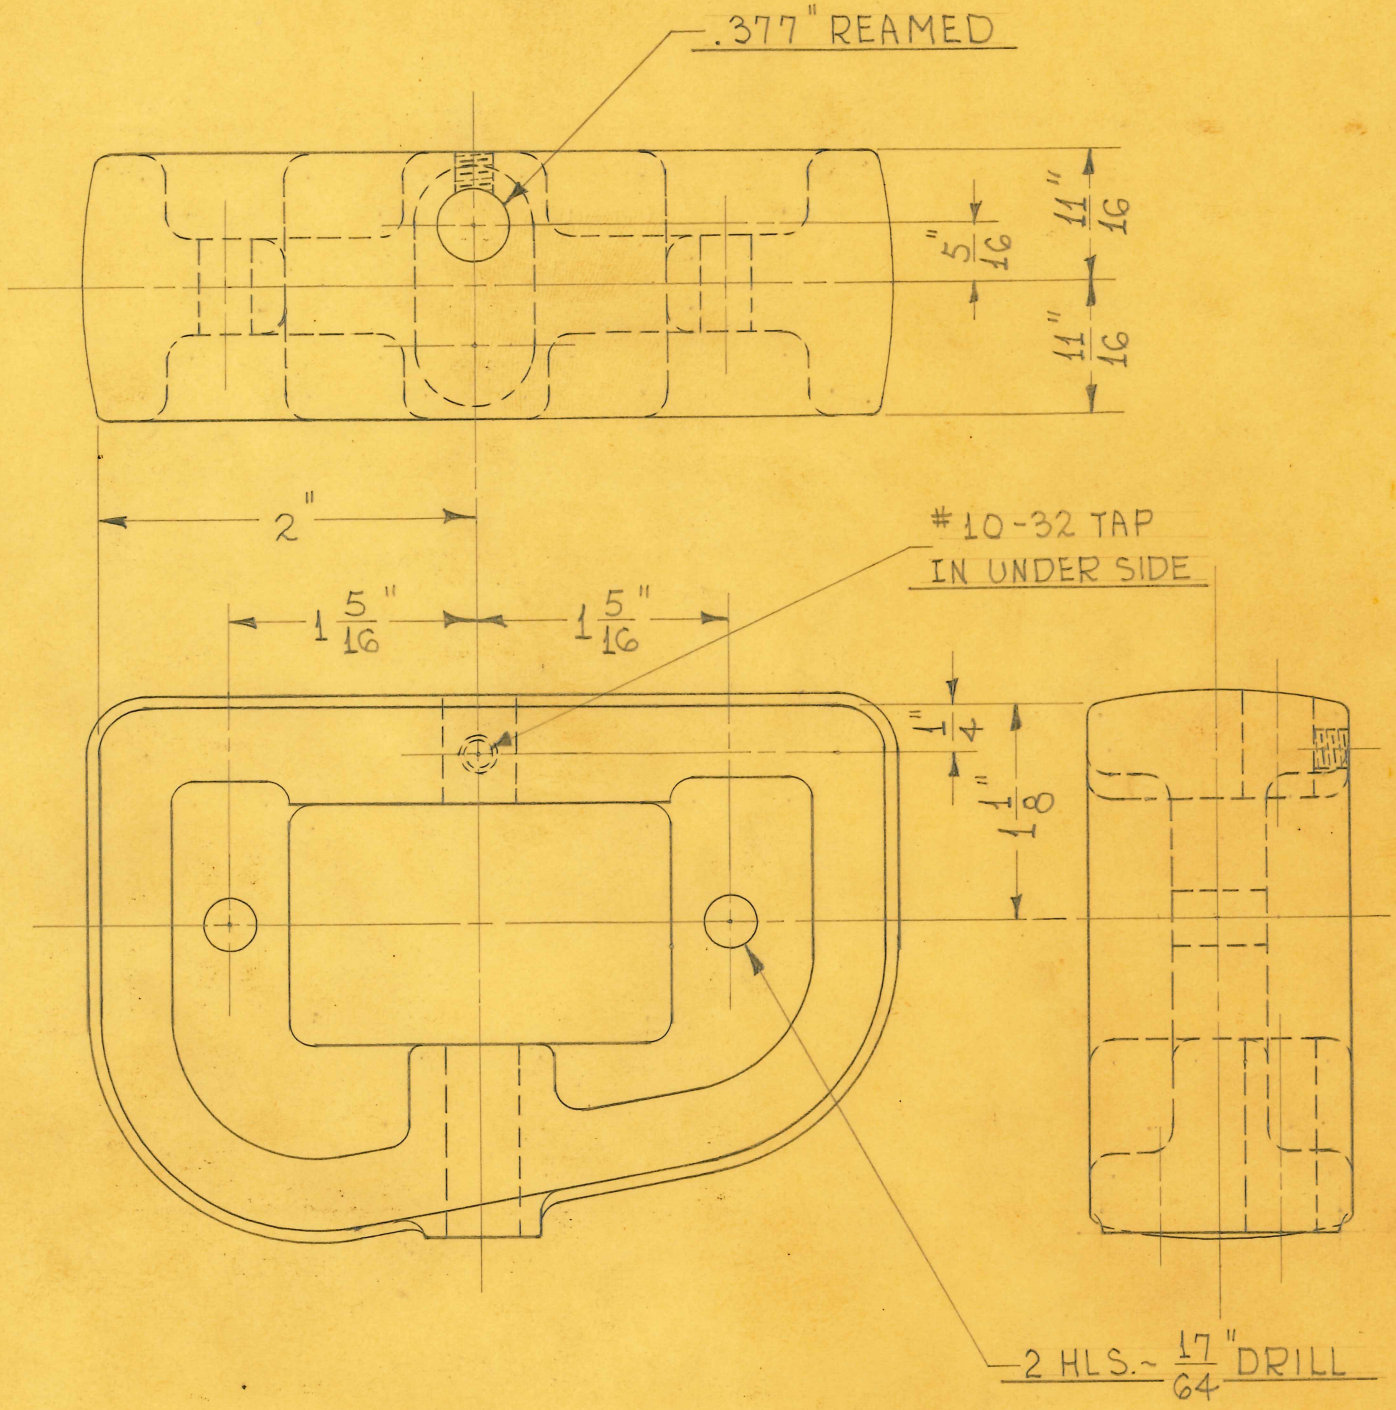

1 REQUIRED

OBSOLATE
4-22-80 JG

DRILL JIG #11043

SIZE		ISSUE 8-11-44	HE.
KIND	IRON CASTING	CHANGED	
SHAPE		"	
FINISH	PAINTED	"	
TEMP.		"	
PATT.	1540	"	

TITLE: FISCHER RAD. & FLUOR. TILT TABLE~ ROLLER BLOCK ~ FRONT (LEFT)

H. G. FISCHER & CO.
2335 WABANSIA AVE.
CHICAGO. ILL.

CAT. NO.

PART NO. 11797A

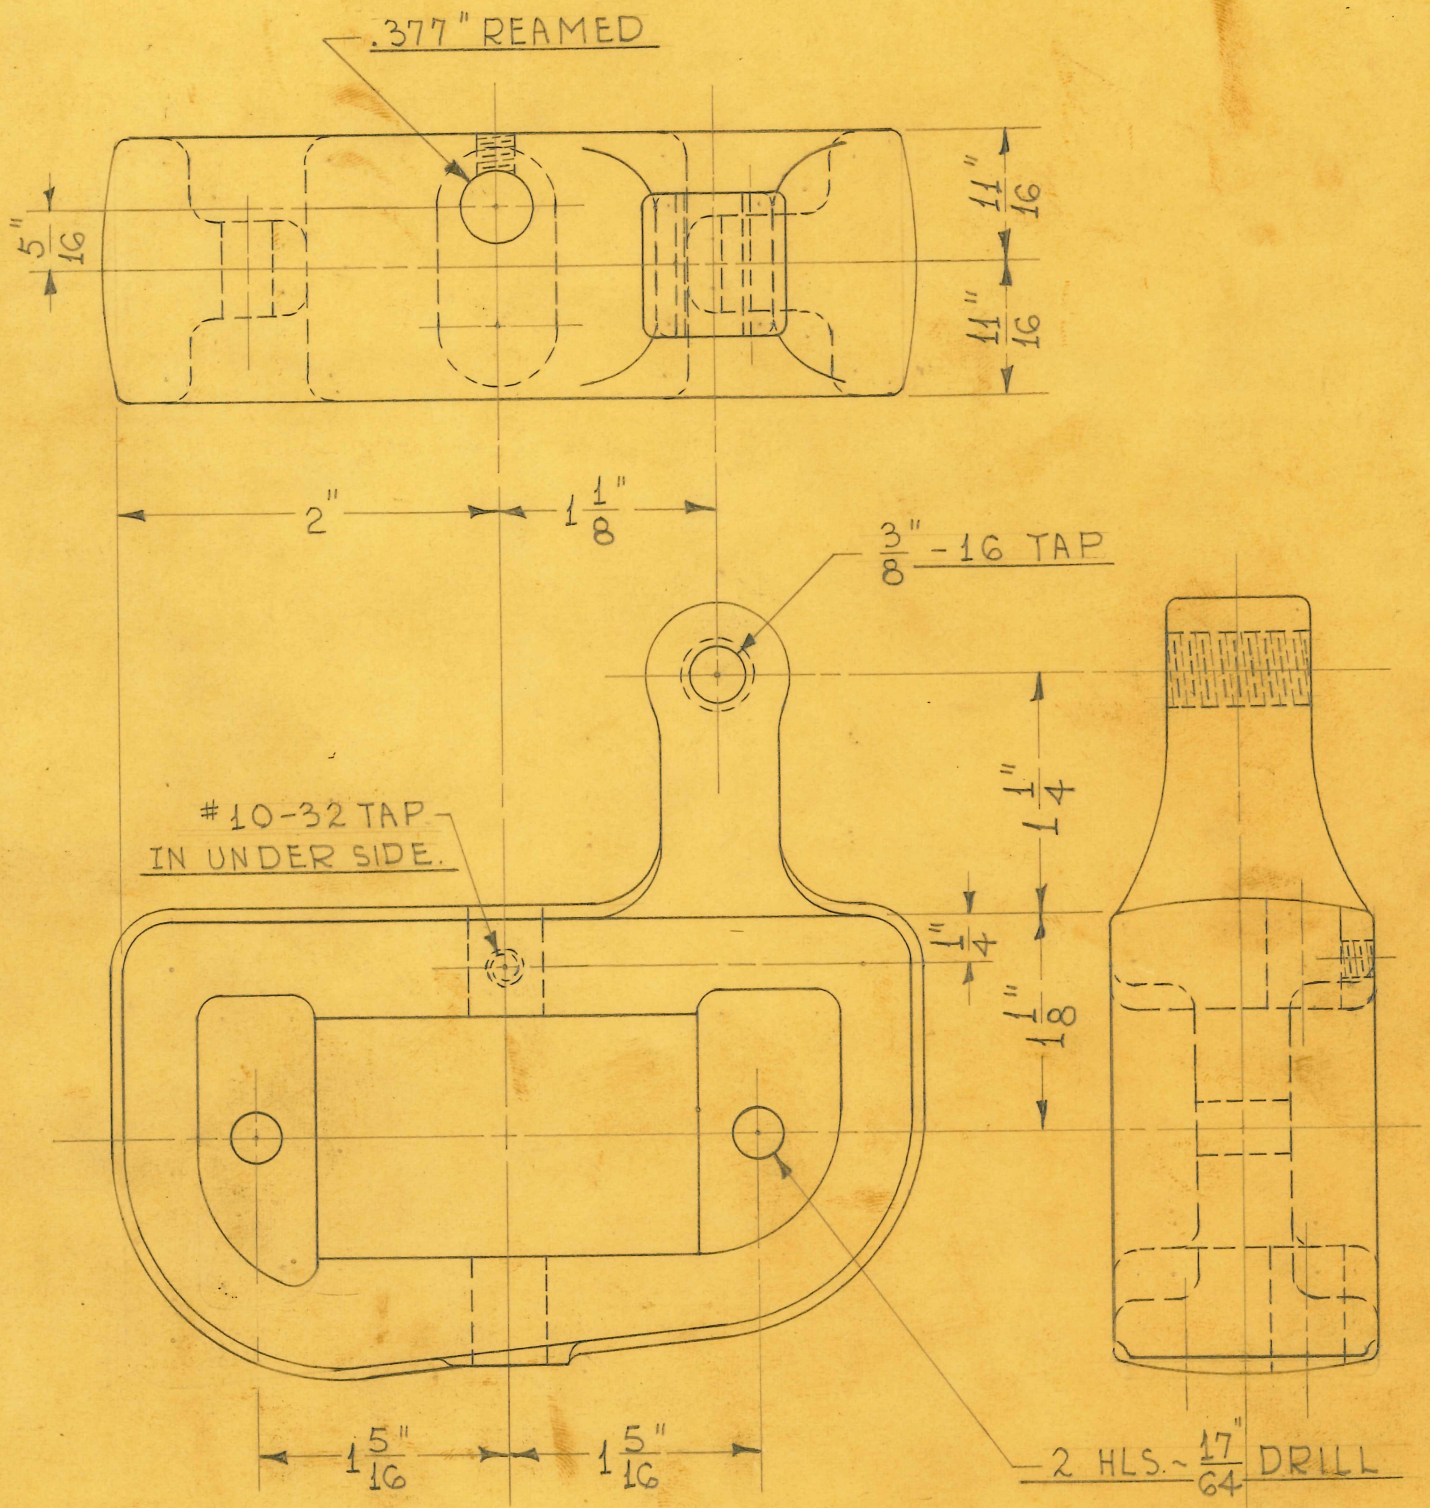

OBSOLATE
4-22-80 J.S.

1 REQUIRED

DRILL JIG # 11043

SIZE		ISSUE 8-10-44	HE.
KIND	IRON CASTING	CHANGED	
SHAPE		"	
FINISH	PAINTED	"	
TEMP.		"	
PATT.	1541	"	

TITLE: FISCHER RAD. & FLUOR. TILT TABLE ~ ROLLER BLOCK - REAR (RIGHT)

H. G. FISCHER & CO.
2338 WABANSIA AVE.
CHICAGO, ILL.

CAT. NO.

PART NO. 11798FA

OBSOLETE
4-22-80 J.S

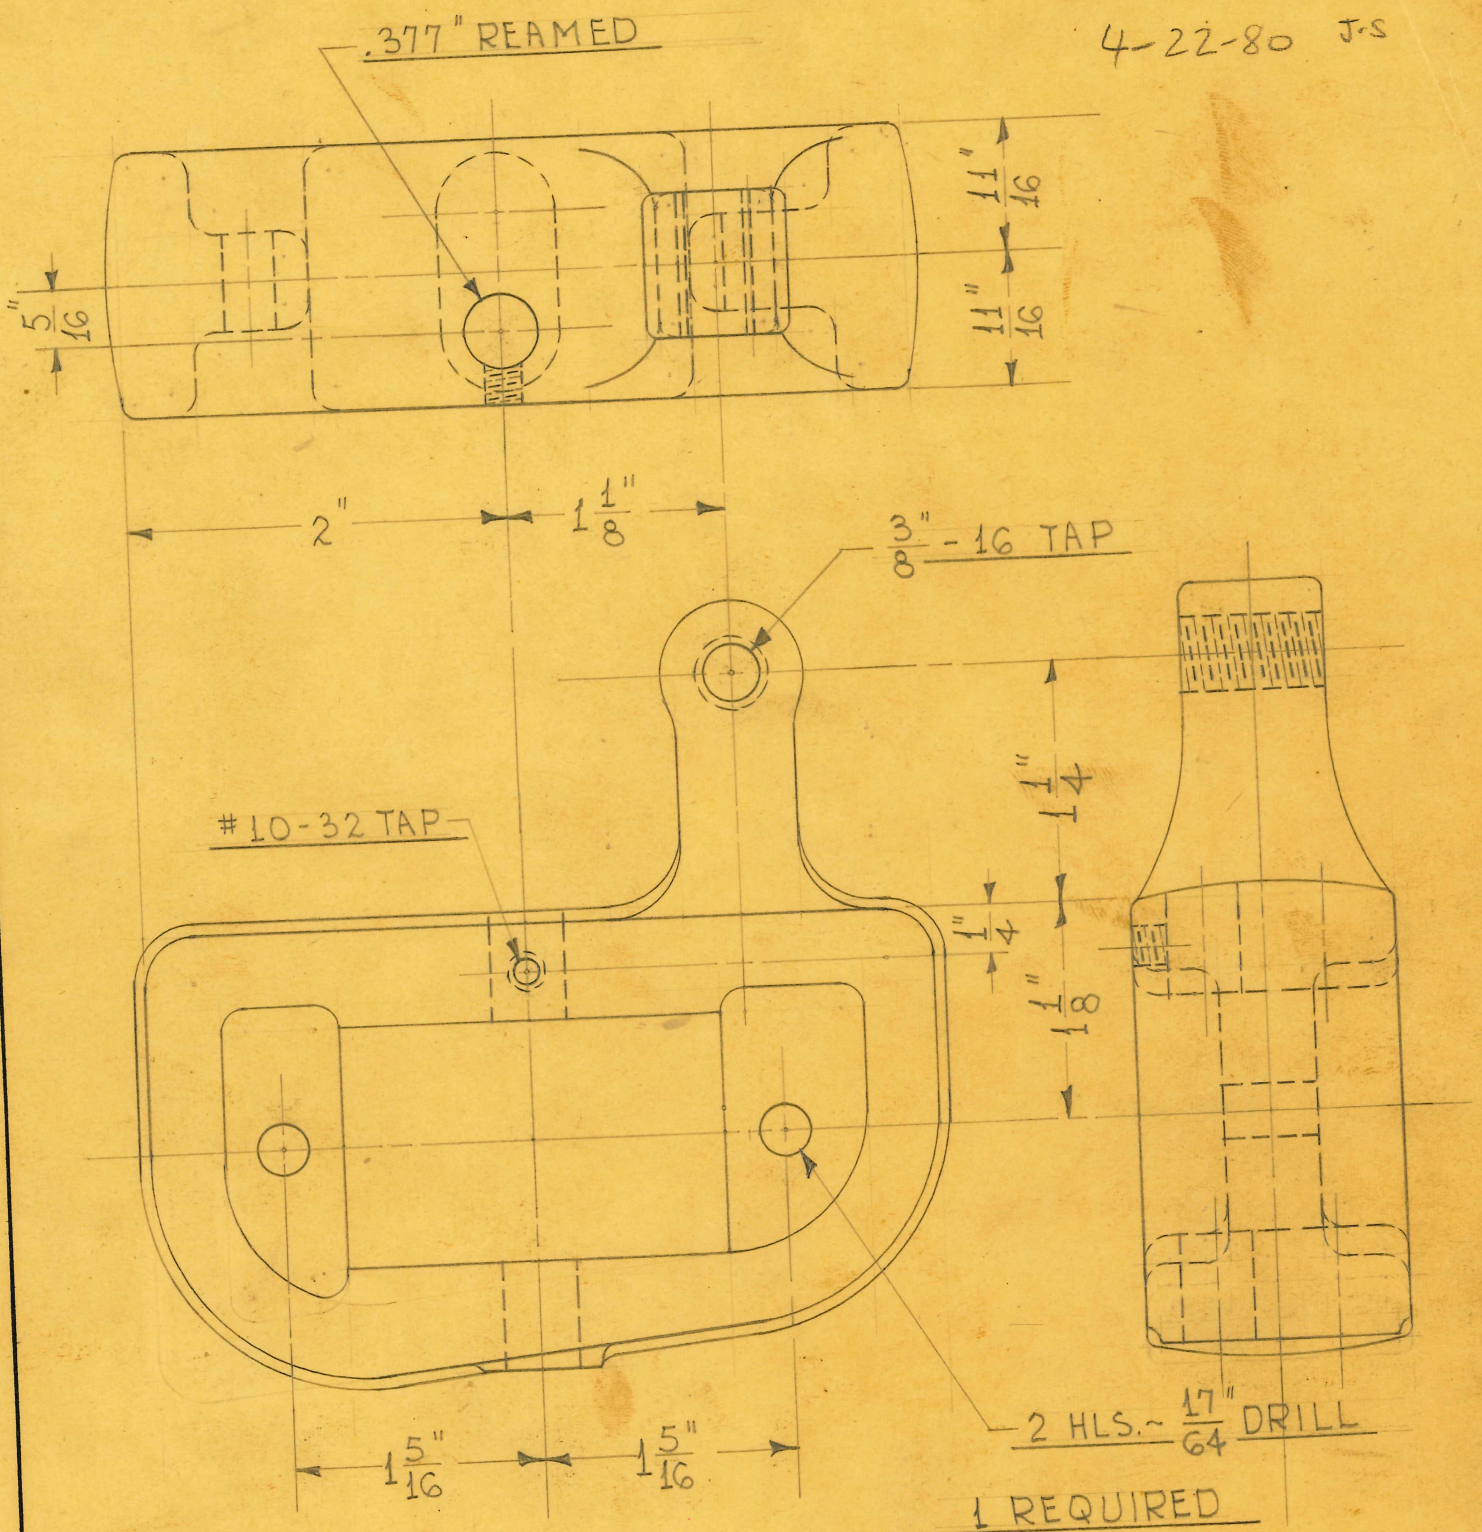

1 REQUIRED

DRILL JIG #7439

SIZE		ISSUE 8-10-44	HE
KIND	IRON CASTING	CHANGED	
SHAPE		"	
FINISH	PAINTED	"	
TEMP.		"	
PATT.	1541	"	

TITLE: FISCHER RAD. & FLUOR. TILT TABLE ~ ROLLER BLOCK - REAR (LEFT)

H. G. FISCHER & CO.
2335 WABANSIA AVE.
CHICAGO, ILL.

CAT. NO.

PART NO. 11799A

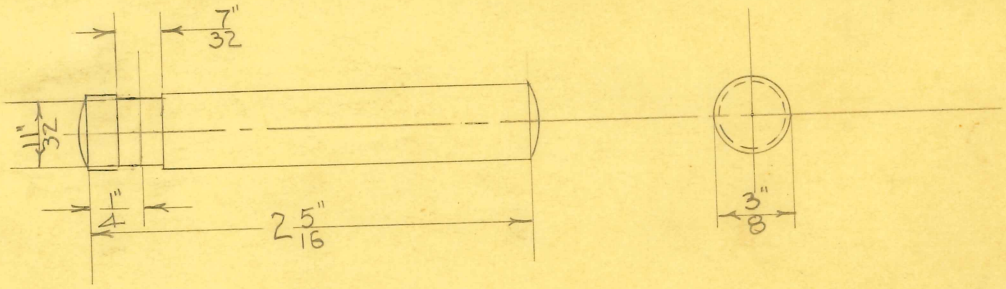

2-REQUIRED

OBSOLETE
4-22-80 J.S

SIZE	3/8 DIA.	ISSUE 6-5-40	C.E.A.
KIND	JEWELERS ROD	CHANGED	
SHAPE		"	
FINISH	CAD. #23	"	
TEMP.		"	
PATT.		"	

TITLE: FISCHER RAD. & FLUOR. TILT TABLE
ROLLER BLOCK - ROLLER SHAFT - FRONT

H. G. FISCHER & CO.
2335 WABANSIA AVE.
CHICAGO, ILL.

CAT. NO.

PART NO. 11813

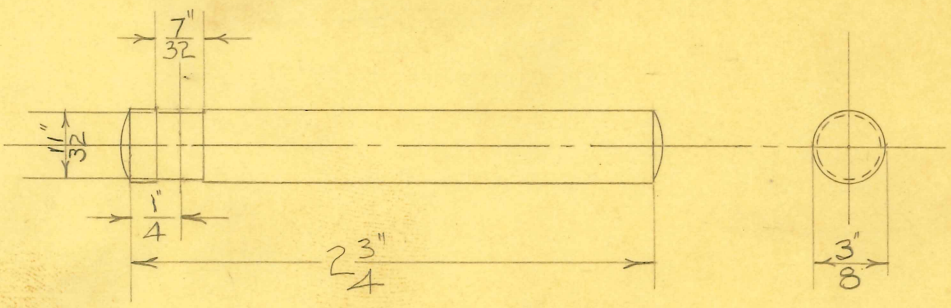

2-REQUIRED

OBSOLETE
4-22-80 J.S

SIZE	3/8" DIA.	ISSUE 6-5-40	C.E.A.
KIND	JEWELERS ROD	CHANGED	
SHAPE		"	
FINISH	CAD. #23	"	
TEMP.		"	
PATT.		"	

TITLE: FISCHER RAD. & FLUOR. TILT TABLE
ROLLER BLOCK ROLLER SHAFT-REAR

H. G. FISCHER & CO.
2335 WABANSIA AVE.
CHICAGO, ILL.

CAT. NO.

PART NO. 11814

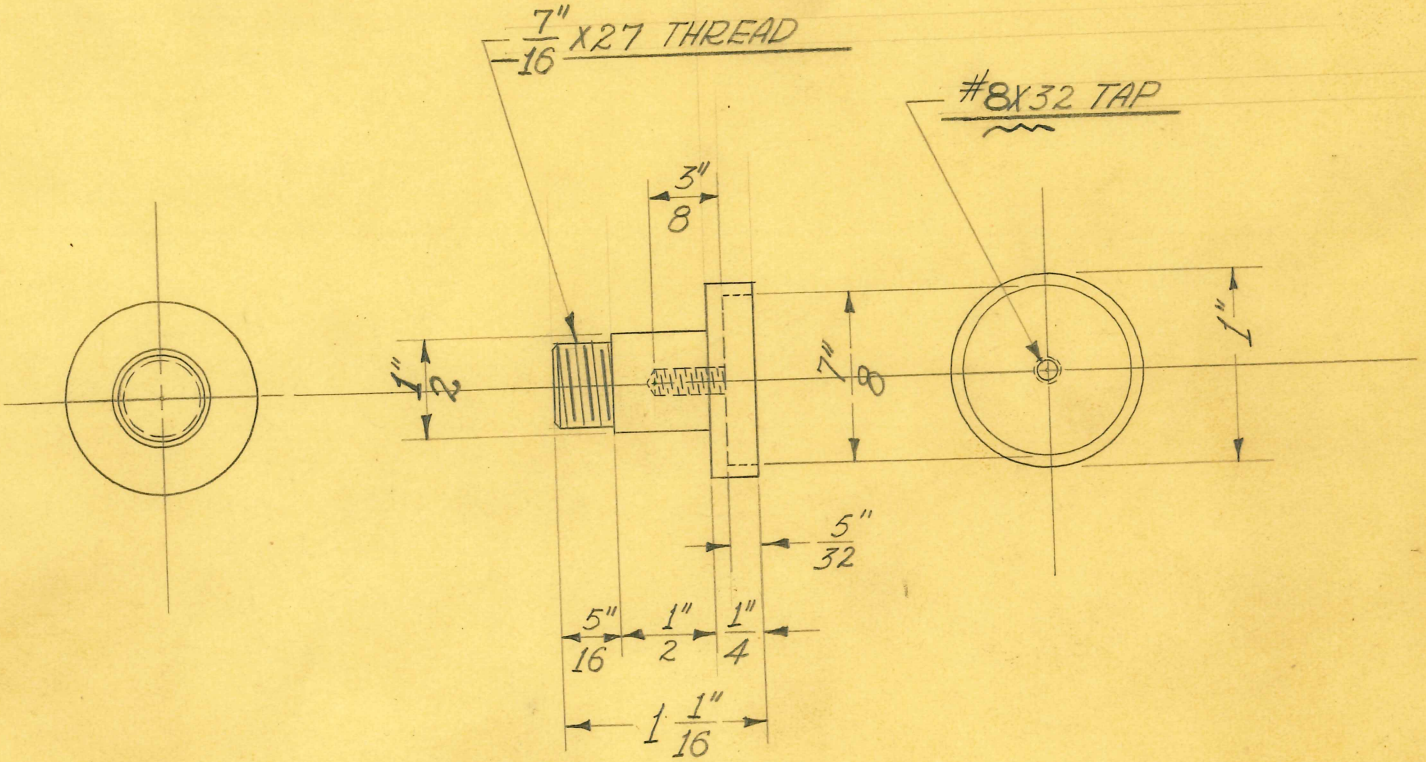

1 REQUIRED

OBSOLETE
4-22-80 J.S

Spec. 01-409

35682G			1
USED ON			QTY.
SIZE	1" DIAM.	ISSUE 11-4-38	J.W.
KIND	C.R.STL. ROD	CHANGED	RCT
SHAPE		WAS "#6x32	9/5/67
FINISH	CAD. 123	" " BRASS	
TEMP.		"	
PATT.		"	

TITLE: FISCHER RAD. & FLUOROSCOPIC TILT TABLE SIDE FRAME STOP-LOWER PLUNGER STOP PIECE

H. G. FISCHER & CO.
2335 WABANSIA AVE.
CHICAGO, ILL.

CAT. NO.

PART NO. 11831

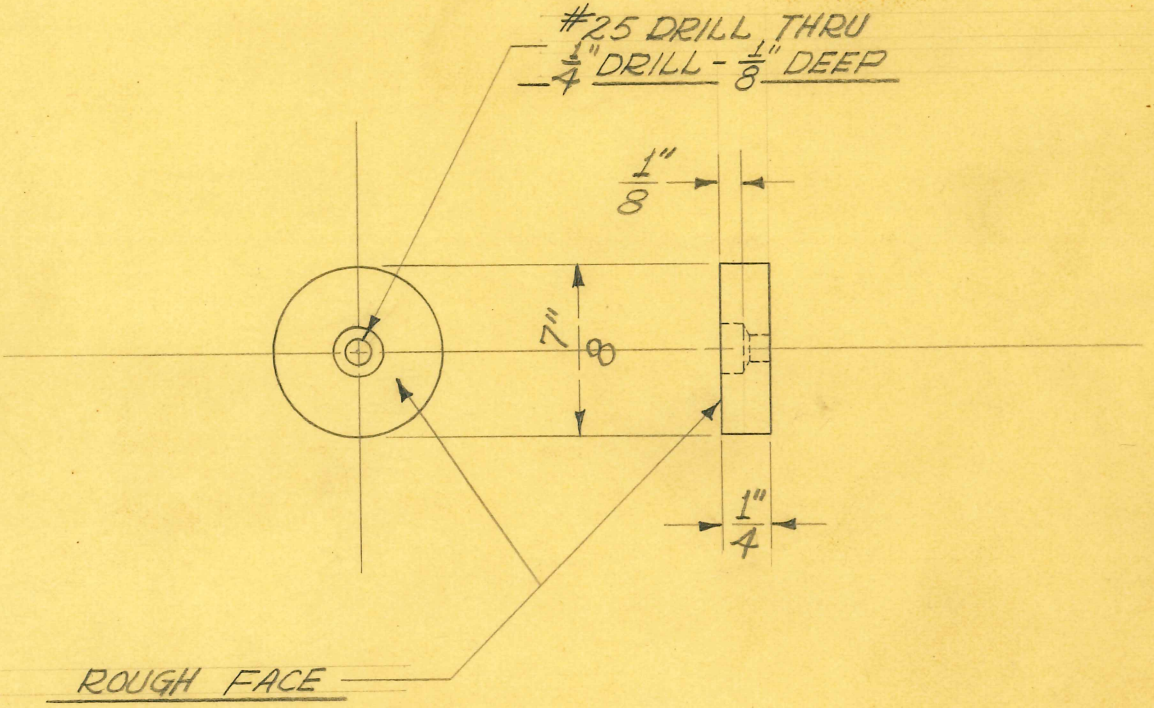

1 REQUIRED

OBSOLETE
4-22-80 J.S

SIZE	1/4" SHEET	ISSUE 11-4-38	J.W.
KIND	LEATHER	CHANGED	
SHAPE		"	
FINISH		"	
TEMP.		"	
PATT.		"	

TITLE:
FISCHER RAD. & FLUOROSCOPIC TILT TABLE
SIDE FRAME STOP-LOWER PLUNGER STOP PIECE PAD

H. G. FISCHER & CO.
2335 WABANSIA AVE.
CHICAGO, ILL.

CAT. NO.

PART NO. 11832

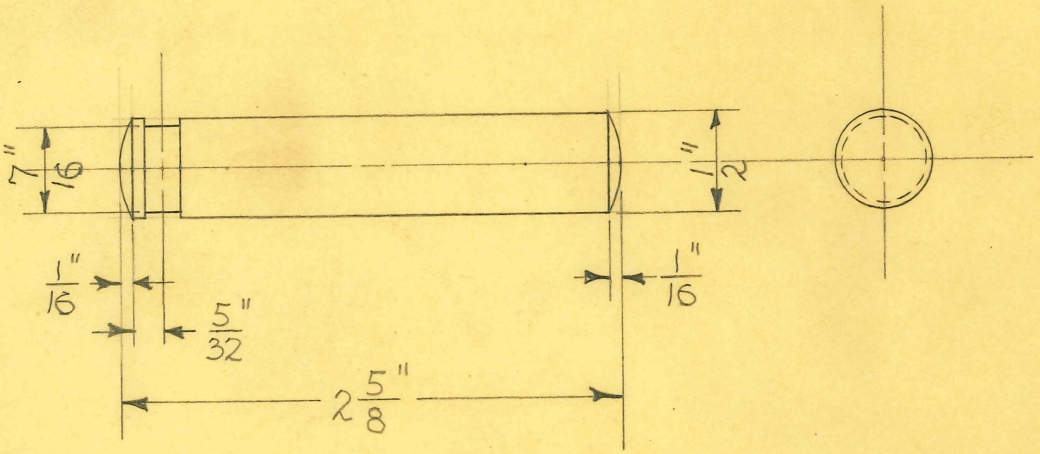

2 REQUIRED

OBSOLETE
4-22-80 - JS.

SIZE	1/2" DIAM.	ISSUE 2-16-40	HE.
KIND	C.R. STEEL	CHANGED	
SHAPE		"	
FINISH	CAD. #23	"	
TEMP.		"	
PATT.		"	

TITLE: FISCHER RAD. & FLUOROSCOPIC TILT TABLE - SIDE FRAME ROLLER SHAFT - FRONT

H. G. FISCHER & CO.
2335 WABANSIA AVE.
CHICAGO, ILL.

CAT. NO.

PART NO. 11833

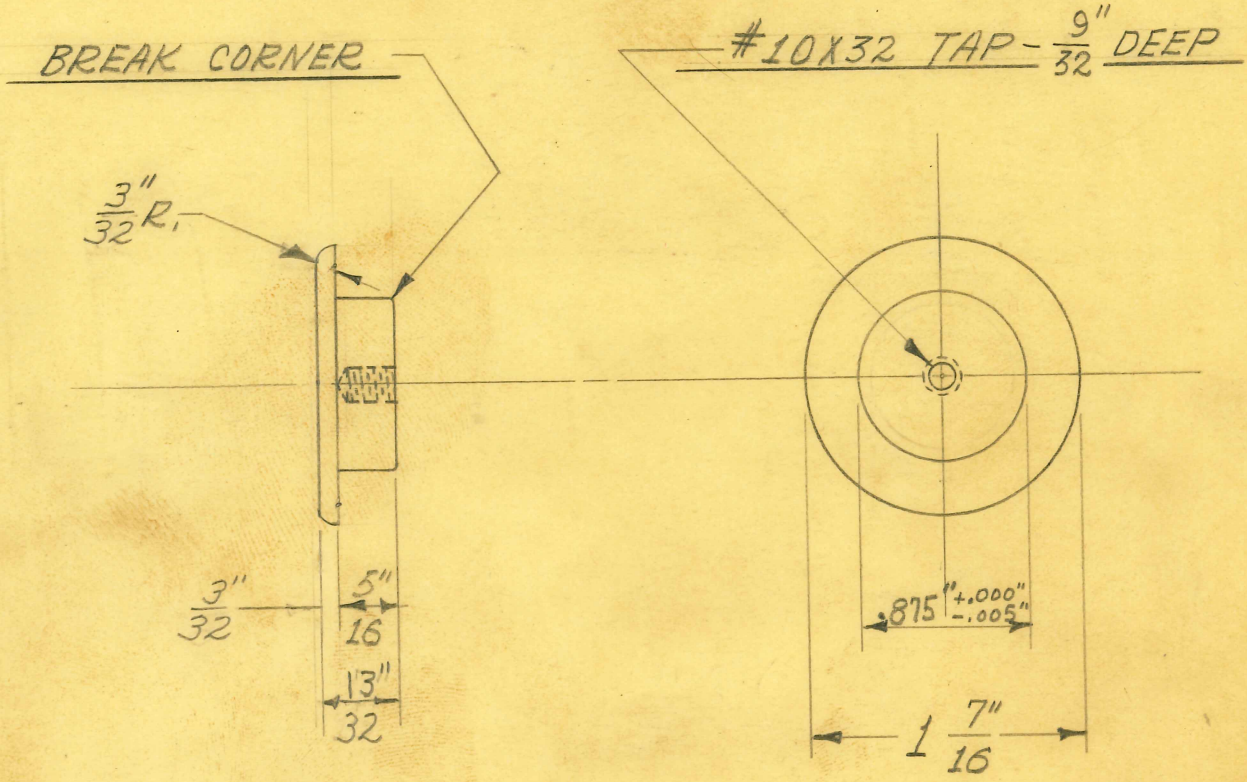

1 REQUIRED

OBSOLETE
4-22-80 J.S

SIZE	1 7/16" DIAM.	ISSUE 5-26-39	J.W.	TITLE: AXILIARY TABLE STAND FOR MOD. "G" X-RAY HEAD HORIZONTAL SLIDE TUBE CAP - FRONT
KIND	C.R. STEEL	CHANGED 8-14-47	J.M.F.	
SHAPE	ROD	"		
FINISH	CHR. #2 POLISH HEAD ONLY	"		
TEMP.		"		
PATT.		"		

H. G. FISCHER & CO.
2335 WABANSIA AVE.
CHICAGO, ILL.

CAT. NO.

PART NO. 11967

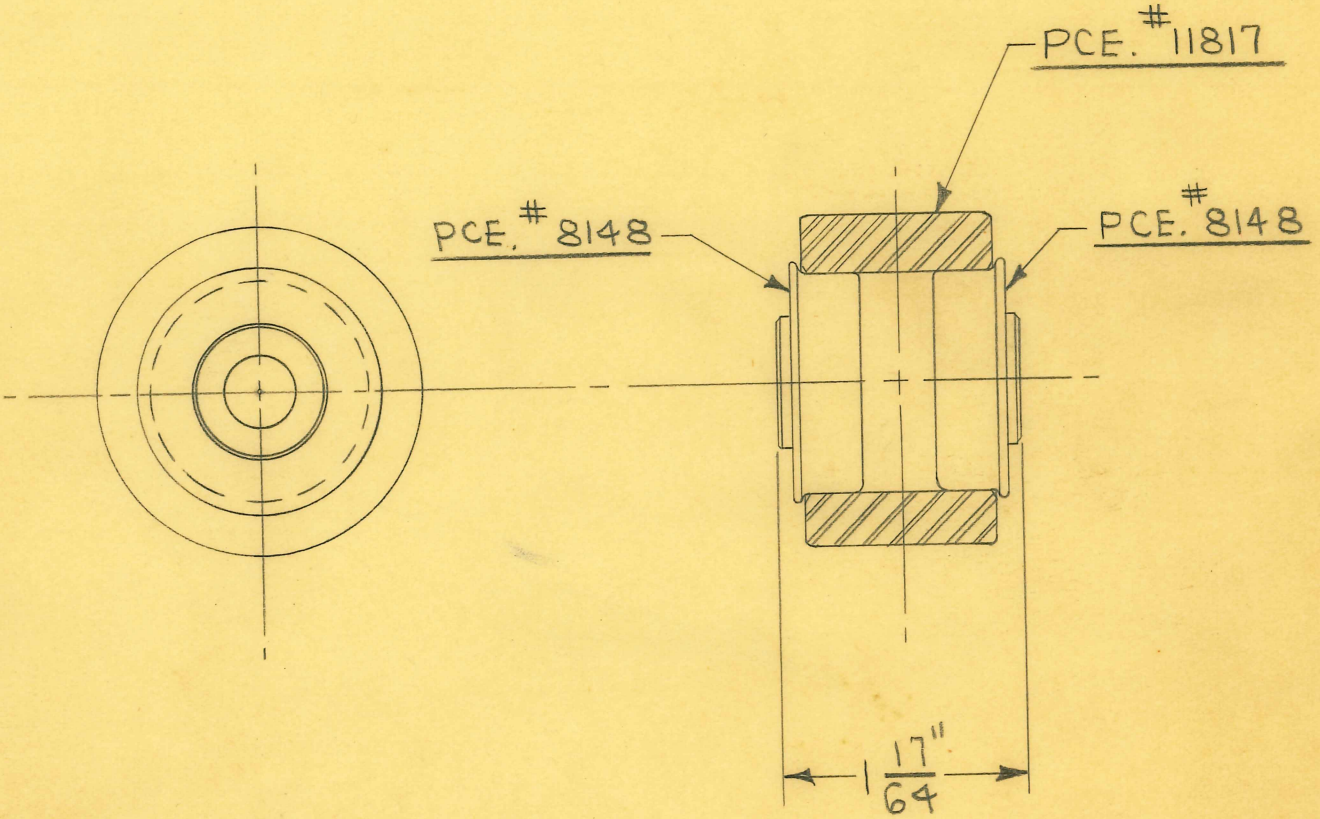

OBSOLETE
4-22-80 J.S.

2 REQUIRED

DIMENSIONS	
FRACTIONAL	± .015
DECIMAL	± .005
ANGULAR	± 1/2°

UNLESS OTHERWISE SPECIFIED

SIZE		ISSUE 3-11-48	W.J.
KIND		CHANGED	
SHAPE		"	
FINISH		"	
TEMP.		"	
PATT.		"	

TITLE: FISCHER RAD. & FLUOR. TILT TABLE ROLLER - PLAIN - ASSEMBLY

H. G. FISCHER & CO.
2335 WABANSIA AVE.
CHICAGO, ILL.

CAT. NO.

PART NO. 11794G

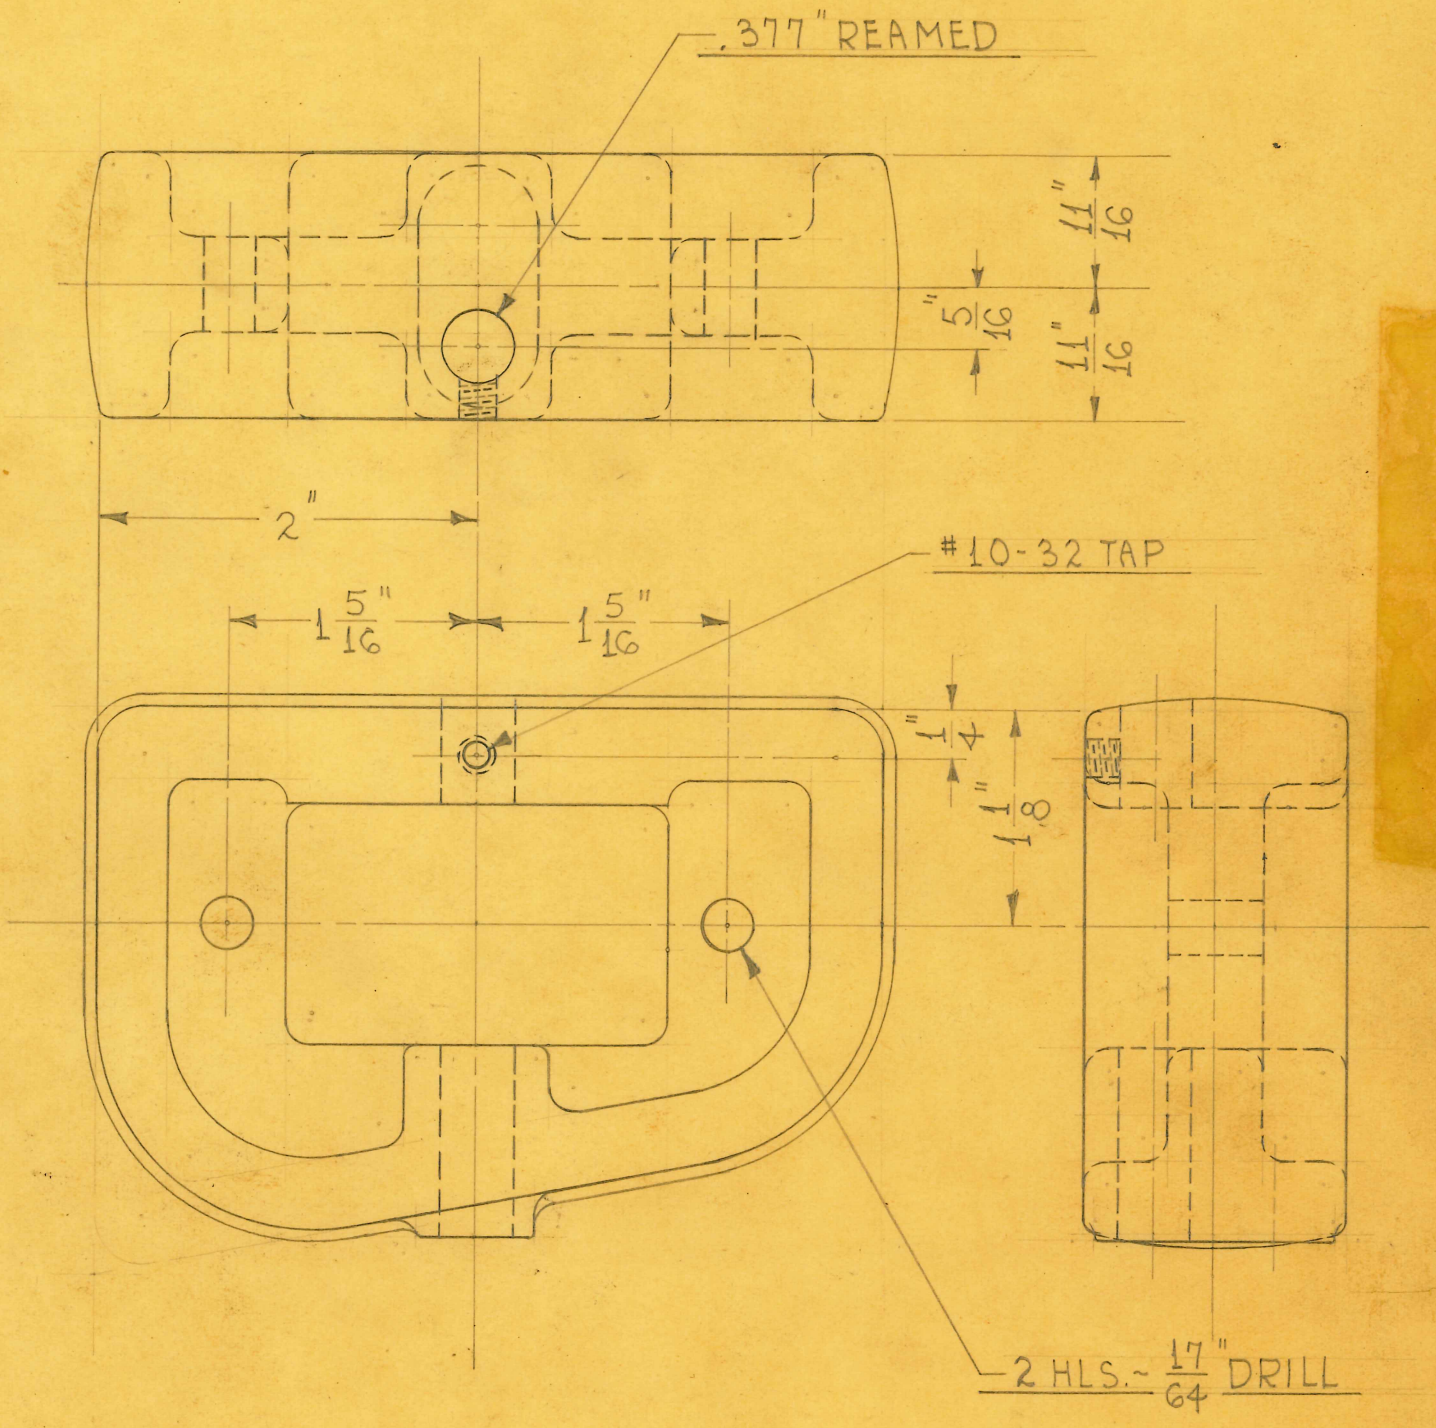

1 REQUIRED

OBSOLETE
4-22-80 J.S.

DRILL JIG #7439

SIZE		ISSUE 8-11-44	HE.
KIND	IRON CASTING	CHANGED	
SHAPE		"	
FINISH	PAINTED	"	
TEMP.		"	
PATT.	1540	"	

TITLE: FISCHER RAD. & FLUOR. TILT TABLE~ ROLLER BLOCK~FRONT (RIGHT)

H. G. FISCHER & CO.
2335 WABANSIA AVE.
CHICAGO, ILL.

CAT. NO.

PART NO. 1179GFA

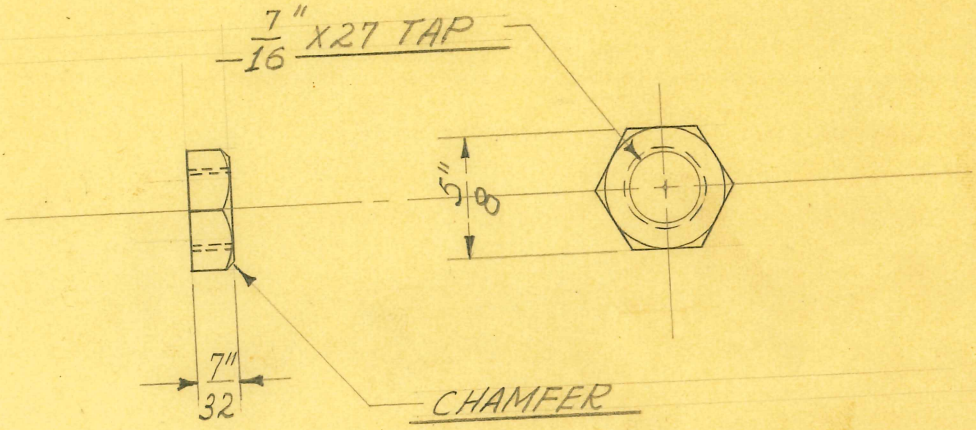

2 REQUIRED

OBSOLETE
4-22-80 J.S.

SIZE	5/8" HEX.	ISSUE 9-29-37	J.W.	TITLE: FISCHER MOD. "6-24-72" SHORT WAVE CONTACT BEARING SEAT-CLAMP NUT
KIND	BRASS ROD	CHANGED		
SHAPE		"		
FINISH	CAD. #23	"		
TEMP.		"		
PATT.		"		

H. G. FISCHER & CO.
2335 WABANSIA AVE.
CHICAGO, ILL.

CAT. NO.

PART NO. 11680

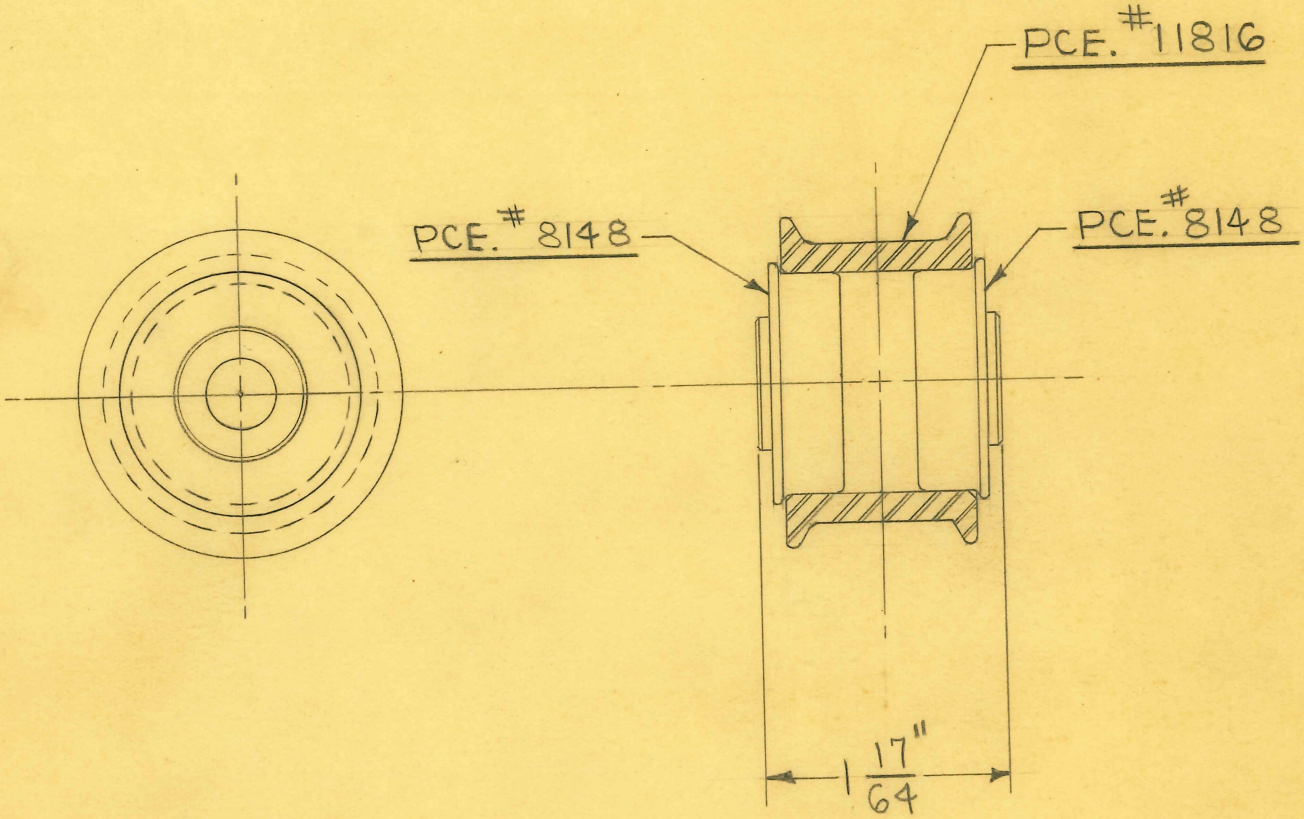

OBSOLETE
4-12-80 J.S.

2 REQUIRED

DIMENSIONS	
FRACTIONAL	± .015
DECIMAL	± .005
ANGULAR	± 1/2°

UNLESS OTHERWISE SPECIFIED

SIZE		ISSUE 3-11-48	W.J.
KIND		CHANGED	
SHAPE		"	
FINISH		"	
TEMP.		"	
PATT.		"	

TITLE: FISCHER RAD. & FLUOR. TILT TABLE ROLLER - GROOVED - ASSEMBLY

H. G. FISCHER & CO.
2335 WABANSIA AVE.
CHICAGO, ILL.

CAT. NO.

PART NO. 11793G

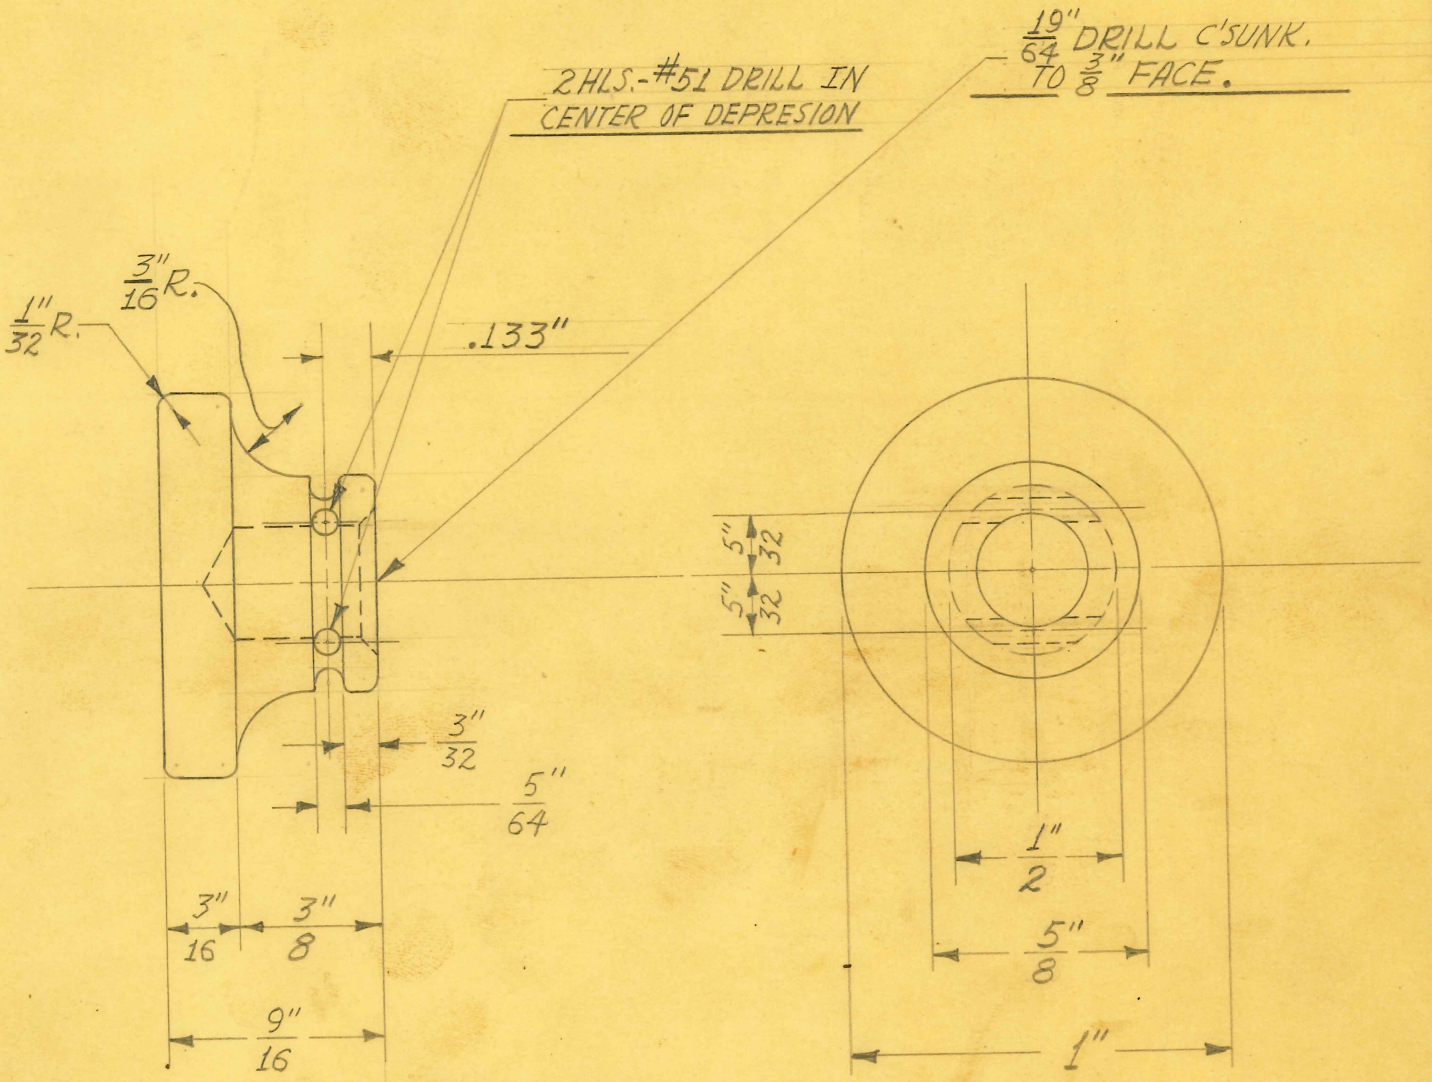

SCALE ~ DOUBLE SIZE

2 REQUIRED

OBSOLETE
4-22-80

SIZE	1" DIAM.	ISSUE 12-12-40	J.V.W.
KIND	C.R. STEEL	CHANGED	
SHAPE		"	
FINISH	DULITE #8	"	
TEMP.		"	
PATT.		"	

TITLE: FISCHER MOD "GF" S.P. FLUOROSCOPE CASTER BLOCK - STOP SCREW PAD

H. G. FISCHER & CO.
2338 WABANSIA AVE.
CHICAGO, ILL.

CAT. NO.

PART NO. 11216A

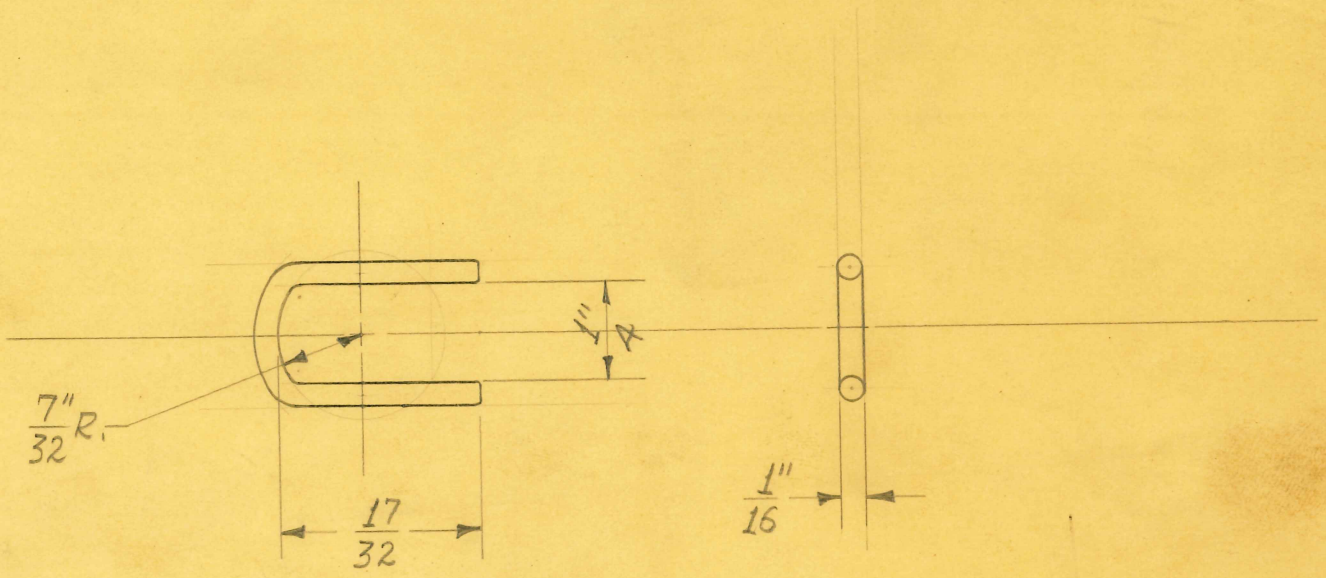

SCALE ~ DOUBLE SIZE

2 REQUIRED

OBSOLETE
4-22-80 JS

DEVELOPED LENGTH = 1 1/2"

SIZE	1/16" DIA.	ISSUE 12-12-40	J.V.W.
KIND	BESSEMER	CHANGED	
SHAPE	ROD	"	
FINISH	DULITE #8	"	
TEMP.		"	
PATT.		"	

TITLE: FISCHER MOD. "GF" S.P. FLUOROSCOPE
CASTER BLOCK STOP SCREW CLAMP WIRE

H. G. FISCHER & CO.
2335 WABANSIA AVE.
CHICAGO, ILL.

CAT. NO.

PART NO. 11217A

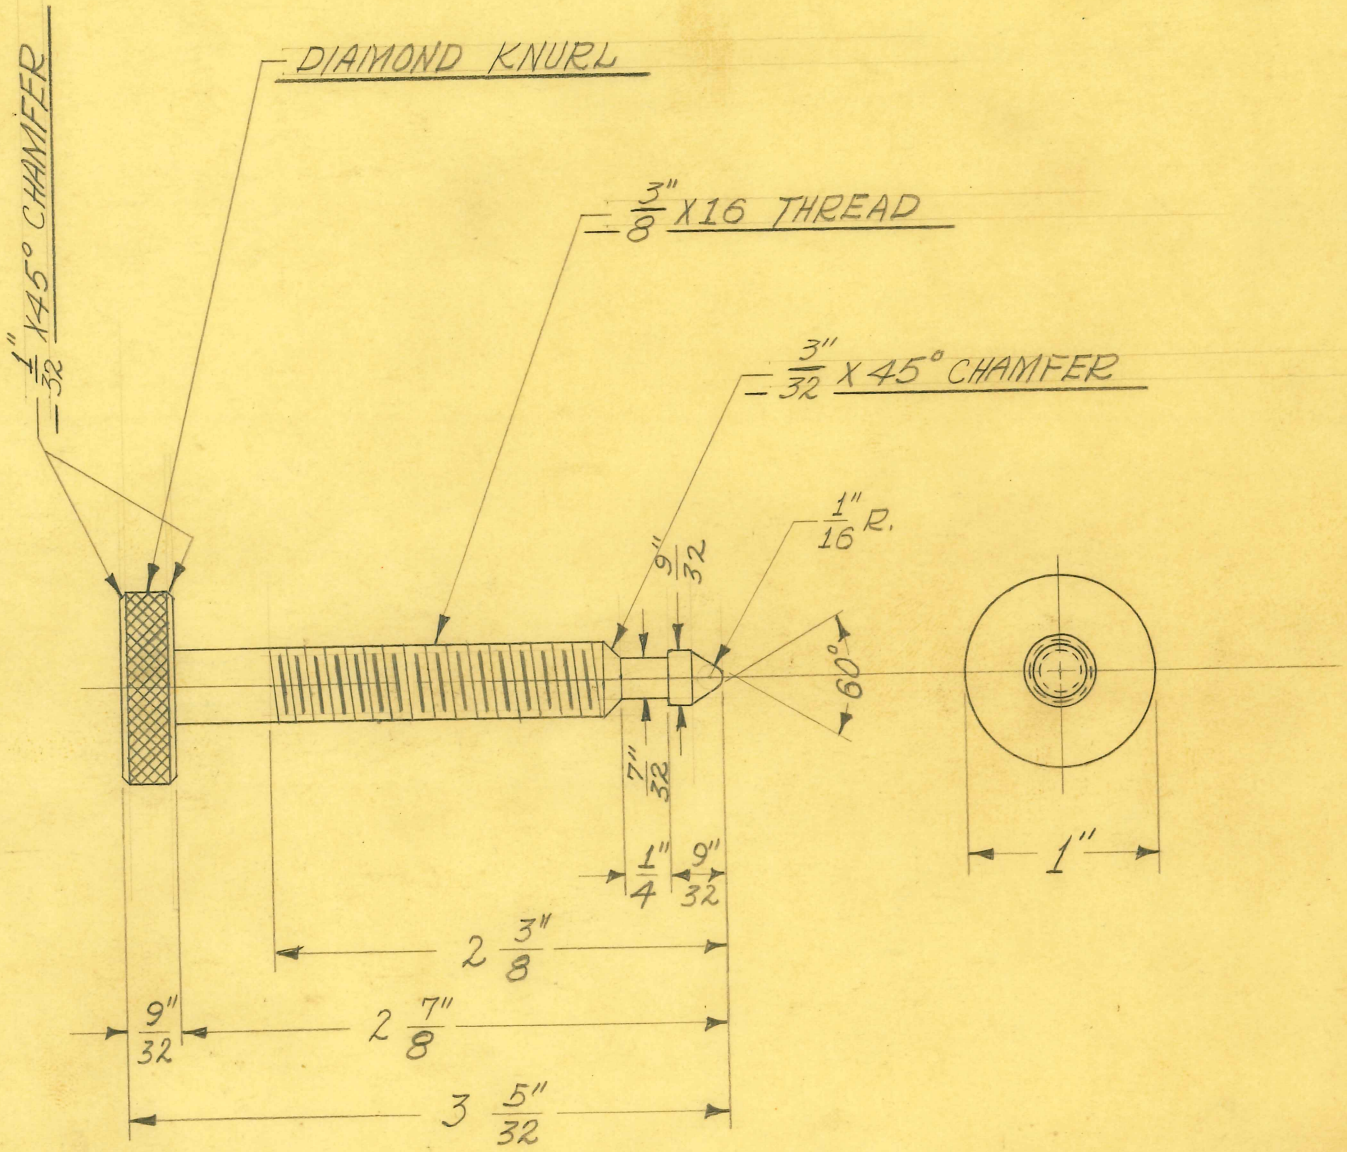

2 REQUIRED

OBSOLETE
4-22-80 J.S

SIZE	1" DIAM.	ISSUE 4-2-40	J.W.
KIND	C.R. STEEL	CHANGED	
SHAPE		"	
FINISH	CAD. #23	"	
TEMP.		"	
PATT.		"	

TITLE: FISCHER MOD. "GF" S.P. FLUOROSCOPE CASTER BLOCK STOP SCREW

H. G. FISCHER & CO.
2335 WABANSIA AVE.
CHICAGO, ILL.

CAT. NO.

PART NO. 11223

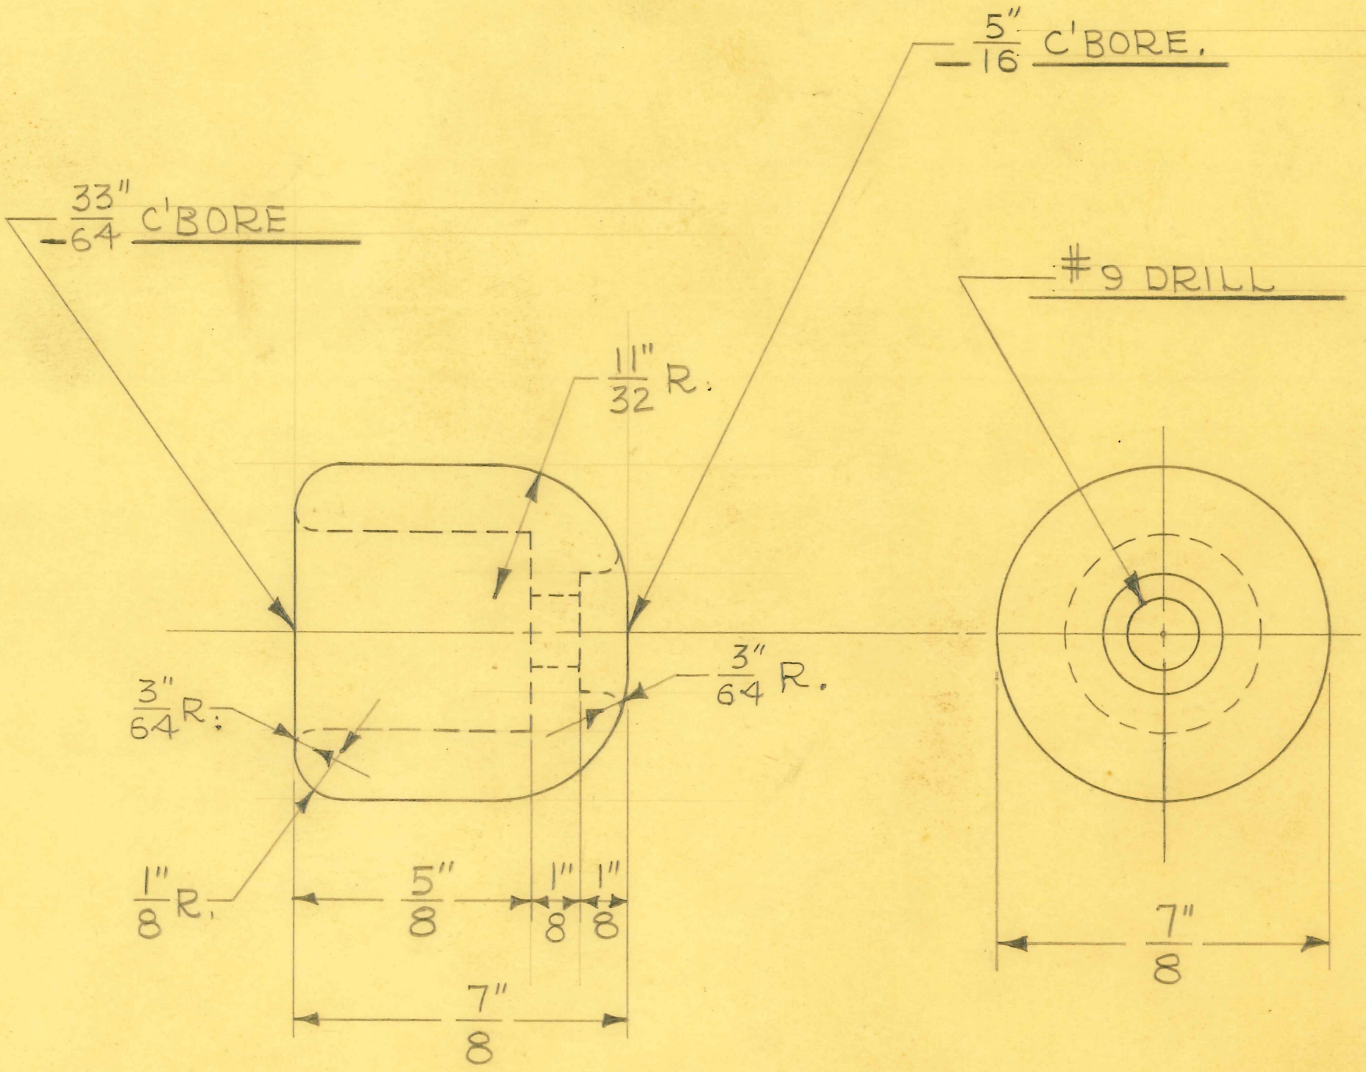

SCALE ÷ DOUBLE SIZE

OBSOLETE
4-22-80 J.S

1 REQUIRED

SIZE	7/8" DIAM.	ISSUE 8-11-42	J.V.W.
KIND	BRASS ROD	CHANGED	
SHAPE		"	
FINISH		"	
TEMP.		"	
PATT.		"	

TITLE: FISCHER MOD. "G" SHOCKPROOF FLUOROSCOPE X-RAY TUBE RADIATOR

H. G. FISCHER & CO.
2335 WABANSIA AVE.
CHICAGO, ILL.

CAT. NO.

PART NO. 11224A

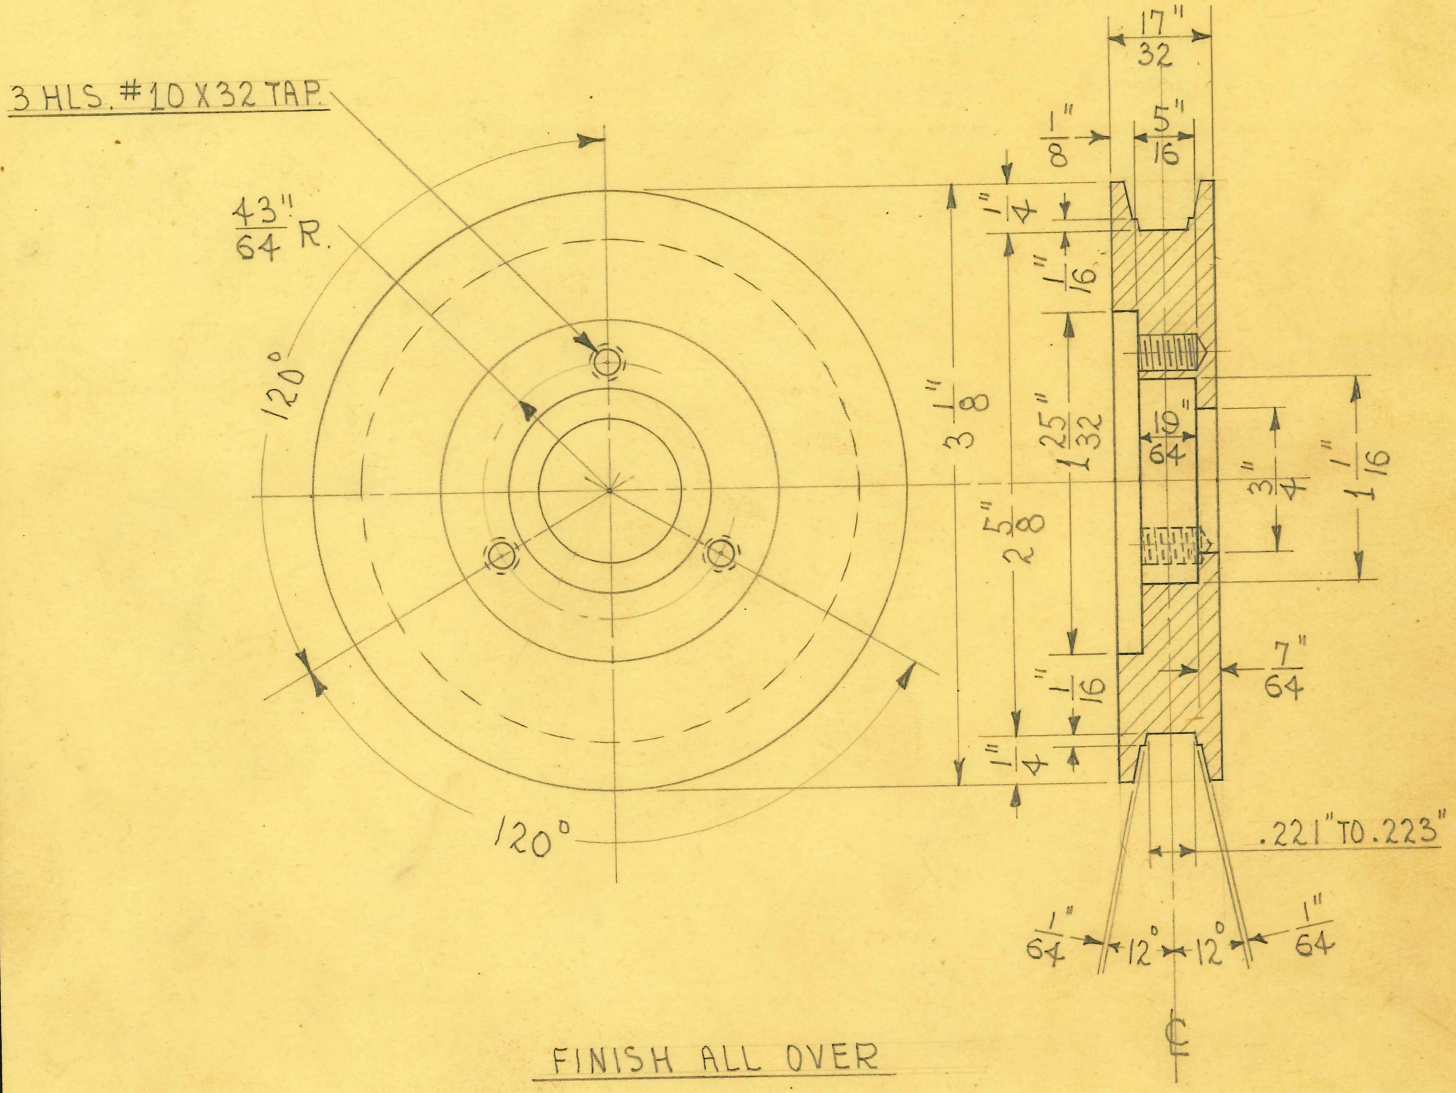

FINISH ALL OVER

2 REQUIRED

OBSOLETE
4-22-80 J.S.

SIZE		ISSUE 2-28-38	A.E.
KIND	ALUM. CASTING	CHANGED	
SHAPE		"	
FINISH		"	
TEMP.		"	
PATT.	1216	"	

TITLE: FISCHER MOD. "G" SHOCKPROOF FLUOROSCOPE-COUNTERWEIGHT PULLEY

H. G. FISCHER & CO.
2335 WABANSIA AVE.
CHICAGO, ILL.

CAT. NO.

PART NO. 11235F

.753" REAMER

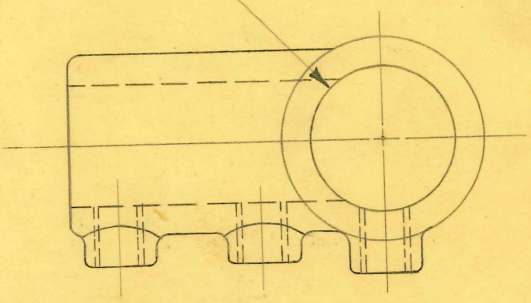

4 HLS. - $\frac{1}{4}$" X 20 TAP

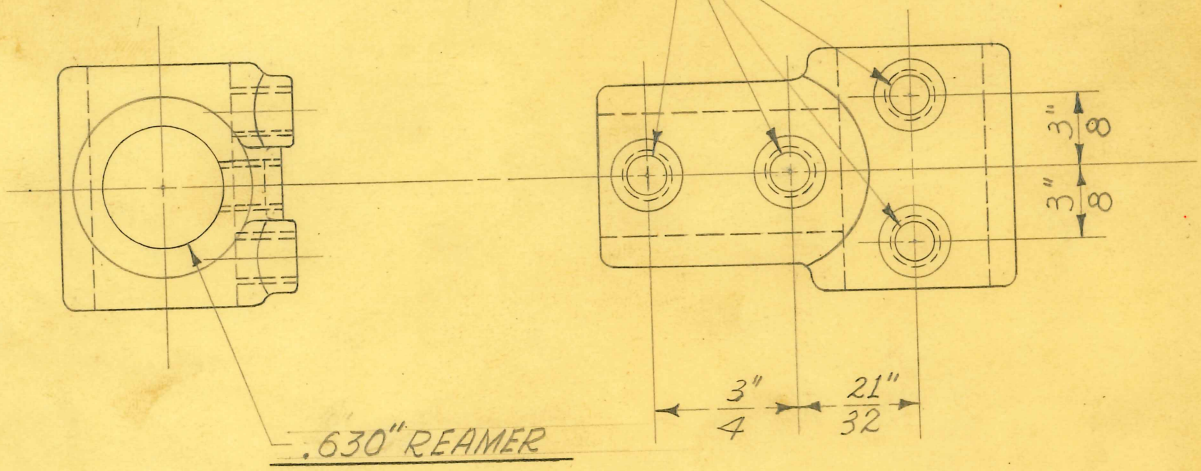

.630" REAMER

OBSOLETE
4-22-80 J.S

2 REQUIRED

SIZE		ISSUE 3-10-38	J.W.
KIND	ALUM. CASTING	CHANGED	
SHAPE		"	
FINISH	PAINTED	"	
TEMP.		"	
PATT.	9127-1196	"	

TITLE: FISCHER MOD. "G" SHOCKPROOF FLUOROSCOPE SCREEN SUPP. CONN. — LARGE

H. G. FISCHER & CO.
2335 WABANSIA AVE.
CHICAGO, ILL.

CAT. NO.

PART NO. 11242F

.630 REAMER

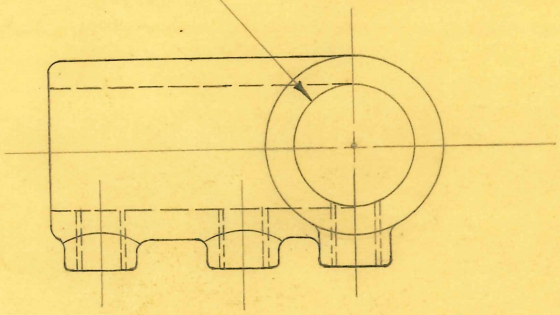

4 HLS. - 1/4" X 20 TAP

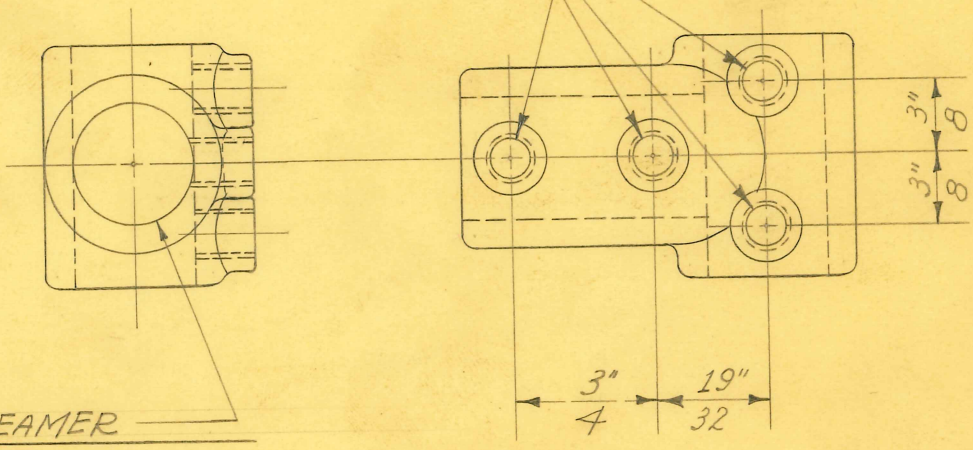

.630" REAMER

2 REQUIRED

OBSOLETE
4-22-80 J.S

SIZE		ISSUE 3-10-38	J.W.
KIND	ALUM. CASTING	CHANGED	
SHAPE		"	
FINISH	PAINTED	"	
TEMP.		"	
PATT.	9128-1197	"	

TITLE: FISCHER MOD. "G" SHOCKPROOF FLUOROSCOPE SCREEN SUPP. CONN. - SMALL

H. G. FISCHER & CO.
2335 WABANSIA AVE.
CHICAGO, ILL.

CAT. NO.

PART NO. 11243F

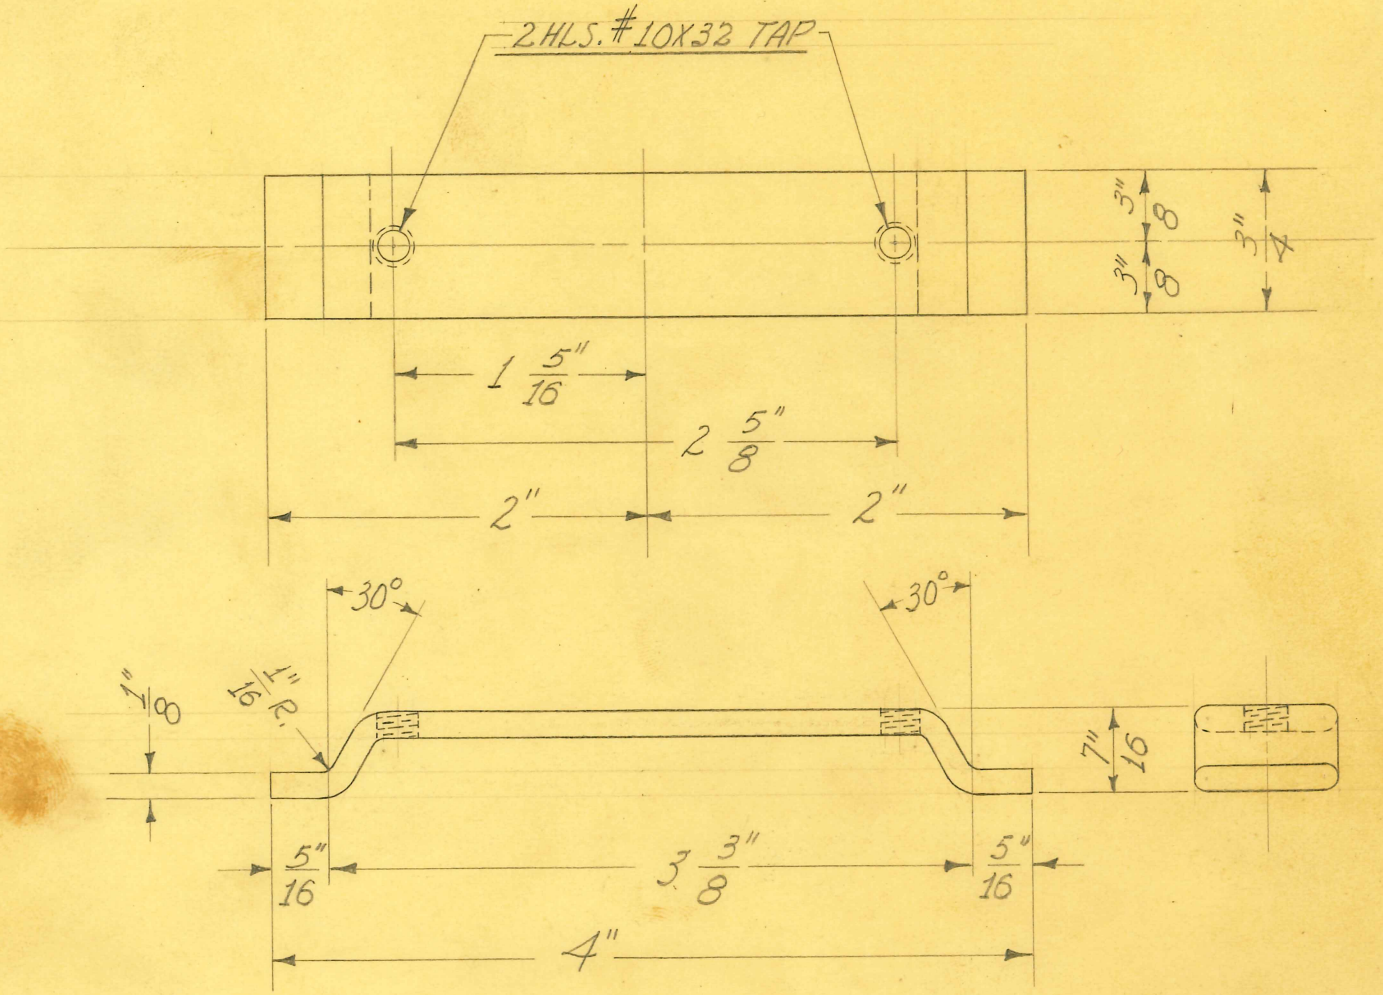

DEVELOPED LENGTH 4 3" 8

OBSOLETE
4-22-80 J.S.

2 REQUIRED

SIZE	3/4" X 1/8"	ISSUE 3-3-38	J.W.
KIND	FLAT WIRE	CHANGED	
SHAPE		"	
FINISH		"	
TEMP.		"	
PATT.		"	

TITLE:
FISCHER MOD. "G" SHOCKPROOF FLUOROSCOPE
SIDE COVER CLAMP STRIP

H. G. FISCHER & CO.
2335 WABANSIA AVE.
CHICAGO, ILL.

CAT. NO.

PART NO. 11244

REVISIONS		DATE	BY
A	WAS .0625" ± .001"	12-19-49	W.J.
B	" SELECTED C.R. STEEL	"	"

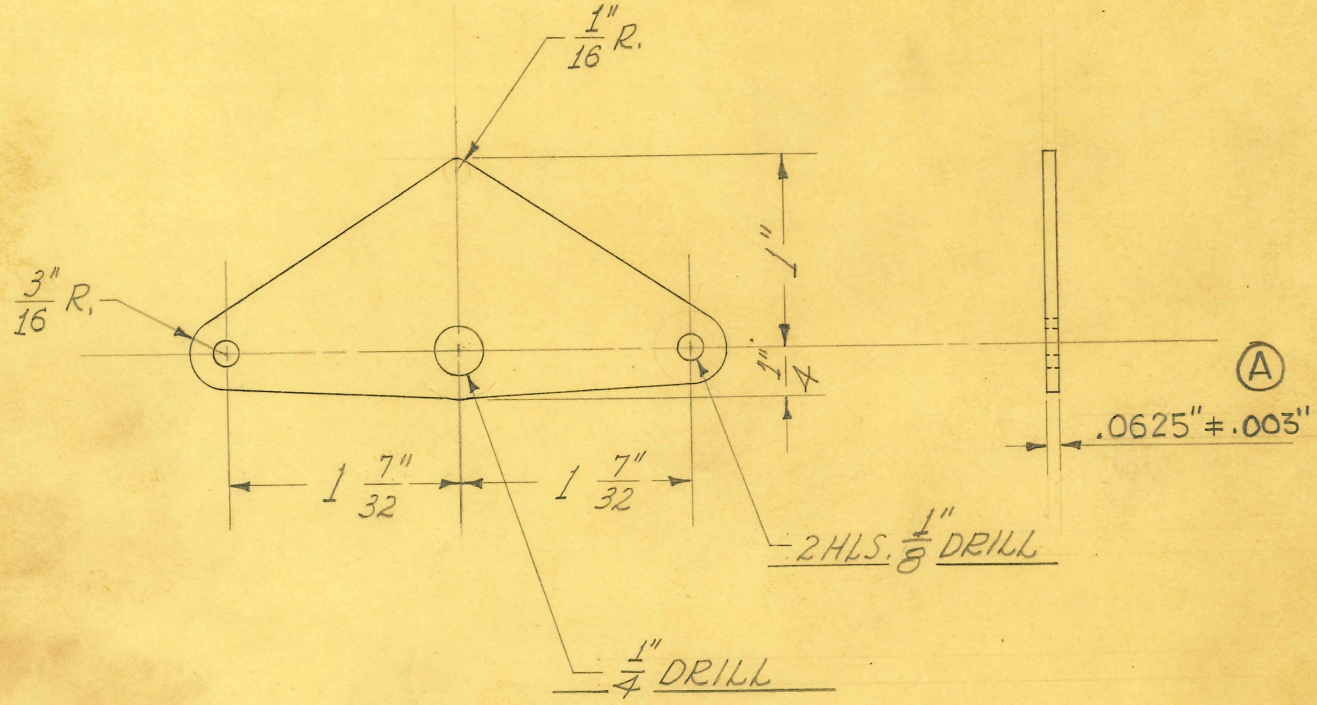

4 REQUIRED

OBSOLATE
4-22-80 J.S.

BLANKING DIE #6521 F-3 (B)

.0625" ± .003" X 2 1/4" SHEARED C.R. STEEL

Sec #18619

SIZE		ISSUE 2-21-38	J.W.
KIND		CHANGED	
SHAPE		"	
FINISH		"	
TEMP.		"	
PATT.		"	

TITLE: FISCHER MOD. "G" SHOCKPROOF FLUOROSCOPE SHUTTER ARM - BLANK

H. G. FISCHER & CO.
2335 WABANSIA AVE.
CHICAGO, ILL.

CAT. NO.

PART NO. 11246

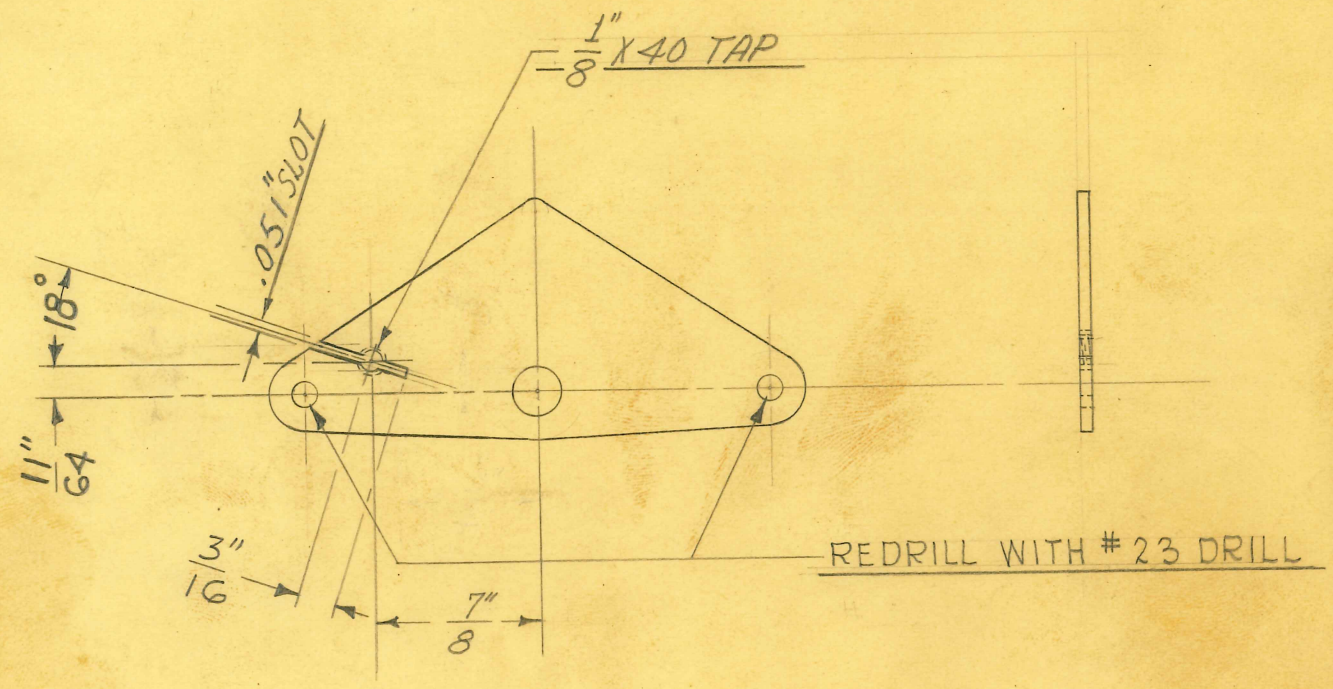

FROM #11246

1 REQUIRED

OBSOLETED
4-22-80 J.S

SIZE		ISSUE 2-21-38	J.W.	**TITLE:** FISCHER MOD. "G" SHOCKPROOF FLUOROSCOPE SHUTTER ARM- HORIZONTAL
KIND		CHANGED		
SHAPE		"		
FINISH	CAD. #23	"		
TEMP.		"		
PATT.		"		

H. G. FISCHER & CO.
2335 WABANSIA AVE.
CHICAGO, ILL.

CAT. NO.

PART NO. 11246F

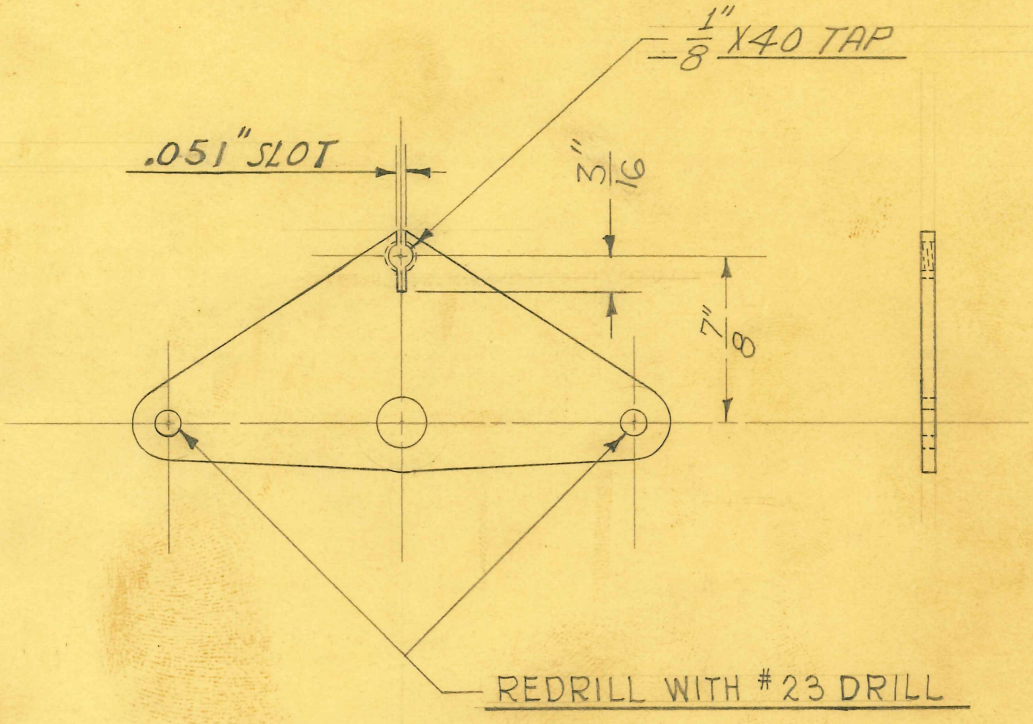

FROM #~~11246~~ sec 18619

1 REQUIRED

OBSOLETE
4-22-80 JS

SIZE		ISSUE 2-21-38	J.W.
KIND		CHANGED	
SHAPE		" 6-11-46	J.W.
FINISH	CAD. #23	"	
TEMP.		"	
PATT.		"	

TITLE: FISCHER MOD. "G" SHOCKPROOF FLUOROSCOPE SHUTTER ARM — VERTICAL

H. G. FISCHER & CO.
2335 WABANSIA AVE.
CHICAGO, ILL.

CAT. NO.

PART NO. 11247

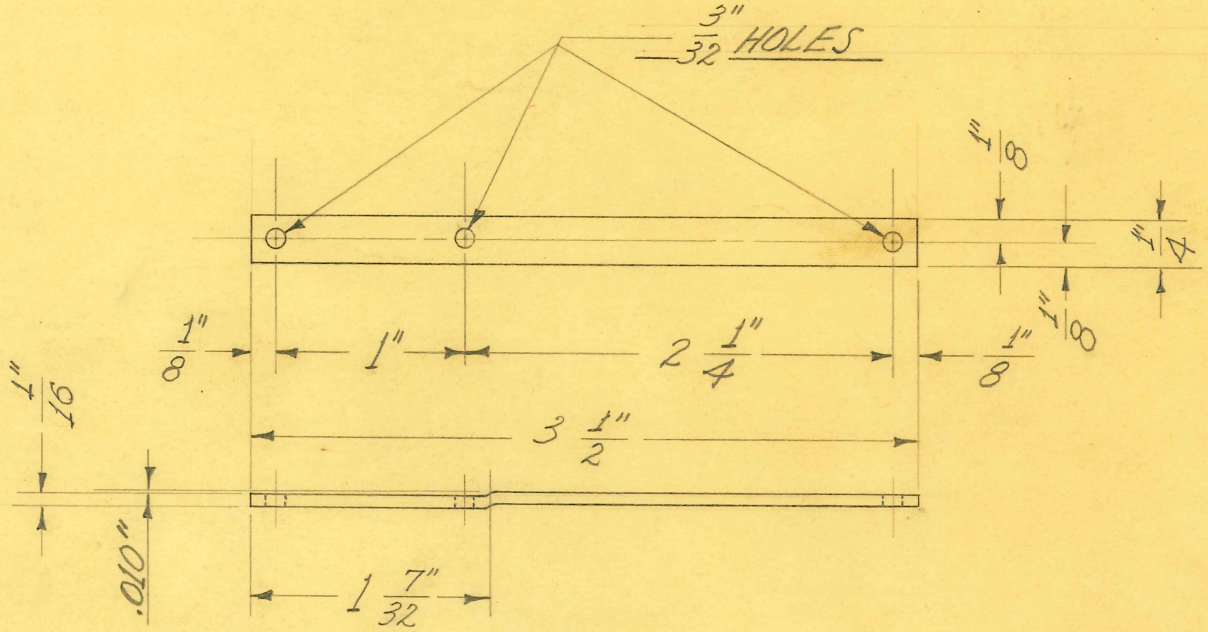

8 REQUIRED

OBSOLETE
4-22-80 J.S.

SIZE	1/4" X 1/16"	ISSUE 2-21-38	J.W.
KIND	C.R. STEEL	CHANGED	
SHAPE	FLAT WIRE	"	
FINISH		"	
TEMP.		"	
PATT.		"	

TITLE: FISCHER MOD. "G" SHOCKPROOF FLUOROSCOPE SHUTTER PLATE GUIDE STRIP

H. G. FISCHER & CO.
2338 WABANSIA AVE.
CHICAGO, ILL.

CAT. NO.

PART NO. 11249

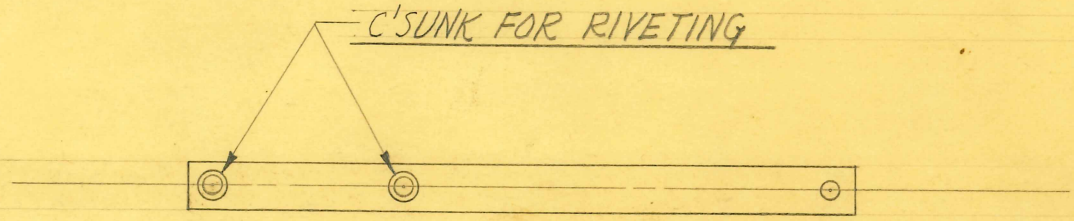

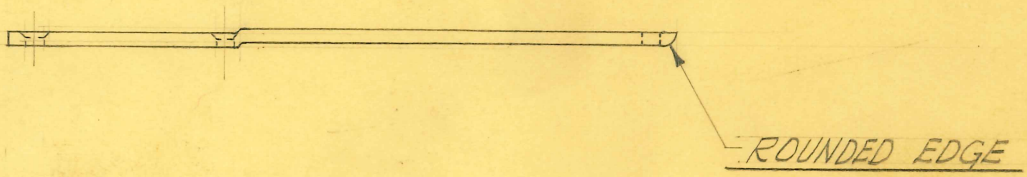

FROM # 11249

OBSOLETE
4-22-80 J.S.

4 REQUIRED

SIZE		ISSUE 2-21-38	J.W.
KIND		CHANGED	
SHAPE		"	
FINISH	CAD. #23	"	
TEMP.		"	
PATT.		"	

TITLE: FISCHER MOD. "G" SHOCKPROOF FLUOROSCOPE SHUTTER PLATE GUIDE STRIP—REAR

H. G. FISCHER & CO.
2335 WABANSIA AVE.
CHICAGO, ILL.

CAT. NO.

PART NO. 11249F

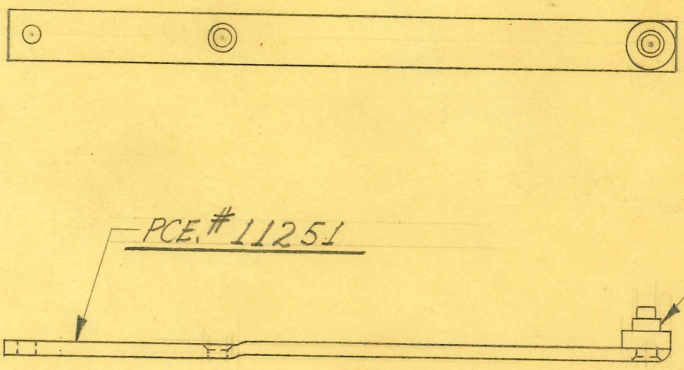

4 REQUIRED

OBSOLETE
4-22-80 J.S

SIZE		ISSUE 2-22-38	J.W.
KIND		CHANGED	
SHAPE		"	
FINISH	CAD. #23	"	
TEMP.		"	
PATT.		"	

TITLE: FISCHER MOD. "G" SHOCKPROOF FLUOROSCOPE SHUTTER PLATE GUIDE STRIP ASSEM. - FRONT

H. G. FISCHER & CO.
2335 WABANSIA AVE.
CHICAGO, ILL.

CAT. NO.

PART NO. 11250G

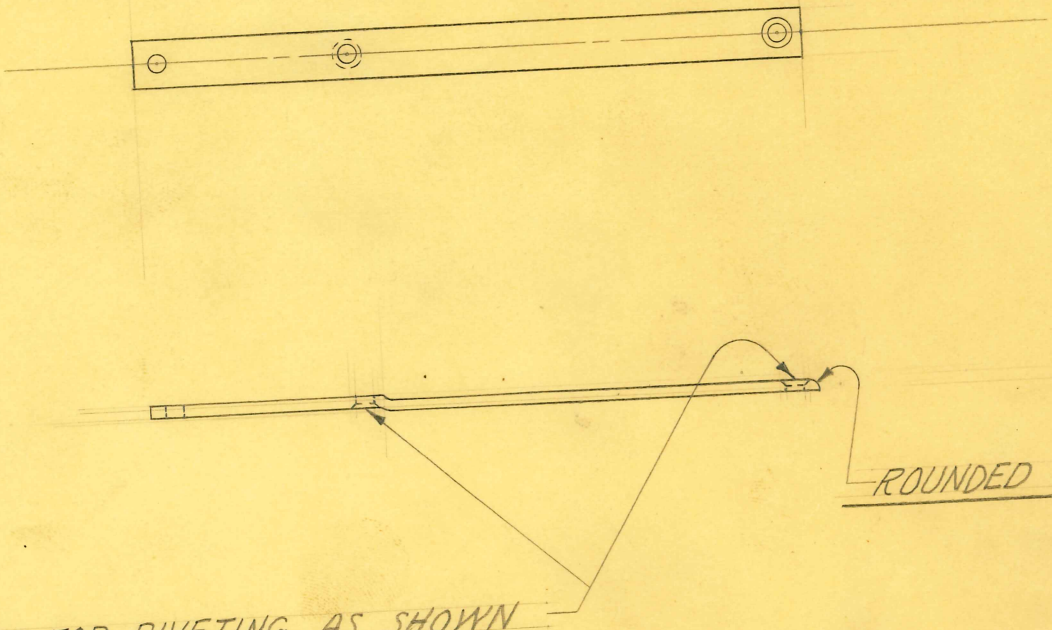

FROM #11249

OBSOLETE
4-22-80 J.S

4 REQUIRED

SIZE		ISSUE 2-22-38	J.W.	TITLE: FISCHER MOD. "G" SHOCKPROOF FLUOROSCOP SHUTTER PLATE GUIDE STRIP-FRONT
KIND		CHANGED		
SHAPE		"		
FINISH		"		
TEMP.		"		
PATT.		"		

H. G. FISCHER & CO.
2335 WABANSIA AVE.
CHICAGO, ILL.

CAT. NO.

PART NO. 11251

#38 DRILL - CSK. FOR RIVETING

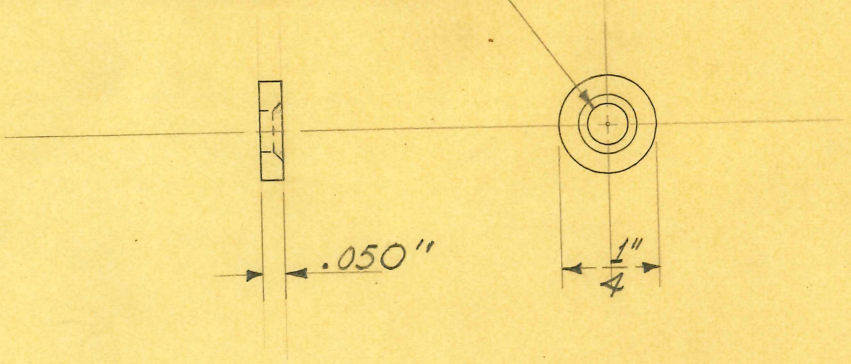

SCALE ~ 2 DIAMETERS

8 REQUIRED

OBSOLETE
4.22-80 J.S

SIZE	1/4" DIAM.	ISSUE 11-23-37	J.W.	TITLE: FISCHER MOD. "G" SHOCKPROOF FLUOROSCOPE SHUTTER RIVET WASHER
KIND	C.R. STEEL	CHANGED		
SHAPE	ROD	"		
FINISH	CAD. #23	"		
TEMP.		"		
PATT.		"		

H. G. FISCHER & CO.
2335 WABANSIA AVE.
CHICAGO, ILL.

CAT. NO.

PART NO. 11252

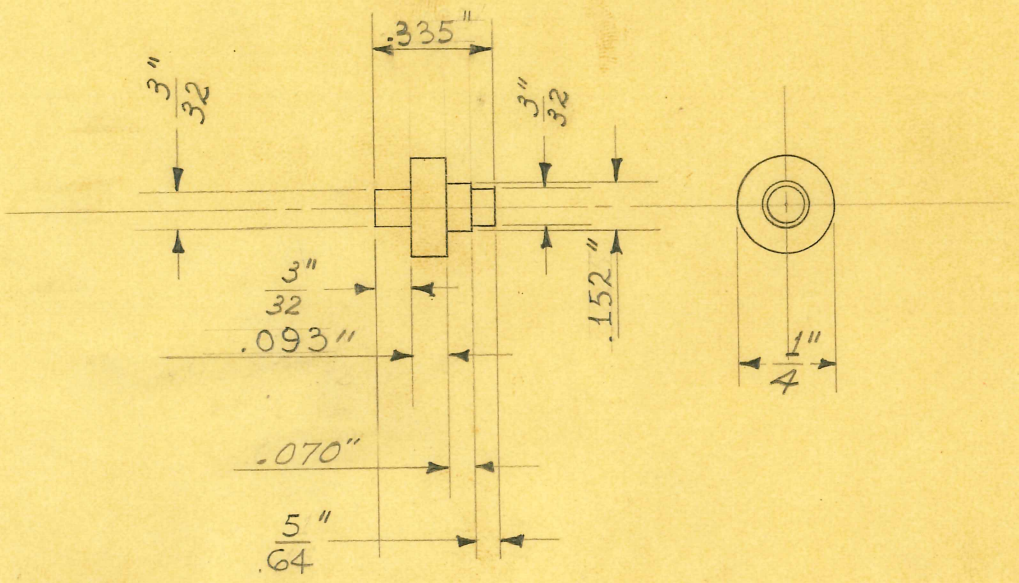

SCALE ÷ 2 DIAMETERS

4 REQUIRED

OBSOLETED
4-22-80 J.S

SIZE	1/4" DIAM.	ISSUE 11-23-37	J.W.
KIND	C.R. STEEL	CHANGED	
SHAPE	ROD	"	
FINISH		"	
TEMP.		"	
PATT.		"	

TITLE: FISCHER MOD. "G" SHOCKPROOF FLUOROSCOPE SHUTTER RIVET - SHORT

H. G. FISCHER & CO.
2335 WABANSIA AVE.
CHICAGO, ILL.

CAT. NO.

PART NO. 11253

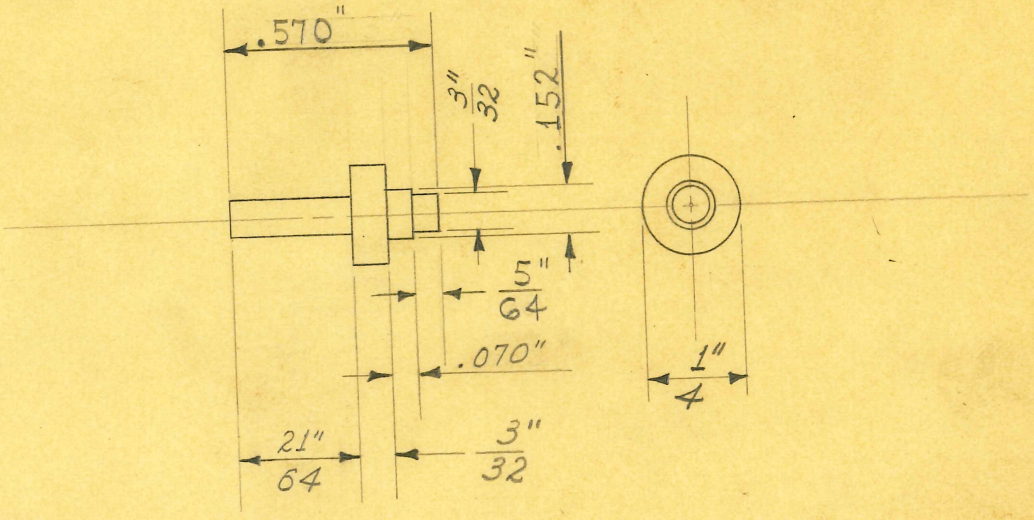

SCALE ÷ 2 DIAMETERS

4 REQUIRED

OBSOLETE
4-22-80 J.S

SIZE	1/4" DIAM.	ISSUE 11-23-37	J.W.	TITLE: FISCHER MOD. "G" SHOCKPROOF FLUOROSCOPE SHUTTER RIVET -LONG
KIND	C.R. STEEL	CHANGED		
SHAPE	ROD	"		
FINISH	CAD. #23	"		
TEMP.		"		
PATT.		"		

H. G. FISCHER & CO.
2335 WABANSIA AVE.
CHICAGO, ILL.

CAT. NO.

PART NO. 11254

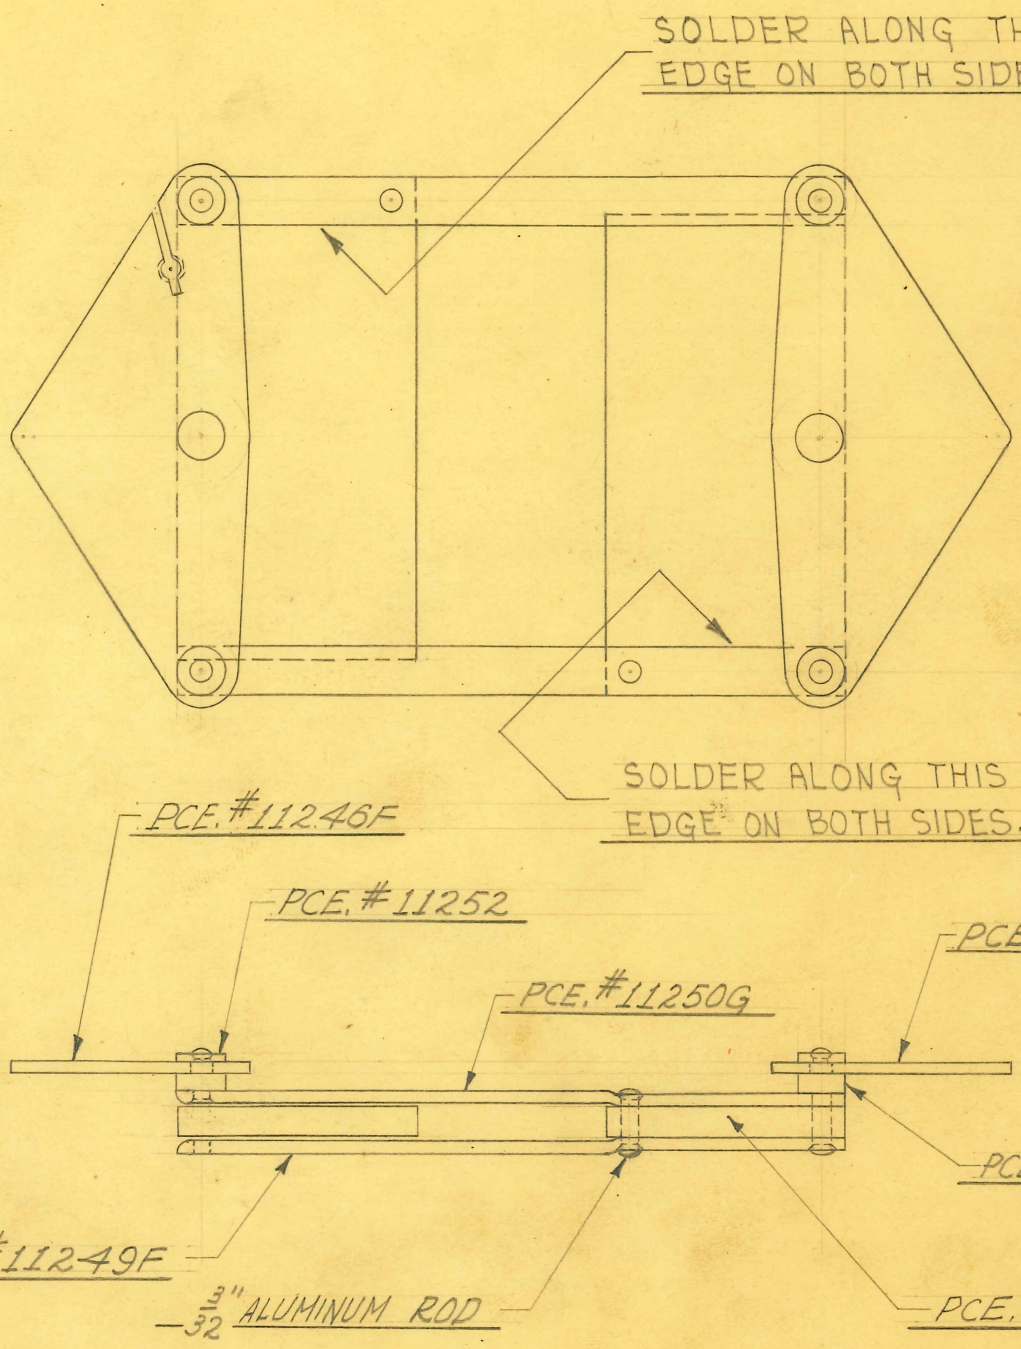

OBSOLETE
4-22-80-J.S

SIZE		ISSUE 2-22-38	J.W.
KIND		CHANGED	
SHAPE		"	
FINISH		"	
TEMP.		"	
PATT.		"	

TITLE: FISCHER MOD. "G" SHOCKPROOF FLUOROSCOPE HORIZONTAL SHUTTER ASSEMBLY

H. G. FISCHER & CO.
2335 WABANSIA AVE.
CHICAGO, ILL.

CAT. NO.

PART NO. 11255G

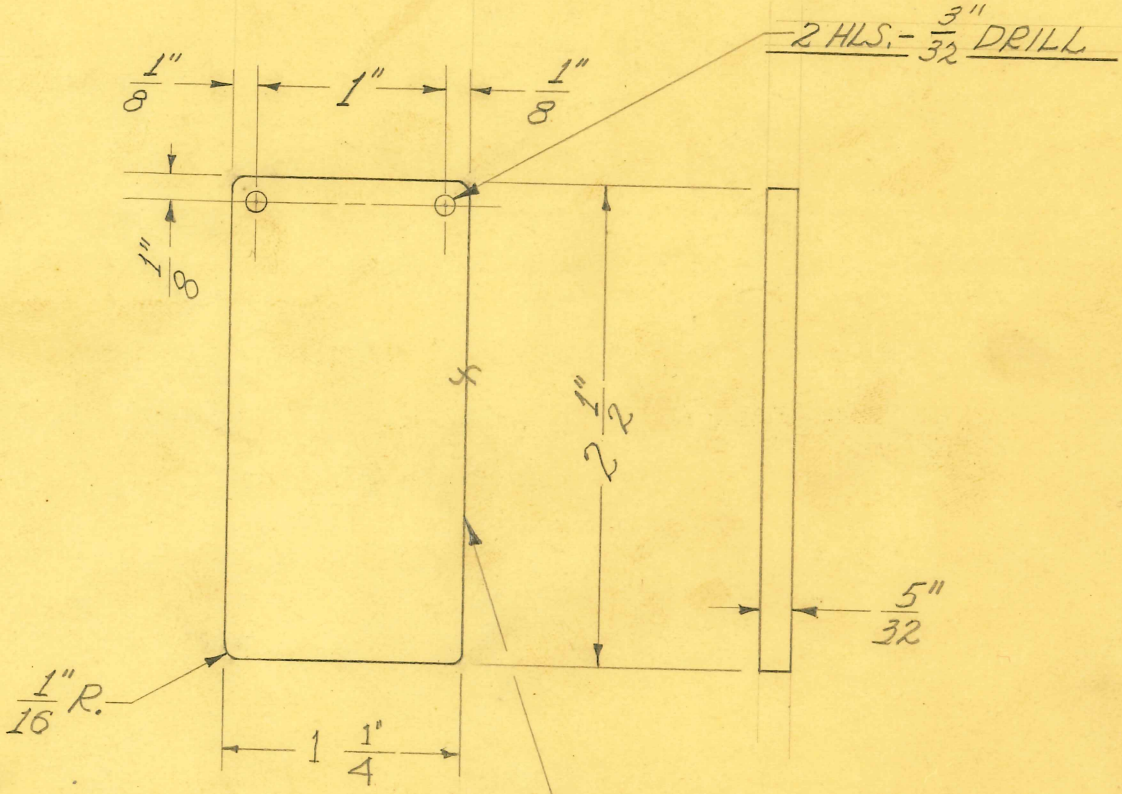

TAKE VERY LIGHT CUT IN SHAPER TO FLAT FACE ONLY

4 REQUIRED

OBSOLETE
4-22-80 J.S

BLANKING DIE #6527
FLATTENING DIE #6146
PIERCING DIE #6523

SIZE	5/32"	ISSUE 2-22-38	J.W.
KIND	LEAD PLATE	CHANGED	
SHAPE		"	
FINISH		"	
TEMP.		"	
PATT.		"	

TITLE: FISCHER MOD. "G" SHOCKPROOF FLUOROSCOPE SHUTTER PLATE - LEAD

H. G. FISCHER & CO.
2335 WABANSIA AVE.
CHICAGO, ILL.

CAT. NO.

PART NO. 11256

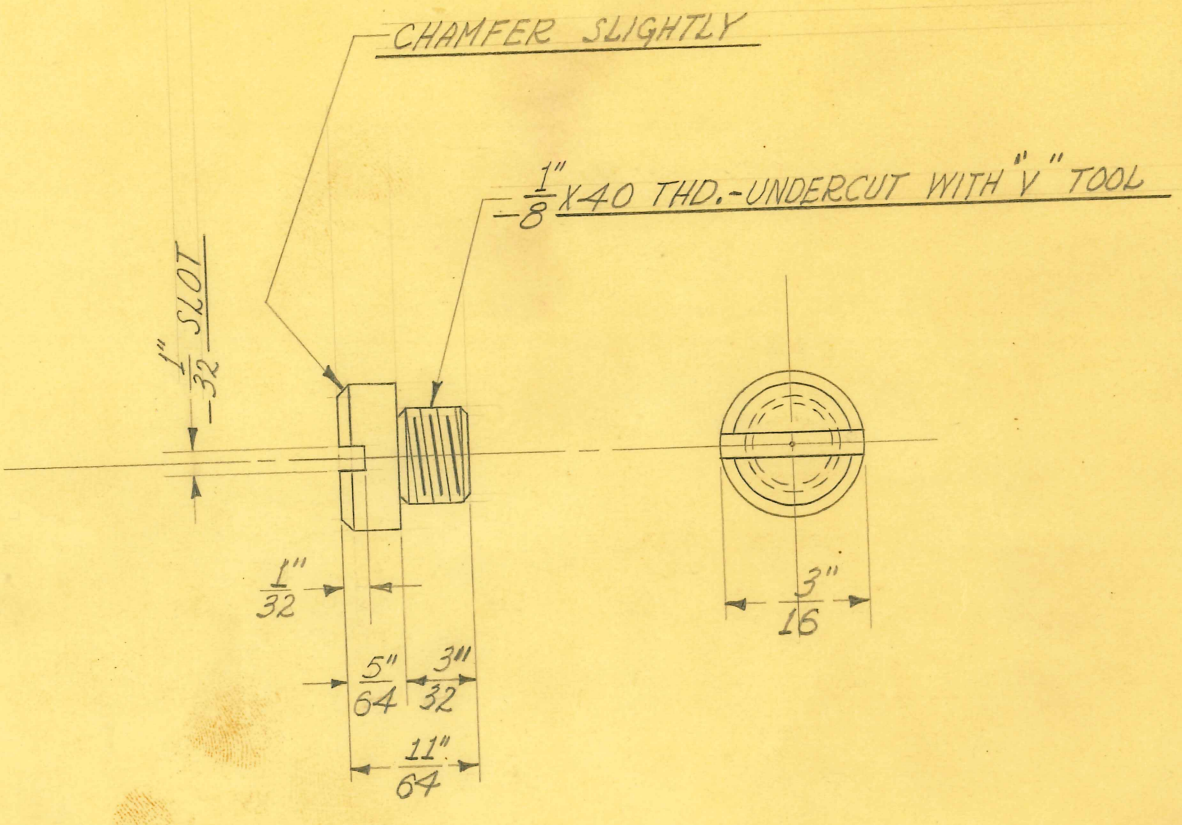

SCALE ÷ 4 DIAMETERS

2 REQUIRED

OBSOLETE
4-22-80 J.S

SIZE	3/16" DIAM.	ISSUE 2-21-38	J.W.
KIND	C.R. STEEL	CHANGED	
SHAPE		"	
FINISH	CAD. #23	"	
TEMP.		"	
PATT.		"	

TITLE: FISCHER MOD. "G" SHOCKPROOF FLUOROSCOPE
SHUTTER OPERATING WIRE CLAMP SCREW

H. G. FISCHER & CO.
2335 WABANSIA AVE.
CHICAGO, ILL.

CAT. NO.

PART NO. 11257

#27 DRILL CSK.
FOR #6X32 O.HD. SCR.

REMOVE SHARP EDGES

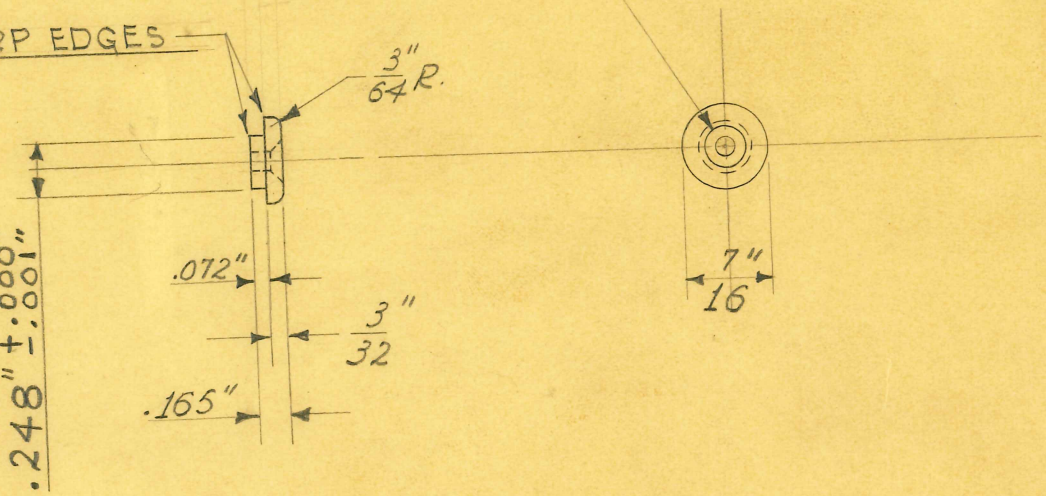

4 REQUIRED

OBSOLETE
4-22-80 J.S

SIZE	7/16" DIA.	ISSUE 11-22-37	J.W.	TITLE: FISCHER MOD. "G" SHOCKPROOF FLUOROSCOPE SHUTTER ARM BUSHING
KIND	C.R. STEEL	CHANGED		
SHAPE	ROD.	"		
FINISH	CAD. #23	"		
TEMP.		"		
PATT.		"		

H. G. FISCHER & CO.
2335 WABANSIA AVE.
CHICAGO, ILL.

CAT. NO.

PART NO. 11258

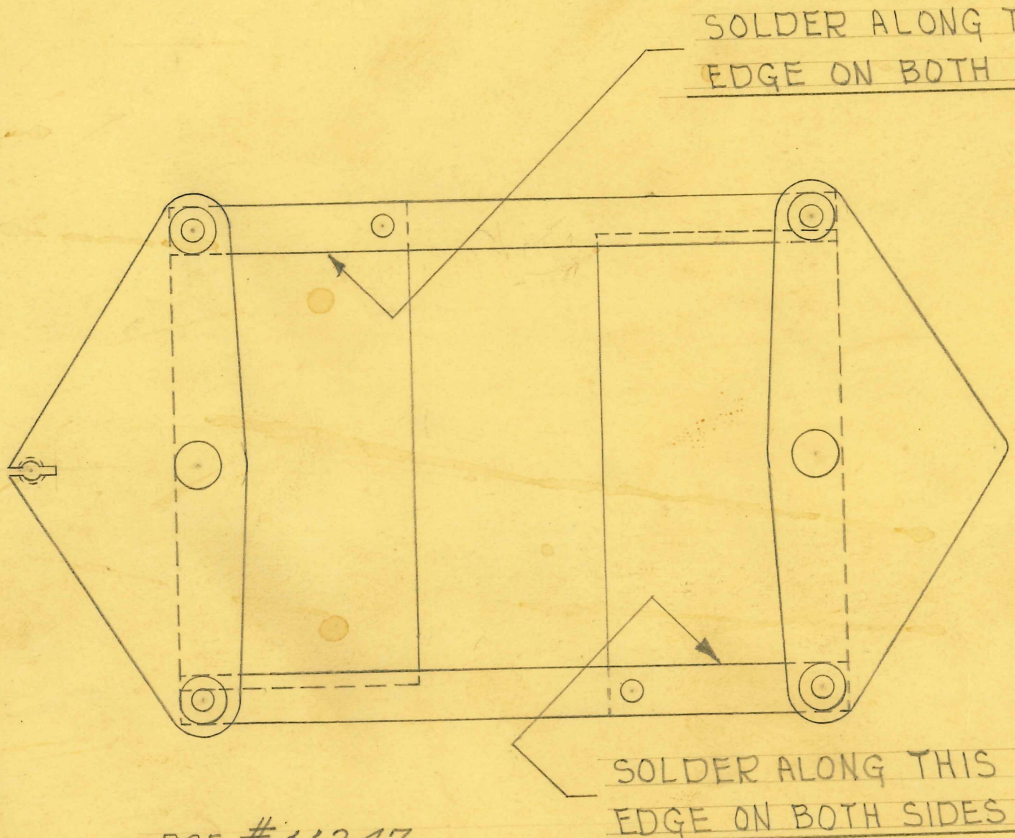

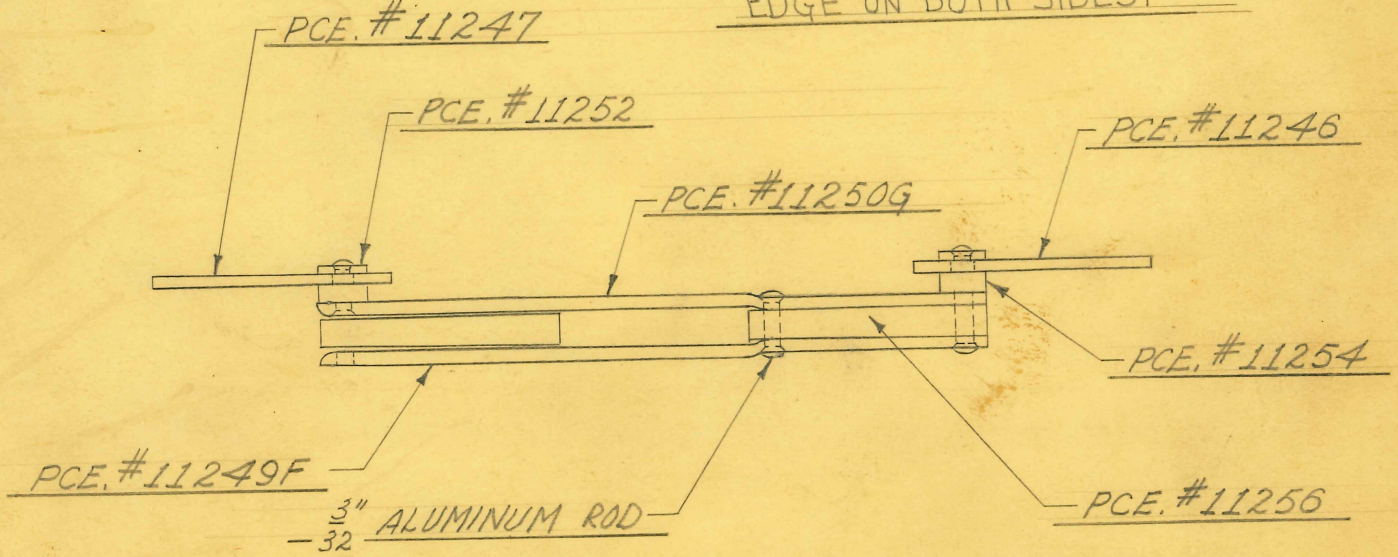

OBSOLETE
4-22-80 J.S

SIZE		ISSUE 2-22-38	J.W.
KIND		CHANGED	
SHAPE		"	
FINISH		"	
TEMP.		"	
PATT.		"	

TITLE: FISCHER MOD. "G" SHOCKPROOF FLUOROSCOPE VERTICAL SHUTTER ASSEMBLY

H. G. FISCHER & CO.
2335 WABANSIA AVE.
CHICAGO, ILL.

CAT. NO.

PART NO. 11259G

REMOVE ALL
SHARP EDGES

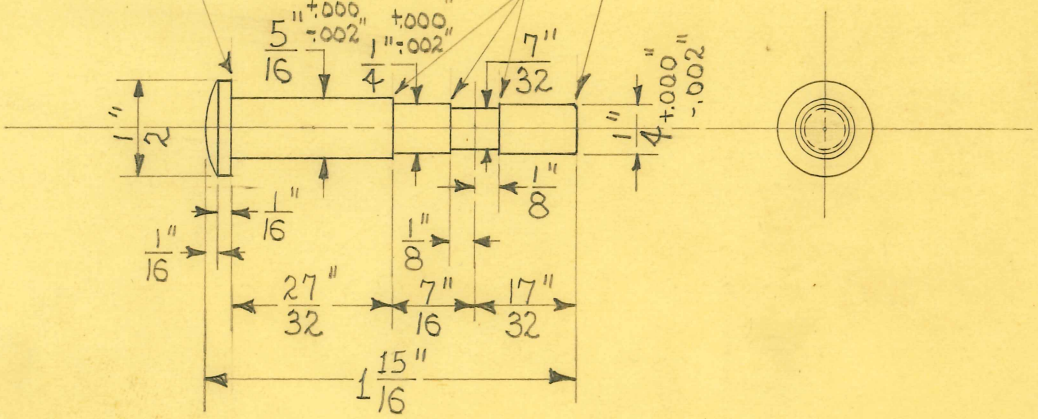

2 REQUIRED

OBSOLETE
4-22-80 J.S

SIZE	1/2" DIAM.	ISSUE 3-2-38	J.E.
KIND	C.R. STEEL	CHANGED	
SHAPE		"	
FINISH	CAD. #23	"	
TEMP.		"	
PATT.		"	

TITLE: FISCHER MOD. "G" SHOCKPROOF FLUOROSCOPE SCREEN FRAME SWIVEL SHAFT

H. G. FISCHER & CO.
2335 WABANSIA AVE.
CHICAGO, ILL.

CAT. NO.

PART NO. 11265

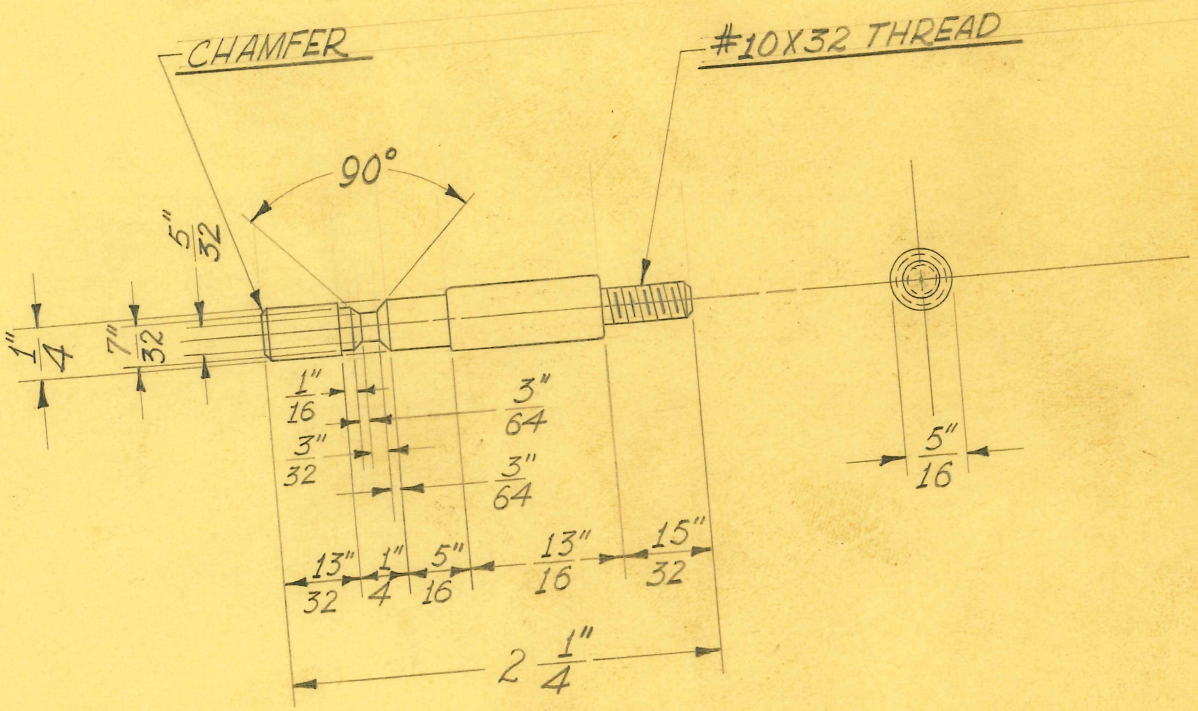

1 REQUIRED

OBSOLETE
4-22-80 J.S

SIZE	5/16" DIAM.	ISSUE 9-23-38	J.W.	TITLE: FISCHER MOD. "G" SHOCKPROOF FLUOROSCOPE SCREEN FRAME SWIVEL LOCK SHAFT (MINSKIER)
KIND	C.R. STEEL	CHANGED		
SHAPE	ROD	"		
FINISH	CAD. #23	"		
TEMP.		"		
PATT.		"		

H. G. FISCHER & CO.
2335 WABANSIA AVE.
CHICAGO, ILL.

CAT. NO.

PART NO. 11265

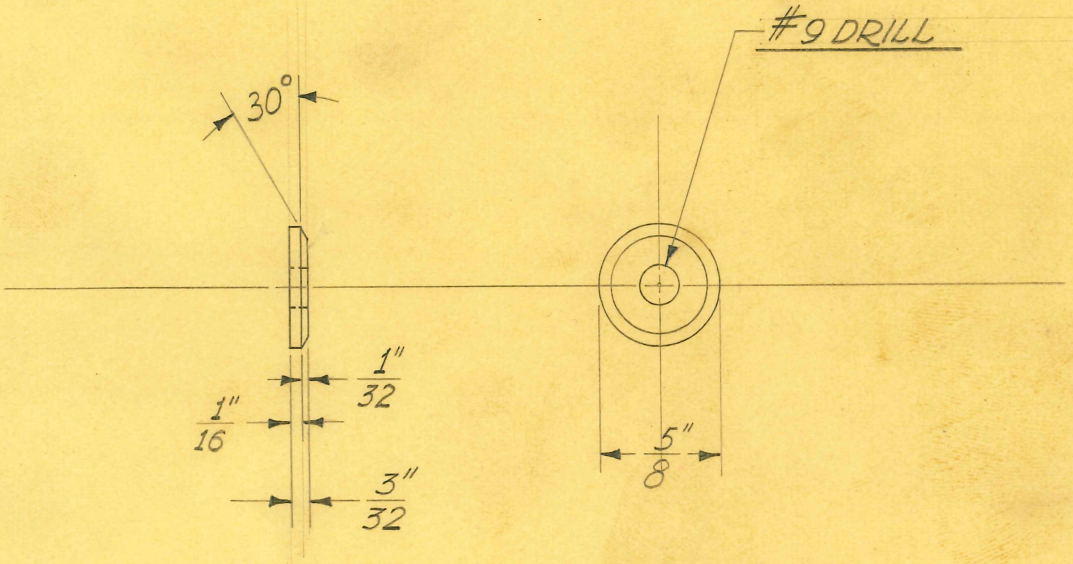

2 REQUIRED

OBSOLETE
4-22-80 J.S

SIZE	5/8 DIAM.	ISSUE 9-23-38	J.W.
KIND	BRASS ROD	CHANGED	
SHAPE		"	
FINISH	WH.CHR.#3	"	
TEMP.		"	
PATT.		"	

TITLE: FISCHER MOD. "G" SHOCKPROOF FLUOROSCOPE SCREEN FRAME SWIVEL LOCK SHAFT WASHER (MINSKIER)

H. G. FISCHER & CO.
2335 WABANSIA AVE.
CHICAGO, ILL.

CAT. NO.

PART NO. 11265 1/2

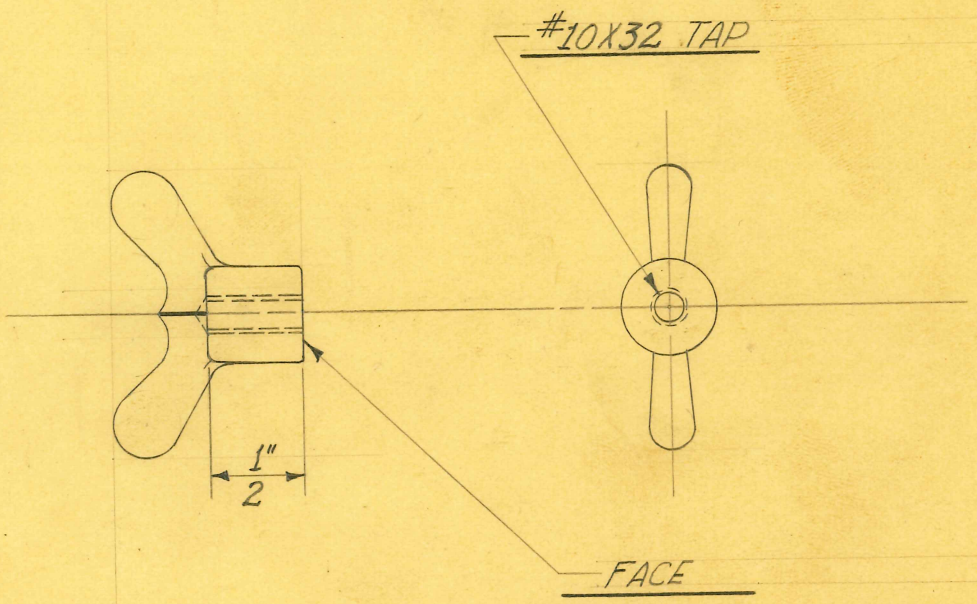

2 REQUIRED

OBSOLETE
4-22-80 J.S

SIZE		ISSUE 9-26-38	J.W.
KIND	IRON CASTING	CHANGED	
SHAPE		"	
FINISH		"	
TEMP.		"	
PATT.	6315-796	"	

TITLE: FISCHER MOD. "G" SHOCKPROOF FLUOROSCOPE SCREEN FRAME SWIVEL LOCK WING NUT (MINSKIER)

H. G. FISCHER & CO.
2335 WABANSIA AVE.
CHICAGO, ILL.

CAT. NO.

PART NO. 11265 3/4

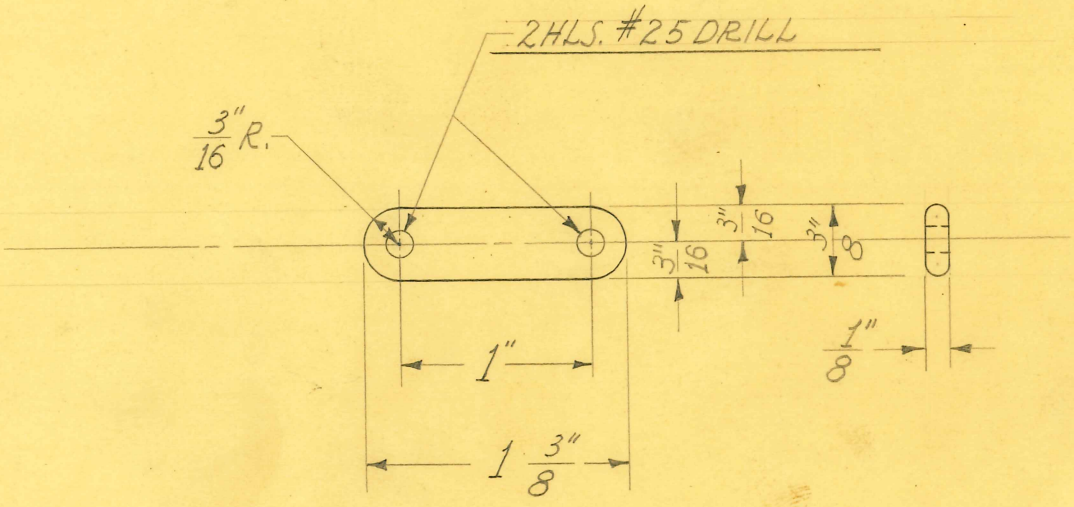

2 REQUIRED

OBSOLETE
4-22-80 J.S

SIZE	3/8" X 1/8"	ISSUE 3-1-38	J.W.
KIND	FLAT WIRE	CHANGED	
SHAPE		"	
FINISH		"	
TEMP.		"	
PATT.		"	

TITLE: FISCHER MOD. "G" SHOCKPROOF FLUOROSCOPE FILAMENT TRANSFORMER CLAMP STRIP

H. G. FISCHER & CO.
2335 WABANSIA AVE.
CHICAGO, ILL.

CAT. NO.

PART NO. 11289

FOR R-50 HR X-RAY TUBE
PCE. NO. 11291 GB

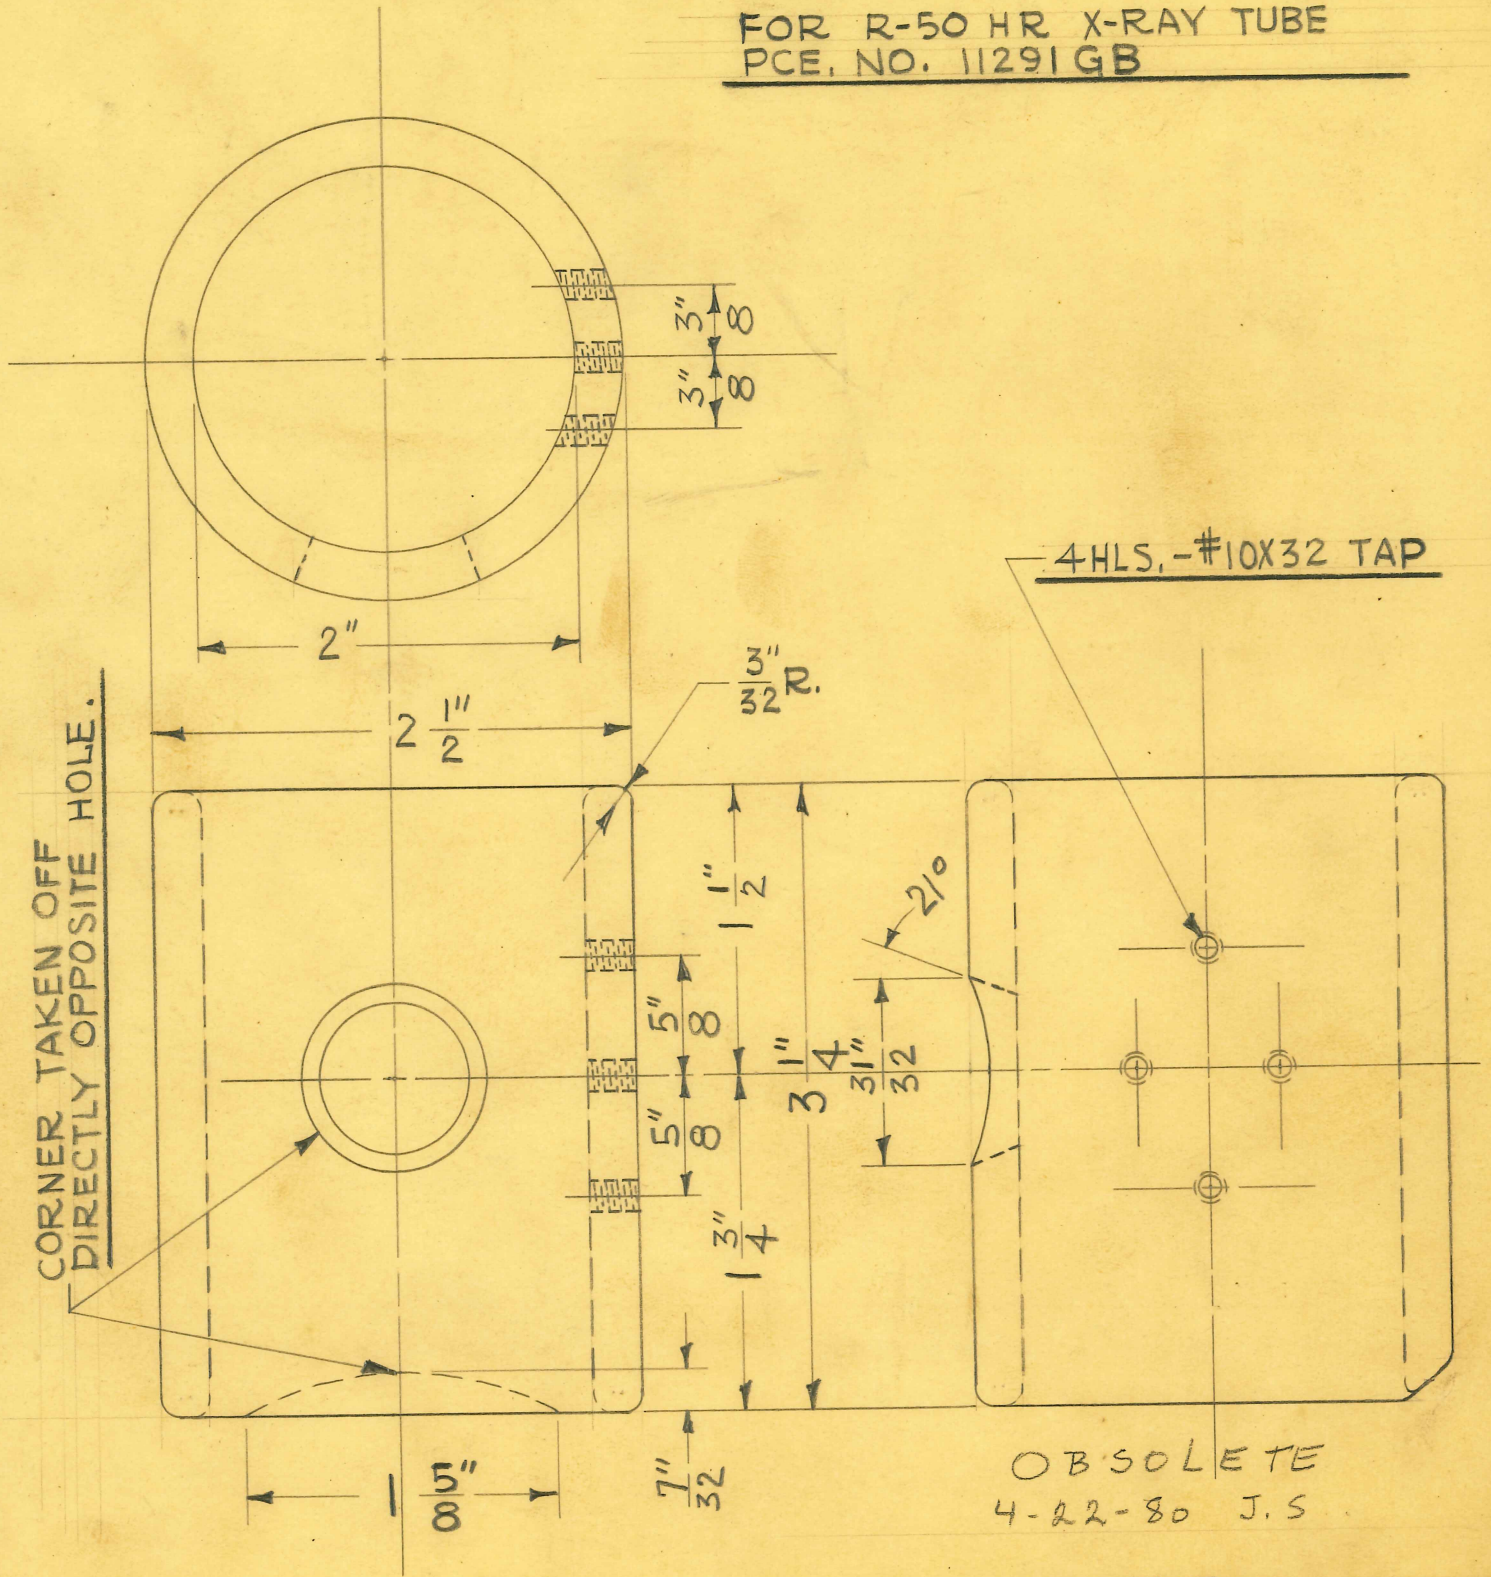

OBSOLETE
4-22-80 J.S

1 REQUIRED

SIZE	2½" O.D. X 2" I.D.	ISSUE 2-5-42	J.V.W.
KIND	X-OPAKE	CHANGED 6-24-42	J.V.W.
SHAPE	TUBING	"	
FINISH		"	
TEMP.		"	
PATT.		"	

TITLE:
FISCHER MOD. "G" SHOCKPROOF FLUOROSCOPE
X-RAY TUBE - SHIELD

H. G. FISCHER & CO.
2335 WABANSIA AVE.
CHICAGO, ILL.

CAT. NO.

PART NO. 11298C

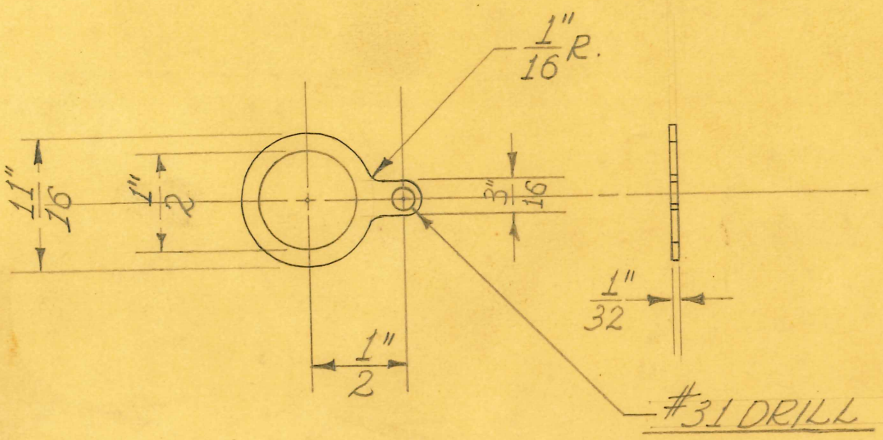

1 REQUIRED

OBSOLETE
4-22-80 J.S

SIZE	1/32"	ISSUE 5-2-38	J.W.
KIND	SHEET BRASS	CHANGED	
SHAPE		"	
FINISH		"	
TEMP.		"	
PATT.		"	

TITLE: FISCHER MOD. "G" SHOCKPROOF FLUOROSCOPE
X-RAY TUBE CONNECTION PLATE

H. G. FISCHER & CO.
2335 WABANSIA AVE.
CHICAGO, ILL.

CAT. NO.

PART NO. 11301

REMOVE ALL
SHARP EDGES

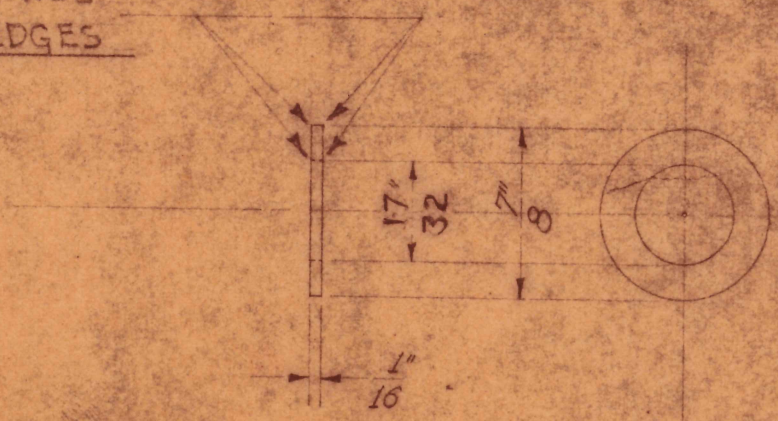

4 REQUIRED

OBSOLETE
4-22-80 JS

RCT

SIZE	7/8" DIAM.	ISSUE 12-28-37	J.W.
KIND	C.R. STEEL	CHANGED	
SHAPE	ROD	"	
FINISH	DU-LITE #8	"	
TEMP.		"	
PATT.		"	

TITLE: FISCHER MOD "G" SHOCKPROOF FLUOROSCOPE CWT. PULLEY SUPP. TIE ROD WASHER

H. G. FISCHER & CO.
2338 WABANSIA AVE.
CHICAGO, ILL.

CAT. NO.

PART NO. 11305 A

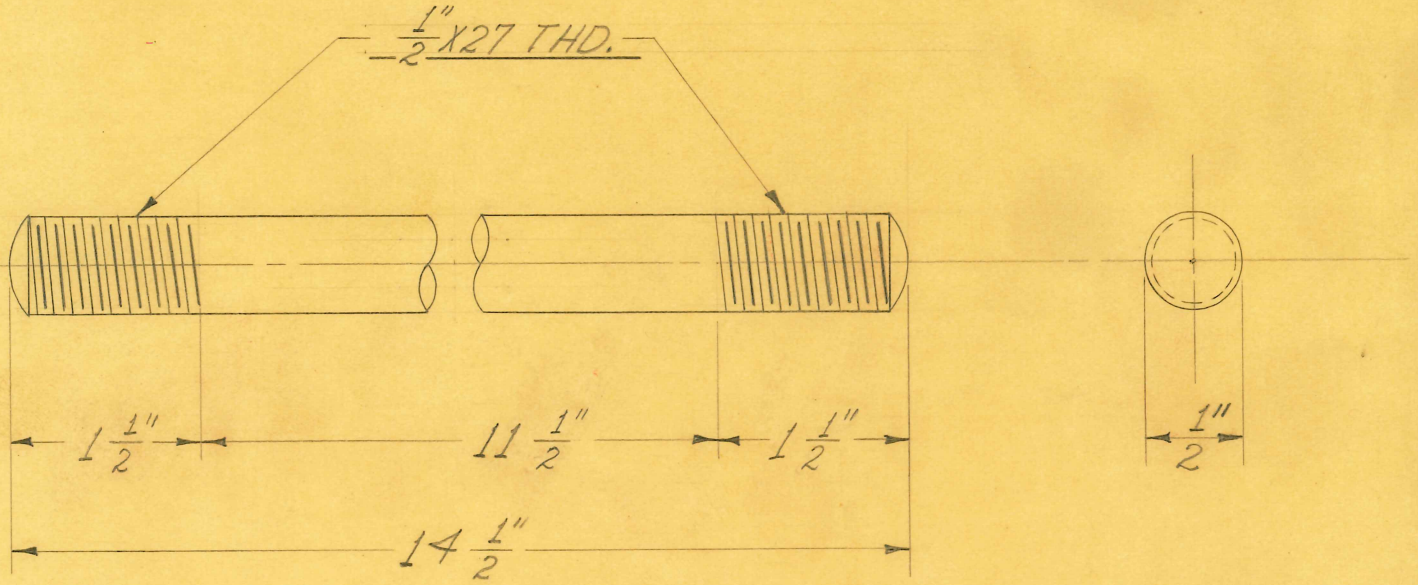

1 REQUIRED

OBSOLETE
4-22-80 J.S.

SIZE	1/2" DIAM.	ISSUE 12-28-37	J.W.
KIND	C.R. STEEL	CHANGED	
SHAPE	ROD	"	
FINISH	WHT. Chrom #3	"	
TEMP.		"	
PATT.		"	

TITLE: FISCHER MOD. "G" SHOCKPROOF FLUOROSCOPE CWT. PULLEY SUPP. TIE ROD

H. G. FISCHER & CO.
2335 WABANSIA AVE.
CHICAGO, ILL.

CAT. NO.

PART NO. 11306

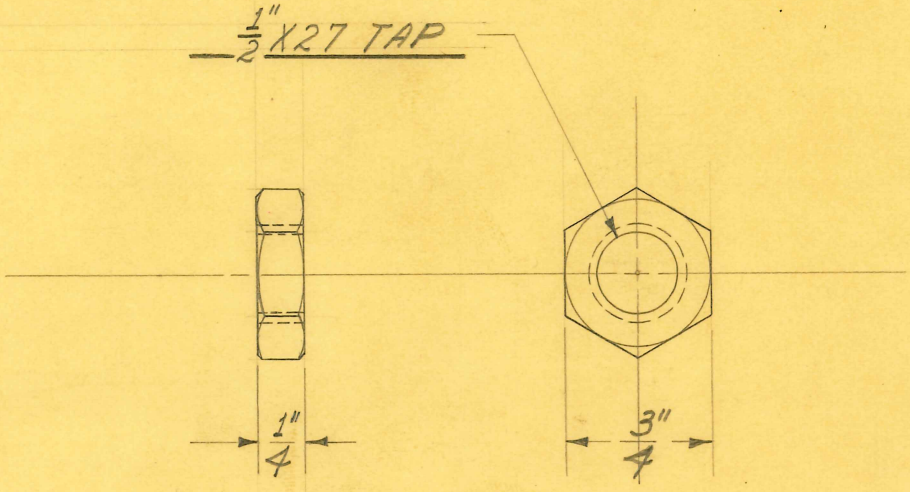

4 REQUIRED

OBSOLETE
H-22-80 J.S.

SIZE	3/4" HEX.	ISSUE 12-28-37	J.W.	**TITLE:** FISCHER MOD. "G" SHOCKPROOF FLUOROSCOPE CWT. PULLEY SUPP. TIE ROD NUT
KIND	C.R. STEEL	CHANGED		
SHAPE		"		
FINISH	DU-LITE #8	"		
TEMP.		"		
PATT.		"		

H. G. FISCHER & CO.
2335 WABANSIA AVE.
CHICAGO, ILL.

CAT. NO.

PART NO. 11307

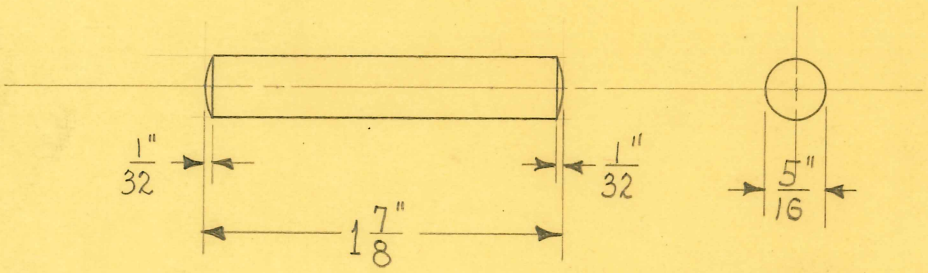

2 REQUIRED

OBSOLETE
4-22-80 J.S

SIZE	5/16" DIAM.	ISSUE 2-28-38	A.E.
KIND	C.R. STEEL	CHANGED	
SHAPE		"	
FINISH	DU-LITE #8	"	
TEMP.		"	
PATT.		"	

TITLE: FISCHER MOD. "G" SHOCKPROOF FLUOROSCOPE COUNTERWEIGHT PULLEY SHAFT

H. G. FISCHER & CO. 2335 WABANSIA AVE. CHICAGO, ILL.	CAT. NO.	PART NO. 11308

REMOVE ALL SHARP EDGES

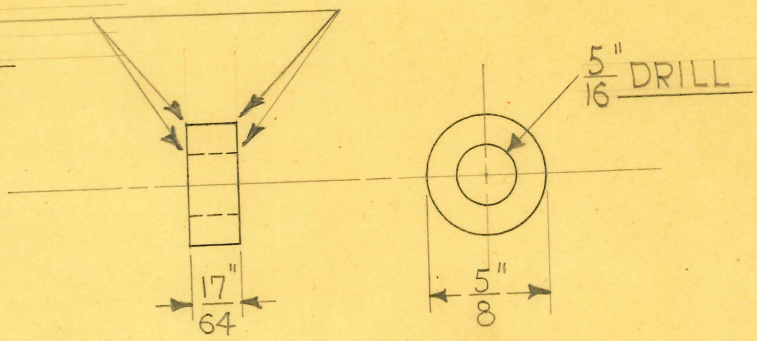

2 REQUIRED

OBSOLETE
4-22-80 JS

SIZE	5/8" DIAM.	ISSUE 3-14-38	A.E.
KIND	C.R. STEEL	CHANGED	
SHAPE		"	
FINISH	DU-LITE #8	"	
TEMP.		"	
PATT.		"	

TITLE: FISCHER MOD. "G." SHOCKPROOF FLUOROSCOPE-
COUNTERWEIGHT PULLEY WASHER

H. G. FISCHER & CO.
2335 WABANSIA AVE.
CHICAGO, ILL.

CAT. NO.

PART NO. 11309

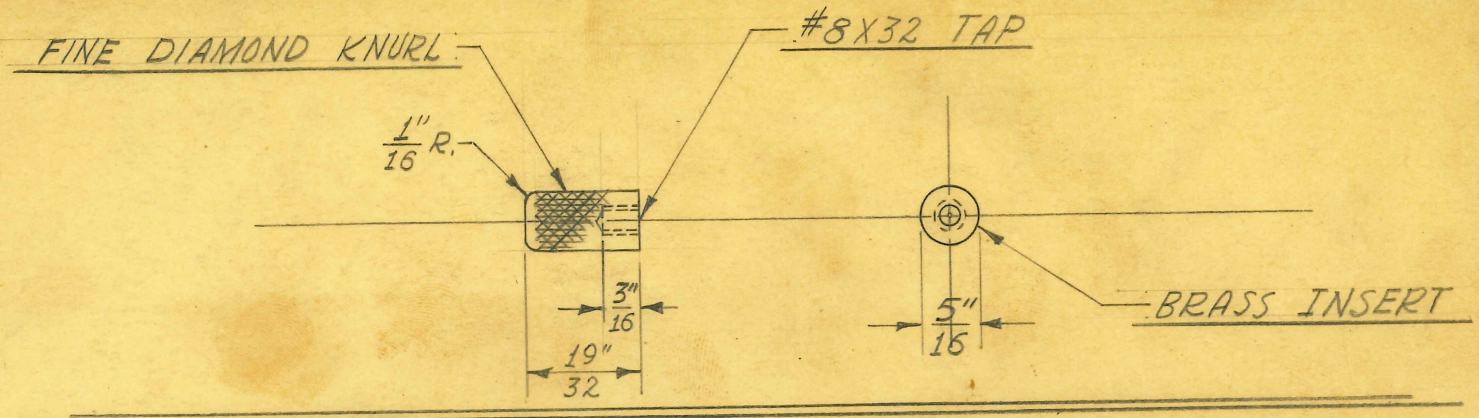

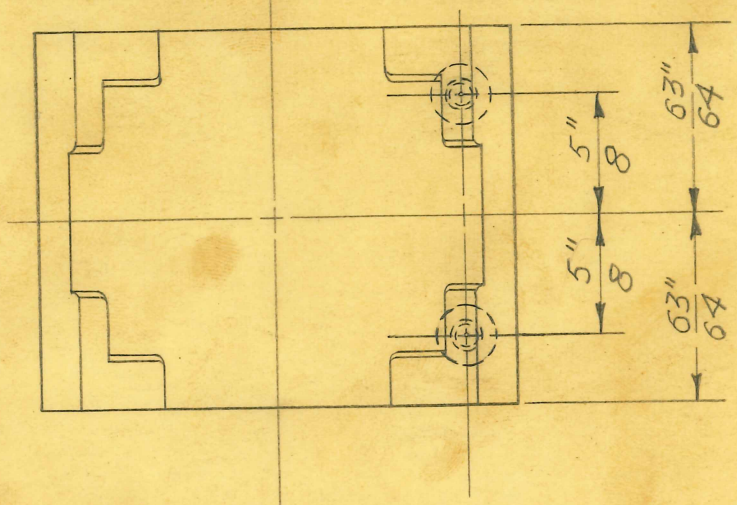

OBSOLETE
4-22-80 J.S

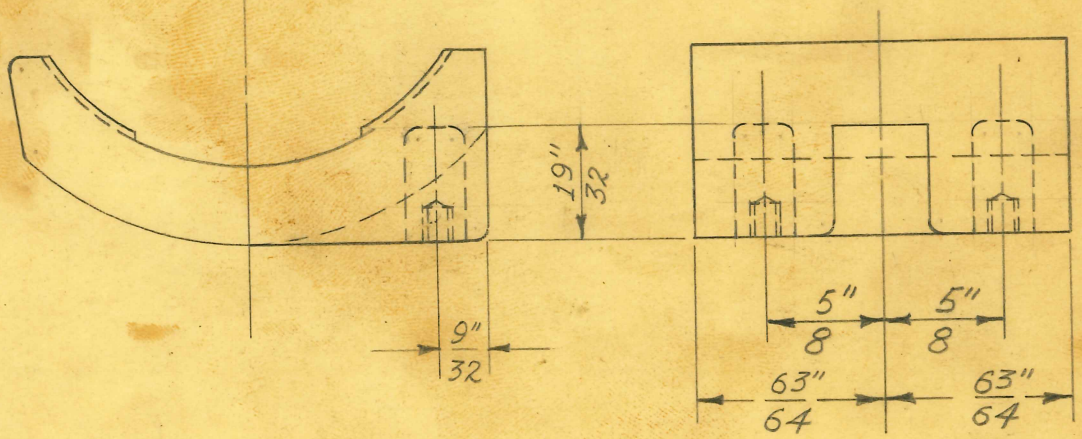

SIZE		ISSUE 10-9-39	J.W.
KIND		CHANGED	
SHAPE		"	
FINISH		"	
TEMP.		"	
PATT.		"	

TITLE:
FISCHER MOD. "G" SHOCKPROOF FLUOROSCOPE
TRANSF. - "X-RAY" TUBE MOUNTING SUPPORT

H. G. FISCHER & CO.
2335 WABANSIA AVE.
CHICAGO, ILL.

CAT. NO.

PART NO. 11311 G

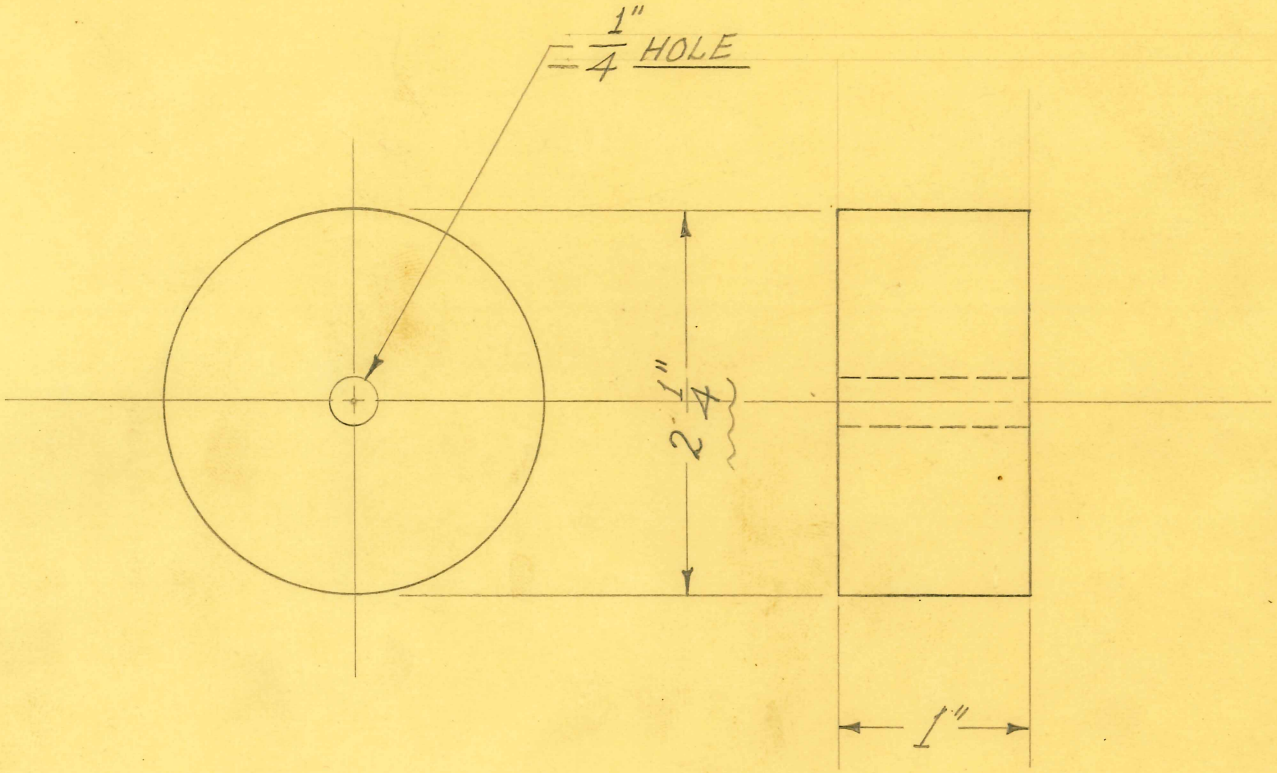

2 REQUIRED.

OBSOLETE
4-22-80 J.S

SIZE		ISSUE 2-25-38	J.W.
KIND	BLACK FELT	CHANGED	
SHAPE		"	
FINISH		"	
TEMP.		"	
PATT.		"	

TITLE: FISCHER MOD. "G" SHOCKPROOF FLUOROSCOPE COUNTER WEIGHT FELT WASHER

H. G. FISCHER & CO.
2335 WABANSIA AVE.
CHICAGO, ILL.

CAT. NO.

PART NO. 11317F

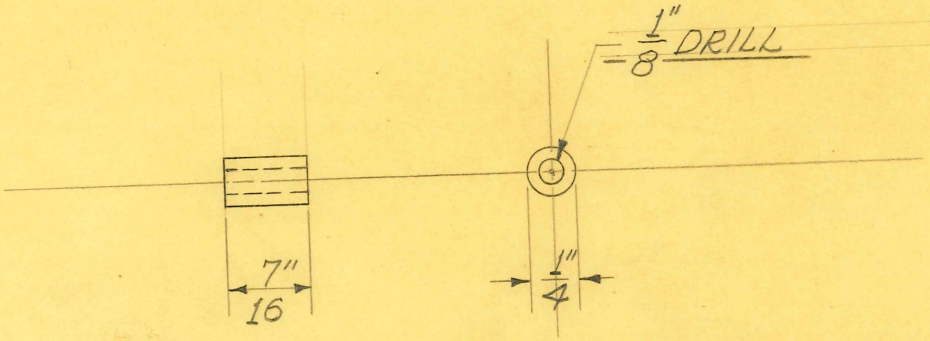

4 REQUIRED

OBSOLETE
4-22-80 J.S

SIZE	1/4" DIAM.	ISSUE 2-22-38	J.W.
KIND	BRASS ROD	CHANGED	
SHAPE		"	
FINISH		"	
TEMP.		"	
PATT.		"	

TITLE: FISCHER MOD. "G". SHOCKPROOF FLUOROSCOPE SHUTTER OPERATING SPRING CLAMP BUSHING

H. G. FISCHER & CO.
2335 WABANSIA AVE.
CHICAGO, ILL.

CAT. NO.

PART NO. 11324

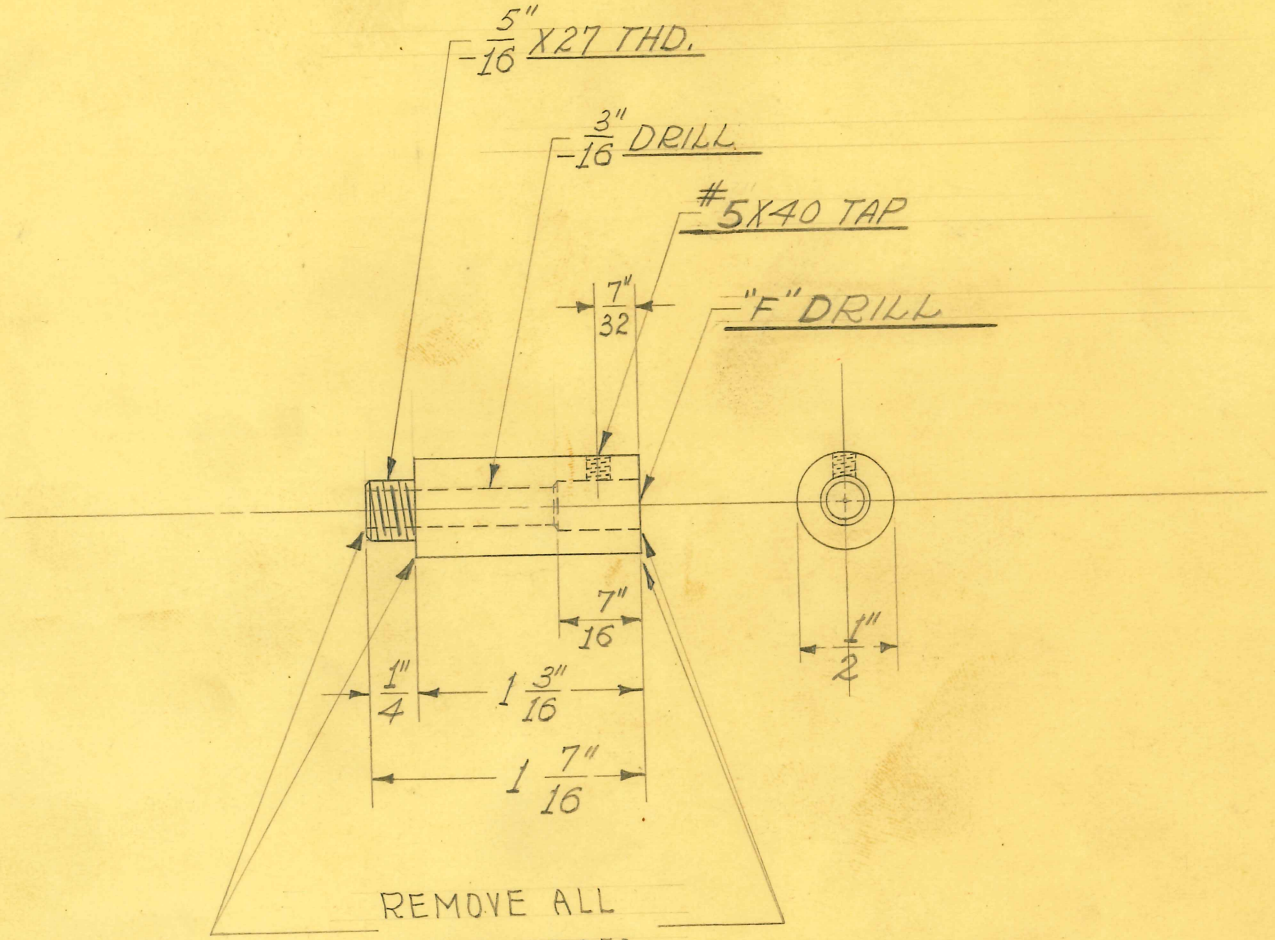

REMOVE ALL SHARP EDGES

2 REQUIRED

OBSOLETE
4-22-80 J.S

SIZE	1/2" DIAM.	ISSUE 2-22-38	J.W.
KIND	BRASS ROD	CHANGED	
SHAPE		"	
FINISH	CAD. #23	"	
TEMP.		"	
PATT.		"	

TITLE: FISCHER MOD. "G" SHOCKPROOF FLUOROSCOPE SHUTTER OPERATING WIRE LEAD BUSHING

H. G. FISCHER & CO.
2335 WABANSIA AVE.
CHICAGO, ILL.

CAT. NO.

PART NO. 11325

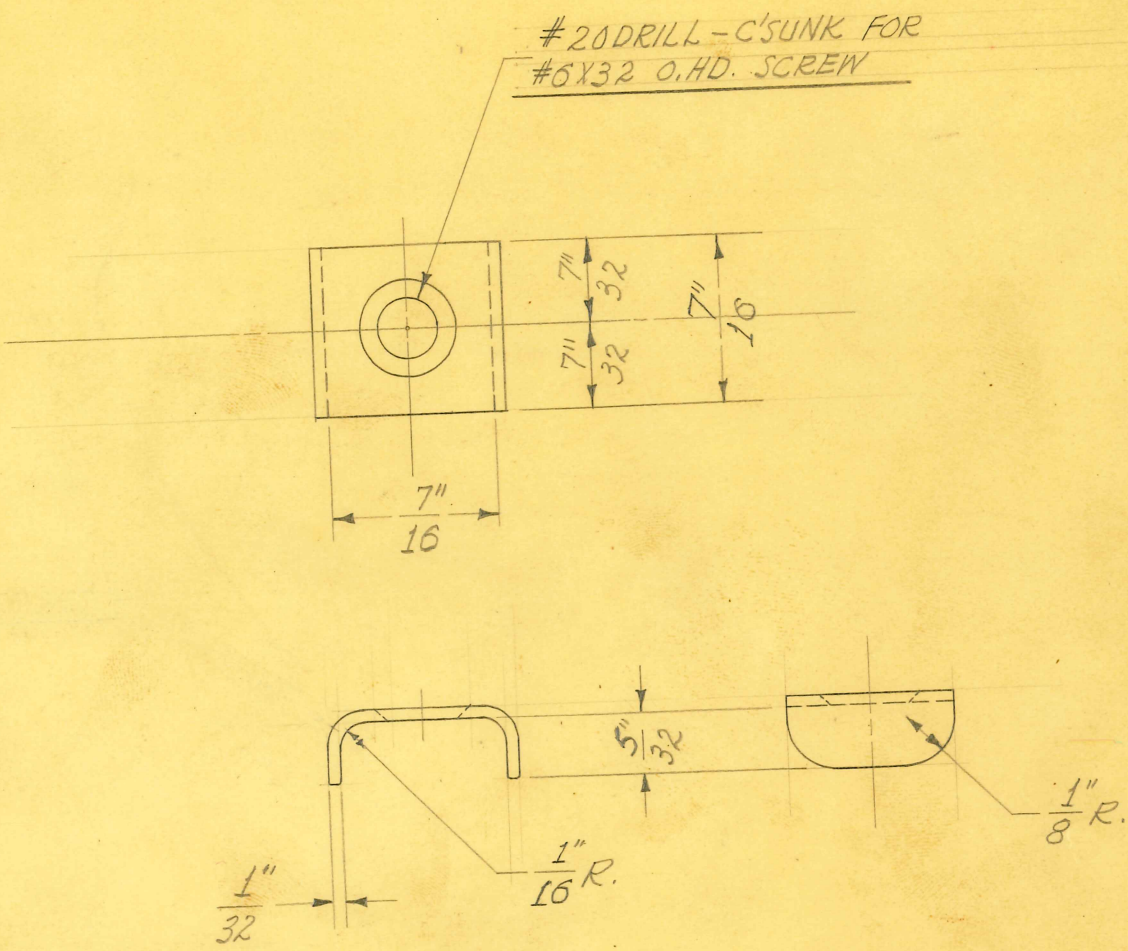

SCALE ÷ DOUBLE SIZE

OBSOLETE
4-22-80 J.S

1 REQUIRED

DEVELOPED LENGTH = 3/4"

SIZE	1/32" SHEET	ISSUE 3-17-38	J.W.
KIND	BRASS	CHANGED	
SHAPE		"	
FINISH	CAD. #23	"	
TEMP.		"	
PATT.		"	

TITLE: FISCHER MOD: "G" SHOCKPROOF FLUOROSCOPE SHUTTER OPERATING SPRING CLAMP

H. G. FISCHER & CO.
2335 WABANSIA AVE.
CHICAGO, ILL.

CAT. NO.

PART NO. 11332

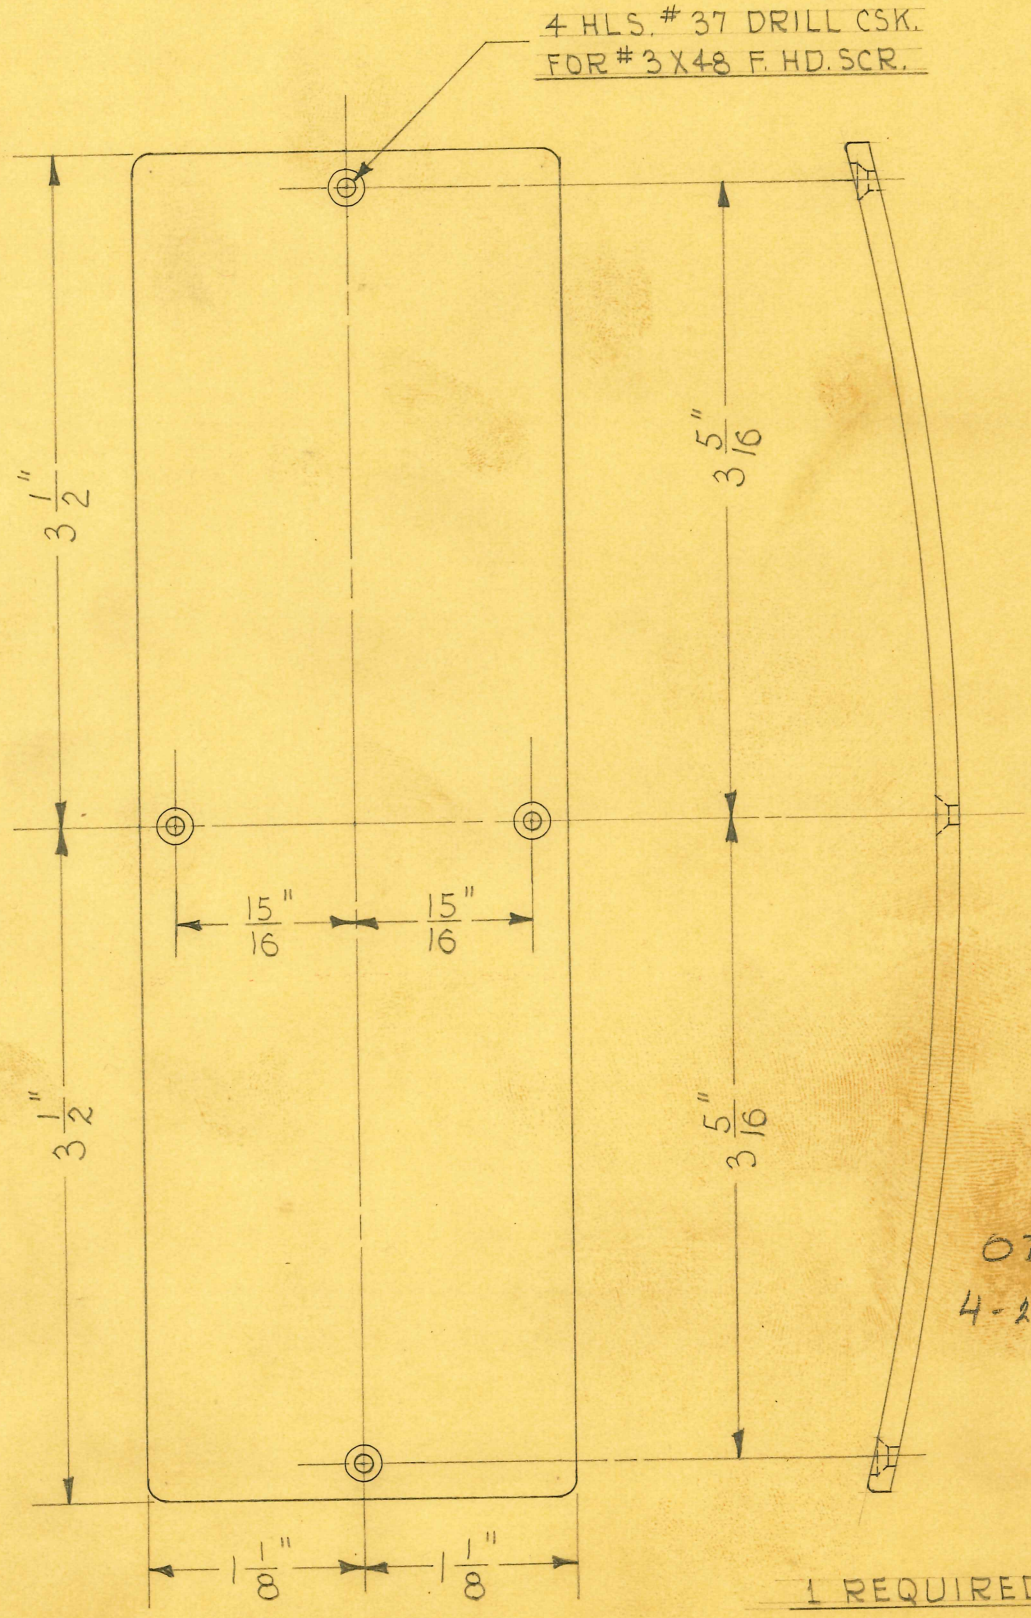

OBSOLETE
4-12-80 J.S.

1 REQUIRED

SIZE	#12	ISSUE 4-13-39	HE.
KIND	ALUM. CASTING	CHANGED	
SHAPE		"	
FINISH		"	
TEMP.		"	
PATT.	1356	"	

TITLE: FISCHER MOD. "G" SHOCKPROOF FLUOROSCOPE - SCREEN FRAME SUPP. ARM - BACK PLATE

H. G. FISCHER & CO.
2335 WABANSIA AVE.
CHICAGO, ILL.

CAT. NO.

PART NO. 11334F

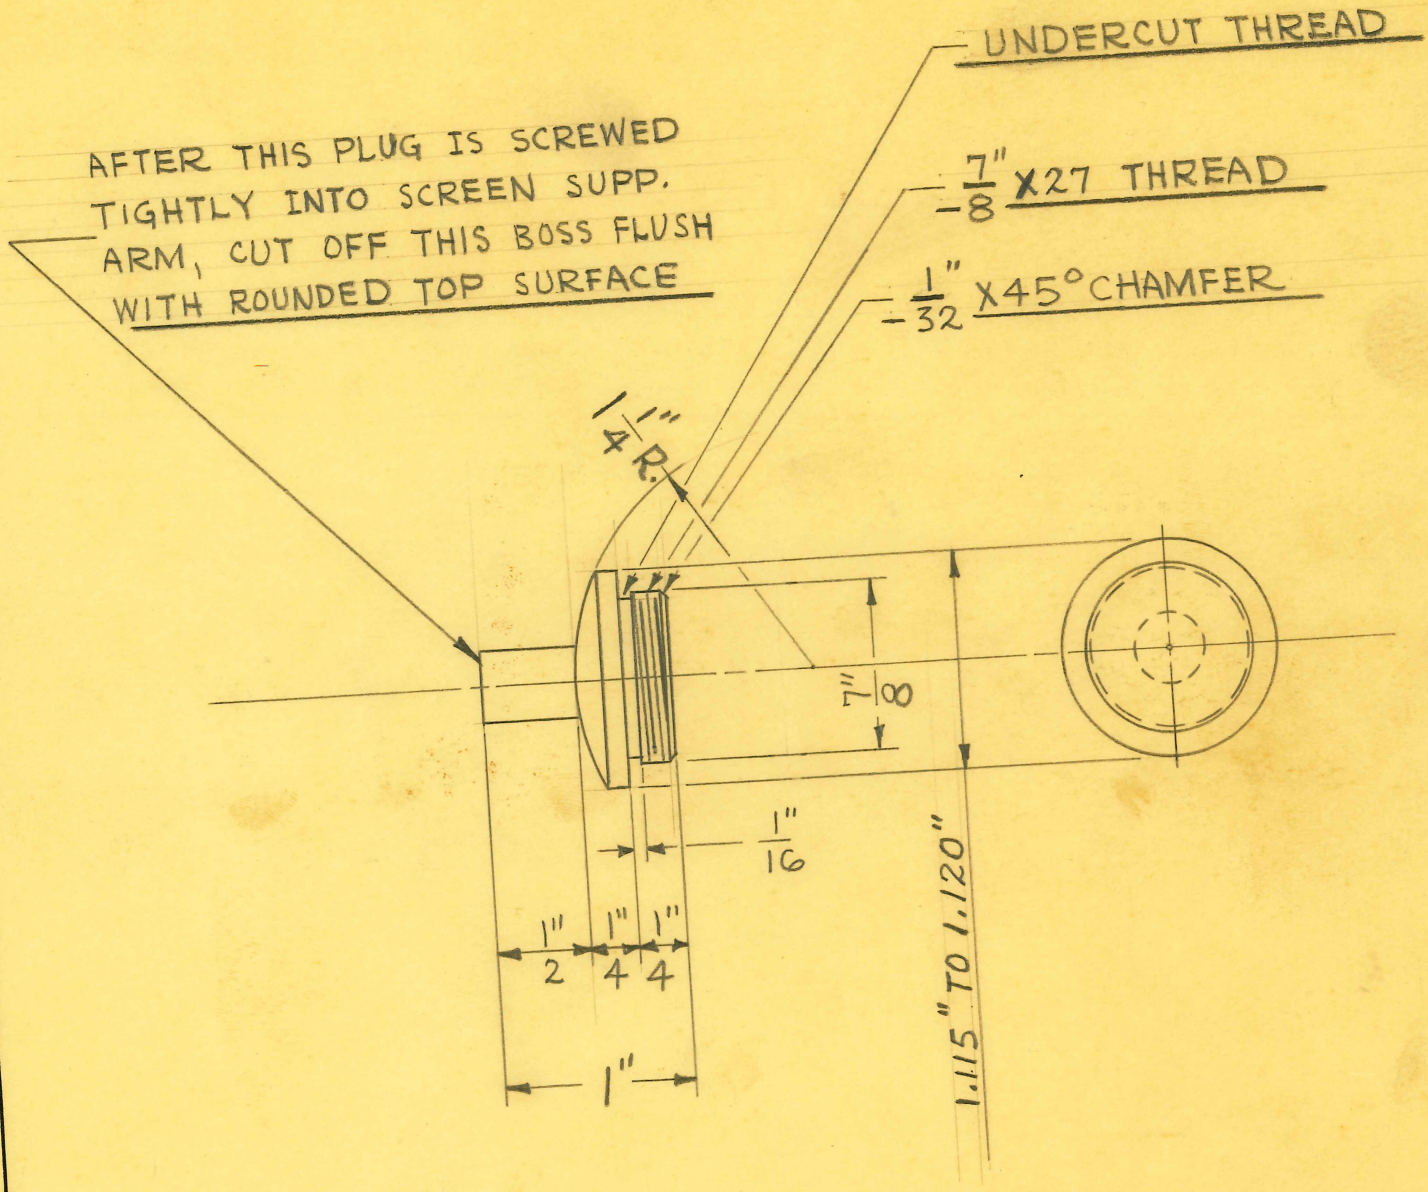

OBSOLETE
4-22-80 J.S.

1 REQUIRED

SIZE	1⅛" DIA.	ISSUE 4-29-46	J.V.W.
KIND	ALUMINUM	CHANGED	
SHAPE	ROD	"	
FINISH		"	
TEMP.		"	
PATT.		"	

TITLE: MOD. "G" SHOCKPROOF FLUOROSCOPE SCREEN FRAME SUPPORTING ARM PLUG

H. G. FISCHER & CO.
2335 WABANSIA AVE.
CHICAGO, ILL.

CAT. NO.

PART NO. 11340A

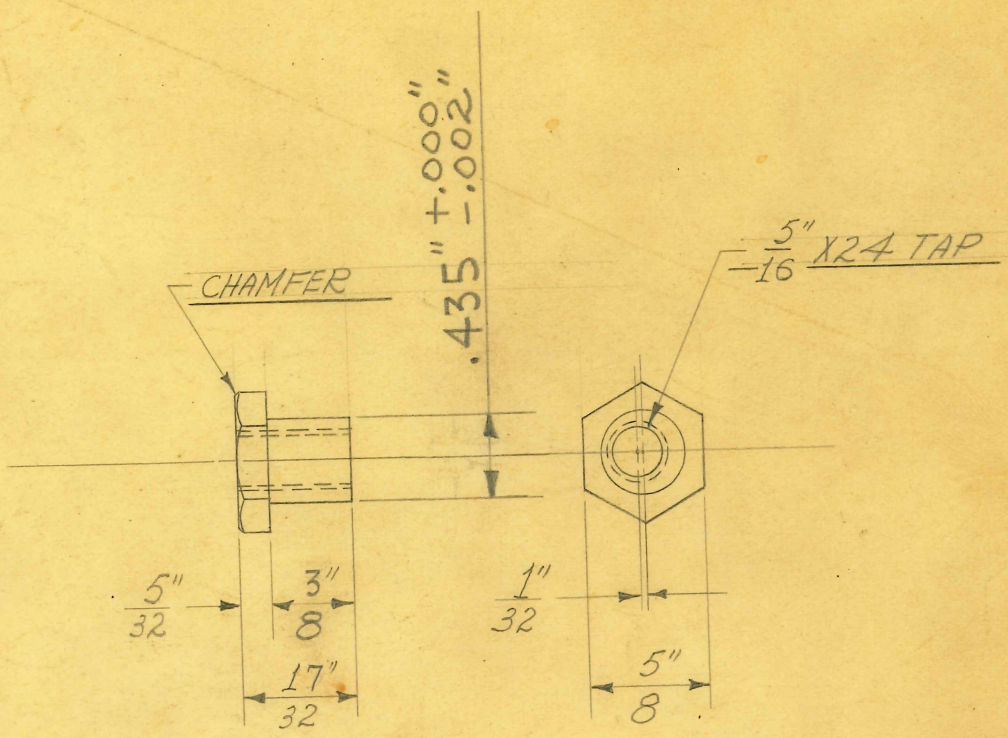

6 REQUIRED

OBSOLETE
4-22-80 J.S

SIZE	5/8" HEX.	ISSUE 3-3-38	J.W.
KIND	C.R. STEEL	H.H.G. CHANGED 9-9-41	J.V.W.
SHAPE	ROD	"	
FINISH	CAD. #23	"	
TEMP.		"	
PATT.		"	

TITLE: FISCHER MOD. "G" SHOCKPROOF FLUOROSCOPE ECCENTRIC BUSHING

H. G. FISCHER & CO.
2335 WABANSIA AVE.
CHICAGO, ILL.

CAT. NO.

PART NO. 11344

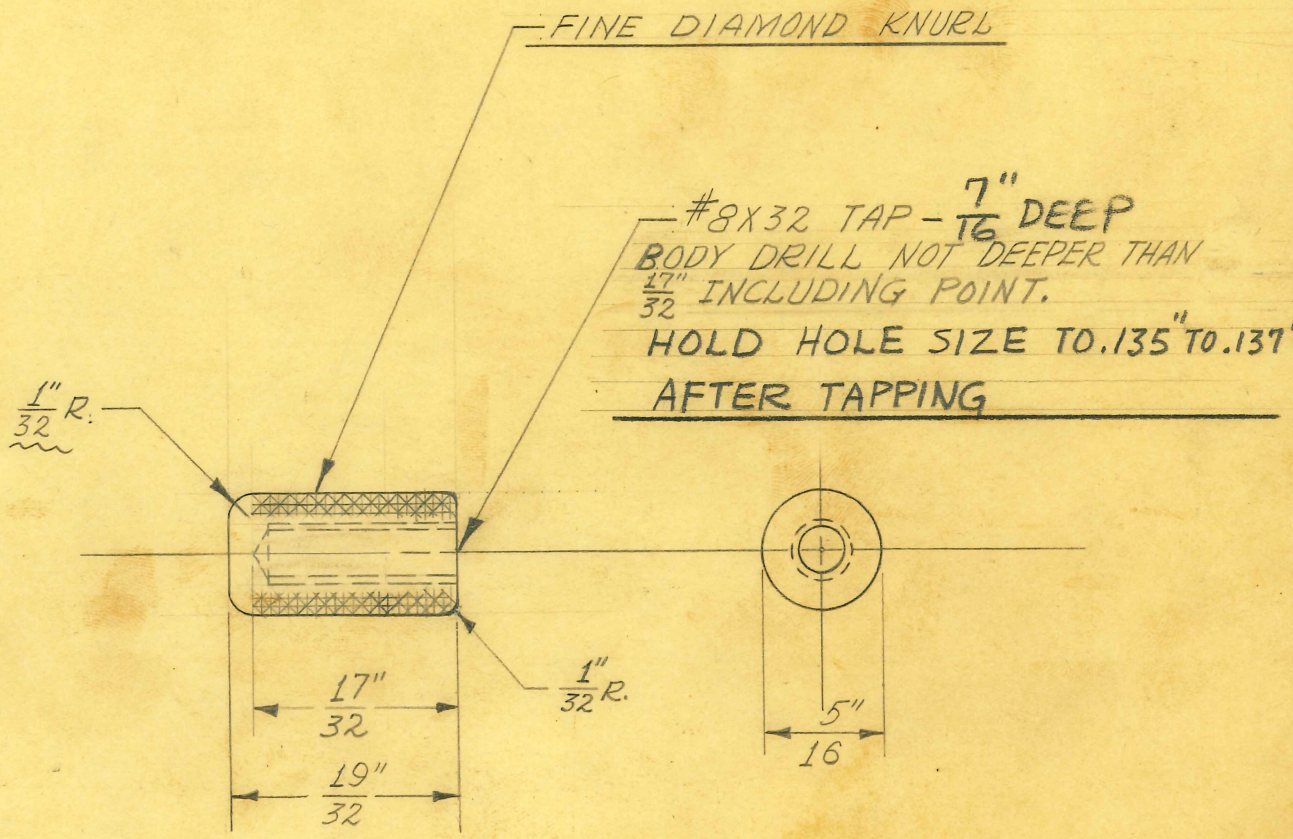

SCALE ~ DOUBLE SIZE

2 REQUIRED

OBSOLETE
4.22-80 J.S.

SIZE	5/16" DIAM.	ISSUE 10-9-39	J.W.
KIND	BRASS ROD	CHANGED	
SHAPE		" 5-6-47	J.V.W.
FINISH		"	
TEMP.		"	
PATT.		"	

TITLE: FISCHER MOD. "G" SHOCKPROOF FLUOROSCOPE TRANSF. - "X-RAY" TUBE MOUNTING SUPPORT INSERT

H. G. FISCHER & CO.
2335 WABANSIA AVE.
CHICAGO, ILL.

CAT. NO.

PART NO. 11348

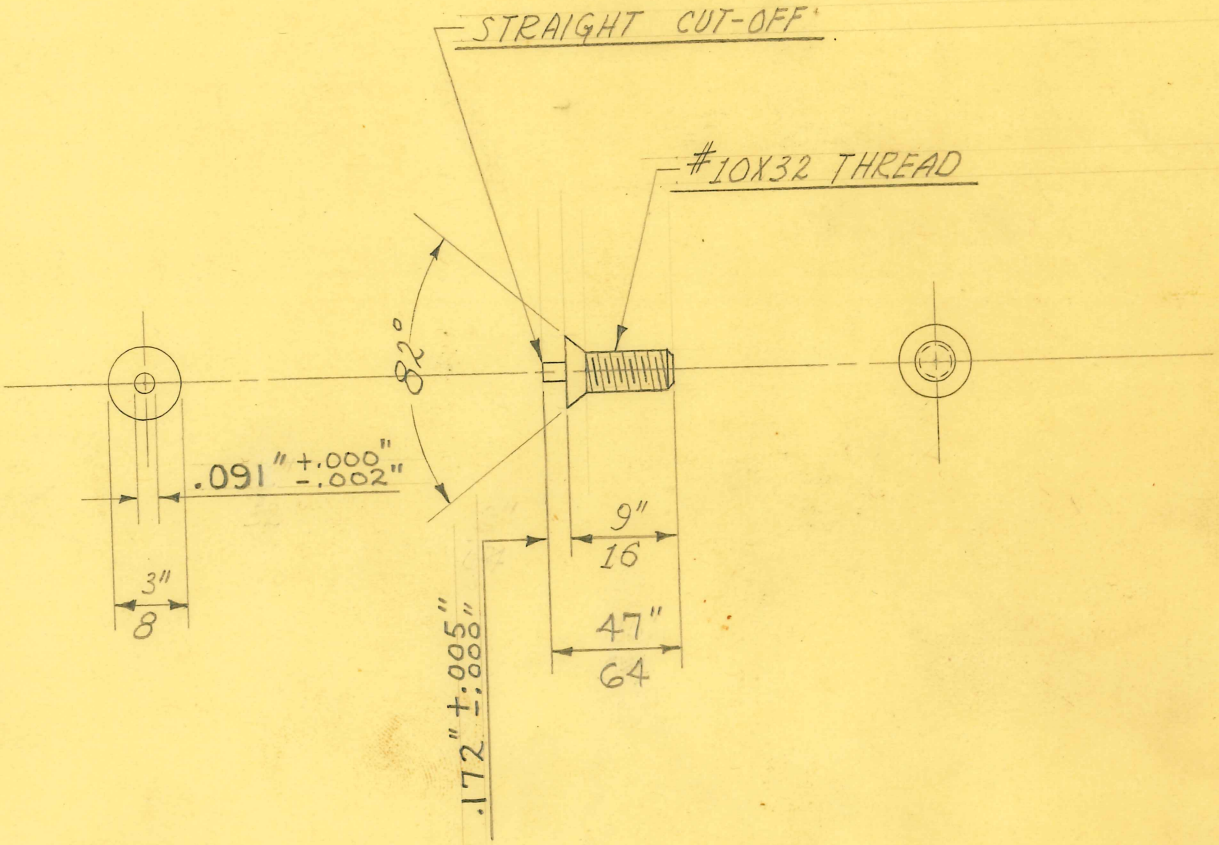

12 REQUIRED

OBSOLETE
4-22-80 J.S

SIZE	3/8" DIAM.	ISSUE 2-25-38	J.W.
KIND	C.R. STEEL	CHANGED	
SHAPE	ROD	" 6-20-46	J.W.
FINISH		"	
TEMP.		"	
PATT.		"	

TITLE: FISCHER MOD. "G" SHOCKPROOF FLUOROSCOPE SIDE COVER SCREW STUD-LONG

H. G. FISCHER & CO.
2335 WABANSIA AVE.
CHICAGO, ILL.

CAT. NO.

PART NO. 11352

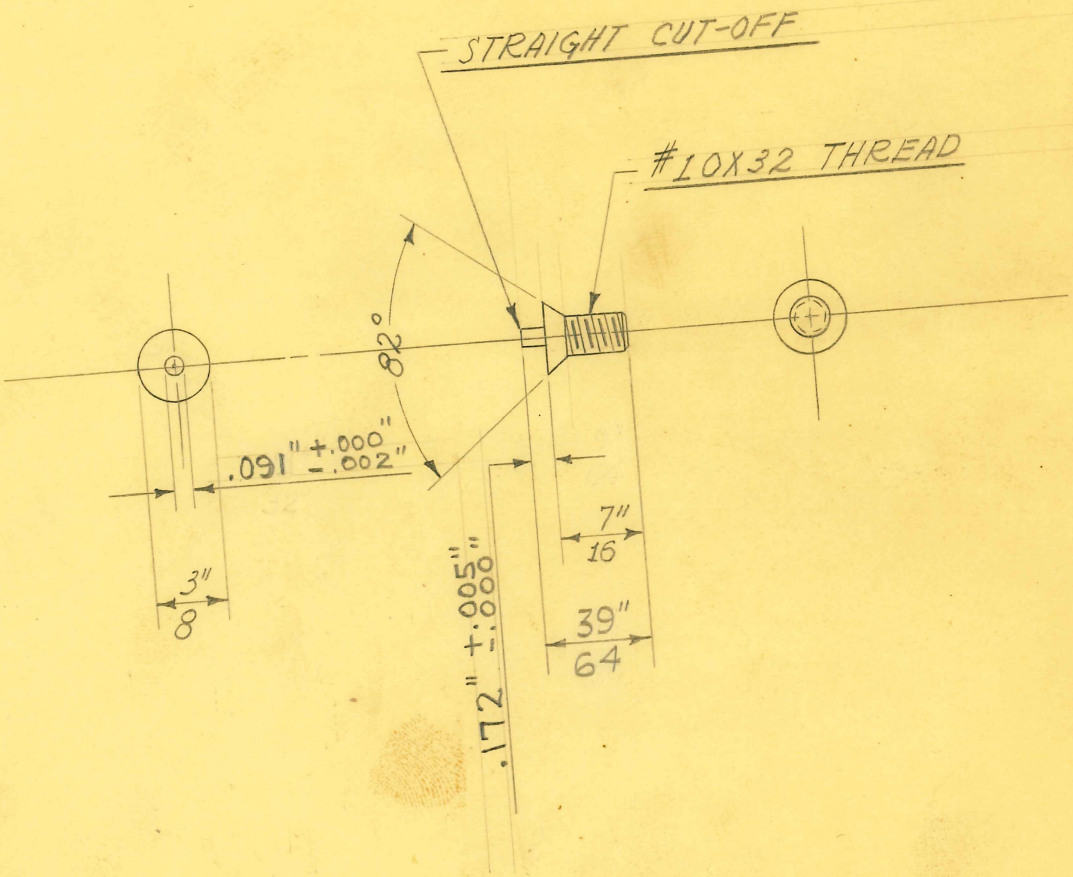

28 REQUIRED

OBSOLETE
4-22-80 J.S.

SIZE	3/8" DIAM.	ISSUE 2-25-38	J.W.	TITLE: FISCHER MOD. "G" SHOCKPROOF FLUOROSC
KIND	C.R. STEEL	CHANGED		SIDE COVER SCREW STUD - SHORT
SHAPE	ROD	" 6-20-46	J.V.W.	
FINISH		"		
TEMP.		"		
PATT.		"		

H. G. FISCHER & CO.
2335 WABANSIA AVE.
CHICAGO, ILL.

CAT. NO.

PART NO. 11353

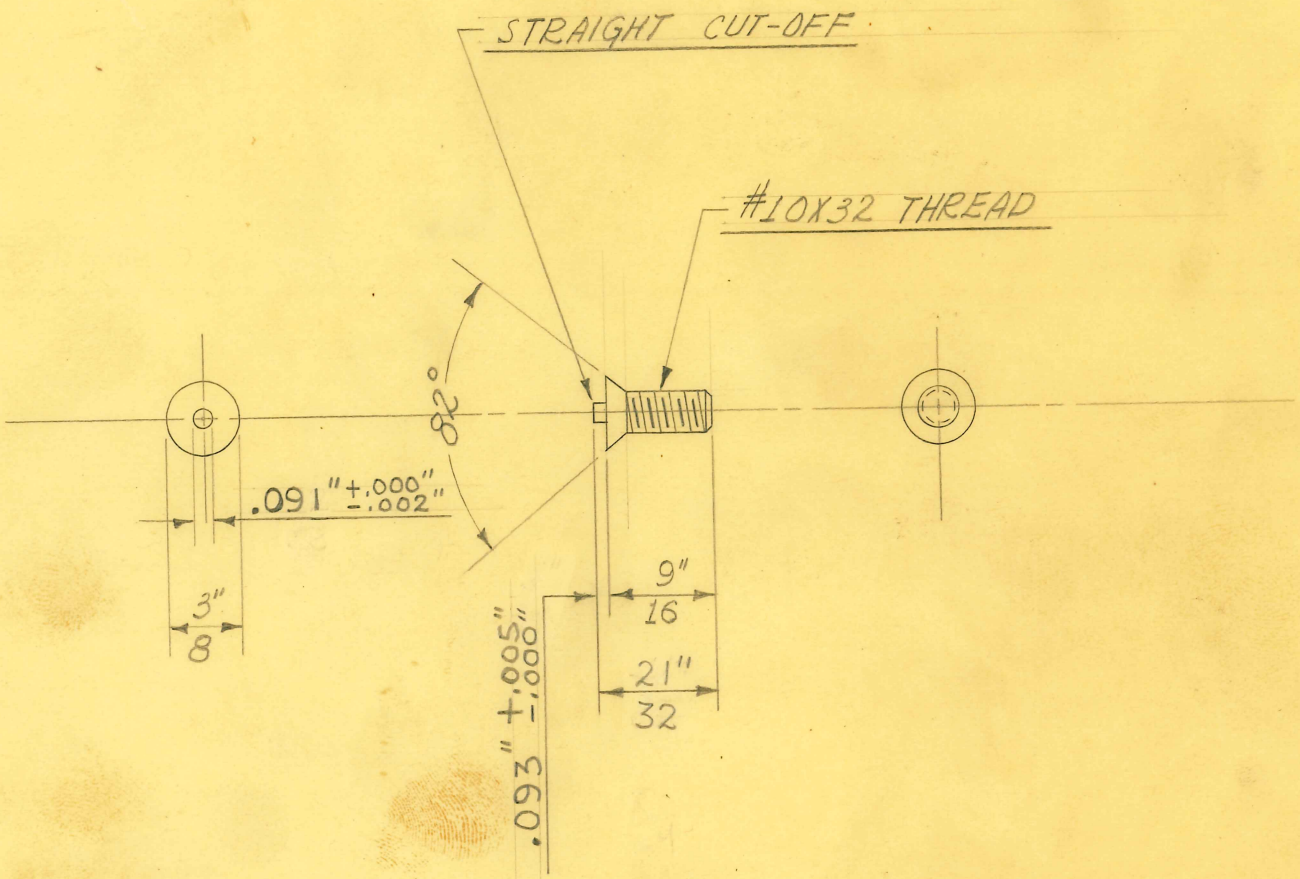

4 REQUIRED

OBSOLETE
4-22-80 J.S.

SIZE	3/8" DIAM.	ISSUE 2-25-38	J.W.
KIND	C.R. STEEL	CHANGED	
SHAPE	ROD	"	
FINISH		"	
TEMP.		"	
PATT.		"	

TITLE: FISCHER MOD. "G" SHOCKPROOF FLUOROSCOPE PANEL STRIP — SCREW STUD

H. G. FISCHER & CO.
2335 WABANSIA AVE.
CHICAGO, ILL.

CAT. NO.

PART NO. 11354

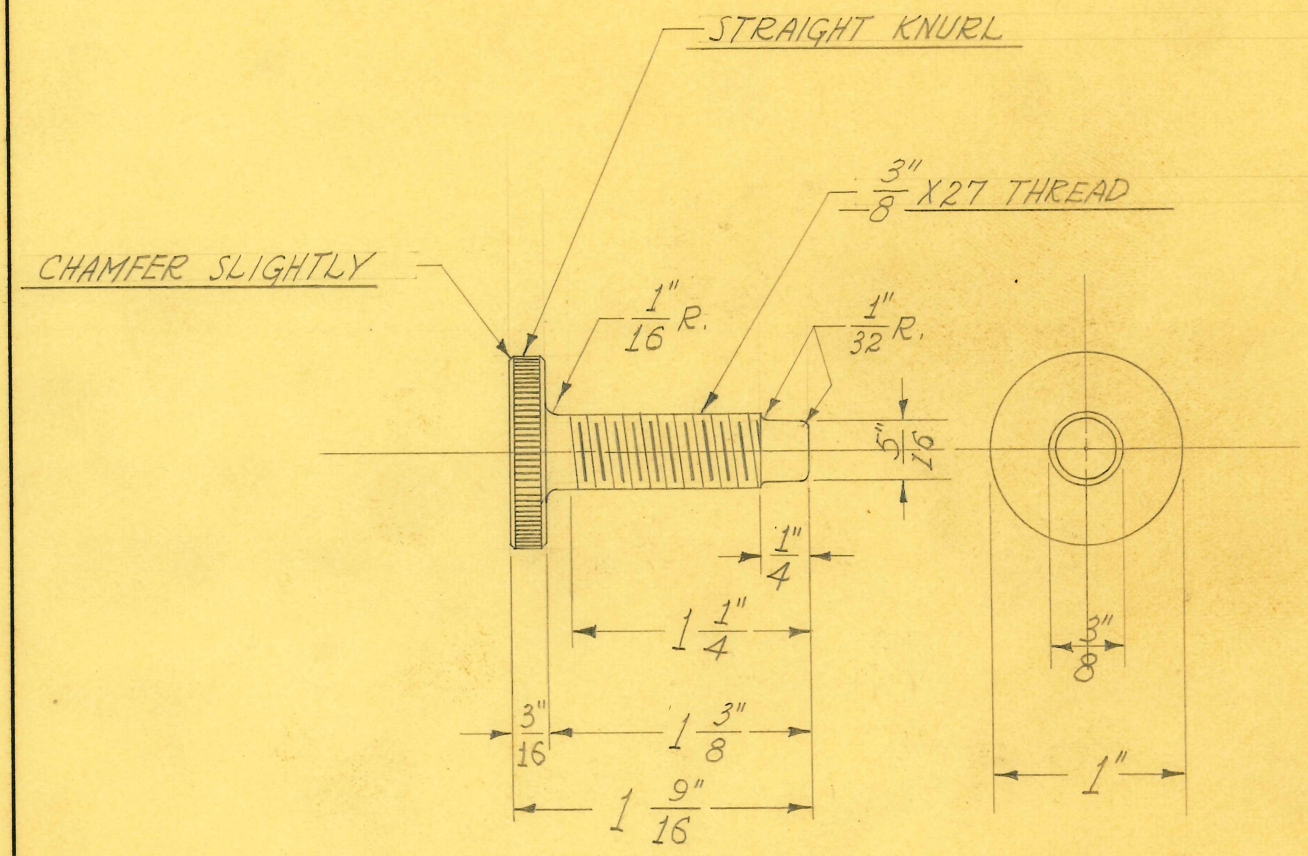

1 REQUIRED

OBSOLETE
4-22-80 J.S

SIZE	1" DIAM.	ISSUE 7-26-38	J.W.
KIND	BRASS ROD	CHANGED	
SHAPE		"	
FINISH	CAD. #23	"	
TEMP.		"	
PATT.		"	

TITLE: FISCHER MOD. "G" SHOCKPROOF FLUOROSCOPE SLIDE - LOCKING THUMB SCREW

H. G. FISCHER & CO.
2335 WABANSIA AVE.
CHICAGO, ILL.

CAT. NO.

PART NO. 11364

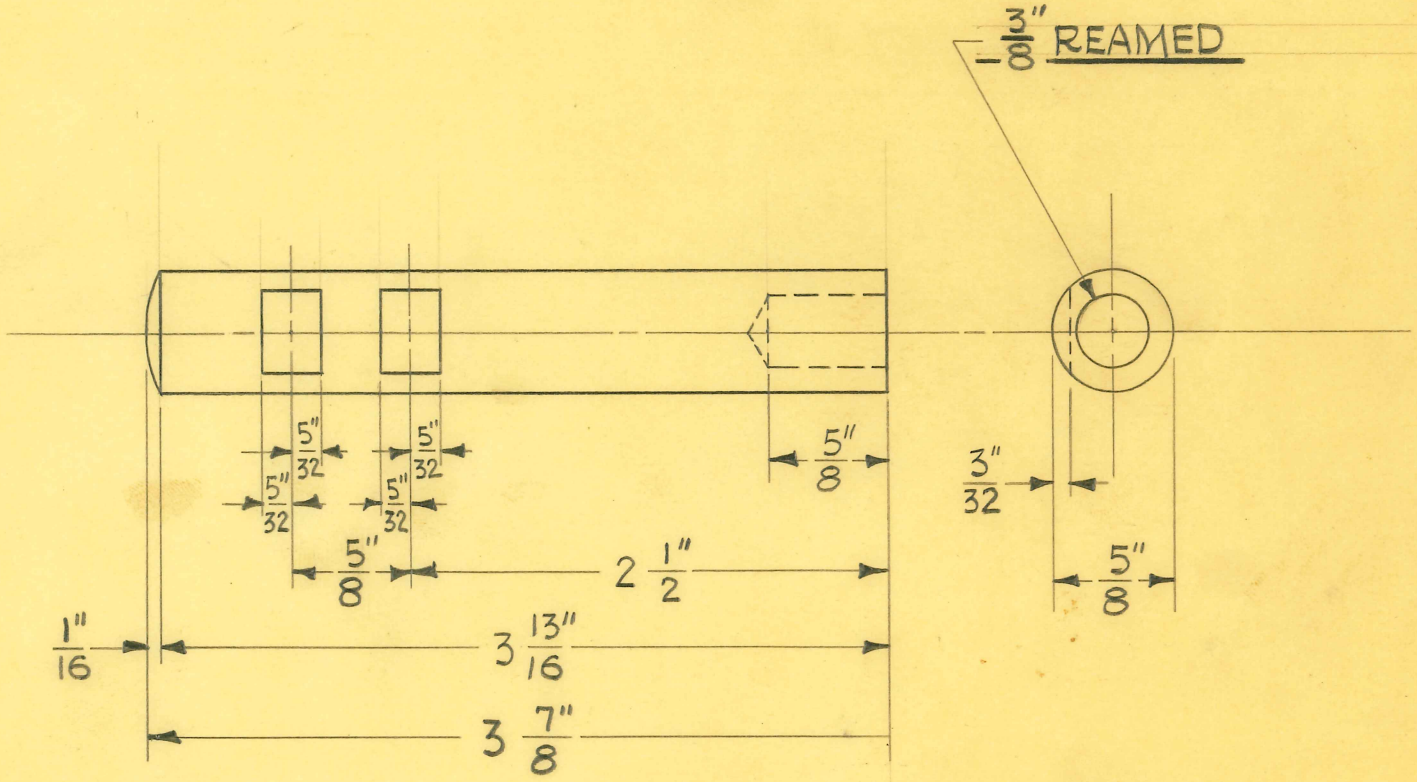

1 REQUIRED

OBSOLETE
4-22-80- J.S.

SIZE	5/8" DIA.	ISSUE 3-20-42	J.V.W.
KIND	JEWELERS	CHANGED	
SHAPE	ROD	"	
FINISH		"	
TEMP.		"	
PATT.		"	

TITLE:
FISCHER MOD. "G" SHOCKPROOF FLUOROSCOPE
SCREEN FORK SHAFT

H. G. FISCHER & CO.
2335 WABANSIA AVE.
CHICAGO, ILL.

CAT. NO.

PART NO. 11366B

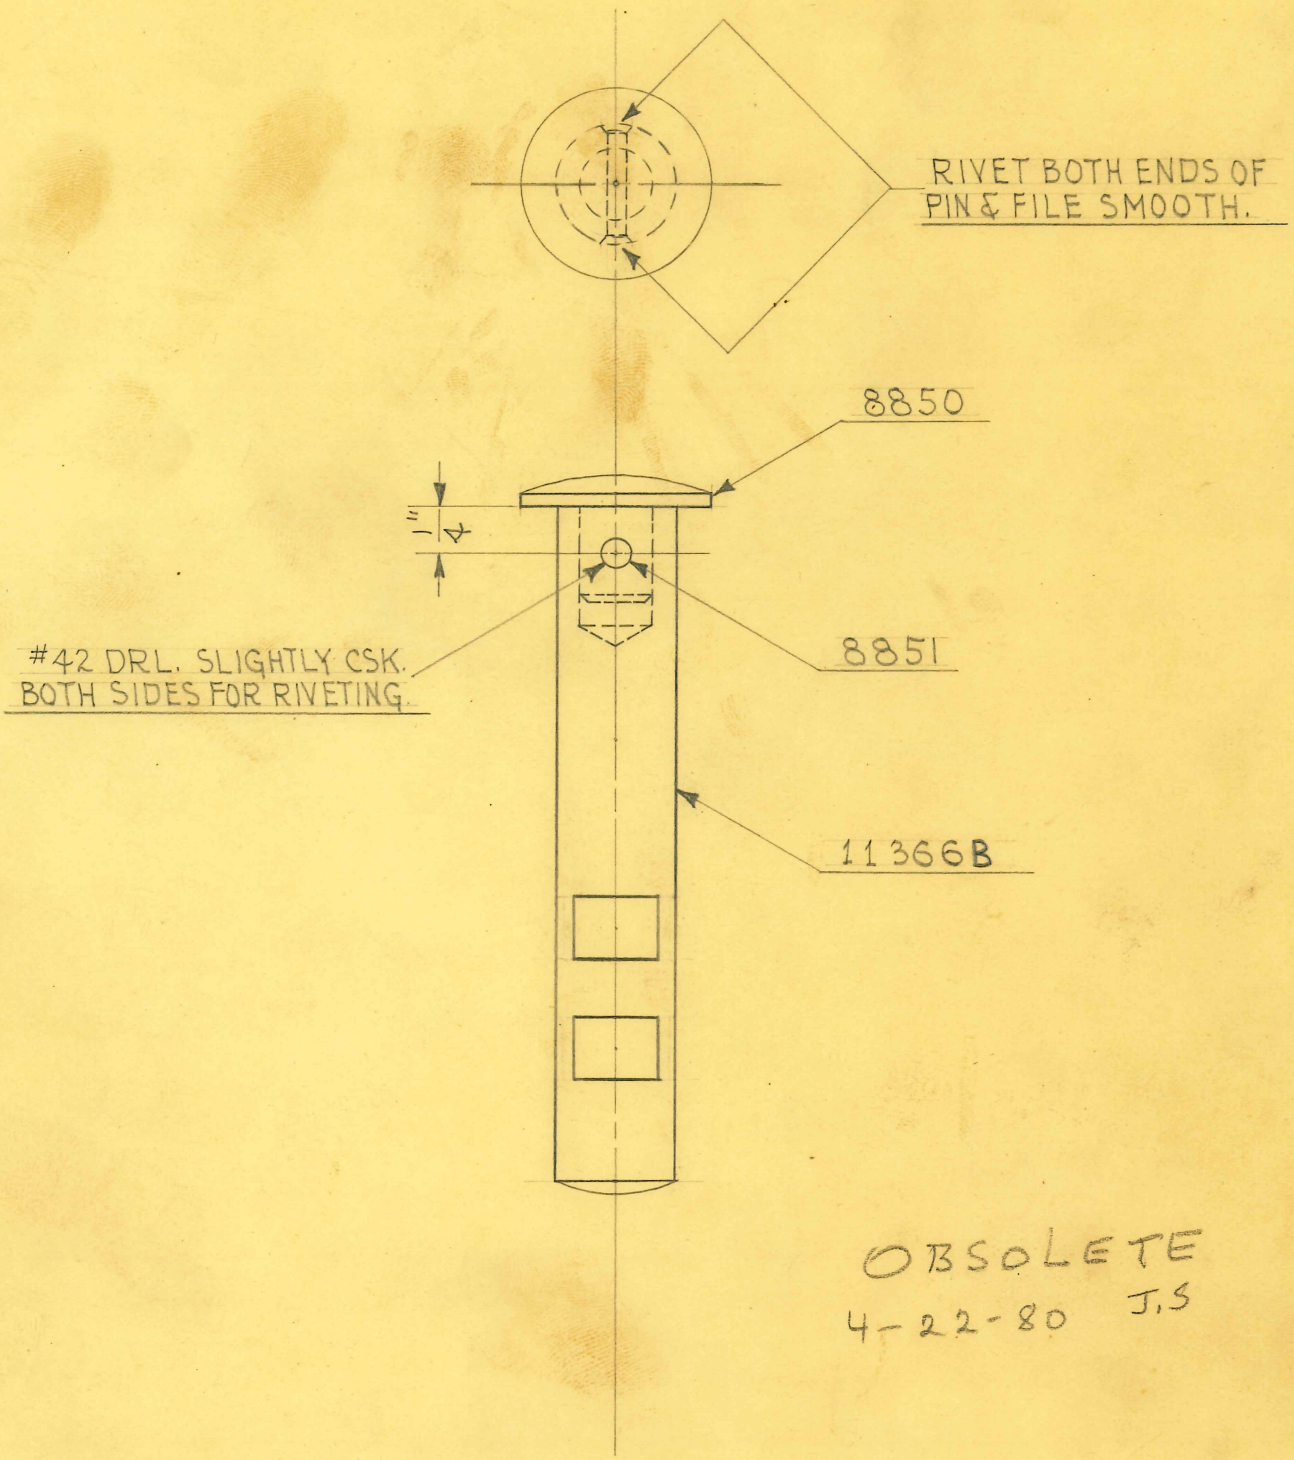

OBSOLETE
4-22-80 J.S

1 REQUIRED

SIZE		ISSUE 3-1-38	A.E.
KIND		CHANGED 6-30-38	H.E.
SHAPE		"	
FINISH	CAD. #23	"	
TEMP.		"	
PATT.		"	

TITLE: FISCHER MOD. "G" SHOCKPROOF FLUOROSCOPE-SCREEN FORK SHAFT ASSEM.

H. G. FISCHER & CO.
2335 WABANSIA AVE.
CHICAGO, ILL.

CAT. NO.

PART NO. 11366GB

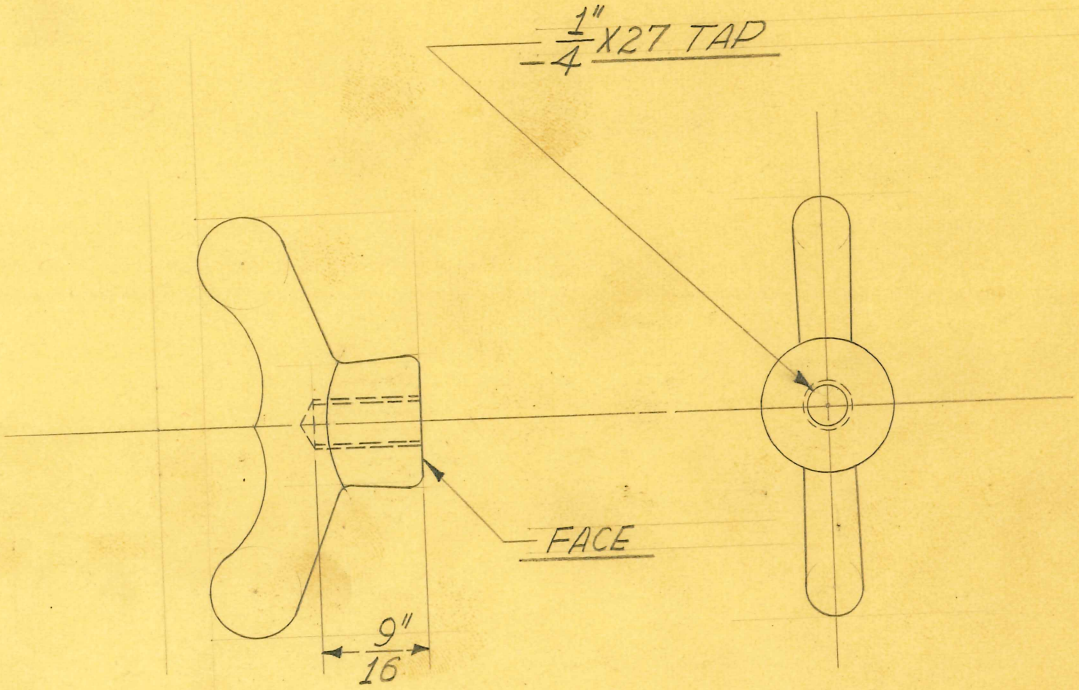

1 REQUIRED

OBSOLETE
4-22-80 J.S

SIZE	FROM #5705	ISSUE 9-23-38	J.W.
KIND	IRON CASTING	CHANGED	
SHAPE		"	
FINISH	CAD. #23	"	
TEMP.		"	
PATT.		"	

TITLE: FISCHER MOD. "G" SHOCKPROOF FLUOROSCOPE SCREEN FORK LOCK SHAFT WING NUT

H. G. FISCHER & CO.
2335 WABANSIA AVE.
CHICAGO, ILL.

CAT. NO.

PART NO. 11366 3/4

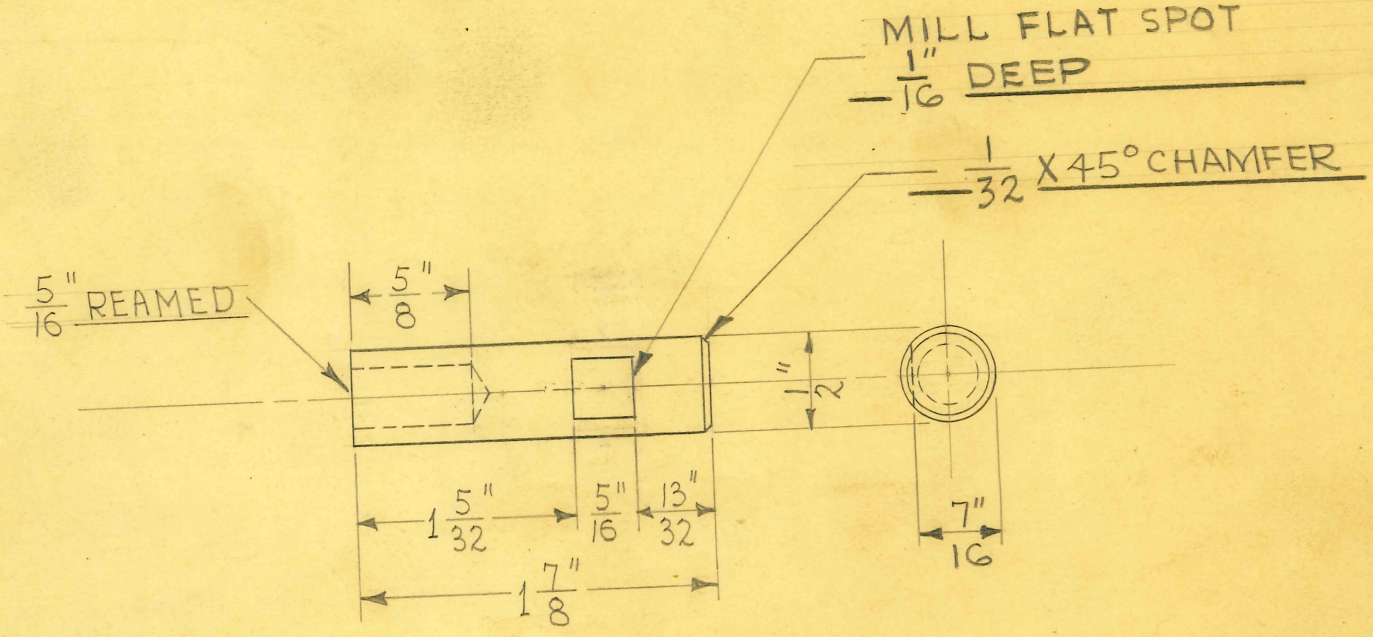

2 REQUIRED

OBSOLETE
4-22-80 J.S.

SIZE	½" DIAM.	ISSUE 4-14-38	A.E.	TITLE: FISCHER MOD. "G" SHOCKPROOF FLUOROSCOPE-SCREEN FORK SWIVEL SHAFT
KIND	C.R. STEEL	CHANGED		
SHAPE		" 12-13-46	J.N.W.	
FINISH		"		
TEMP.		"		
PATT.		"		

H. G. FISCHER & CO.
2335 WABANSIA AVE.
CHICAGO, ILL.

CAT. NO.

PART NO. 11367

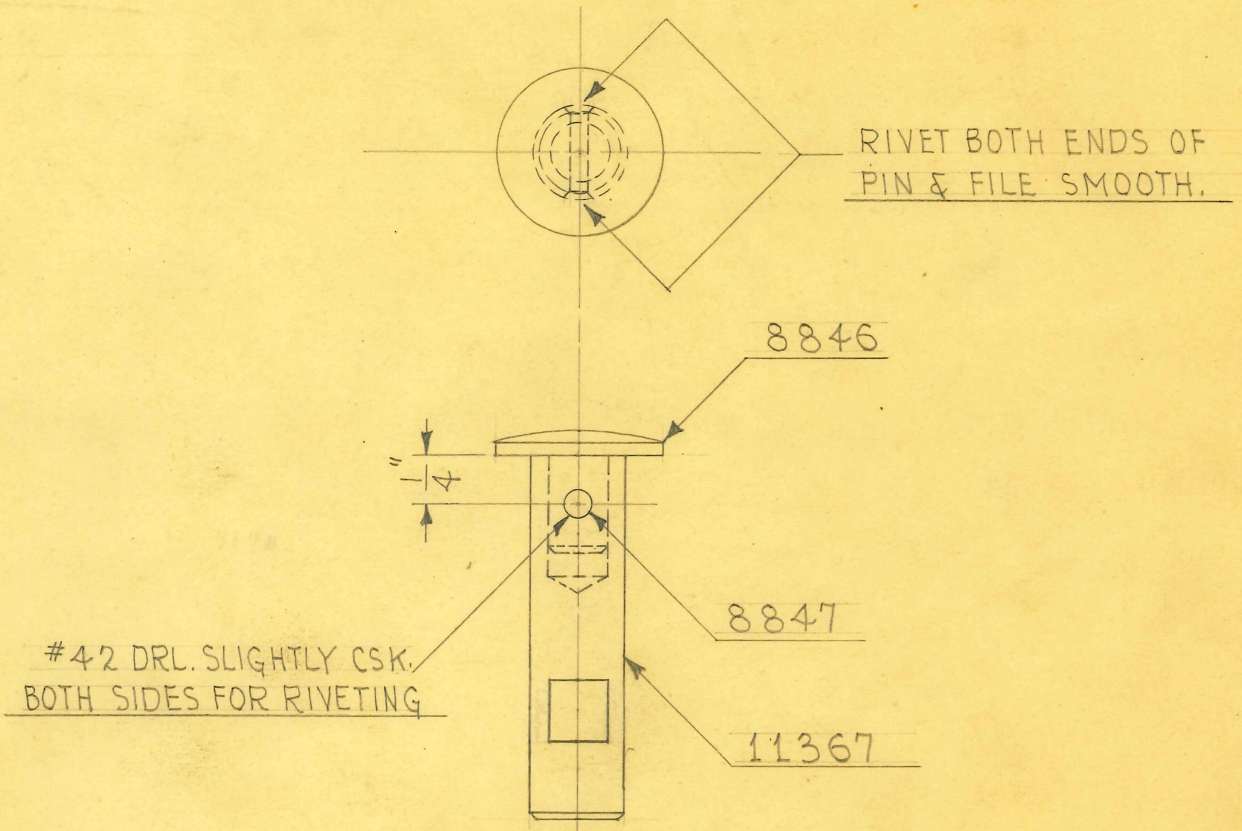

2 REQUIRED

OBSOLETE
4-22-80 J.S.

SIZE		ISSUE 4-15-38	J.E.
KIND		CHANGED	
SHAPE		" 12-13-46	J.V.W.
FINISH	CAD. # 23	"	
TEMP.		"	
PATT.		"	

TITLE:
FISCHER MOD. "G" SHOCKPROOF FLUOROSCOPE-
SCREEN FORK SWIVEL SHAFT ASSEM.

H. G. FISCHER & CO.
2335 WABANSIA AVE.
CHICAGO, ILL.

CAT. NO.

PART NO. 11367G

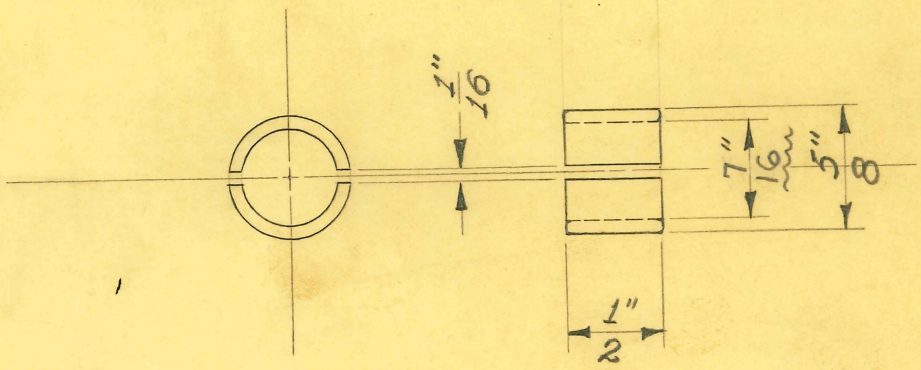

1 SET

OBSOLETE
4-22-80 J.S

· 5/8" O.D. X 7/16" I.D.

SIZE	~~5/8" O.D. X 1/2" I.D.~~	ISSUE 3-22-40	J.W.
KIND	BRASS	CHANGED	
SHAPE	TUBING	"	
FINISH	CAD. #23	"	
TEMP.		"	
PATT.		"	

TITLE: FISCHER. MOD. "GF-15" S.P. FLUOROSCOPE TRANSFORMER CABLE CLAMP BUSHING

H. G. FISCHER & CO.
2335 WABANSIA AVE.
CHICAGO, ILL.

CAT. NO.

PART NO. 11368A

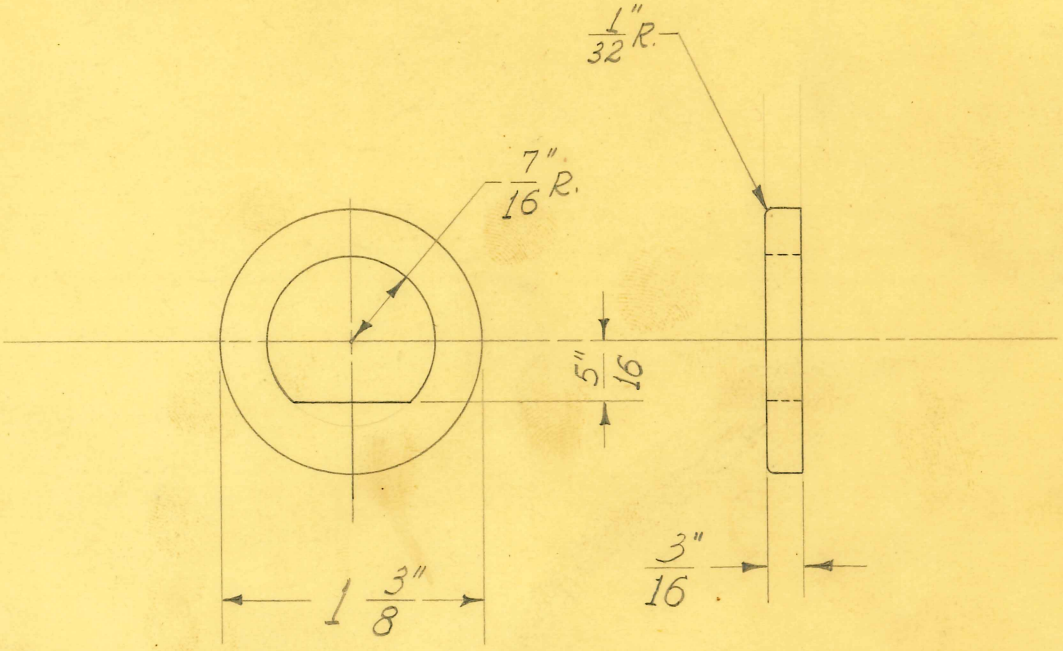

1 REQUIRED

OBSOLETE
4-22-80 J.S.

SIZE	1 3/8" DIAM.	ISSUE 3-1-38	J.W.
KIND	C.R. STEEL	CHANGED	
SHAPE	ROD	"	
FINISH		"	
TEMP.		"	
PATT.		"	

TITLE:
FISCHER MOD. "G" SHOCKPROOF FLUOROSCOPE
TRANSF. SWIVEL SUPP. STUD "D" WASHER

H. G. FISCHER & CO.
2335 WABANSIA AVE.
CHICAGO, ILL.

CAT. NO.

PART NO. 11370

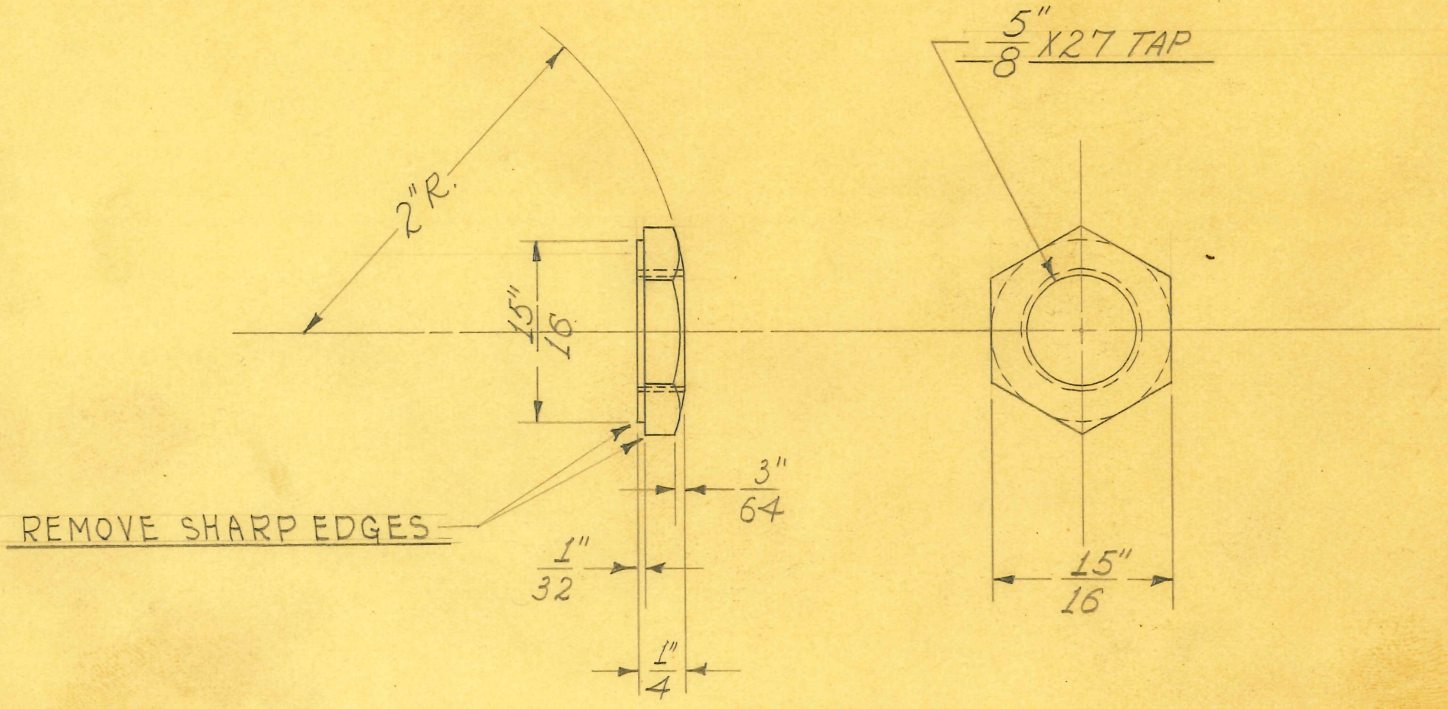

2 REQUIRED

OBSOLETE
4-22-80 J.S.

SIZE	15/16" HEX.	ISSUE 7-15-38	J.W.
KIND	C.R. STEEL	CHANGED	
SHAPE	ROD	"	
FINISH	CAD. #23	"	
TEMP.		"	
PATT.		"	

TITLE: FISCHER MOD. "G" SHOCKPROOF FLUOROSCOPE SCREEN FRAME SUPPORT ARM CLAMP NUT

H. G. FISCHER & CO.
2335 WABANSIA AVE.
CHICAGO, ILL.

CAT. NO.

PART NO. 11371 1/2

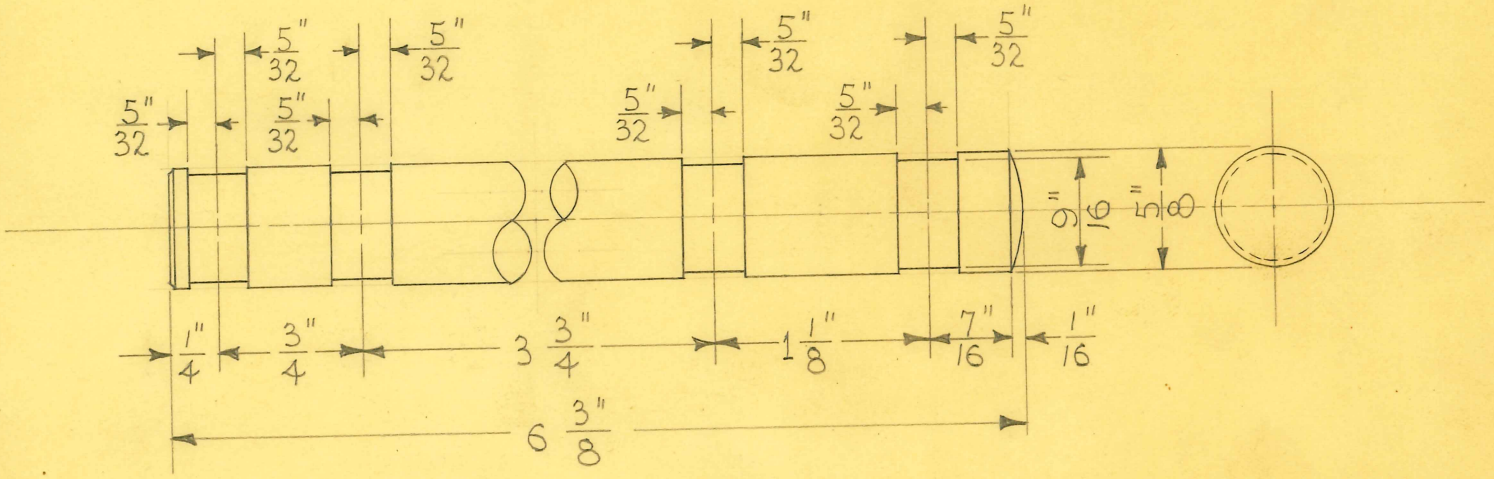

2 REQUIRED

OBSOLETE
4-22-80 J.S

SIZE	5/8" DIAM.	ISSUE 3-24-38	A.E.
KIND	JEWELERS ROD	CHANGED	
SHAPE		"	
FINISH	CAD. #23	"	
TEMP.		"	
PATT.		"	

TITLE: FISCHER MOD. "G" SHOCKPROOF FLUOROSCOPE-SCREEN FRAME SUPP. ARM BRACE ROD

H. G. FISCHER & CO.
2335 WABANSIA AVE.
CHICAGO, ILL.

CAT. NO.

PART NO. 11373

TITLE
FISCHER MOD. "G" SHOCKPROOF FLUOR. SCREEN FRAME SUPP. ARM ADJ. NUT

H. G. FISCHER & CO.
FRANKLIN PARK, ILLINOIS

DATE 5-6-49 | DR. BY W. J. | CH'K'D. J.V.W.

PART NO. 11373 1/2 A

PATTERN | FINISH CAD. # 23 | SCALE FULL

TOOLS: DRILL JIG # 6766

MATERIAL: 1" DIA. C.R. STEEL ROD

DIMENSIONS UNLESS OTHERWISE SPECIFIED
FRACTIONAL ± .015
DECIMAL ± .005
ANGULAR ± 1/2°

REVISION		DATE	BY
A	WAS 15/16"	6-2-49	J.V.W.

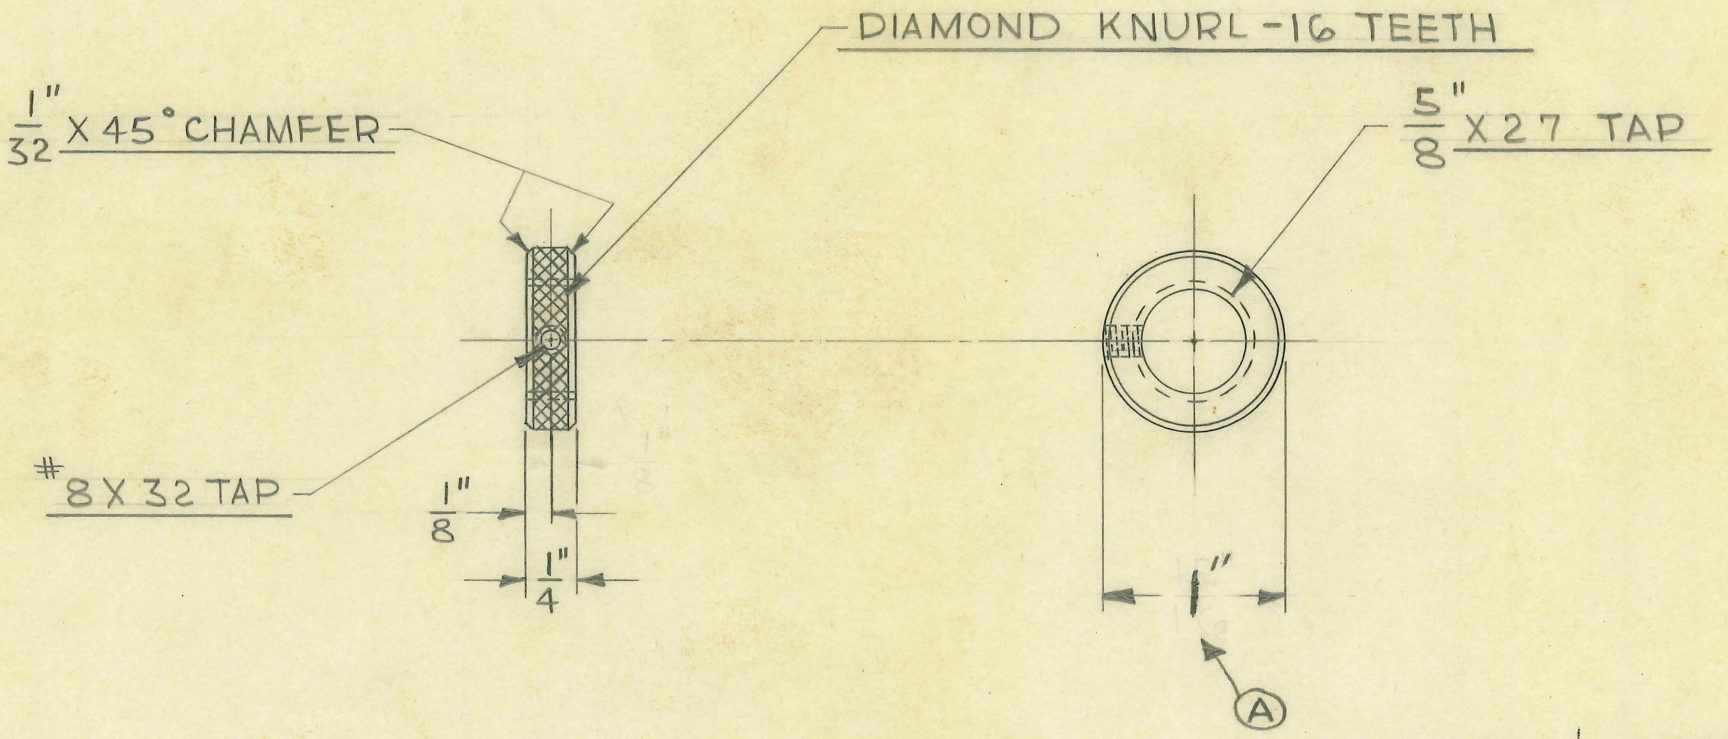

2 REQUIRED

OBSOLETED
4-22-80 J.S

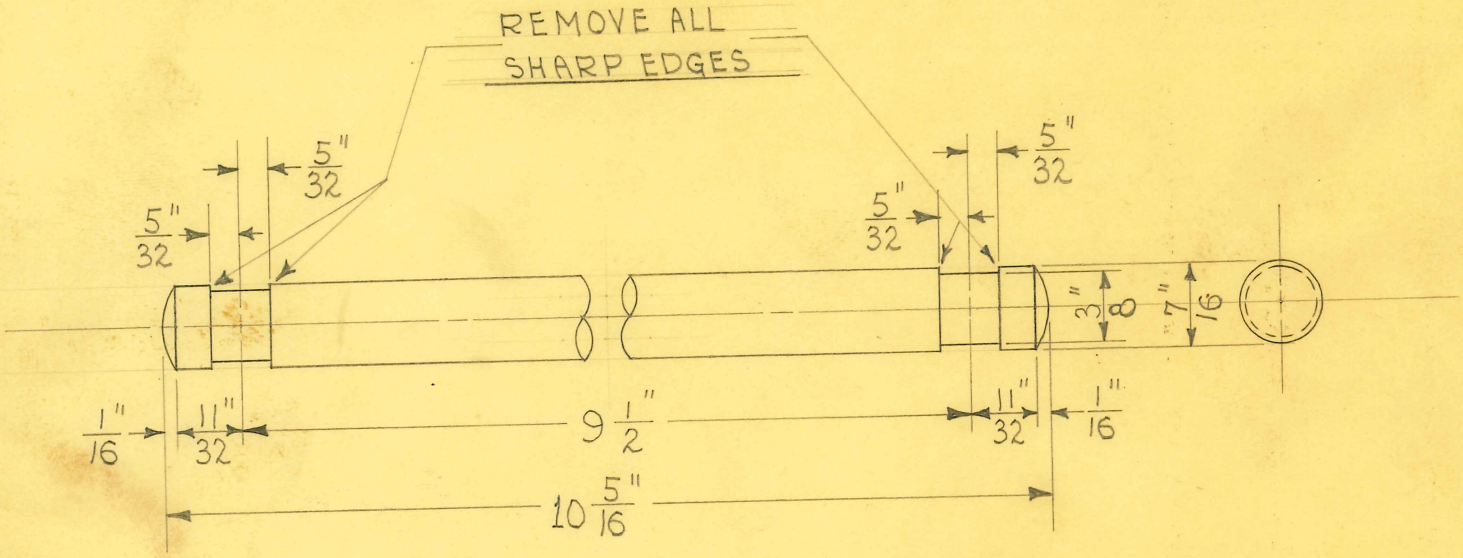

2 REQUIRED.

OBSOLETE
4-22-80 J.S

SIZE	7/16" DIAM.	ISSUE 3-24-38	A.E.
KIND	JEWELERS ROD	CHANGED	
SHAPE		"	
FINISH	CAD. #23	"	
TEMP.		"	
PATT.		"	

TITLE: FISCHER MOD. "G" SHOCKPROOF FLUOROSCOPE-TRANSF. SUPP. ARM ROD - LONG

H. G. FISCHER & CO.
2335 WABANSIA AVE.
CHICAGO, ILL.

CAT. NO.

PART NO. 11375

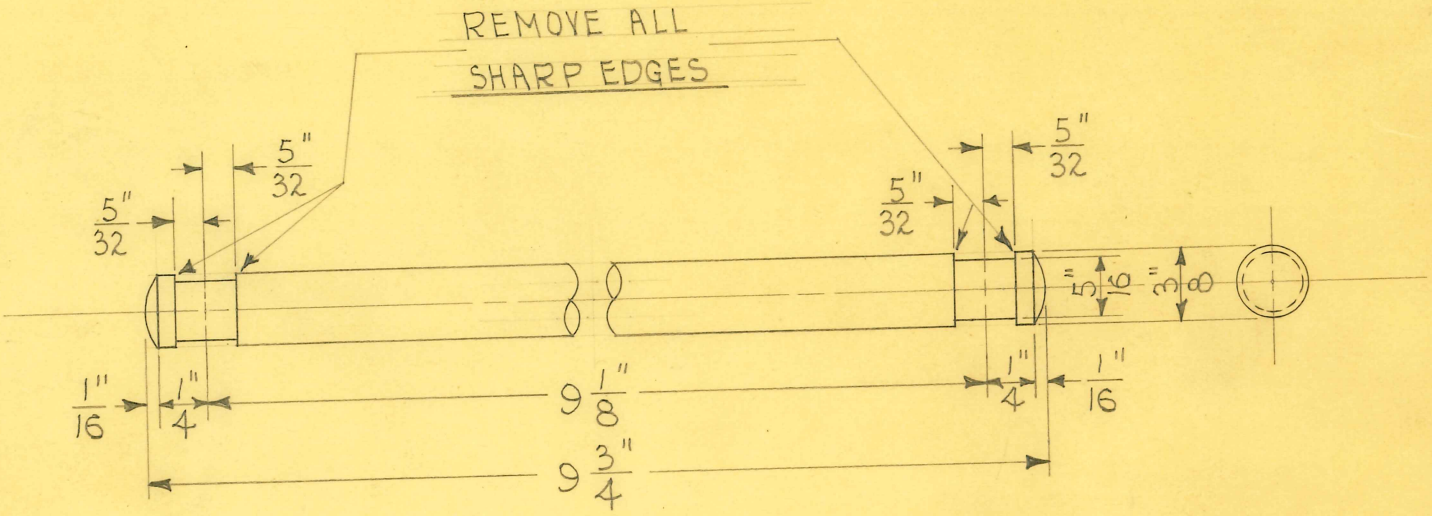

2 REQUIRED

OBSOLETED
4-22-80 J.S.

SIZE	3/8" DIAM.	ISSUE 3-24-38	A.E.
KIND	JEWELERS ROD	CHANGED	
SHAPE		"	
FINISH	CAD. #23	"	
TEMP.		"	
PATT.		"	

TITLE: FISCHER MOD. "G" SHOCKPROOF FLUOROSCOPE-TRANSF. SUPP. ARM ROD - SHORT

H. G. FISCHER & CO.
2335 WABANSIA AVE.
CHICAGO, ILL.

CAT. NO.

PART NO. 11376

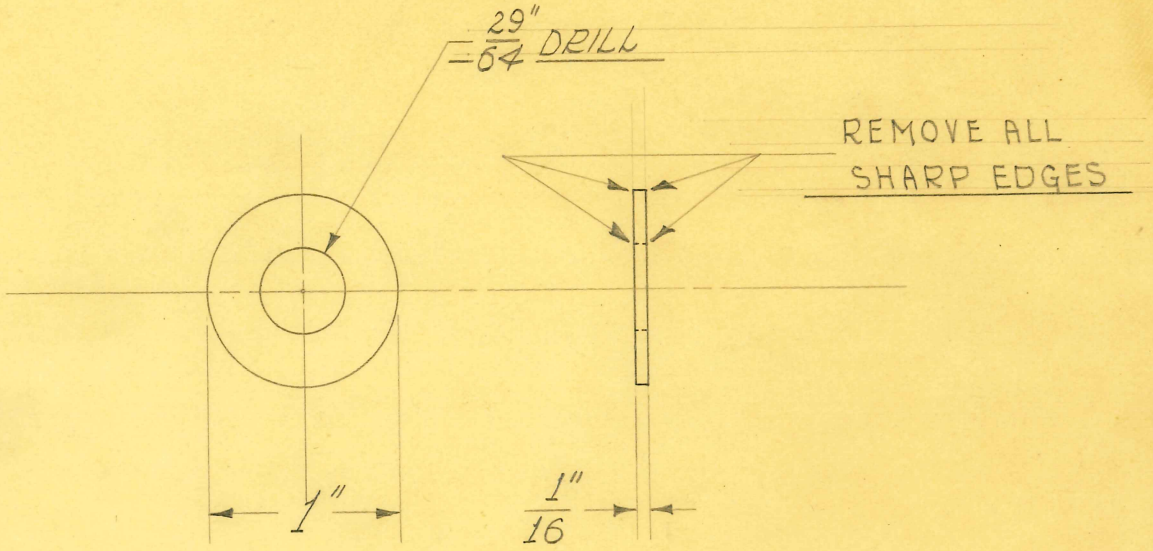

4 REQUIRED

OBSOLETE
H-22-80 J.S.

1/16" X 1 1/4" SHEARED C.R. STEEL

SIZE	~~1" DIAM.~~	ISSUE 3-2-38	J.W.
KIND	~~C.R. STEEL~~	CHANGED	
SHAPE	~~ROLL~~	"	
FINISH	CAD. #23	"	
TEMP.		"	
PATT.		"	

TITLE: FISCHER MOD. "G" SHOCKPROOF FLUOROSCOPE TRANSF. SUPP. ARM SWIVEL WASHER - FRONT

H. G. FISCHER & CO.
2335 WABANSIA AVE.
CHICAGO, ILL.

CAT. NO.

PART NO. 11377

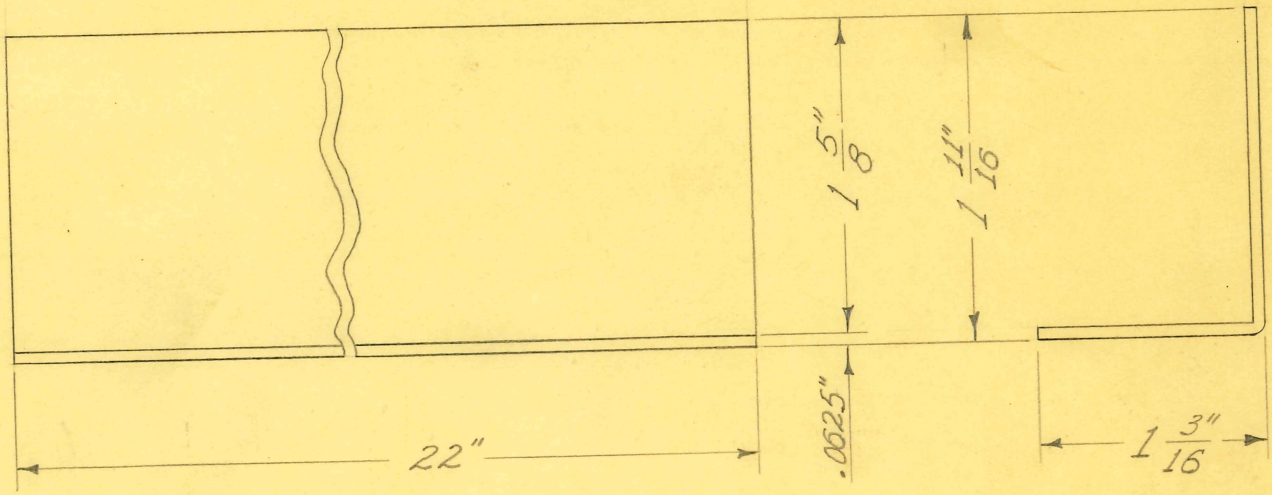

1 REQUIRED

OBSOLETE
4-22-80 J.S

SIZE	#16GA.(.0625")	ISSUE 3-7-38	J.W.
KIND	C.R. STEEL	CHANGED	
SHAPE	SHEET	"	
FINISH		"	
TEMP.		"	
PATT.		"	

TITLE: FISCHER MOD. "G" SHOCKPROOF FLUOROSCOPE
SIDE COVER TIE ANGLE FRONT

H. G. FISCHER & CO.
2335 WABANSIA AVE.
CHICAGO, ILL.

CAT. NO.

PART NO. 11379

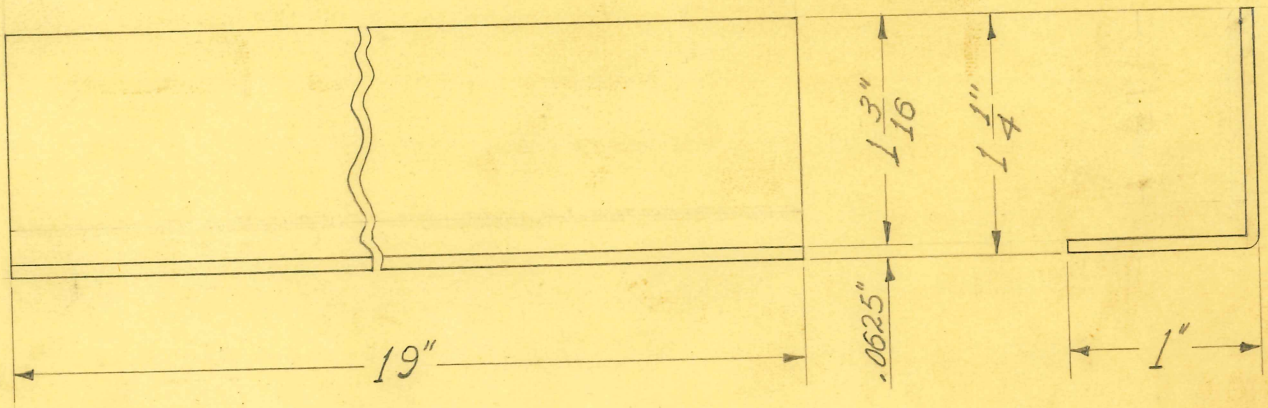

1 REQUIRED

OBSOLETE
4-22-80 J.S

SIZE	#16GA.(.0625")	ISSUE 3-7-38	J.W.
KIND	C.R. STEEL	CHANGED	
SHAPE	SHEET	"	
FINISH		"	
TEMP.		"	
PATT.		"	

TITLE: FISCHER MOD. "G" SHOCKPROOF FLUOROSCOPE SIDE COVER TIE ANGLE -REAR-TOP

H. G. FISCHER & CO.
2335 WABANSIA AVE.
CHICAGO, ILL.

CAT. NO.

PART NO. 11380

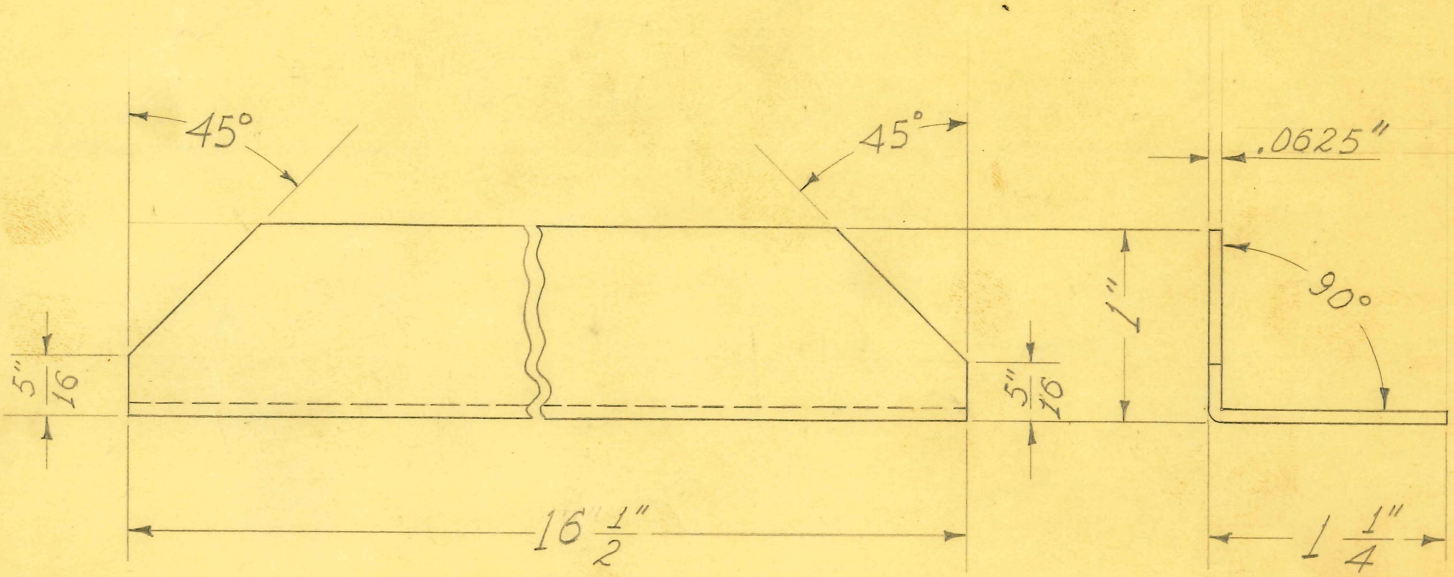

1 REQUIRED

OBSOLETE
4-22-80 J.S.

SIZE	#16 U.S.S. GA.	ISSUE 3-29-38	J.W.
KIND	C.R. STEEL	CHANGED	
SHAPE	SHEET	"	
FINISH		"	
TEMP.		"	
PATT.		"	

TITLE:
FISCHER MOD. "G" SHOCKPROOF FLUOROSCOPE
FRONT COVER PLATE ANGLE-BOTTOM

H. G. FISCHER & CO.
2335 WABANSIA AVE.
CHICAGO, ILL.

CAT. NO.

PART NO. 11382

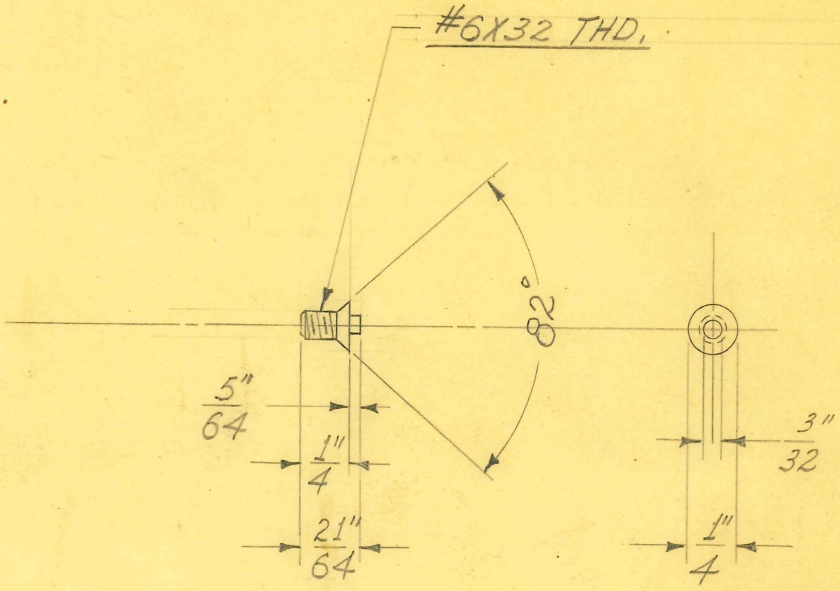

6 REQUIRED

OBSOLETE
4-22-80 J.S.

SIZE	1/4" DIAM.	ISSUE 3-30-38	J.W.
KIND	C.R. STEEL	CHANGED	
SHAPE	ROD.	"	
FINISH		"	
TEMP.		"	
PATT.		"	

TITLE: FISCHER MOD. "G" SHOCKPROOF FLUOROSCOPE
FINISHING STRIP SCREW. STUD-END

H. G. FISCHER & CO.
2335 WABANSIA AVE.
CHICAGO, ILL.

CAT. NO.

PART NO. 11413

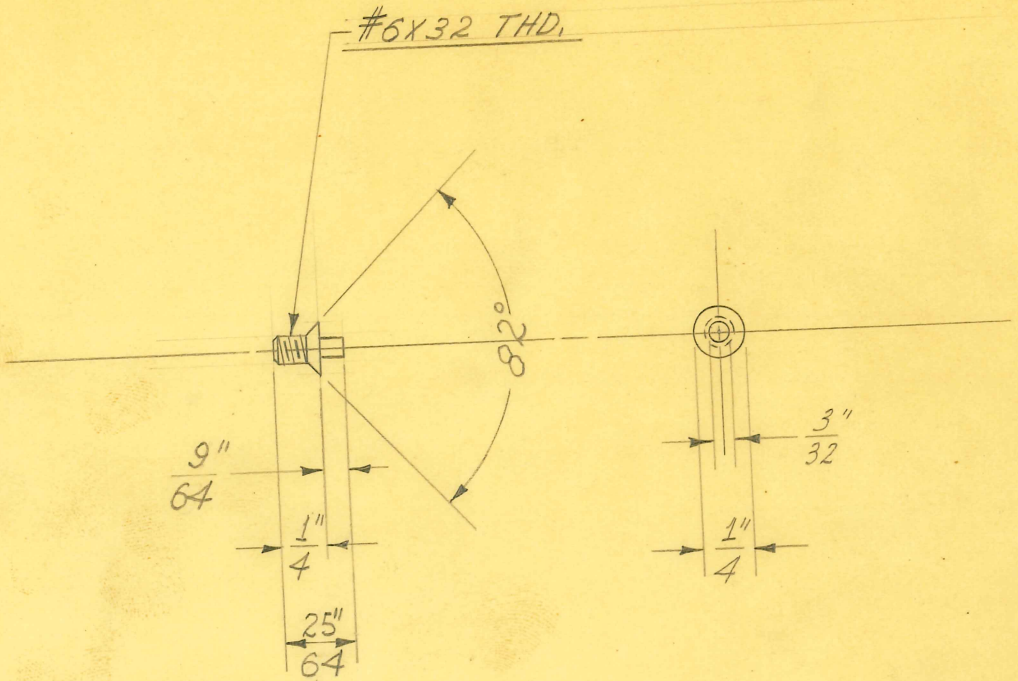

4 REQUIRED

OBSOLETE
4-22-80 J.S

SIZE	1/4" DIAM.	ISSUE 3-31-38	J.W.	TITLE: FISCHER MOD. "G" SHOCKPROOF FLUOROSCOPE FINISHING STRIP SCREW STUD - CENTER
KIND	C.R. STEEL	CHANGED		
SHAPE	ROD	"		
FINISH		"		
TEMP.		"		
PATT.		"		

H. G. FISCHER & CO.
2335 WABANSIA AVE.
CHICAGO, ILL.

CAT. NO.

PART NO. 11414

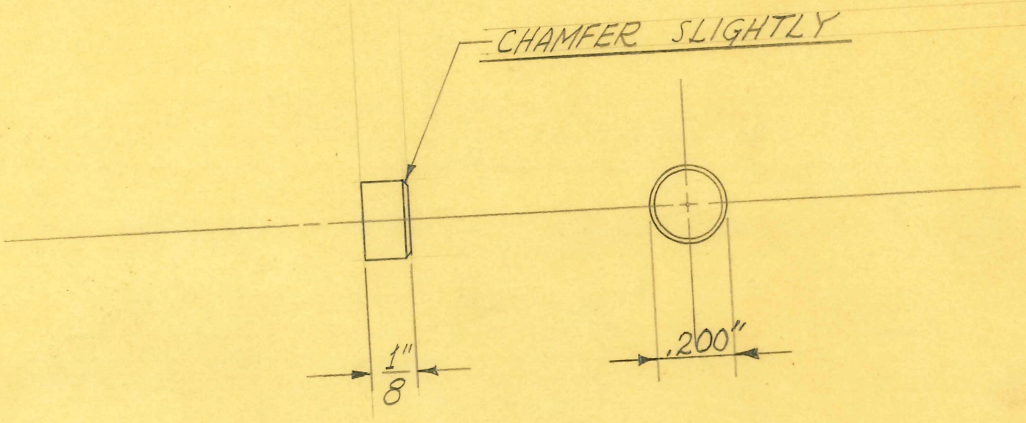

SCALE ~ 2 DIAMETERS

1 REQUIRED

OBSOLETE
4-22-80 J.S

SIZE	7/32" DIAM.	ISSUE 4-25-38	J.W.	TITLE: FISCHER MOD. "G" SHOCKPROOF FLUOROSCOPE TRANSF. SUPPORTING ARM LOCK SLUG
KIND	BRASS. ROD	CHANGED		
SHAPE		"		
FINISH		"		
TEMP.		"		
PATT.		"		

H. G. FISCHER & CO.
2335 WABANSIA AVE.
CHICAGO, ILL.

CAT. NO.

PART NO. 11417

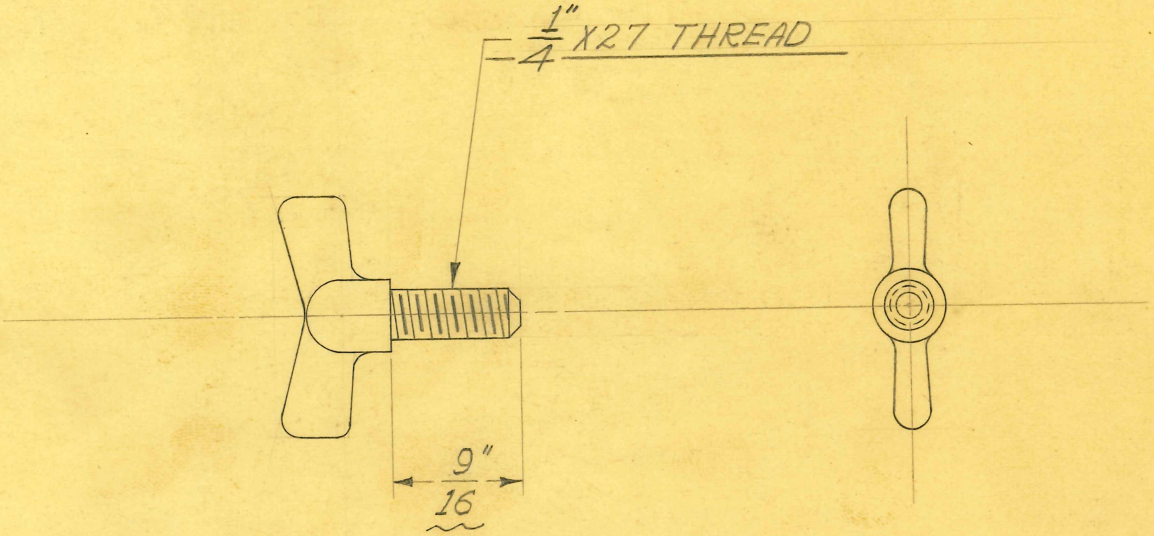

1 REQUIRED

OBSOLETE
4-22-80 J.S

SIZE		ISSUE 4-13-38	J.W.
KIND	BRASS CASTING	CHANGED	
SHAPE		"	
FINISH	CAD. #23	"	
TEMP.		"	
PATT.	1232	"	

TITLE: FISCHER MOD. "G" SHOCKPROOF FLUOROSCOPE
TRANSF. SUPPORTING ARM LOCK WING SCREW

H. G. FISCHER & CO.
2335 WABANSIA AVE.
CHICAGO, ILL.

CAT. NO.

PART NO. 11419F

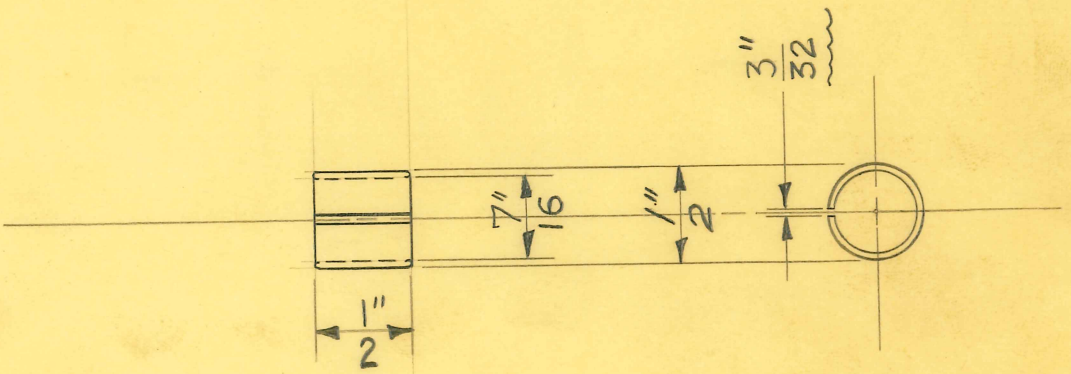

1 REQUIRED

OBSOLETE
4-22-80 J.S

½" O.D. X #20 GA. (.032") WALL SEAMLESS BRASS TUBING

SIZE		ISSUE 12-23-41	J.Y.W.
KIND		CHANGED	
SHAPE		"	
FINISH	CAD. #23	"	
TEMP.		"	
PATT.		"	

TITLE: FISCHER MOD. "G" SHOCKPROOF FLUOROSCOPE FOOT SWITCH – CORD STRAIN RELIEF

H. G. FISCHER & CO.
2335 WABANSIA AVE.
CHICAGO, ILL.

CAT. NO.

PART NO. 11421 ½

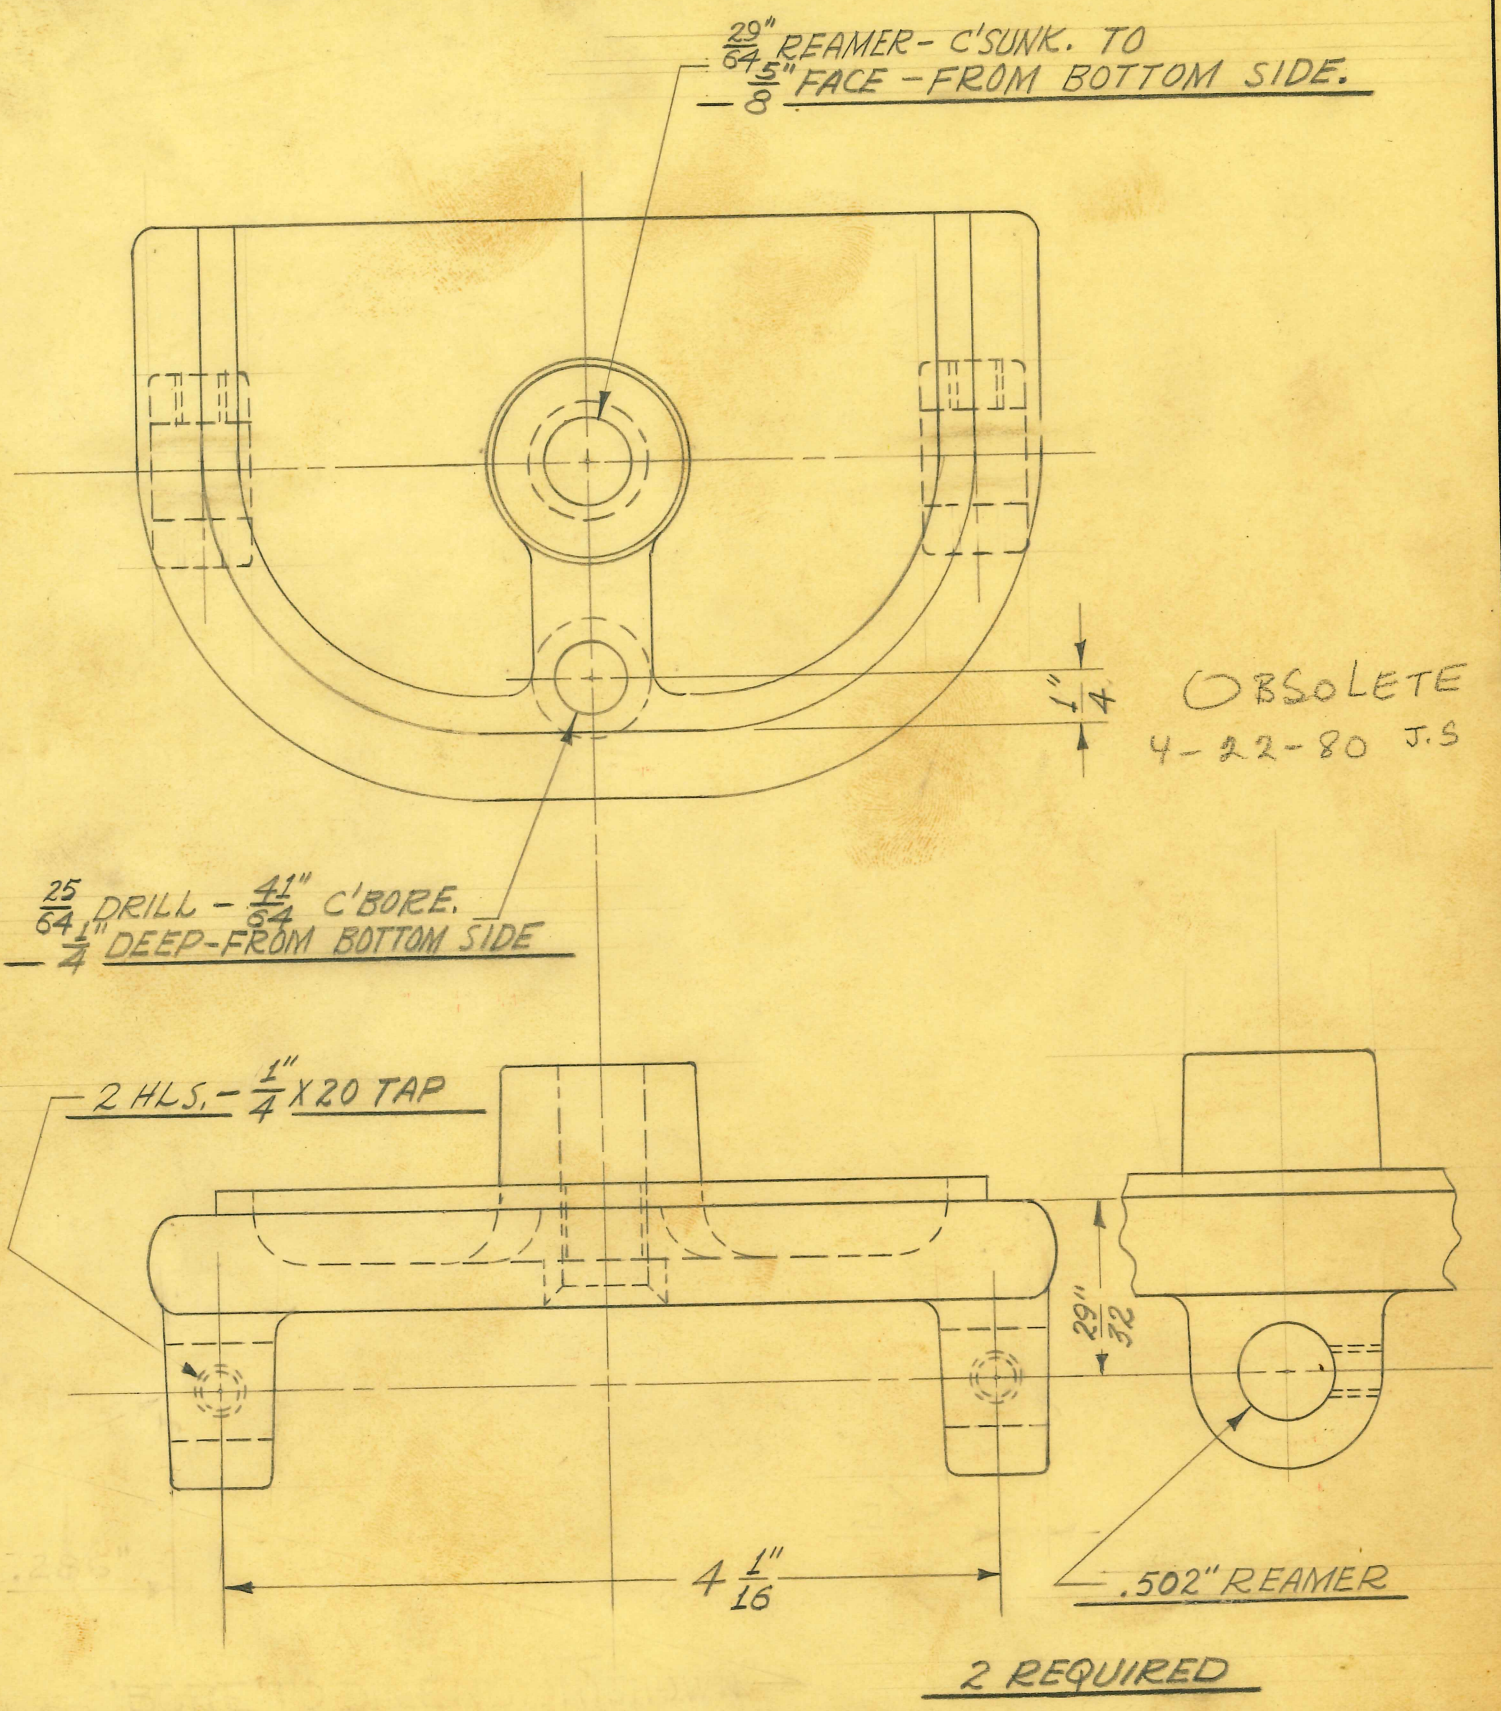

SIZE		ISSUE 4-4-40	J.W.
KIND	IRON CASTING	CHANGED	
SHAPE		"	
FINISH	PAINTED	"	
TEMP.		"	
PATT.	1515	"	

TITLE: FISCHER MOD. "TF-30-96" S.P. FLUOROSCOPE BASE CASTER & ROLLER BLOCK - LARGE

H. G. FISCHER & CO.
2335 WABANSIA AVE.
CHICAGO, ILL.

CAT. NO.

PART NO. 11492AF

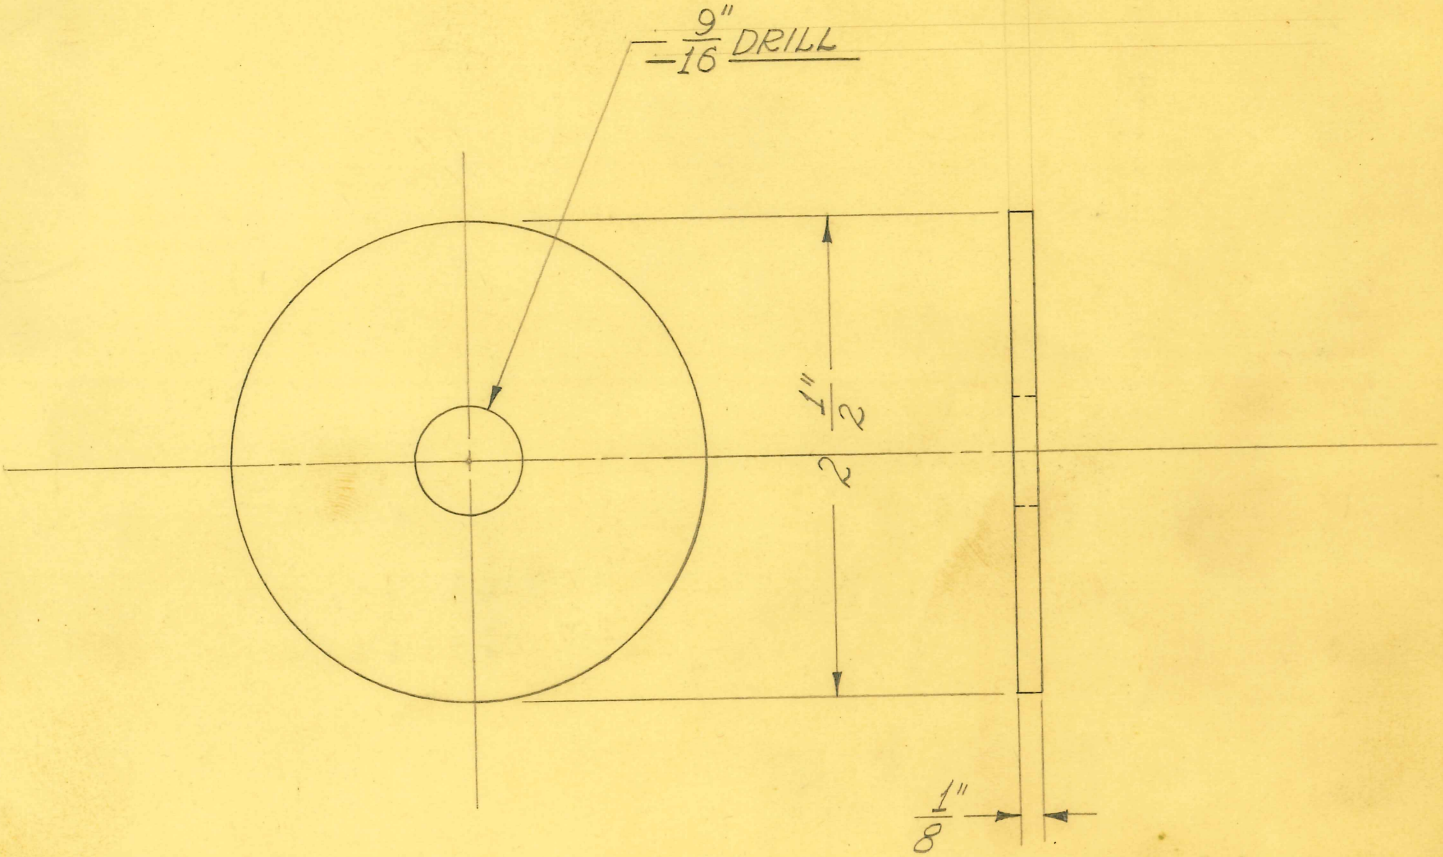

2 REQUIRED

OBSOLETE
4-22-80 J.S.

SIZE	1/8" SHEET	ISSUE 5-6-38	J.W.
KIND	C.R. STEEL	CHANGED	
SHAPE		"	
FINISH		"	
TEMP.		"	
PATT.		"	

TITLE:
FISCHER MOD. "G" SHOCKPROOF FLUOROSCOPE
COUNTERWEIGHT CLAMP WASHER

H. G. FISCHER & CO.
2335 WABANSIA AVE.
CHICAGO, ILL.

CAT. NO.

PART NO. 11495

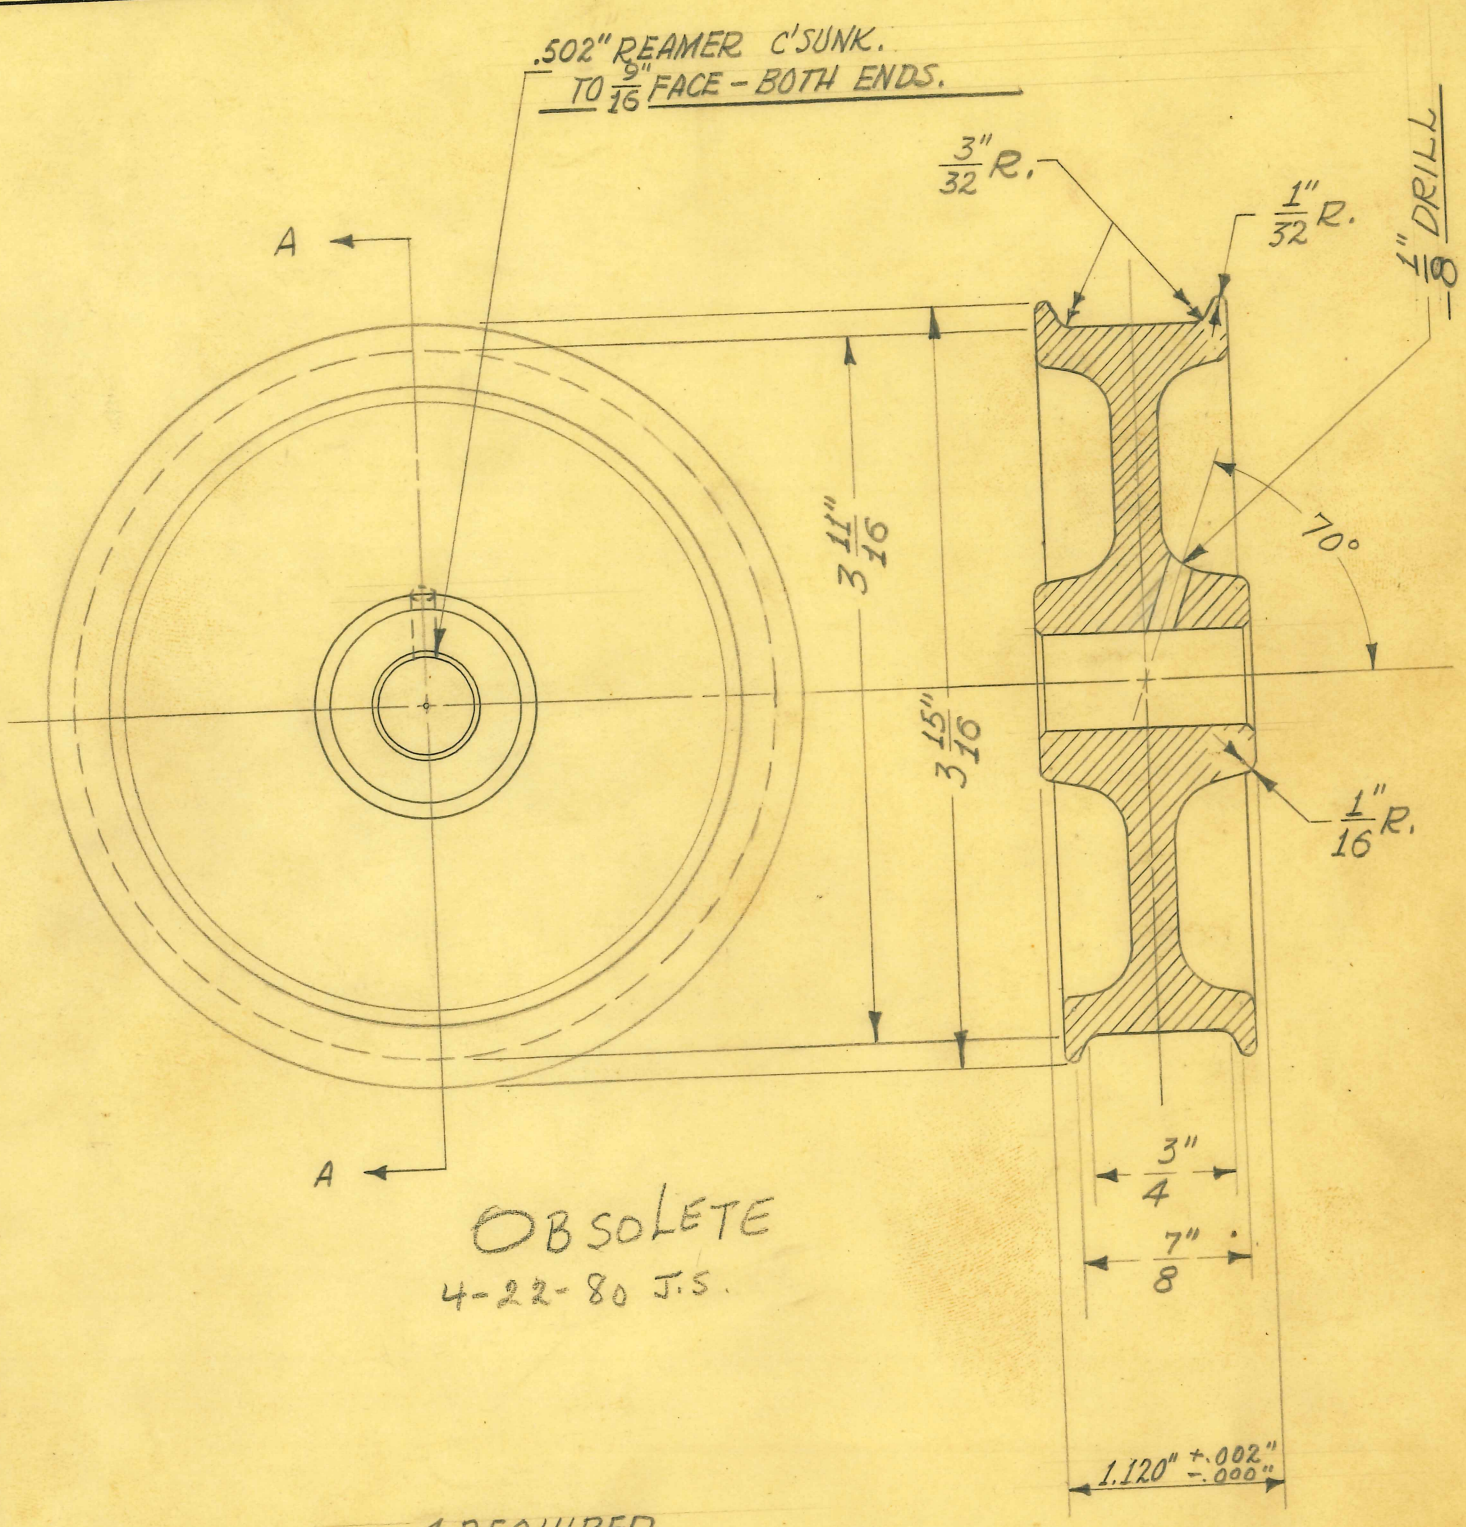

OBSOLETE
4-22-80 J.S.

4 REQUIRED

SECTION THRU "A-A"

CIRCULAR FORMING TOOL #11095

SIZE		ISSUE 4-2-40	J.W.
KIND	IRON CASTING	CHANGED	
SHAPE		"	
FINISH	CAD. PLATE #23 & PAINTED	"	
TEMP.		"	
PATT.		"	

TITLE: FISCHER MOD. "TF" S.P. FLUOROSCOPE GROOVED ROLLER

H. G. FISCHER & CO.
2335 WABANSIA AVE.
CHICAGO, ILL.

CAT. NO.

PART NO. 11523

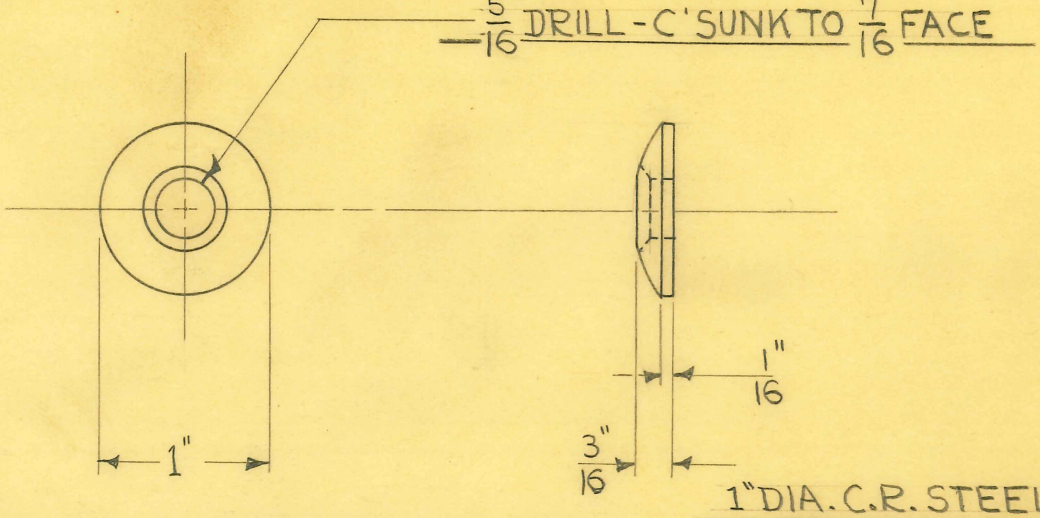

1" DIA. C.R. STEEL

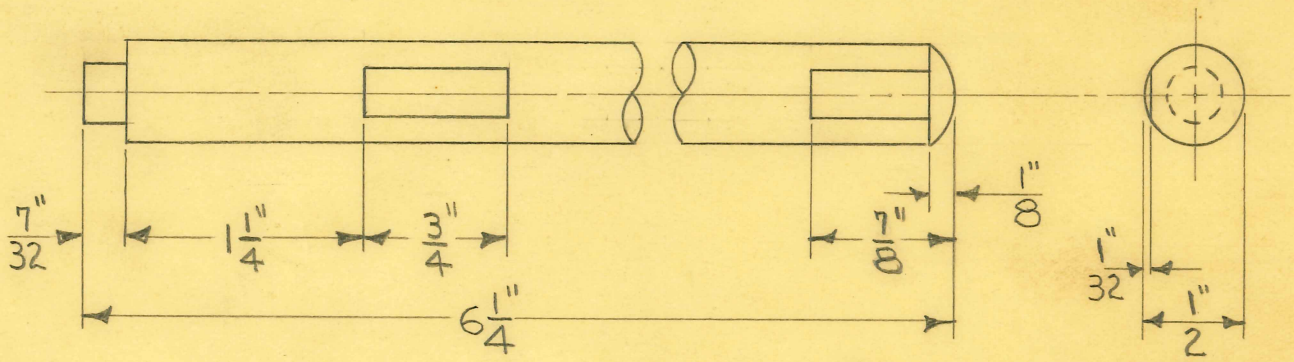

1/2" DIA. JEWELERS ROD

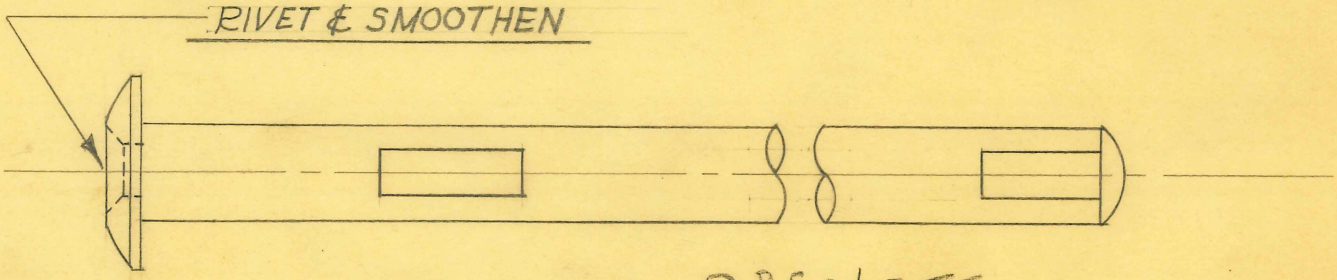

OBSOLETE
4-22-80 J.S.

4-REQUIRED

DIMENSIONS	
FRACTIONAL	± .015
DECIMAL	± .005
ANGULAR	± 1/2°

UNLESS OTHERWISE SPECIFIED

SIZE		ISSUE 2-6-48	J.M.F
KIND	IRON CASTING	CHANGED	
SHAPE		"	
FINISH	CAD. #23	"	
TEMP.		"	
PATT.	1515	"	

TITLE:
FISCHER MOD. "TF-30-96" S.P. FLUOROSCOPE
GROOVED ROLLER SHAFT

H. G. FISCHER & CO.
2335 WABANSIA AVE.
CHICAGO, ILL.

CAT. NO.

PART NO. 11528GA

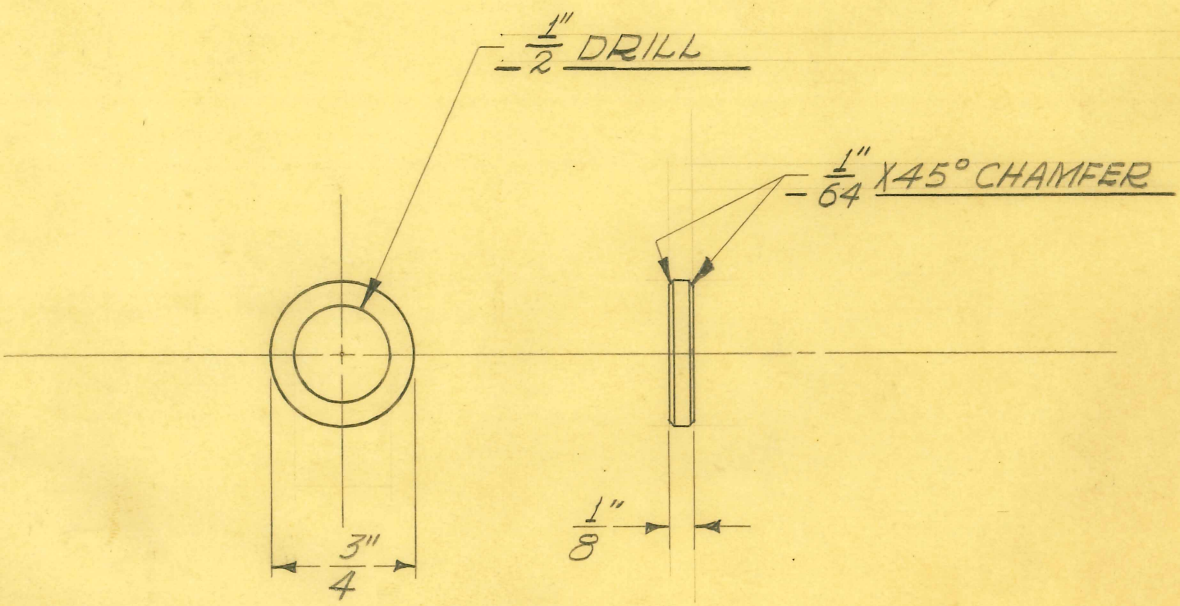

4 REQUIRED

OBSOLETE
4-22-80 J.S.

SIZE	3/4" DIA.	ISSUE 4-4-40	J.W.
KIND	C.R. STEEL	CHANGED	
SHAPE	ROD.	"	
FINISH	CAD. #23	"	
TEMP.		"	
PATT.		"	

TITLE: FISCHER MOD. "TF-30-96" S.P. FLUOROSCOPE GROOVED ROLLER SPACER

H. G. FISCHER & CO.
2335 WABANSIA AVE.
CHICAGO, ILL.

CAT. NO.

PART NO. 11529

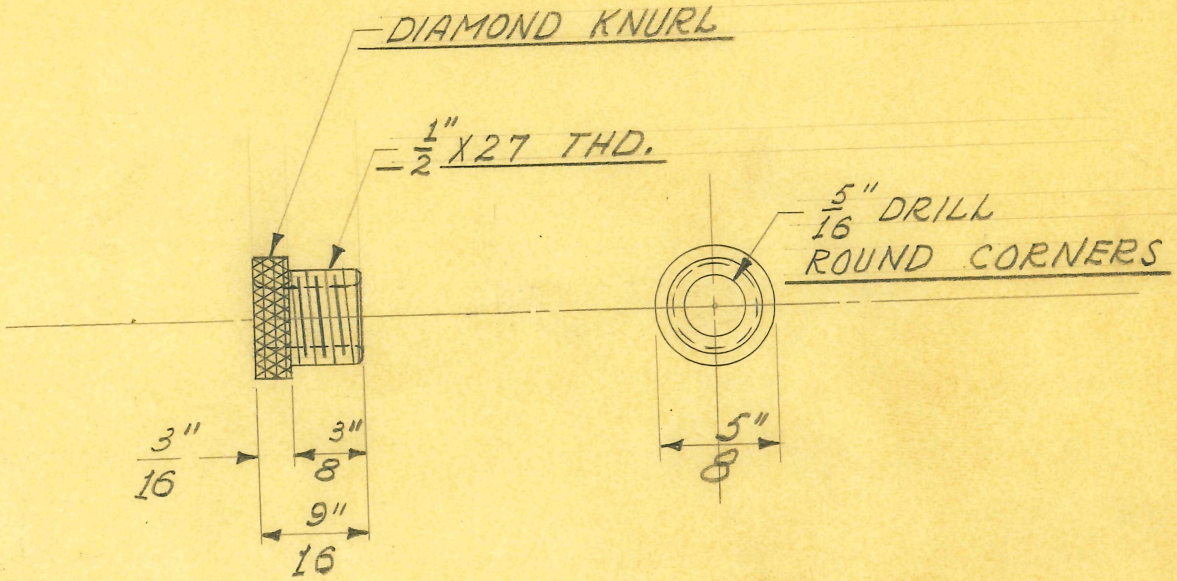

1 REQUIRED

SIZE	5/8" DIA.	ISSUE 10-29-37	J.W.	TITLE: FISCHER MOD. "700-100" REMOTE CONTROL CABLE BUSHING
KIND	ALUMINUM	CHANGED		
SHAPE	ROD	"		
FINISH	POLISH TOP OF HEAD	"		
TEMP.		"		
PATT.		"		

H. G. FISCHER & CO.
2335 WABANSIA AVE.
CHICAGO, ILL.

CAT. NO.

PART NO. 11007

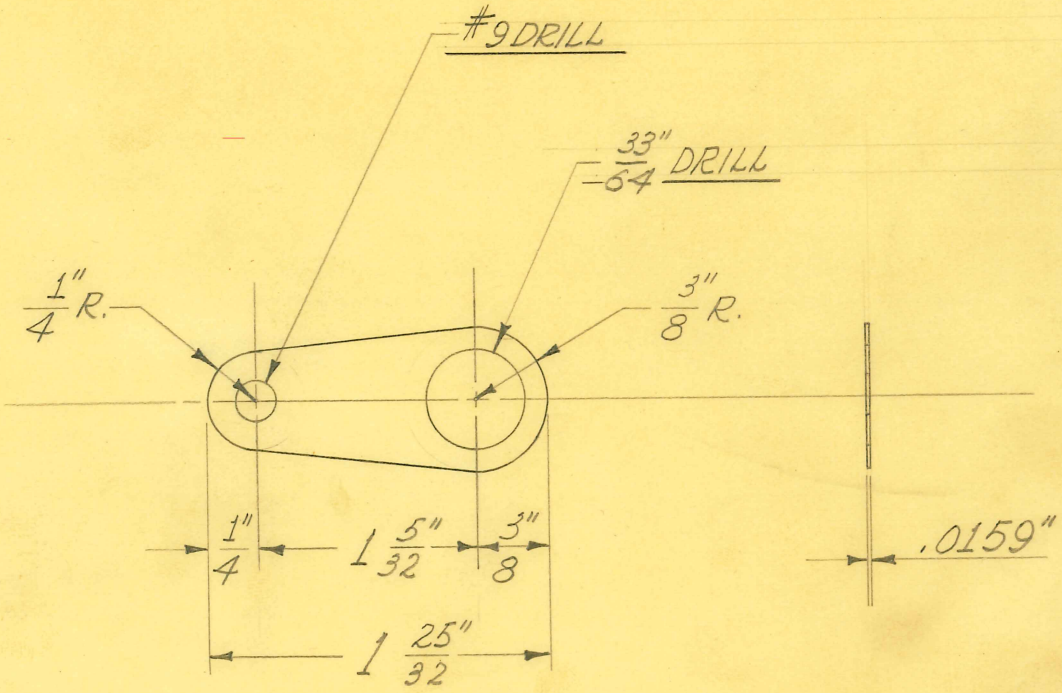

1 REQUIRED.

OBSOLETE
4-22-80

SIZE	#26 GA. H.H.	ISSUE 1-27-38	J.W.
KIND	SHEET BRASS	CHANGED	
SHAPE		"	
FINISH		"	
TEMP.		"	
PATT.		"	

TITLE: FISCHER MOD. "100-100" TRANSFORMER GROUND STRIP

H. G. FISCHER & CO.
2335 WABANSIA AVE.
CHICAGO, ILL.

CAT. NO.

PART NO. 10652A

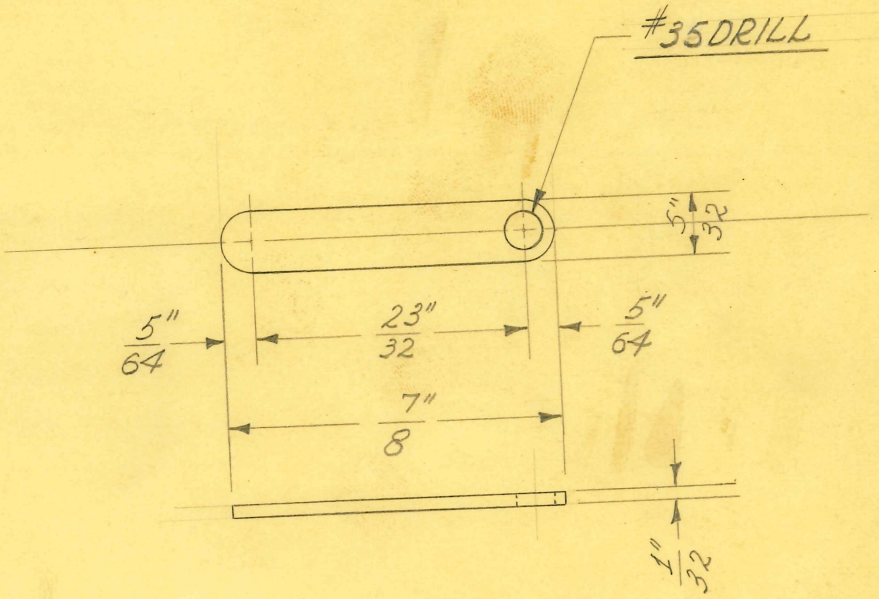

SCALE ÷ DOUBLE SIZE

1 REQUIRED

OBSOLETE
4-22-80

SIZE	1/32" SHEET	ISSUE 1-21-38	J.W.	TITLE: "H" PORTABLE X-RAY UNIT SECONDARY COIL CONNECTION LINK
KIND	BRASS	CHANGED		
SHAPE		"		
		"		
		"		
		"		

H. G. FISCHER & CO.
2335 WABANSIA AVE.
CHICAGO, ILL.

CAT. NO.

PART NO. 10842

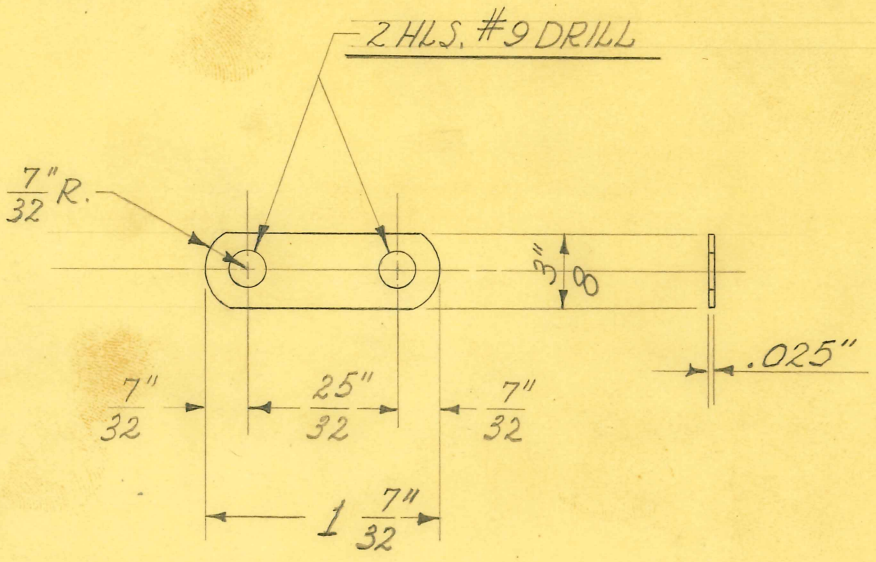

1 REQUIRED

OBSOLETE
4-22-80

SIZE	#22 GA. (.025")	ISSUE 1-18-38	J.W.
KIND	SHEET BRASS	CHANGED	
SHAPE		"	
FINISH		"	
TEMP.		"	
PATT.		"	

TITLE: "H" PORTABLE X-RAY UNIT
GROUND STRIP

H. G. FISCHER & CO.
2335 WABANSIA AVE.
CHICAGO, ILL.

CAT. NO.

PART NO. 10847

TITLE

PORTABLE "H" X-RAY UNIT
BELLOWS MOUNTING SUPP. WASHER

H. G. FISCHER & CO.
FRANKLIN PARK, ILLINOIS

PART NO. 10879A

DATE 11-8-54 | DR BY W. J. | CH'K'D. J.V.W.

REVISION	DATE	BY

PATTERN | FINISH | SCALE FULL

TOOLS | MATERIAL 1/16" SHEET BRASS

DIMENSIONS
FRACTIONAL ± .015
DECIMAL ± .005
ANGULAR ± ½°
UNLESS OTHERWISE SPECIFIED

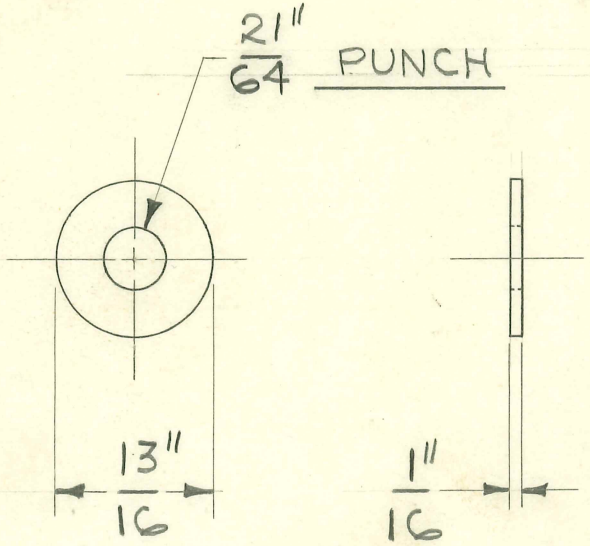

OBSOLETE
4-22-80

3 REQUIRED

#86

JUL 3 1 1973 26421

NEXT ASSEMBLY	
PART NO.	QTY.
208-428	1

NUMBER 103-293

NOTE:
CINCH JONES TERMINAL MARKER SWITCH (5 PTS)
PURCHASED FROM ALLIED RADIO, CAT. # MS5-140

OBSOLETE
4-22-80

LTR	DESCRIPTION	ECO	DATE

REVISIONS

MATERIAL: AS NOTED
SPEC. NO.
ENG. SPEC.
SPEC. NO.
DIMENSIONS ARE IN INCHES
TOLERANCES UNLESS OTHERWISE SPEC.
DECIMALS .X ±.030 .XX ±.010 .XXX ±.005 ANGLES ±½°

SCALE
NET WEIGHT
DRAFTSMAN R.W. 3-14-63
CHECKER J.V.W.
ENGINEER
APPROVAL

GRACO
GRACO INC.
Minneapolis, Minnesota

TITLE: STRIP MARKER
FEDERAL STOCK NO.

SIZE	CODE IDENT. NO.	NUMBER
A	25980	103-293

GRACO FORM NO. 315093 REV. 2-68

TITLE

MODEL PORT. "C"
TUNING COND. CLAMP NUT

H. G. FISCHER & CO.
FRANKLIN PARK, ILLINOIS

PART NO. 11054

DATE 4-20-51 DR. BY W.J. CH'K'D. J.V.W.

REVISION	DATE	BY

PATTERN | FINISH CAD. #23 | SCALE FULL

TOOLS | MATERIAL ½" HEX. BRASS ROD

DIMENSIONS
FRACTIONAL ± .015
DECIMAL ± .005
ANGULAR ± ½°
UNLESS OTHERWISE SPECIFIED

USE SWITCH PCE# 9060 ½ AS GAUGE

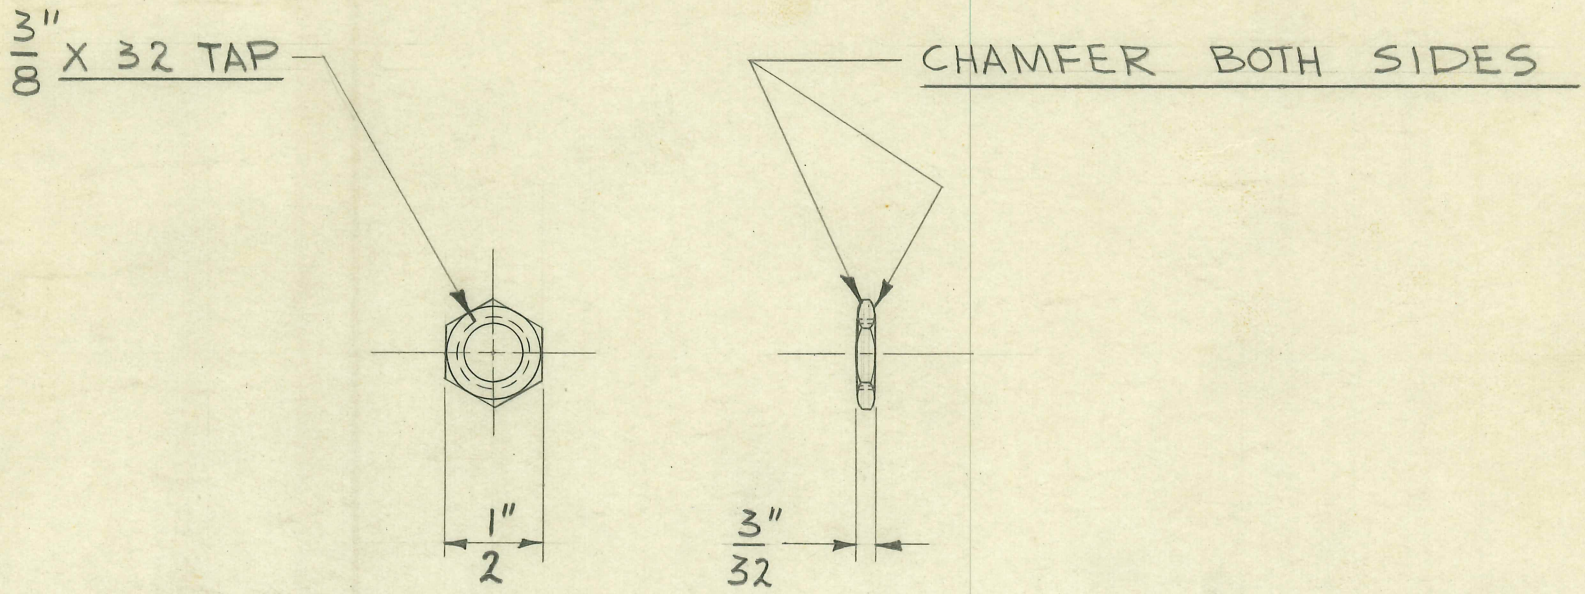

OBSOLETE
4-22-80

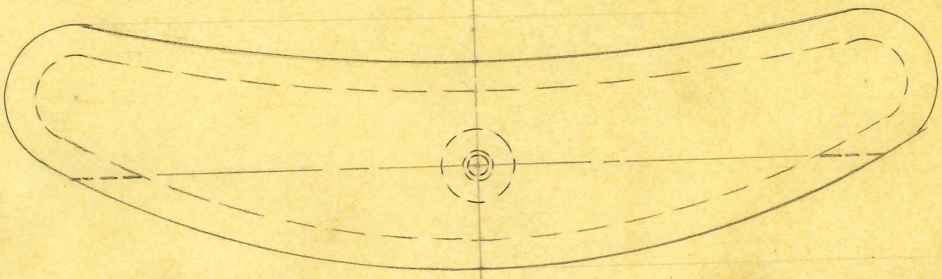

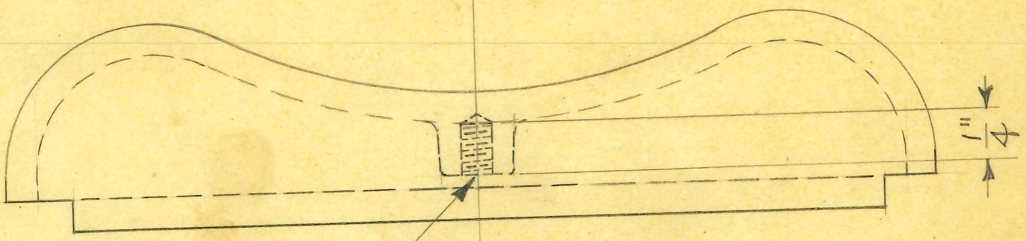

#8 X 32 TAP

OBSOLETE

1 REQUIRED

4-22-80

SIZE		ISSUE 11-4-37	A.E.
KIND	ALUM. CASTING	CHANGED	
SHAPE		"	
FINISH	POL. & BUFF	"	
TEMP.		"	
PATT.	5269-1153	"	

TITLE: WALL FORM CASSETTE HOLDER
CHIN REST

H. G. FISCHER & CO.
2335 WABANSIA AVE.
CHICAGO, ILL.

CAT. NO.

PART NO. 11011F

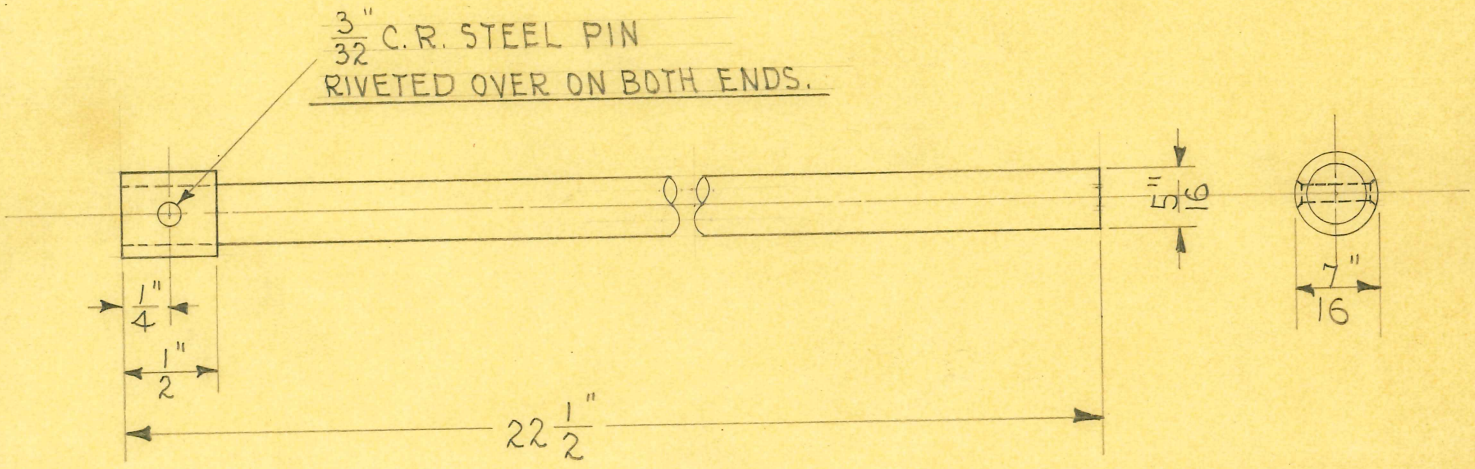

OBSOLETE
4-22-80

SIZE	5/16" & 7/16"	ISSUE 10-7-37	J.F.E.
KIND	C.R. STEEL	CHANGED	
SHAPE		"	
FINISH	SATIN CHR. #4	"	
TEMP.		"	
PATT.		"	

TITLE: WALL FORM CASSETTE HOLDER ADJUSTMENT ROD

H. G. FISCHER & CO.
2335 WABANSIA AVE.
CHICAGO, ILL.

CAT. NO.

PART NO. 11017G

TITLE WALL FORM CASSETTE HOLDER "WING SCREW ASSEMBLY"

H. G. FISCHER & CO.
FRANKLIN PARK, ILLINOIS

PART NO. 11020G

DATE 10-28-65 | DR BY T.T. | CH'K'D. RS

REVISION	DATE	BY

PATTERN | FINISH BLACK KRISTOKRAK(255) | SCALE DOUBLE

TOOLS | MATERIAL AS SHOWN

DIMENSIONS
FRACTIONAL ± .015
DECIMAL ± .005
ANGULAR ± ½°
UNLESS OTHERWISE SPECIFIED

USED ON	QTY.

NOTE:
SCREW (ITEM NO. 2) WING SCREW INTO (ITEM NO. 1) WING SCREW NUT TIGHT AS POSSIBLE BEFORE DRILLING 3/32 HOLE.

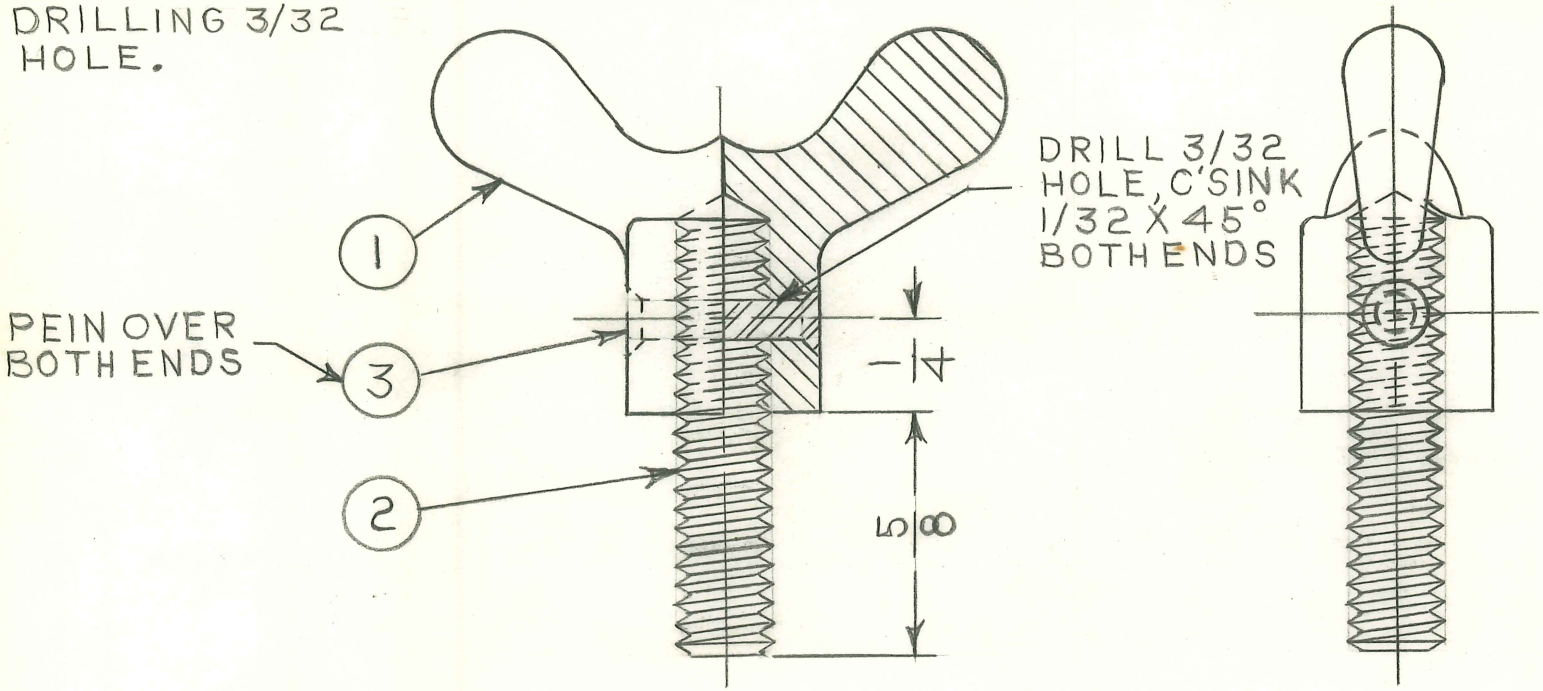

DEPT.	AMT.	ITEM NO.	NAME OF PARTS	PART NO.
M/S	1	1	WING SCREW NUT	11027
M/S	1	2	WING SCREW	11028
M/S	1	3	WING SCREW RIVET	11029

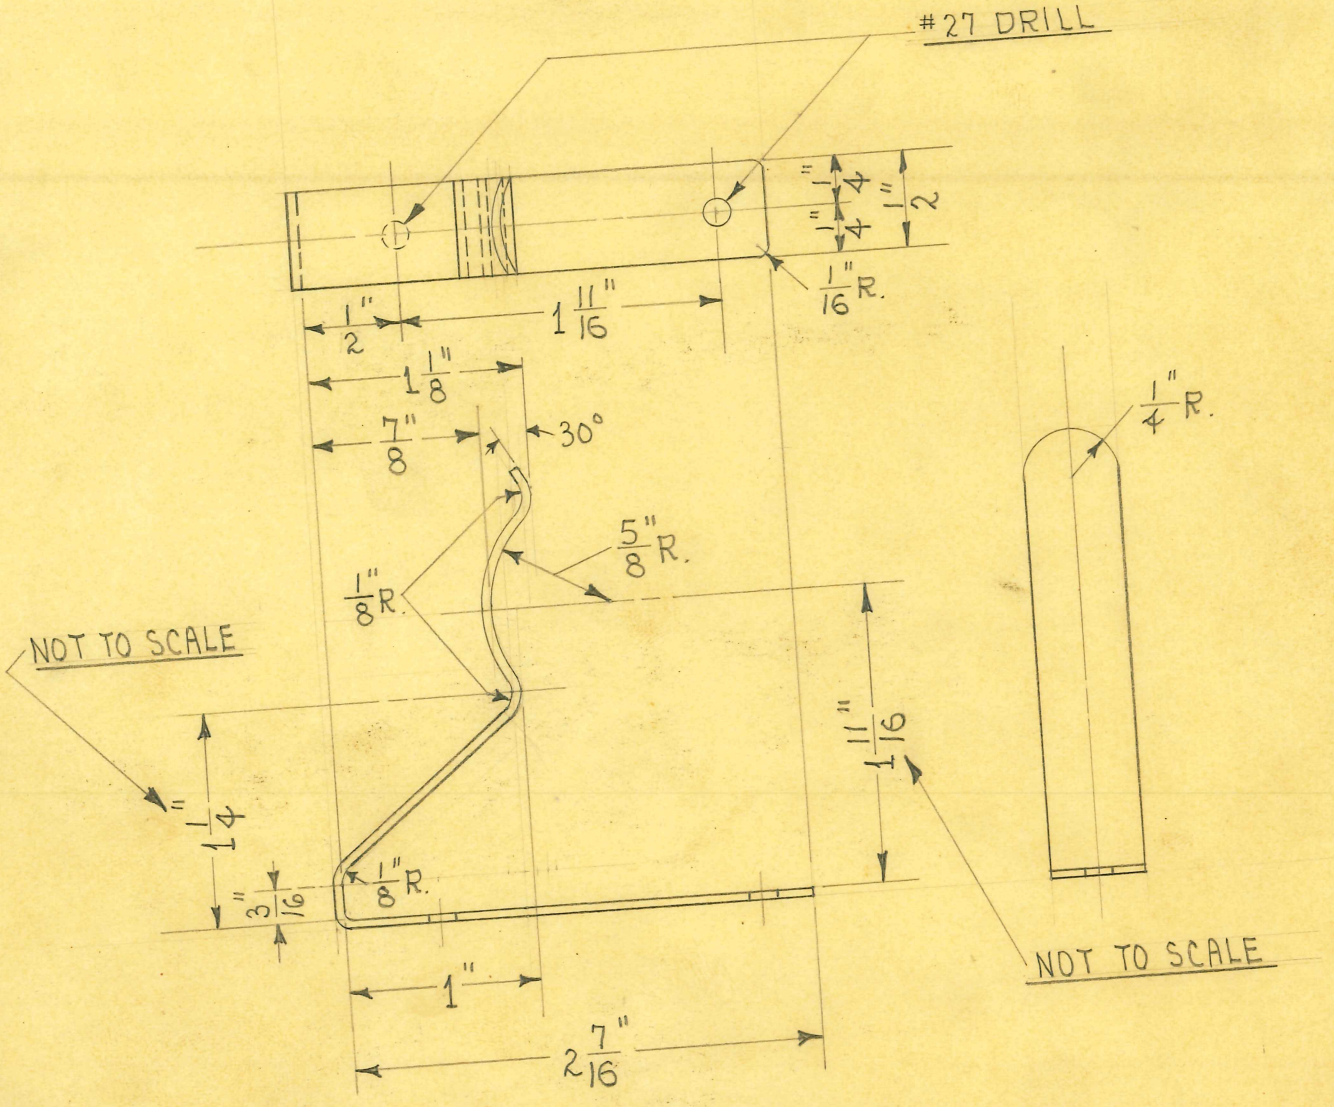

2 REQUIRED

DEVELOPED LENGTH- 5 3/8"

OBSOLETE 4-22-58

SIZE	.040"	ISSUE 10-11-37	J.E.	TITLE: WALL FORM CASSETTE HOLDER CASSETTE COVER CLAMP
KIND	SHEET BRASS	CHANGED		
SHAPE		"		
FINISH	WH. CHR. #3	"		
TEMP.		"		
		"		

H. G. FISCHER & CO.
2335 WABANSIA AVE.
CHICAGO, ILL.

CAT. NO.

PART NO. 11025

LETTER "O" (.316") DRILL

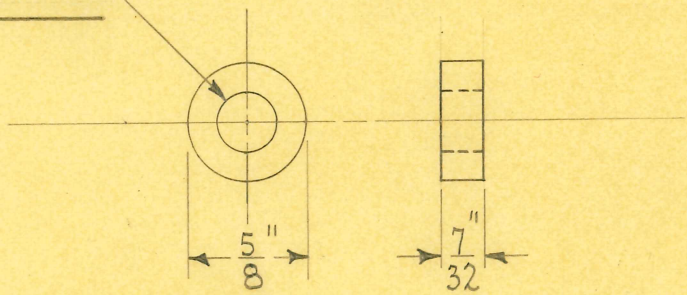

2 REQUIRED

OBSOLETE
4-22-80

SIZE	5/8" DIAM.	ISSUE 10-28-37	A.E.
KIND	C.R. STEEL	CHANGED	
SHAPE		"	
FINISH	CAD. #23	"	
TEMP.		"	
PATT.		"	

TITLE: VERTICAL WALL FRAME
BUCKY COUNTERWEIGHT PULLEY SPACER

H. G. FISCHER & CO.
2335 WABANSIA AVE.
CHICAGO, ILL.

CAT. NO.

PART NO. 11075

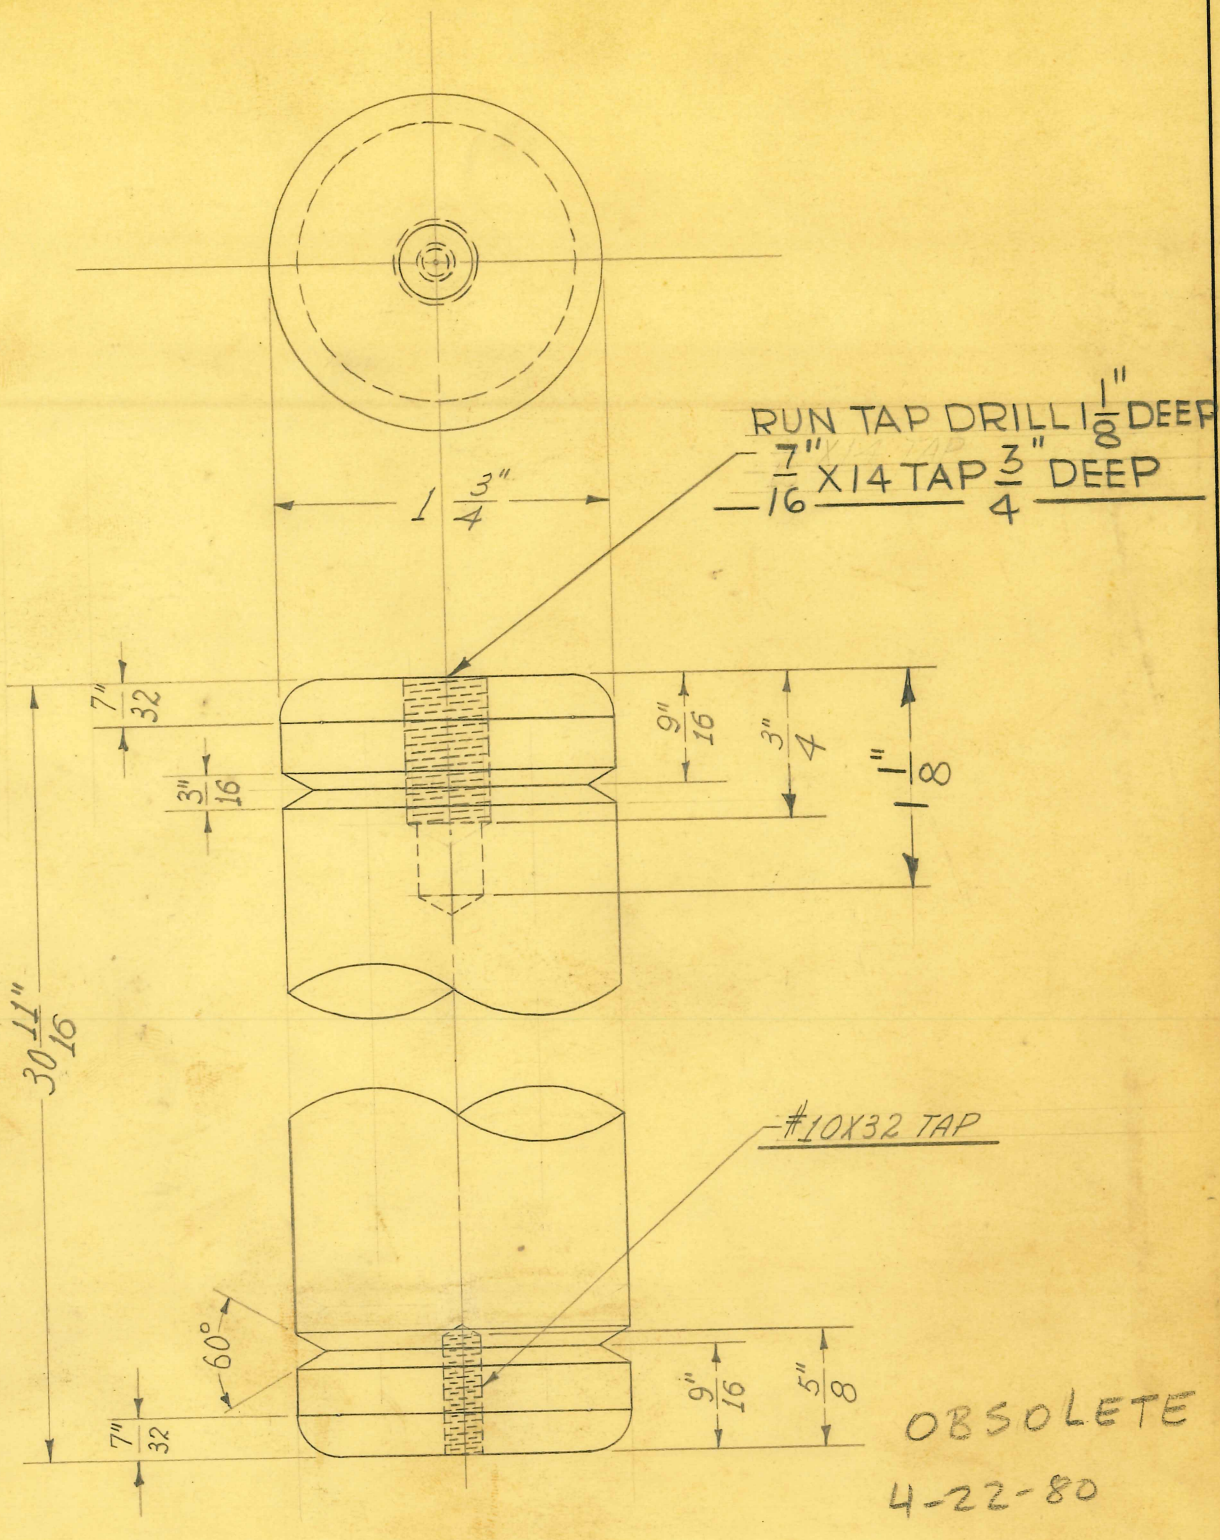

OBSOLETE
4-22-80

SIZE	1¾" DIAM.	ISSUE 3-12-38	J.W.	TITLE: VERTICAL WALL FRAME FOR 17" BUCKY - - COUNTERWEIGHT - FINISHED
KIND	C.R. STEEL	CHANGED		
SHAPE	ROD	" 9-23-48	W.J.	
FINISH		"		
TEMP.		"		
PATT.		"		

H. G. FISCHER & CO.
2335 WABANSIA AVE.
CHICAGO, ILL.

CAT. NO.

PART NO. 11098F

TITLE MOD. "PC" CONDENSER MOUNTING BOARD

H. G. FISCHER & CO.
FRANKLIN PARK, ILLINOIS

PART NO. 11106 C

DATE 7-17-58 | DR BY RCT | CH'K'D. J.V.W.

REVISION	DATE	BY
C REDRAWN	7-17-58	RCT
WAS 1"	8-14-63	PRM

PATTERN | FINISH | SCALE FULL

TOOLS: DRILL JIG #12592

MATERIAL: 1/4" SHEET BAKELITE

DIMENSIONS UNLESS OTHERWISE SPECIFIED
FRACTIONAL ± .015
DECIMAL ± .005
ANGULAR ± ½°

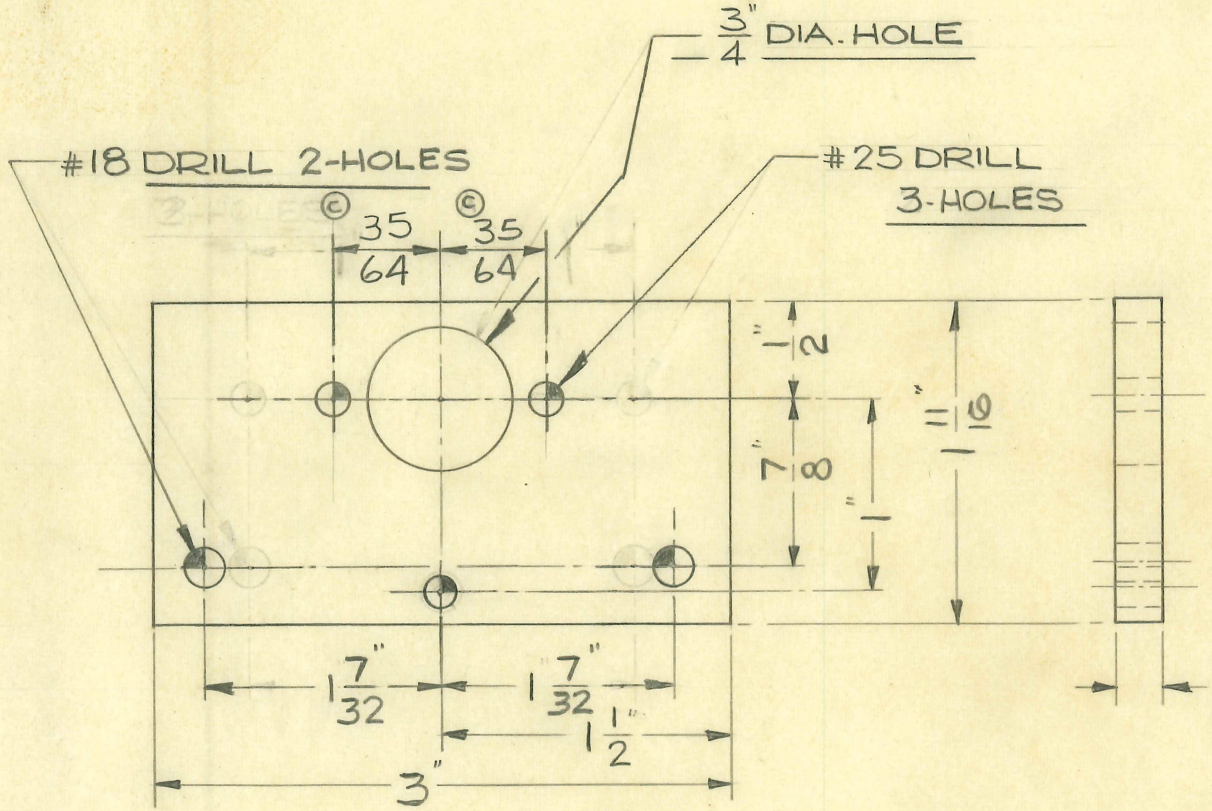

1-REQUIRED

FOLDER # 62

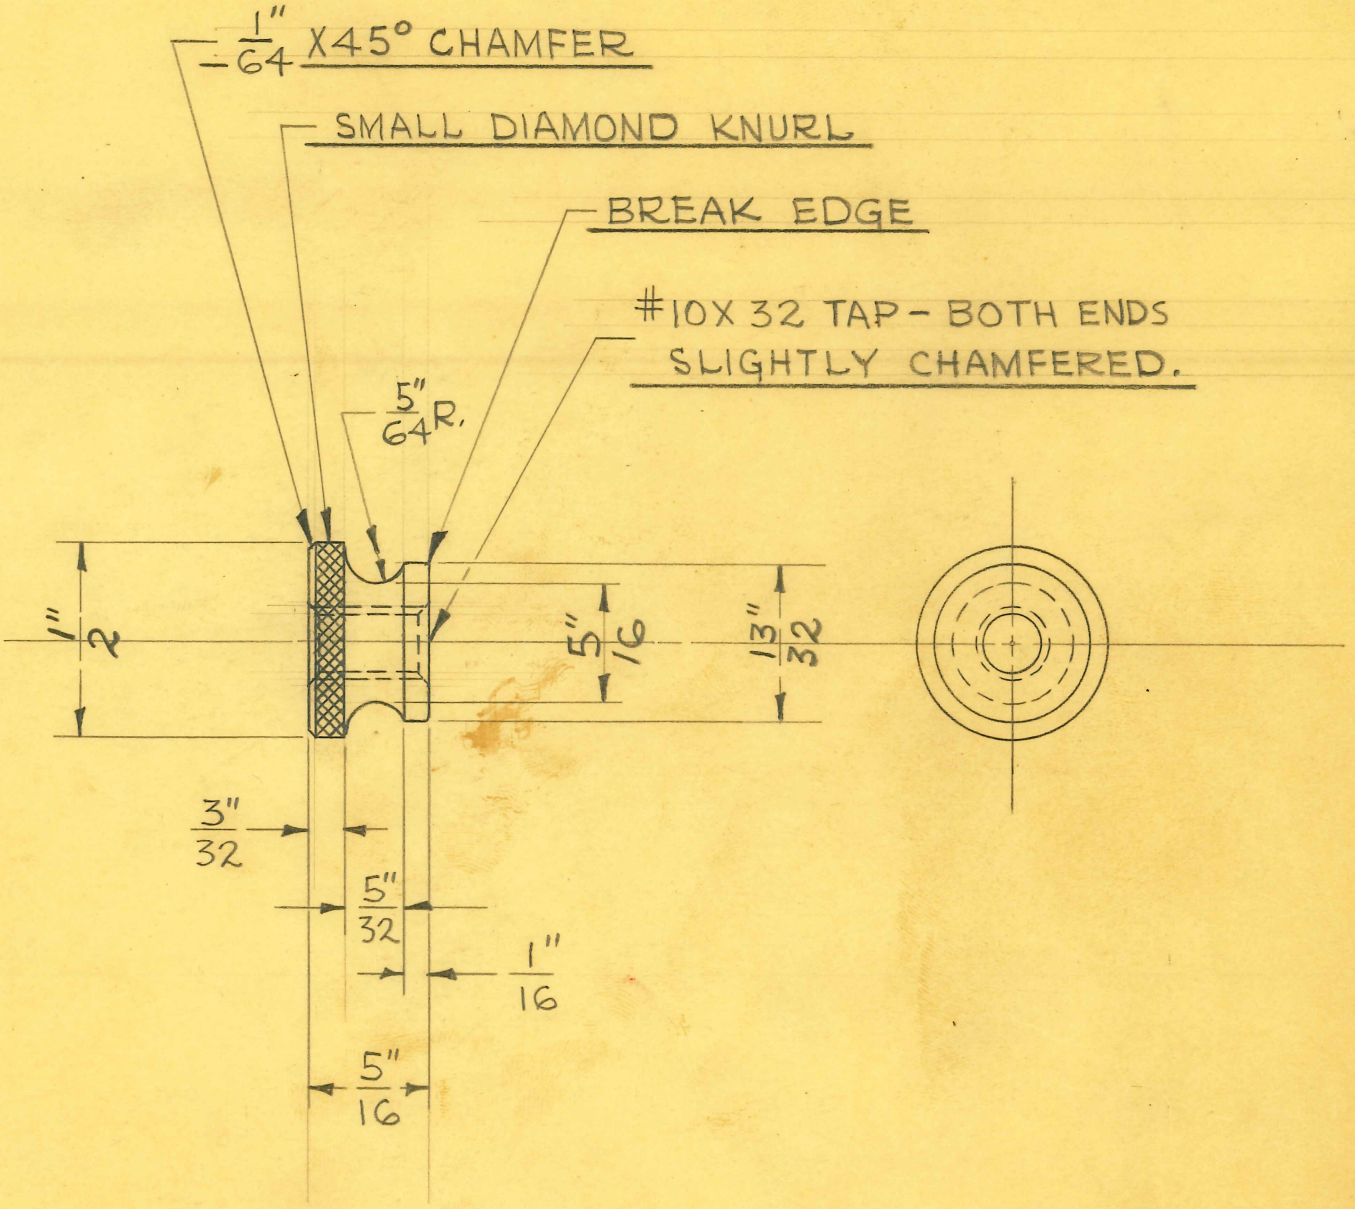

SCALE ~ DOUBLE SIZE

OBSOLETE
4-22-80

SIZE	½" DIA.	ISSUE 1-17-46	J.V.W.
KIND	BRASS ROD	CHANGED	
SHAPE		"	
FINISH		"	
TEMP.		"	
PATT.		"	

TITLE: #10X32 THUMB NUT

H. G. FISCHER & CO.
2335 WABANSIA AVE.
CHICAGO, ILL.

CAT. NO.

PART NO. 5241

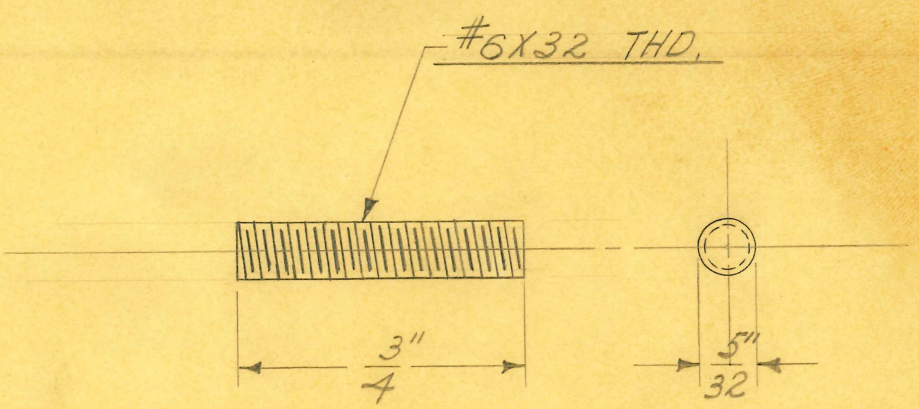

SCALE ÷ 2 DIAM.

4 REQUIRED

OBSOLETE
4-22-80

SIZE	5/32" DIAM.	ISSUE 8-16-37	J.W.
KIND	BRASS ROD	CHANGED	
SHAPE		"	
FINISH		"	
TEMP.		"	
PATT.		"	

TITLE: #6X32X 3/4" BRASS STUD

H. G. FISCHER & CO.
2335 WABANSIA AVE.
CHICAGO, ILL.

CAT. NO.

PART NO. 3544

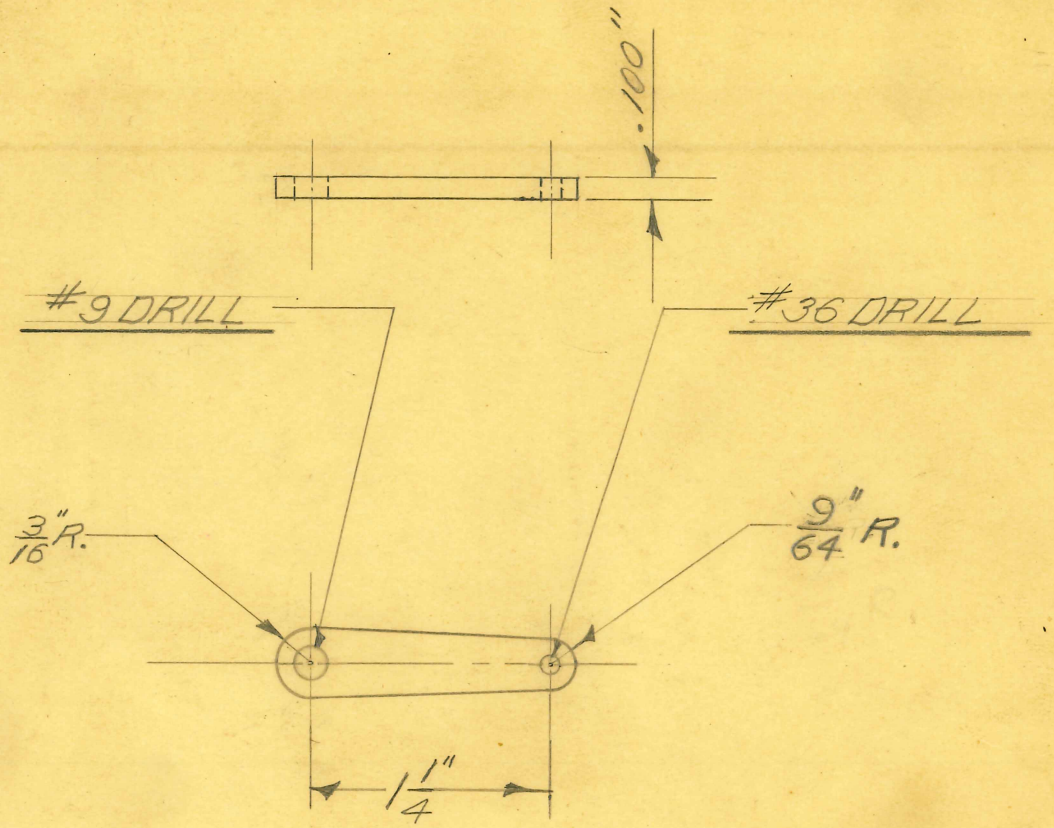

2-REQUIRED

OBSOLETE
4-22-80

#13 GA. (.090")

SIZE	~~.100"~~	ISSUE 9-3-47	J.M.F
KIND	C.R. STEEL	CHANGED	
SHAPE		"	
FINISH	CAD. #23	"	
TEMP.		"	
PATT.		"	

TITLE:
FISCHER MOD. "RF-100" X RAY UNIT
CWT. CHAIN LINK

H. G. FISCHER & CO.
2335 WABANSIA AVE.
CHICAGO. ILL.

CAT. NO.

PART NO. 3728

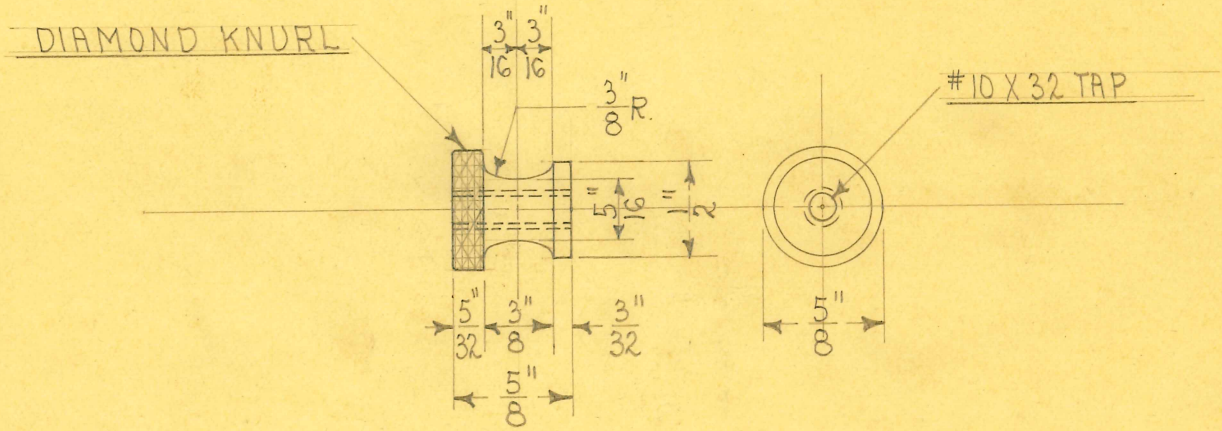

OBSOLETE

4-22-80

SIZE	5/8" DIAM.	ISSUE 9-24-35	A.E.
KIND	BRASS ROD	CHANGED	
SHAPE		"	
FINISH	CAD. #23	"	
TEMP.		"	
PATT.		"	

TITLE: OSBORN TUBE ARM TUBE HOLDER SPLIT RING CLAMP THUMB NUT

H. G. FISCHER & CO.
2335 WABANSIA AVE.
CHICAGO, ILL.

CAT. NO.

PART NO. 2417

TITLE
FRICTION TYPE CORD TIP PLUG

PATTERN | FINISH #113 | SCALE 4" = 1"

MATERIAL
3/32" DIA. BRASS ROD

TOOLS

H. G. FISCHER & CO.
FRANKLIN PARK, ILLINOIS

PART NO. 1269 1/4

DATE 2-20-68 | RE DR. BY CRS | CH'K'D. LJB

DIMENSIONS—UNLESS OTHERWISE SPECIFIED:

FRACTIONAL	± .015	THREAD CHAMFER
DECIMAL	± .005	UP TO 5/16 D. - 1/32 X 45°
ANGULAR	± 1/2°	3/8 D. & OVER - 1/16 X 45°

REMOVE ALL BURRS & SHARP CORNERS

USED ON	QTY.	USED ON	QTY.
8694 1/4G	1		

REVISION	DATE	BY

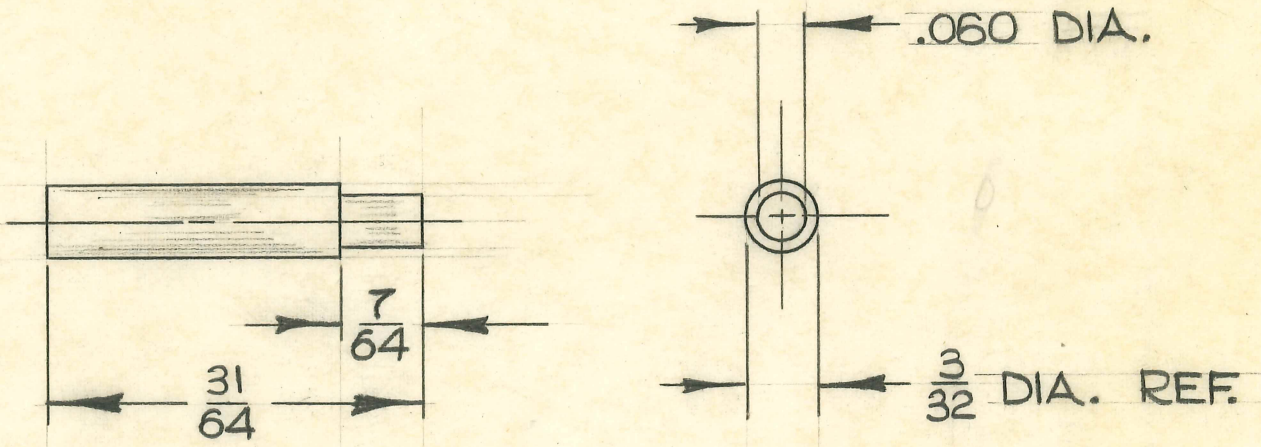

OBSOLETE
4-22-80

DO NOT SCALE DRAWING.

TITLE
LOW VOLTAGE
RESONATOR SUPPORT - LONG

H. G. FISCHER & CO.
FRANKLIN PARK, ILLINOIS

PART NO. 10393 3/4

DATE 2-23-51 | DR. BY J.V.W. | CH'K'D. [illegible]

REVISION	DATE	BY

PATTERN | FINISH | SCALE FULL

TOOLS
CUT-OFF & PERF. DIE #687 (Q-4)
BENDING DIE # 6372 (Z-7)

MATERIAL
1/16" X 1/2" C.R. STEEL FLAT WIRE

DIMENSIONS
FRACTIONAL ± .015
DECIMAL ± .005
ANGULAR ± ½°
UNLESS OTHERWISE SPECIFIED

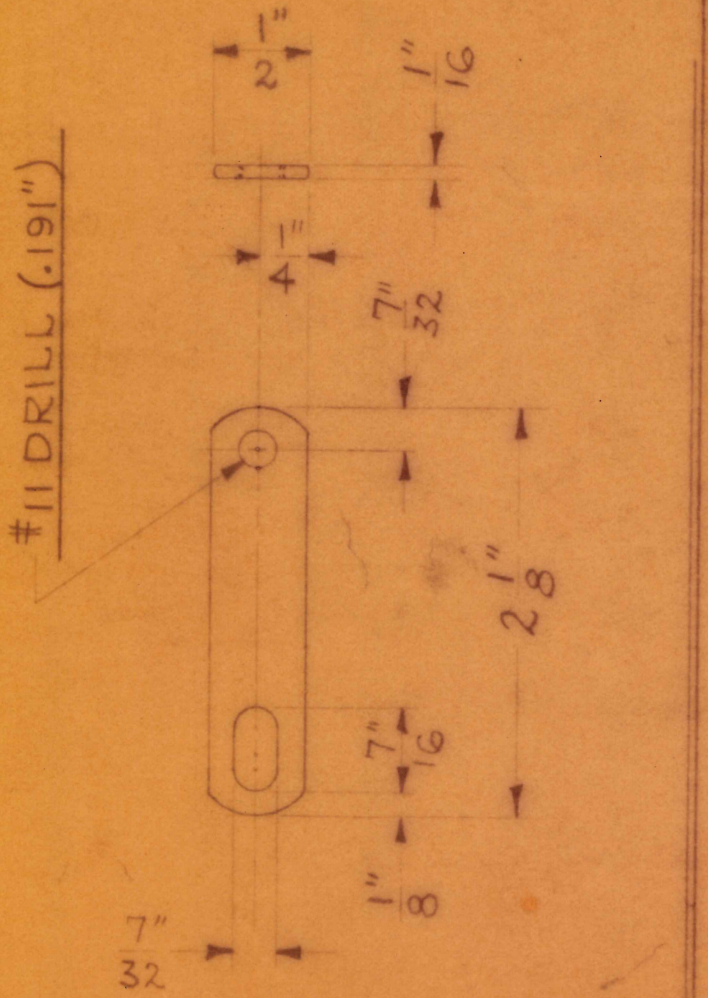

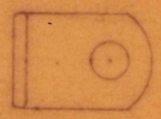

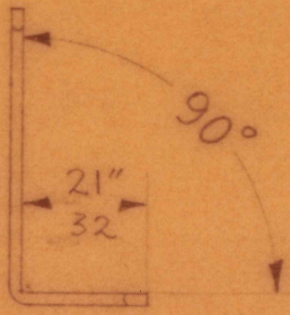

OPERATIONS

1ST CUT-OFF & PIERCE
2ND PUT THRU FLATTENING DIE
3RD BEND

OBSOLETE
4-22-80

NEXT ASSEMBLY	
NUMBER	QTY.
208-417	1

NUMBER 103-250

CONSISTS OF HANDLE AND (2) 10-24 UNC X.53 LG. SCREWS

L - LENGTH	-	4.78 REF
W - WIDTH	-	.53 REF
B - LENGTH MTG	-	4.00 ± .03
A - THREAD	-	10-24 UNC
MATERIAL	-	ZINC
FINISH	-	BRIGHT CHROME
MANUFACTURER	-	NATIONAL LOCK
MFR. NO.	-	61-371

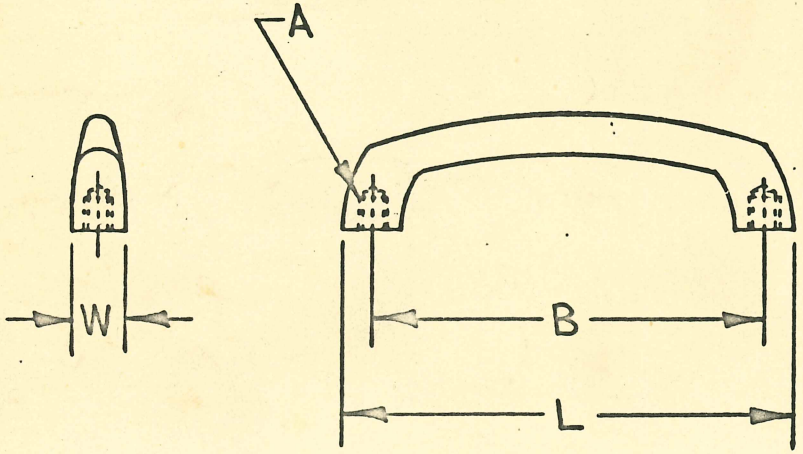

OBSOLETE
4-22-80

B	NO CHNG PER PRE-PROD RELEASED	A 0451	10-2-73 1-31-73
A	REDWN TO G STDS FROM FISCHER 103-250 (20955) NO REV	9308	4/14/72
	DESCRIPTION	ECO	DATE
	REVISIONS		

UNLESS OTHERWISE SPEC. DIMENSIONS ARE IN INCHES

TOLERANCES
FRACTIONS ±
DECIMALS ±
ANGLES ±

GRACO
Minneapolis, Minn.

DRAWN	DE	2-17-72
CHECKED		1-6-72
ENGINEER		1-29-73
APPROVED		1-29-73

PURCHASED PART DRAWING

TITLE
HANDLE

SIZE	CODE IDENT. NO.	NUMBER
A		103-25

SCALE 1/2X SHEET 1 OF

NEXT ASSEMBLY	
PART NO.	QTY.
208-417	1

NUMBER 103-250

NATIONAL LOCK # 61-371

OBSOLETE
4-22-80

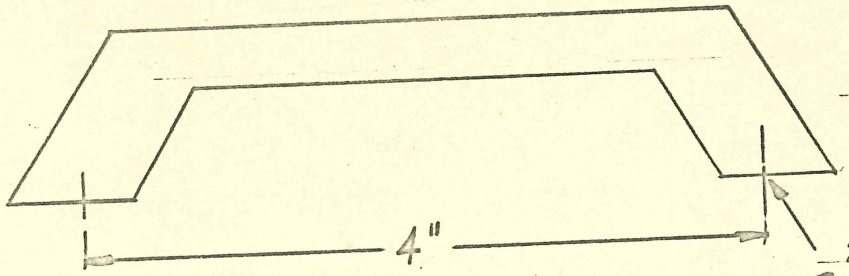

CHROME FINISH

2-#10-24 TAPPED HOLES
2-#10-24 RD. HD SCREWS
INCLUDED

LTR	DESCRIPTION	ECO	DATE

REVISIONS

MATERIAL

SPEC. NO.

ENG. SPEC.

SPEC. NO.

DIMENSIONS ARE IN INCHES
TOLERANCES UNLESS OTHERWISE SPEC.
DECIMALS .X ±.030 .XX ±.010 .XXX ±.005
ANGLES ±½°

SCALE AS SHOWN
NET WEIGHT

DRAFTSMAN 8-26-71
CHECKER J.V.W. 8-27-71
ENGINEER J.V.W. 8-27-71
APPROVAL

GRACO

GRACO INC.
Minneapolis, Minnesota

TITLE
HANDLE

FEDERAL STOCK NO.

SIZE	CODE IDENT. NO.	NUMBER
A	25980	103-250

GRACO FORM NO. 315093 REV. 2-68

TITLE
FISCHER "TC-30-96 S.P. MOBILE X-RAY IDENTIFICATION PLATE

H. G. FISCHER & CO.
FRANKLIN PARK, ILLINOIS

PART NO. 12788A

DATE 7-14-49 DR. BY J.N.W. CH'K'D.

REVISION	DATE	BY

PATTERN | FINISH | SCALE FULL

TOOLS | MATERIAL .020" SHEET ALUMINUM

DIMENSIONS
FRACTIONAL ± .015
DECIMAL ± .005
ANGULAR ± ½°
UNLESS OTHERWISE SPECIFIED

SAME AS OUR PART # 12788 EXCEPT SUBSTITUTE BLANK AREA FOR "IC" AND LEAVE OUT LIGHTNING MARKS

2 HLS.- #51 DRILL (.067")

LETTERING - BLANK AREA AN BORDER
PLAIN ANODIZED ALUMINUM
BACKGROUND BLACK ANODIZE

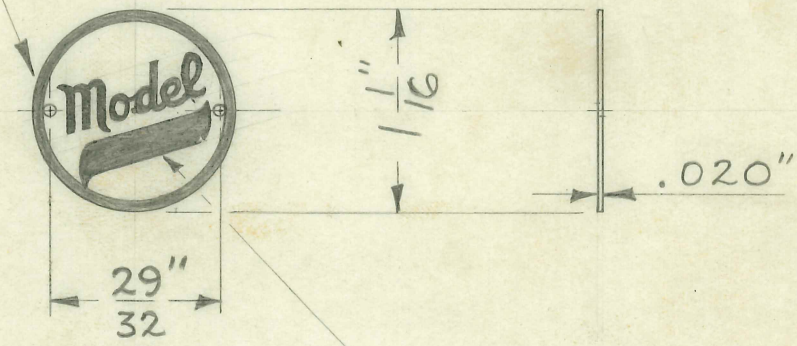

RECTANGULAR BLANK AREA MUST BE
5/32" WIDE BY (AT LEAST) 5/8" LONG
EXCLUSIVE OF END TREATMENT

1 REQUIRED

FOLDER #101

TITLE
UNIVERSAL SECTIONAL GUIDE RAIL
2 FT SECTION WITH TONGUE

H. G. FISCHER & CO.
FRANKLIN PARK, ILLINOIS

PART NO. 12178GA

DATE	DR BY	CH'K'D.

REVISION	DATE	BY

PATTERN | FINISH CAD. #23 | SCALE

TOOLS | MATERIAL 1-#12181A 1-#12183B

DIMENSIONS
FRACTIONAL ± .015
DECIMAL ± .005
ANGULAR ± ½°
UNLESS OTHERWISE SPECIFIED

OBSOLETE
4-22-80 J.S

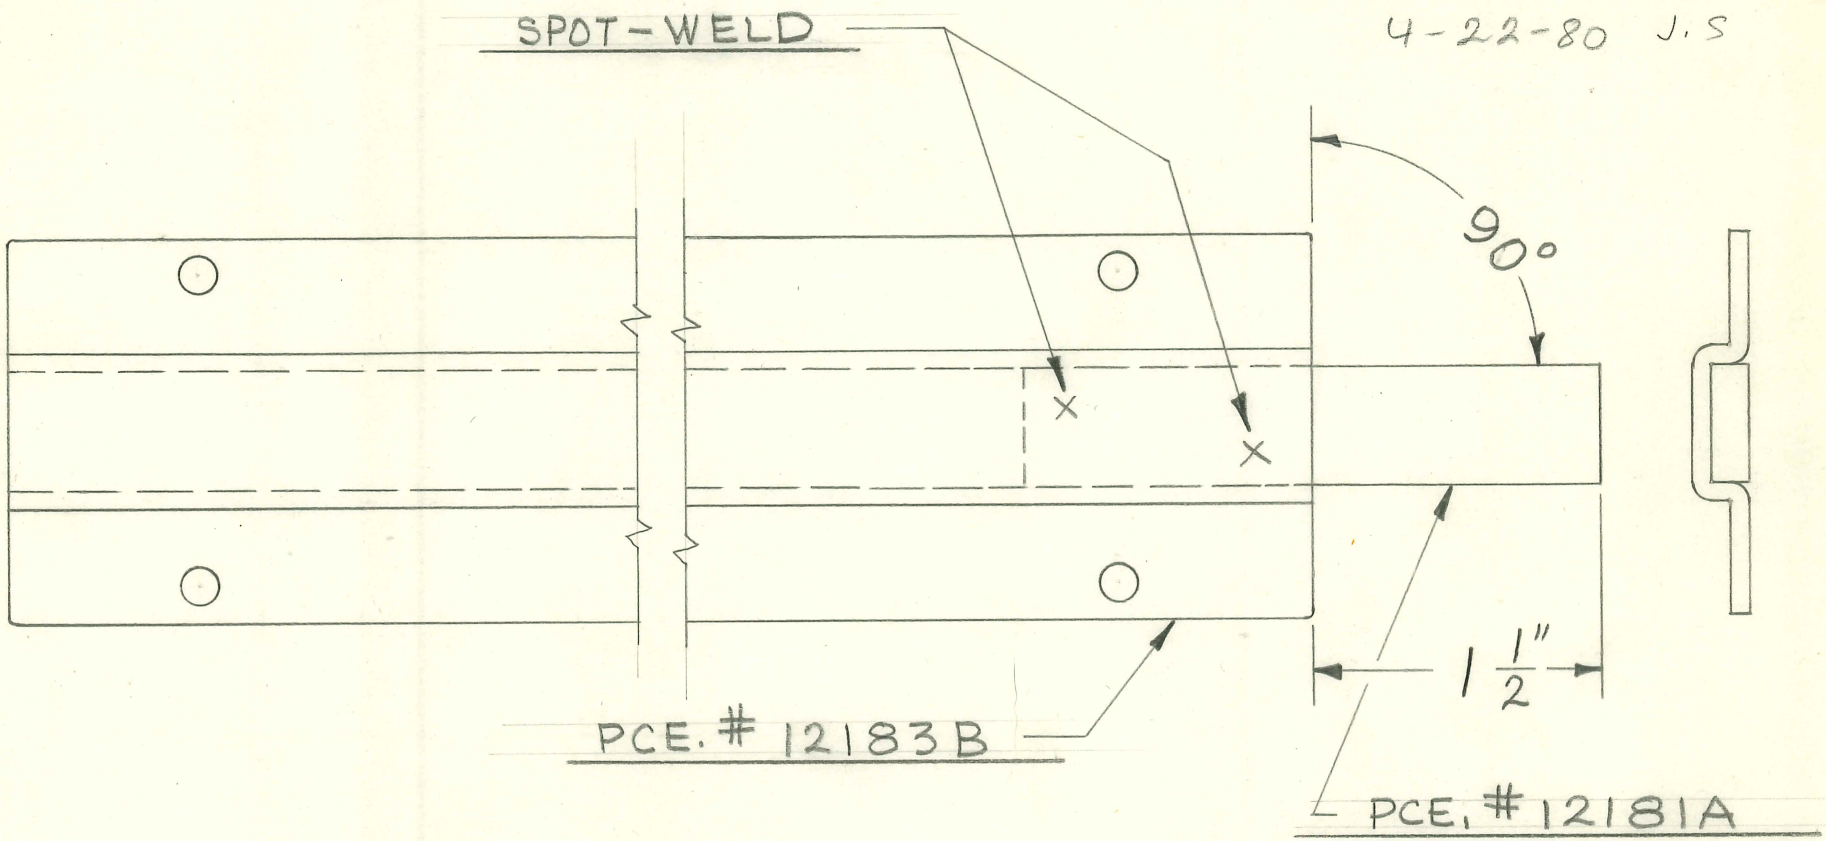

TITLE
UNIVERSAL SECTIONAL GUIDE RAIL
3 FT. SECTION WITH TONGUE

H. G. FISCHER & CO.
FRANKLIN PARK, ILLINOIS

PART NO. 12179GA

DATE 1-4-56 DR BY J.V.W. CH'K'D.

REVISION	DATE	BY

PATTERN | FINISH CAD. #23 | SCALE FULL

TOOLS | MATERIAL 1-#12181A, 1-#12180B

DIMENSIONS
FRACTIONAL ± .015
DECIMAL ± .005
ANGULAR ± ½°
UNLESS OTHERWISE SPECIFIED

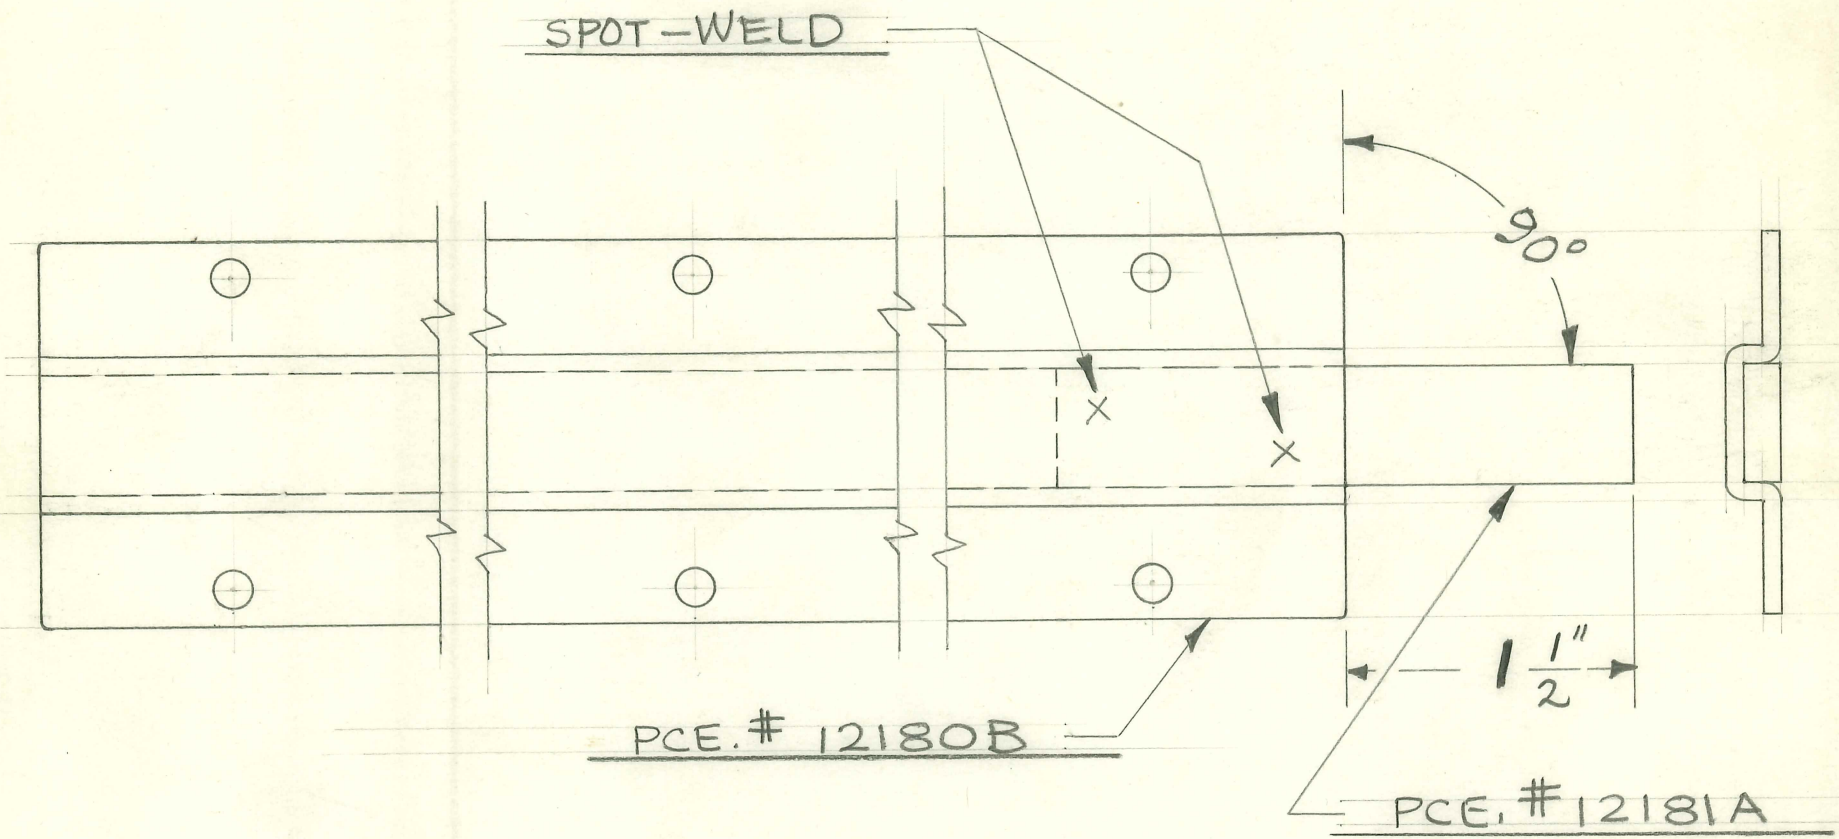

OBSOLETE
4-22-80 J.S

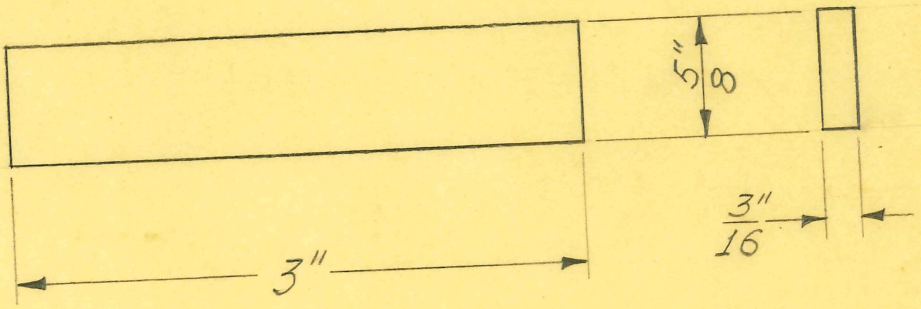

OBSOLETE
4-22-80 J.S.

SIZE	5/8 X 3/16"	ISSUE 12-15-39	J.W.
KIND	C.R. STEEL	CHANGED	
SHAPE	BAR	"	
FINISH		"	
TEMP.		"	
		"	

TITLE: UNIVERSAL SECTIONAL GUIDE RAIL CONNECTION LINK

H. G. FISCHER & CO.
2335 WABANSIA AVE.
CHICAGO, ILL.

CAT. NO.

PART NO. 12181A

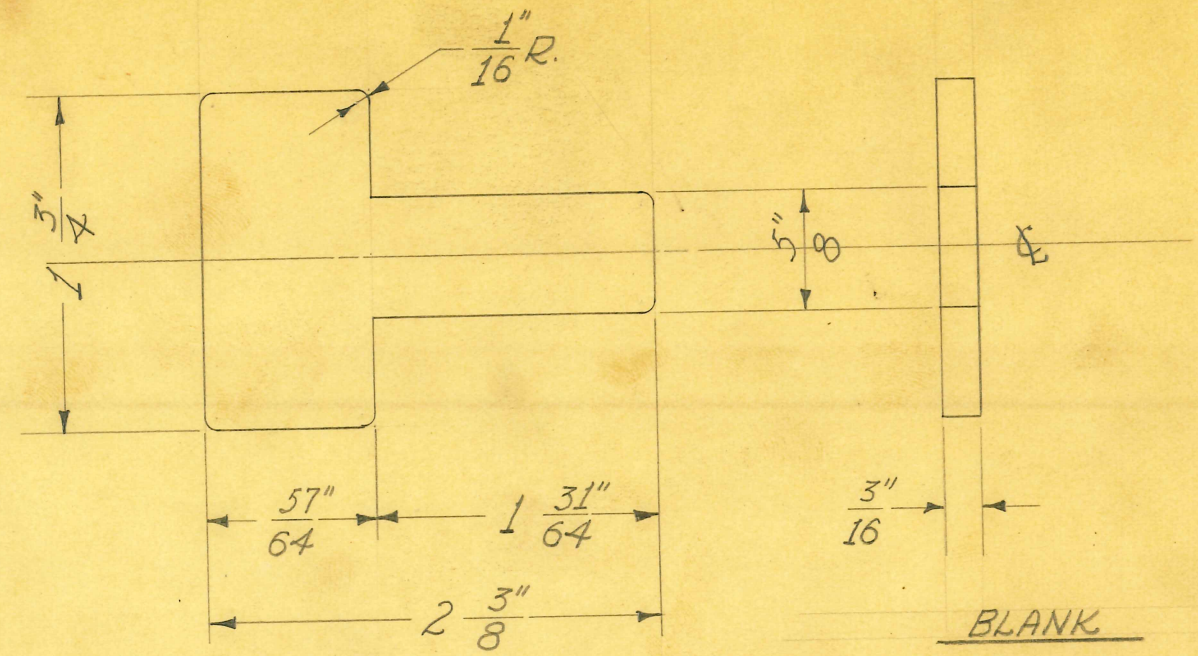

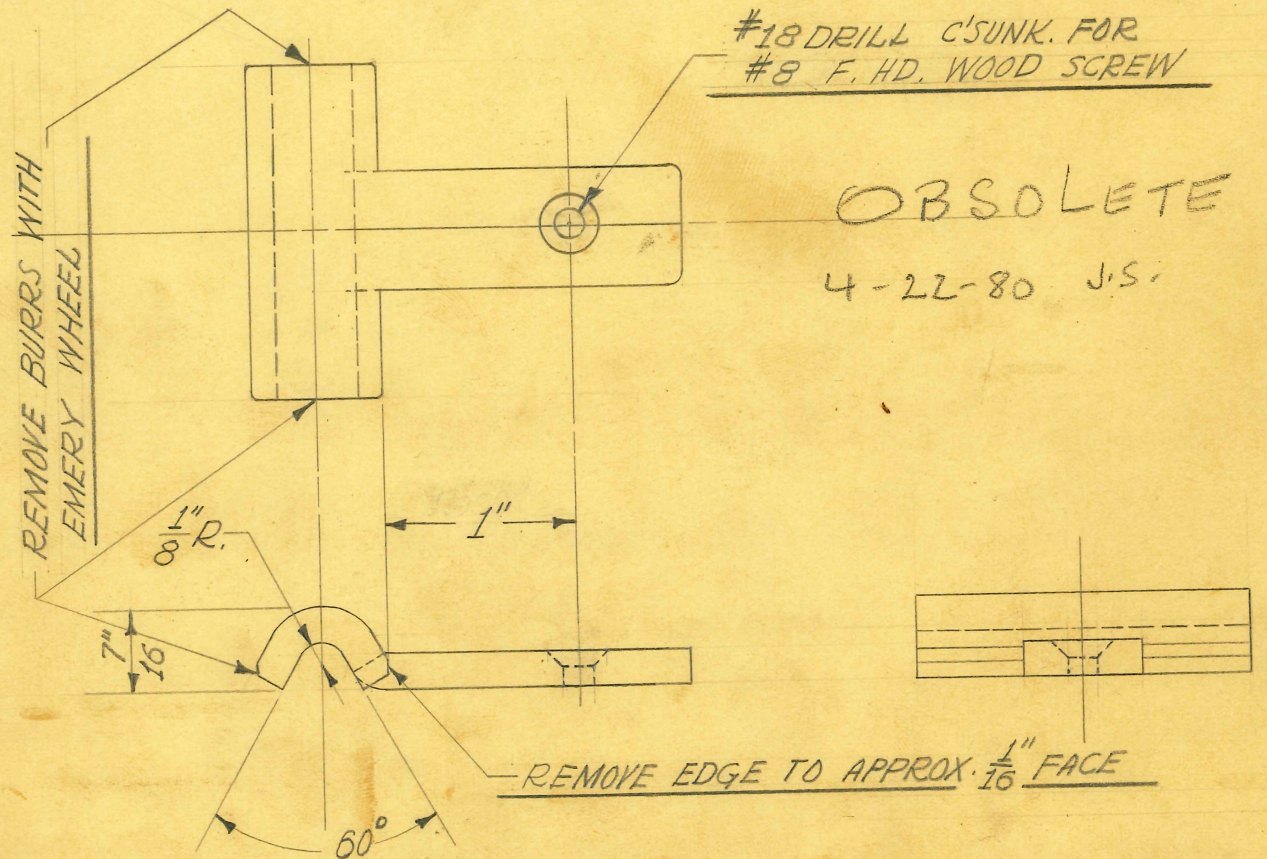

SIZE	3/16" X 2" C.R.	ISSUE 11-9-38	J.W.
KIND	STEEL STRIP	CHANGED 12-15-39	J.W.
~~SHAPE~~	(DEAD SOFT)	"	
FINISH	CAD. #23	"	
TEMP.		"	
PATT.		"	

TITLE: UNIVERSAL SECTIONAL GUIDE RAIL END STOP

H. G. FISCHER & CO.
2335 WABANSIA AVE.
CHICAGO, ILL.

CAT. NO.

PART NO. 12182A

TITLE
UNIVERSAL SECTIONAL GUIDE RAIL
2 FT. LENGTH

H. G. FISCHER & CO.
FRANKLIN PARK, ILLINOIS

PART NO. 12183 B

DATE 1-4-56 | DR BY J.V.W. | CH'K'D.

REVISION	DATE	BY

PATTERN | FINISH CAD. #23 | SCALE FULL

TOOLS MASTER HOLE PUNCHING UNIT #972X

MATERIAL SELECTED STOCK #13 GA. (.089") +.000" -.010" SHEET C.R. STEEL

DIMENSIONS UNLESS OTHERWISE SPECIFIED
FRACTIONAL ± .015
DECIMAL ± .005
ANGULAR ± ½°

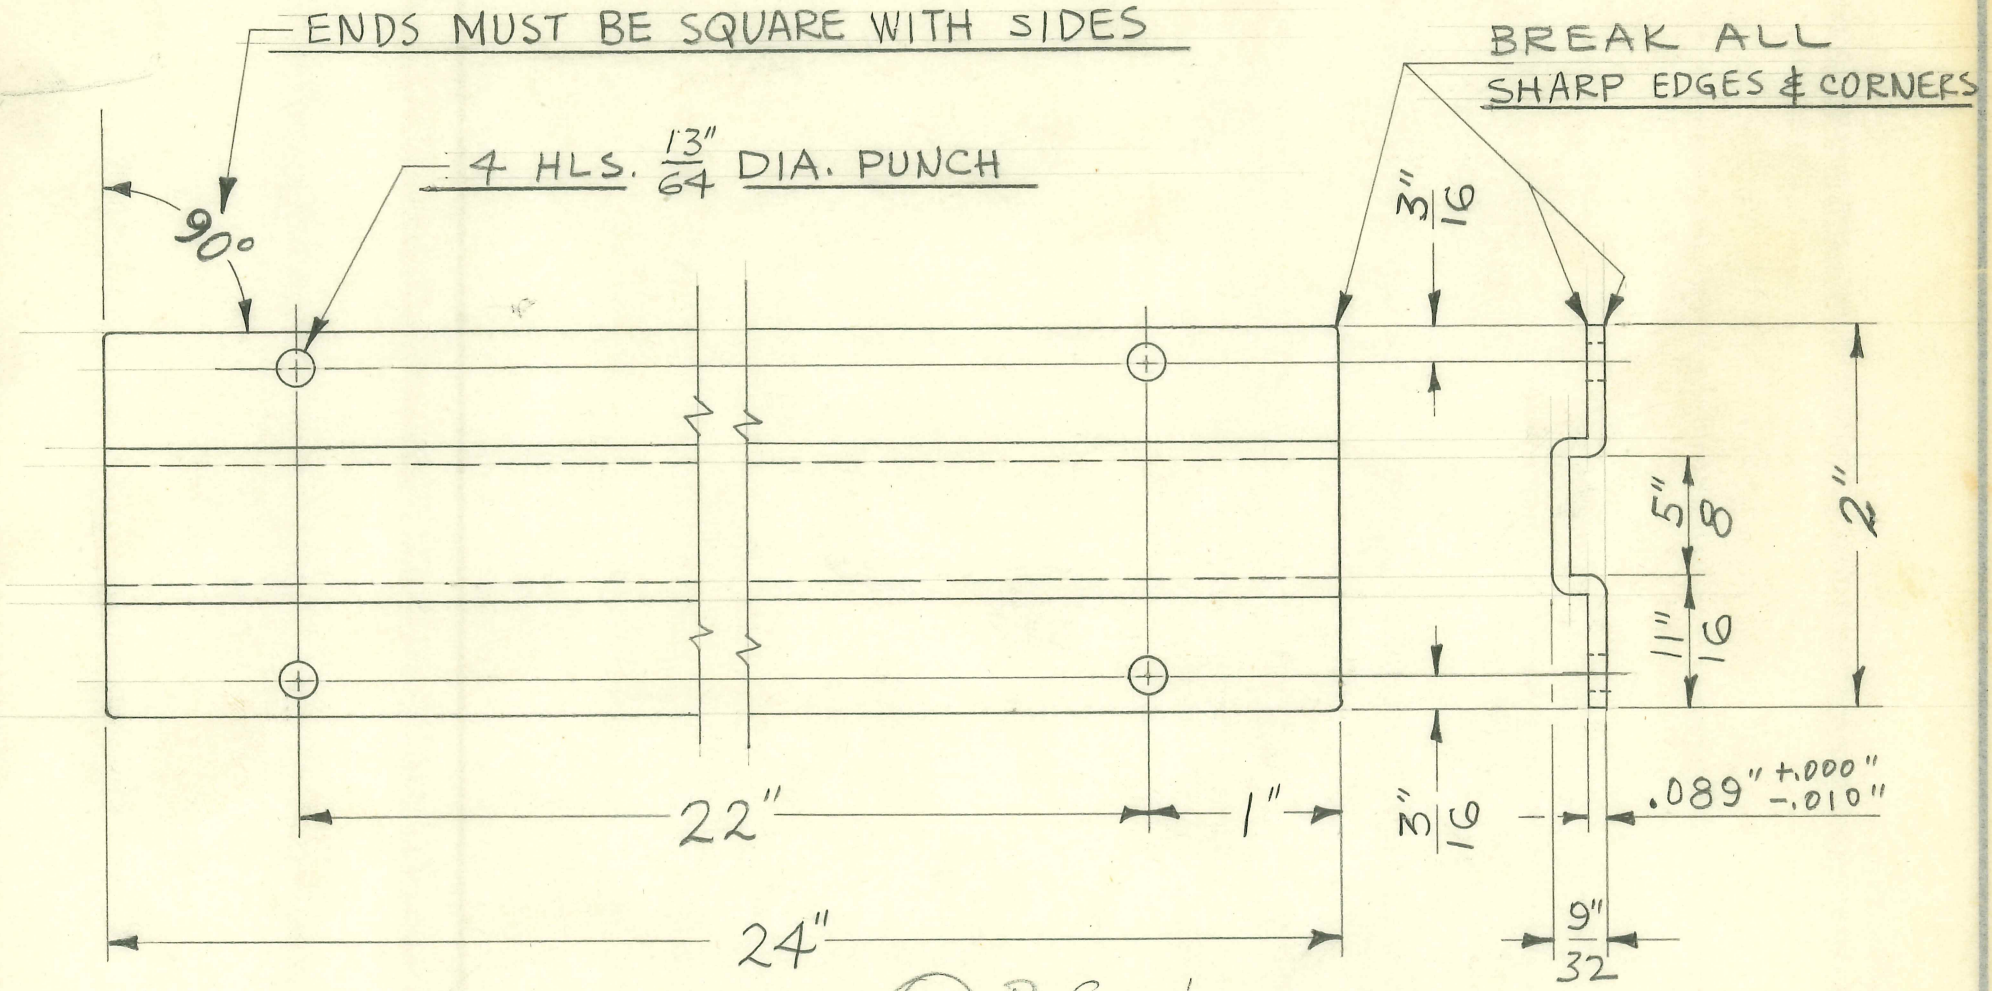

OBSOLETE
4-22-80 J.S

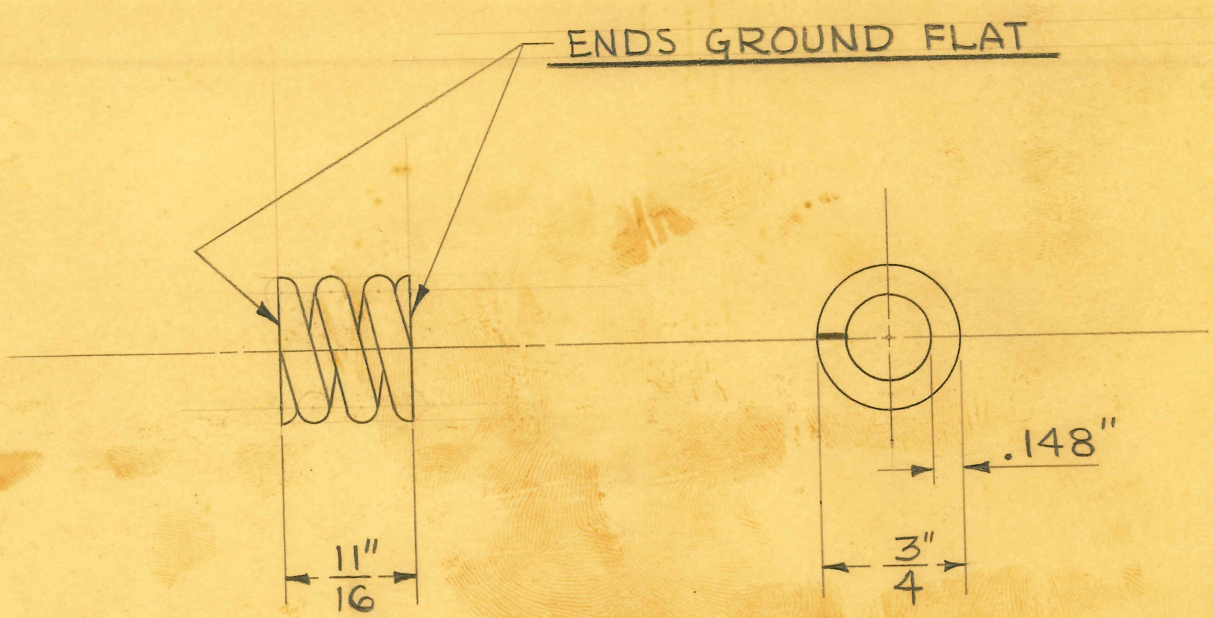

OBSOLETE
4-22-80 J.S

4 TURNS

#9 GA. (.1483") TEMPERED STEEL SPRING

SIZE		ISSUE 2-7-46	J.V.W.
KIND		CHANGED	
SHAPE		"	
FINISH		"	
TEMP.		"	
PATT.		"	

TITLE: FISCHER "GM" MOBILE UNIT
GUIDE RODS SWIVEL LOCK SPRING

H. G. FISCHER & CO.
2335 WABANSIA AVE.
CHICAGO, ILL.

CAT. NO.

PART NO. 12222

12228

CHROME DIE CASTING * LIND BRASS (125 A LEAD OR)

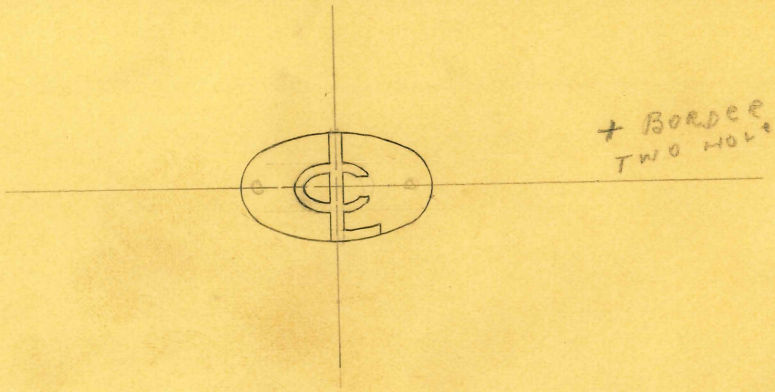

OBSOLETE
4-22-80 J.S.

.025 SOFT BRASS

Die 129VV

SIZE		ISSUE 10-14-38	J.W.
KIND		CHANGED	
SHAPE		"	
FINISH		"	
TEMP.		"	
PATT.		"	

TITLE: MOBILE UNIT - TABLE CENTER INDICATOR PLATE

H. G. FISCHER & CO.
2335 WABANSIA AVE.
CHICAGO, ILL.

CAT. NO.

PART NO. 12228

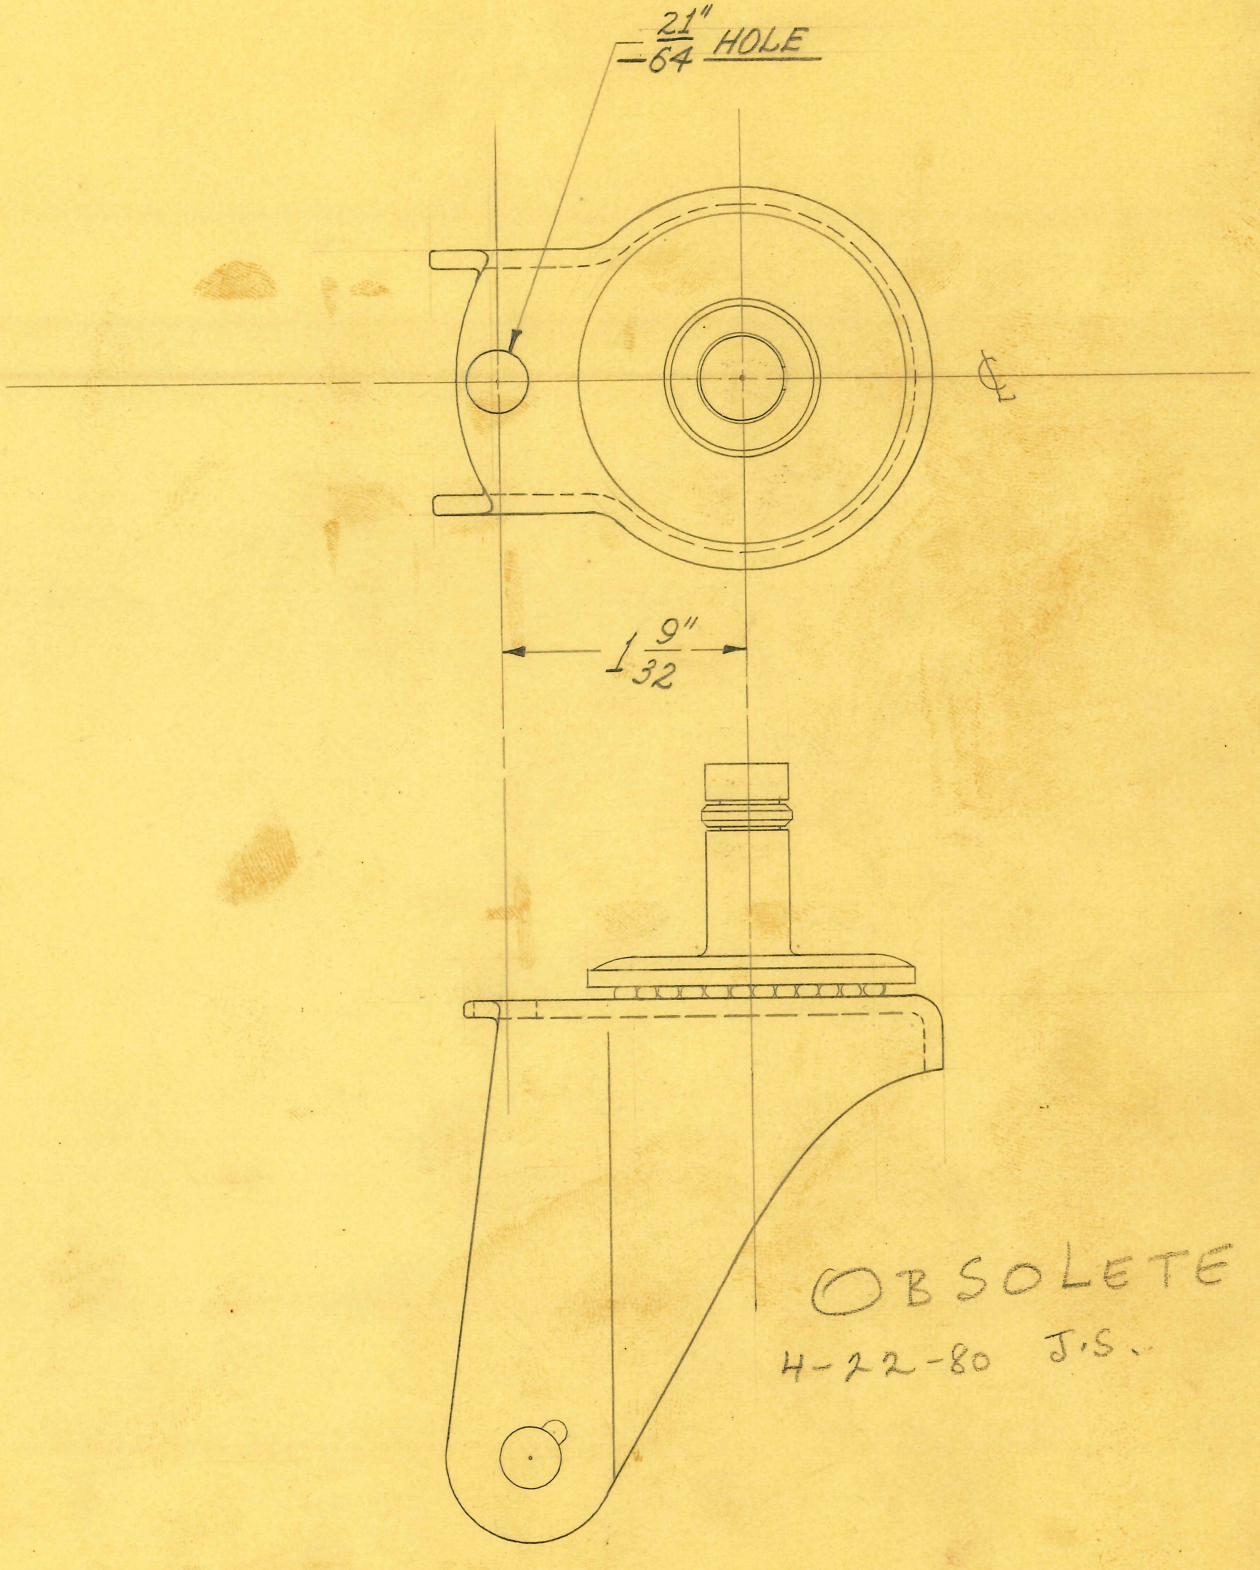

OBSOLETE
4-22-80 J.S.

SIZE		ISSUE 9-22-38	J.W.
KIND		CHANGED	
SHAPE		"	
FINISH		"	
TEMP.		"	
PATT.		"	

TITLE: FISCHER MOD. "GM" MOBILE UNIT - SPECIAL CASTER HORN

H. G. FISCHER & CO.
2335 WABANSIA AVE.
CHICAGO, ILL.

CAT. NO.

PART NO. 12266G

USED ON	QTY
32760GT	1

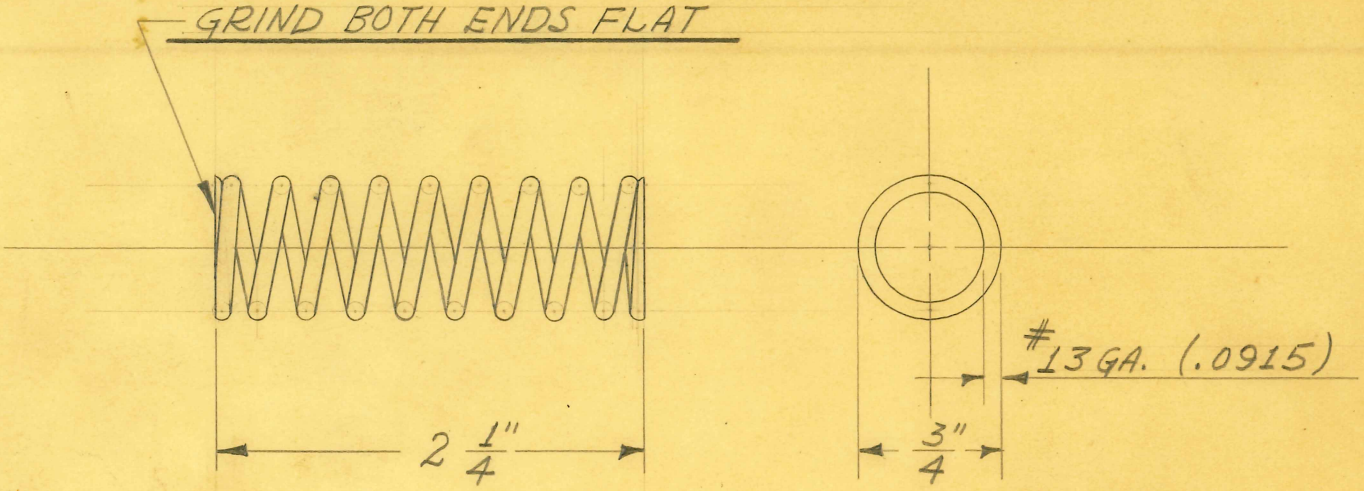

10 TURNS

OBSOLETE

4-22-80 J.S.

SIZE	#13GA. (.0915")	ISSUE 10-28-40	J.V.W.
KIND	SPRING WIRE	CHANGED	
SHAPE		"	
FINISH	PAINTED	"	
TEMP.		"	
PATT.		"	

TITLE: FISCHER MOD. "GM" MOBILE UNIT ROLLER SUPPORT BRACKET - SPRING

H. G. FISCHER & CO.
2335 WABANSIA AVE.
CHICAGO, ILL.

CAT. NO.

PART NO. 12296

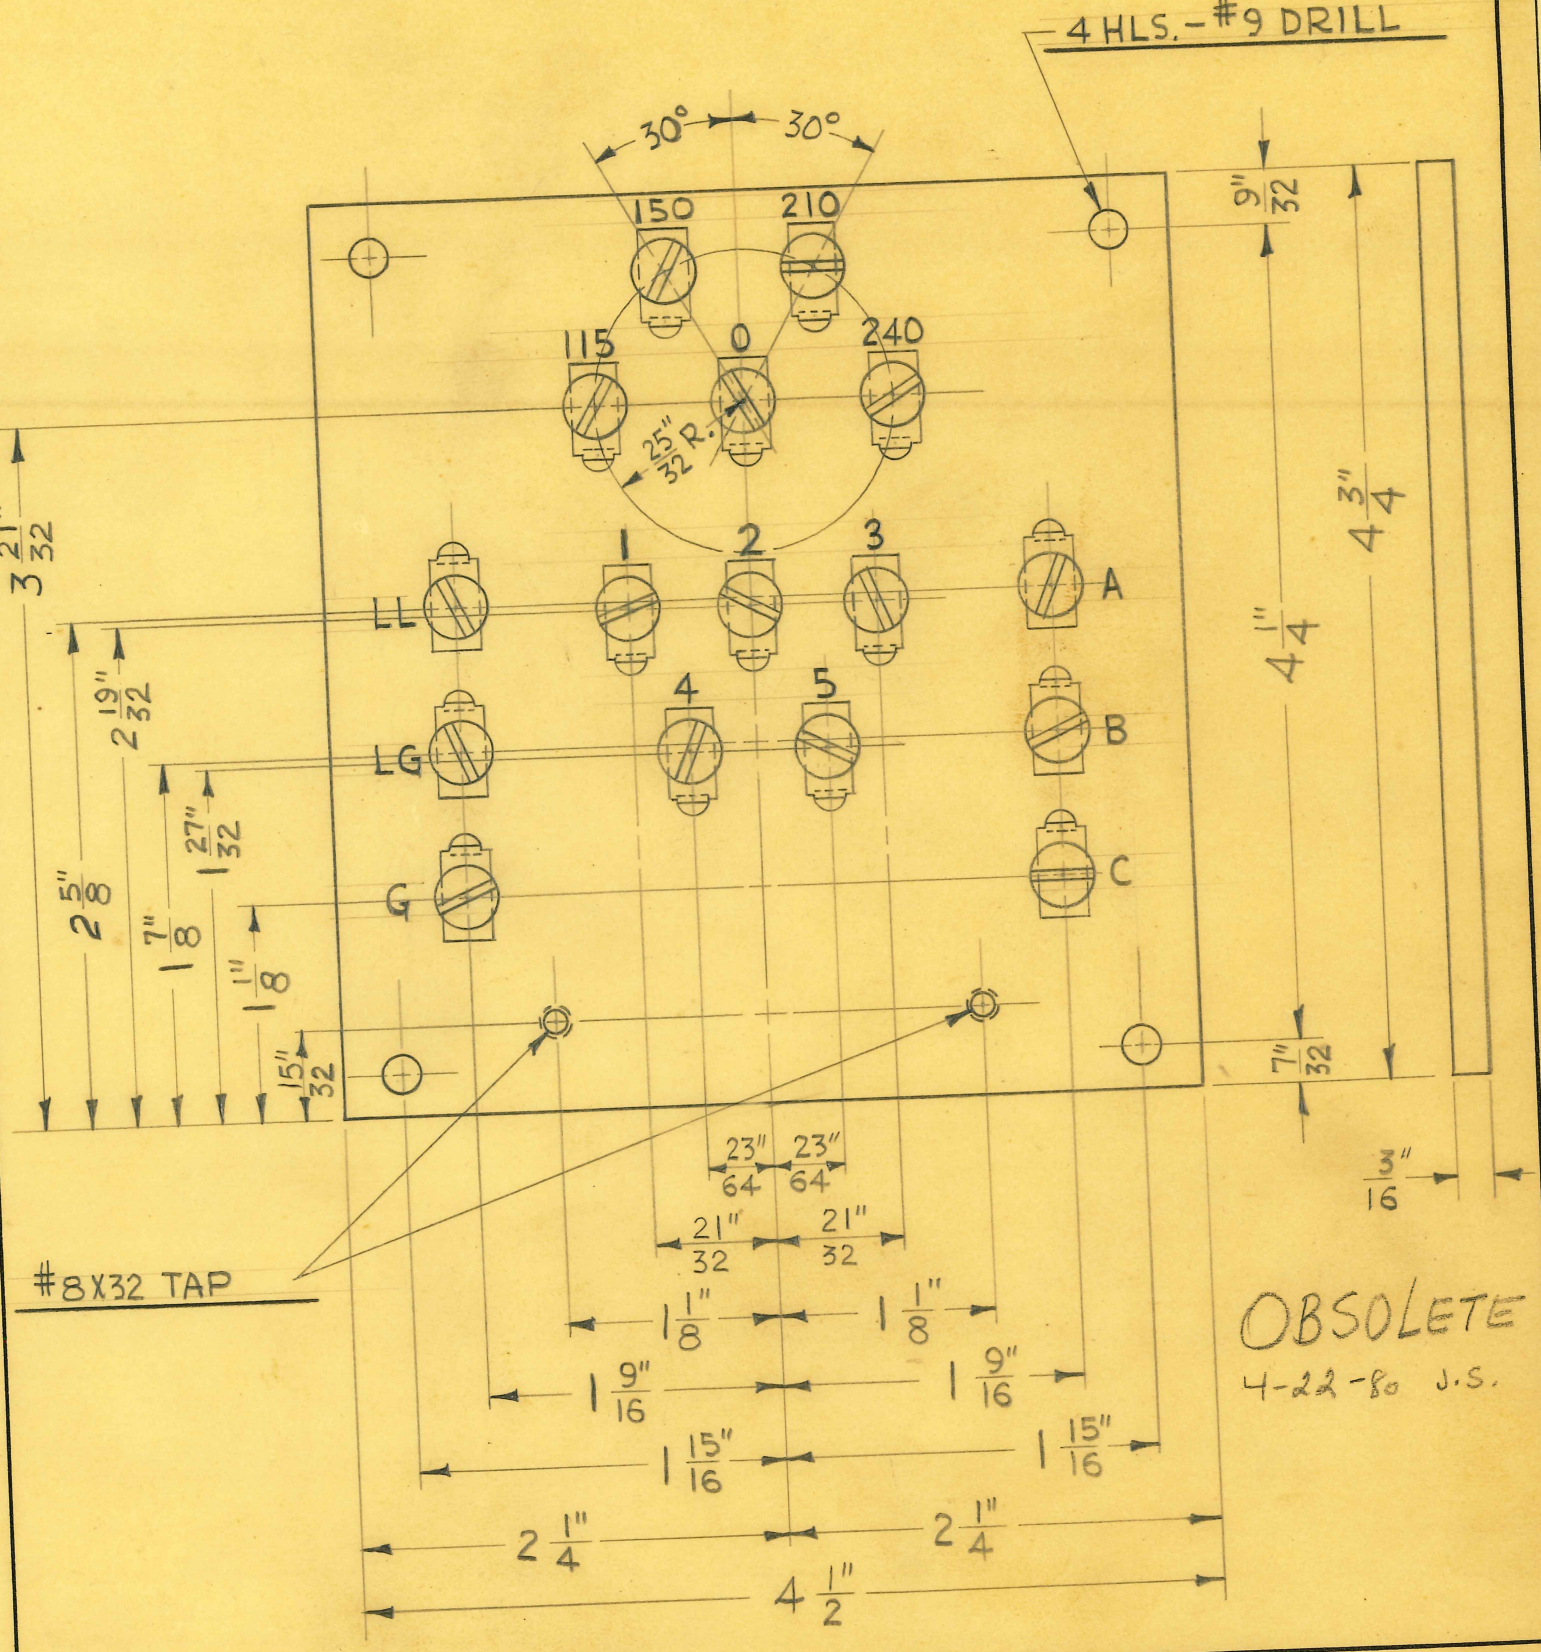

OBSOLETE
4-22-80 J.S.

SIZE		ISSUE 6-18-41	J.V.W.
KIND		CHANGED	
SHAPE		"	
FINISH		"	
TEMP.		"	
PATT.		"	

TITLE: FISCHER INTERMEDIATE REMOTE CONTROL FOR "G" PORT. — TERMINAL MTG. BOARD 220 VOLT

H. G. FISCHER & CO.
2335 WABANSIA AVE.
CHICAGO, ILL.

CAT. NO.

PART NO. 12302G

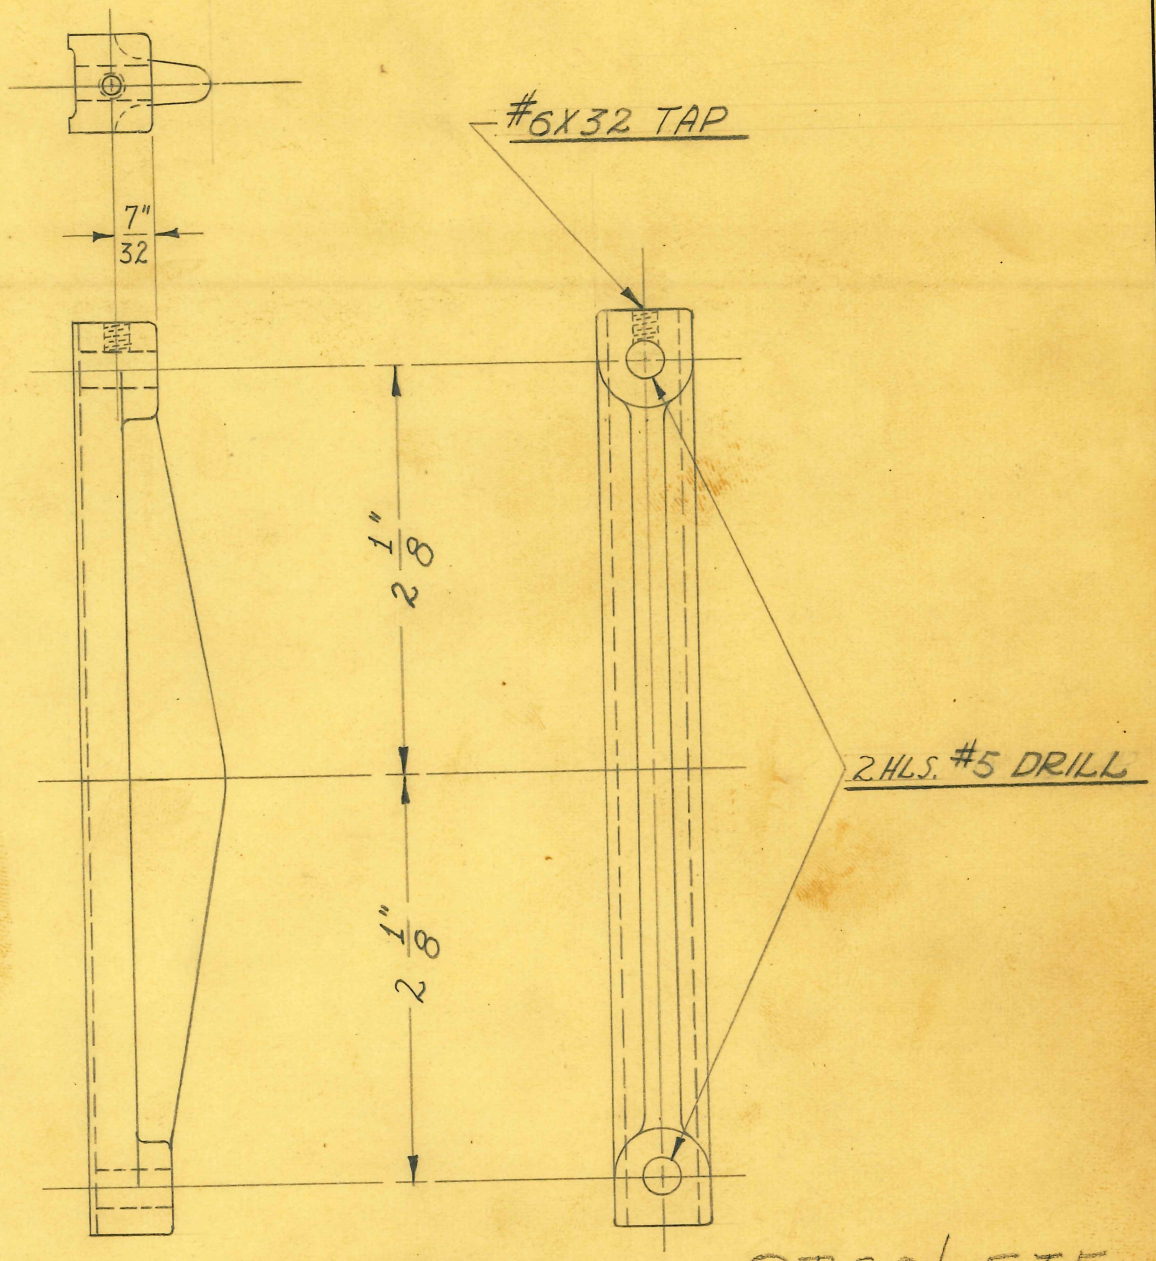

OBSOLETE
4-22-80 J.S.

2 REQUIRED

SIZE	#214	ISSUE 2-16-39	J.W.
KIND	ALUM.-CASTING	CHANGED	
SHAPE		"	
FINISH	BLACK #80	"	
TEMP.		"	
PATT.	1348	"	

TITLE: FISCHER WALL MOD. D.X. AUTO TRANSF. SUPPORT - LOWER

H. G. FISCHER & CO.
2335 WABANSIA AVE.
CHICAGO, ILL.

CAT. NO.

PART NO. 12337F

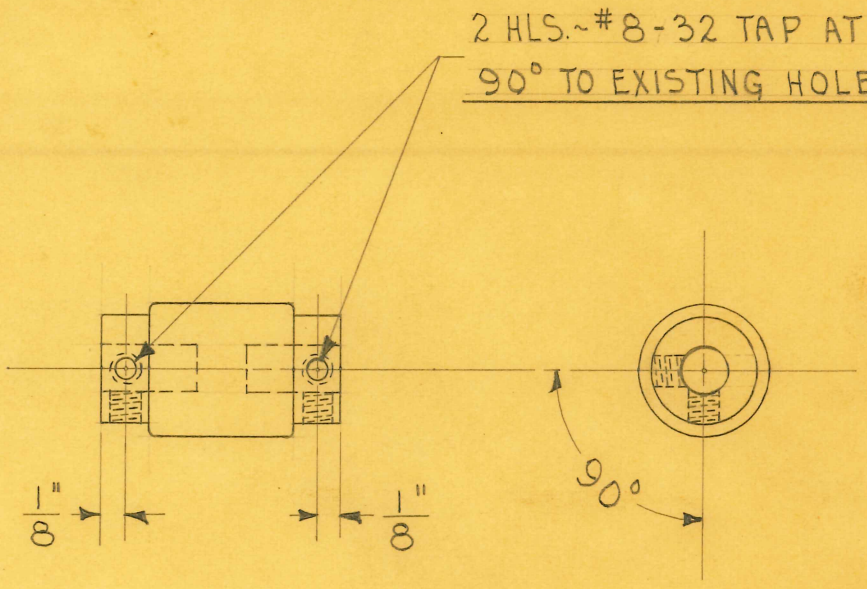

1 REQUIRED

OBSOLETE
4-22-80 J.S.

SIZE	FROM 12468GA	ISSUE 3-18-44	HE.
KIND		CHANGED	
SHAPE		"	
FINISH		"	
TEMP.		"	
PATT.		"	

TITLE: FISCHER "VC" SHORT WAVE APPARATUS~ INSULATING COUPLING

H. G. FISCHER & CO.
2335 WABANSIA AVE.
CHICAGO. ILL.

CAT. NO.

PART NO. 12468GAF

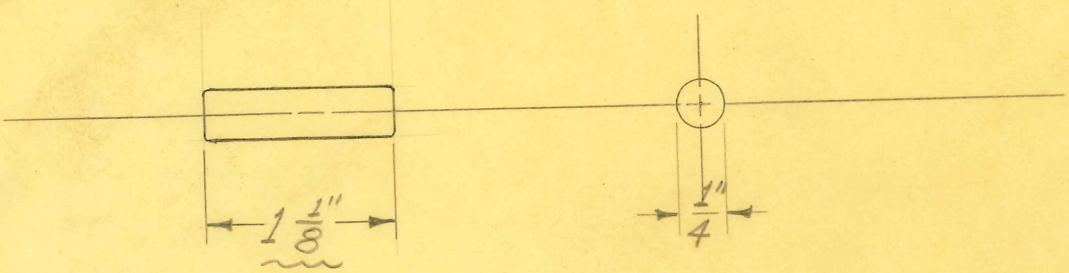

1 REQUIRED

OBSOLETE
4-22-80 J.S.

1/4" DIA. NYLON ROD
COLONIAL KOLONITE SPEC. #FM 10001 } CHANGED 1-11-54 JW.

SIZE	~~1/4" DIAM.~~	ISSUE 7-7-39	J.W.
KIND	~~BAKELITE~~	CHANGED 6-26-40	J.W.
SHAPE	~~ROD~~	" OHKO	RS
FINISH		"	
TEMP.		"	
PATT.		"	

TITLE: FISCHER MOD. "S" SHORT WAVE TUNING CONDENSER ROTOR SHAFT EXTENSION

H. G. FISCHER & CO.
2335 WABANSIA AVE.
CHICAGO, ILL.

CAT. NO.

PART NO. 12469A

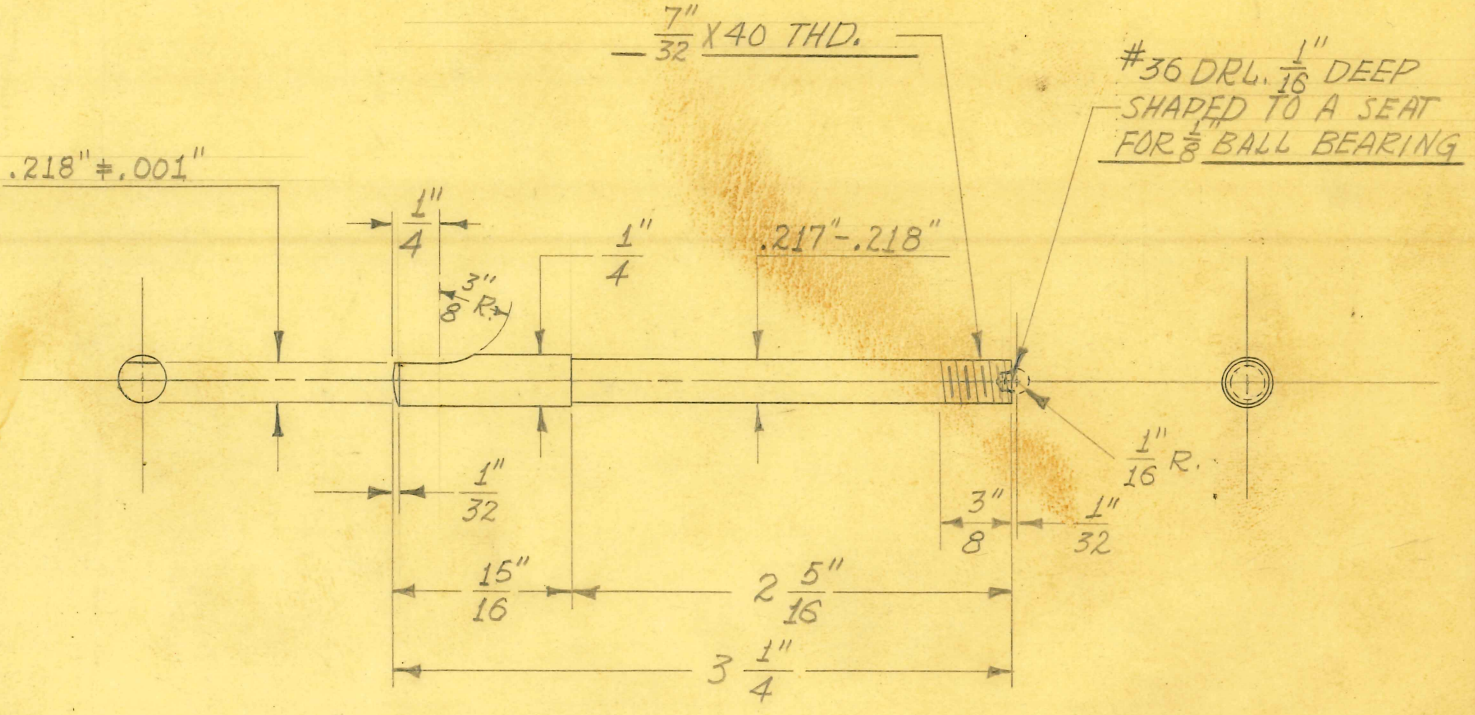

1 REQUIRED

OBSOLETE
4-22-80 J.S

SIZE	1/4" DIAM.	ISSUE 7-7-39	J.W.
KIND	C.R. STEEL	CHANGED	
SHAPE	ROD	"	
FINISH	CAD. #23	"	
TEMP.		"	
PATT.		"	

TITLE: FISCHER SMALL TUNING CONDENSER (FOR "S" SHORT WAVE) ROTOR PLATE SHAFT

H. G. FISCHER & CO.
2335 WABANSIA AVE.
CHICAGO, ILL.

CAT. NO.

PART NO. 12471

TITLE

FISCHER LIGHT MOBILE STAND
AUTOMATIC LOCK PIECE SPRING

H. G. FISCHER & CO.
FRANKLIN PARK, ILLINOIS

PART NO. 12483

DATE	DR. BY	CH'K'D.
8-9-49	W. J.	

REVISION	DATE	BY

PATTERN	FINISH	SCALE
		FULL

DIMENSIONS
FRACTIONAL ± .015
DECIMAL ± .005
ANGULAR ± ½°
UNLESS OTHERWISE SPECIFIED

TOOLS

MATERIAL
.080" SPRING WIRE

1 REQUIRED

OBSOLETE
4-22-80 J.S

2 1/4 TURNS

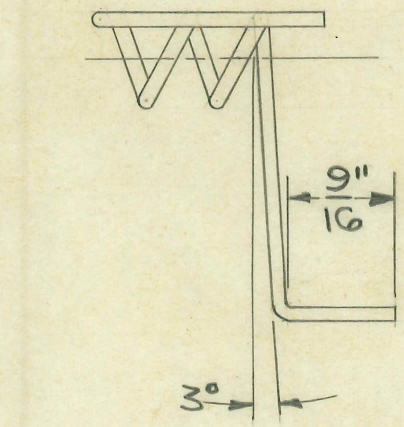

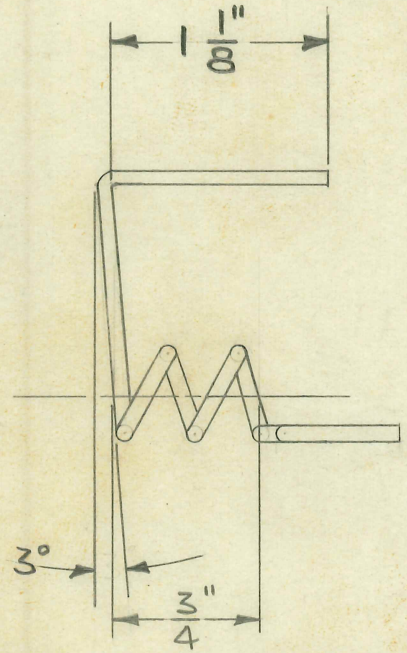

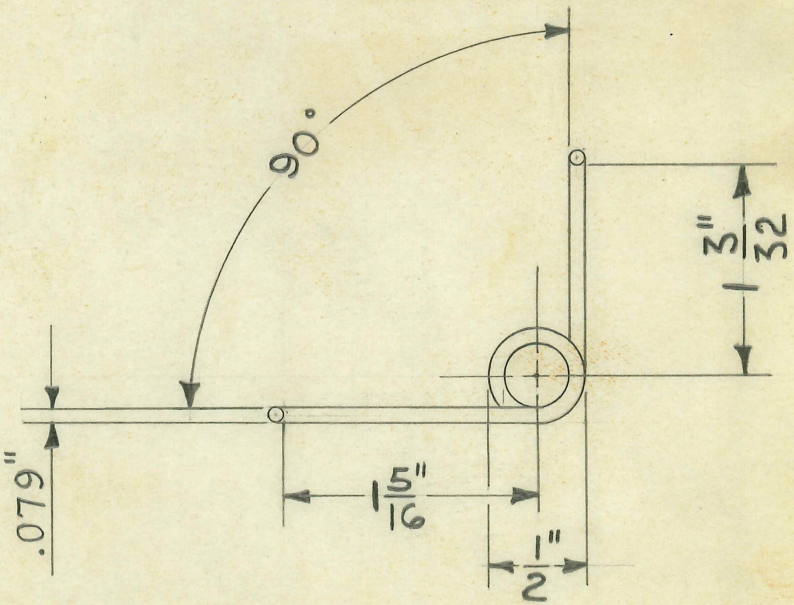

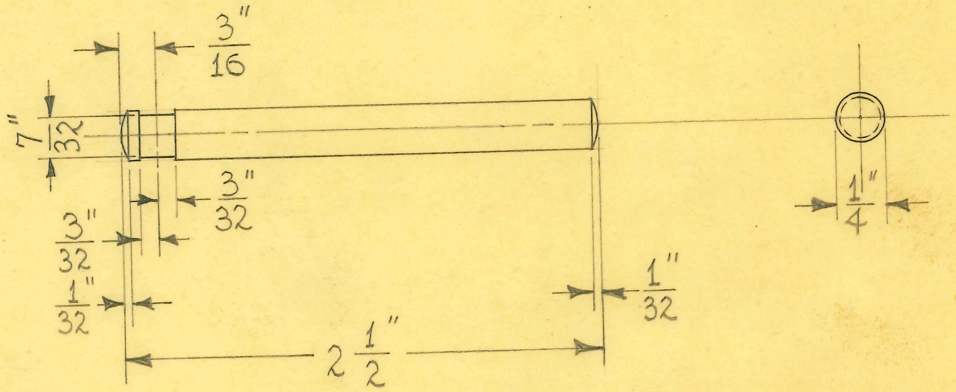

1 REQUIRED

OBSOLETE
4-22-80 J.S

SIZE	1/4" DIAM.	ISSUE 8-2-39	HE.
KIND	C.R.STEEL	CHANGED	
SHAPE		"	
FINISH	CAD. #23	"	
TEMP.		"	
PATT.		"	

TITLE: LIGHT MOBILE STAND
AUTOMATIC LOCK PIECE SHAFT

H. G. FISCHER & CO.
2335 WABANSIA AVE.
CHICAGO. ILL.

CAT. NO.

PART NO. 12484

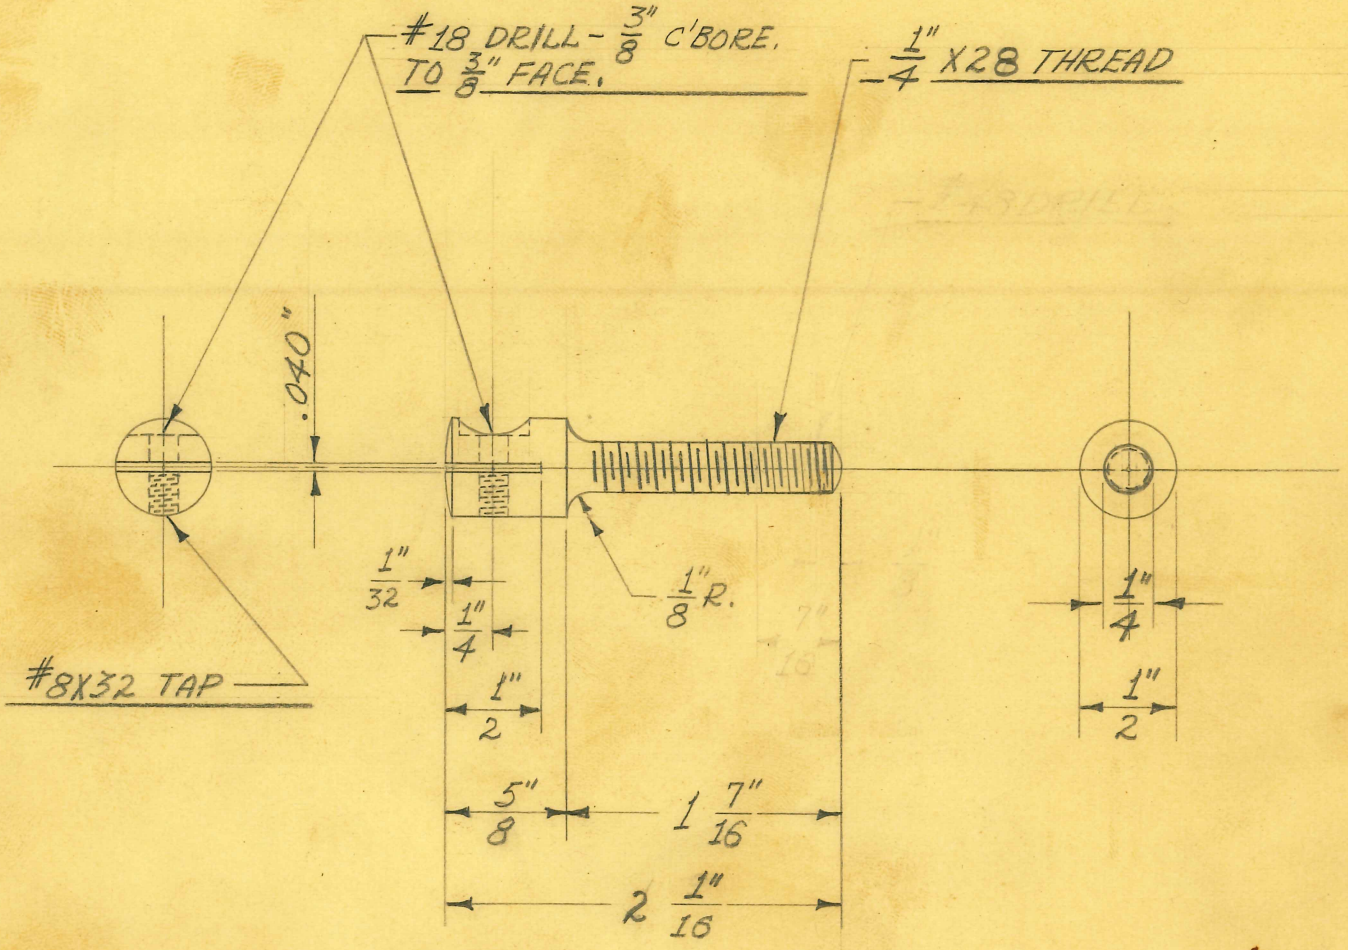

1 REQUIRED

OBSOLETE

RS

SIZE	1/2" DIAM.	ISSUE 2-14-39	J.W.
KIND	C.R. STEEL	CHANGED 5-1-46	J.V.W.
SHAPE	ROD	"	
FINISH	CAD. #23	"	
TEMP.		"	
PATT.		"	

TITLE: LIGHT MOBILE STAND
FRICTION CLAMP PLATE STUD

H. G. FISCHER & CO.
2335 WABANSIA AVE.
CHICAGO, ILL.

CAT. NO.

PART NO. 12492 A

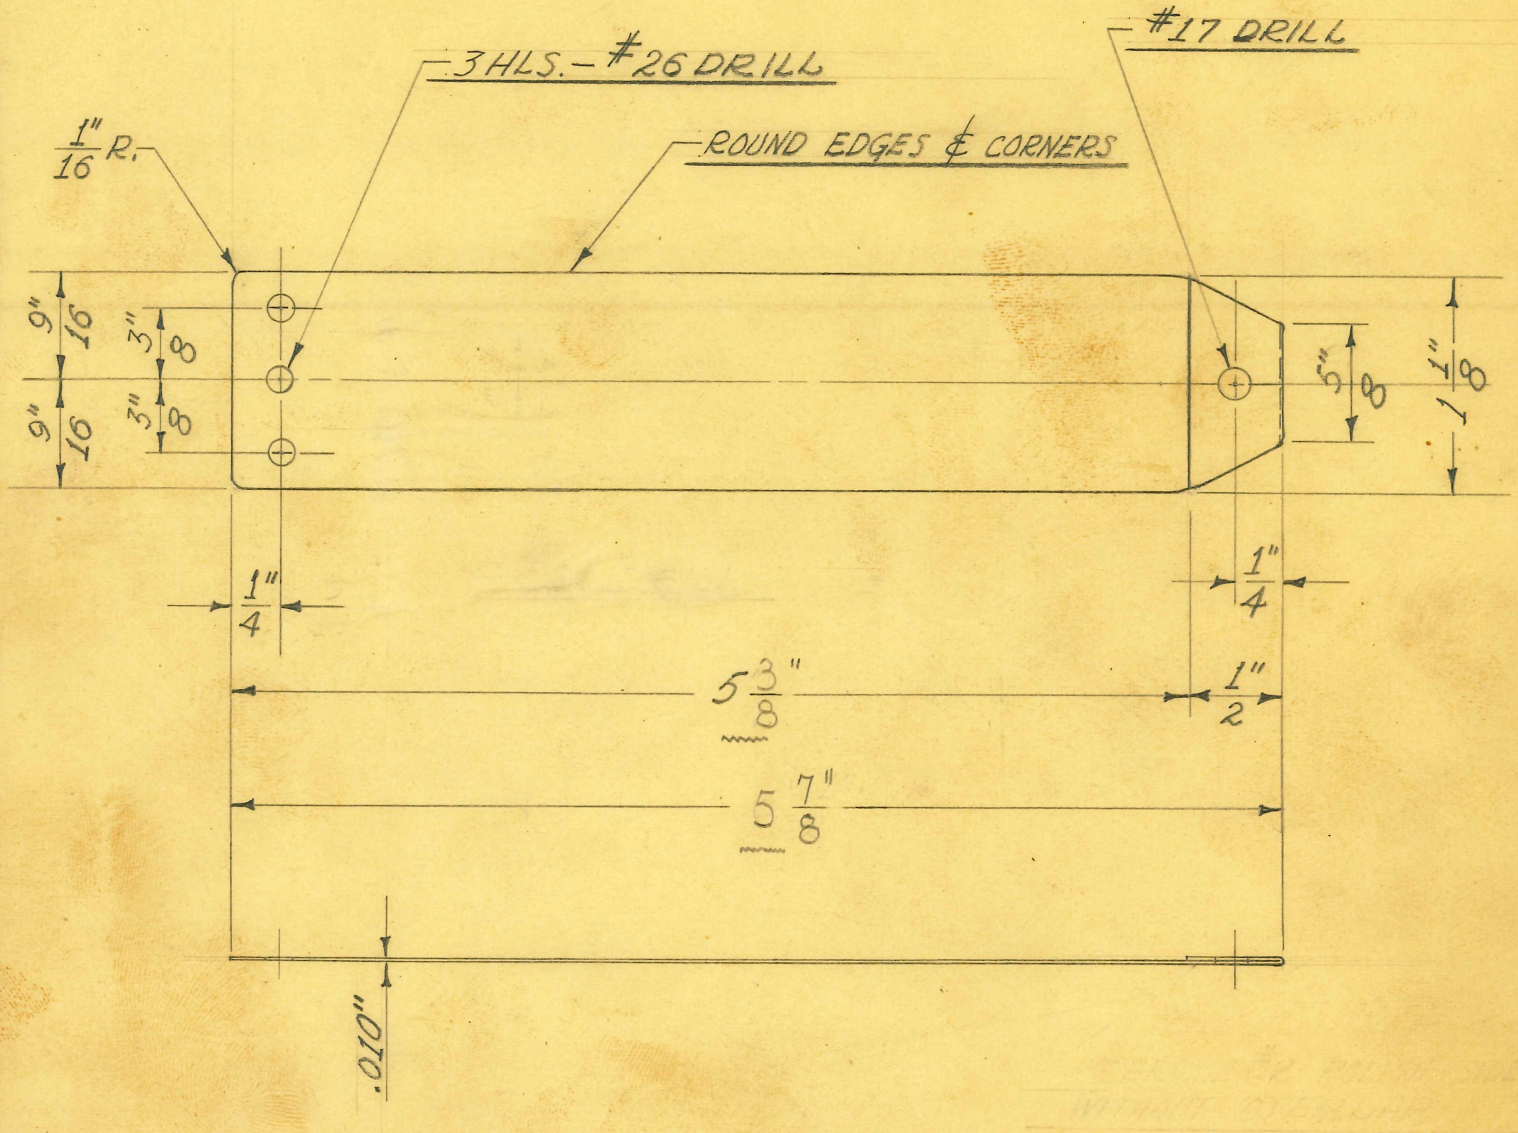

DEVELOPED LENGTH = 6 3/8"

1 REQUIRED

SIZE	.010" SHEET	ISSUE 2-7-39	J.W.
KIND	PHOS. BRONZE	CHANGED 7-5-39	J.W.
SHAPE		" 8-2-39	H.E.
FINISH	DULITE #8	"	
TEMP.	#123	"	
PATT.		"	

TITLE:
LIGHT MOBILE STAND
FRICTION CLAMP PLATE

H. G. FISCHER & CO.
2335 WABANSIA AVE.
CHICAGO, ILL.

CAT. NO.

PART NO. 12493 B

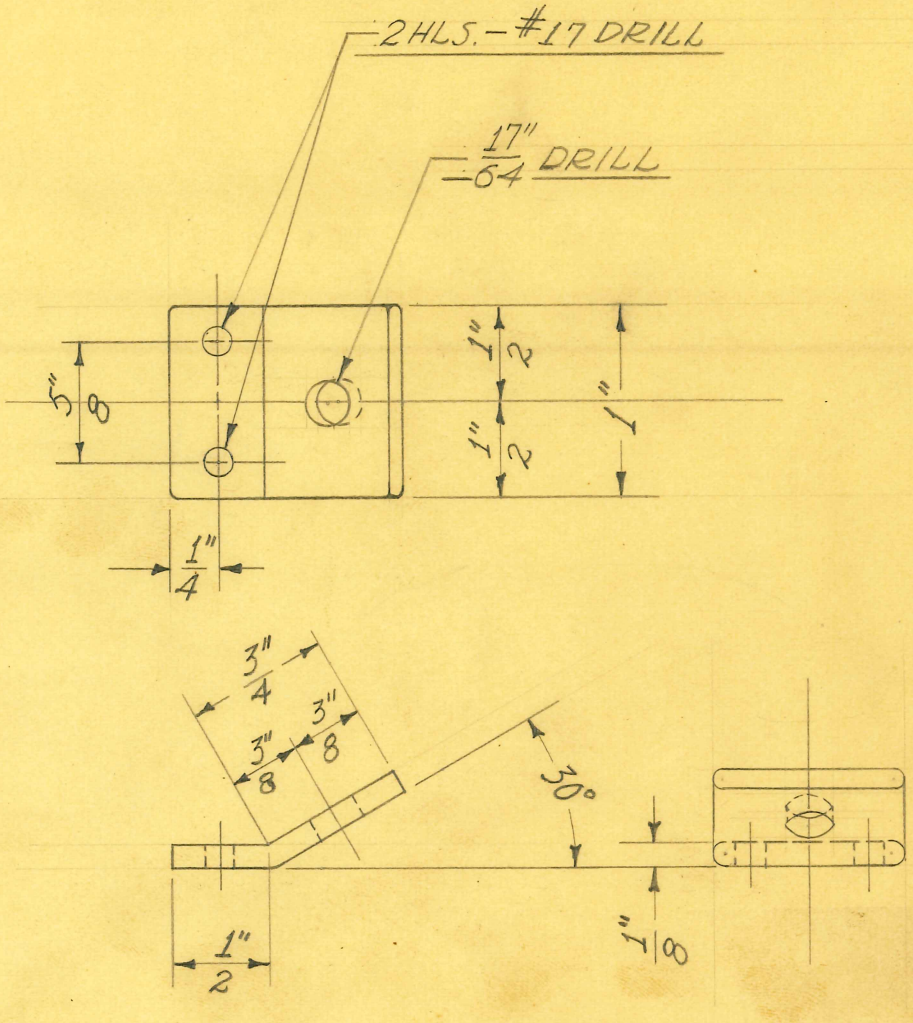

DEVELOPED LENGTH = 1 1/4"

1 REQUIRED

SIZE	1" X 1/8"	ISSUE 2-7-39	J.W.
KIND	FLAT WIRE	CHANGED	
SHAPE		"	
FINISH	CAD 23	"	
TEMP.		"	
PATT.		"	

TITLE:
LIGHT MOBILE STAND
FRICTION CLAMP SUPPORT PIECE

H. G. FISCHER & CO.
2335 WABANSIA AVE.
CHICAGO, ILL.

CAT. NO.

PART NO. 12494

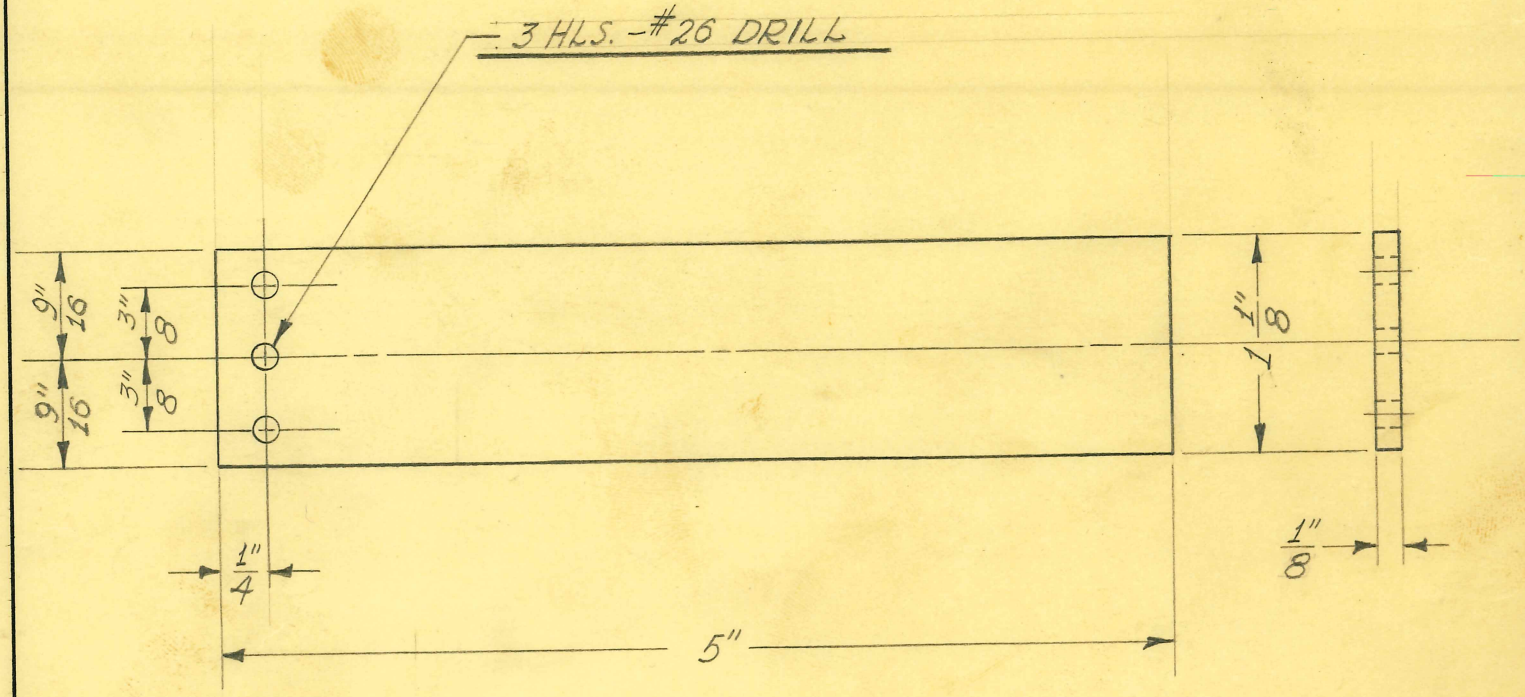

1 REQUIRED

SIZE	1/8" - NO. 60	ISSUE 2-2-40	J.W.
KIND	SERVICE SHEET	CHANGED	
SHAPE	UNGRAPHITED	"	
FINISH		"	
TEMP.		"	
PATT.		"	

TITLE: FISCHER LIGHT MOBILE STAND
FRICTION PIECE

H. G. FISCHER & CO.
2335 WABANSIA AVE.
CHICAGO, ILL.

CAT. NO.

PART NO. 12498CF

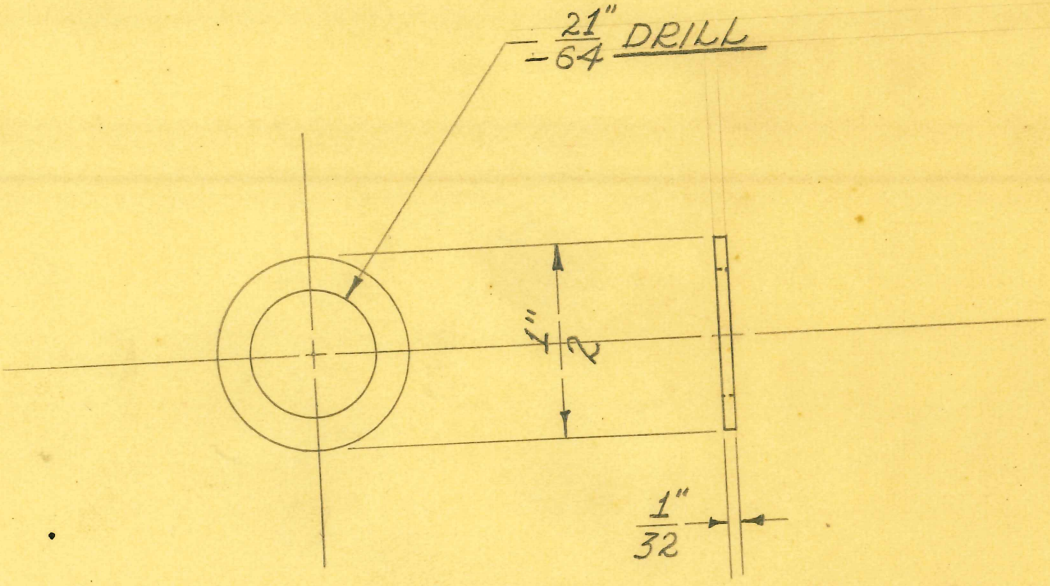

SCALE ÷ DOUBLE SIZE

1 REQUIRED

SIZE	1/2" DIAM.	ISSUE 2-7-39	J.W.
KIND	C.R. STEEL	CHANGED	
SHAPE	ROD	"	
FINISH	CAD. #23	"	
TEMP.		"	
PATT.		"	

TITLE: LIGHT MOBILE STAND
CRANK HANDLE KNOB WASHER

H. G. FISCHER & CO.
2335 WABANSIA AVE.
CHICAGO, ILL.

CAT. NO.

PART NO. 12505

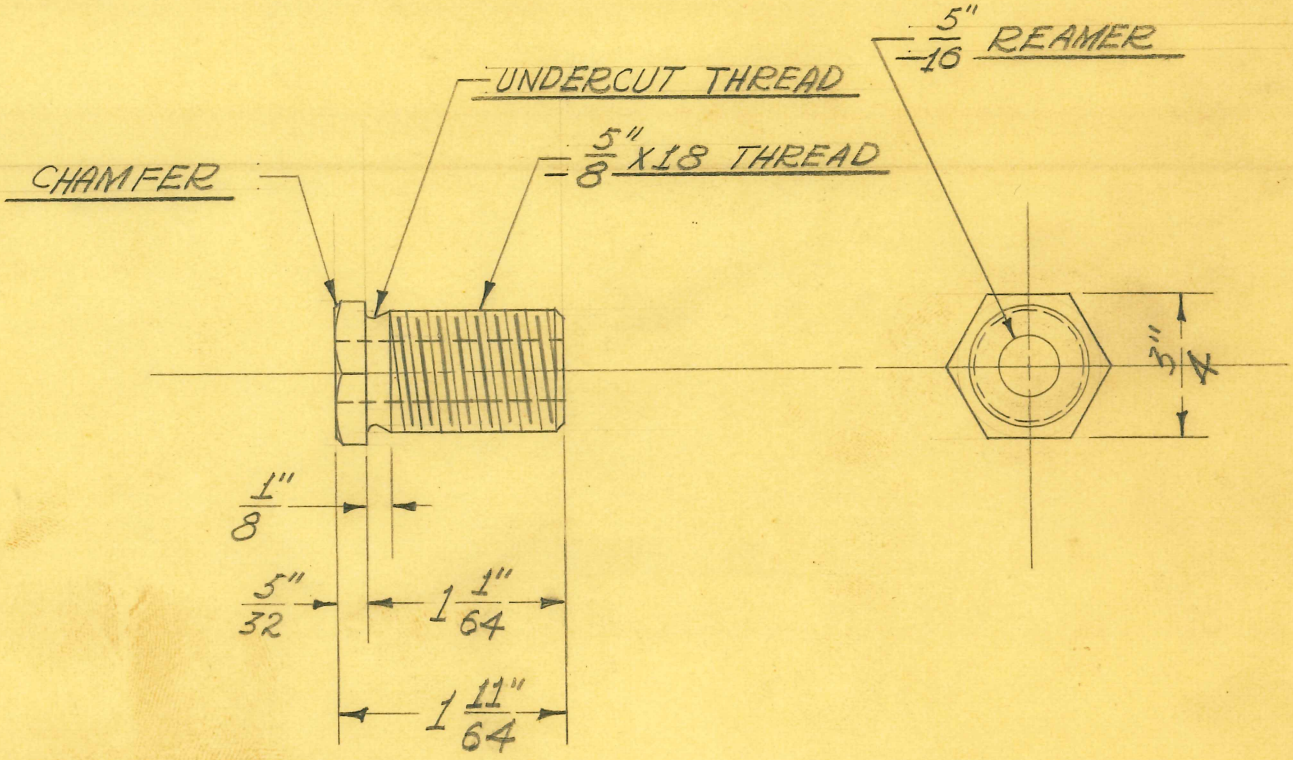

1 REQUIRED

SIZE	3/4" HEX.	ISSUE 2-7-39	J.W.
KIND	C.R. STEEL	CHANGED	
SHAPE	ROD.	"	
FINISH	CHROME #2	"	
TEMP.		"	
PATT.		"	

TITLE: LIGHT MOBILE STAND
CRANK HANDLE KNOB BUSHING

H. G. FISCHER & CO.
2335 WABANSIA AVE.
CHICAGO, ILL.

CAT. NO.

PART NO. 12506

3/8" REAMED HOLE - C'SUNK TO 13/32" FACE - ON SIDE OPPOSITE TONGUE.

BREAK EDGES

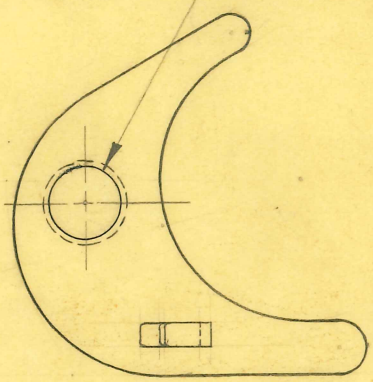

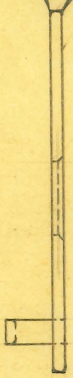

ROUND INSIDE EDGES

1 REQUIRED

SIZE		ISSUE 8-24-39	J.W.
KIND	FROM 12517	CHANGED	
SHAPE		"	
FINISH		"	
TEMP.		"	
PATT.		"	

TITLE: FISCHER LIGHT MOBILE STAND CABLE GUIDE

H. G. FISCHER & CO.
2335 WABANSIA AVE.
CHICAGO, ILL.

CAT. NO.

PART NO. 12517F

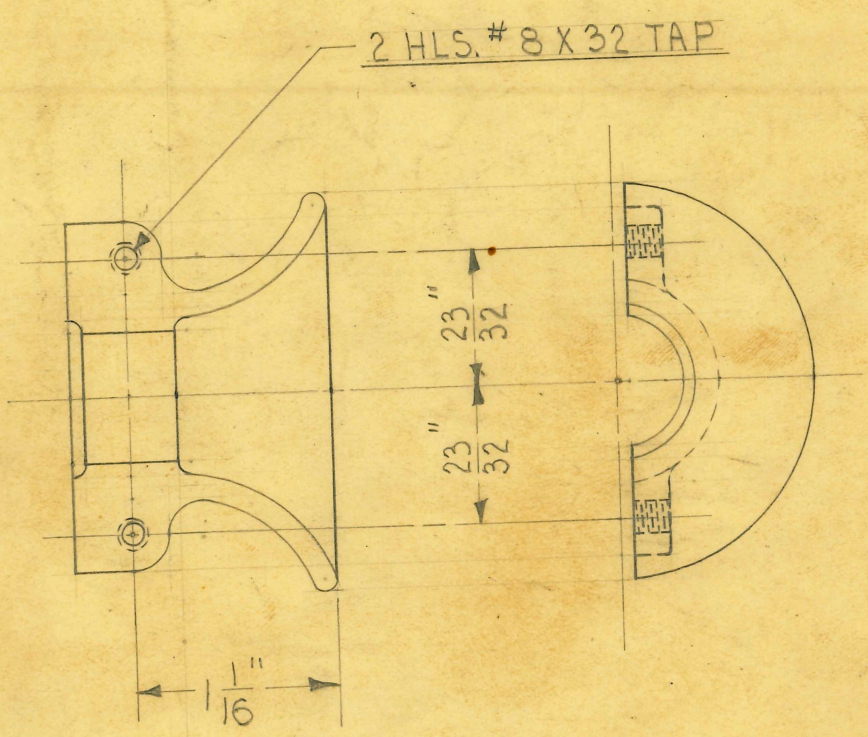

1 REQUIRED

USED ON 23290G
18744G

SIZE		ISSUE 5-26-39	HE.
KIND	#12 ALUMINUM	CHANGED	
SHAPE	CASTING	"	
FINISH	PAINTED	"	
TEMP.		"	
PATT.	1379	"	

TITLE: FISCHER MOD. "TM-30-96" MOBILE SHOCKPROOF X-RAY UNIT TRANSFORMER CABLE SUPPORT CLAMP

H. G. FISCHER & CO.
2335 WABANSIA AVE.
CHICAGO, ILL.

CAT. NO.

PART NO. 12623F

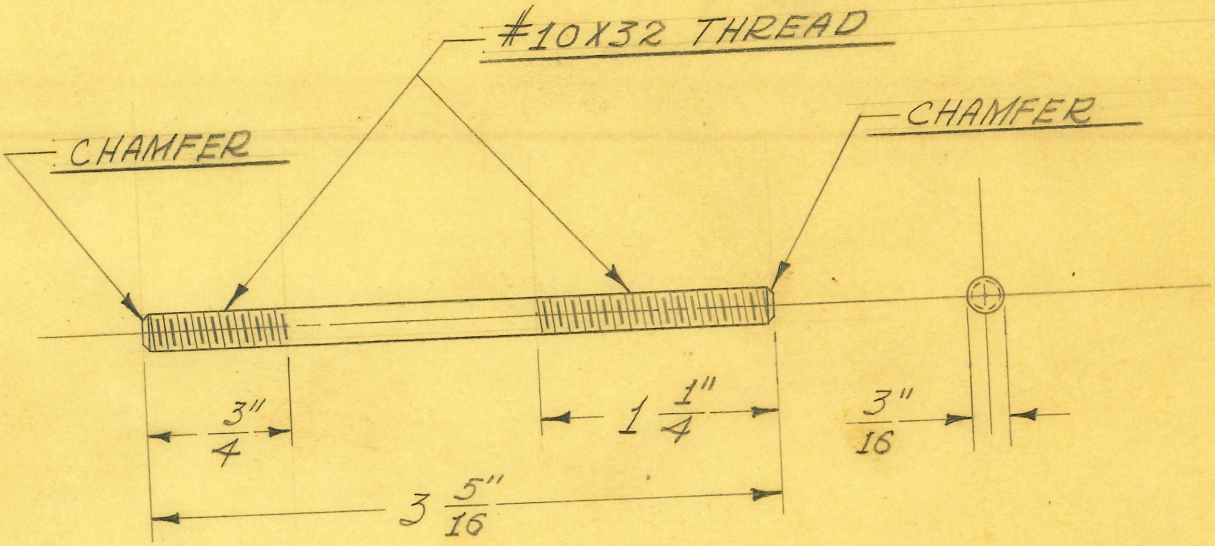

2 REQUIRED

SIZE	3/16" DIAM.	ISSUE 2-17-39	J.W.	TITLE: INTERMEDIATE REMOTE CONTROL TRANSFORMER SUPPORT STUD
KIND	C.R. STEEL	CHANGED		
SHAPE	ROD	"		
FINISH		"		
TEMP.		"		
PATT.		"		

H. G. FISCHER & CO.
2335 WABANSIA AVE.
CHICAGO, ILL.

CAT. NO.

PART NO. 12548

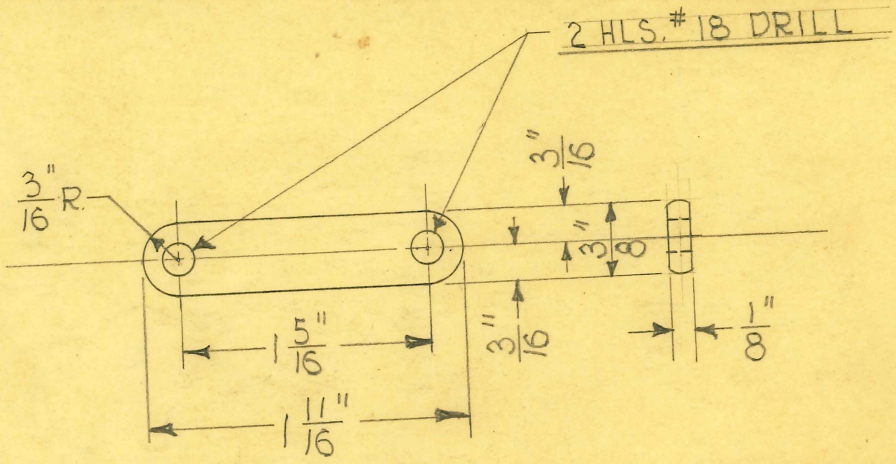

2 REQUIRED

RS

SIZE	3/8" X 1/8"	ISSUE 5-11-39	HE
KIND	FLAT WIRE	CHANGED	
SHAPE		"	
FINISH		"	
TEMP.		"	
		"	

TITLE: FISCHER MOD. "TM-30-96" MOBILE SHOCKPROOF XRAY UNIT — FILAMENT TRANSF. CLAMP STRIP

H. G. FISCHER & CO.
2335 WABANSIA AVE.
CHICAGO, ILL.

CAT. NO.

PART NO. 12615

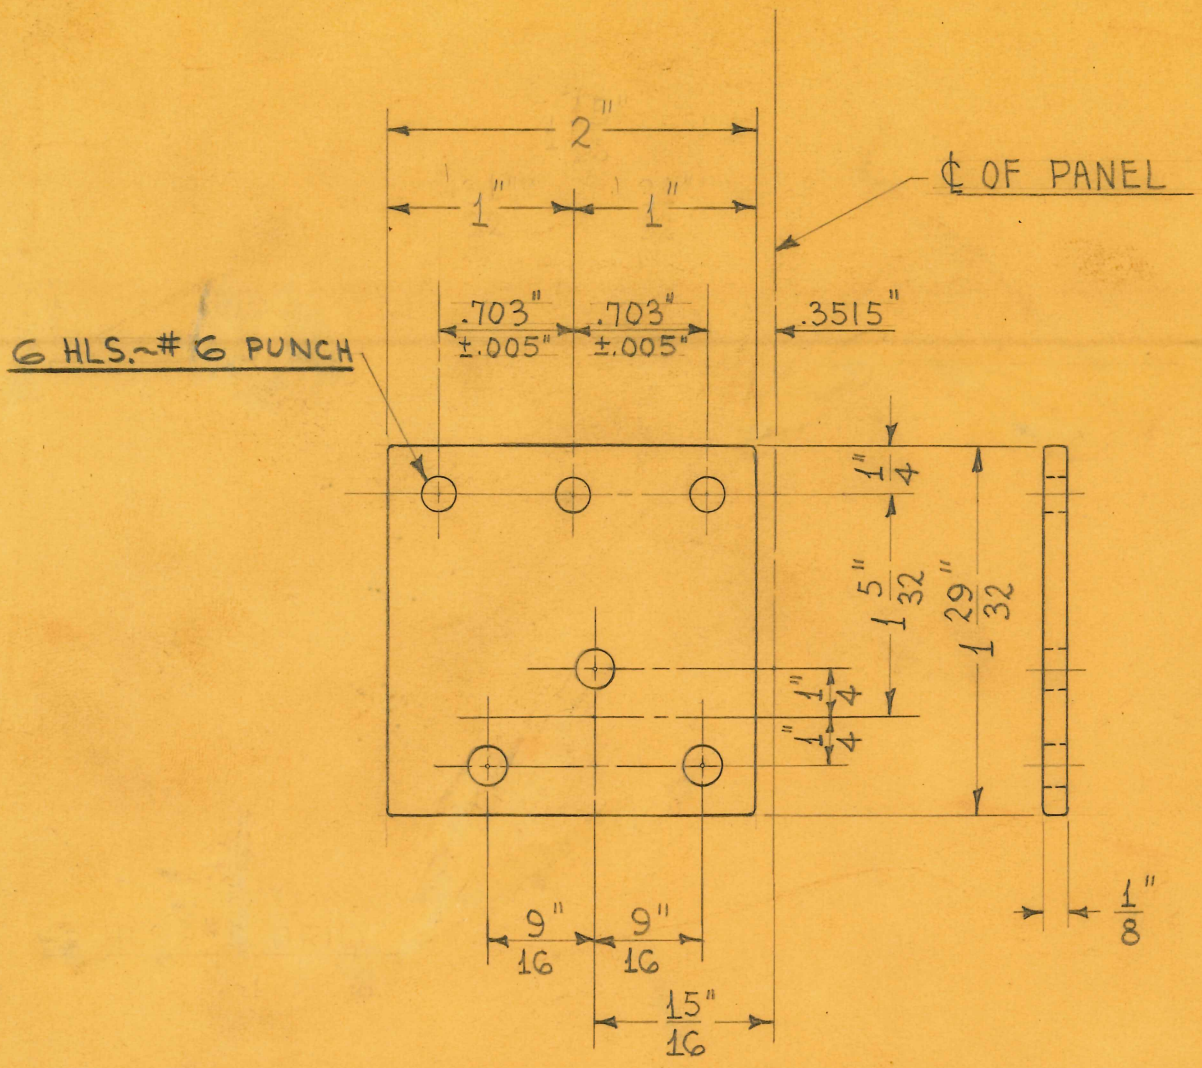

2 REQUIRED

REMOVE ALL SHARP CORNERS & EDGES

PERF. DIE # 12212 RS

SIZE	1/8" X 2"	ISSUE 3-10-45	HE.
KIND	STRIP	CHANGED	
SHAPE	C.R. STEEL	"	
FINISH	CAD. #23	"	
TEMP.		"	
PATT.		"	

TITLE: FISCHER MOD. "TM-30-96" MOBILE SHOCKPROOF X-RAY UNIT ~ TRANSFORMER MOUNTING PLATE

H. G. FISCHER & CO.
2335 WABANSIA AVE.
CHICAGO, ILL.

CAT. NO.

PART NO. 12619A

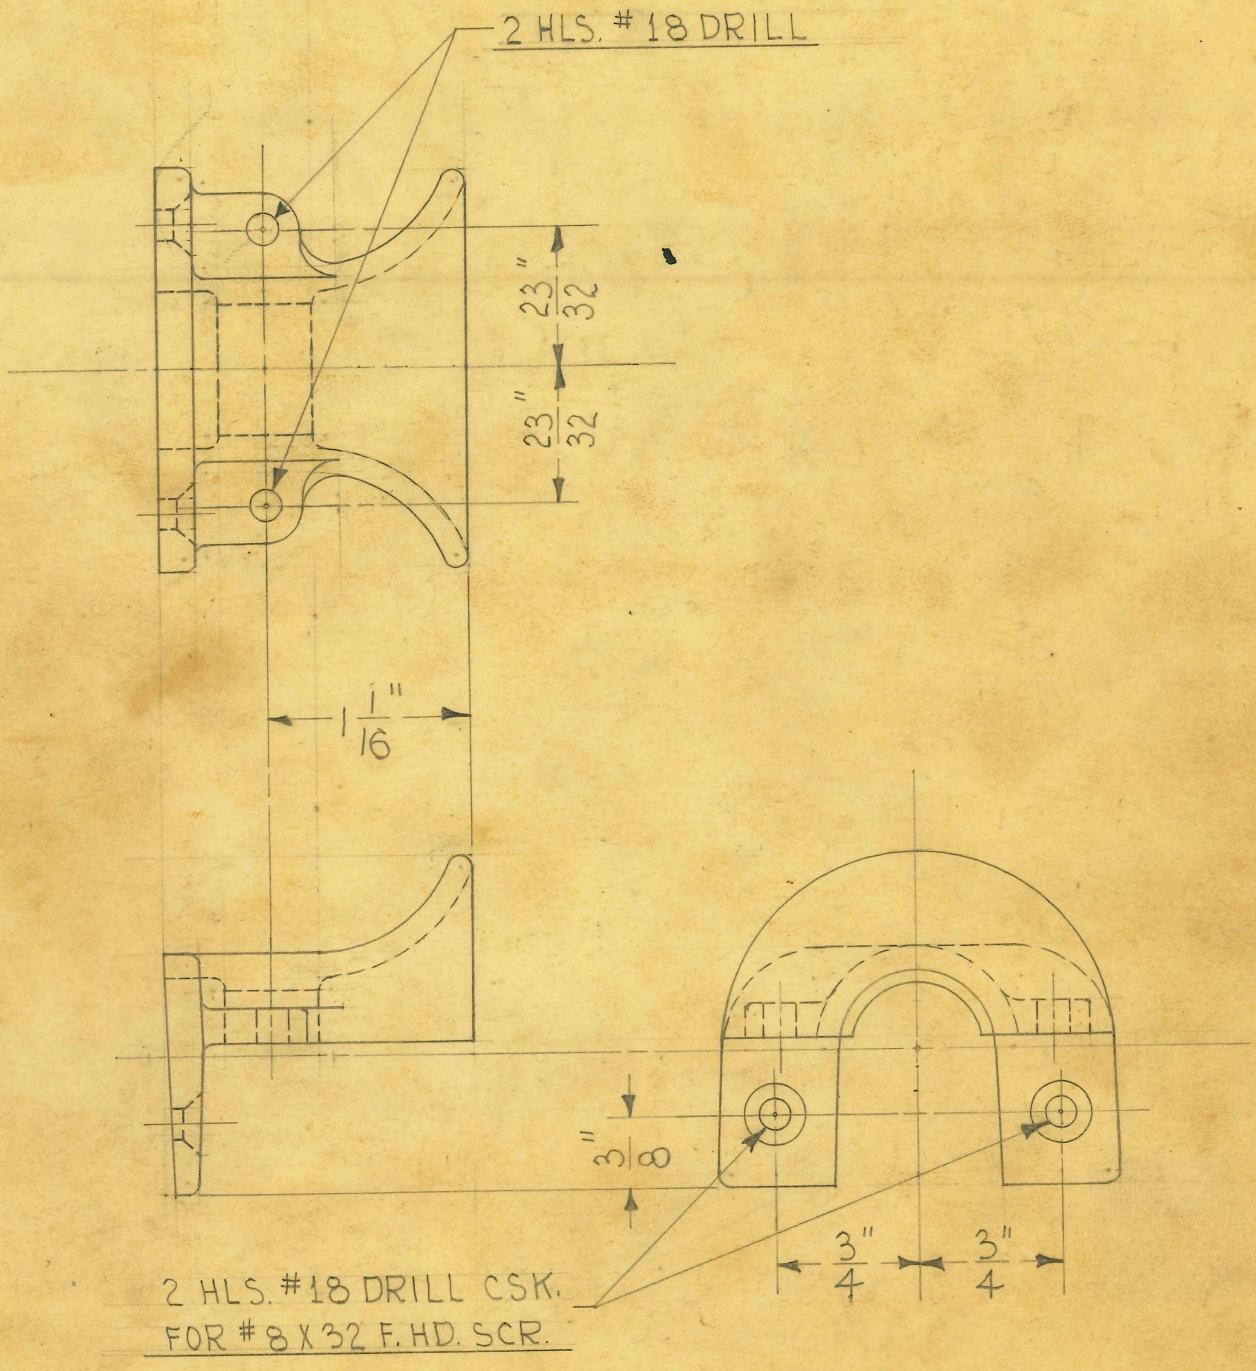

USED ON 23290G
18744G

1 REQUIRED

SIZE	#12	ISSUE 5-26-39	HE.
KIND	ALUMINUM	CHANGED	
SHAPE	CASTING	"	
FINISH	PAINTED	"	
TEMP.		"	
PATT.	1378	"	

TITLE: FISCHER MOD. "TM-30-96" MOBILE SHOCKPROOF X-RAY UNIT— TRANSFORMER CABLE SUPPORT

H. G. FISCHER & CO.
2335 WABANSIA AVE.
CHICAGO, ILL.

CAT. NO.

PART NO. 12624F

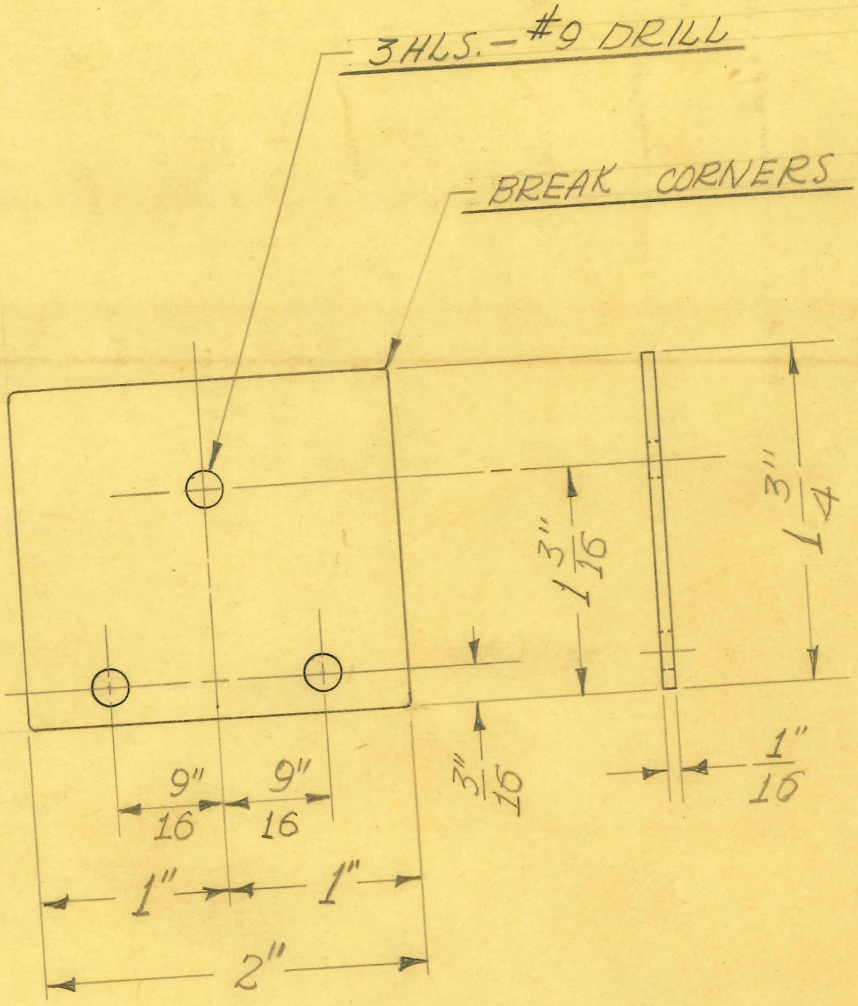

1 REQUIRED

SIZE	1/16" SHEET	ISSUE 8-14-39	JW.	TITLE: FISCHER MOD. "TM-30-96" MOBILE SHOCKPR
KIND	C.R. STEEL	CHANGED		X-RAY UNIT – VARIABLE RESISTOR SUPP. PLAT
SHAPE		"		
FINISH	BLACK #80	"		
TEMP.		"		
PATT.		"		

H. G. FISCHER & CO.
2335 WABANSIA AVE.
CHICAGO, ILL.

CAT. NO.

PART NO. 12669

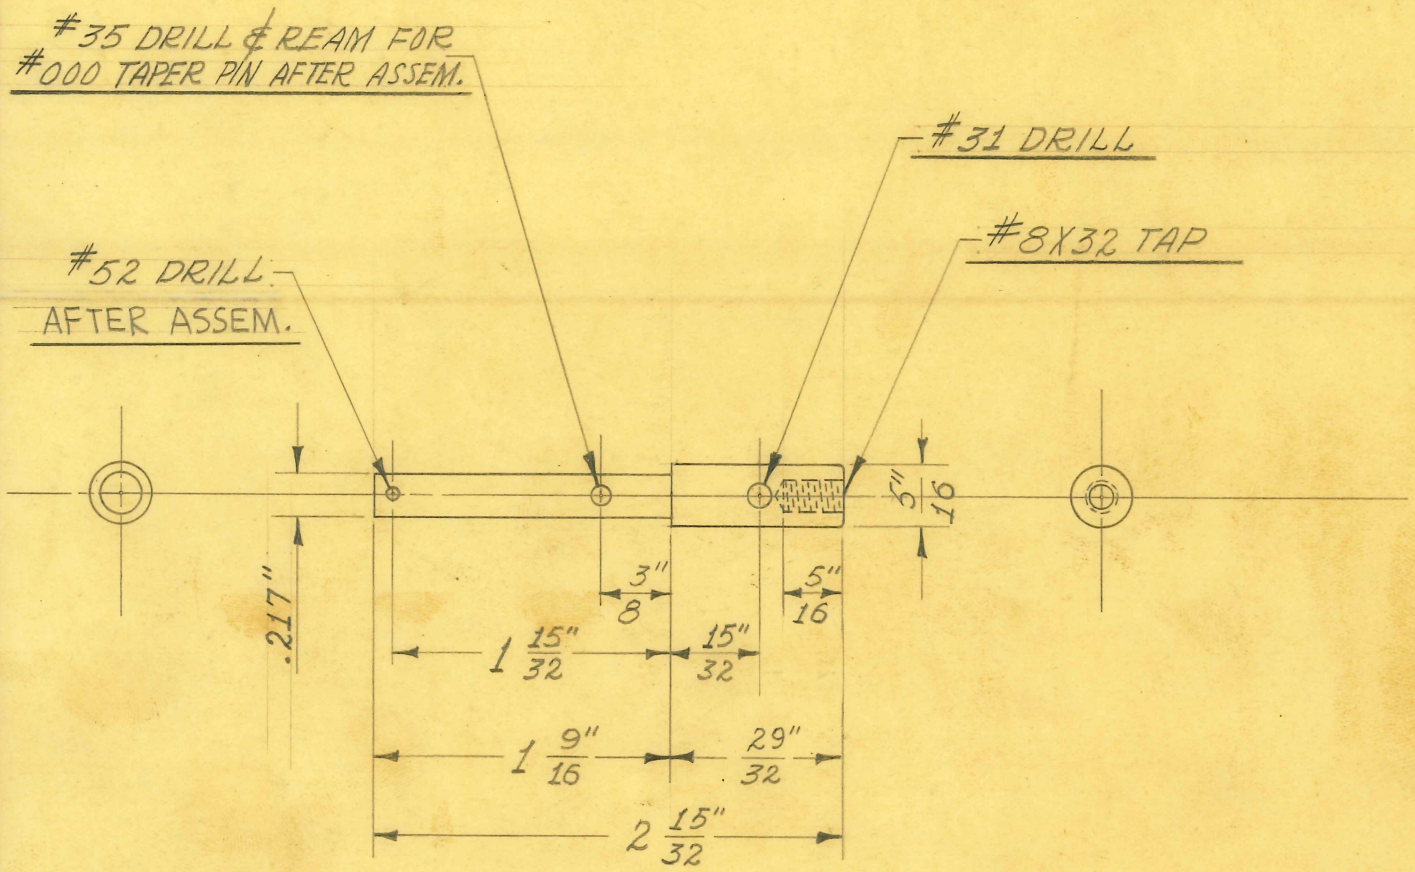

1 REQUIRED

SIZE	5/16" DIA.	ISSUE 7-14-39	J.W.
KIND	C.R. STEEL	CHANGED	
SHAPE		"	
FINISH	CAD #23	"	
TEMP.		"	
PATT.		"	

TITLE:
FISCHER SHOCKPROOF MOD. "TM-30-96" MOBILE X-RAY UNIT—REMOTE CONTROL—6 POINT SWITCH MAIN SHAFT

H. G. FISCHER & CO.
2335 WABANSIA AVE.
CHICAGO, ILL.

CAT. NO.

PART NO. 12674

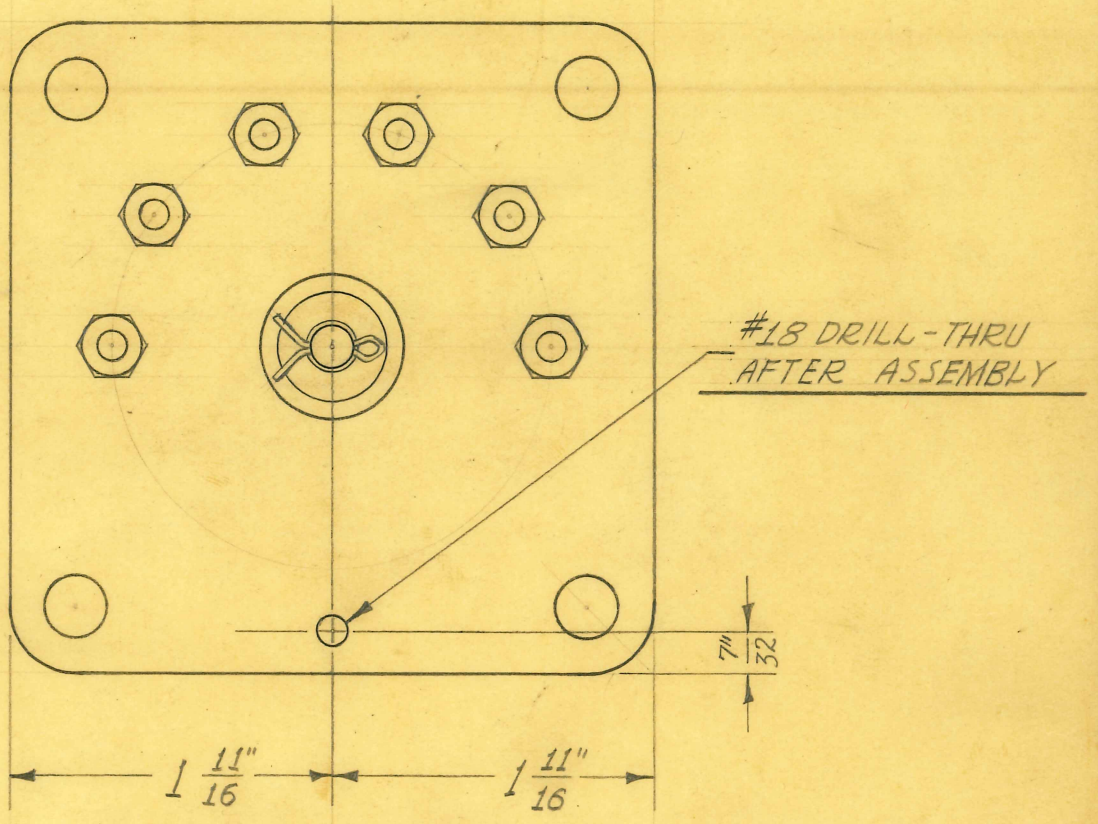

SIZE		ISSUE 10-5-39	J.W.
KIND		CHANGED	
SHAPE		"	
FINISH		"	
TEMP.		"	
PATT.		"	

TITLE:
FISCHER MOD. "TM-30-96" MOBILE SHOCKPROOF
X-RAY - REMOTE CONTROL - 6 POINT SWITCH

H. G. FISCHER & CO. 2335 WABANSIA AVE. CHICAGO, ILL.	CAT. NO.	PART NO. 12675G

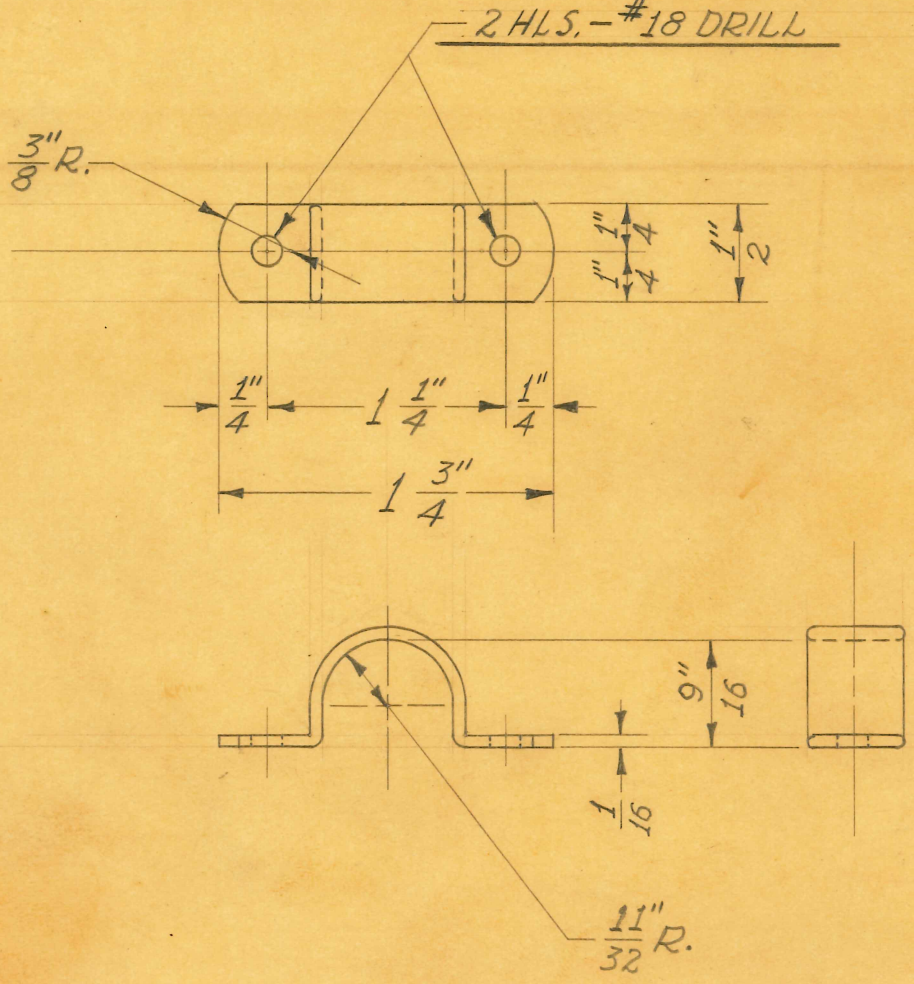

2 REQUIRED

R.S

SIZE	1/2" X 1/16"	ISSUE 7-14-39	J.W.
KIND	FLAT WIRE	CHANGED	
SHAPE		"	
FINISH	Cad 123	"	
TEMP.		"	
PATT.		"	

TITLE:
FISCHER SHOCKPROOF MOD. "TM-30-96" MOBILE X-RAY UNIT – REMOTE CONTROL – CORD STRAIN RELIEF

H. G. FISCHER & CO.
2335 WABANSIA AVE.
CHICAGO, ILL.

CAT. NO.

PART NO. 12689

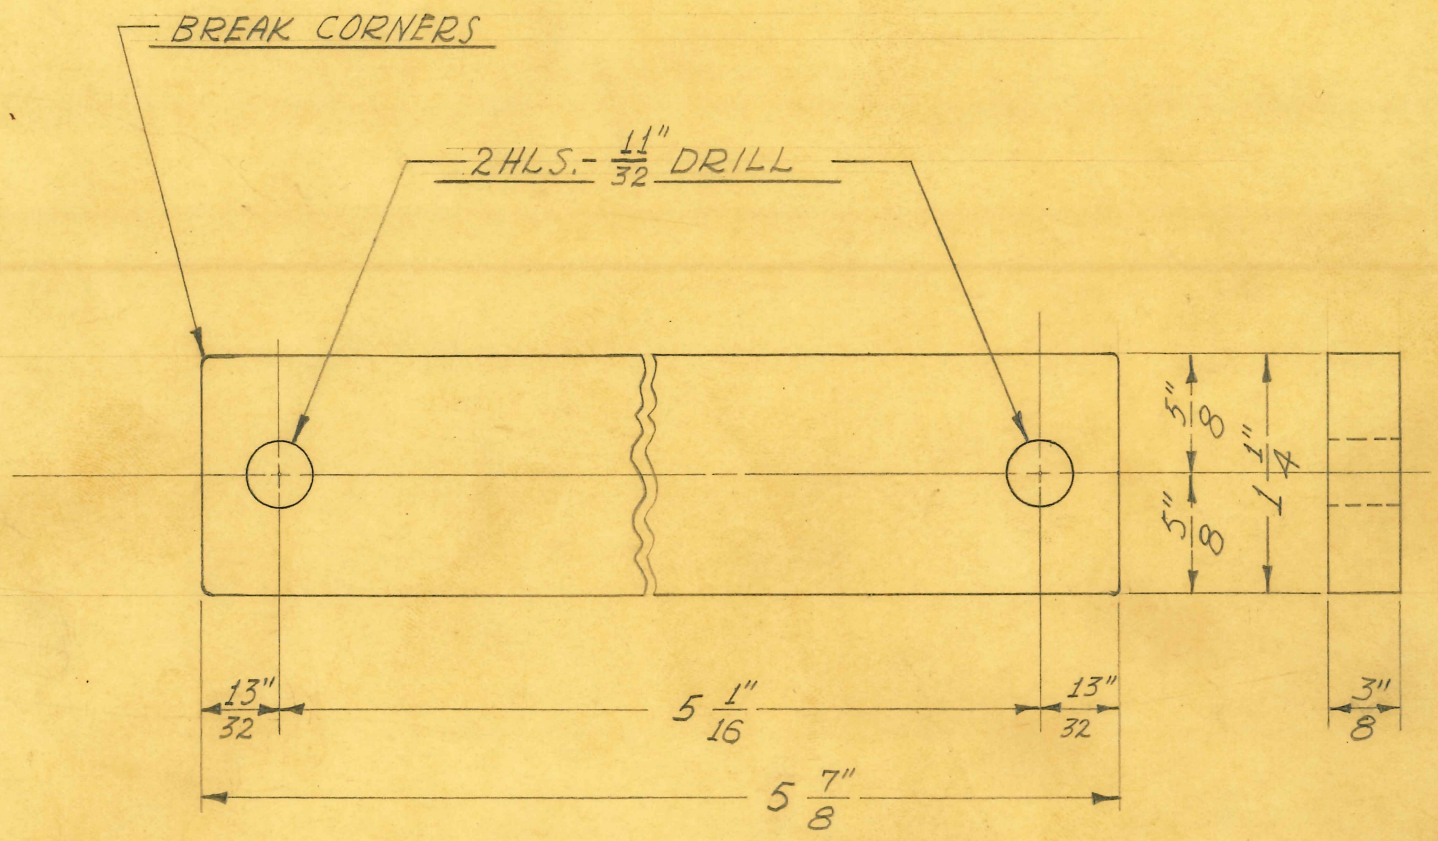

2. REQUIRED

SIZE	1¼" X ⅜"	ISSUE 10-5-39	J.W.	**TITLE:** FISCHER MOD. "TM-30-96" MOBILE SHOCKPROOF X-RAY — REMOTE CONTROL — TRANSF. SUPP. — LOWER
KIND	C.R. STEEL	CHANGED		
SHAPE	BAR	"		
FINISH		"		
TEMP.		"		
PATT.		"		

H. G. FISCHER & CO.
2335 WABANSIA AVE.
CHICAGO, ILL.

CAT. NO.

PART NO. 12696A

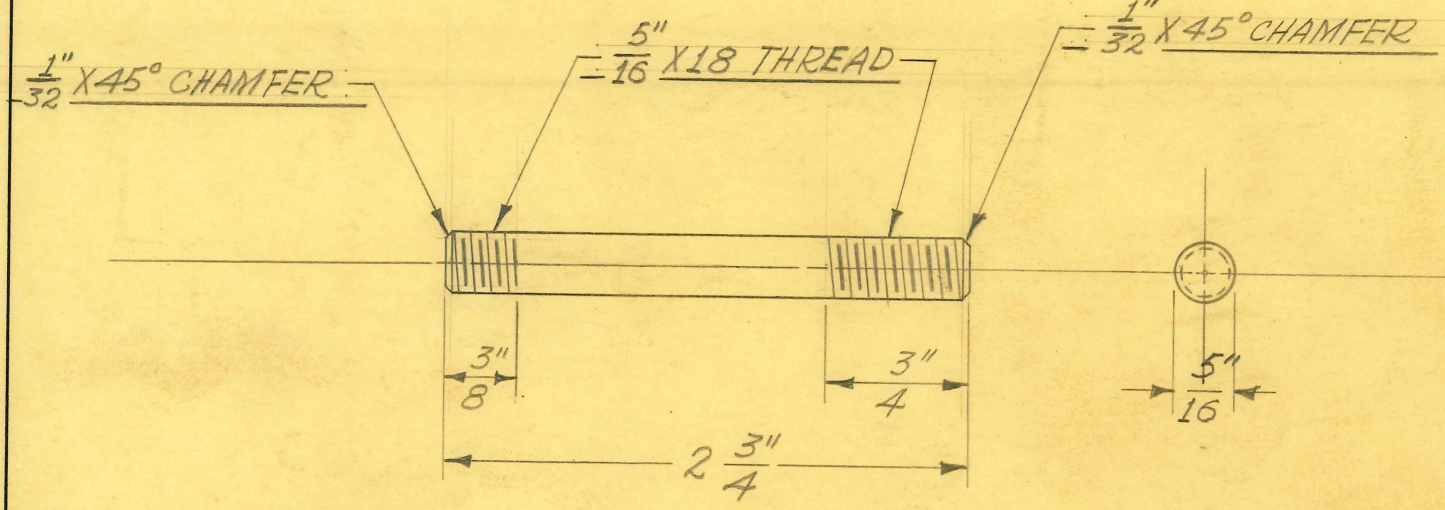

4 REQUIRED

SIZE	5/16" DIAM.	ISSUE 7-17-39	J.W.
KIND	C.R. STEEL	CHANGED	
SHAPE		"	
FINISH		"	
TEMP.		"	
PATT.		"	

TITLE:
FISCHER SHOCKPROOF MOD. "TM-30-96" MOBILE X-RAY UNIT-REMOTE CONTROL- TRANSF. SUPP. STUD.

H. G. FISCHER & CO.
2335 WABANSIA AVE.
CHICAGO, ILL.

CAT. NO.

PART NO. 12699

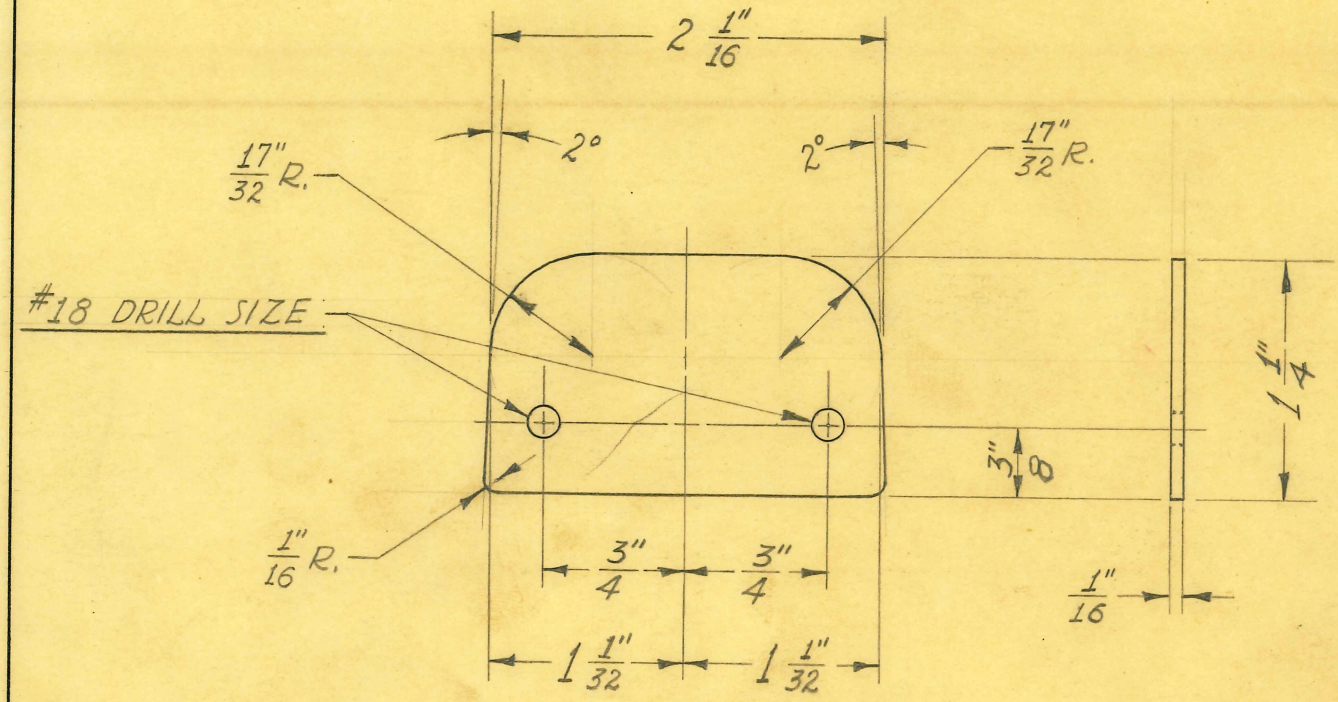

1 REQUIRED

USED ON 23290G
18744G

BLANK & PIERCE DIE #11593

SIZE	1/16" SHEET	ISSUE 10-11-39	J.W.
KIND	C.R. STEEL	CHANGED	
SHAPE		"	
FINISH	PAINTED	"	
TEMP.		"	
PATT.		"	

TITLE: FISCHER MOD. "TM.-30-96" MOBILE SHOCKPROOF "X-RAY" UNIT - TRANSF. COVER CABLE OPENING PLATE

H. G. FISCHER & CO.
2335 WABANSIA AVE.
CHICAGO, ILL.

CAT. NO.

PART NO. 12703

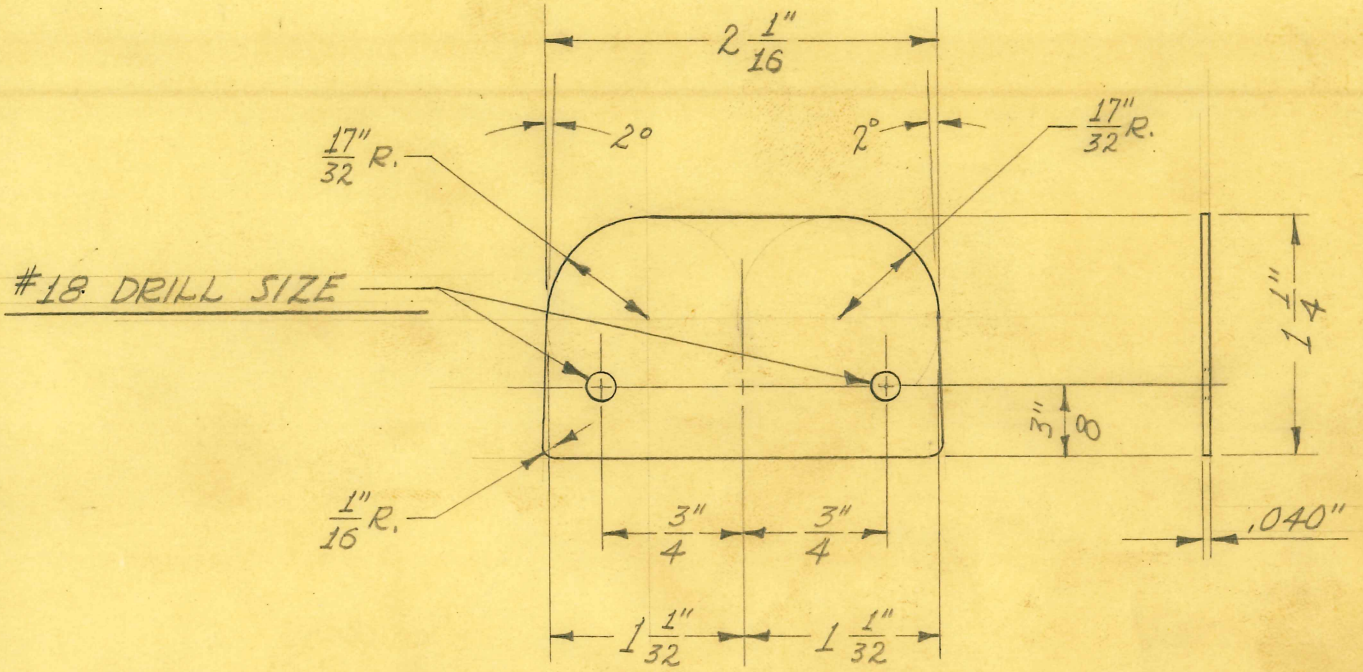

1 REQUIRED

BLANK & PIERCE DIE #11593

SIZE	.040" SHEET	ISSUE 10-11-39	J.W.	TITLE: FISCHER MOD. "TM-30-96" MOBILE SHOCKPROOF "X-RAY" UNIT – TRANSF. COVER CABLE OPENING LEAD PLATE
KIND	LEAD	CHANGED		
SHAPE		"		
FINISH	PAINTED	"		
TEMP.		"		
PATT.		"		

H. G. FISCHER & CO.
2335 WABANSIA AVE.
CHICAGO, ILL.

CAT. NO.

PART NO. 12704

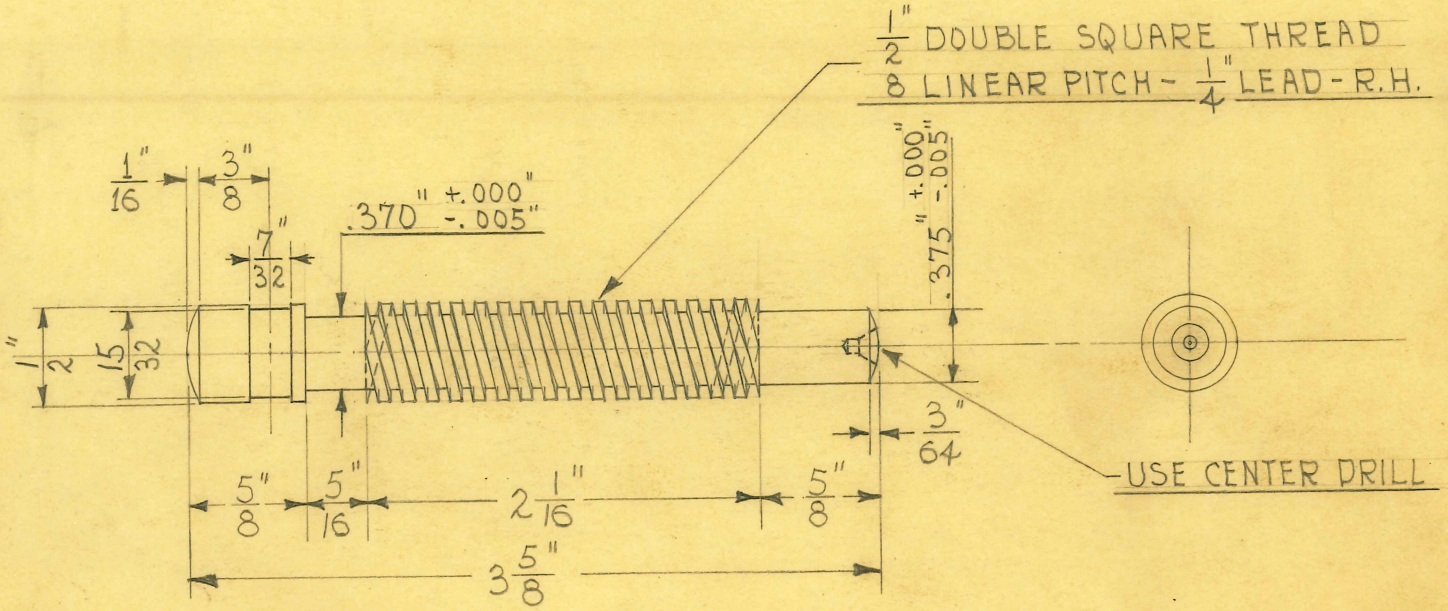

1 REQUIRED

BIT HOLDER TOOL # 7275

SIZE	1/2" DIAM.	ISSUE 9-8-39	HE.
KIND	C.R. STEEL	CHANGED	
SHAPE		"	
FINISH	CHROME #2 POL. ENDS ONLY	"	
TEMP.		"	
PATT.		"	

TITLE: FISCHER MOD. "TC-30-96" MOBILE STAND PULLEY SHAFT

H. G. FISCHER & CO.
2335 WABANSIA AVE.
CHICAGO, ILL.

CAT. NO.

PART NO. 12717

13/32" DRILL.-THEN TAP 1/2" DIA. DOUBLE SQ. THREAD
8 LINEAR PITCH - 1/4" LEAD - R.H.

ROUND EDGES

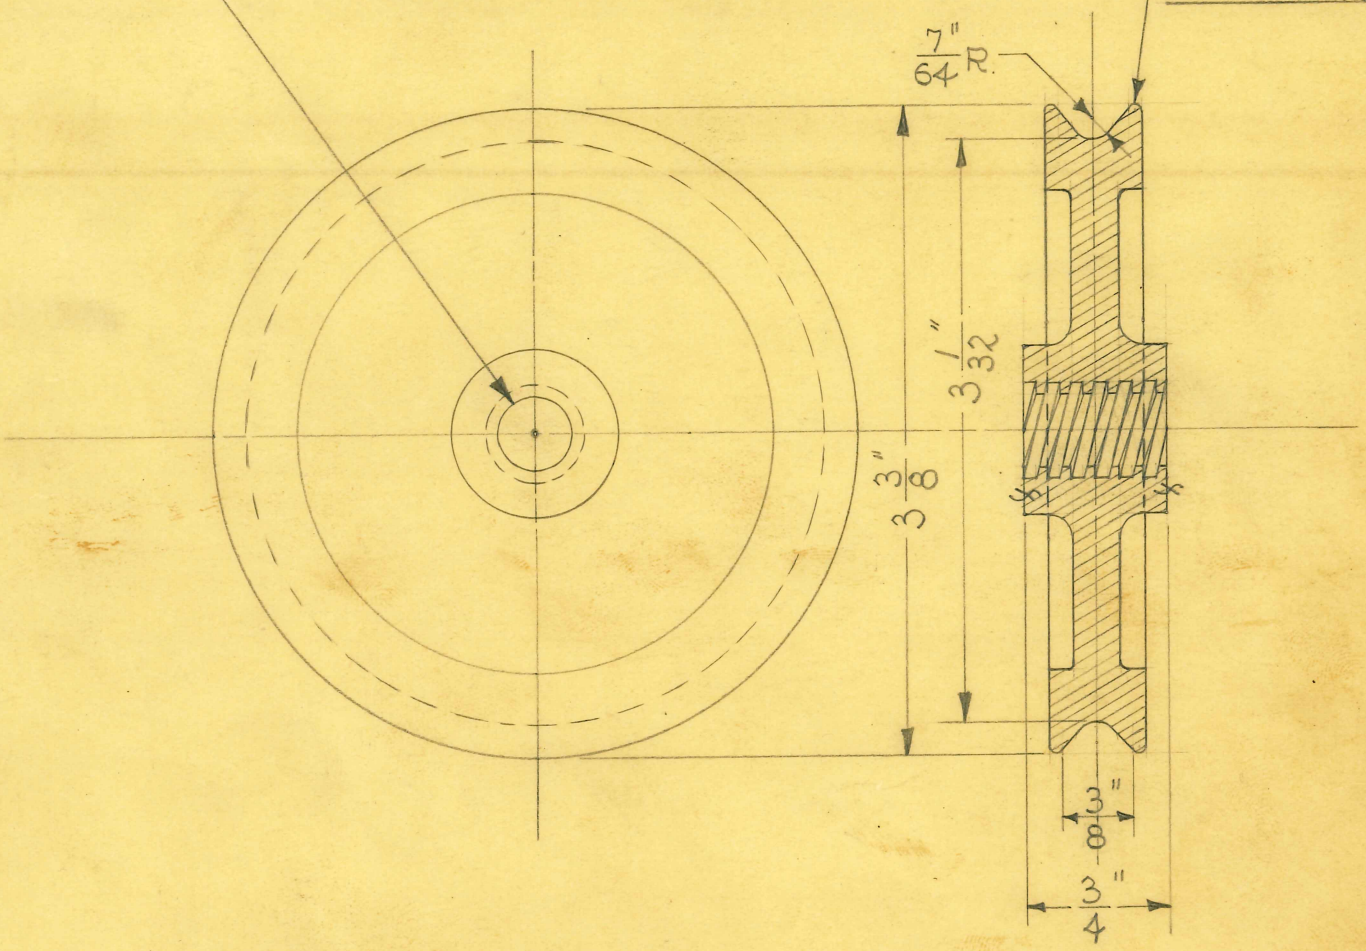

1 REQUIRED

SIZE	#12	ISSUE 9-11-39	HE.
KIND	ALUM. CASTING	CHANGED	
SHAPE		"	
FINISH		"	
TEMP.		"	
PATT.	1406	"	

TITLE: FISCHER MOD. "TC-30-96" MOBILE STAND CABLE PULLEY

H. G. FISCHER & CO.
2335 WABANSIA AVE.
CHICAGO, ILL.

CAT. NO.

PART NO. 12725F

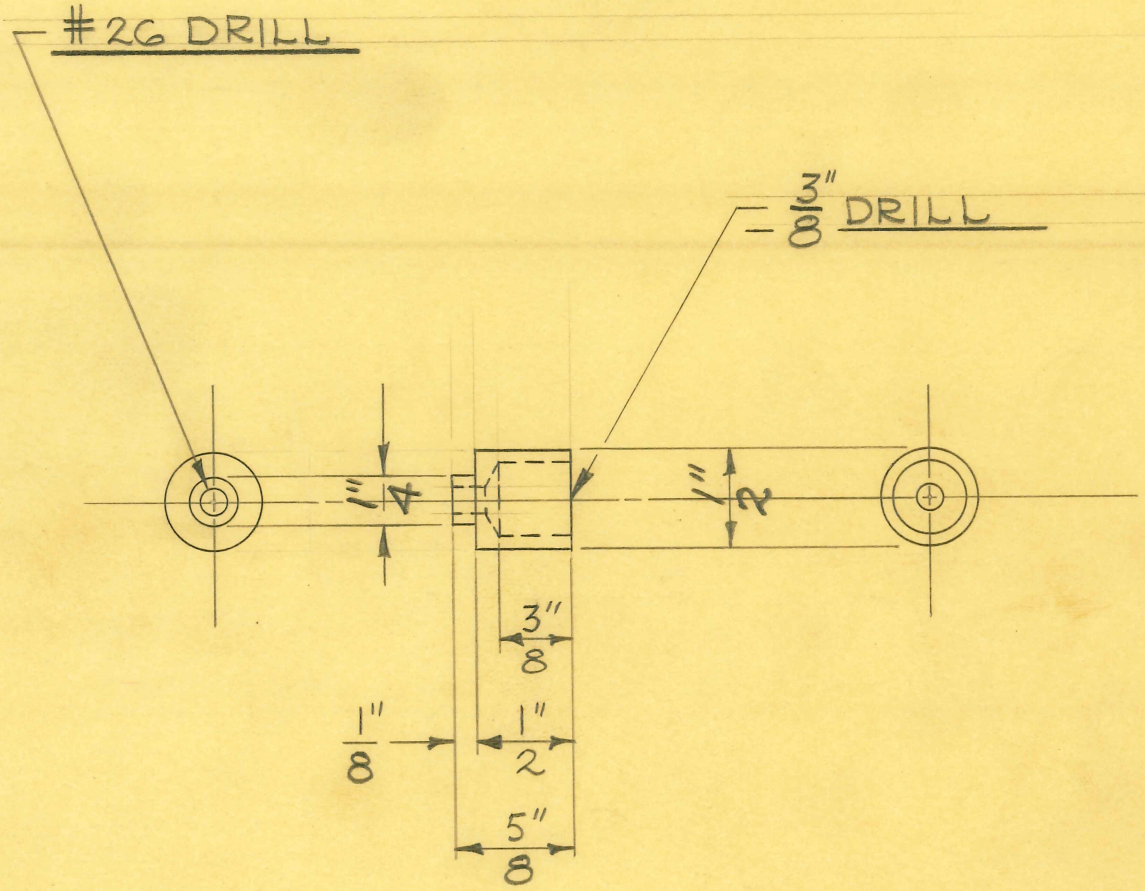

1 REQUIRED

SIZE	1/2" DIA.	ISSUE 2-5-47	J.V.W.
KIND	BRASS ROD	CHANGED	
SHAPE		"	
FINISH		"	
TEMP.		"	
PATT.		"	

TITLE: FISCHER "TC-30-96" MOBILE STAND CABLE (LIFT) END PIECE

H. G. FISCHER & CO.
2335 WABANSIA AVE.
CHICAGO, ILL.

CAT. NO.

PART NO. 12727A

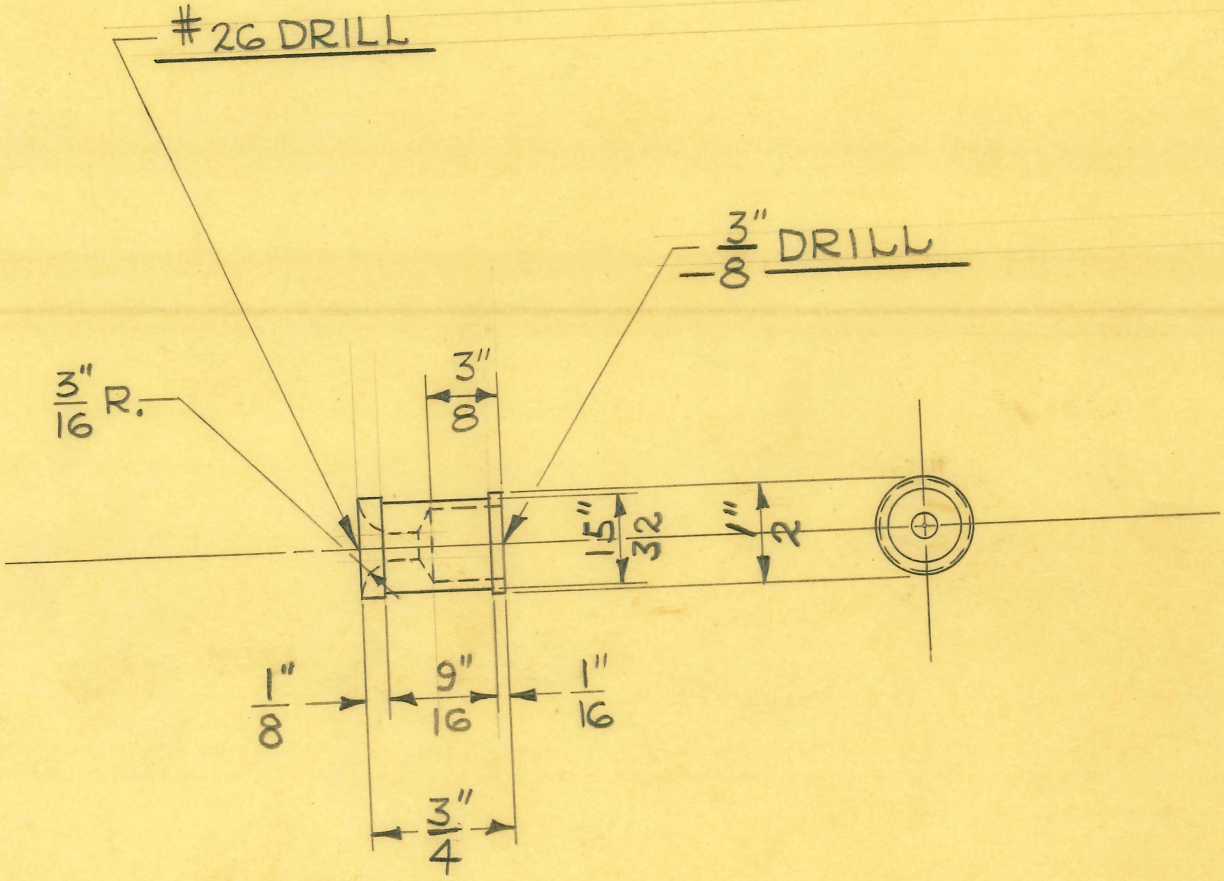

1 REQUIRED

SIZE	1/2" DIA.	ISSUE 2-5-47	J.V.W.
KIND	BRASS ROD	CHANGED	
SHAPE		"	
FINISH		"	
TEMP.		"	
PATT.		"	

TITLE: FISCHER "TC-30-96" MOBILE STAND CABLE (CRANK) END PIECE

H. G. FISCHER & CO.
2335 WABANSIA AVE.
CHICAGO, ILL.

CAT. NO.

PART NO. 12728A

SIZE A

TITLE MODEL TC MOBILE STAND CONTROL SUPPORT TUBE	H. G. FISCHER & CO. FRANKLIN PARK, ILLINOIS	PART NO. 12731
	DATE 11-8-67 | DR. BY RCT | CH'K'D. RCT	REVISION | DATE | BY
PATTERN | FINISH PAINT | SCALE —	DIMENSIONS—UNLESS OTHERWISE SPECIFIED: FRACTIONAL ± .015 DECIMAL ± .005 ANGULAR ± 1/2° THREAD CHAMFER UP TO 5/16 D.-1/32 X 45° 3/8 D. & OVER - 1/16 X 45° REMOVE ALL BURRS & SHARP CORNERS	
MATERIAL C.D. SEAMLESS STEEL TUBING 2 O.D. x #11 GA. (.120) WALL		
TOOLS		

USED ON	QTY.	USED ON	QTY.
12772 G	2		

2" O.D. x #11 GA. (.120) WALL
SEAMLESS STEEL TUBING

25" LONG

NOTE: SURFACE FINISH OF TUBING TO BE SUITABLE FOR MINIMUM POLISHING CUTOFF MARKS

DO NOT SCALE DRAWING.

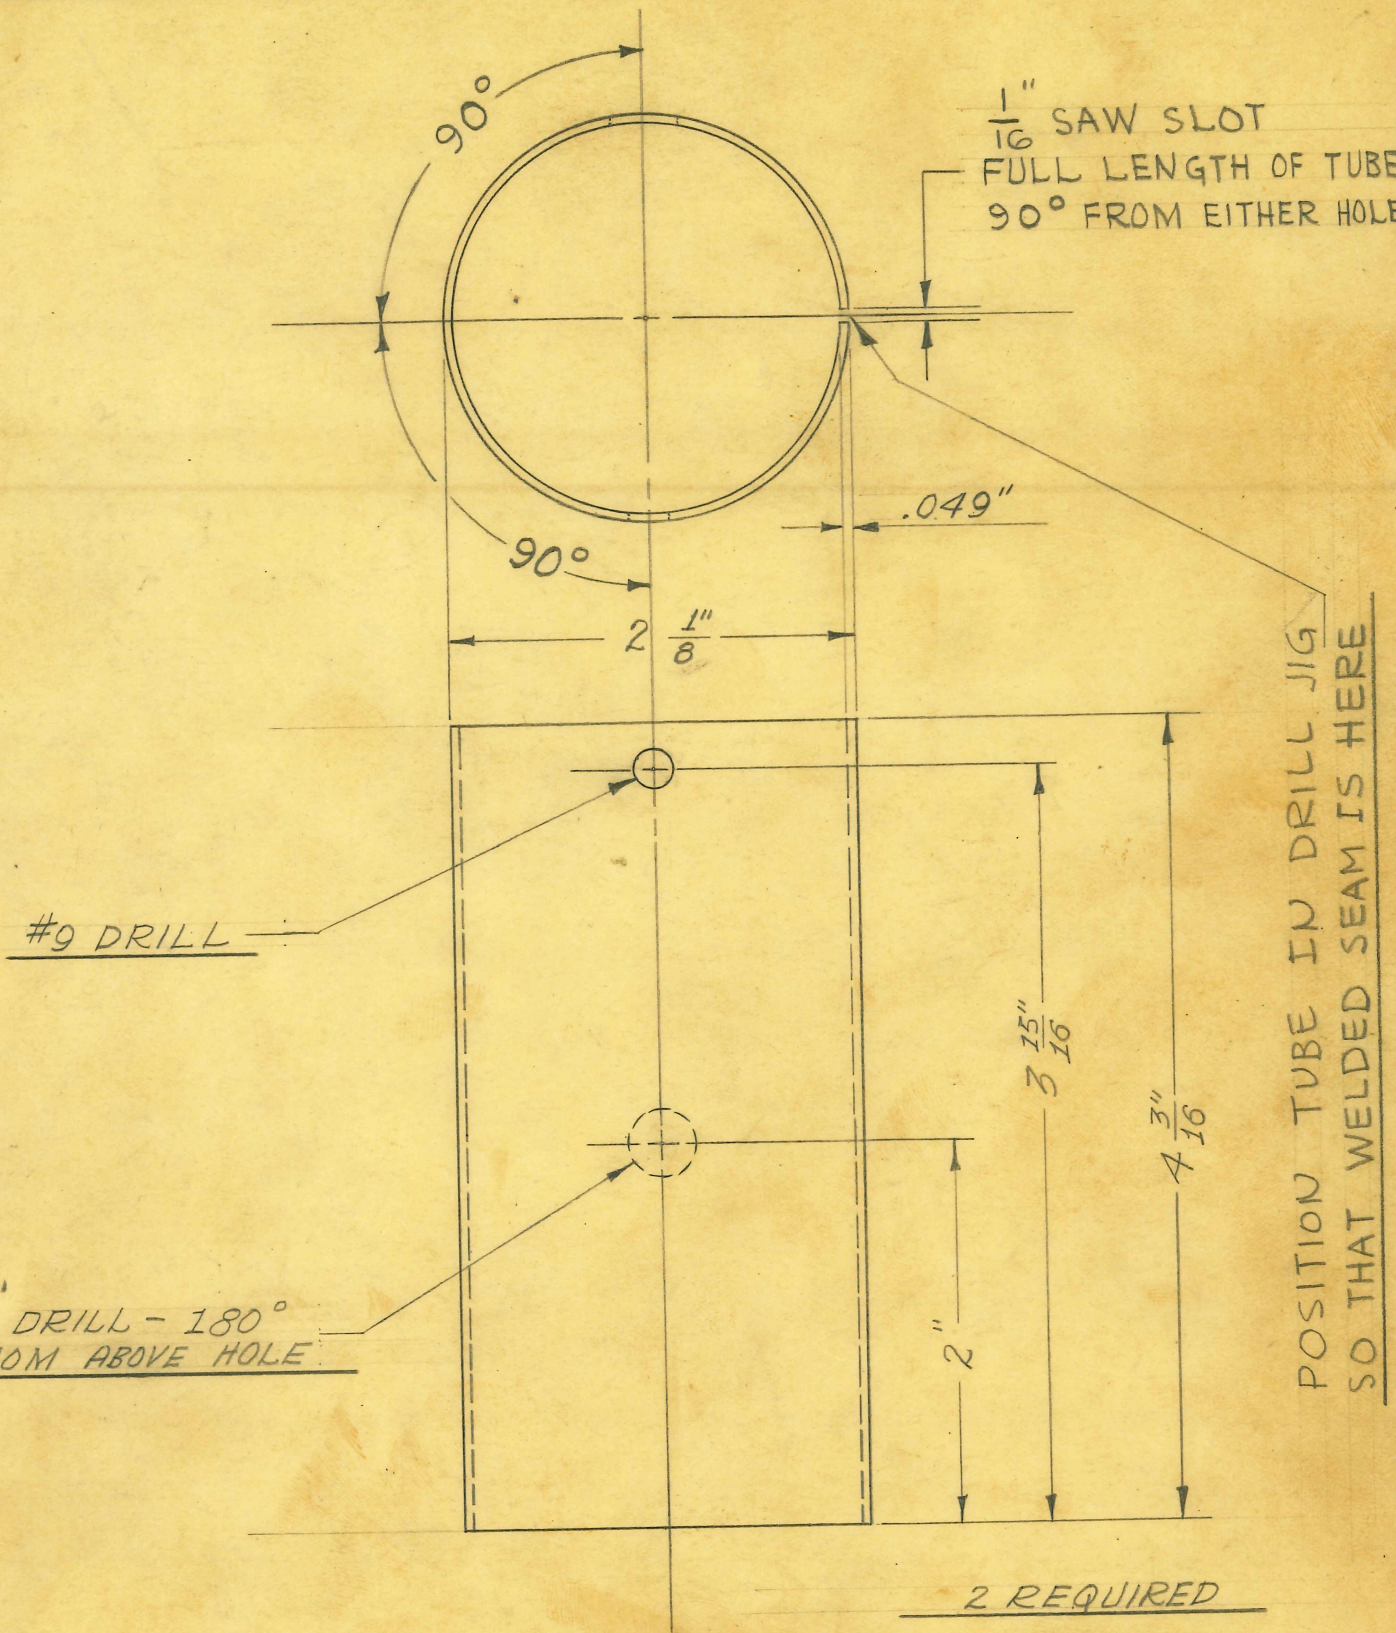

2 REQUIRED

E 11-20-52 J.V.W

2 1/8" O.D. X #18 GA. (.049") WALL WELDED STEEL TUBING

SIZE		ISSUE 9-27-39	J.W.
KIND		CHANGED	
SHAPE		"	
FINISH	CAD. #23	"	
TEMP.		"	
PATT.		"	

TITLE:
FISCHER MOD. "TC-30-96" MOBILE STAND
REMOTE CONTROL SUPPORT SLEEVE

H. G. FISCHER & CO.
2335 WABANSIA AVE.
CHICAGO, ILL.

CAT. NO.

PART NO. 12733

SIZE A

TITLE MODEL TC MOBILE STAND UPRIGHT TUBE	H. G. FISCHER & CO. FRANKLIN PARK, ILLINOIS	PART NO. 12735 AF
PATTERN / FINISH 102 / SCALE #	DATE 11-8-67 / DR. BY RCT / CH'K'D. RCT	REVISION / DATE / BY
MATERIAL PURCHASE; (SEE NOTE) #12735A	DIMENSIONS—UNLESS OTHERWISE SPECIFIED: FRACTIONAL ± .015, DECIMAL ± .005, ANGULAR ± 1/2°; THREAD CHAMFER UP TO 5/16 D. - 1/32 X 45°, 3/8 D. & OVER - 1/16 X 45°	
TOOLS	REMOVE ALL BURRS & SHARP CORNERS	

USED ON	QTY.	USED ON	QTY.
12772G	2		

PLATING QUALITY—

2" O.D. x 3/16 WALL D.O.M. STEEL TUBING SELECT OUTSIDE SURFACE FOR PLATING

CUT TO LENGTH

78 5/8"

NOTE: SURFACE FINISH OF TUBING TO BE SUITABLE FOR MINIMUM POLISHING BEFORE PLATING

IF SURFACE FINISH OF TUBING NOT SUITABLE FOR PLATING, HAVE O.D. GROUND TO CLEAN FOR PLATING — MINIMUM SIZE 1.970" O.D. - 40 R.M.S. OR BETTER. (SUITABLE SOURCE FOR GRINDING. - ACE GRINDING")

DO NOT SCALE DRAWING.

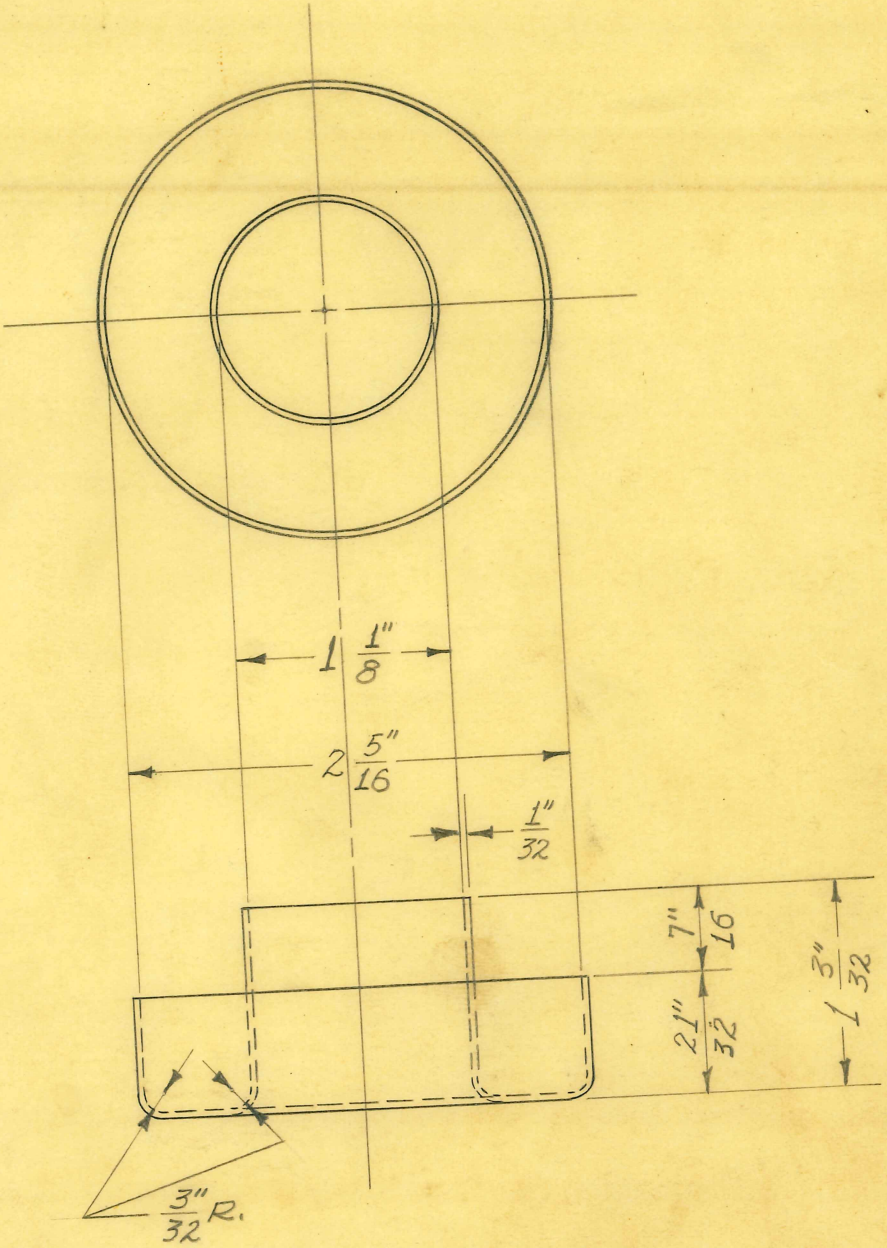

SIZE		ISSUE 9-28-39	J.W.
KIND	BRASS	CHANGED	
SHAPE	SPINNING	"	
FINISH		"	
TEMP.		"	
PATT.		"	

TITLE: FISCHER "TC-30-96" MOBILE STAND HEAD SUPPORT TUBE OPENING CAP

H. G. FISCHER & CO.
2335 WABANSIA AVE.
CHICAGO, ILL.

CAT. NO.

PART NO. 12736

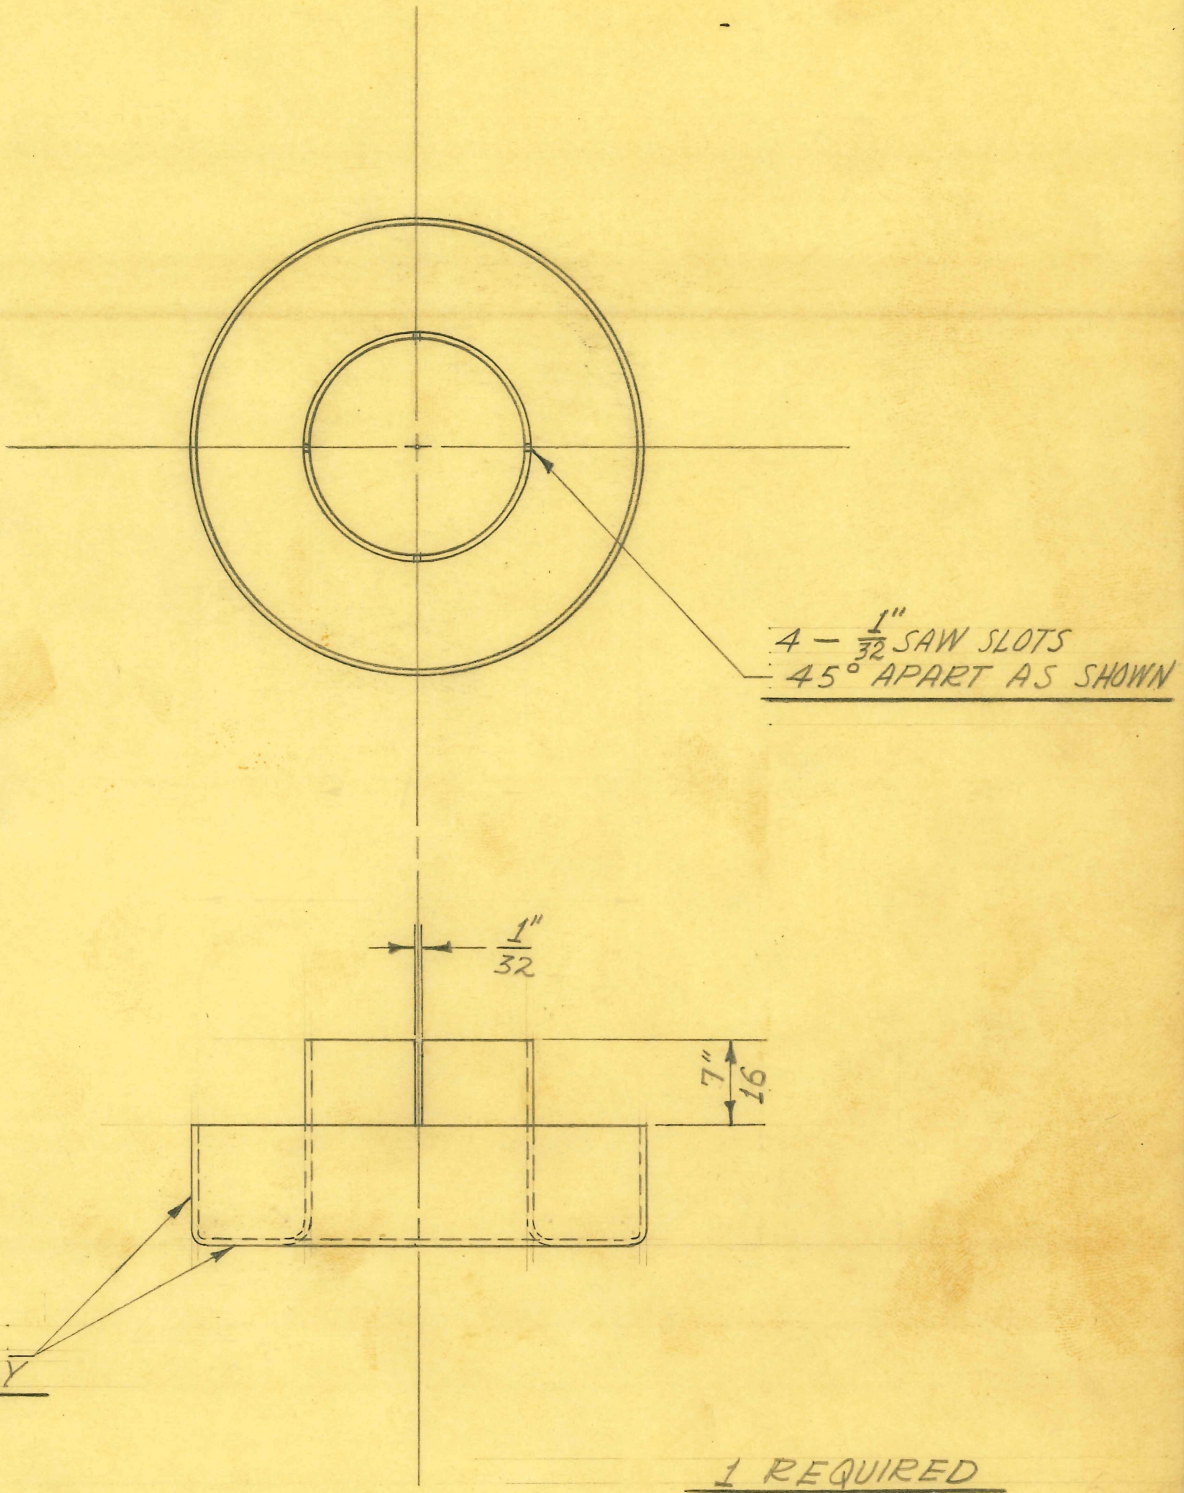

1 REQUIRED

SIZE		ISSUE 9-26-39	J.W.
KIND		CHANGED	
SHAPE		"	
FINISH	CHROME #2 SEE NOTE	"	
TEMP.		"	
PATT.		"	

TITLE:
FISCHER "TC-30-96" MOBILE STAND
HEAD SUPPORT TUBE OPENING CAP (SLOTTED)

H. G. FISCHER & CO.
2335 WABANSIA AVE.
CHICAGO, ILL.

CAT. NO.

PART NO. 12736F

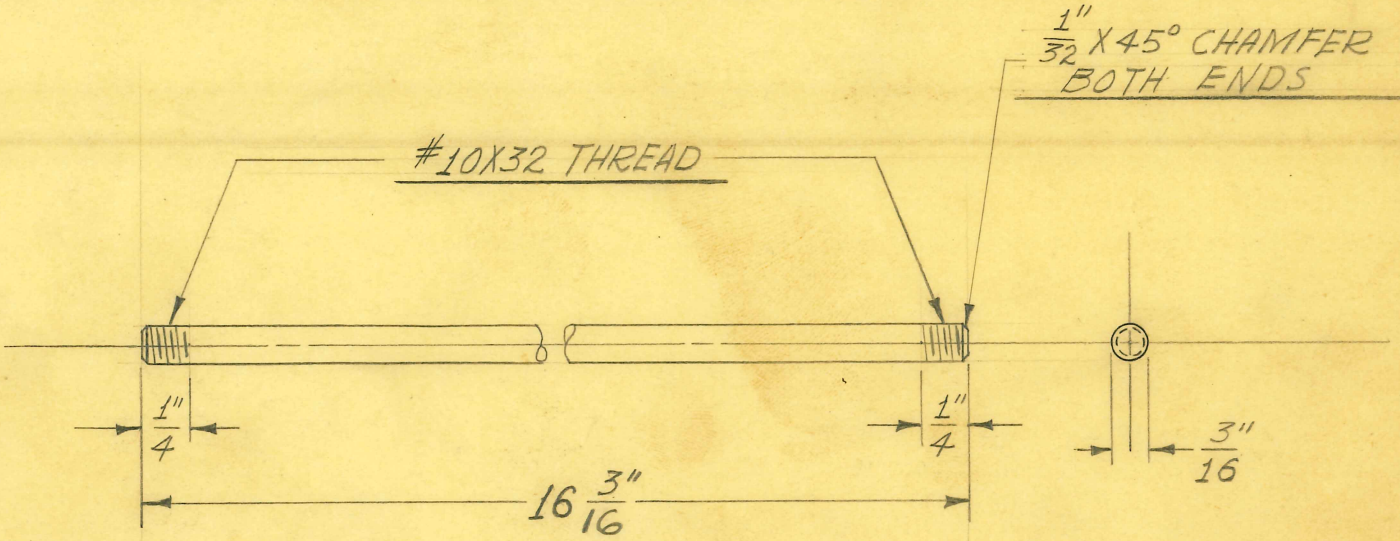

1 REQUIRED

SIZE	3/16" DIAM.	ISSUE 9-28-39	J.W.
KIND	C.R. STEEL	CHANGED	
SHAPE	ROD.	"	
FINISH	CAD. #23	"	
TEMP.		"	
PATT.		"	

TITLE:
FISCHER MOD. "TC-30-96" MOBILE STAND
HEAD SUPPORT TUBE CAP CLAMP ROD

H. G. FISCHER & CO.
2335 WABANSIA AVE.
CHICAGO, ILL.

CAT. NO.

PART NO. 12739

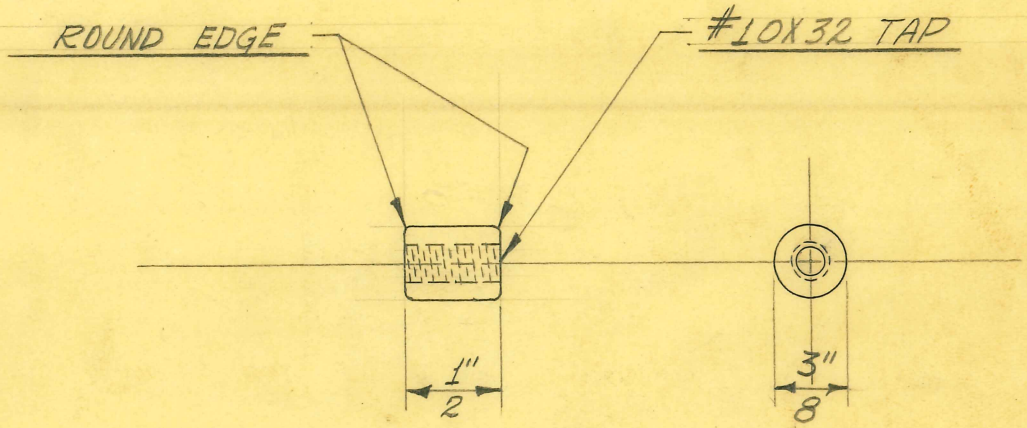

1 REQUIRED

RS

SIZE	3/8" DIAM.	ISSUE 9-28-39	J.W.	**TITLE:** FISCHER MOD. "TC-30-96" MOBILE STAND HEAD SUPPORT TUBE CAP CLAMP SPACER
KIND	BRASS ROD	CHANGED		
SHAPE		"		
FINISH		"		
TEMP.		"		
PATT.		"		

H. G. FISCHER & CO.
2338 WABANSIA AVE.
CHICAGO, ILL.

CAT. NO.

PART NO. 12740

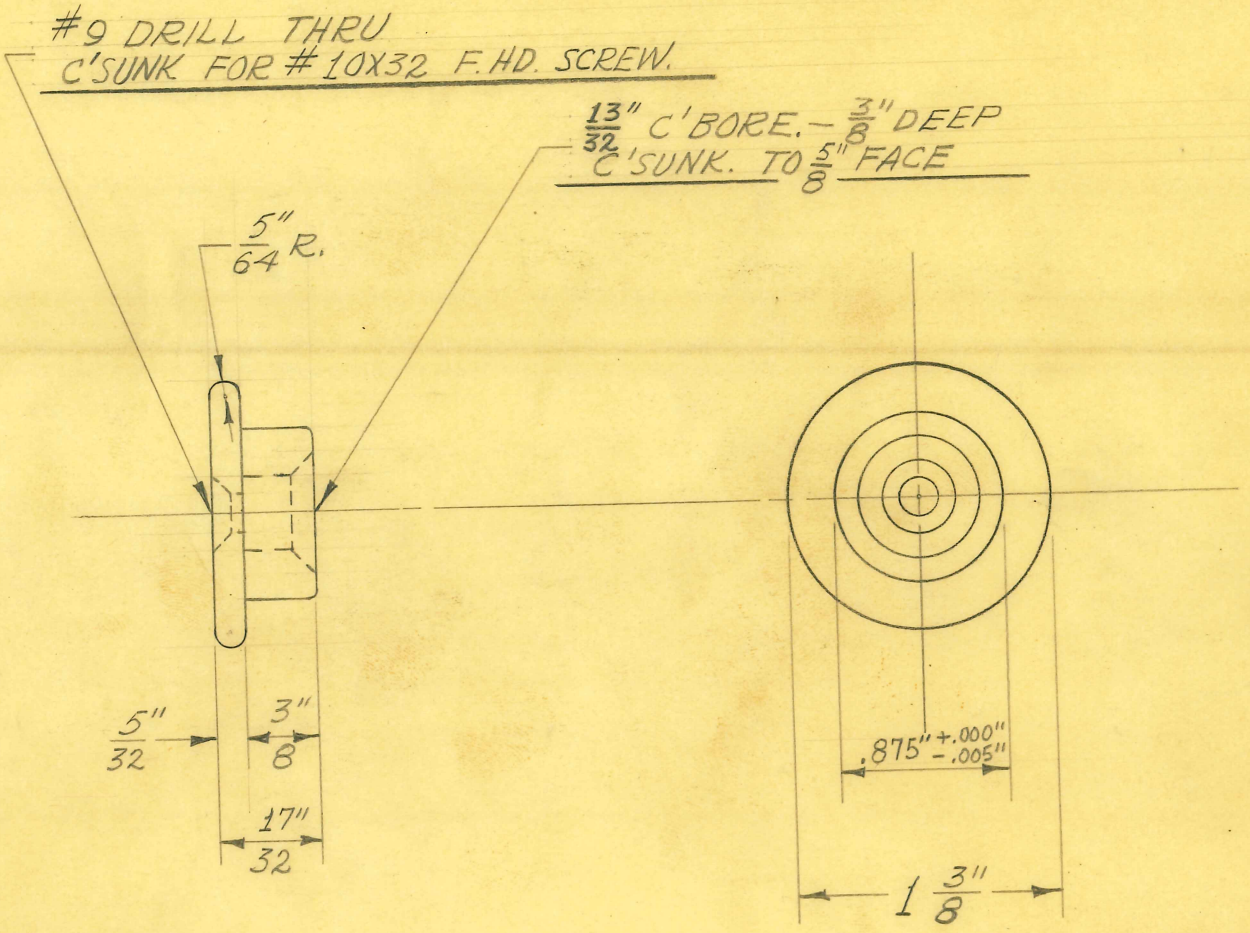

1 REQUIRED

NOTE:

- CAD. #23 FOR "TC-30-96" -

~~- CHROME #2 POLISH TOP OF HEAD & EDGE FOR LIGHT MOBILE STAND. -~~

SIZE	1 3/8" DIAM.	ISSUE 9-28-39	J.W.
KIND	C.R. STEEL	CHANGED	
SHAPE	ROD	"	
FINISH	SEE NOTE	"	
TEMP.		"	
PATT.		"	

TITLE: FISCHER MOD. "TC-30-96" MOBILE STAND HEAD SUPPORT TUBE CAP - REAR

H. G. FISCHER & CO.
2335 WABANSIA AVE.
CHICAGO, ILL.

CAT. NO.

PART NO. 12741

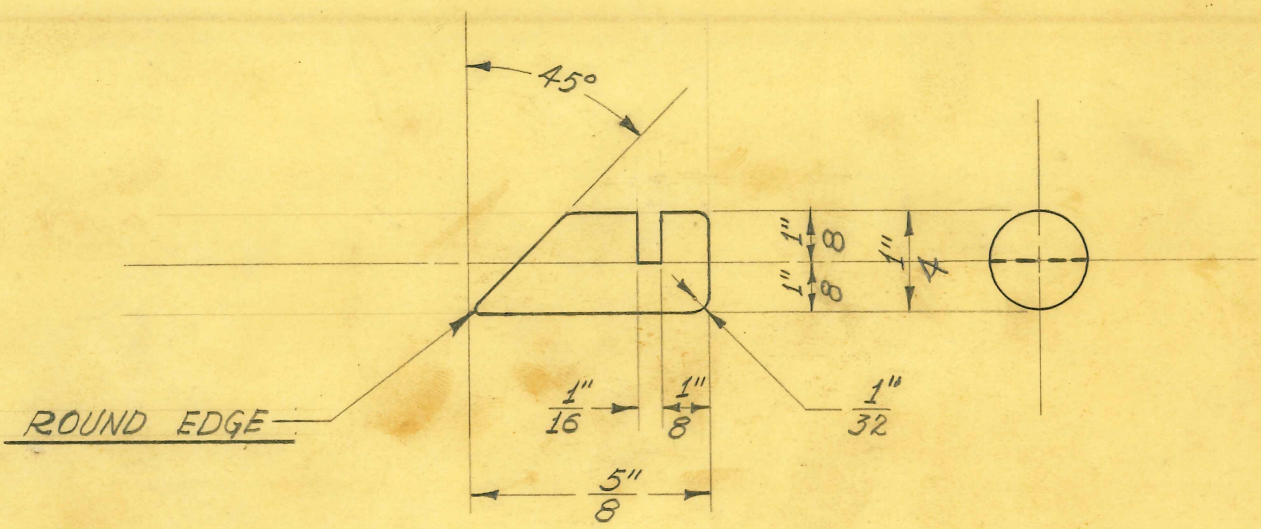

SCALE ÷ 2 DIAMETERS

1 REQUIRED

GRINDING FIX. #7320
MILLING FIX. #7320

SIZE	1/4" DIAM.	ISSUE 10-20-39	J.W.
KIND	C.R. STEEL	CHANGED	
SHAPE	ROD	"	
FINISH	CAD. #23	"	
TEMP.		"	
PATT.		"	

TITLE: FISCHER MOD. "TC-30-96" SHOCKPROOF MOBILE "X-RAY" UNIT - CABLE CONT. - LOCKING PIN

H. G. FISCHER & CO.
2338 WABANSIA AVE.
CHICAGO, ILL.

CAT. NO.

PART NO. 12743

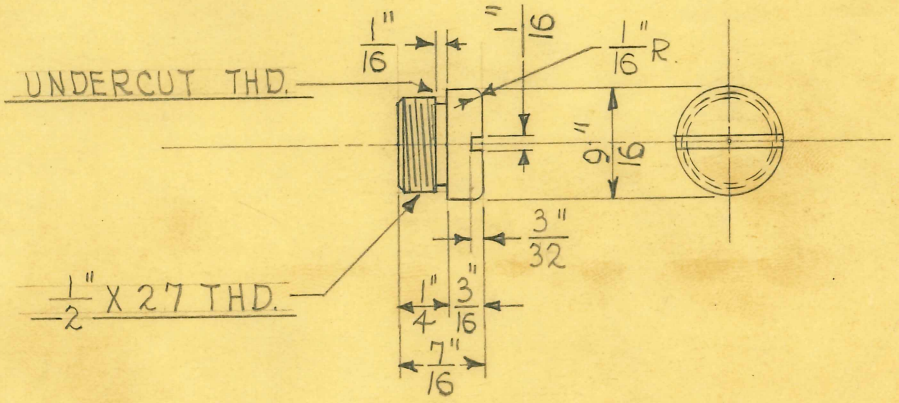

2 REQUIRED

SIZE	9/16" DIAM	ISSUE 11-20-39	HE.
KIND	Ⓐ NYLON	CHANGED 12-11-67	RSB
SHAPE	ROD	"	
FINISH		"	
TEMP.		"	
PATT.		"	

TITLE: FISCHER "TC-30-96" S.P. MOBILE X-RAY SLIDE-GUIDE PLUG

H. G. FISCHER & CO.
2335 WABANSIA AVE.
CHICAGO, ILL.

CAT. NO.

PART NO. 12744A

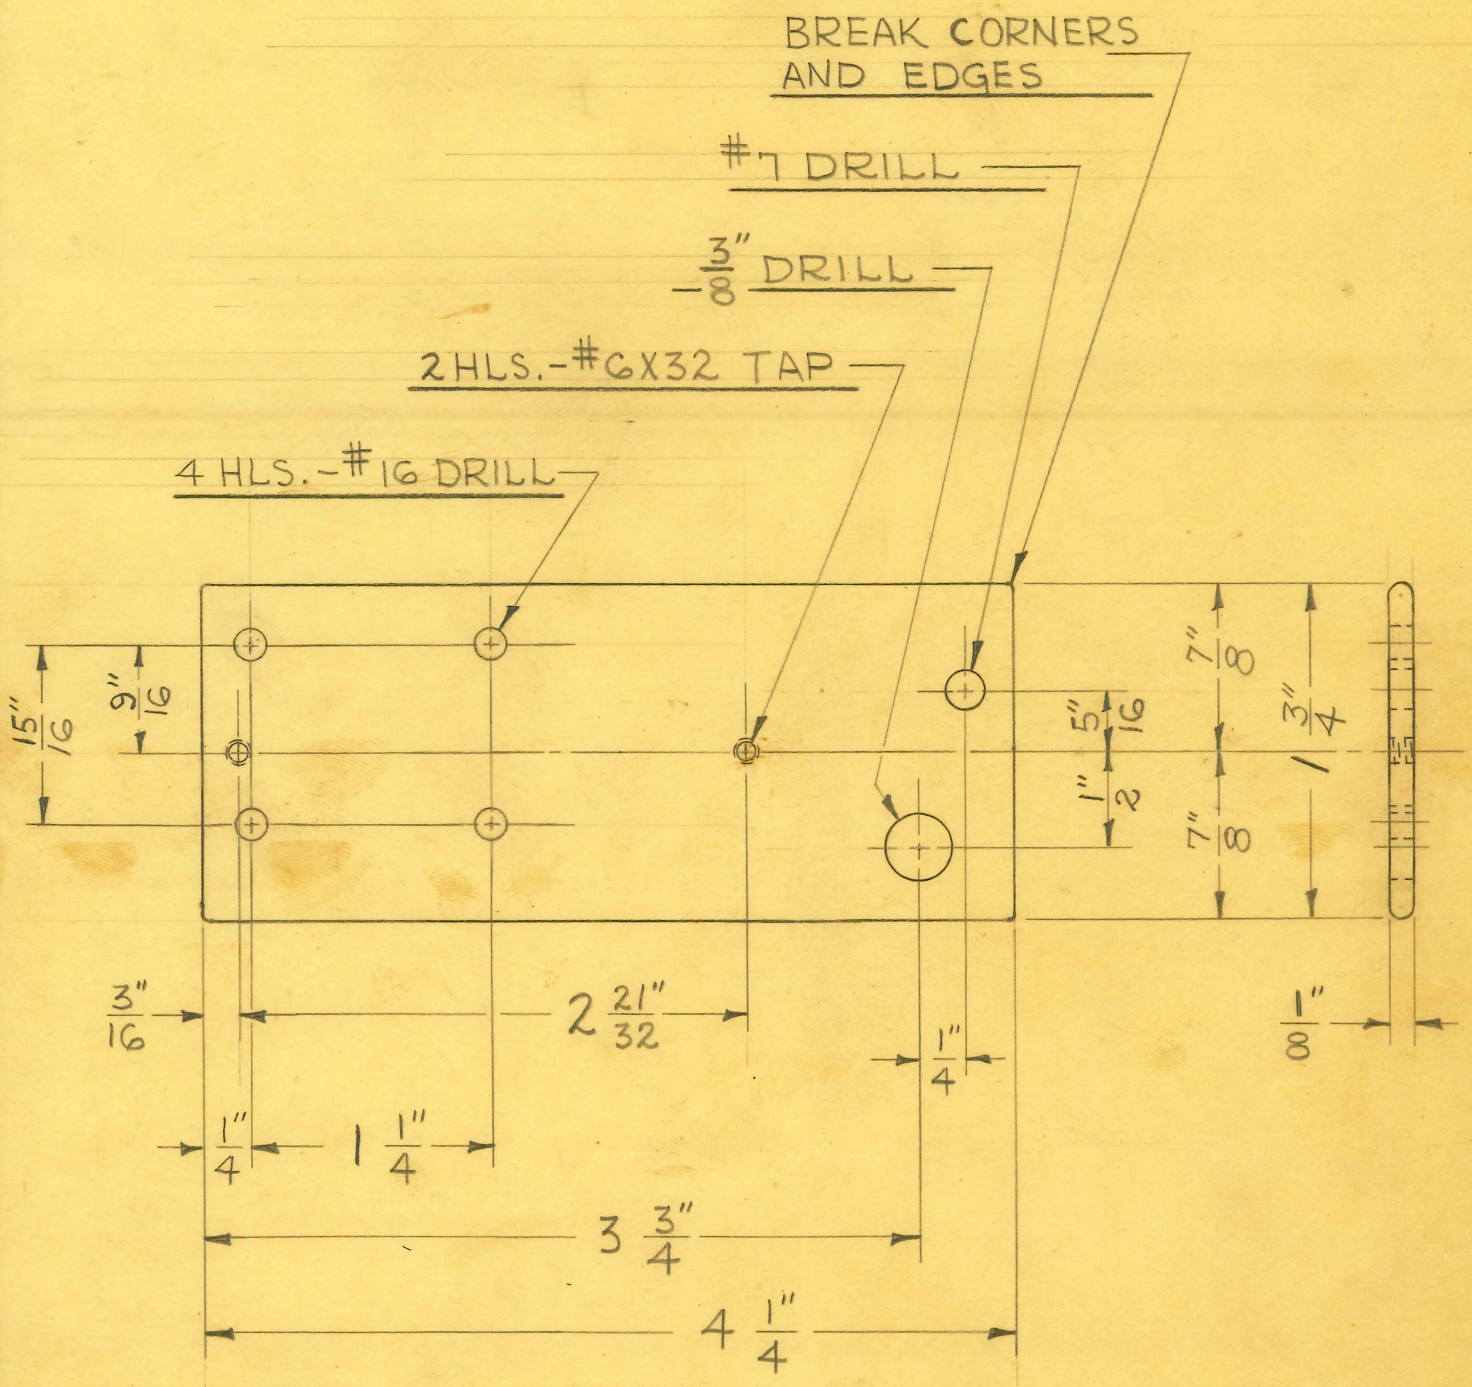

1 REQUIRED

SIZE	1/8" X 1 3/4"	ISSUE 12-21-45	J.V.W.	
KIND	FLAT WIRE	CHANGED		
SHAPE		"		
FINISH	BLACK #80	"		
TEMP.		"		
PATT.		"		

TITLE: FISCHER MOD. "TC-30-96" S.P. MOBILE X-RAY CONTROL-CONTACTOR BRACKET

H. G. FISCHER & CO.
2335 WABANSIA AVE.
CHICAGO, ILL.

CAT. NO.

PART NO. 12753B

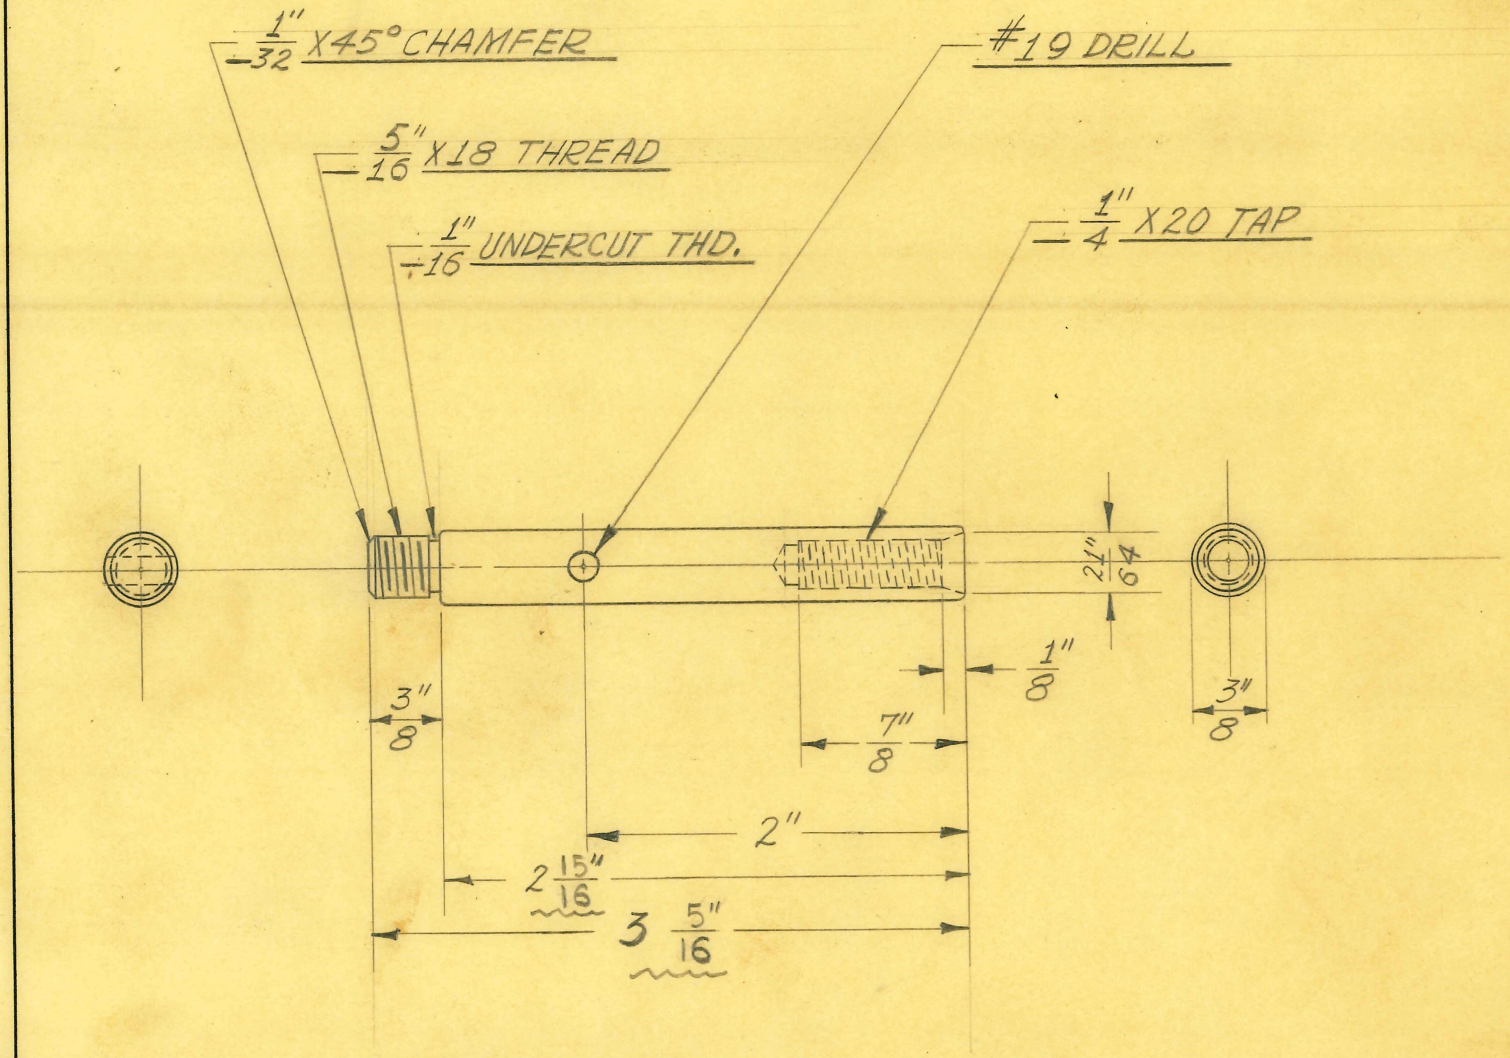

4 REQUIRED

SIZE	3/8" DIAM.	ISSUE 11-1-39	J.W.
KIND	C.R. STEEL	CHANGED 4-15-41	J.V.W.
SHAPE	ROD	"	
FINISH		"	
TEMP.		"	
PATT.		"	

TITLE: FISCHER MOD. "TC-30-96" S.P. MOBILE "X-RAY" CONTROL HOUSING COVER SPACER

H. G. FISCHER & CO.
2335 WABANSIA AVE.
CHICAGO, ILL.

CAT. NO.

PART NO. 12761A

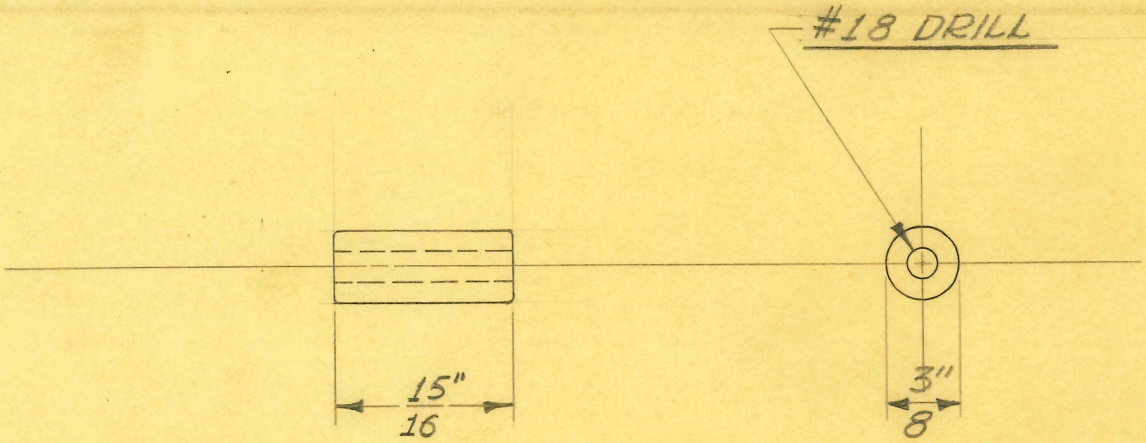

4 REQUIRED

RS

SIZE	3/8" DIAM.	ISSUE 11-2-39	J.W.
KIND	C.R. STEEL	CHANGED	
SHAPE	ROD.	"	
FINISH		"	
TEMP.		"	
PATT.		"	

TITLE: FISCHER MOD. "TC-30-96" S.P. MOBILE "X-RAY" CONTROL - TERMINAL BOARD SPACER

H. G. FISCHER & CO.
2335 WABANSIA AVE.
CHICAGO, ILL.

CAT. NO.

PART NO. 12762

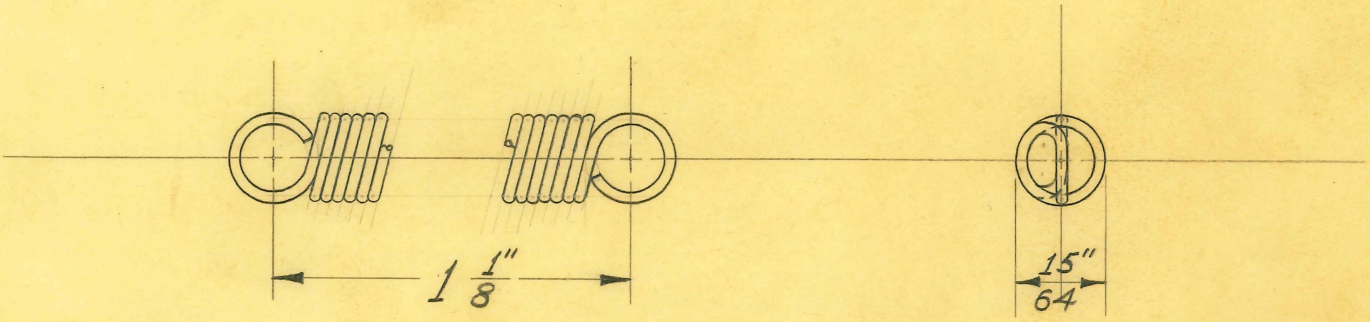

SCALE ÷ 2 DIAMETERS

APPROX. – 34 TURNS – WOUND CLOSE

1 REQUIRED

SIZE	.025" DIAM.	ISSUE 11-4-39	J.W.
KIND	MUSIC WIRE	CHANGED	
SHAPE		"	
FINISH	CAD. #23	"	
TEMP.		"	
PATT.		"	

TITLE: FISCHER MOD. "TC-30-96" S.P. MOBILE "X-RAY" CABLE CONT. LOCK ROD SPRING

H. G. FISCHER & CO.
2335 WABANSIA AVE.
CHICAGO, ILL.

CAT. NO.

PART NO. 12763

TITLE
FISCHER MOD. "TC-30-96" S.P. MOBILE "X-RAY" CABLE CONT. LOCK ROD.

PATTERN | FINISH | SCALE FULL

MATERIAL

TOOLS

H. G. FISCHER & CO.
FRANKLIN PARK, ILLINOIS

PART NO. 12764 GA

DATE 3-23-68 | DR. BY DJH | CH'K'D.

DIMENSIONS—UNLESS OTHERWISE SPECIFIED:

FRACTIONAL	± .015	THREAD CHAMFER
DECIMAL	± .005	UP TO 5/16 D. - 1/32 X 45°
ANGULAR	± 1/2°	3/8 D. & OVER - 1/16 X 45°

REMOVE ALL BURRS & SHARP CORNERS

USED ON	QTY.	USED ON	QTY.
12772 GB	1		

REVISION		DATE	BY
A1	GIVEN PART NUMBERS BUL 519	3-25-68	SD
A2			

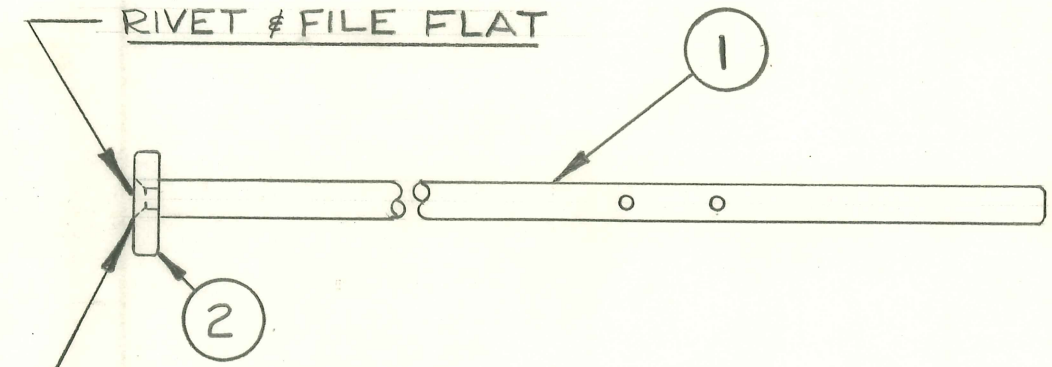

	DEPT.	AMT.	ITEM	DESCRIPTION	PART NO.
A1	M.S.	1	1	CABLE ROD	18971
A2	M.S	1	2	CABLE BUSHING	18972

DO NOT SCALE DRAWING.

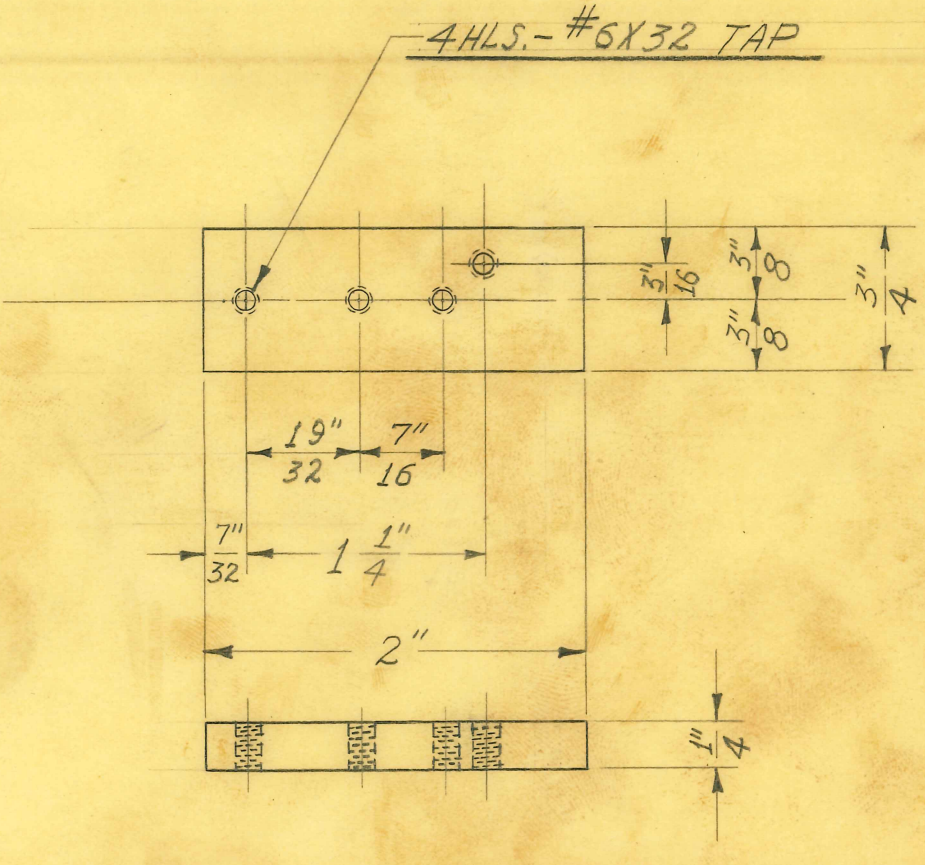

2 REQUIRED

RS

SIZE	1/4" SHEET	ISSUE 11-8-39	J.W.
KIND	BAKELITE	CHANGED 11-17-39	J.W.
SHAPE		"	
FINISH		"	
TEMP.		"	
PATT.		"	

TITLE: FISCHER MOD. "TC-30-96" S.P. MOBILE "X-RAY" CONTROL - METER LIGHT MTG. BOARD

H. G. FISCHER & CO.
2338 WABANSIA AVE.
CHICAGO, ILL.

CAT. NO.

PART NO. 12766

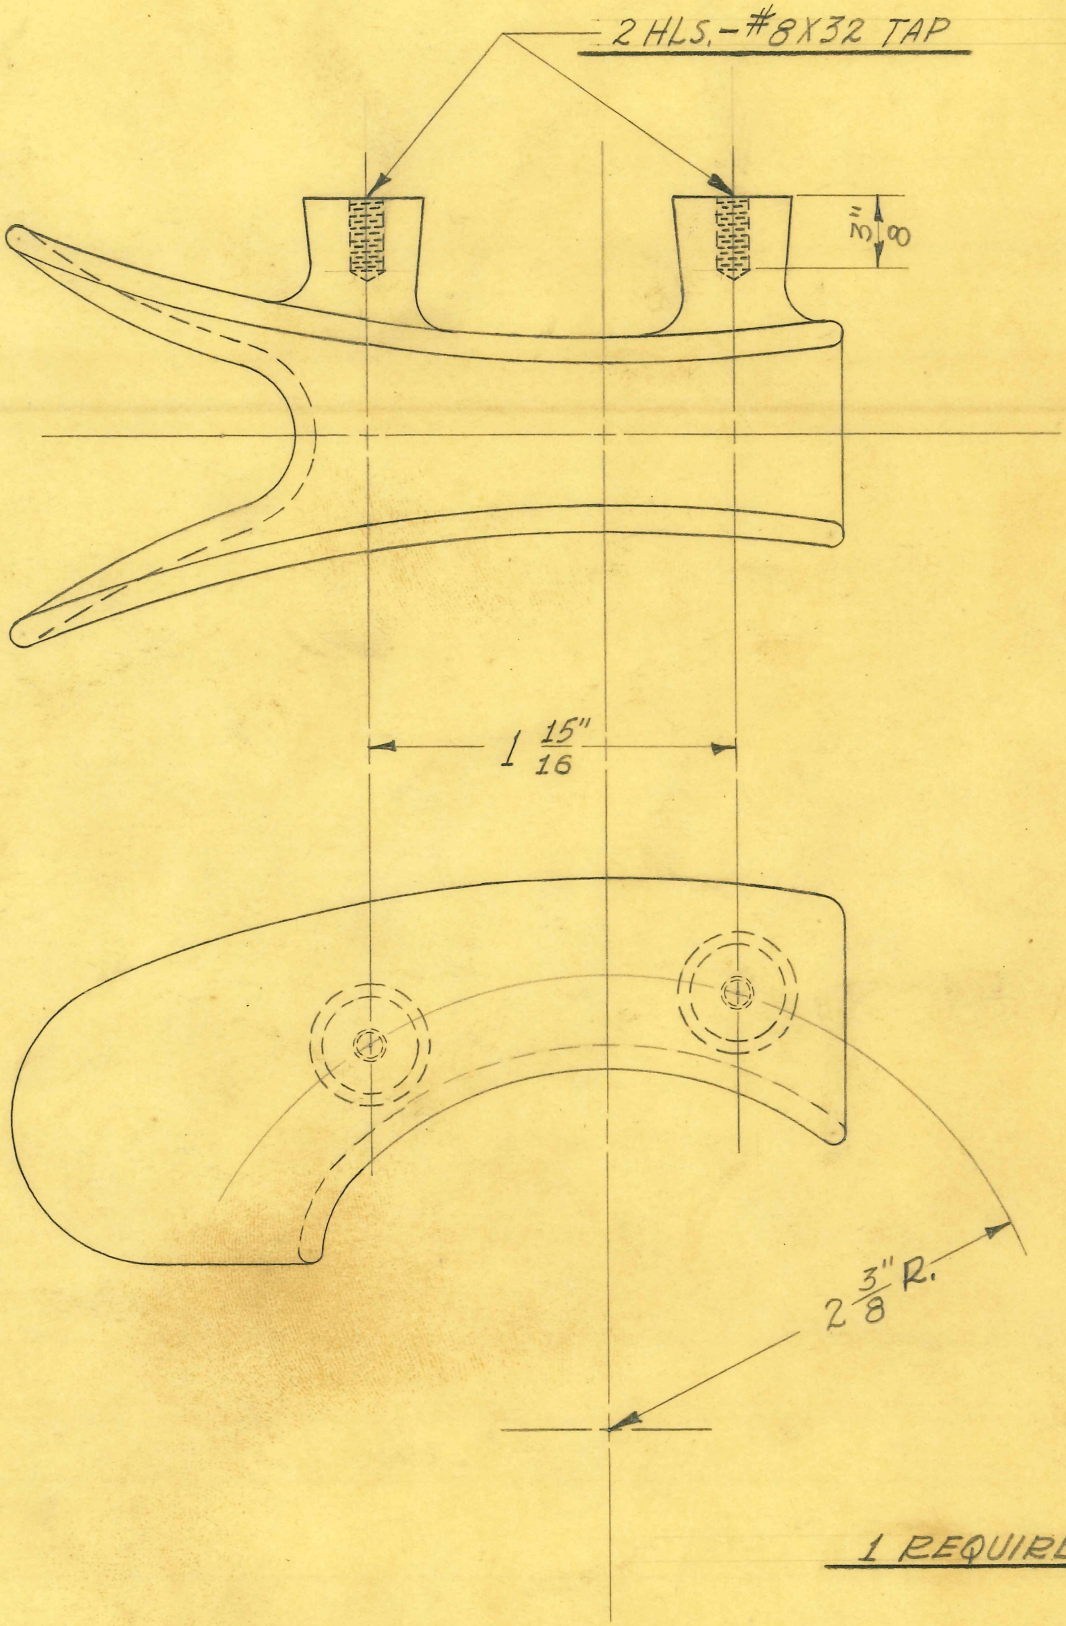

1 REQUIRED

SIZE	#12	ISSUE 1-22-40	J.W.
KIND	ALUM. CASTING	CHANGED	
SHAPE		"	
FINISH	PAINTED	"	
TEMP.		"	
PATT.	1438	"	

TITLE: FISCHER MOD. "TC-30-96" S.P. MOBILE "X-RAY" CABLE REST

H. G. FISCHER & CO.
2335 WABANSIA AVE.
CHICAGO, ILL.

CAT. NO.

PART NO. 12768F

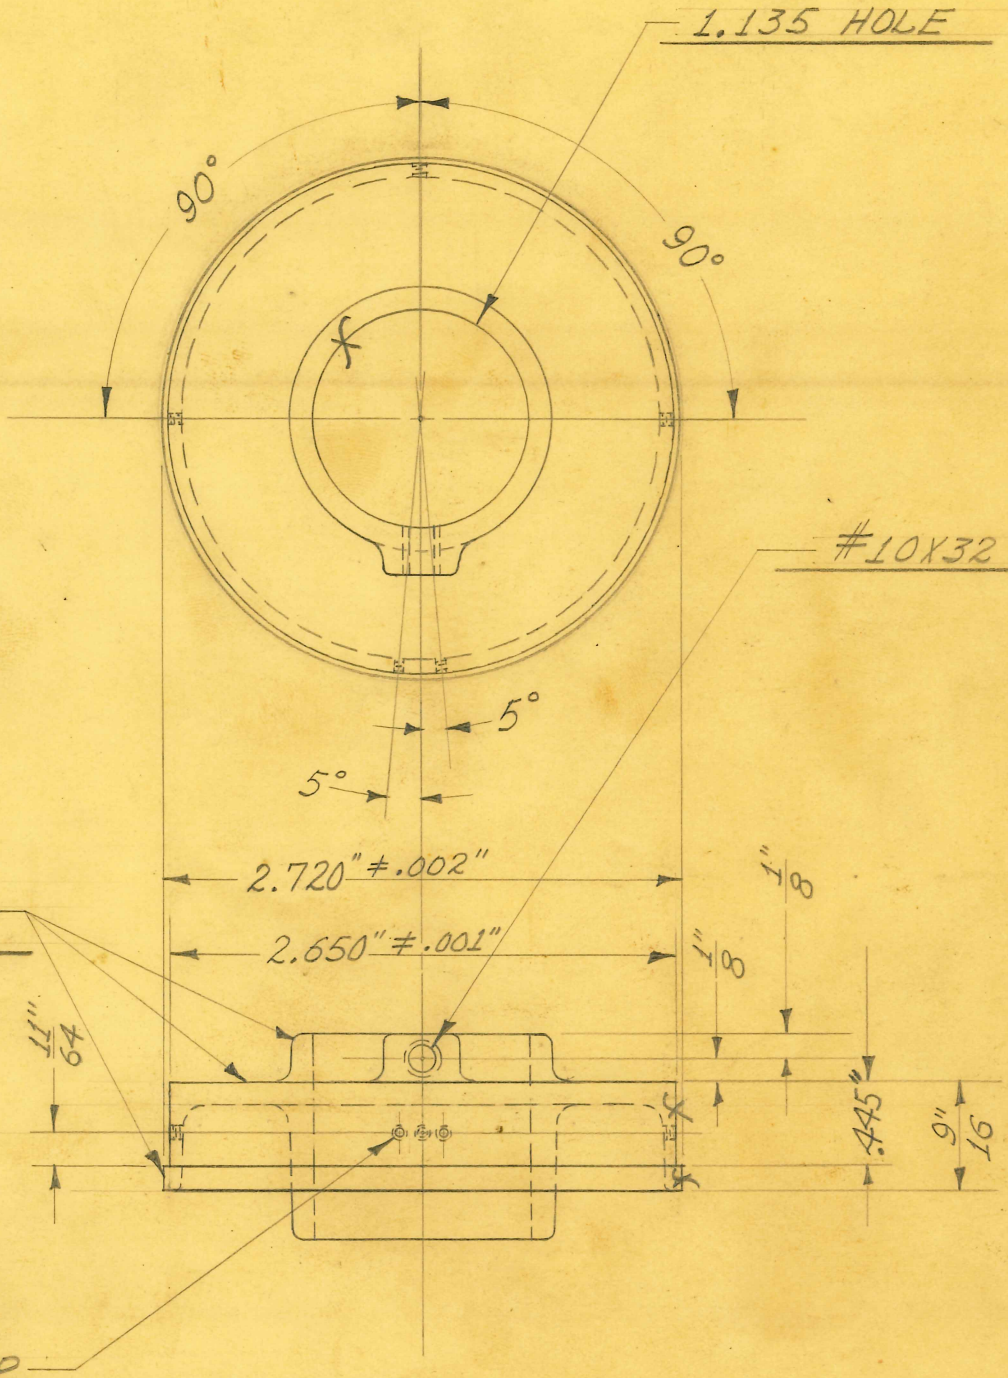

1 REQUIRED

SIZE	#12	ISSUE 10-21-40	J.V.W.
KIND	ALUM. CASTING	CHANGED	
SHAPE		"	
FINISH	SEE NOTE	"	
TEMP.		"	
PATT.	1639	"	

TITLE: FISCHER MOD. "TC-30-96" MOBILE UNIT HORIZONTAL ANGLE PLATE MTG. RING

H. G. FISCHER & CO.
2335 WABANSIA AVE.
CHICAGO, ILL.

CAT. NO.

PART NO. 12778F

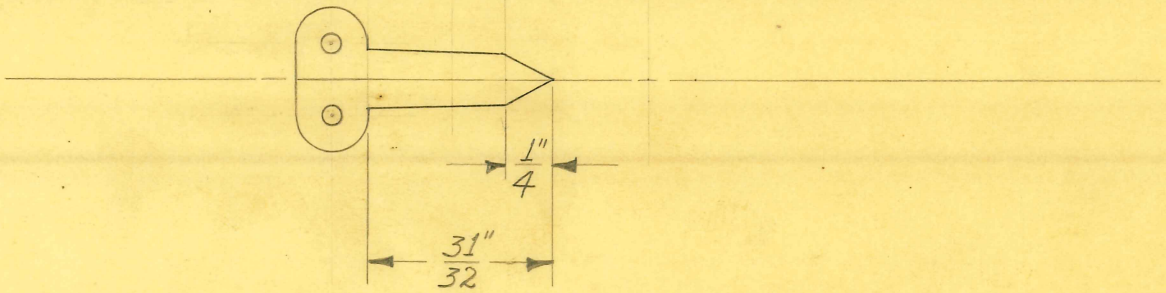

FROM PCE. #8125

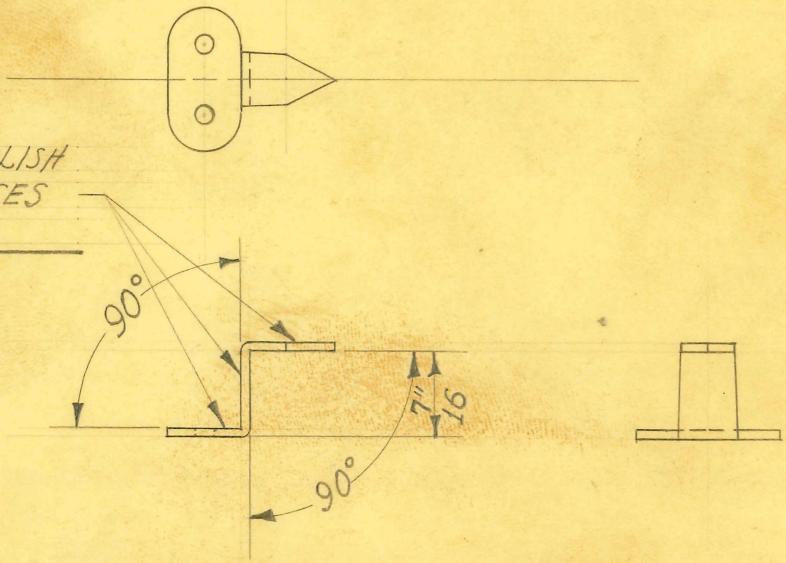

CHROME #2 POLISH THESE SURFACES & EDGES.

1 REQUIRED

SIZE		ISSUE 10-21-40	J. V. W.
KIND		CHANGED	
SHAPE		"	
FINISH	SEE NOTE	"	
TEMP.		"	
PATT.		"	

TITLE: FISCHER MOD. "TC-30-96" MOBILE UNIT VERTICAL ANGLE INDICATOR

H. G. FISCHER & CO.
2335 WABANSIA AVE.
CHICAGO, ILL.

CAT. NO.

PART NO. 12779

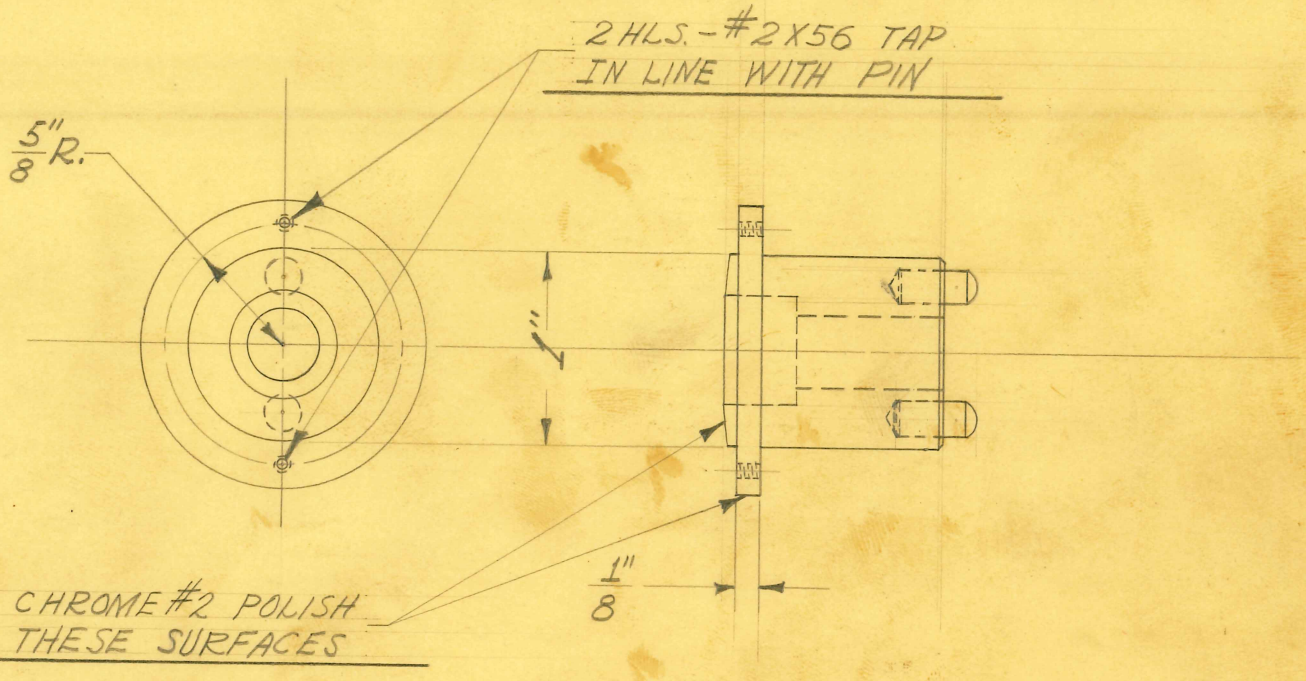

2 REQUIRED

SIZE	FROM	ISSUE 10-21-40	J.V.W.
KIND	12667GA	CHANGED	
SHAPE		"	
FINISH	SEE NOTE	"	
TEMP.		"	
PATT.		"	

TITLE:
FISCHER MOD. "TC-30-96" MOBILE UNIT
X-RAY UNIT - TANK BEARING

H. G. FISCHER & CO.
2335 WABANSIA AVE.
CHICAGO, ILL.

CAT. NO.

PART NO. 12781

2 ELONGNATED HOLES
#37 DRILL SIZE.

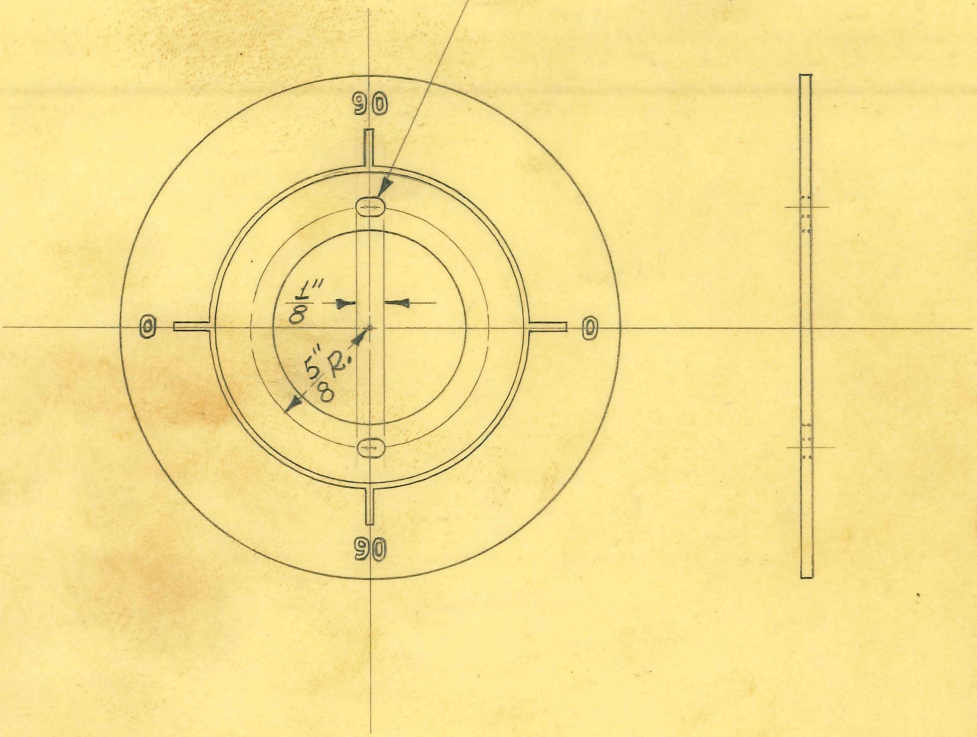

2 REQUIRED

FROM PCE. # 12321

SIZE		ISSUE 10-21-40	J.V.W.
KIND		CHANGED	
SHAPE		"	
FINISH		"	
TEMP.		"	
PATT.		"	

TITLE: FISCHER MOD. "TC-30-96" MOBILE UNIT
VERTICAL ANGLE PLATE

H. G. FISCHER & CO.
2335 WABANSIA AVE.
CHICAGO, ILL.

CAT. NO.

PART NO. 12782

TITLE "TM" 3 POINT SWITCH CONTACT RING

H. G. FISCHER & CO.
FRANKLIN PARK, ILLINOIS

PART NO. 12787A

DATE 3-12-53 | DR. BY J.N.W. | CH'K'D.

REVISION	DATE	BY

PATTERN | FINISH | SCALE FULL

TOOLS: DRILL JIG # 7685

MATERIAL: FROM # 11476A

DIMENSIONS
FRACTIONAL ± .015
DECIMAL ± .005
ANGULAR ± ½°
UNLESS OTHERWISE SPECIFIED

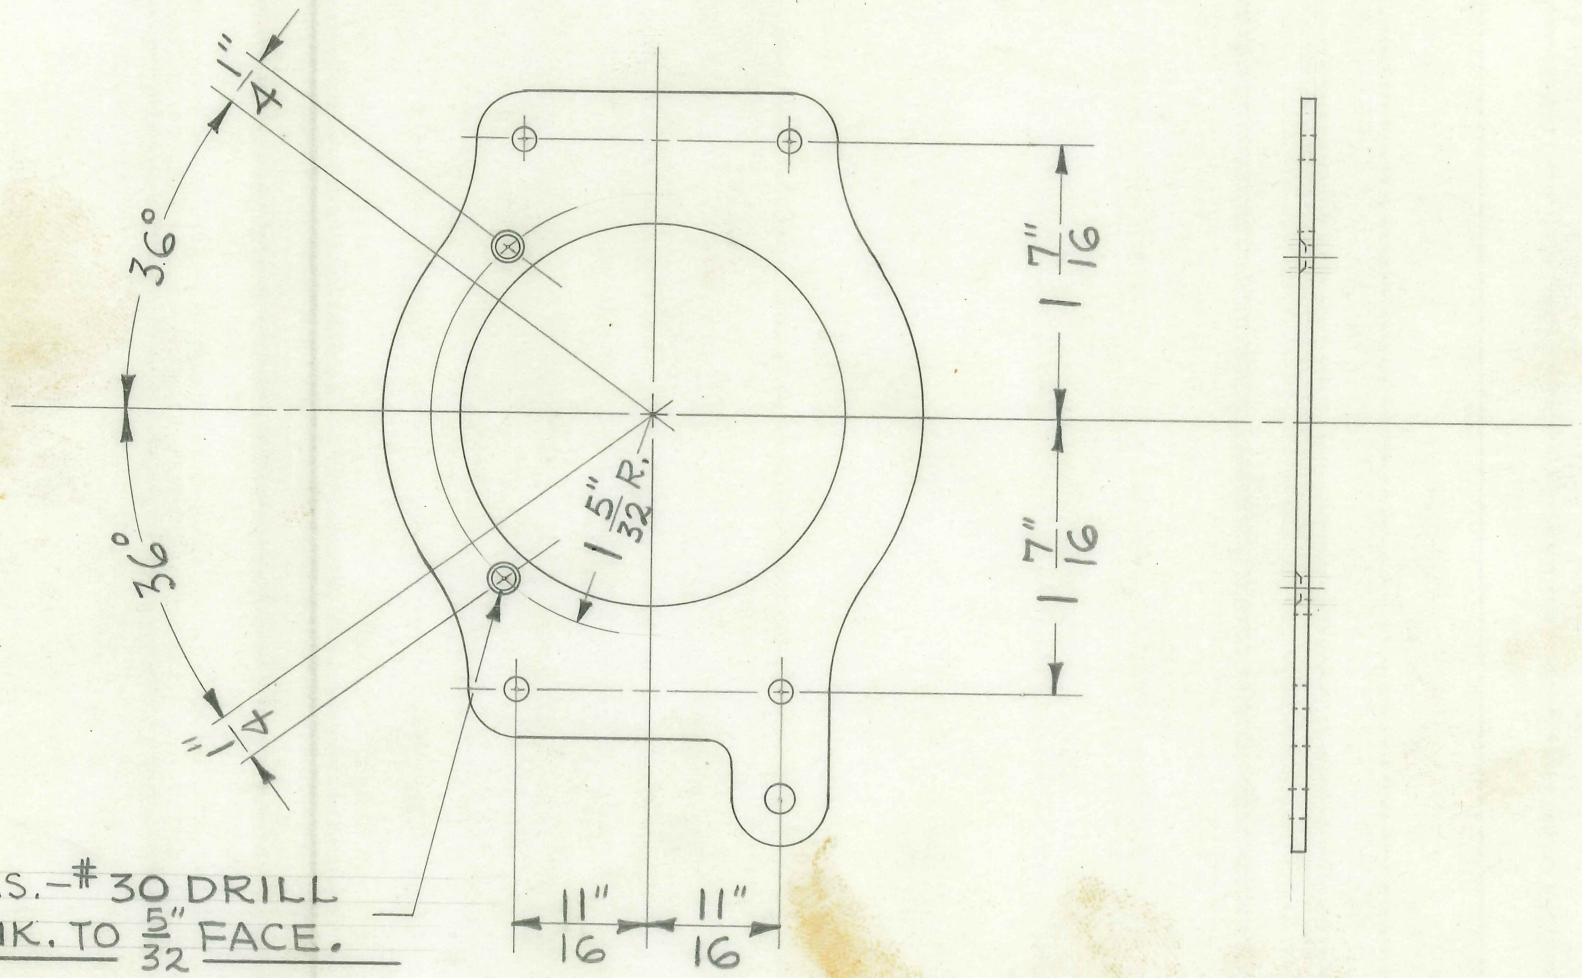

2 HLS. – # 30 DRILL
C'SINK. TO 5/32" FACE.

1 REQUIRED

FOLDER # 100

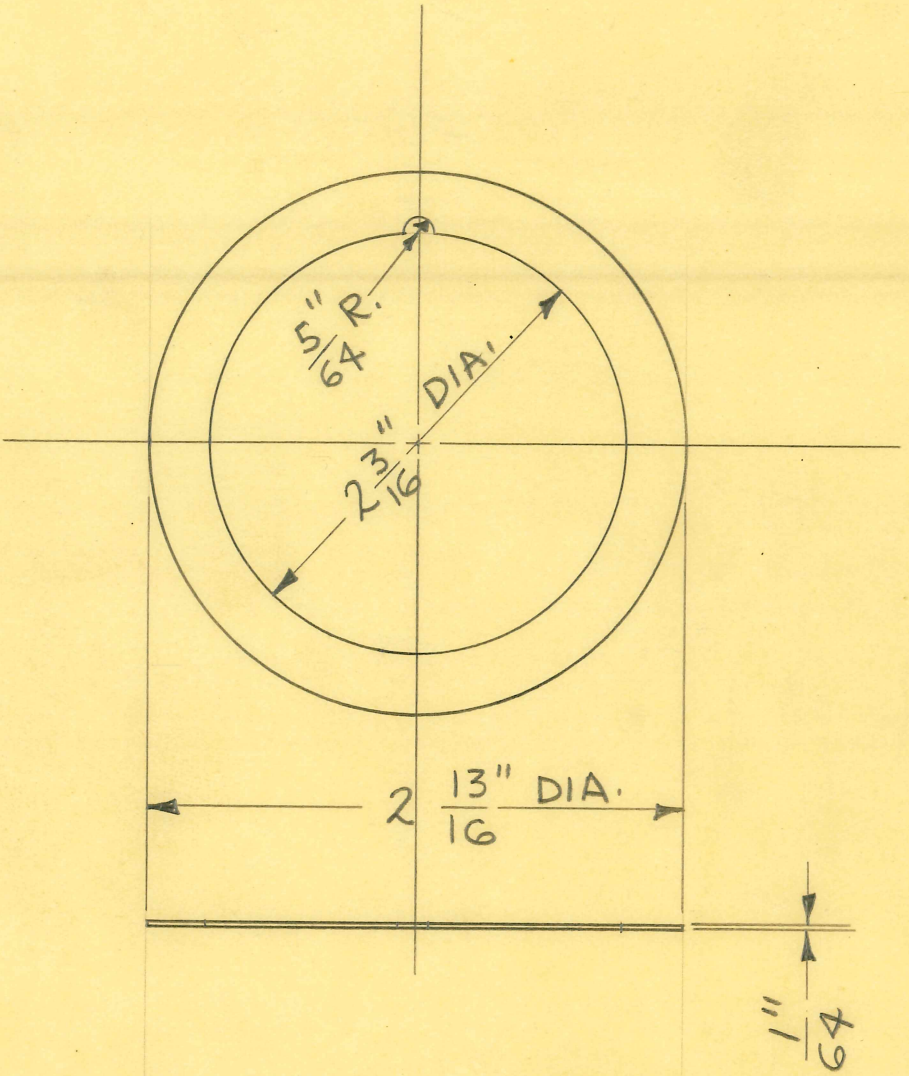

1 REQUIRED

DIMENSIONS	
FRACTIONAL	± .015
DECIMAL	± .005
ANGULAR	± 1/2°

UNLESS OTHERWISE SPECIFIED

SIZE	1/64" SHEET	ISSUE 6-16-48	J.V.W.
KIND		CHANGED	
SHAPE		"	
FINISH		"	
TEMP.		"	
PATT.		"	

TITLE: MODEL "300" DIATHERMY METER RING

H. G. FISCHER & CO.
2335 WABANSIA AVE.
CHICAGO, ILL.

CAT. NO.

PART NO. 17661 1/2

2 HLS. - #31 DRILL

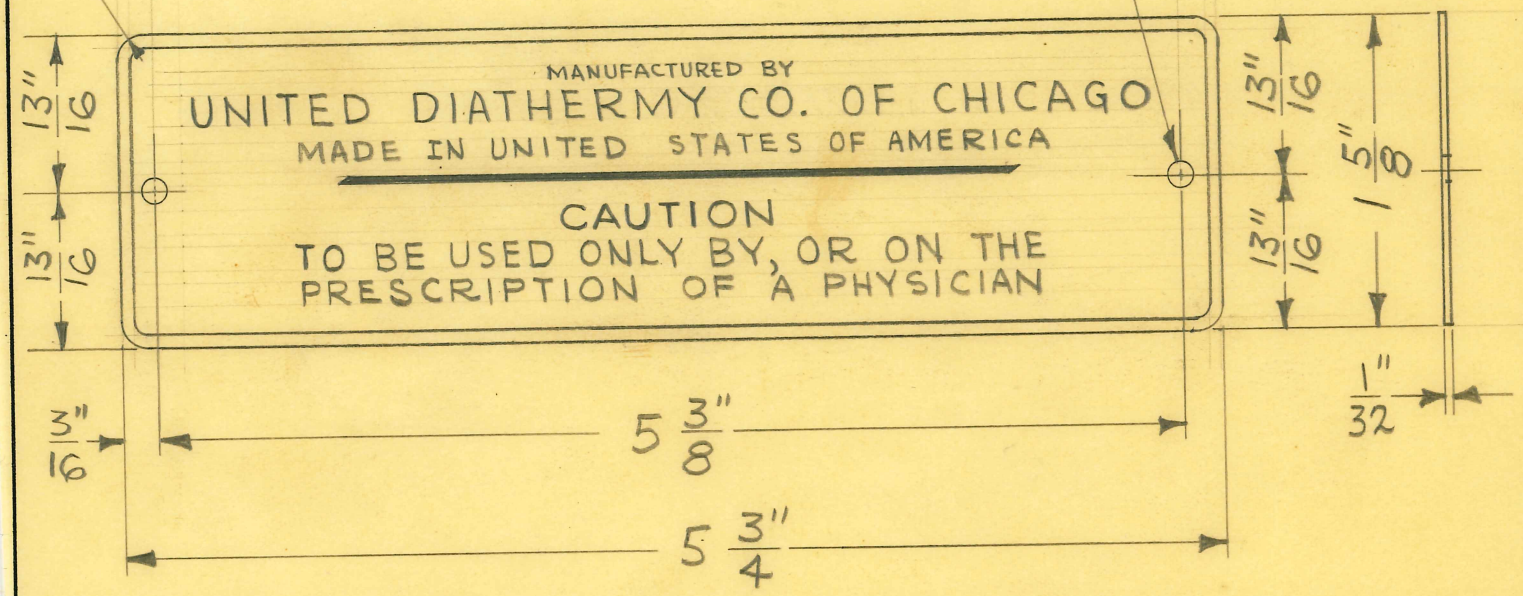

1 REQUIRED

DIMENSIONS	
FRACTIONAL	± .015
DECIMAL	± .005
ANGULAR	± 1/2°

UNLESS OTHERWISE SPECIFIED

SIZE		ISSUE 5-12-48	J.V.W.
KIND		CHANGED	
SHAPE		"	
FINISH		"	
TEMP.		"	
PATT.		"	

TITLE: MODEL "300" DIATHERMY NAME PLATE

H. G. FISCHER & CO.
2335 WABANSIA AVE.
CHICAGO, ILL.

CAT. NO.

PART NO. 17662

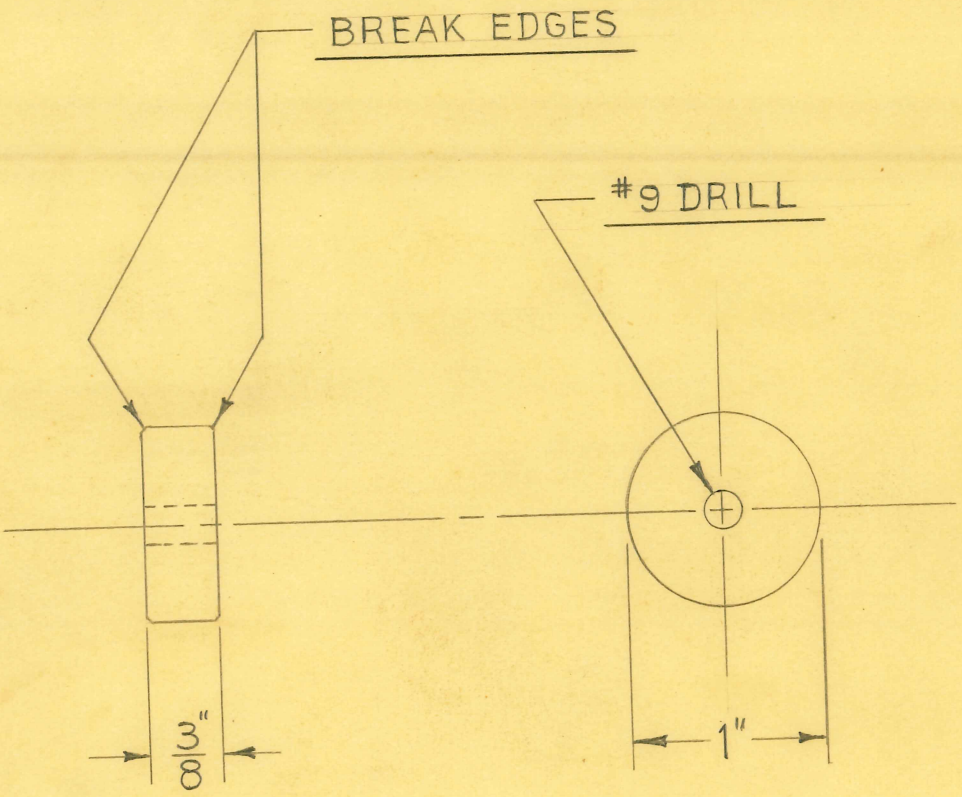

4-REQUIRED

DIMENSIONS	
FRACTIONAL	± .015
DECIMAL	± .005
ANGULAR	± 1/2°

UNLESS OTHERWISE SPECIFIED

SIZE	1" DIA.	ISSUE 5-12-48	J.B.G.	
KIND	C.R.STEEL	CHANGED		
SHAPE	ROD	"		
FINISH	CAD.#23	"		
TEMP.		"		
PATT.		"		

TITLE: FISCHER MOD."10" DIATHERMY
MODEL"300" PORTABLE DIATHERMY
CABINET GLIDE

H. G. FISCHER & CO.
2333 WABANSIA AVE.
CHICAGO, ILL.

CAT. NO.

PART NO. 17663

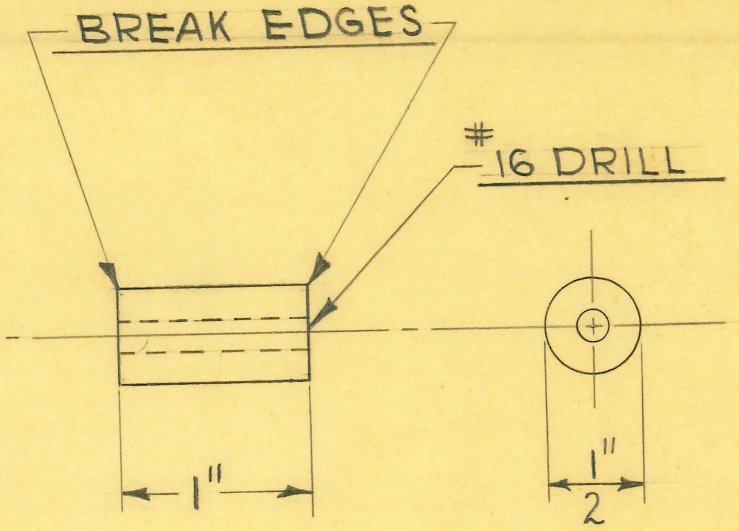

2 REQUIRED

DIMENSIONS	
FRACTIONAL	± .015
DECIMAL	± .005
ANGULAR	± 1/2°

UNLESS OTHERWISE SPECIFIED

SIZE	½" DIA.	ISSUE 5-13-48	W.J.
KIND	BRASS	CHANGED	
SHAPE	ROD	"	
FINISH		"	
TEMP.		"	
PATT.		"	

TITLE:

MODEL "300" PORTABLE DIATHERMY
SOCKET BOARD SPACER

H. G. FISCHER & CO.
2335 WABANSIA AVE.
CHICAGO, ILL.

CAT. NO.

PART NO. 17664

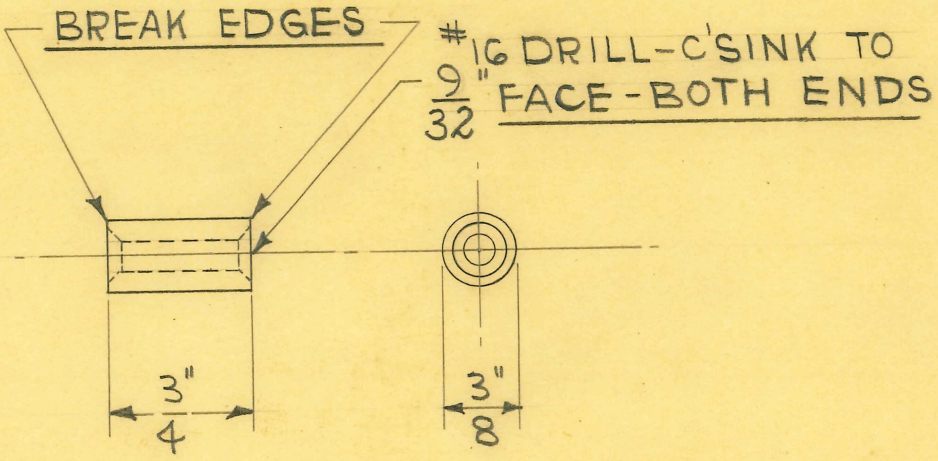

2 REQUIRED

DIMENSIONS	
FRACTIONAL	± .015
DECIMAL	± .005
ANGULAR	± 1/2°

UNLESS OTHERWISE SPECIFIED

SIZE	3/8" DIA.	ISSUE 5-13-48	W.J.
KIND	BRASS	CHANGED	
SHAPE	ROD	"	
FINISH		"	
TEMP.		"	
PATT.		"	

TITLE: FISCHER MOD. "10" DIATHERMY
MODEL "300" PORTABE DIATHERMY
TUNING CONDENSER SUPP.
SPACER

H. G. FISCHER & CO.
2335 WABANSIA AVE.
CHICAGO, ILL.

CAT. NO.

PART NO. 17668

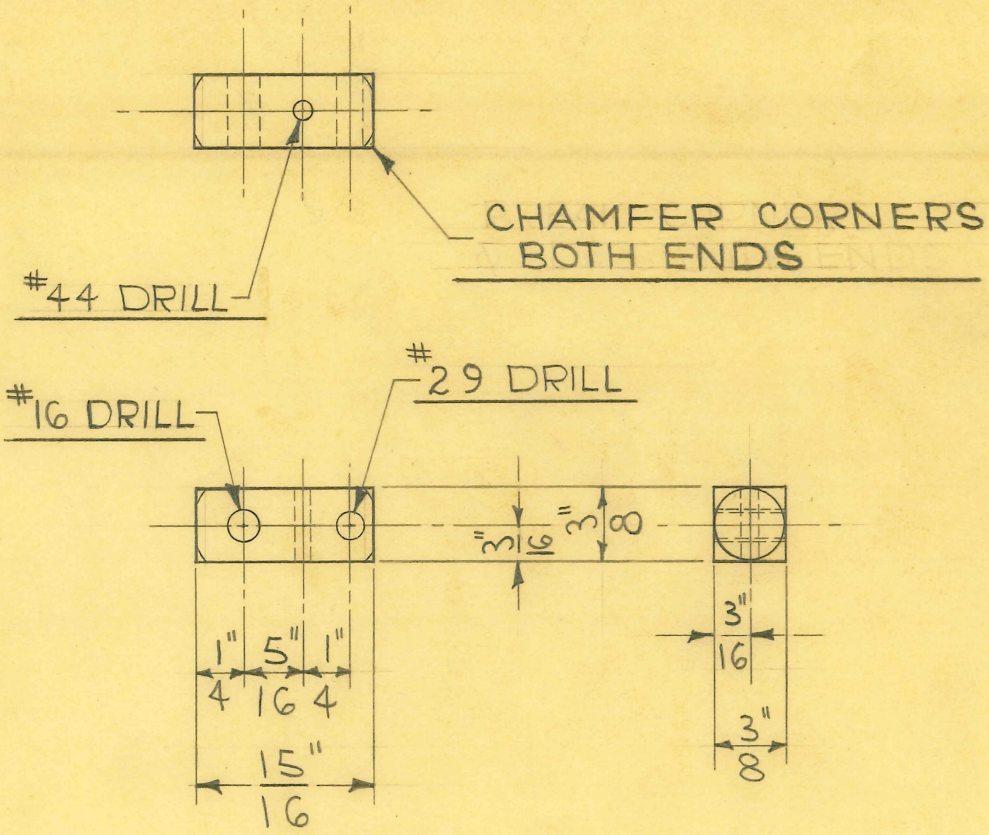

2 REQUIRED

DRILL JIG TOOL #9818

DIMENSIONS	
FRACTIONAL	± .015
DECIMAL	± .005
ANGULAR	± 1/2°

UNLESS OTHERWISE SPECIFIED

SIZE	3/8" SQ.	ISSUE 5-13-48	W.J.
KIND	BRASS	CHANGED	
SHAPE	BAR	"	
FINISH		"	
TEMP.		"	
PATT.		"	

TITLE: FISCHER MOD. "10" DIATHERMY
MODEL "300" PORTABLE DIATHERMY
PARALLEL COIL SUPPORT

H. G. FISCHER & CO.
2335 WABANSIA AVE.
CHICAGO, ILL.

CAT. NO.

PART NO. 17669

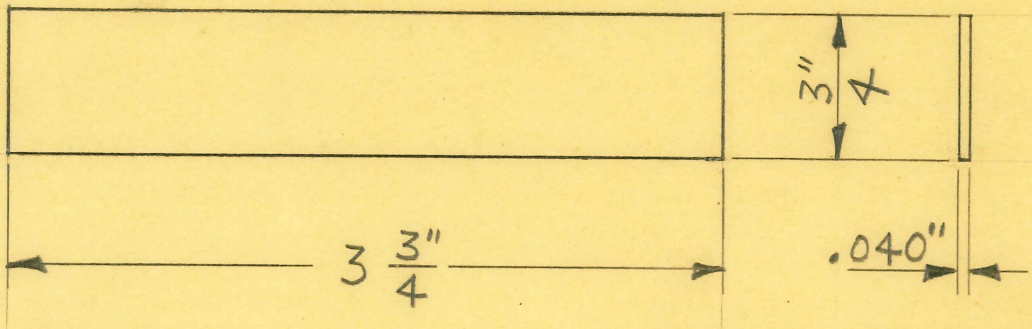

1 REQUIRED

.040" #2400 CHACE THERMOSTATIC BIMETAL

DIMENSIONS	
FRACTIONAL	± .015
DECIMAL	± .005
ANGULAR	± 1/2°

UNLESS OTHERWISE SPECIFIED

SIZE		ISSUE 5-14-48	J.V.W.
KIND		CHANGED	
SHAPE		"	
FINISH		"	
TEMP.		"	
PATT.		"	

TITLE: FISCHER MOD. "10" DIATHERMY
MODEL "300" DIATHERMY
THERMAL COMP.-ACTIVE-BLANK

H. G. FISCHER & CO.
2335 WABANSIA AVE.
CHICAGO, ILL.

CAT. NO.

PART NO. 17670

1ST OPERATION

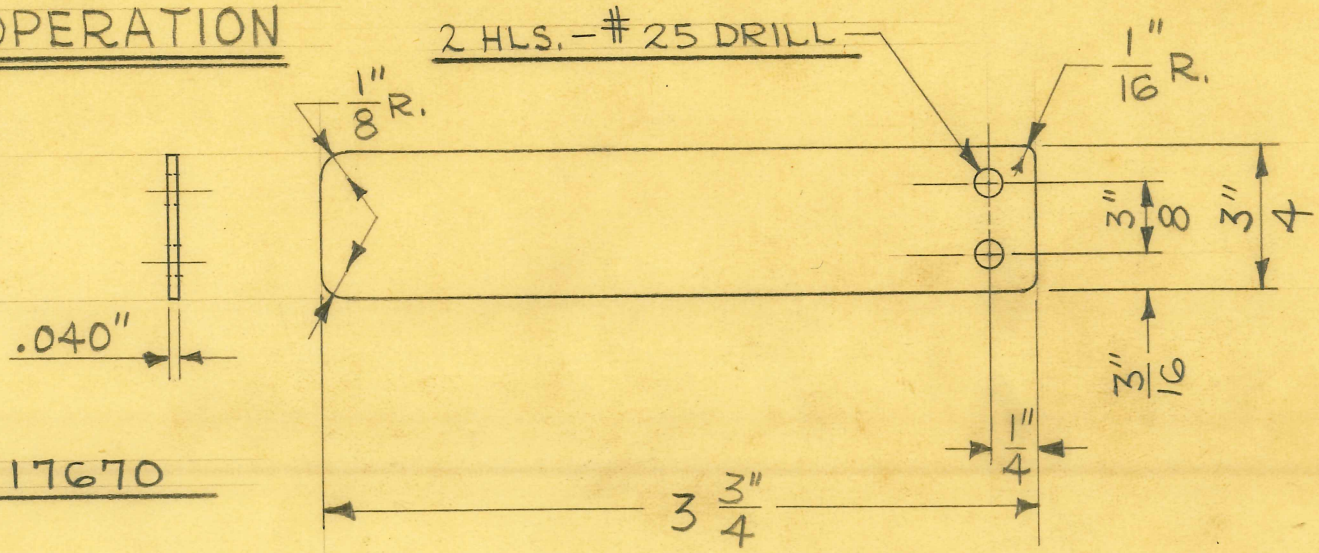

FROM 17670

2nd OPERATION

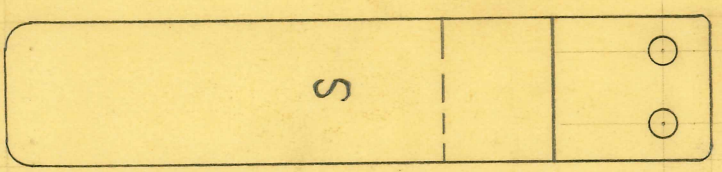

LETTER "S" STAMPED ON BIMETAL MUST BE ON THIS SIDE AFTER BENDING

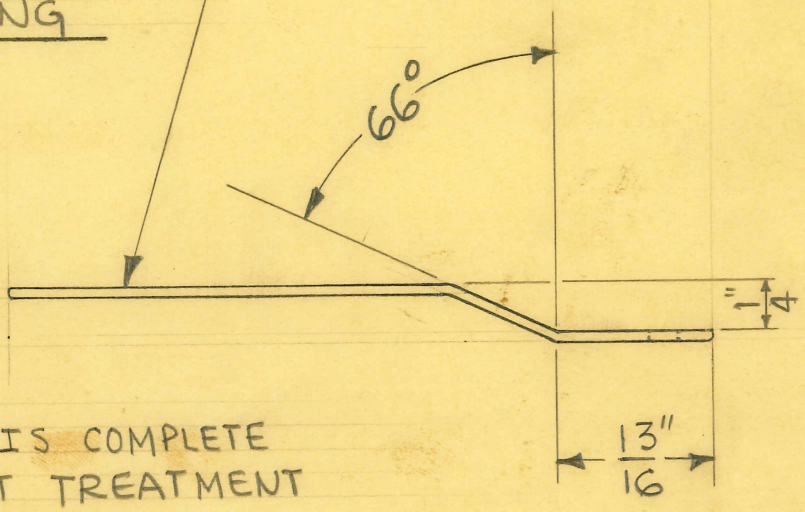

NOTE:

AFTER PIECE IS COMPLETE SEND OUT FOR HEAT TREATMENT 700°F. FOR 3 HOURS.

DRILL JIG TOOL #9819
FORMING FIXTURE TOOL #9645 (17045)

1 REQUIRED

FROM 17670 RS

DIMENSIONS	
FRACTIONAL	± .015
DECIMAL	± .005
ANGULAR	± 1/2°

UNLESS OTHERWISE SPECIFIED

SIZE		ISSUE 5-14-48	J.V.W.
KIND		CHANGED	
SHAPE		"	
FINISH		"	
TEMP.		"	
PATT.		"	

TITLE: FISCHER MOD. "10" DIATHERMY
MODEL "300" DIATHERMY
THERMAL COMPENSATOR-ACTIVE

H. G. FISCHER & CO.
2335 WABANSIA AVE.
CHICAGO, ILL.

CAT. NO.

PART NO. 17670F

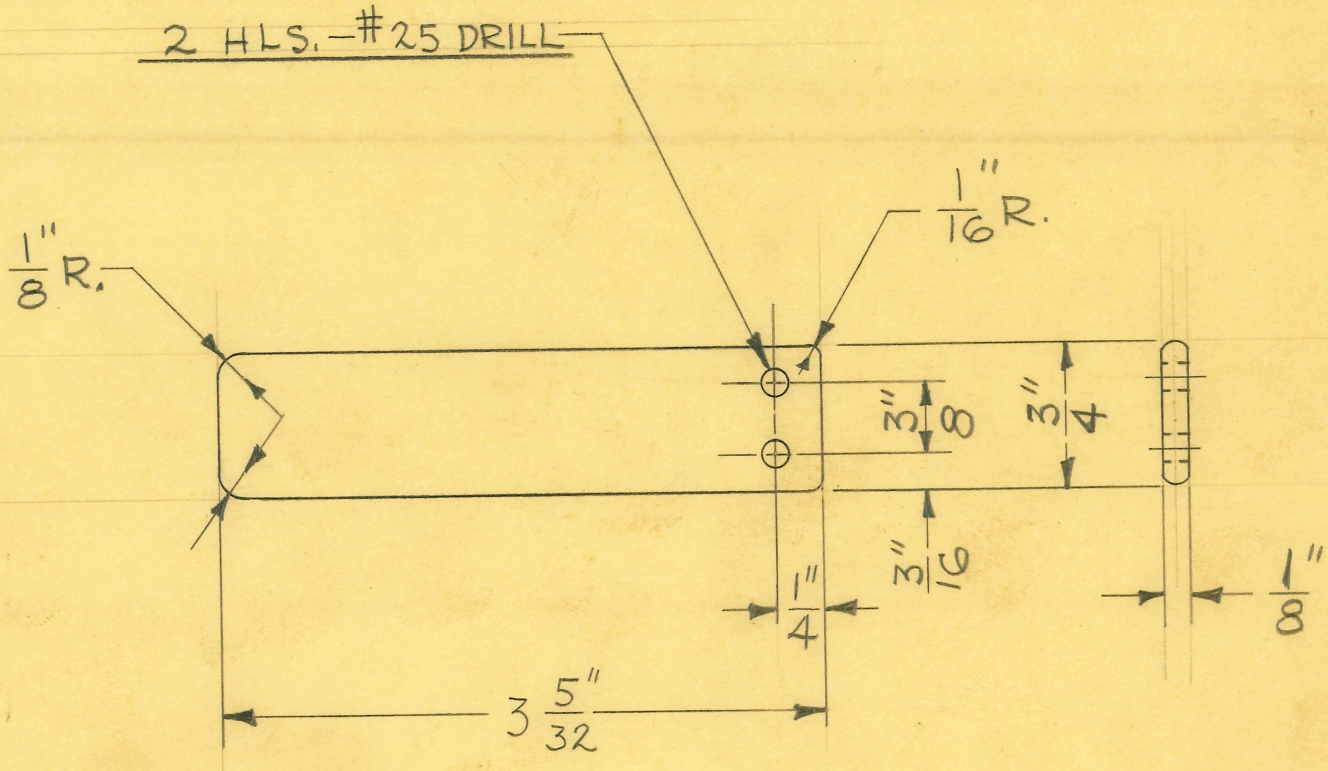

1 REQUIRED

DRILL JIG TOOL #9819

DIMENSIONS	
FRACTIONAL	± .015
DECIMAL	± .005
ANGULAR	± 1/2°

UNLESS OTHERWISE SPECIFIED

SIZE	1/8" X 3/4"	ISSUE 5-14-48	J.V.W.
KIND	FLAT WIRE	CHANGED	
SHAPE		"	
FINISH	CAD. #23	"	
TEMP.		"	
PATT.		"	

TITLE: FISCHER MOD. "10" DIATHERMY
MODEL "300" DIATHERMY
THERMAL COMPENSATOR - STATIONARY

H. G. FISCHER & CO.
2335 WABANSIA AVE.
CHICAGO, ILL.

CAT. NO.

PART NO. 17671

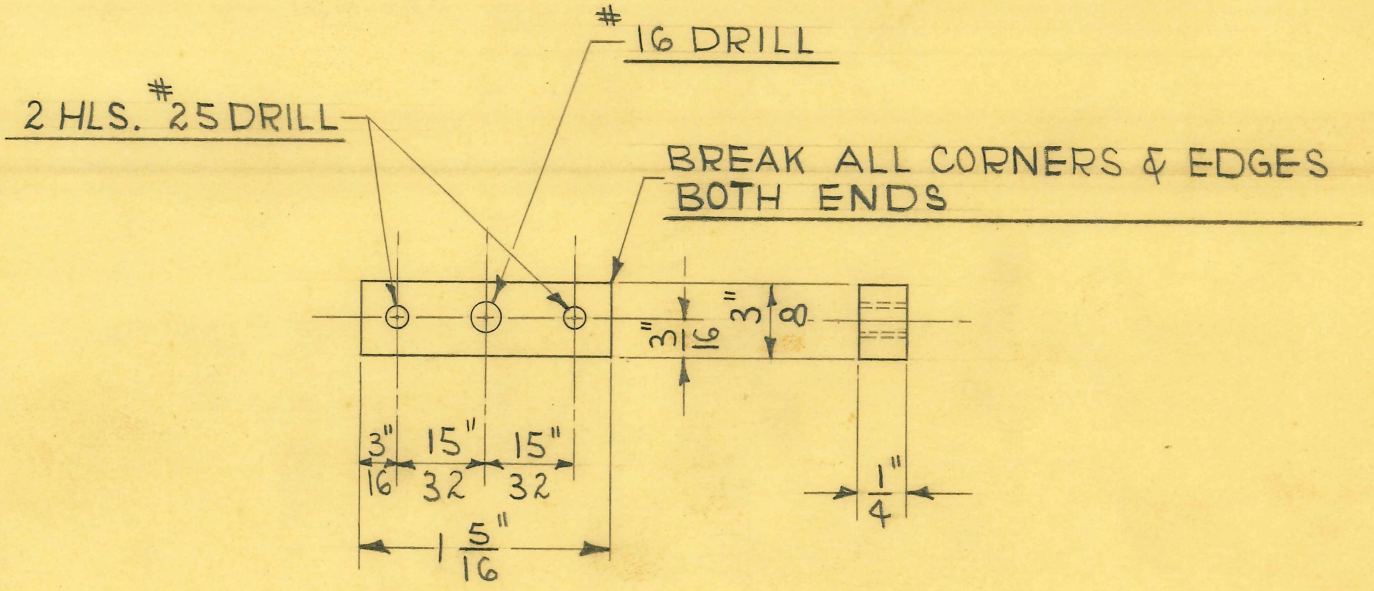

1 REQUIRED

DIMENSIONS	
FRACTIONAL	± .015
DECIMAL	± .005
ANGULAR	± 1/2°

UNLESS OTHERWISE SPECIFIED

SIZE	1/4" SHEET	ISSUE 5-14-48	W.J.
KIND	MYKROY	CHANGED	
SHAPE		"	
FINISH		"	
TEMP.		"	
PATT.		"	

TITLE: FISCHER MOD. "10" DIATHERMY MODEL "300" PORTABLE DIATHERMY PARALLEL COIL INSULATOR SUPP.

H. G. FISCHER & CO.
2335 WABANSIA AVE.
CHICAGO, ILL.

CAT. NO.

PART NO. 17672

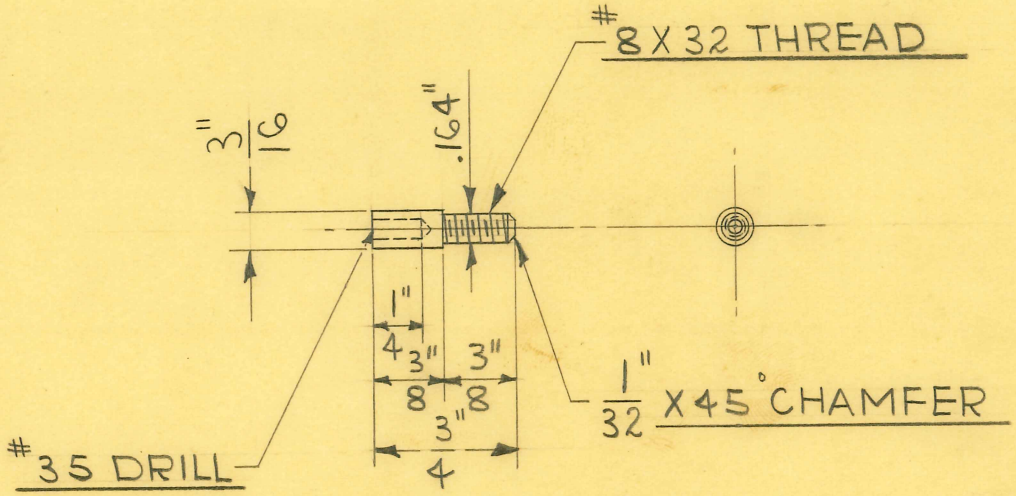

2 REQUIRED

DIMENSIONS	
FRACTIONAL	± .015
DECIMAL	± .005
ANGULAR	± 1/2°

UNLESS OTHERWISE SPECIFIED

SIZE	3/16" DIA.	ISSUE 5-14-48	W. J.
KIND	BRASS	CHANGED	
SHAPE	ROD	"	
FINISH		"	
TEMP.		"	
PATT.		"	

TITLE: FISCHER MOD. "10" DIATHERMY
MODEL "300" PORTABLE DIATHERMY
GRID COIL SUPPORT

H. G. FISCHER & CO.
2335 WABANSIA AVE.
CHICAGO, ILL.

CAT. NO.

PART NO. 17673

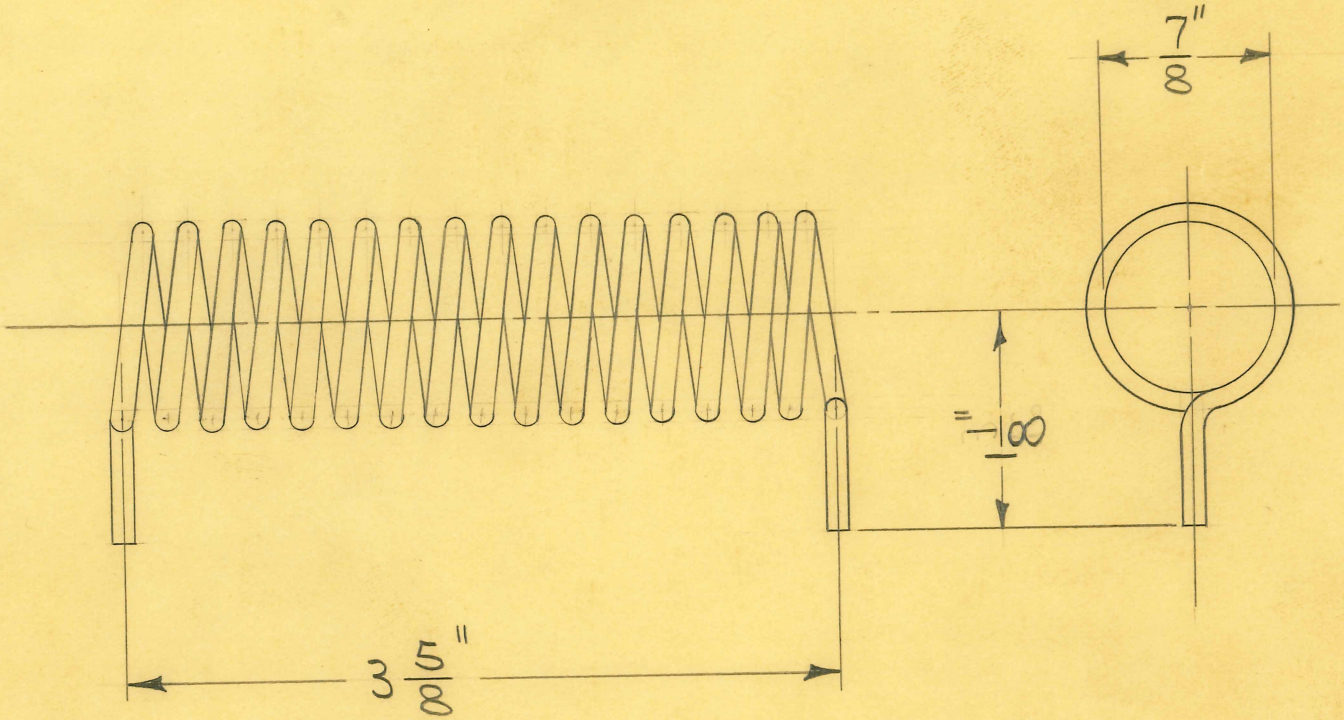

16 TURNS

1 REQUIRED

DIMENSIONS	
FRACTIONAL	± .015
DECIMAL	± .005
ANGULAR	± 1/2°

UNLESS OTHERWISE SPECIFIED

SIZE	#10 GA.	ISSUE 5-14-48	W.J.
KIND	TINNED	CHANGED	
SHAPE	COPPER WIRE	"	
FINISH		"	
TEMP.		"	
PATT.		"	

TITLE: FISCHER MOD. "10" DIATHERMY
MODEL "300" PORTABLE DIATHERMY
GRID COIL

H. G. FISCHER & CO.
2335 WABANSIA AVE.
CHICAGO, ILL.

CAT. NO.

PART NO. 17674

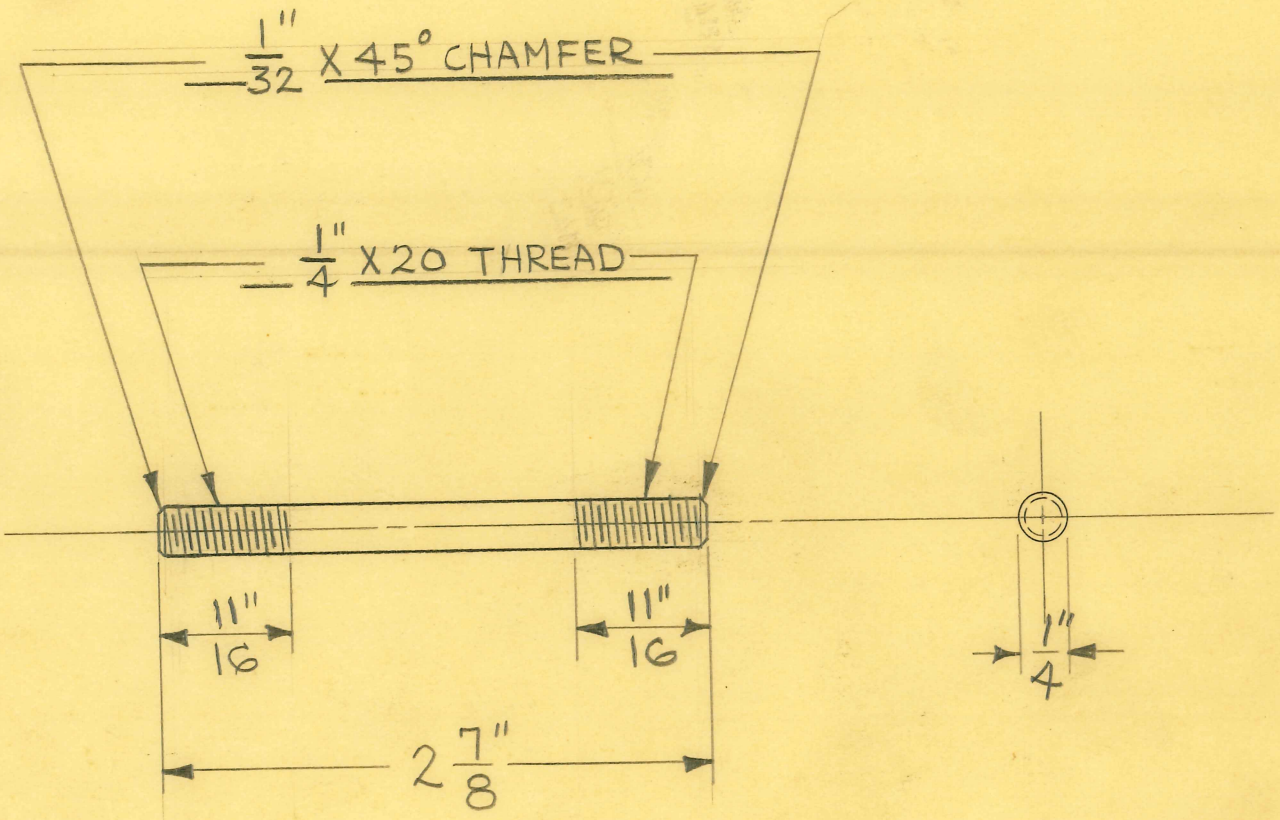

4 REQUIRED

DIMENSIONS	
FRACTIONAL	± .015
DECIMAL	± .005
ANGULAR	± 1/2°

UNLESS OTHERWISE SPECIFIED

SIZE	1/4" DIA.	ISSUE 5-15-48	J.N.W.
KIND	SCREW STOCK	CHANGED	
~~SHAPE~~	C.R.STEEL	"	
FINISH		"	
TEMP.		"	
PATT.		"	

B

TITLE: FISCHER MOD."10" DIATHERMY
MOD."300" DIATHERMY
TRANSF. STUD

H. G. FISCHER & CO.
2335 WABANSIA AVE.
CHICAGO, ILL.

CAT. NO.

PART NO. 17679

#6X32 TAP

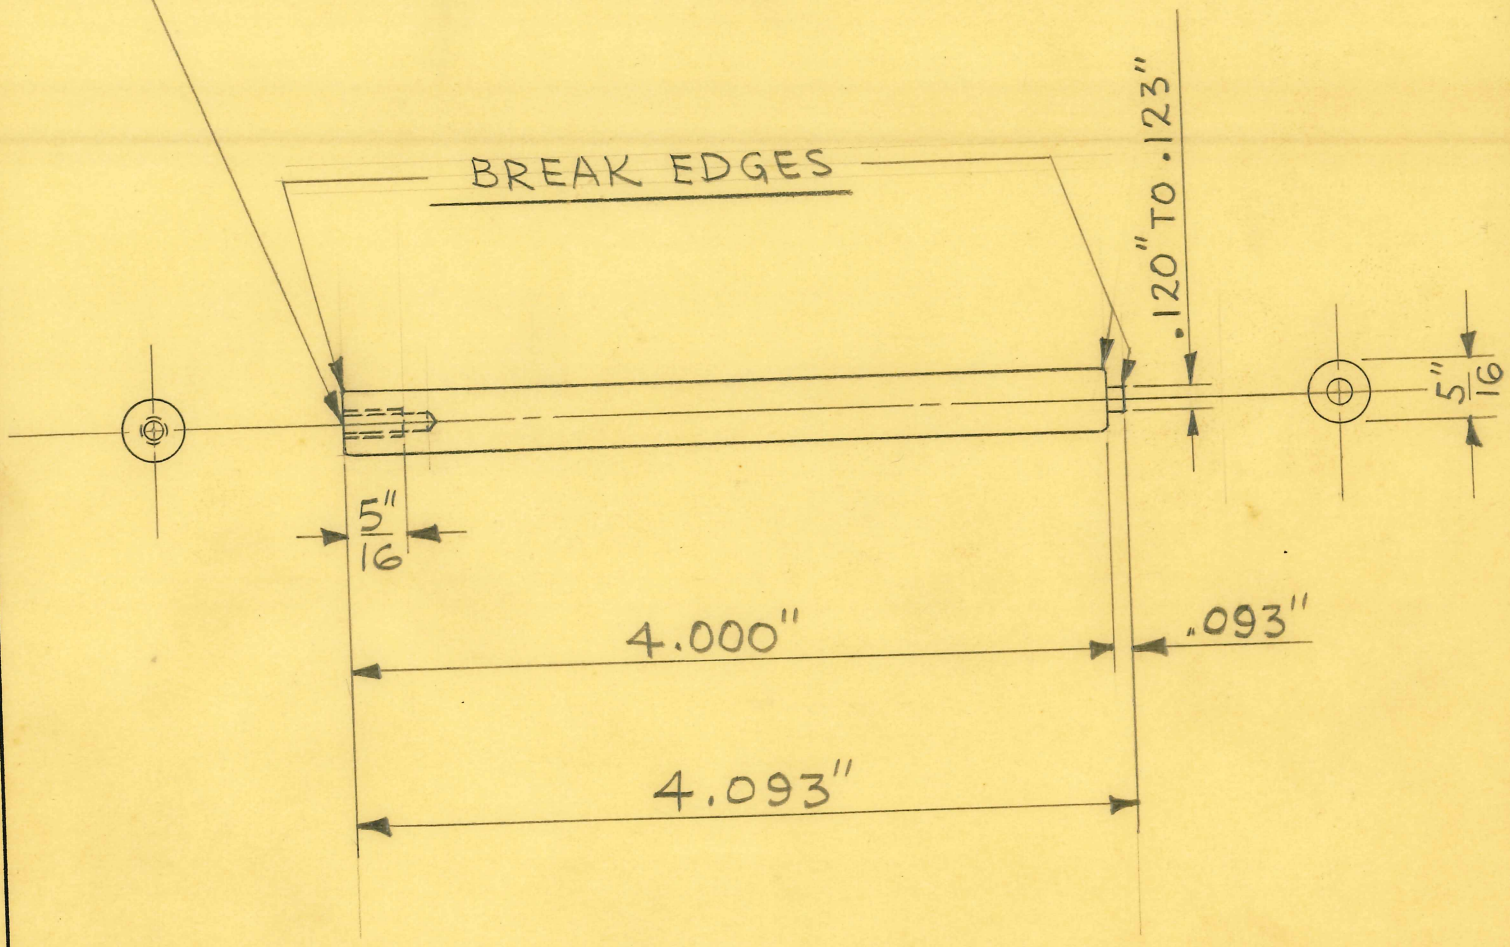

1 REQUIRED

DIMENSIONS	
FRACTIONAL	± .015
DECIMAL	± .005
ANGULAR	± 1/2°

UNLESS OTHERWISE SPECIFIED

5/16" DIA. NATURAL BAKELITE ROD

		ISSUE 5-15-48	J.V.W.
SIZE		CHANGED	
KIND		"	
SHAPE		"	
FINISH		"	
TEMP.		"	
PATT.		"	

TITLE: FISCHER "MOD. "10" DIATHERMY
MODEL "300" DIATHERMY
RESISTOR SUPP. ROD -LONG

H. G. FISCHER & CO.
2335 WABANSIA AVE.
CHICAGO, ILL.

CAT. NO.

PART NO. 17680

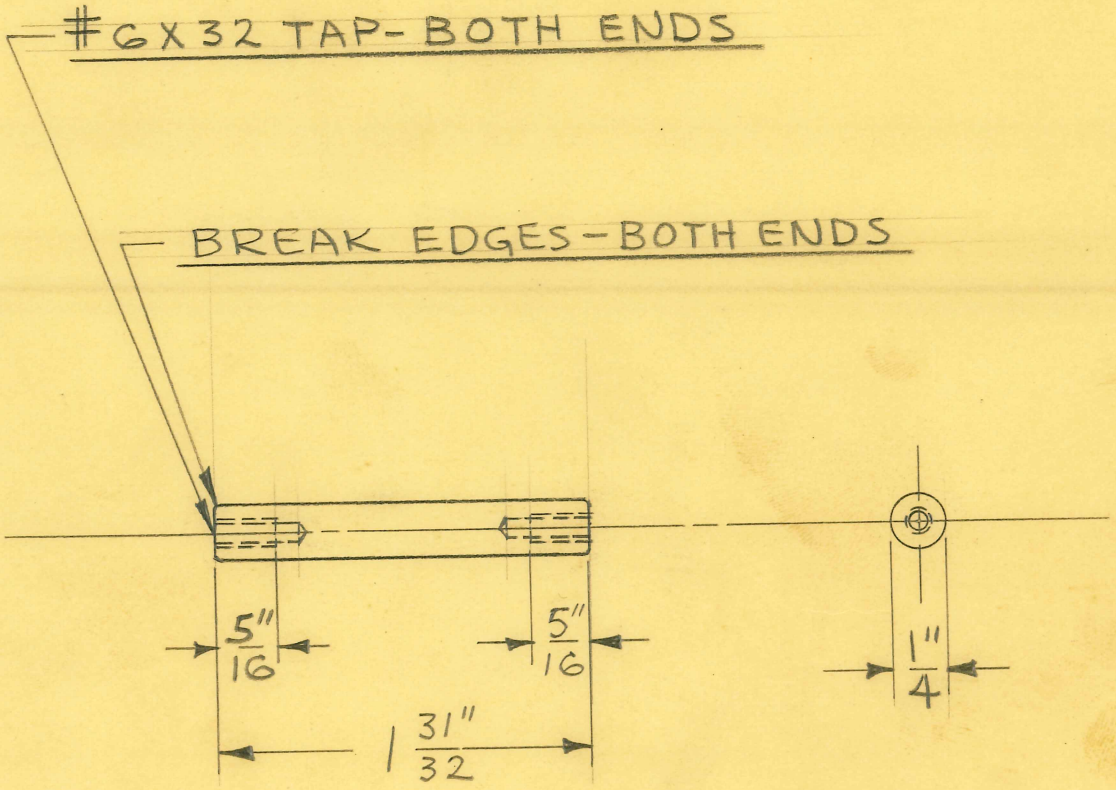

2 REQUIRED

1/4" DIA. DELRIN ROD ~~NATURAL BAKELITE ROD~~ J.V.W. 5-8-68

DIMENSIONS	
FRACTIONAL	± .015
DECIMAL	± .005
ANGULAR	± 1/2°

UNLESS OTHERWISE SPECIFIED

SIZE		ISSUE 5-15-48	J.V.W.
KIND		CHANGED	
SHAPE		"	
FINISH		"	
TEMP.		"	
PATT.		"	

TITLE: FISCHER MOD. "10" DIATHERMY
MODEL 300 DIATHERMY
RESISTOR SUPP. ROD - SHORT

H. G. FISCHER & CO.
2335 WABANSIA AVE.
CHICAGO, ILL.

CAT. NO.

PART NO. 17681

#6X32 TAP- BOTH ENDS

BREAK EDGES- BOTH ENDS

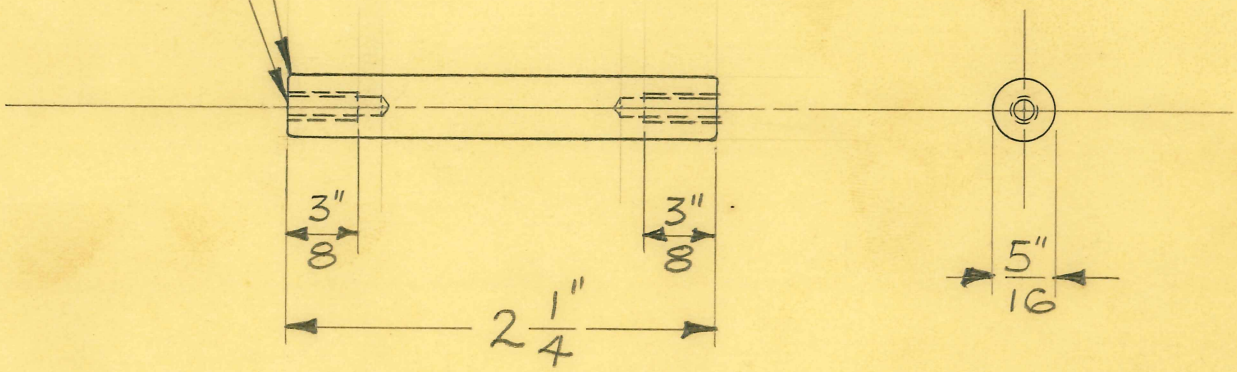

1 REQUIRED

DIMENSIONS	
FRACTIONAL	± .015
DECIMAL	± .005
ANGULAR	± 1/2°

UNLESS OTHERWISE SPECIFIED

RS

SIZE	5/16" DIA.	ISSUE 5-15-48	J.V.W.
KIND	BRASS ROD	CHANGED	
SHAPE		"	
FINISH		"	
TEMP.		"	
PATT.		"	

TITLE: FISCHER MOD. "10" DIATHERMY
MOD. "300" DIATHERMY
LINK CIRCUIT COIL SPACER

H. G. FISCHER & CO.
2335 WABANSIA AVE.
CHICAGO, ILL.

CAT. NO.

PART NO. 17682

TITLE
MOD "300" DIATHERMY UNIT TUBE SOCKET CABINET HANDLE

H. G. FISCHER & CO.
FRANKLIN PARK, ILLINOIS

PART NO. 17686 A

PATTERN	FINISH	SCALE
		#

MATERIAL: #

TOOLS:

DATE 9-12-68 | DR. BY AD | CH'K'D. T.K.

DIMENSIONS—UNLESS OTHERWISE SPECIFIED:

FRACTIONAL	± .015	THREAD CHAMFER
DECIMAL	± .005	UP TO 5/16 D.-1/32 X 45°
ANGULAR	± 1/2°	3/8 D. & OVER - 1/16 X 45°

REMOVE ALL BURRS & SHARP CORNERS

USED ON	QTY.	USED ON	QTY.

REVISION	DATE	BY

PURCHASE:

#2200-B HANDLE ASS'Y. PASTEL GRAY
#4277 NICKEL PLATED STEEL HARDWARE
BLACK LEATHER WITH ST'L FLAT WIRE
INSERT - EYELETS & FASTENERS .15¢ EACH

ACCEPTABLE SOURCE:
PHILADELPHIA BRIEF CASE CO.
333 N. MICHIGAN AV. CHICAGO, ILL.

DO NOT SCALE DRAWING.

TITLE
MOD. 10A DIATHERMY
CABINET RETAINING WASHER

H. G. FISCHER & CO.
FRANKLIN PARK, ILLINOIS

DATE 3-2-53 | DR. BY W.J. | CH'K'D. J.V.W.

PART NO. 17692 1/2

REVISION	DATE	BY

PATTERN | FINISH CAD# 23 | SCALE FULL

TOOLS MASTER DIE BLOCK #9938
DIE INSERT & PUNCH #11521

MATERIAL 1/16" SHEET C.R. STEEL

DIMENSIONS
FRACTIONAL ± .015
DECIMAL ± .005
ANGULAR ± ½°
UNLESS OTHERWISE SPECIFIED

MASTER DIE BLOCK #4608
NEST FOR MASTER DIE BLOCK PCE. # 17692 1/2

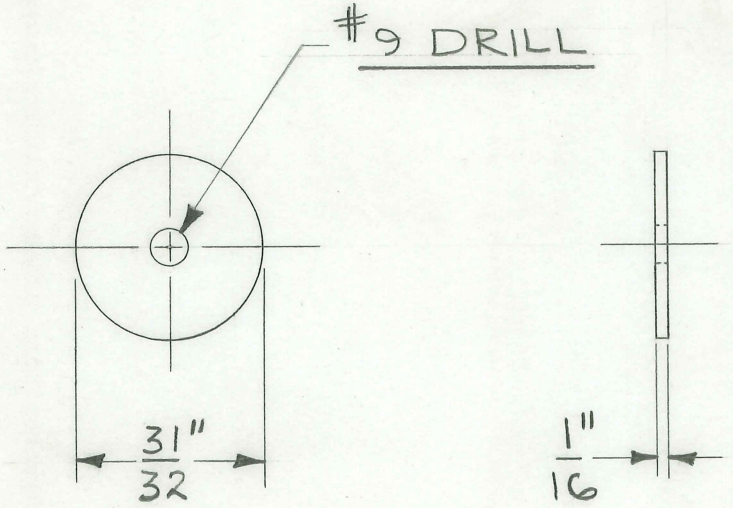

4 REQUIRED

FOLDER #132

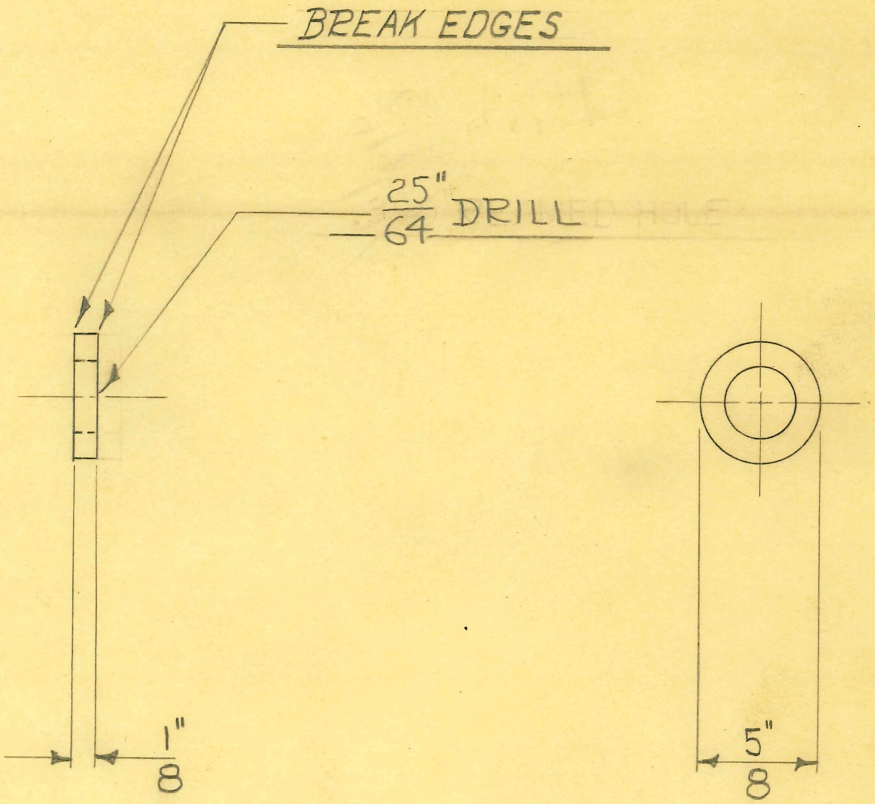

1-REQUIRED

DIMENSIONS	
FRACTIONAL	± .015
DECIMAL	± .005
ANGULAR	± 1/2°

UNLESS OTHERWISE SPECIFIED

SIZE	5/8" DIAM.	ISSUE 1-5-48	J.M.F
KIND	BRASS	CHANGED	
SHAPE	ROD.	"	
FINISH	CAD# 23	"	
TEMP.		"	
PATT.		"	

TITLE:
FISCHER MODEL "200" PORTABLE DIATHERMY
CONTROL KNOB SHAFT BUSHING-SPACER

H. G. FISCHER & CO.
2335 WABANSIA AVE.
CHICAGO, ILL.

CAT. NO.

PART NO. 17030

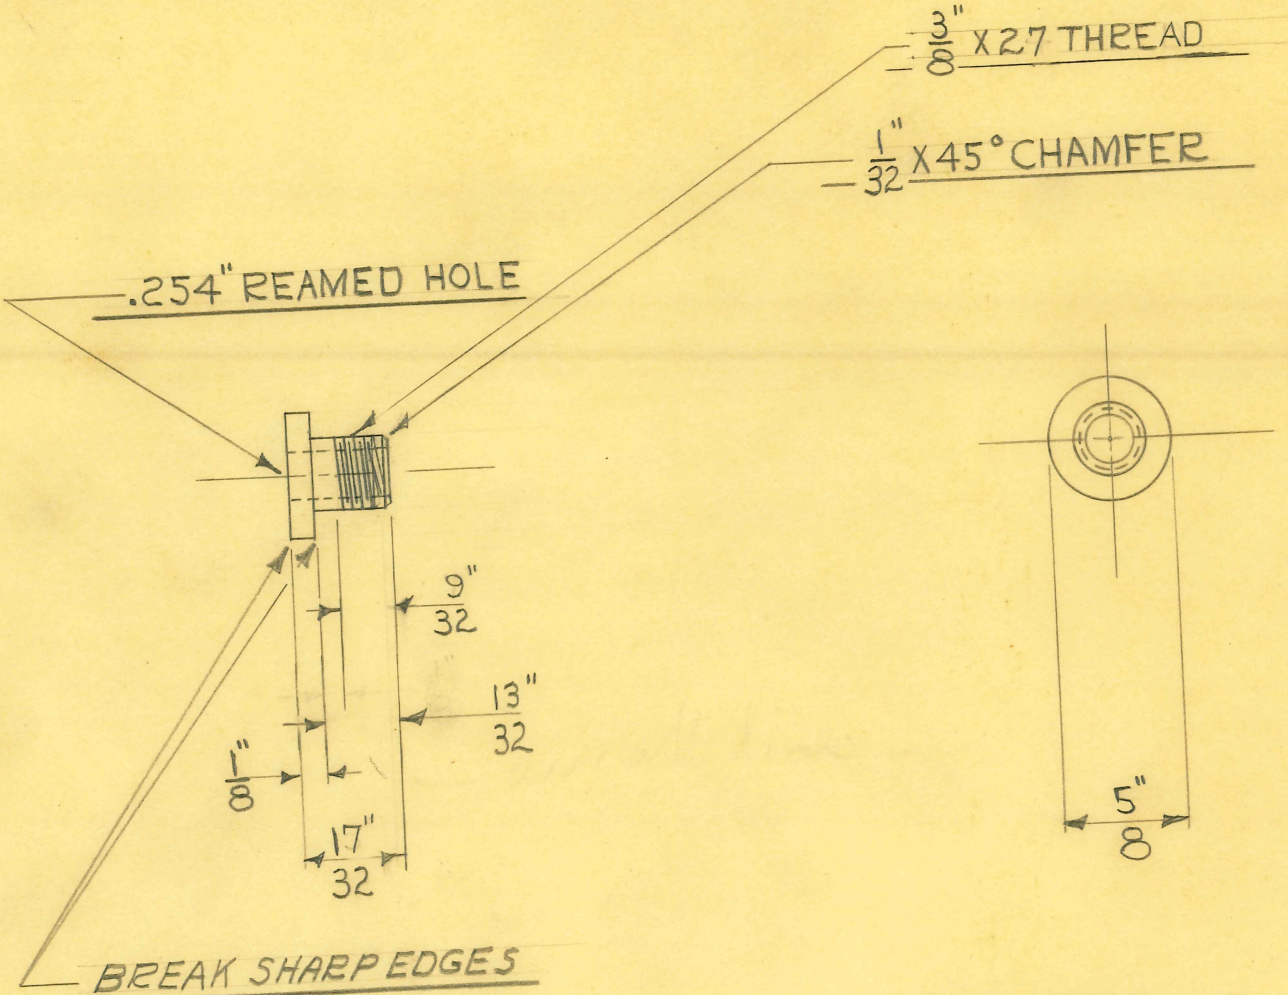

1-REQUIRED

DIMENSIONS	
FRACTIONAL	± .015
DECIMAL	± .005
ANGULAR	± 1/2°

UNLESS OTHERWISE SPECIFIED

SIZE	5/8" DIAM.	ISSUE 1-5-48	J.M.F
KIND	BRASS	CHANGED	
SHAPE	ROD	"	
FINISH	CAD #23	"	
TEMP.		"	
PATT.		"	

TITLE: FISCHER MODEL "200" PORTABLE DIATHERMY CONTROL KNOB SHAFT BUSHING

H. G. FISCHER & CO.
2338 WABANSIA AVE.
CHICAGO, ILL.

CAT. NO.

PART NO. 17031

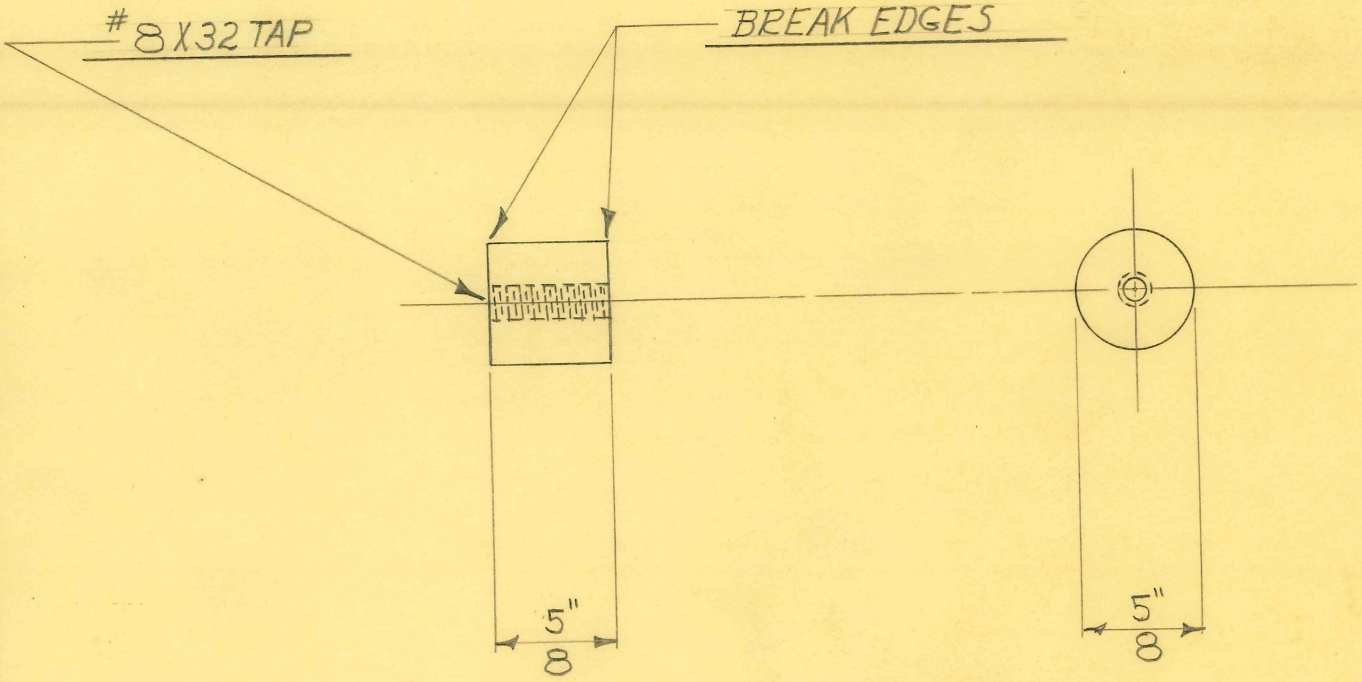

8 - REQUIRED

DIMENSIONS	
FRACTIONAL	± .015
DECIMAL	± .005
ANGULAR	± 1/2°

UNLESS OTHERWISE SPECIFIED

SIZE	5/8" DIAM.	ISSUE 1-6-48	J.M.F
KIND	ALUMINUM	CHANGED	
SHAPE	ROD	"	
FINISH	CAD #23	"	
TEMP.		"	
PATT.		"	

TITLE: FISCHER MODEL "200" PORTABLE DIATHERMY INDUCTION CABLE FACE PLATE SPACER

H. G. FISCHER & CO.
2335 WABANSIA AVE.
CHICAGO, ILL.

CAT. NO.

PART NO. 17032

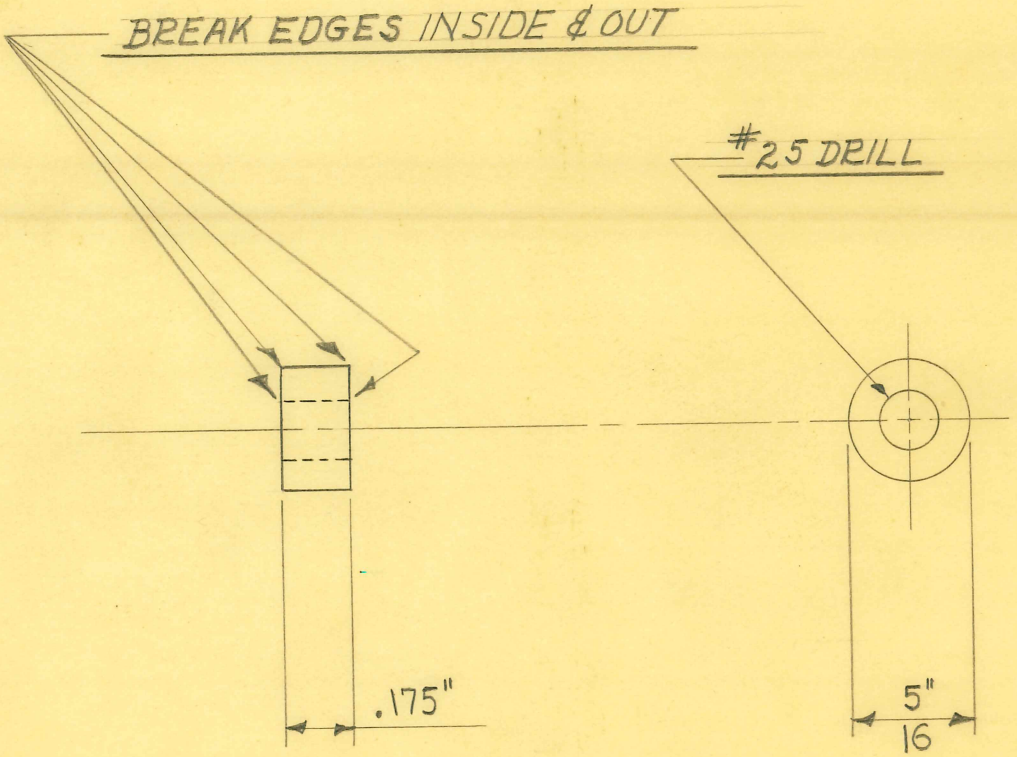

SCALE ≈ DOUBLE SIZE

10 - REQUIRED

DIMENSIONS	
FRACTIONAL	± .015
DECIMAL	± .005
ANGULAR	± 1/2°

UNLESS OTHERWISE SPECIFIED

SIZE	5/16" DIAM.	ISSUE 1-3-48	J.M.F
KIND	BRASS	CHANGED	
SHAPE	ROD	"	
FINISH	CAD #23	"	
TEMP.		"	
PATT.		"	

TITLE:
FISCHER MODEL "200" PORTABLE DIATHERMY
GRID CONDENSER SPACER - MED.

H. G. FISCHER & CO.
2335 WABANSIA AVE.
CHICAGO, ILL.

CAT. NO.

PART NO. 17033

BREAK EDGES INSIDE & OUT

#25 DRILL

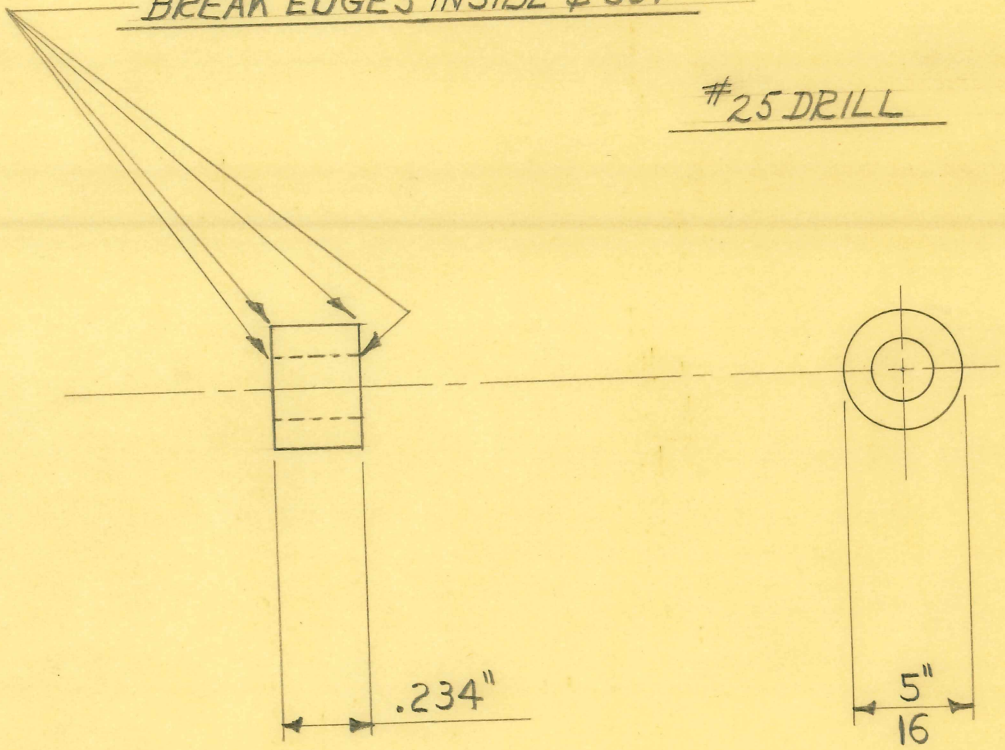

SCALE ≈ DOUBLE SIZE

4 - REQUIRED

DIMENSIONS	
FRACTIONAL	± .015
DECIMAL	± .005
ANGULAR	± 1/2°

UNLESS OTHERWISE SPECIFIED

SIZE	5/16" DIAM.	ISSUE 1-3-48	J.M.F
KIND	BRASS	CHANGED	
SHAPE	ROD	"	
FINISH	CAD #23	"	
TEMP.		"	
PATT.		"	

TITLE: FISCHER MODEL "200" PORTABLE DIATHERMY GRID CONDENSER SPACER - LONG

H. G. FISCHER & CO.
2338 WABANSIA AVE.
CHICAGO, ILL.

CAT. NO.

PART NO. 17034

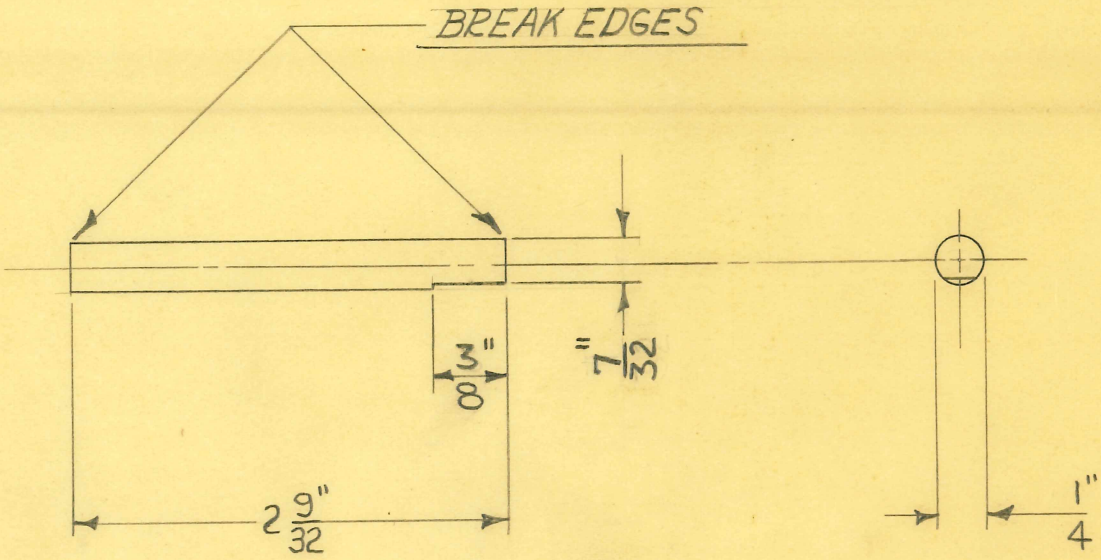

1-REQUIRED

DIMENSIONS	
FRACTIONAL	± .015
DECIMAL	± .005
ANGULAR	± 1/2°

UNLESS OTHERWISE SPECIFIED

SIZE	1/4" DIAM.	ISSUE 1-5-48	J.M.F
KIND	C.R. STEEL	CHANGED	
SHAPE	ROD	" 1-26-49	
FINISH	CAD #23	"	
TEMP.		"	
PATT.		"	

TITLE: FISCHER MODEL "200" PORTABLE DIATHERMY CONTROL KNOB SHAFT

H. G. FISCHER & CO.
2335 WABANSIA AVE.
CHICAGO, ILL.

CAT. NO.

PART NO. 17035 A

TITLE

FISCHER MODEL "200" PORT. DIA. TRANSFER COIL

H. G. FISCHER & CO.
FRANKLIN PARK, ILLINOIS

PART NO. 17036A

DATE 5-15-51 | DR. BY W.J. | CH'K'D. J.V.W.

REVISION	DATE	BY

PATTERN | FINISH | SCALE FULL

TOOLS: NO. 5 JR. PUNCH

MATERIAL: .072" X 5/16" COPPER FLAT WIRE

DIMENSIONS UNLESS OTHERWISE SPECIFIED
FRACTIONAL ± .015
DECIMAL ± .005
ANGULAR ± ½°

WHEN USING 1/16" X 1/4" STOCK
DEV. LENGTH = 20 3/8" FOR 2 7/8 TURNS USING #3500 TERMINALS

1 REQUIRED

DEVELOPED LENGTH =

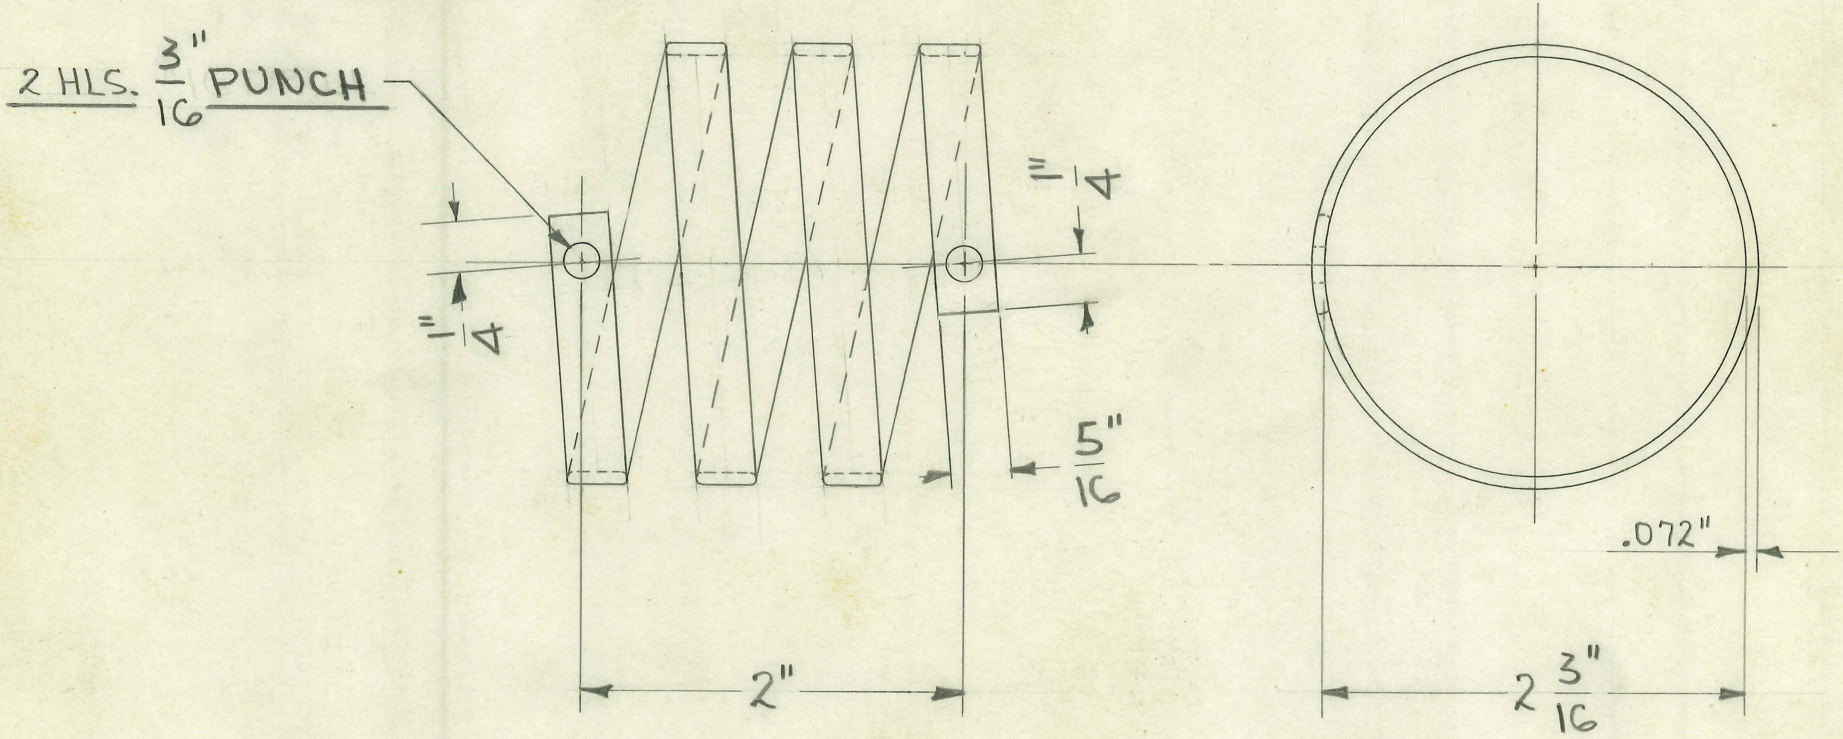

3 TURNS

FOLDER #129

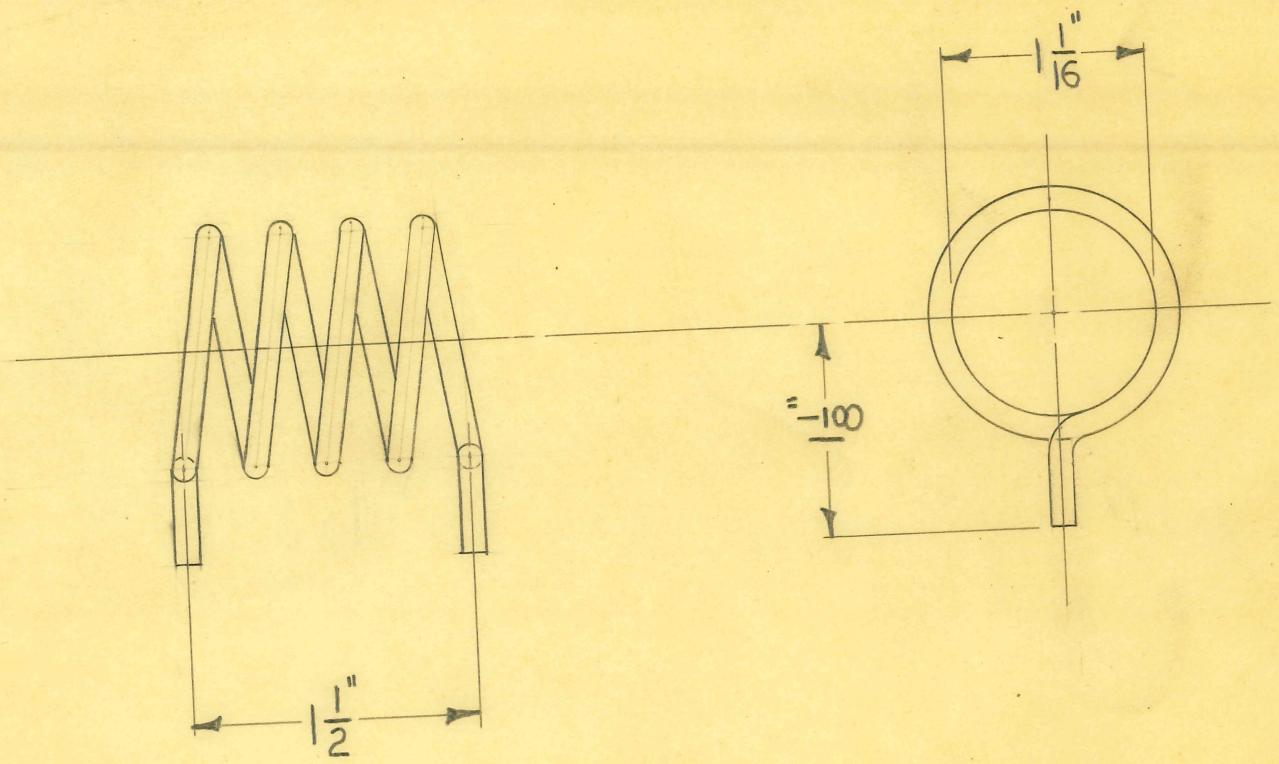

4 TURNS
1-REQUIRED

DIMENSIONS	
FRACTIONAL	± .015
DECIMAL	± .005
ANGULAR	± 1/2°

UNLESS OTHERWISE SPECIFIED

SIZE	#8 BARE	ISSUE 1-2-48	J.M.F
KIND	COPPER WIRE	CHANGED	
SHAPE		"	
FINISH		"	
TEMP.		"	
PATT.		"	

TITLE: FISCHER MODEL "200" PORTABLE DIATHERMY GRID COIL

H. G. FISCHER & CO.
2335 WABANSIA AVE.
CHICAGO, ILL.

CAT. NO.

PART NO. 17037

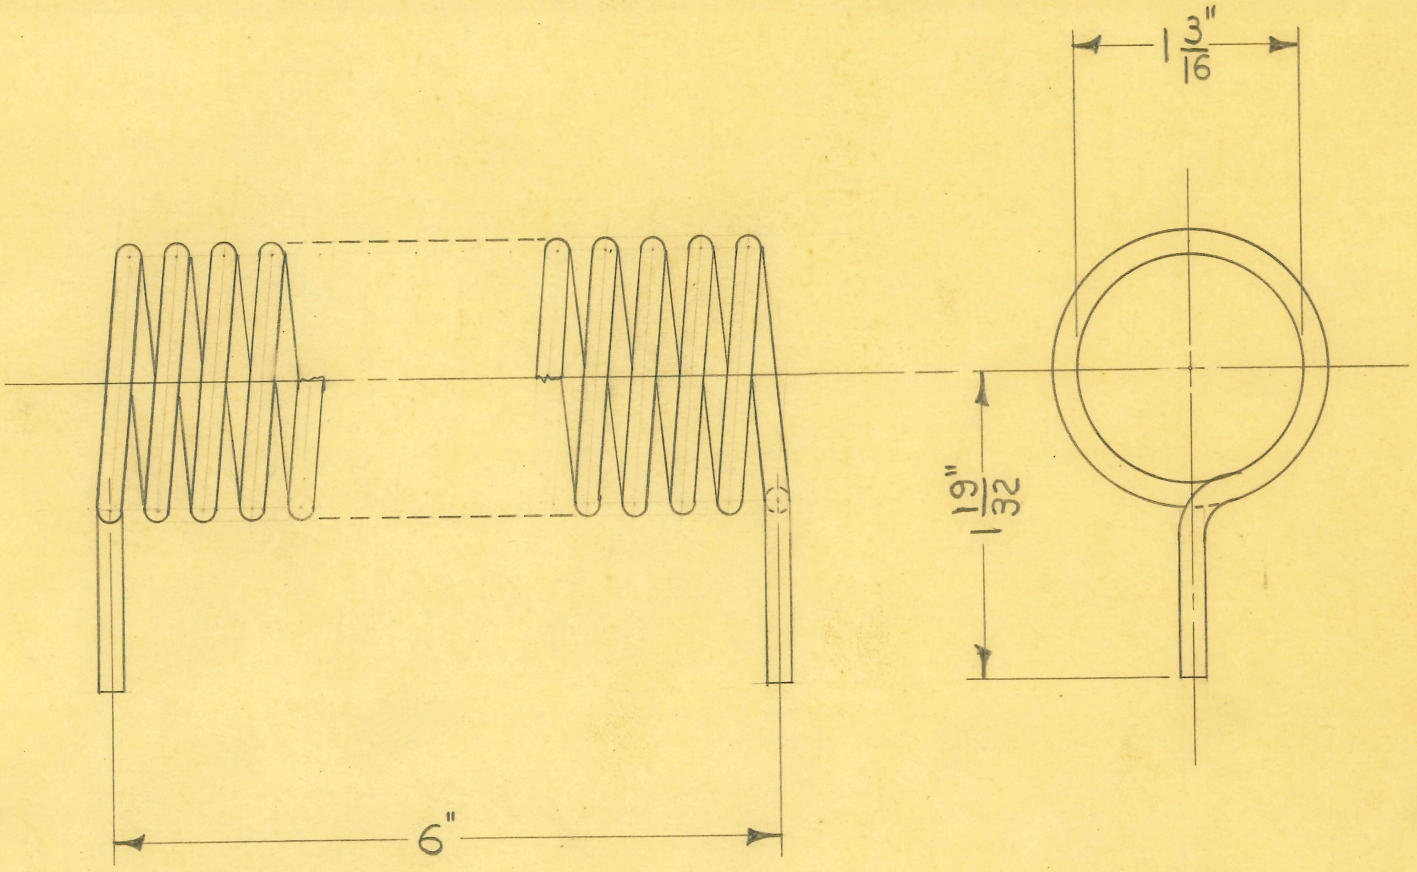

1-REQUIRED

27 TURNS

DEVELOPMENT-LENGTH 115"

DIMENSIONS	
FRACTIONAL	± .015
DECIMAL	± .005
ANGULAR	± 1/2°

UNLESS OTHERWISE SPECIFIED

SIZE	#8 BARE	ISSUE 1-2-48	J.M.F
KIND	COPPER WIRE	CHANGED	
SHAPE		"	
FINISH		"	
TEMP.		"	
PATT.		"	

TITLE: FISCHER MODEL "200" PORTABLE DIATHERMY PARALLEL TUNING COIL

H. G. FISCHER & CO.
2335 WABANSIA AVE.
CHICAGO, ILL.

CAT. NO.

PART NO. 17038

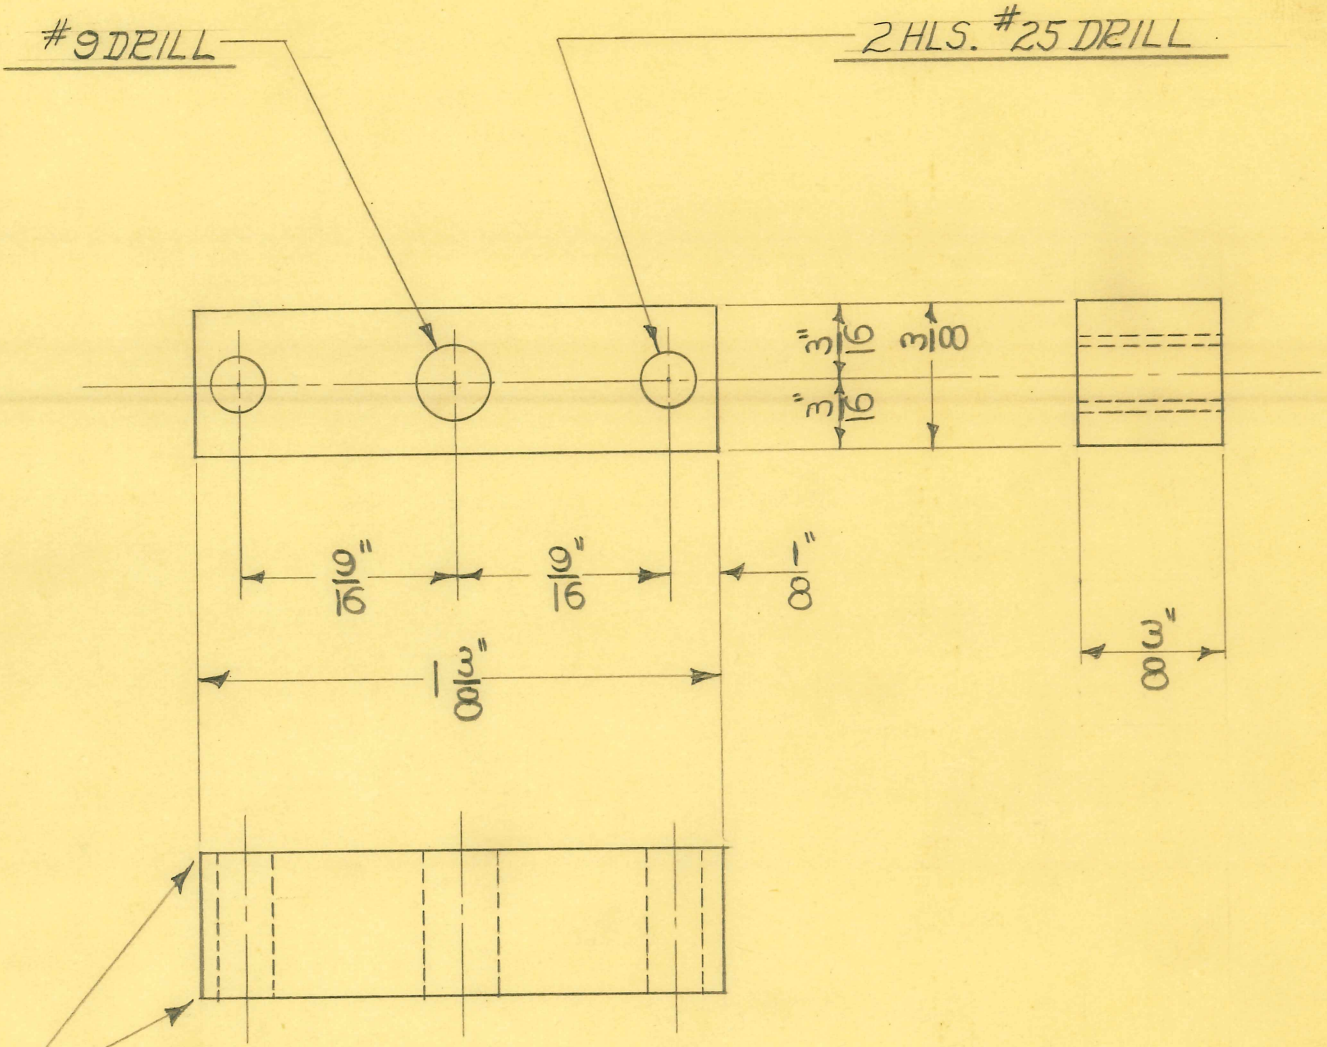

SCALE ~ DOUBLE SIZE

2 - REQUIRED

DRILL JIG TOOL #9640

DIMENSIONS	
FRACTIONAL	± .015
DECIMAL	± .005
ANGULAR	± 1/2°

UNLESS OTHERWISE SPECIFIED

SIZE	3/8 SQUARE	ISSUE 1-5-48	J.M.F
KIND	BRASS	CHANGED	
SHAPE		"	
FINISH	CAD #23	"	
TEMP.		"	
PATT.		"	

TITLE: FISCHER MODEL "200" PORTABLE DIATHERMY GRID CONDENSER - SUPPORT

H. G. FISCHER & CO.
2335 WABANSIA AVE.
CHICAGO, ILL.

CAT. NO.

PART NO. 17039

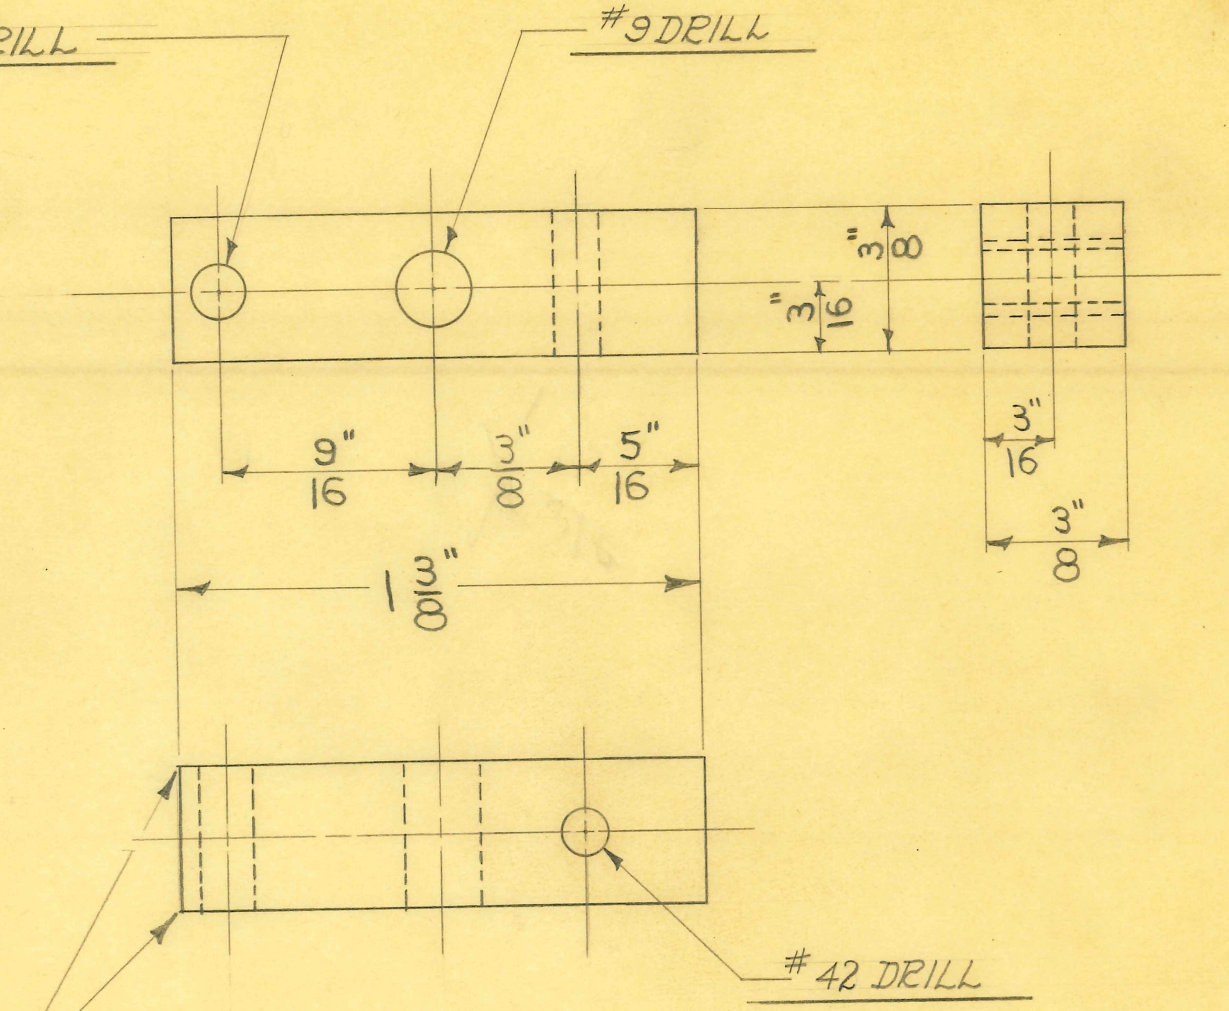

BREAK ALL CORNERS & EDGES

SCALE ÷ DOUBLE SIZE

2-REQUIRED

DRILL JIG TOOL #9641

DIMENSIONS	
FRACTIONAL	± .015
DECIMAL	± .005
ANGULAR	± 1/2°

UNLESS OTHERWISE SPECIFIED

SIZE	3/8" SQUARE	ISSUE 1-5-48	J.M.F	
KIND	BRASS	CHANGED		
SHAPE		"		
FINISH	CAD #23	"		
TEMP.		"		
PATT.		"		

TITLE: FISCHER MODEL "200" PORTABLE DIATHERMY PARRALLEL TUNING COIL - SUPPORT

H. G. FISCHER & CO.
2335 WABANSIA AVE.
CHICAGO, ILL.

CAT. NO.

PART NO. 17040

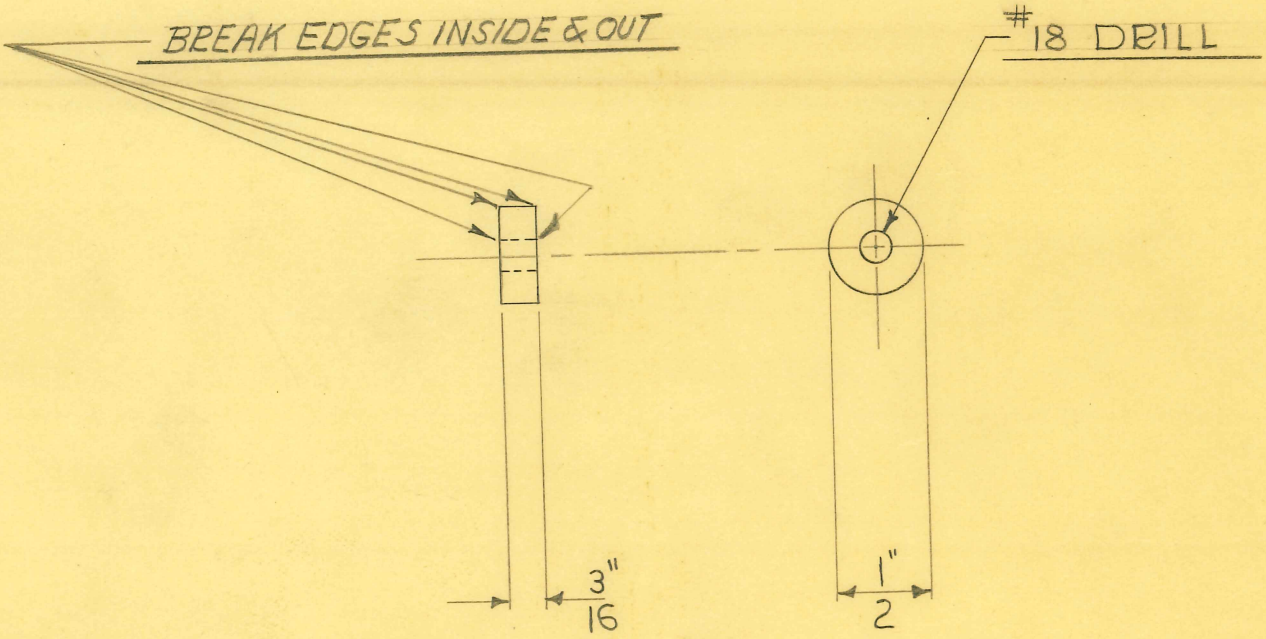

4-REQUIRED

DIMENSIONS	
FRACTIONAL	± .015
DECIMAL	± .005
ANGULAR	± 1/2°

UNLESS OTHERWISE SPECIFIED

SIZE	1/2" DIAM.	ISSUE 1-6-48	J.M.F
KIND	BRASS	CHANGED	
SHAPE	ROD	"	
FINISH	CAD#23	"	
TEMP.		"	
PATT.		"	

TITLE: FISCHER MODEL "200" PORTABLE DIATHERMY TUNING CONDENSER SPACER

H. G. FISCHER & CO.
2338 WABANSIA AVE.
CHICAGO, ILL.

CAT. NO.

PART NO. 17041

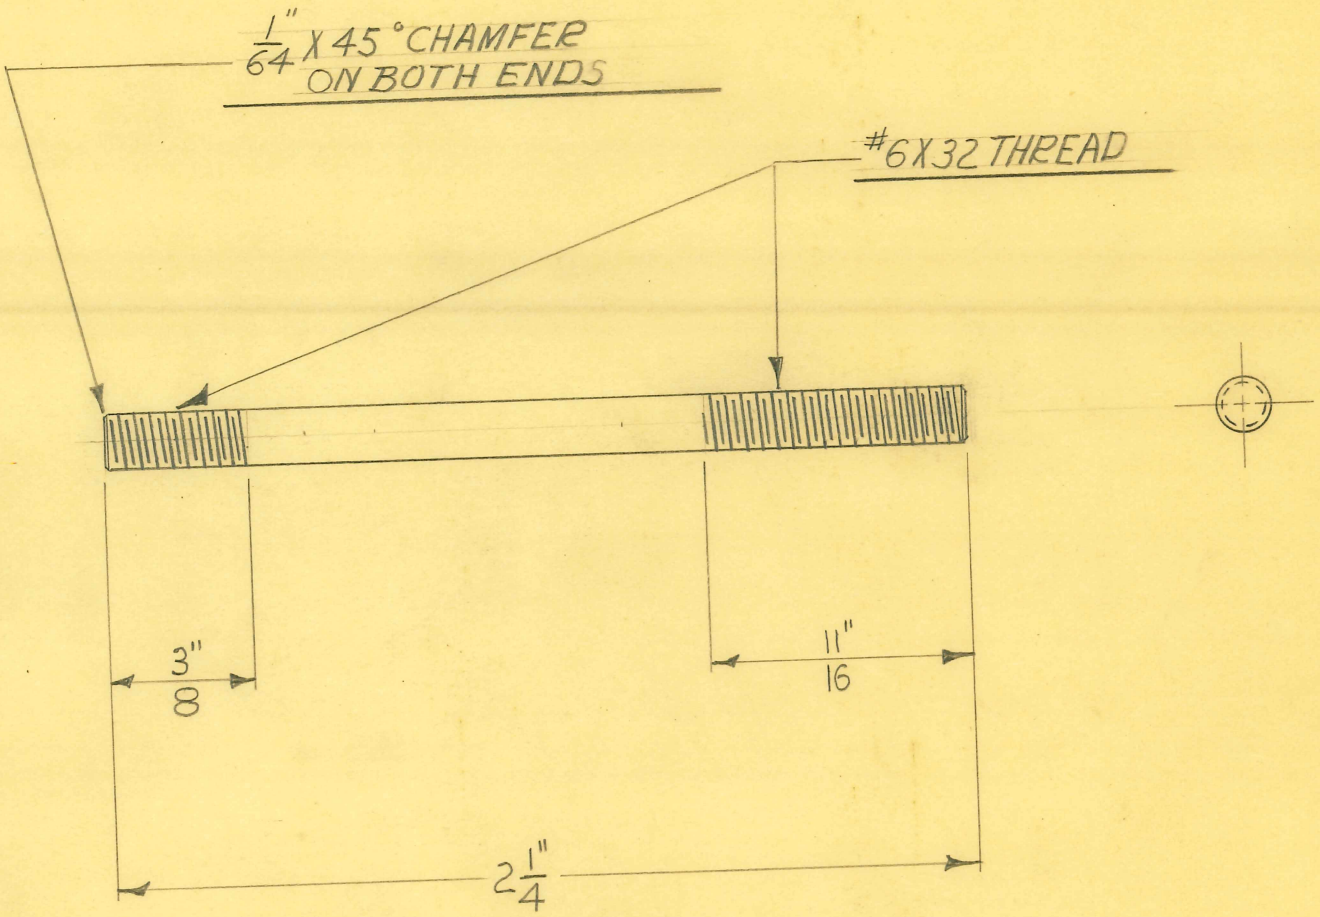

SCALE ÷ DOUBE SIZE

2-REQUIRED

DIMENSIONS	
FRACTIONAL	± .015
DECIMAL	± .005
ANGULAR	± 1/2°

UNLESS OTHERWISE SPECIFIED

SIZE	9/64 DIAM.	ISSUE 1-6-48	J.M.F
KIND	BRASS	CHANGED	
SHAPE	ROD	"	
FINISH	CAD # 23	"	
TEMP.		"	
PATT.		"	

TITLE: FISCHER MODEL "200" PORTABLE DIATHERMY GRID CONDENSER STUD

H. G. FISCHER & CO.
2335 WABANSIA AVE.
CHICAGO, ILL.

CAT. NO.

PART NO. 17042

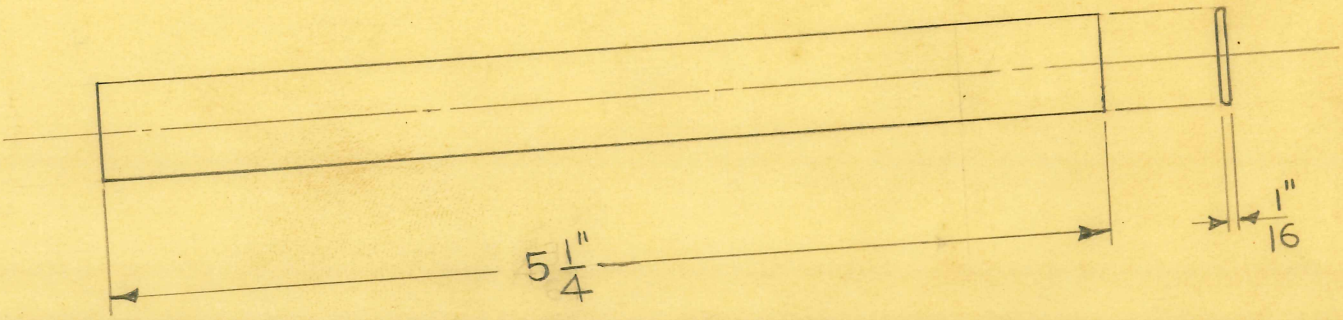

DEVELOPED LENGTH

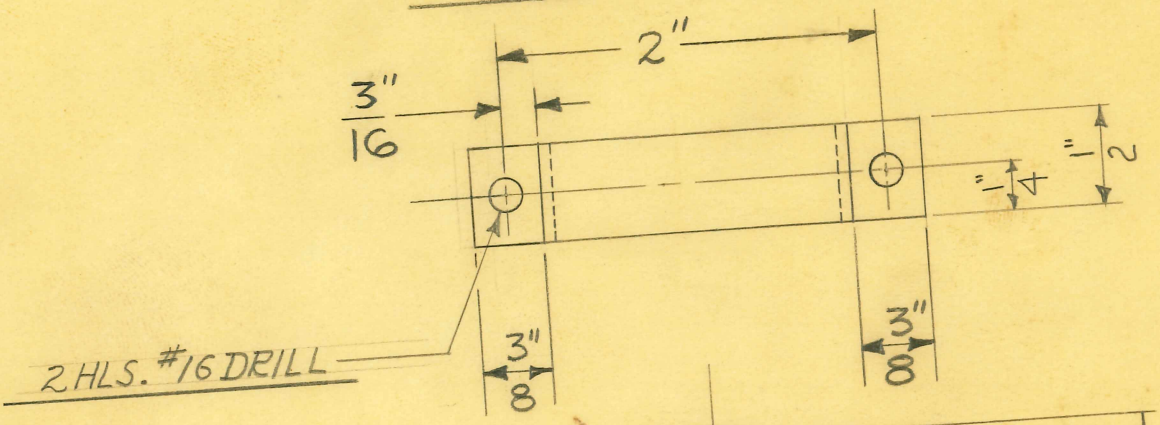

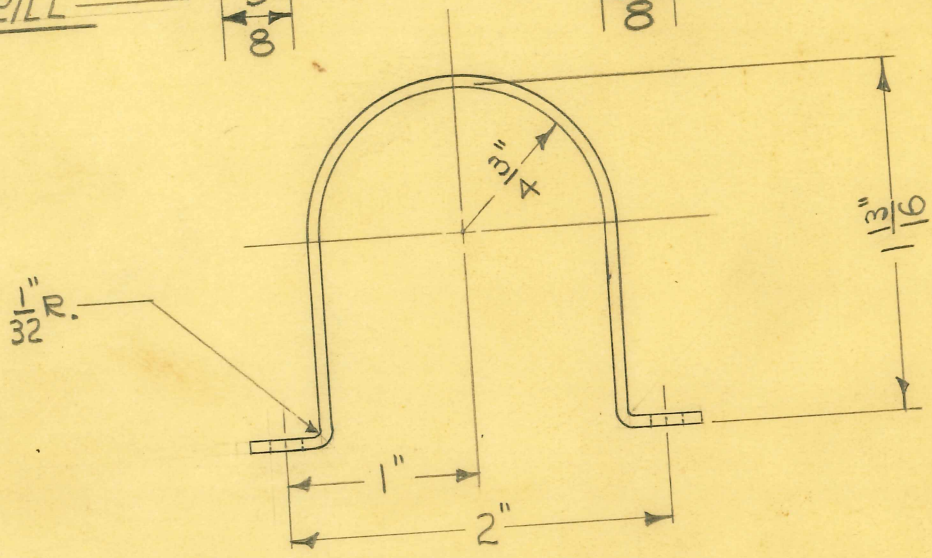

2-REQUIRED

FORMING FIXTURE TOOL # 9643
DRILL JIG TOOL # 9642

DIMENSIONS	
FRACTIONAL	± .01
DECIMAL	± .00
ANGULAR	± 1/2
UNLESS OTHERWISE SPECI	

SIZE	1/16" X 1/2"	ISSUE 1-6-48	J.M.F
KIND	FLAT WIRE	CHANGED	
SHAPE		"	
FINISH	CAD. #23	"	
TEMP.		"	
PATT.		"	

TITLE: FISCHER MODEL "200" PORTABLE DIATHERM
ELECTRODE ARM TUBE CLAMP

H. G. FISCHER & CO.
2335 WABANSIA AVE.
CHICAGO, ILL.

CAT. NO.

PART NO. 17043

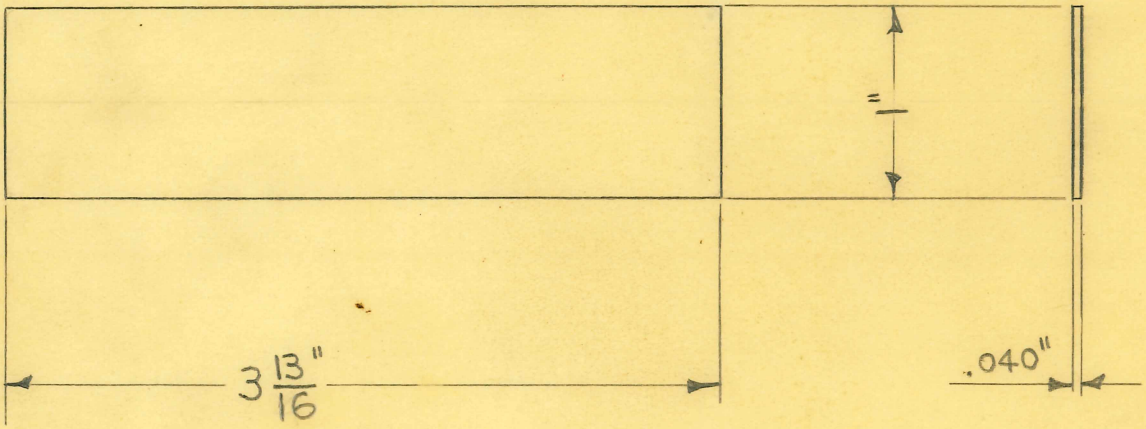

1-REQUIRED

.040" # 2400 CHACE THERMOSTATIC BIMETAL

DIMENSIONS	
FRACTIONAL	± .015
DECIMAL	± .005
ANGULAR	± 1/2°

UNLESS OTHERWISE SPECIFIED

SIZE		ISSUE 1-7-48	J.M.F
KIND		CHANGED	
SHAPE		" 5-17-48	J.B.G.
FINISH		"	
TEMP.		"	
PATT.		"	

TITLE: FISCHER MODEL "200" PORTABLE DIATHERMY BIMETAL COMPENSATOR BLANK

H. G. FISCHER & CO.
2335 WABANSIA AVE.
CHICAGO, ILL.

CAT. NO.

PART NO. 17044

NOTE:

SEND ONLY PCE. #17044F TO BE USED AS IS FOR HEAT TREATMENT. 700°F. FOR 3 HOURS

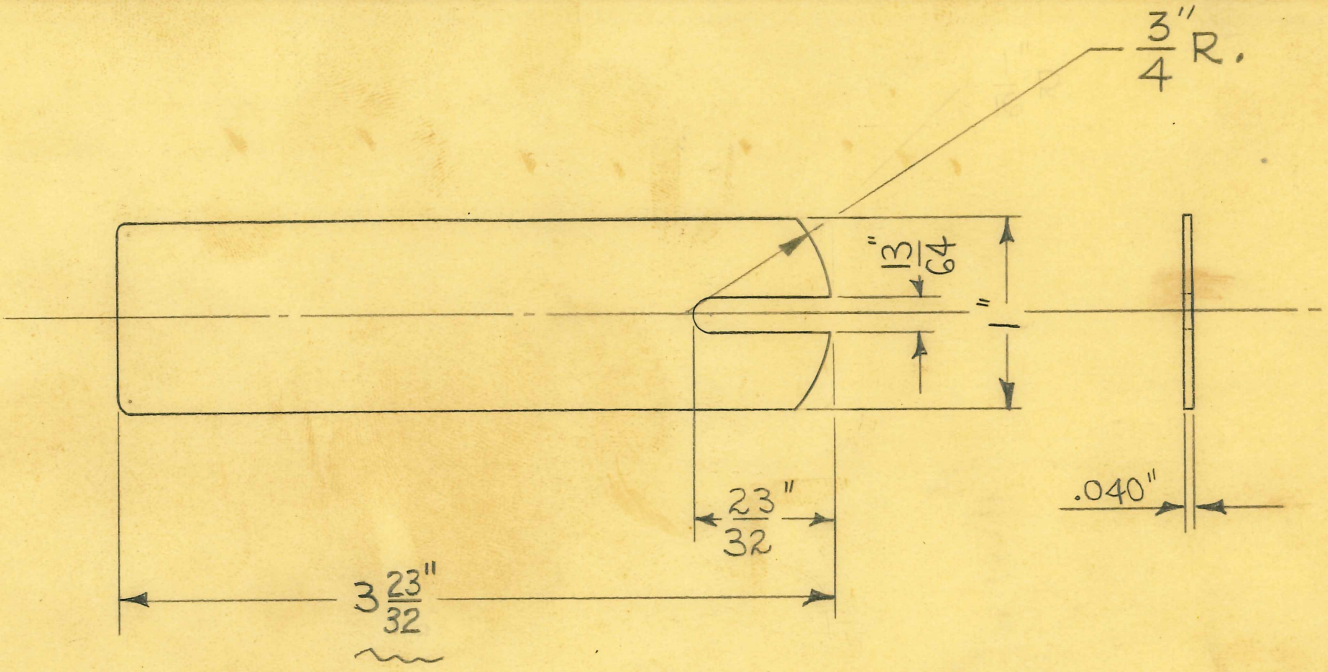

1 REQUIRED AS IS

1 REQUIRED FOR PCE. #17045

FROM 17044

NOTCHING DIE TOOL # 9662

DIMENSIONS	
FRACTIONAL	± .015
DECIMAL	± .005
ANGULAR	± 1/2°

UNLESS OTHERWISE SPECIFIED

SIZE		ISSUE 1-21-48	WJ.
KIND		CHANGED	
SHAPE		"	
FINISH		"	
TEMP.		"	
PATT.		"	

TITLE: FISCHER MODEL "200" PORTABLE DIATHERMY BIMETAL COMPENSATOR

H. G. FISCHER & CO.
2335 WABANSIA AVE.
CHICAGO, ILL.

CAT. NO.

PART NO. 17044F

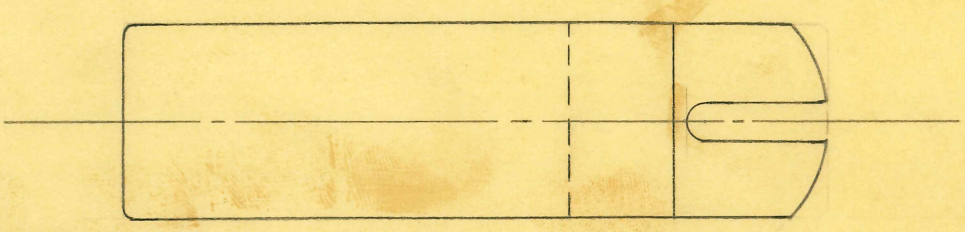

LETTER "S" STAMPED ON BIMETAL MUST BE ON THIS SIDE AFTER PIECE IS BENT

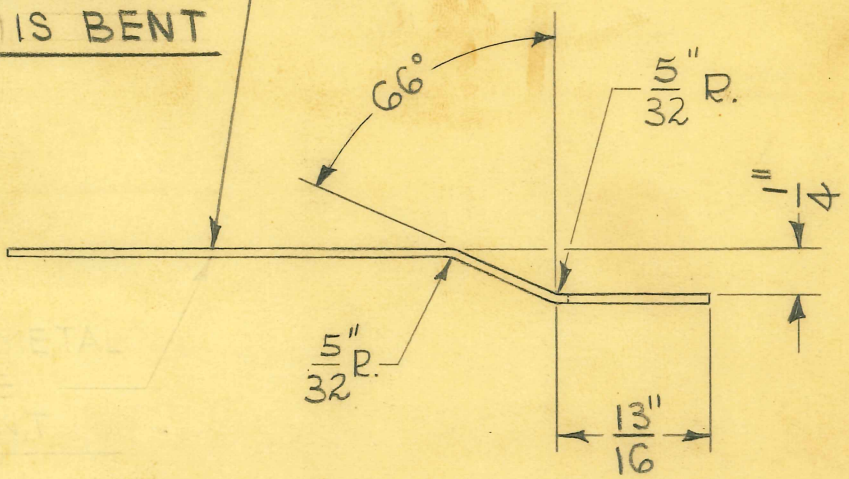

NOTE:
AFTER PIECE IS COMPLETE SEND OUT FOR HEAT TREATMENT. 700° F. FOR 3 HOURS

FROM 17044F

1 REQUIRED
FORMING FIXTURE TOOL #9645

DIMENSIONS	
FRACTIONAL	± .015
DECIMAL	± .005
ANGULAR	± 1/2°

UNLESS OTHERWISE SPECIFIED

SIZE		ISSUE 1-21-48	W.J.
KIND		CHANGED	
SHAPE		"	
FINISH		"	
TEMP.		"	
PATT.		"	

TITLE:
FISCHER MODEL "200" PORTABLE DIATHERMY
BIMETAL COMPENSATOR

H. G. FISCHER & CO.
2335 WABANSIA AVE.
CHICAGO, ILL.

CAT. NO.

PART NO. 17045

TITLE
MODEL "200" FISCHER DIATHERMY OSCILLATING COIL CONNECTION

H. G. FISCHER & CO.
FRANKLIN PARK, ILLINOIS

PART NO. 17053AF

DATE 4-5-49 DR. BY W.J. CH'K'D. J.V.W.

REVISION	DATE	BY
A WAS FINISHED PATTERN CHANGED	3-13-51	J.V.W.

PATTERN 2311 | FINISH | SCALE FULL

TOOLS VISE JAWS #11033
SANDING GAGE #9710

MATERIAL
CAST IN BRASS

DIMENSIONS UNLESS OTHERWISE SPECIFIED
FRACTIONAL ±.015
DECIMAL ±.005
ANGULAR ± ½°

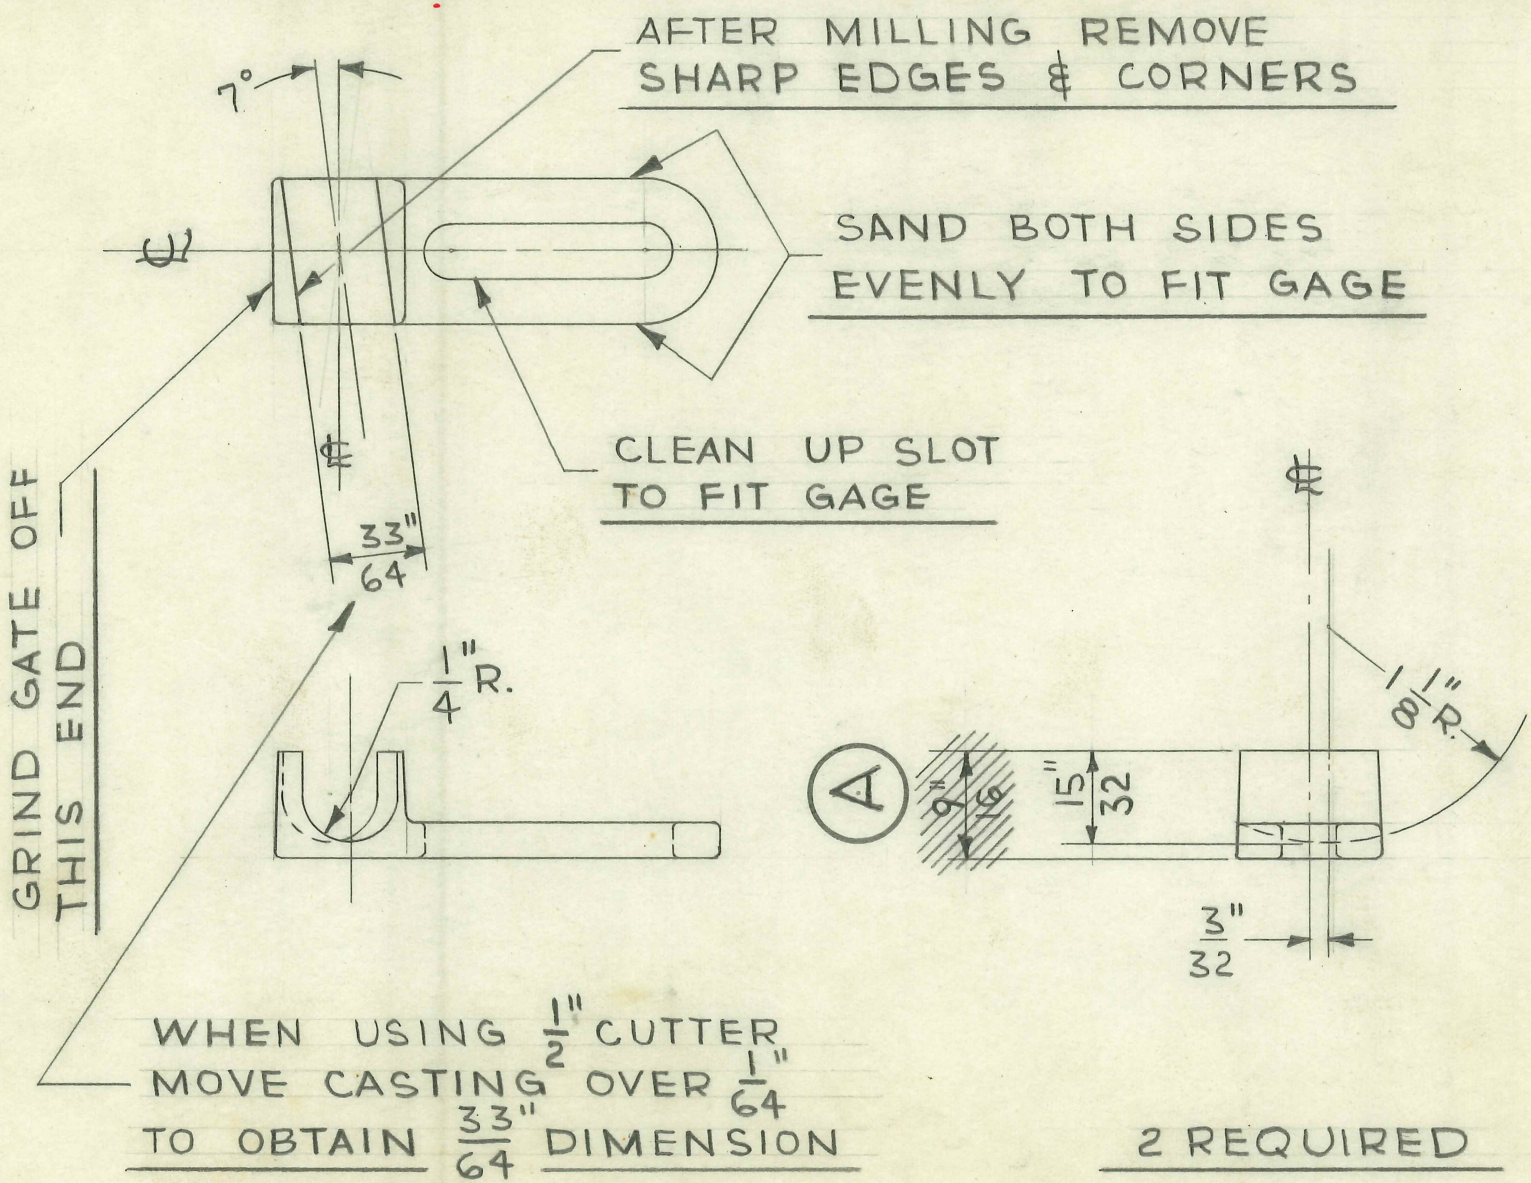

FOLDER #129

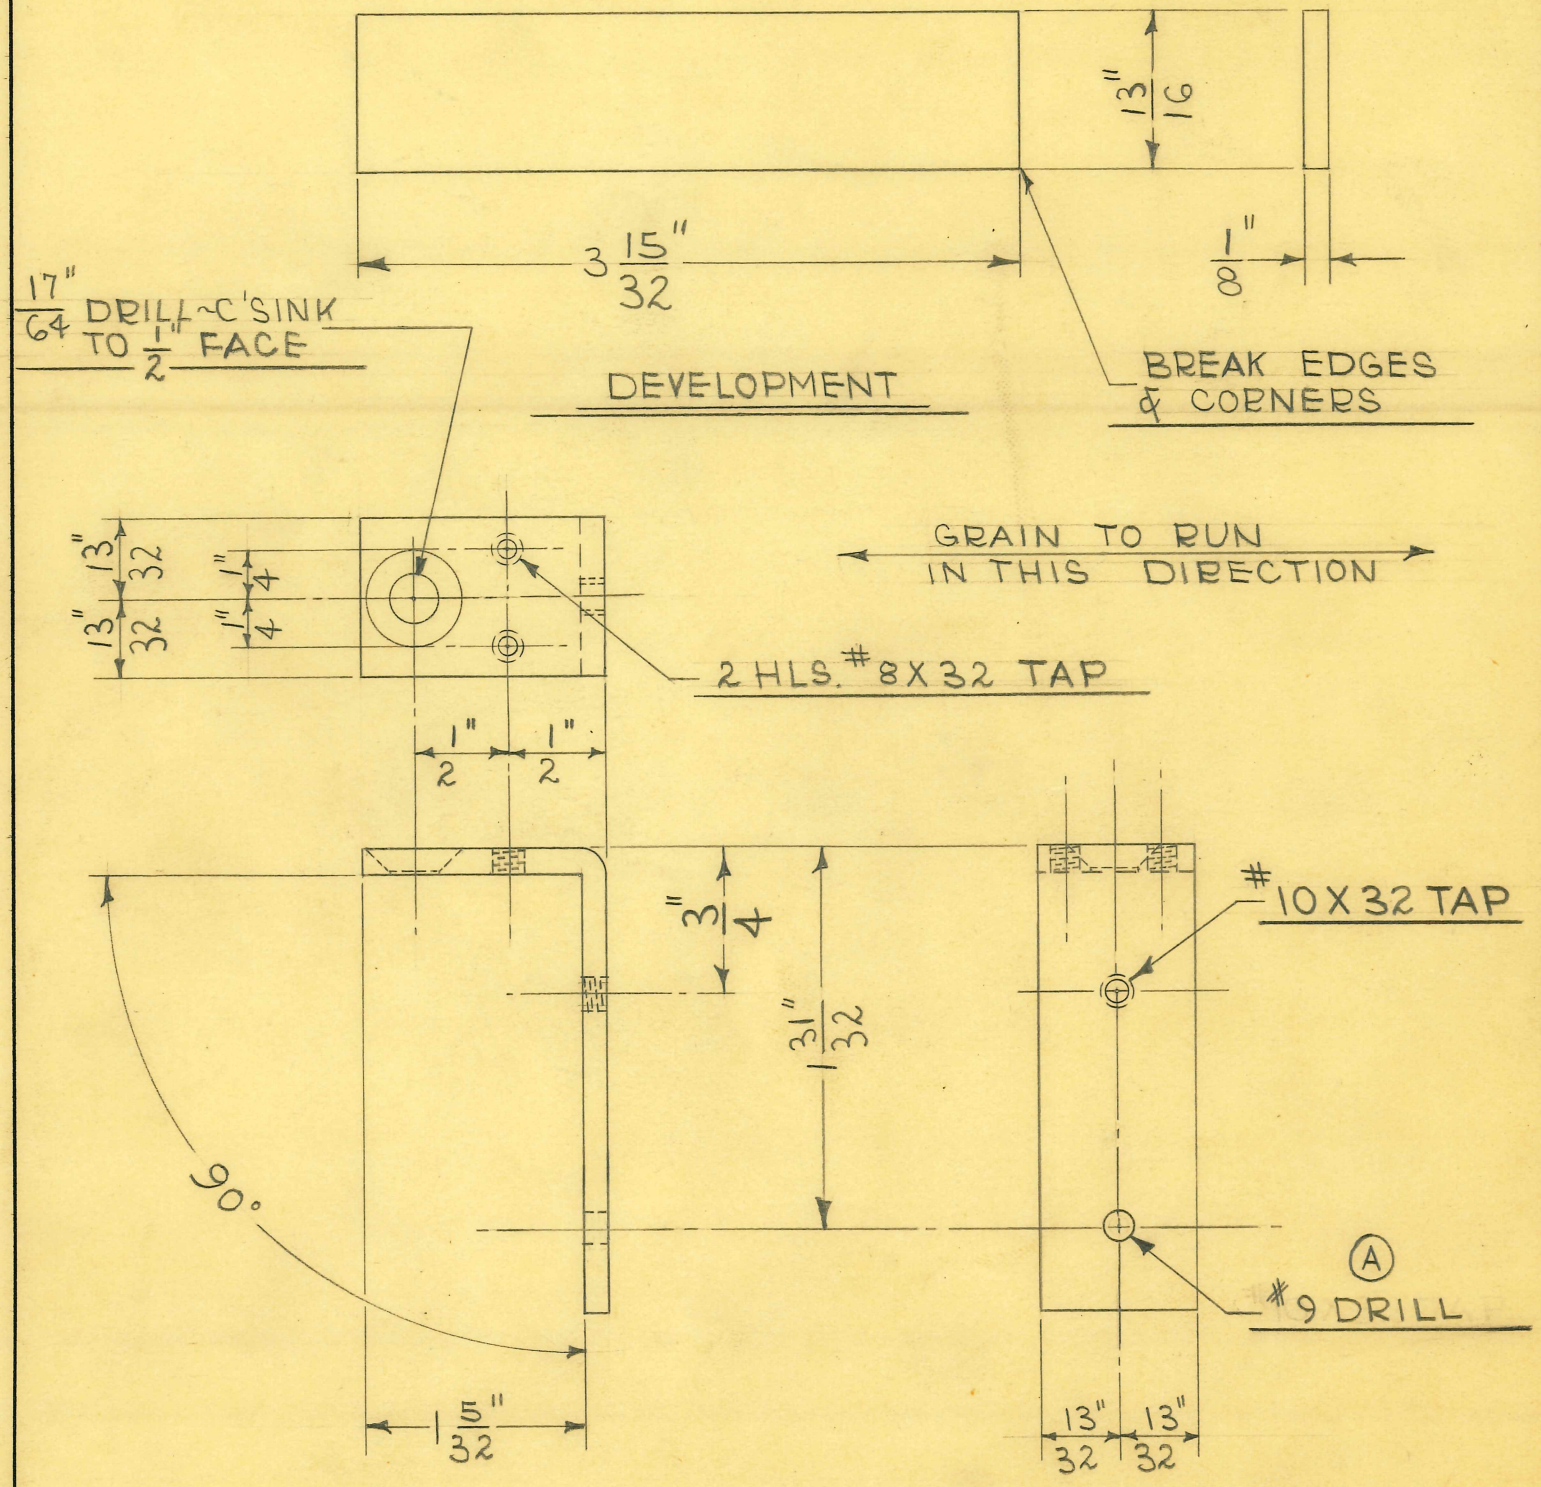

1 REQUIRED

DRILL JIG TOOL #9664

DIMENSIONS	
FRACTIONAL	± .015
DECIMAL	± .005
ANGULAR	± 1/2°

UNLESS OTHERWISE SPECIFIED

SIZE	1/8" X 13/16"	ISSUE 2-24-48	W.J.
KIND	BRASS	CHANGED	
SHAPE	SHEARED	(A) " 2-3-50	W.J.
FINISH		"	
TEMP.		"	
PATT.		"	

TITLE: FISCHER "MODEL 200" PORTABLE DIATERMY VACUUM CONDENSER SUPP. ~ FRONT

H. G. FISCHER & CO.
2335 WABANSIA AVE.
CHICAGO, ILL.

CAT. NO.

PART NO. 17054A

TITLE: FISCHER MOD. "200" TABLE MOD. DIA. VACUUM CONDENSER SUPP-REAR	H. G. FISCHER & CO. FRANKLIN PARK, ILLINOIS		PART NO. 17055A
	DATE 11-18-48 DR. BY J.V.W. CH'K'D.		REVISION / DATE / BY
PATTERN / FINISH / SCALE FULL	DIMENSIONS: FRACTIONAL ± .015; DECIMAL ± .005; ANGULAR ± ½°; UNLESS OTHERWISE SPECIFIED		
TOOLS / MATERIAL $\frac{1}{8}$" SHEET SOFT TEMPER BRASS			

GRAIN MUST RUN IN THIS DIRECTION

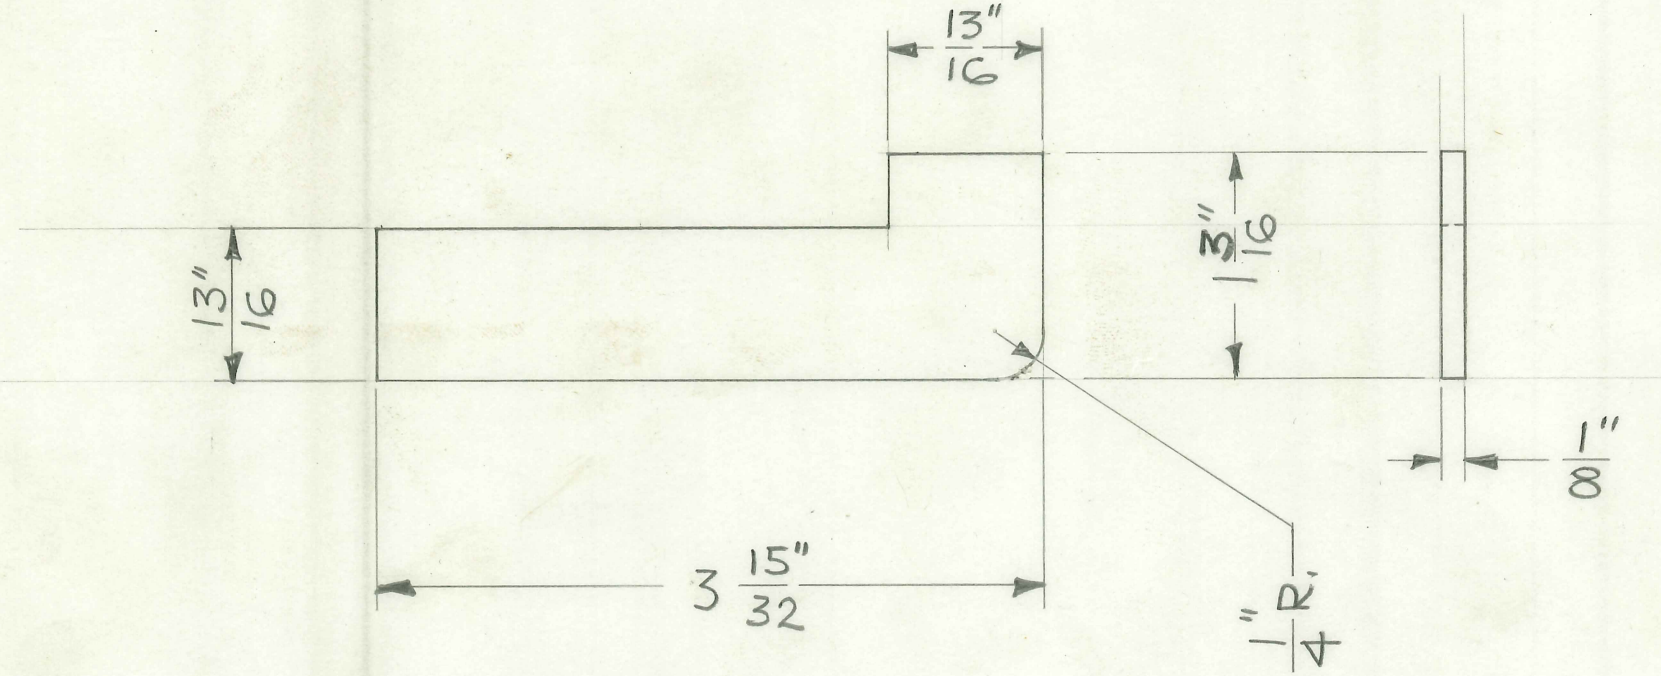

1 REQUIRED

FOLDER #129

TITLE
FISCHER MOD. "200" TABLE DIATHERMY
VACUUM CONDENSER SUPP. ~ REAR

H. G. FISCHER & CO.
FRANKLIN PARK, ILLINOIS

DATE 11-19-48 DR. BY J.V.W. CH'K'D.

PART NO. 17055AFA

REVISION		DATE	BY
A	WAS #10X32 TAP	2-3-50	W.J.

PATTERN | FINISH | SCALE FULL

TOOLS: DRILL JIG TOOL #9664

MATERIAL: FROM #17055A

DIMENSIONS UNLESS OTHERWISE SPECIFIED
FRACTIONAL ± .015
DECIMAL ± .005
ANGULAR ± ½°

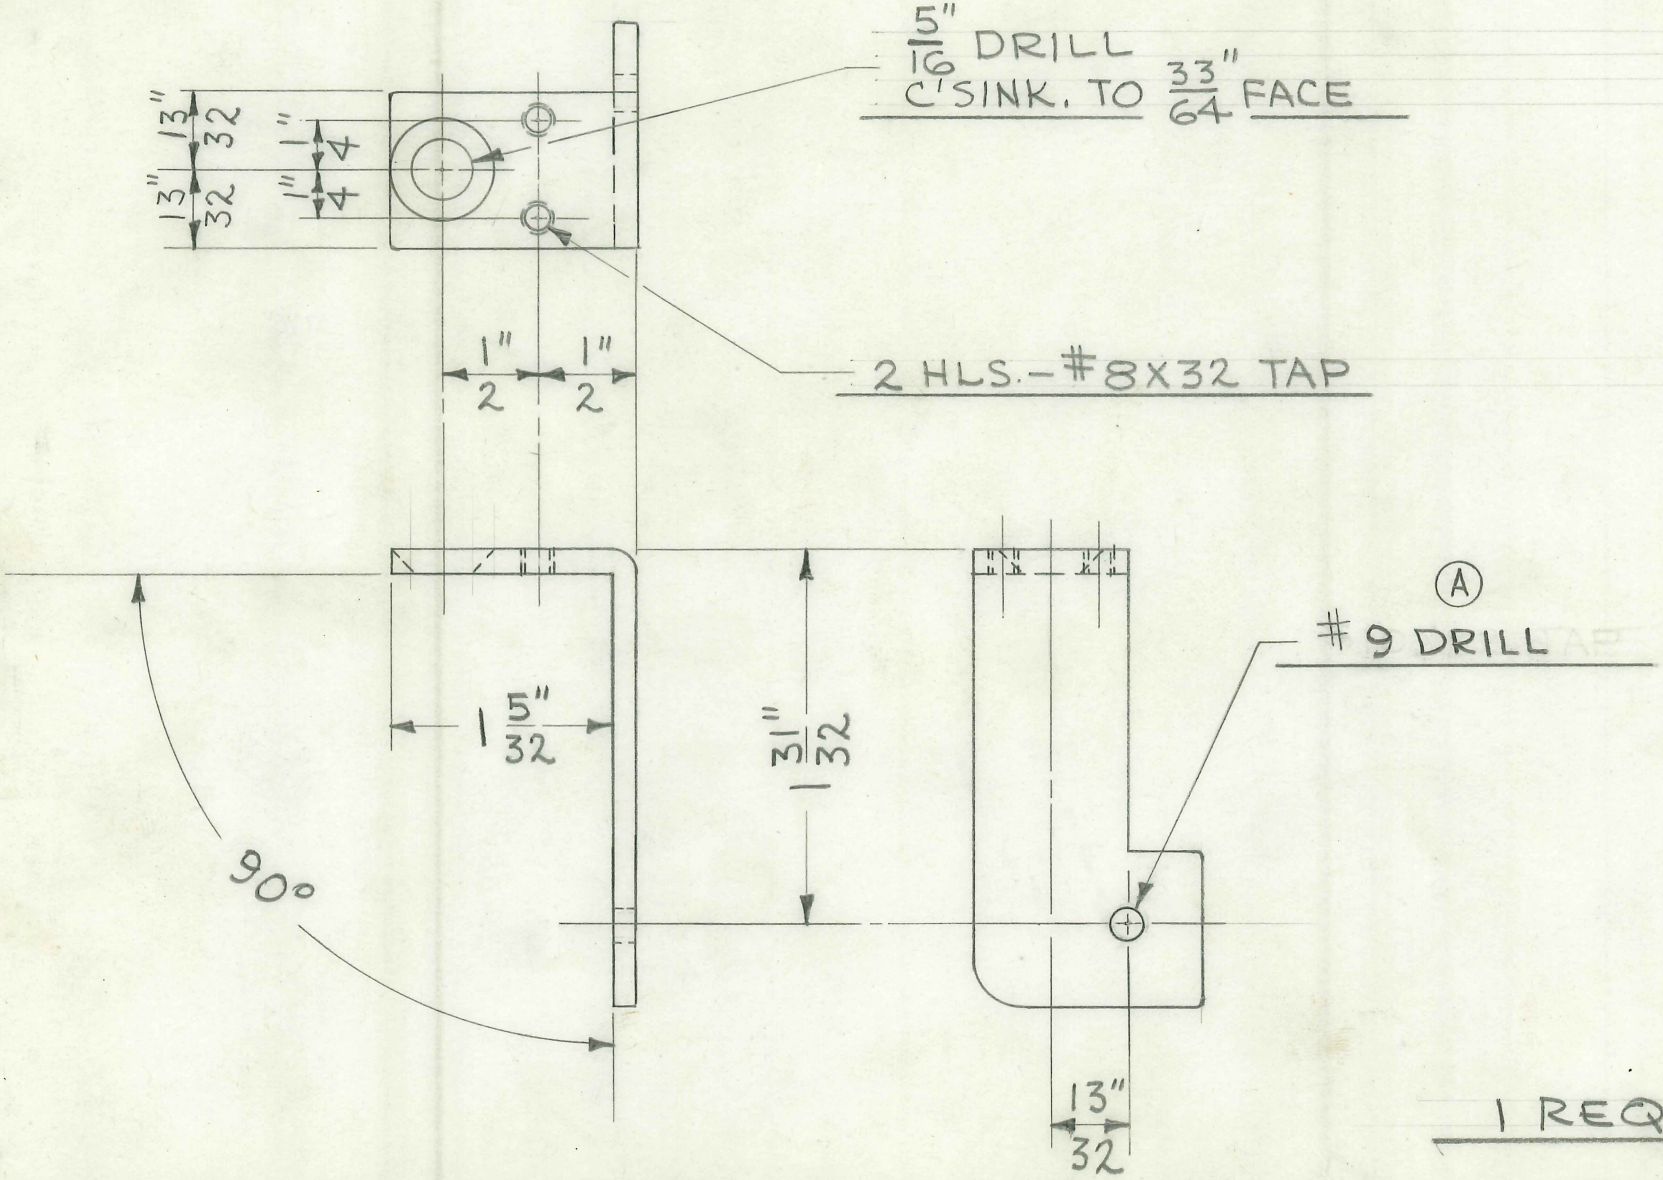

1 REQUIRED

FOLDER #129

TITLE

BRACKE-SEIB SPOTOGRAPH
SPOTOGRAPH SWITCH & CABLE ASSEM.

H. G. FISCHER & CO.
FRANKLIN PARK, ILLINOIS

PART NO. 16475 G

DATE 7-8-53 | DR BY W. J. | CH'K'D

REVISION	DATE	BY

PATTERN | FINISH | SCALE FULL

TOOLS | MATERIAL

DIMENSIONS
FRACTIONAL ± .015
DECIMAL ± .005
ANGULAR ± ½°
UNLESS OTHERWISE SPECIFIED

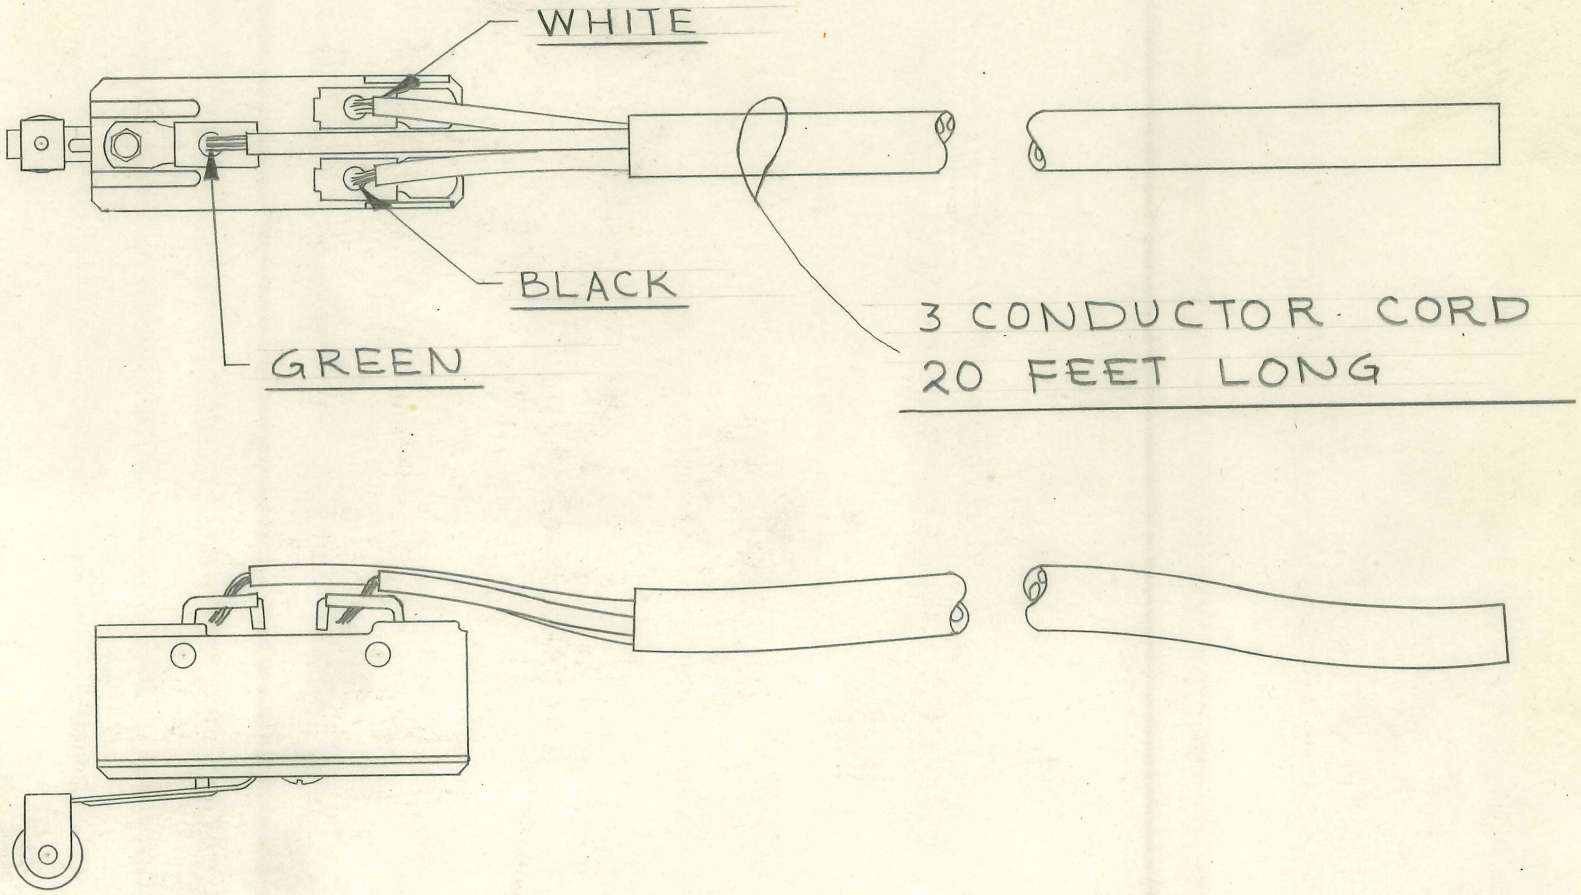

FOLDER 127

TITLE: FISCHER MOD. "10A" DIATHERMY OSCILLATING COIL CONNECTION

H. G. FISCHER & CO.
FRANKLIN PARK, ILLINOIS

PART NO. 16483

DATE 9-5-52 | DR BY J.V.W. | CH'K'D.

REVISION	DATE	BY

PATTERN 2031 | FINISH | SCALE FULL

TOOLS: DRILL JIG #11800

MATERIAL: BRASS CASTING FROM #16281

DIMENSIONS UNLESS OTHERWISE SPECIFIED
FRACTIONAL ± .015
DECIMAL ± .005
ANGULAR ± ½°

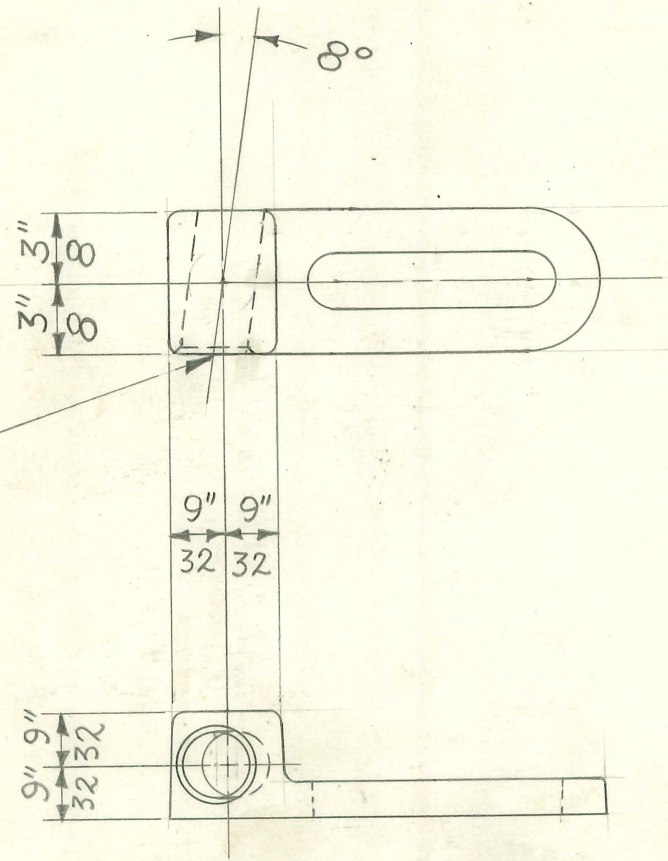

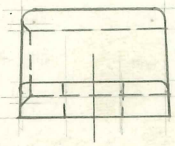

1 - 11/32" DRILL - C'SUNK. TO 13/32" FACE

2 REQUIRED

FOLDER #132

TITLE
FISCHER MP30 X-RAY CASTER

H. G. FISCHER & CO.
FRANKLIN PARK, ILLINOIS

PART NO. 16537

DATE 4-24-57 | DR BY C.E.K. | CH'K'D. J.V.W.

REVISION	DATE	BY

PATTERN | FINISH | SCALE FULL

TOOLS | MATERIAL FROM 21602

DIMENSIONS
FRACTIONAL ± .015
DECIMAL ± .003
ANGULAR ± ½°
UNLESS OTHERWISE SPECIFIED

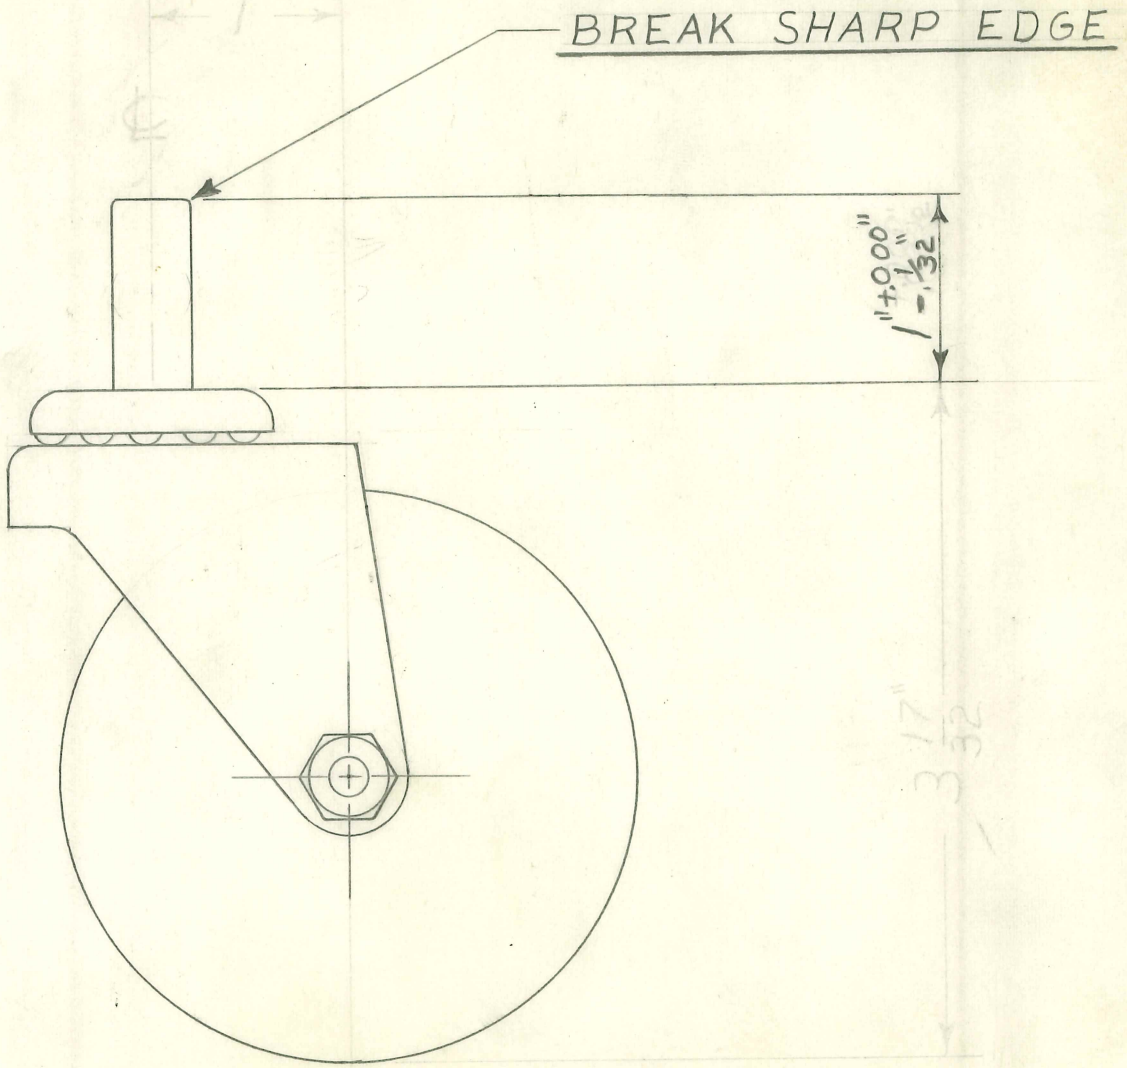

4 REQUIRED

TITLE
"MP-30" TUBE STAND WITH FLUOROSCOPIC ARM - CWT. CLAMP ROD

H. G. FISCHER & CO.
FRANKLIN PARK, ILLINOIS

PART NO. 16544

DATE 10-11-55 DR BY RDL CH'K'D. J.V.W.

REVISION	DATE	BY

PATTERN | FINISH | SCALE FULL

TOOLS | MATERIAL 1/4" DIA. C.R. STEEL

DIMENSIONS
FRACTIONAL ± .015
DECIMAL ± .005
ANGULAR ± ½°
UNLESS OTHERWISE SPECIFIED

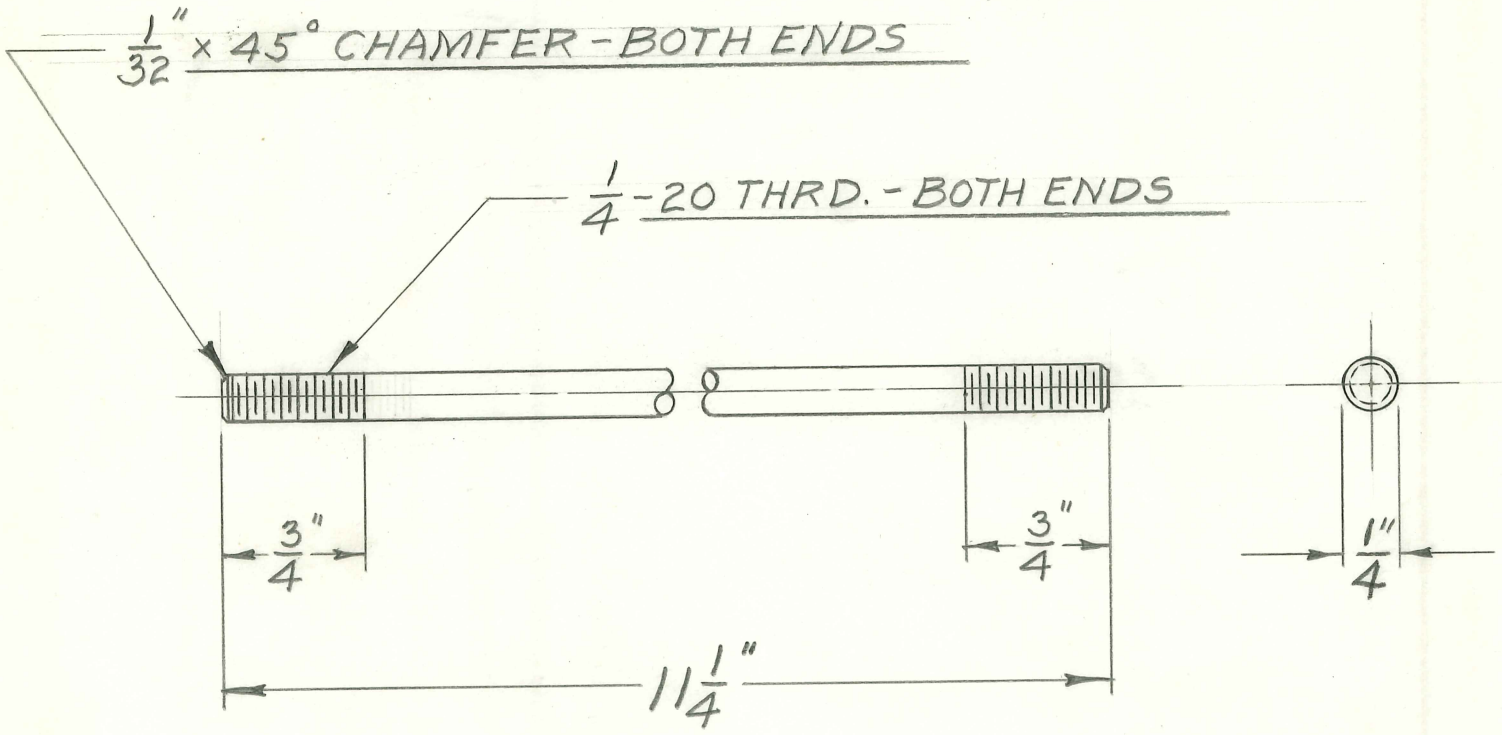

2 REQUIRED

FOLDER # 119

TITLE

FISCHER "MP-30" TRANSFORMER
COVER INSULATOR

H. G. FISCHER & CO.
FRANKLIN PARK, ILLINOIS

PART NO. 16549

DATE	DR BY	CH'K'D.
10-26-55	C.E.K.	J.V.W.

REVISION	DATE	BY

PATTERN | FINISH | SCALE FULL

TOOLS

MATERIAL
1/32" SHEET BLACK FIBRE

DIMENSIONS
FRACTIONAL ± .015
DECIMAL ± .005
ANGULAR ± ½°
UNLESS OTHERWISE SPECIFIED

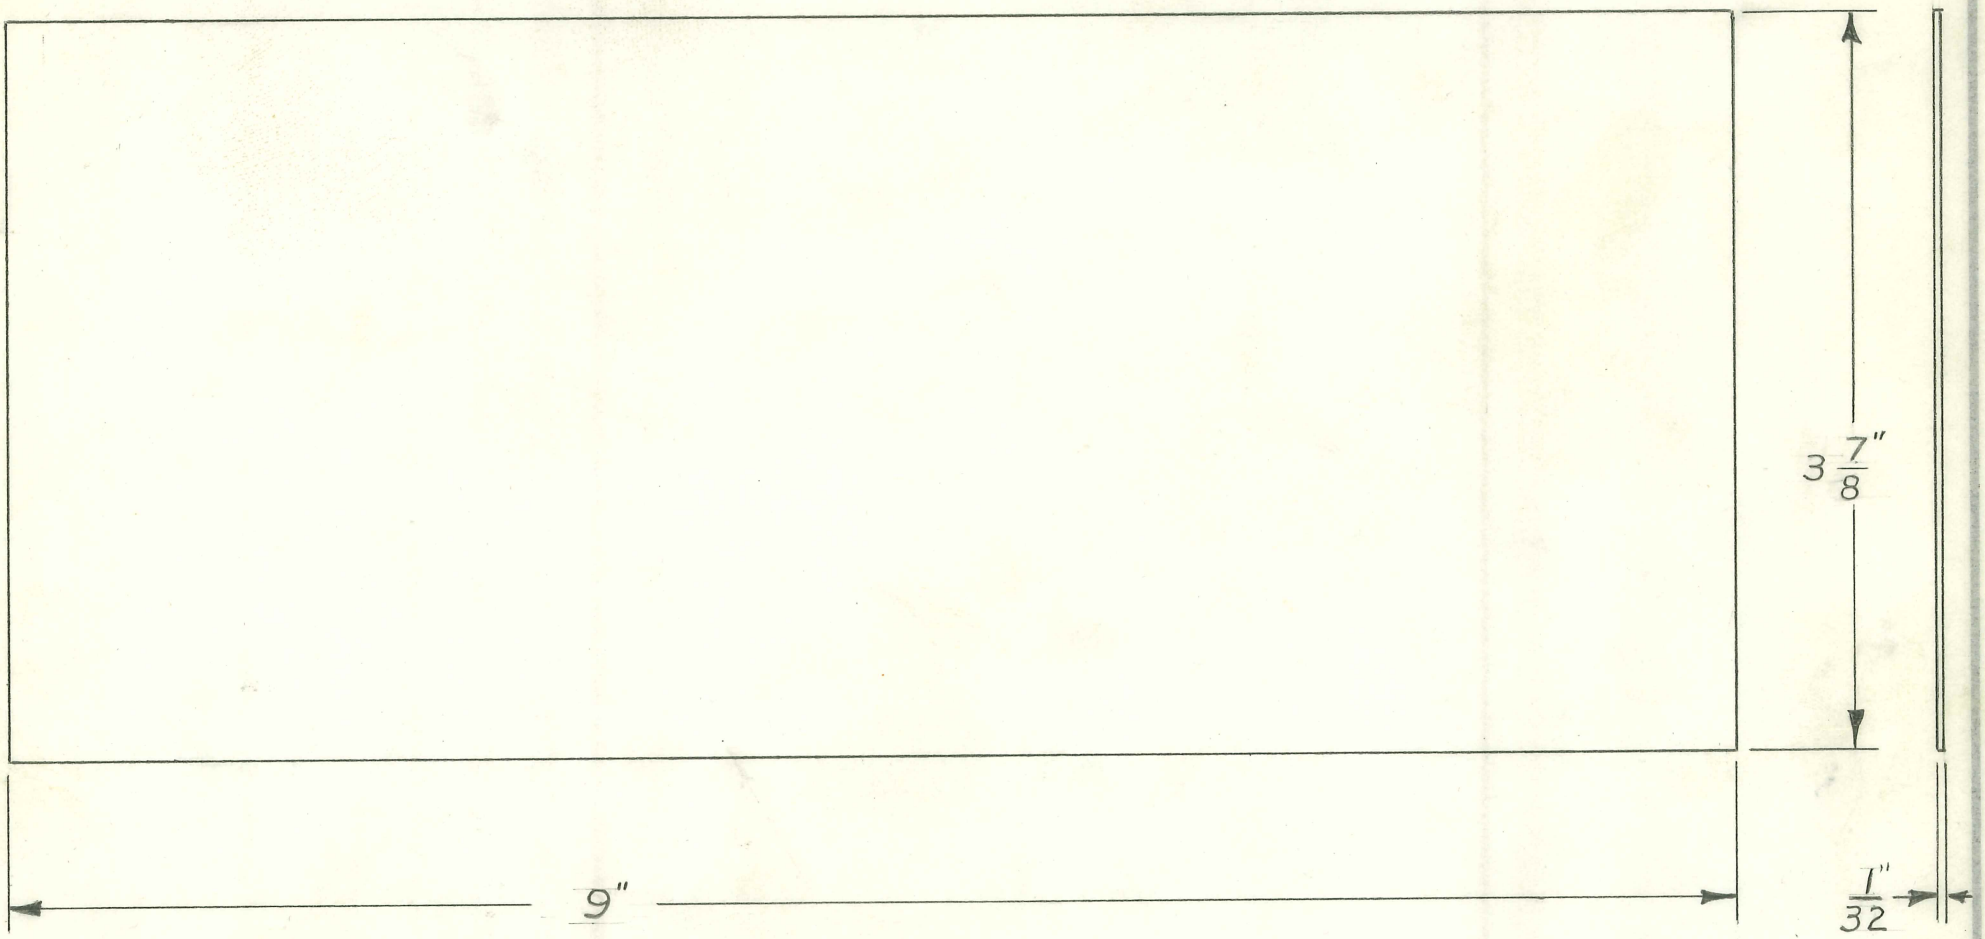

1 REQUIRED

FOLDER # 119

TITLE **DELUXE "400" DIATHERMY**
INDUCTION CABLE TIP

H. G. FISCHER & CO.
FRANKLIN PARK, ILLINOIS

PART NO. 15523

DATE 3-26-65 DR BY T. T. CH'K'D. RS

REVISION	DATE	BY

PATTERN | FINISH WHITE NICKEL (113) | SCALE FULL

TOOLS

MATERIAL 5/16 RD. BRASS ROD, MUST FIT .313 RING GAUGE

DIMENSIONS UNLESS OTHERWISE SPECIFIED
FRACTIONAL ± .015
DECIMAL ± .005
ANGULAR ± ½°

USED ON	QTY.
15544GB	2

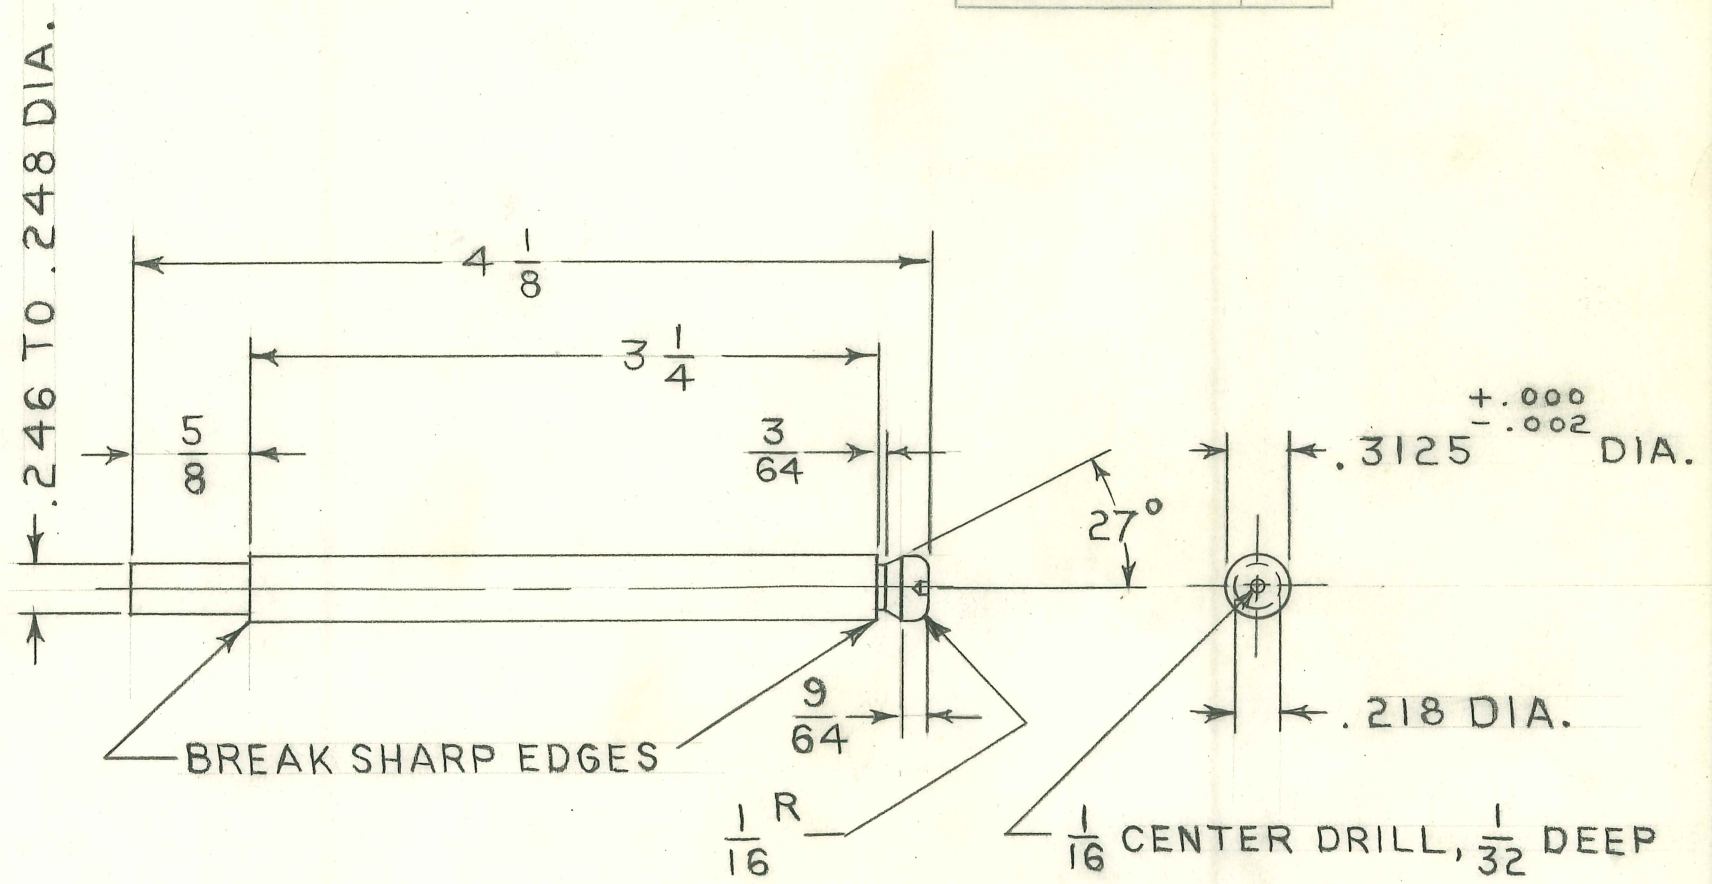

USED FOR IDENTIFYING THIS NEW STYLE TIP

TITLE	DELUXE "400" DIATHERMY INDUCTION CABLE TIP SLEEVE	H. G. FISCHER & CO. FRANKLIN PARK, ILLINOIS	PART NO. 15524
		DATE 3-25-65 DR BY T. T. CH'K'D. R.S.	

REVISION	DATE	BY
A WAS .016 SLOTS E.C.O. 1160	6/9/71	AP.

PATTERN	FINISH	SCALE
	NONE	FULL

TOOLS

MATERIAL: $\frac{5}{8}$ DIA. BRASS

DIMENSIONS UNLESS OTHERWISE SPECIFIED
FRACTIONAL ± .015
DECIMAL ± .005
ANGULAR ± ½°

USED ON	QTY.
15544GB	2

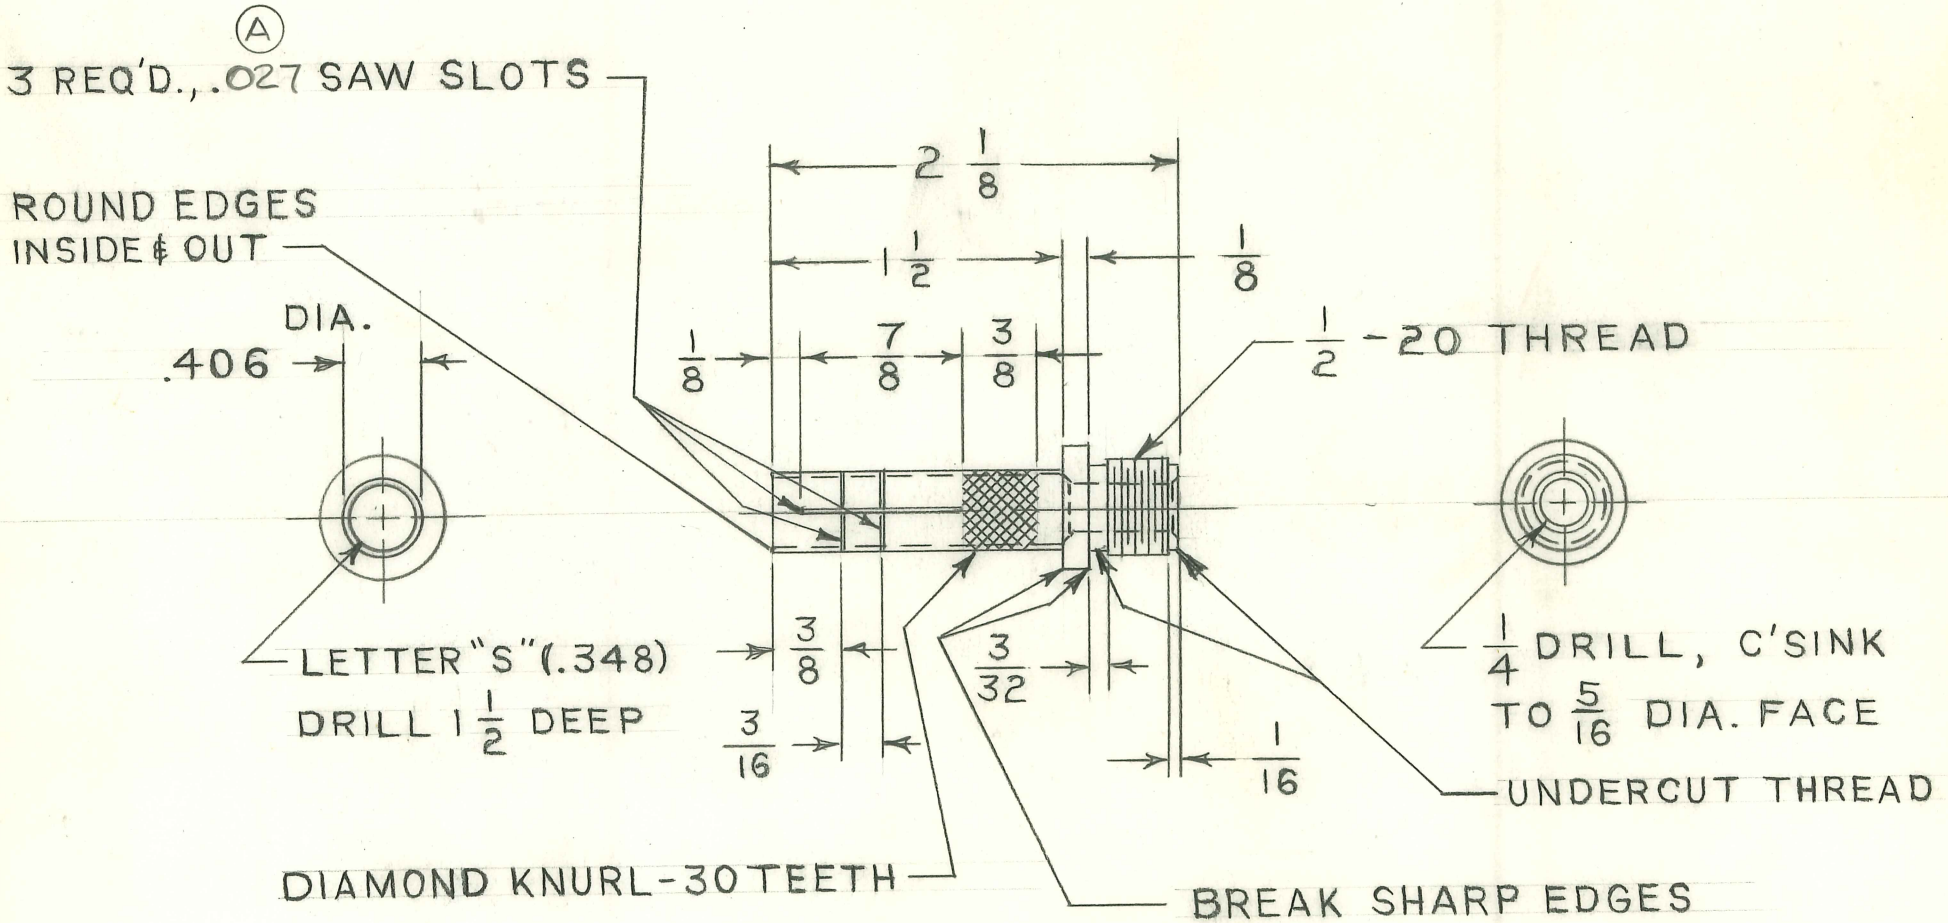

TITLE SPECIAL SLEEVE TO ADAPT KRISER ELECT ARM TO FISCHER BRKT. #15527AF

H. G. FISCHER & CO.
FRANKLIN PARK, ILLINOIS

DATE 1-16-63 DR BY J.V.W. CH'K'D.

PART NO. 15527 1/2

REVISION	DATE	BY

PATTERN

FINISH CAD. #23

SCALE NONE

TOOLS

MATERIAL 1 3/8 O.D. X 1 1/4 I.D. BRASS TUBING

DIMENSIONS
FRACTIONAL ± .015
DECIMAL ± .005
ANGULAR ± 1/2°
UNLESS OTHERWISE SPECIFIED

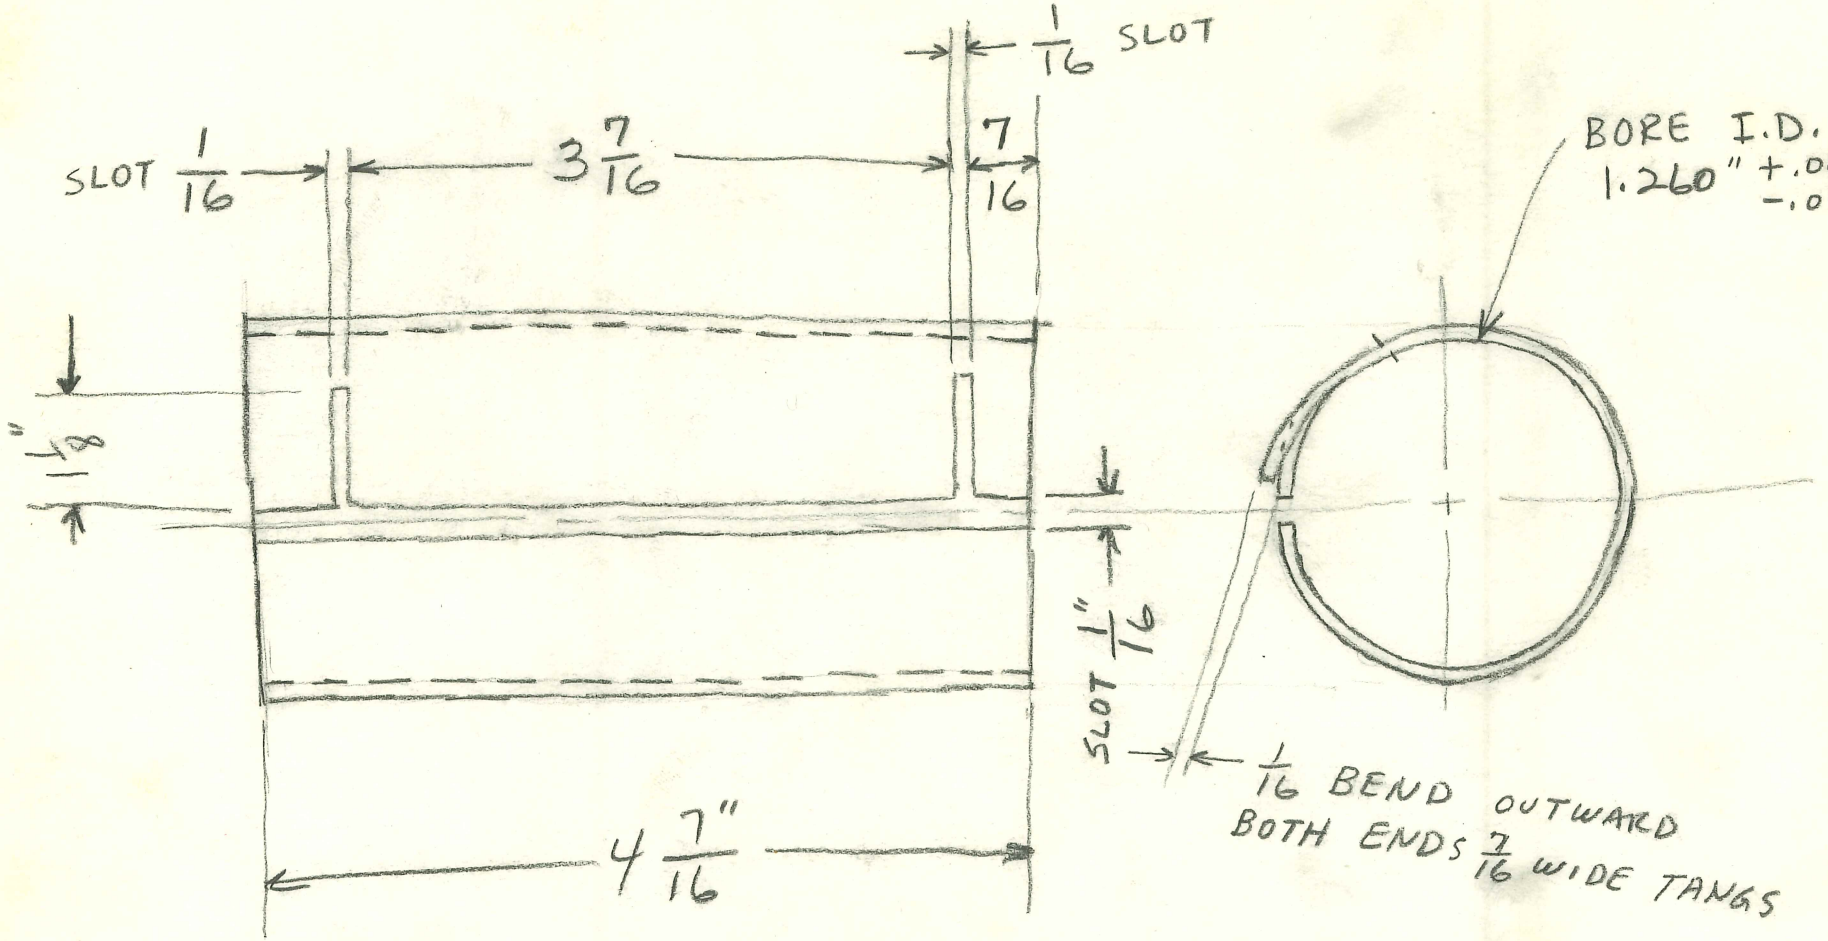

FOLDER #116

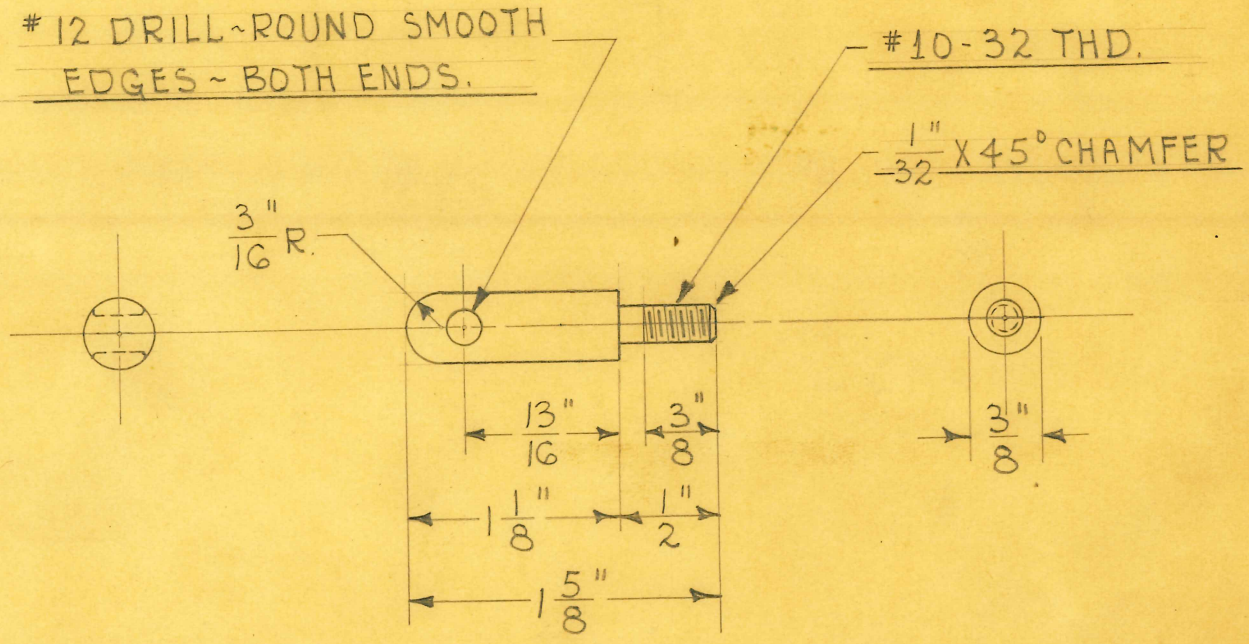

1 REQUIRED

SIZE	3/8" DIA.	ISSUE 3-22-44	HE.
KIND	C.R. STEEL	CHANGED	
SHAPE	ROD	"	
FINISH	CHR. # 2	"	
TEMP.		"	
PATT.		"	

TITLE: FISCHER "VC" SHORT WAVE APPARATUS~ CABINET ~ SWITCH CORD EYELET

H. G. FISCHER & CO.
2335 WABANSIA AVE.
CHICAGO, ILL.

CAT. NO.

PART NO. 15534

TITLE

FISCHER "VC" SHORT WAVE APP. INDUCTION DISC CABLE SEPERATOR

H. G. FISCHER & CO.
FRANKLIN PARK, ILLINOIS

PART NO. 15538A

DATE 2-2-49 | DR. BY W.J. | CH'K'D. J.V.W.

REVISION	DATE	BY

PATTERN | FINISH | SCALE FULL

DIMENSIONS
FRACTIONAL ± .015
DECIMAL ± .005
ANGULAR ± ½°
UNLESS OTHERWISE SPECIFIED

TOOLS PERF. DIE #4608 - Y-6
PERF. GAUGE ON DIE #4372-0-3

MATERIAL 1/16" SHEET (NAT. SEMI)
PANELYTE BAKELITE. GRADE 780

TRIMMING DIE # 7005 - F-5

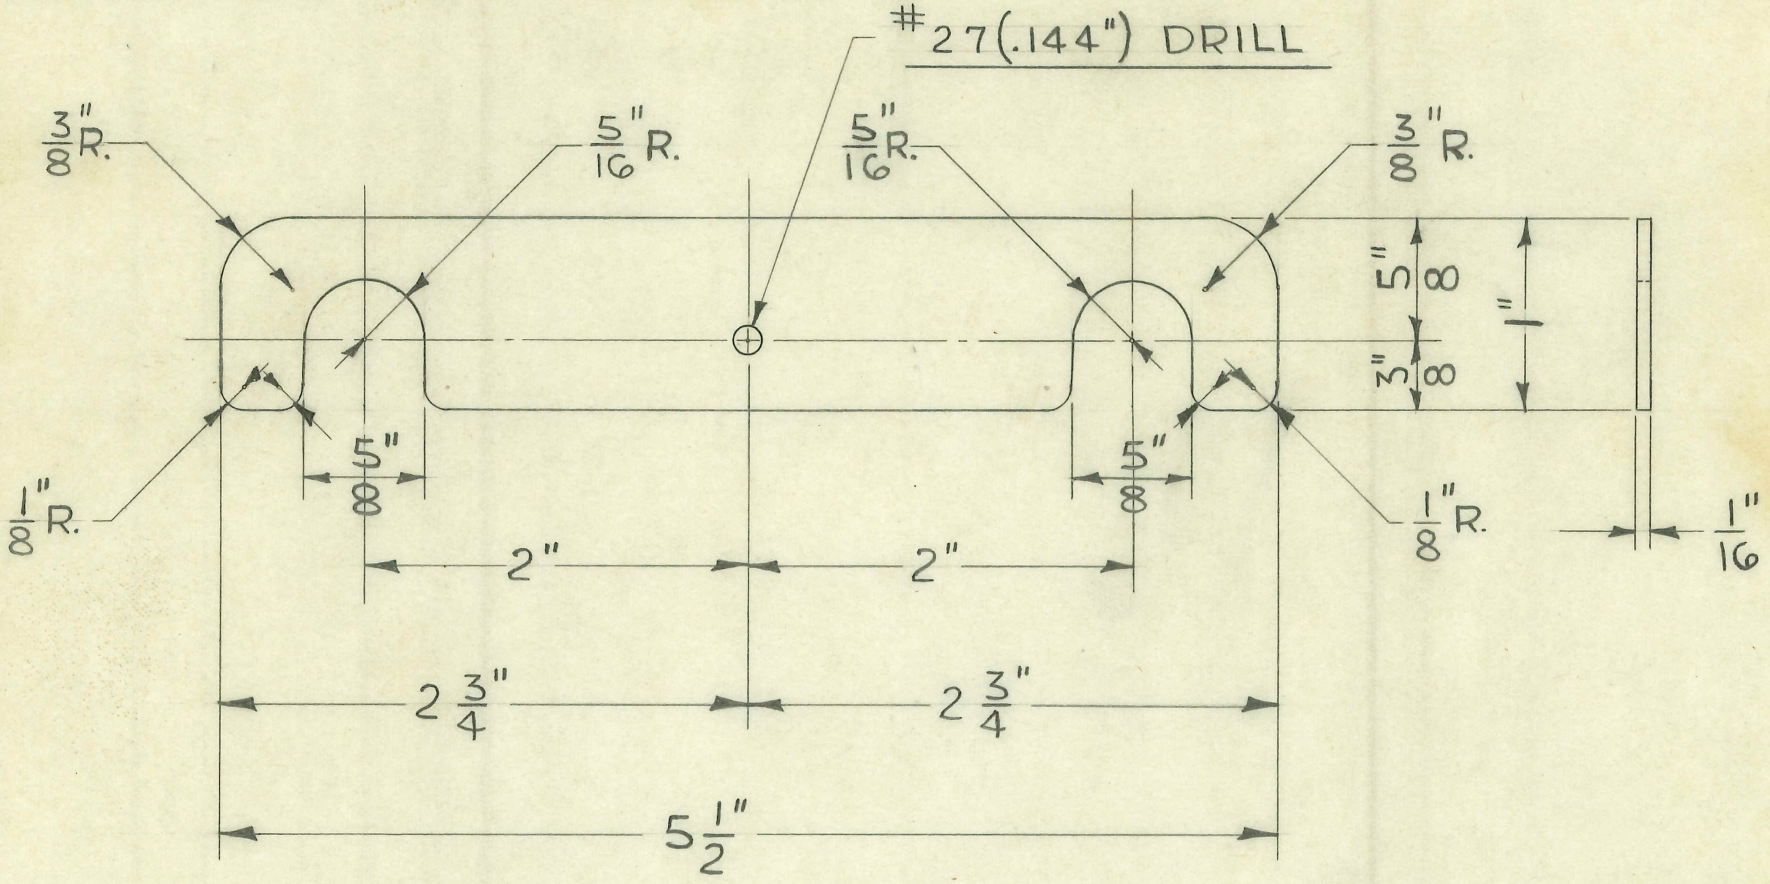

2 REQUIRED

116 FOLDER #116

TITLE FISCHER "VC" SHORT WAVE INDUCTION DISC CORE COVER CLAMP RING

H. G. FISCHER & CO.
FRANKLIN PARK, ILLINOIS

PART NO. 15539A

DATE 4-12-49 DR. BY J.V.W. CH'K'D. RS

REVISION		DATE	BY
A	WAS .726"	5-6-49	J.V.W.

PATTERN | FINISH | SCALE FULL

TOOLS

MATERIAL $\frac{13}{16}$" O.D. X $\frac{11}{16}$" I.D. SEAMLESS BRASS TUBING

DIMENSIONS UNLESS OTHERWISE SPECIFIED
FRACTIONAL ± .015
DECIMAL ± .005
ANGULAR ± ½°

ROUND EDGES - INSIDE & OUT - BOTH ENDS

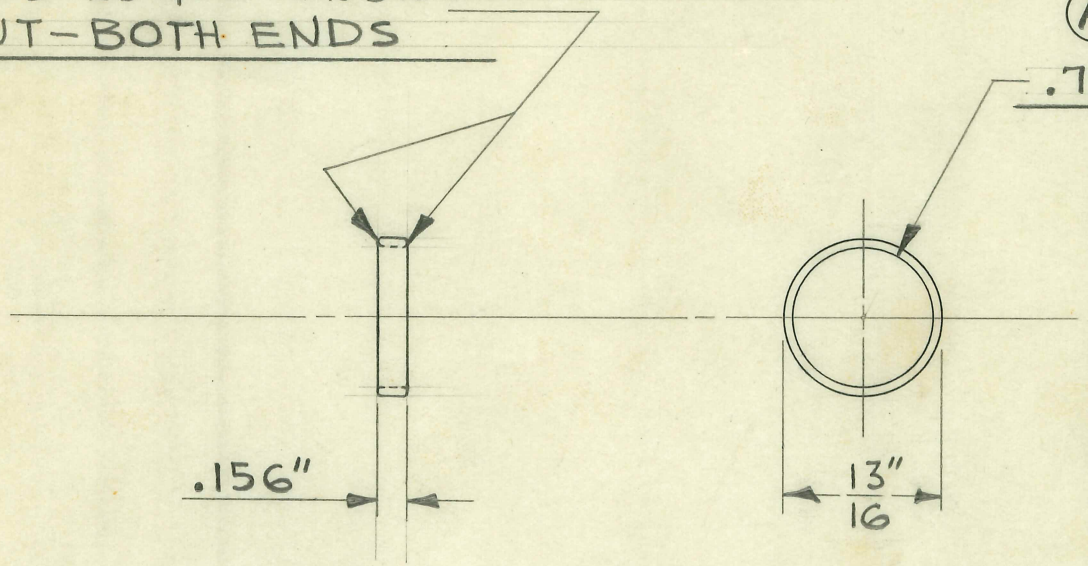

ANNEAL BEFORE SENDING TO STOCK

2 REQUIRED

FOLDER #116

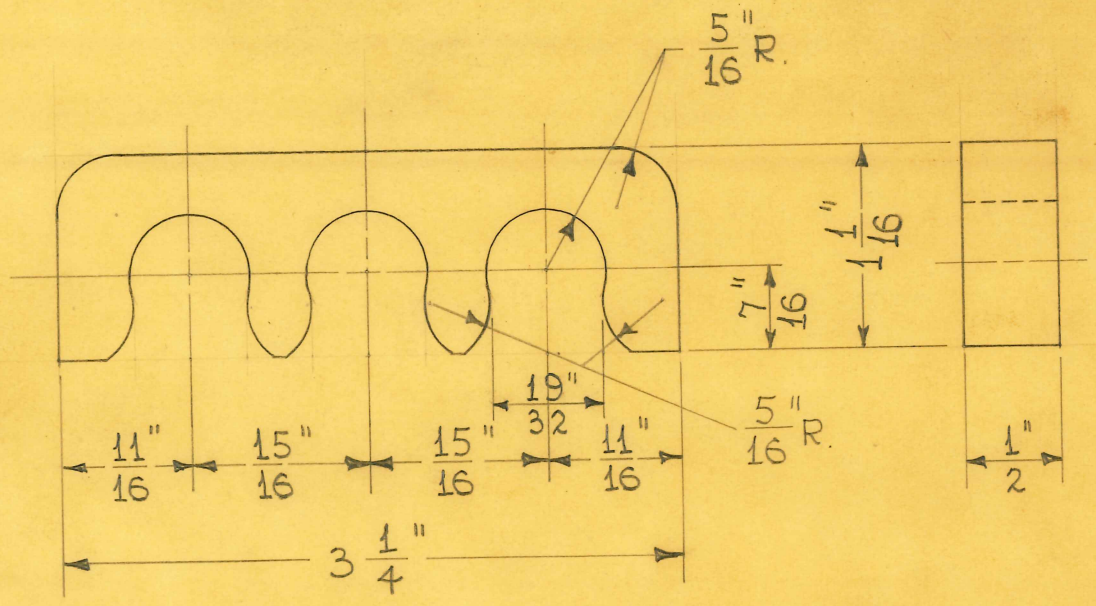

6 REQUIRED

SIZE	1/2"	ISSUE 1-24-44	HE.	**TITLE:** FISCHER "VC" SHORT WAVE APPARATUS - IND. CABLE SEPARATOR
KIND	BIRCH	CHANGED		
SHAPE		"		
FINISH		"		
TEMP.		"		
PATT.		"		

H. G. FISCHER & CO.
2335 WABANSIA AVE.
CHICAGO. ILL.

CAT. NO.

PART NO. 15541

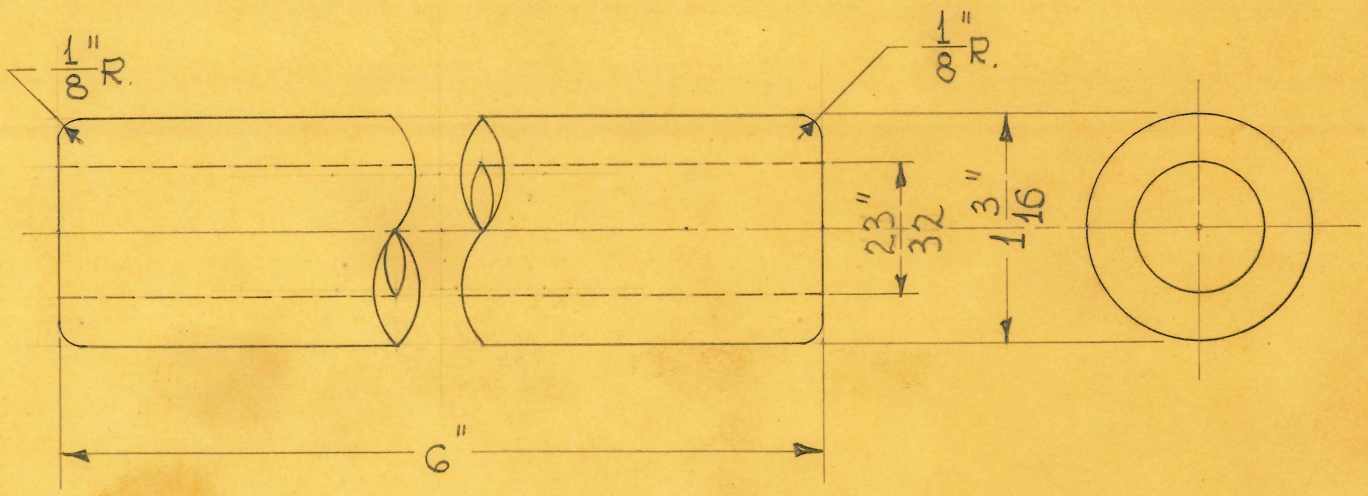

1 REQUIRED

SIZE		ISSUE 1-25-44	HE.
KIND	BIRCH	CHANGED	
SHAPE		"	
FINISH		"	
TEMP.		"	
PATT.		"	

TITLE: FISCHER "VC" SHORT WAVE APPARATUS-
CABLE GUARD

H. G. FISCHER & CO.
2335 WABANSIA AVE.
CHICAGO. ILL.

CAT. NO.

PART NO. 15542

TITLE

DELUXE "400" DIATHERMY
INDUCTION CABLE TIP ASS'Y.

H. G. FISCHER & CO.
FRANKLIN PARK, ILLINOIS

DATE 3-26-65 DR BY T. T. CH'K'D. RS

PART NO. 15544 GB

REVISION	DATE	BY

PATTERN | FINISH | SCALE FULL

TOOLS | MATERIAL AS SHOWN

DIMENSIONS
FRACTIONAL ± .015
DECIMAL ± .005
ANGULAR ± ½°
UNLESS OTHERWISE SPECIFIED

DEPT.	NO. REQ'D.	ITEM NO.	NAME OF PART	PART NO.	USED ON	QTY.
P.S.	1	1	INDUCTION CABLE TIP	15523		
P.S	1	2	INDUCTION CABLE TIP SLEEVE	15524		

SWEAT SOLDER BUSHING ONTO SHAFT AS SHOWN

REMOVE SOLDER

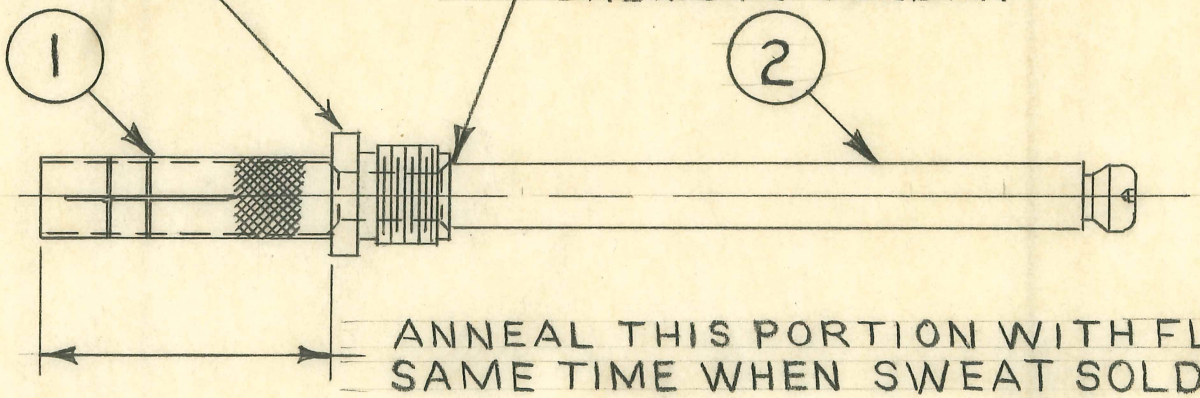

2 REQUIRED PER UNIT.

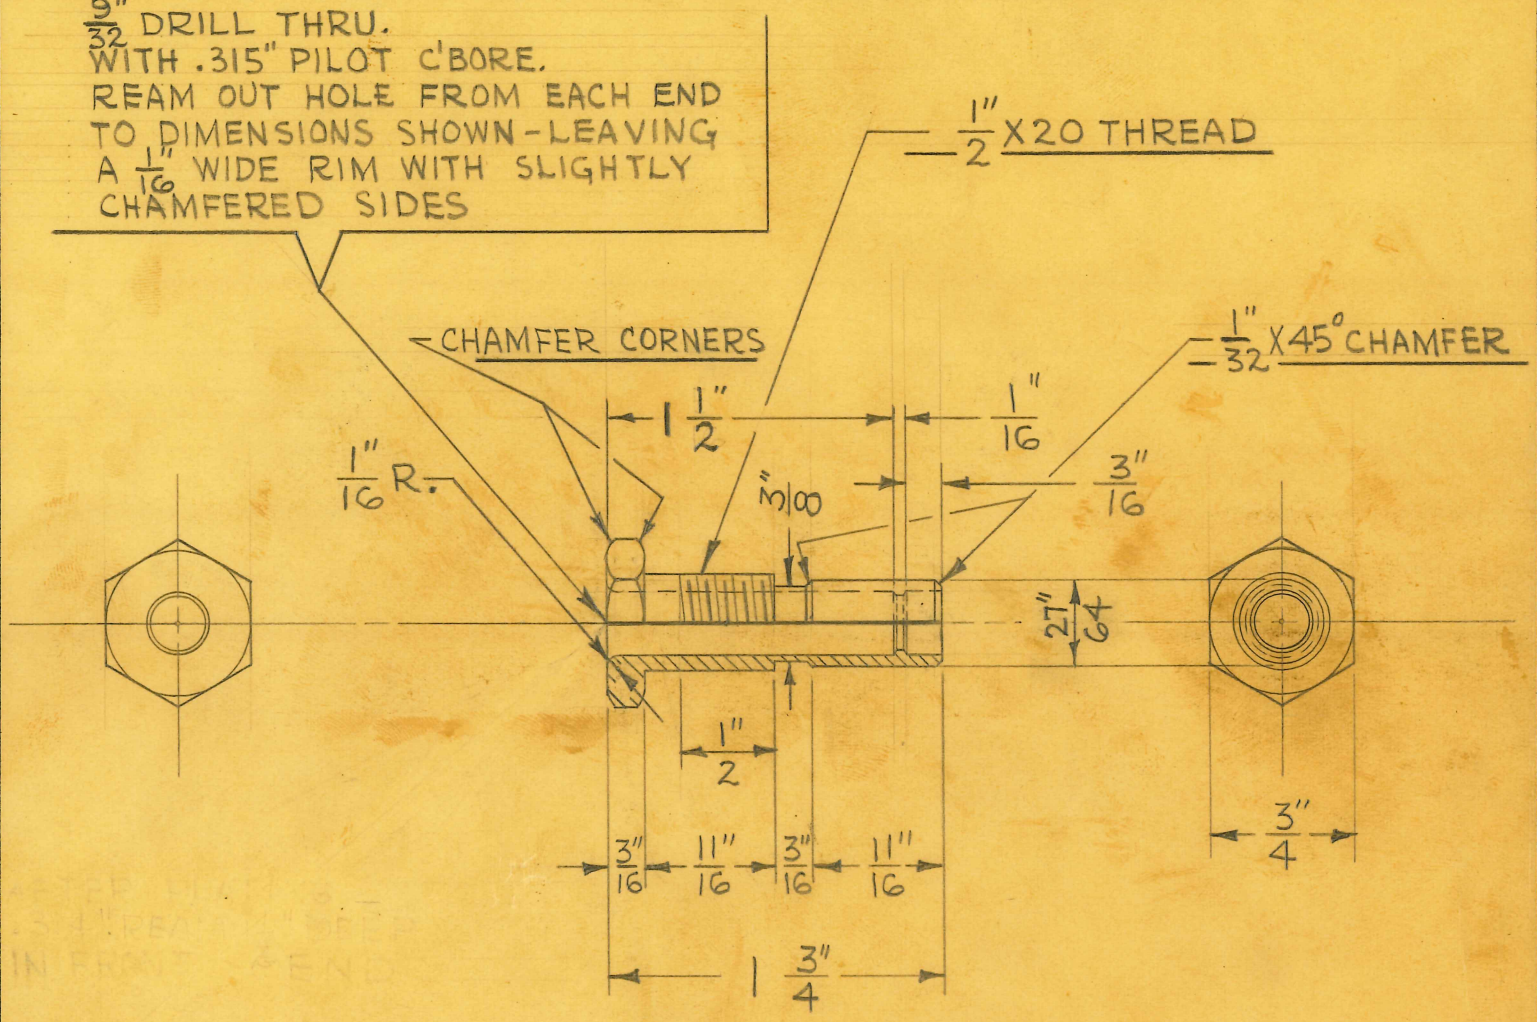

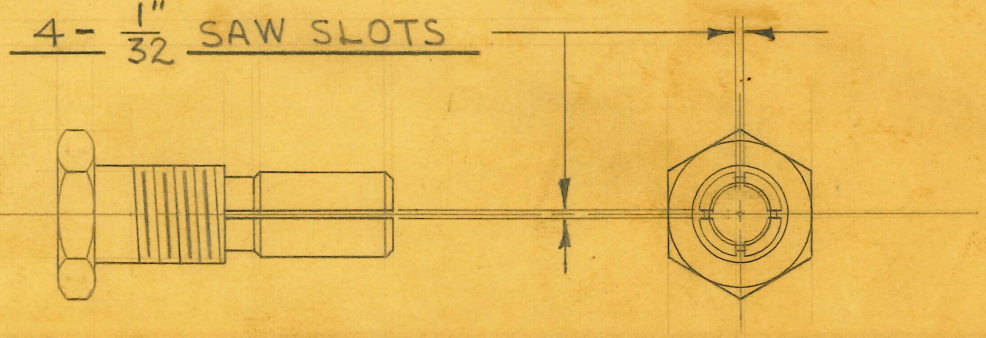

2-REQUIRED

PLUG GAUGE TOOL #9805
"GO" .314" - "NO-GO" .315"

SIZE	3/4" HEX.	ISSUE 3-4-44	J.V.W.
KIND	BRASS ROD	CHANGED	
SHAPE		"	
FINISH	WH. NICK #13	"	
TEMP.		"	
PATT.		"	

TITLE:
FISCHER "VC" SHORT WAVE APP.
INDUCTION CABLE SOCKET

H. G. FISCHER & CO.
2335 WABANSIA AVE.
CHICAGO, ILL.

CAT. NO.

PART NO. 15546

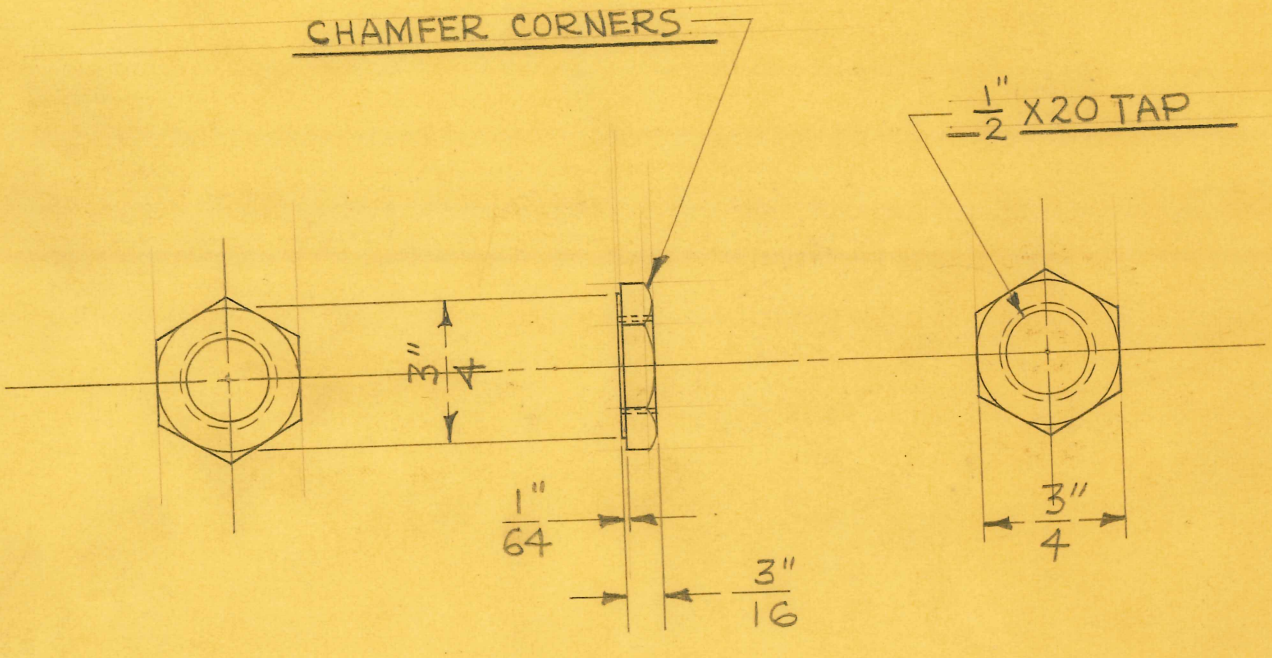

2 REQUIRED

SIZE	3/4" HEX.	ISSUE 2-24-44	J.V.W.	TITLE: FISCHER "VC" SHORT WAVE APP. INDUCTION CABLE SOCKET NUT
KIND	BRASS ROD	CHANGED		
SHAPE		"		
FINISH	WH. NICK. #13	"		
TEMP.		"		
PATT.		"		

H. G. FISCHER & CO.
2335 WABANSIA AVE.
CHICAGO. ILL.

CAT. NO.

PART NO. 15547

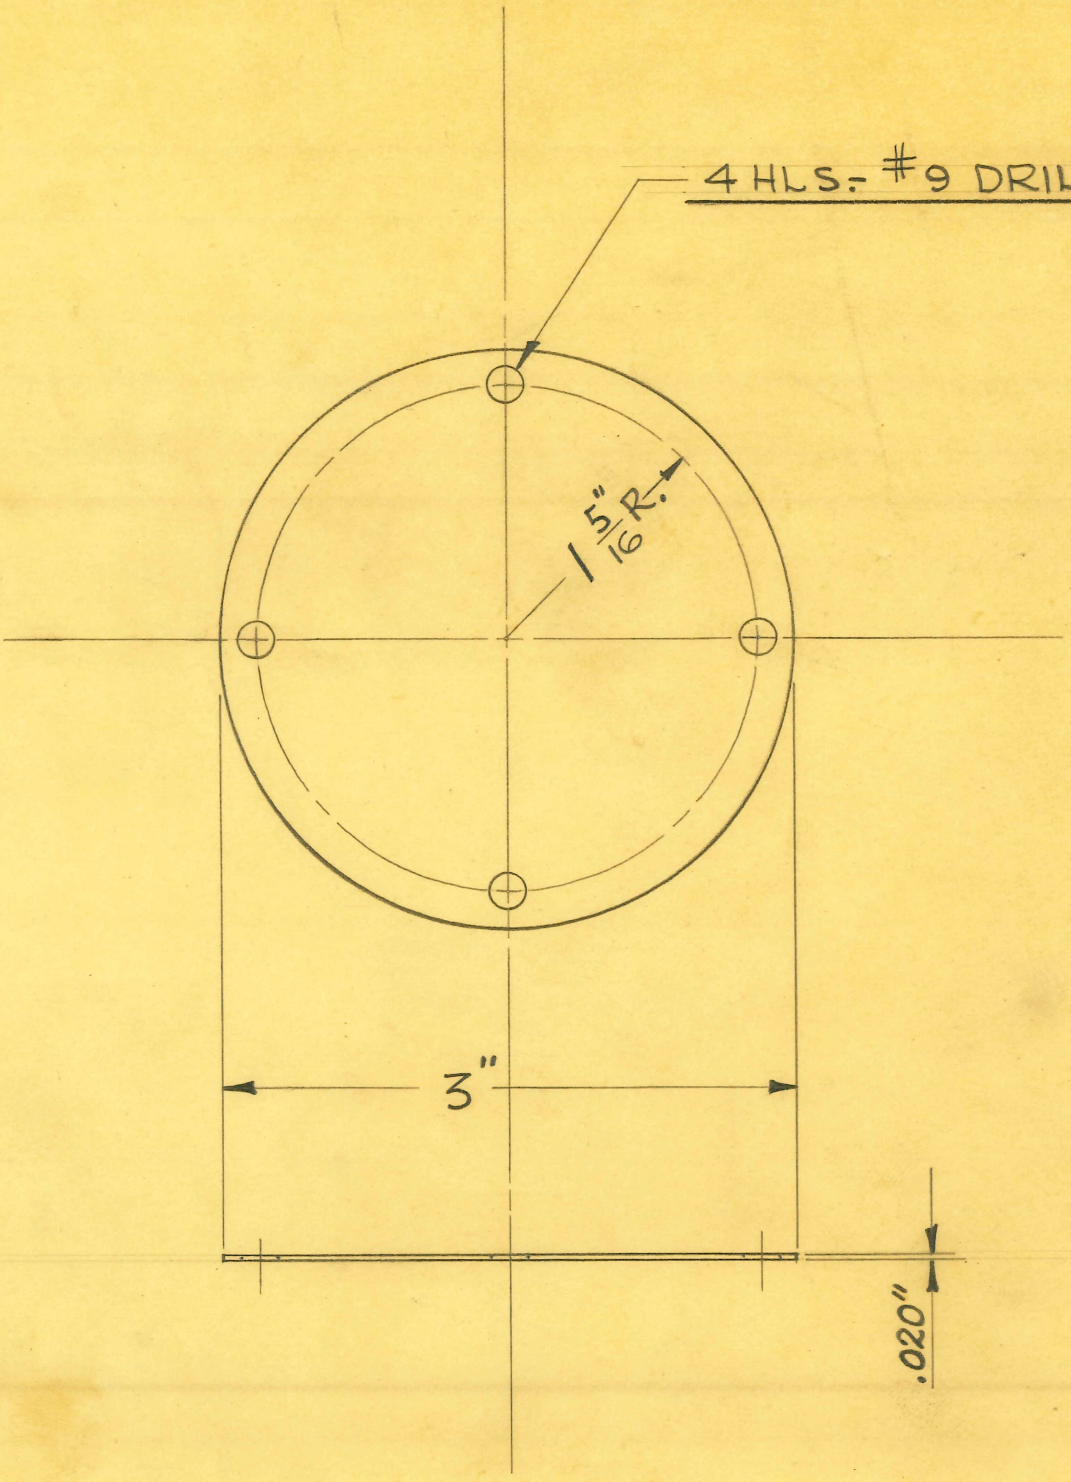

SIZE	.020" SHEET	ISSUE 10-1-46	J.V.W.
KIND	ALUMINUM	CHANGED	
SHAPE		"	
FINISH		"	
TEMP.		"	
PATT.		"	

TITLE:
FISCHER "RF-100" X-RAY UNIT
FILTER DISC ½ mm.

H. G. FISCHER & CO.
2335 WABANSIA AVE.
CHICAGO, ILL.

CAT. NO.

PART NO. 15635

TITLE

FISCHER "RF-100" H.T. TRANSF FILAMENT TRANSF. SUPP. STRAP

H. G. FISCHER & CO.
FRANKLIN PARK, ILLINOIS

DATE 12-11-50 DR. BY J.V.W. CH'K'D.

PART NO. 15636

REVISION	DATE	BY

PATTERN | FINISH | SCALE FULL

TOOLS: DRILL JIG #11498

MATERIAL: $\frac{1}{4}$" X $\frac{1}{2}$" C.R. STEEL BAR

DIMENSIONS UNLESS OTHERWISE SPECIFIED

FRACTIONAL	± .015
DECIMAL	± .005
ANGULAR	± ½°

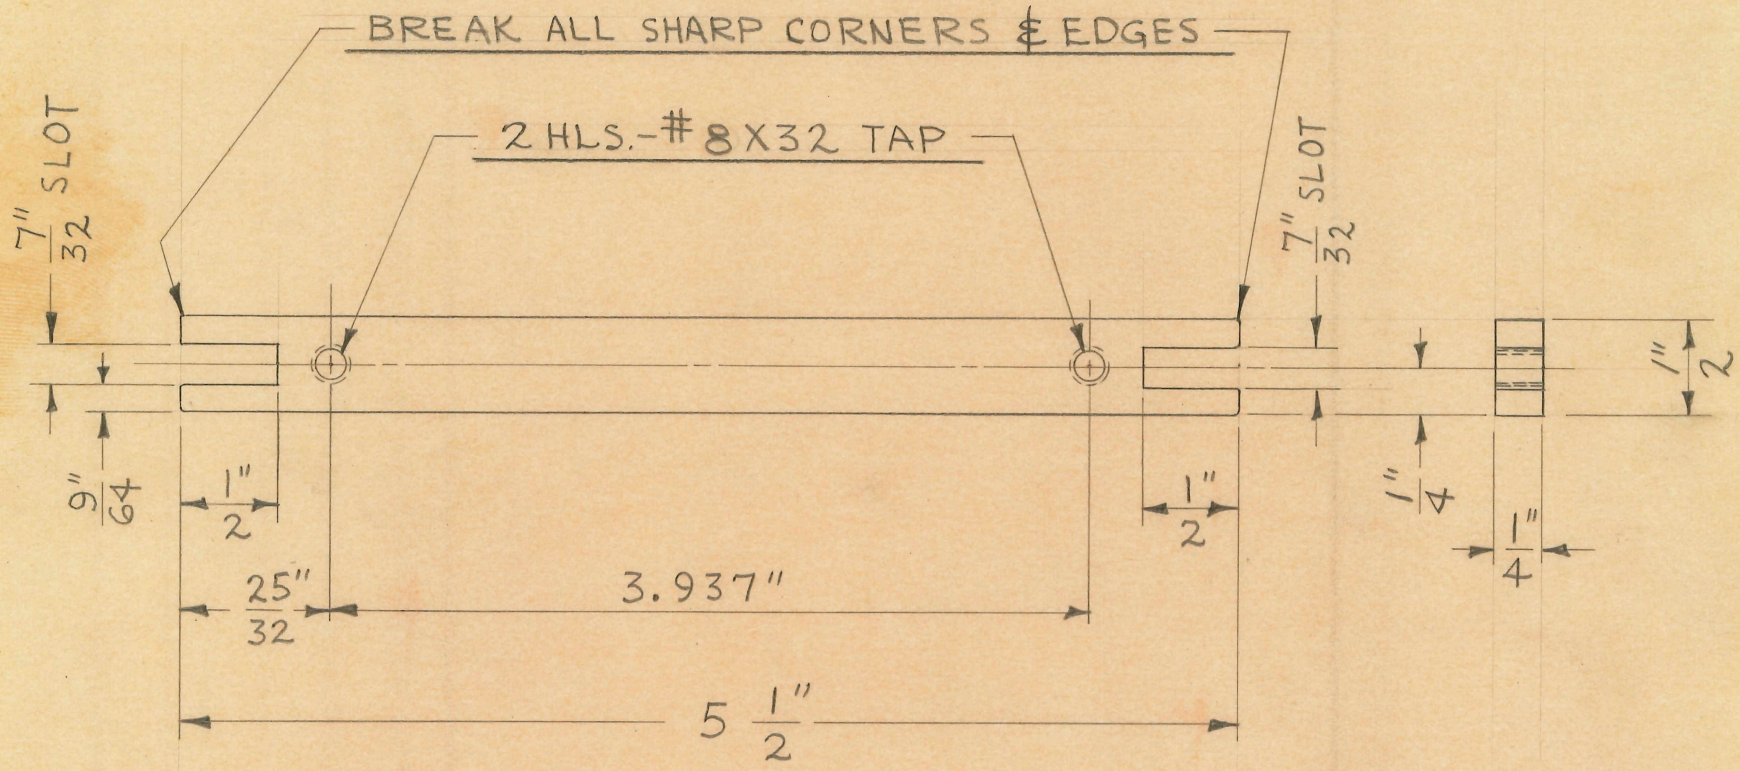

2 REQUIRED

FOLDER #107

$\frac{1}{32}$" X 45° CHAMFER – BOTH ENDS

$\frac{1}{4}$" X 20 THREAD

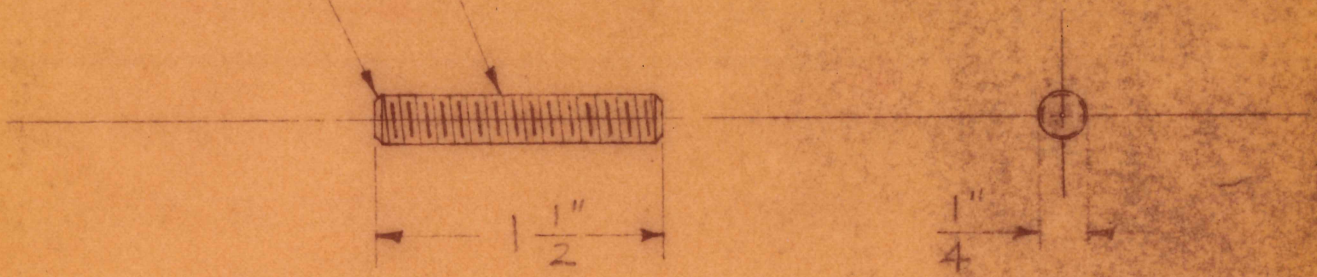

15 REQUIRED

SIZE	¼" DIA.	ISSUE 6-25-46	J.V.W.
KIND	BRASS ROD	CHANGED	
SHAPE		"	
FINISH		"	
TEMP.		"	
PATT.		"	

TITLE:
FISCHER MOD. "RF-100" X-RAY UNIT
FROM 3 PHASE TO SINGLE PHASE TRANSF.
¼" X 20 X 1½" BRASS STUD

H. G. FISCHER & CO.
2338 WABANSIA AVE.
CHICAGO, ILL.

CAT. NO.

PART NO. 15657

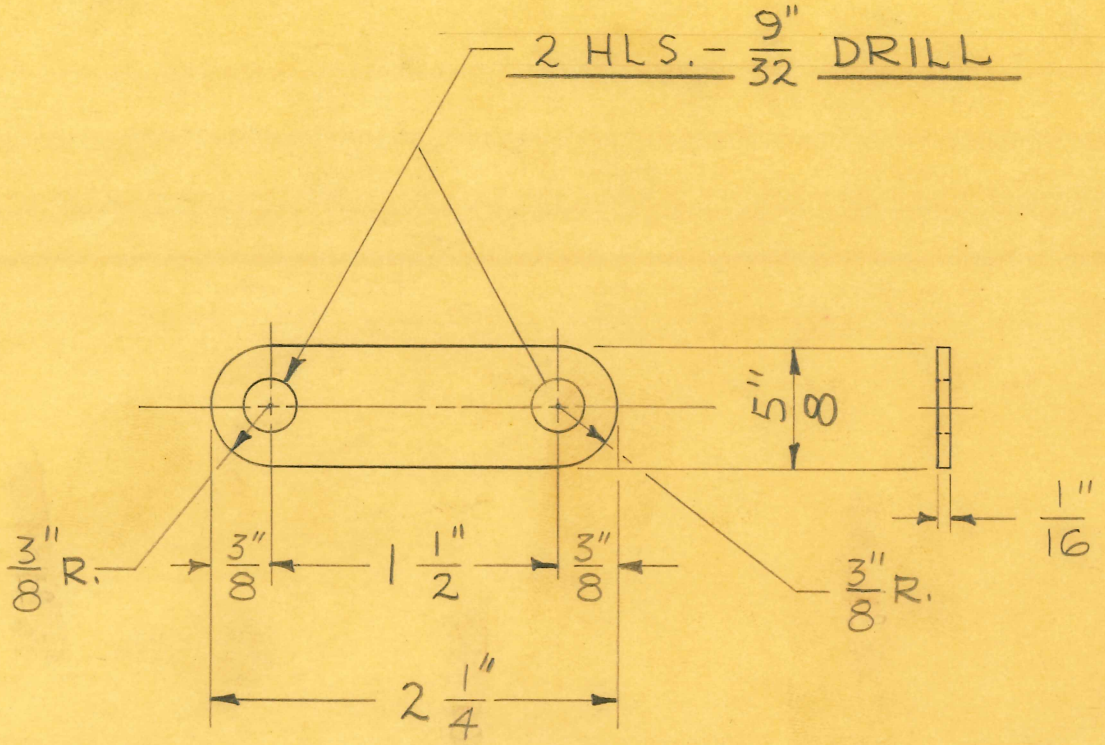

3 REQUIRED

SIZE	1/16" SHEET	ISSUE 6-26-46	J.V.W.
KIND	BRASS	CHANGED	
SHAPE		"	
FINISH		"	
TEMP.		"	
PATT.		"	

TITLE:
FISCHER "RF-100" X-RAY UNIT
FROM 3 PHASE TO SINGLE PHASE
VOLTAGE CHANGE LINK

H. G. FISCHER & CO.
2335 WABANSIA AVE.
CHICAGO, ILL.

CAT. NO.

PART NO. 15658

TITLE
FISCHER MOD. "200" DIA.
MOLTEN METAL DEFLECTOR SPACING BUSHING

H. G. FISCHER & CO.
FRANKLIN PARK, ILLINOIS

PART NO. 17625

DATE 4-13-49 | DR. BY W.J. | CH'K'D. J.V.W.

REVISION	DATE	BY

PATTERN | FINISH | SCALE FULL

TOOLS | MATERIAL $\frac{5}{16}$" DIA. BRASS ROD

DIMENSIONS
FRACTIONAL ± .015
DECIMAL ± .005
ANGULAR ± ½°
UNLESS OTHERWISE SPECIFIED

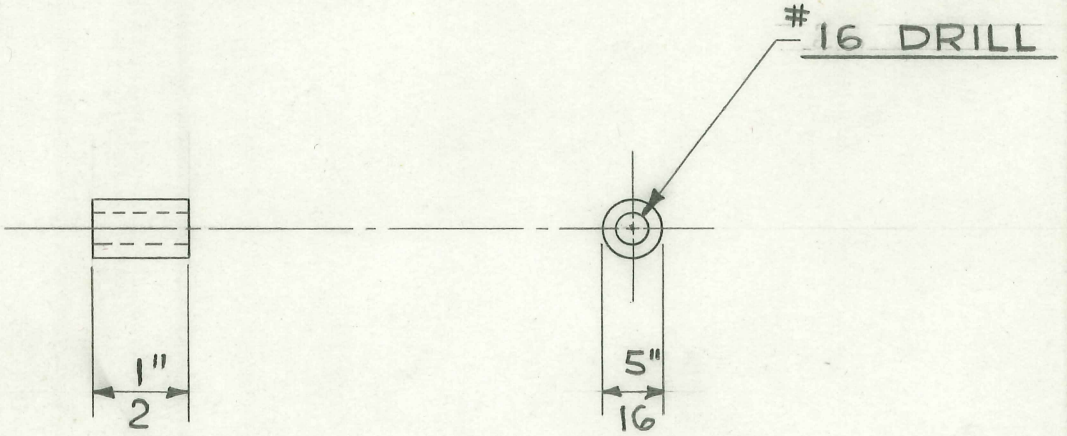

4 REQUIRED

FOLDER #129

6

TITLE
FISCHER MOD. "10" DIATHERMY
CORD STRAIN RELIEF - SMALL

H. G. FISCHER & CO.
FRANKLIN PARK, ILLINOIS

PART NO. 17626

DATE 4-13-49 | DR. BY W. J. | CH'K'D. J.V.W.

REVISION	DATE	BY

PATTERN | FINISH | SCALE FULL

TOOLS

MATERIAL
3/8" O.D. X 5/16" I.D. BRASS TUBING

DIMENSIONS
FRACTIONAL ± .015
DECIMAL ± .005
ANGULAR ± ½°
UNLESS OTHERWISE SPECIFIED

ROUND EDGE INSIDE
& OUT - BOTH ENDS

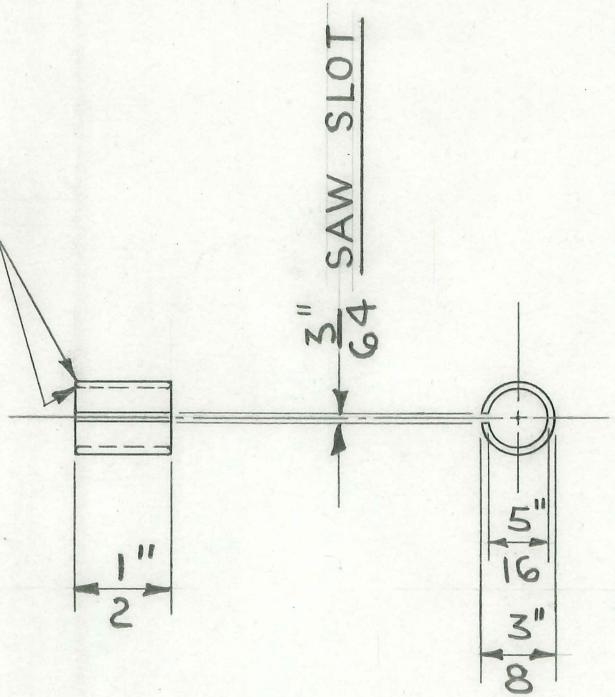

1 REQUIRED

FOLDER #132 6

TITLE

FISCHER "MOD. 10" PORTABLE DIA.

220 VOLT POWER TRANSF. SEC. INSULATOR-BOTTOM

H. G. FISCHER & CO.
FRANKLIN PARK, ILLINOIS

PART NO. 17628

DATE	DR. BY	CH'K'D.
3-25-49	W.J.	J.V.W.

REVISION	DATE	BY

PATTERN | FINISH | SCALE FULL

TOOLS

MATERIAL 1/16" SHEET BLACK CANVAS BASE BAKELITE

DIMENSIONS UNLESS OTHERWISE SPECIFIED

FRACTIONAL	± .015
DECIMAL	± .005
ANGULAR	± ½°

1 REQUIRED

4 HLS. #26 DRILL

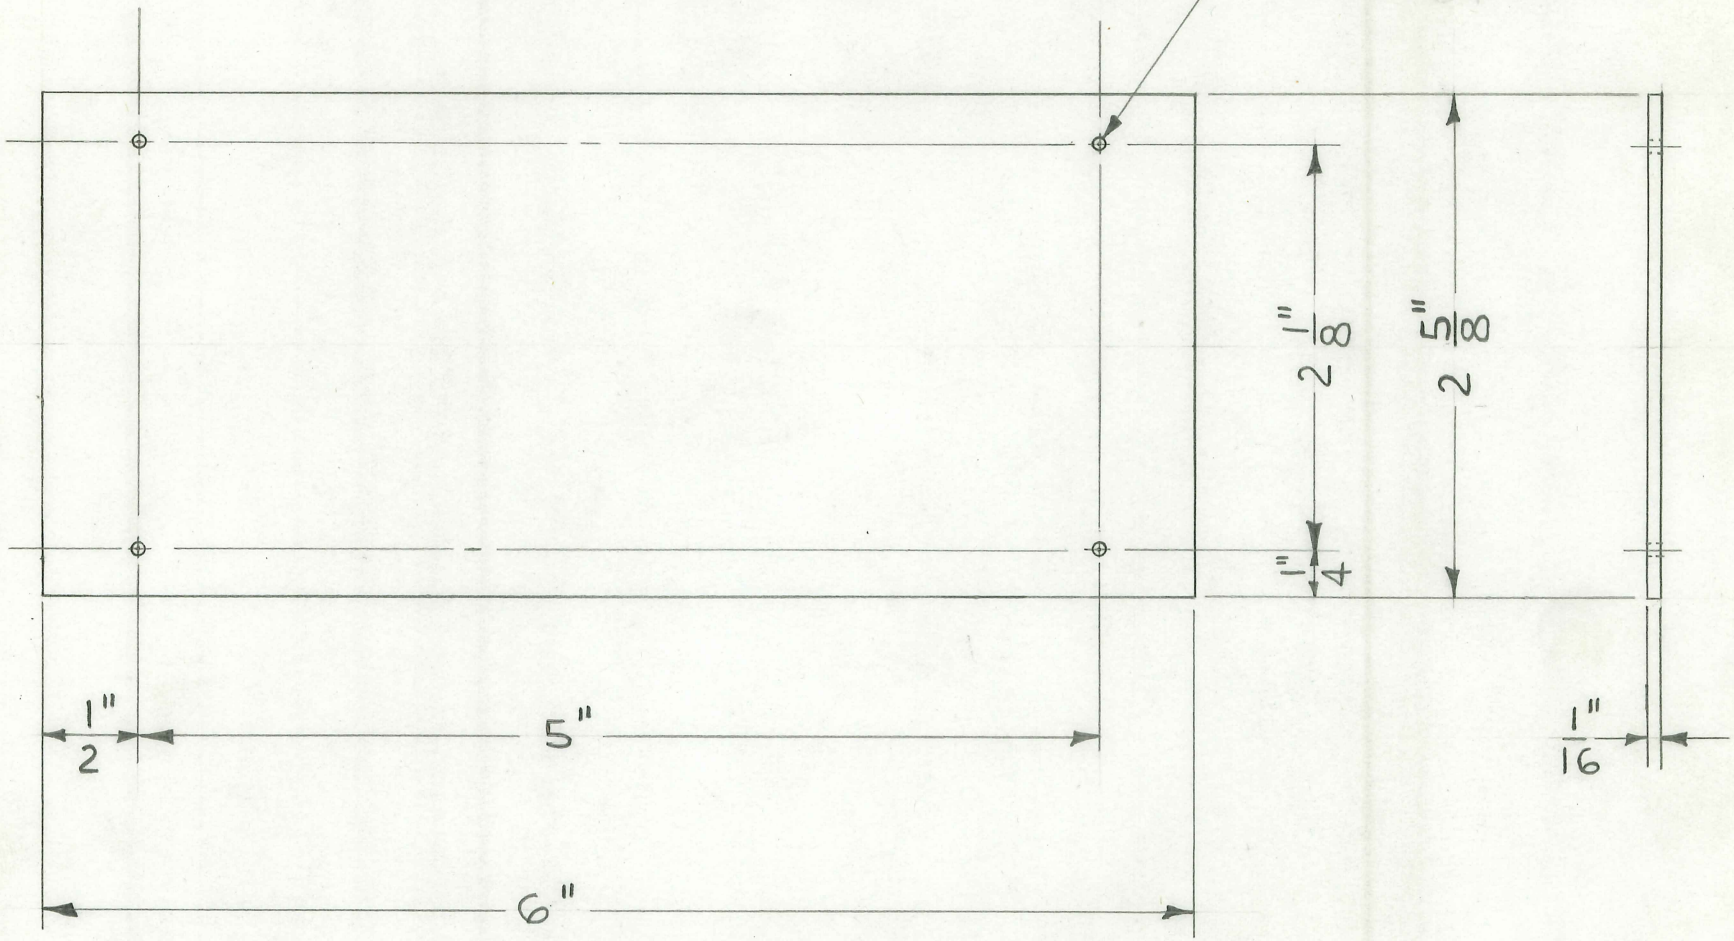

FOLDER #132

TITLE

CSA APPROVAL PLATE

H. G. FISCHER & CO.
FRANKLIN PARK, ILLINOIS

PART NO. 17634A

DATE 4-11-61 | DR BY J.V.W. | CH'K'D. JK

REVISION	DATE	BY

PATTERN | FINISH | SCALE DOUBLE SIZE

TOOLS | MATERIAL .003" FOIL ALUMINUM

DIMENSIONS UNLESS OTHERWISE SPECIFIED
FRACTIONAL ± .015
DECIMAL ± .005
ANGULAR ± ½°

SELF ADHERING BACKED (WATER LOOSENING CELLOPHANE PROTECTIVE FILM)

FINISH: LETTERING & RECTANGULAR BLOCK – BLEACHED ALUMINUM
BACKGROUND – DULL BLACK

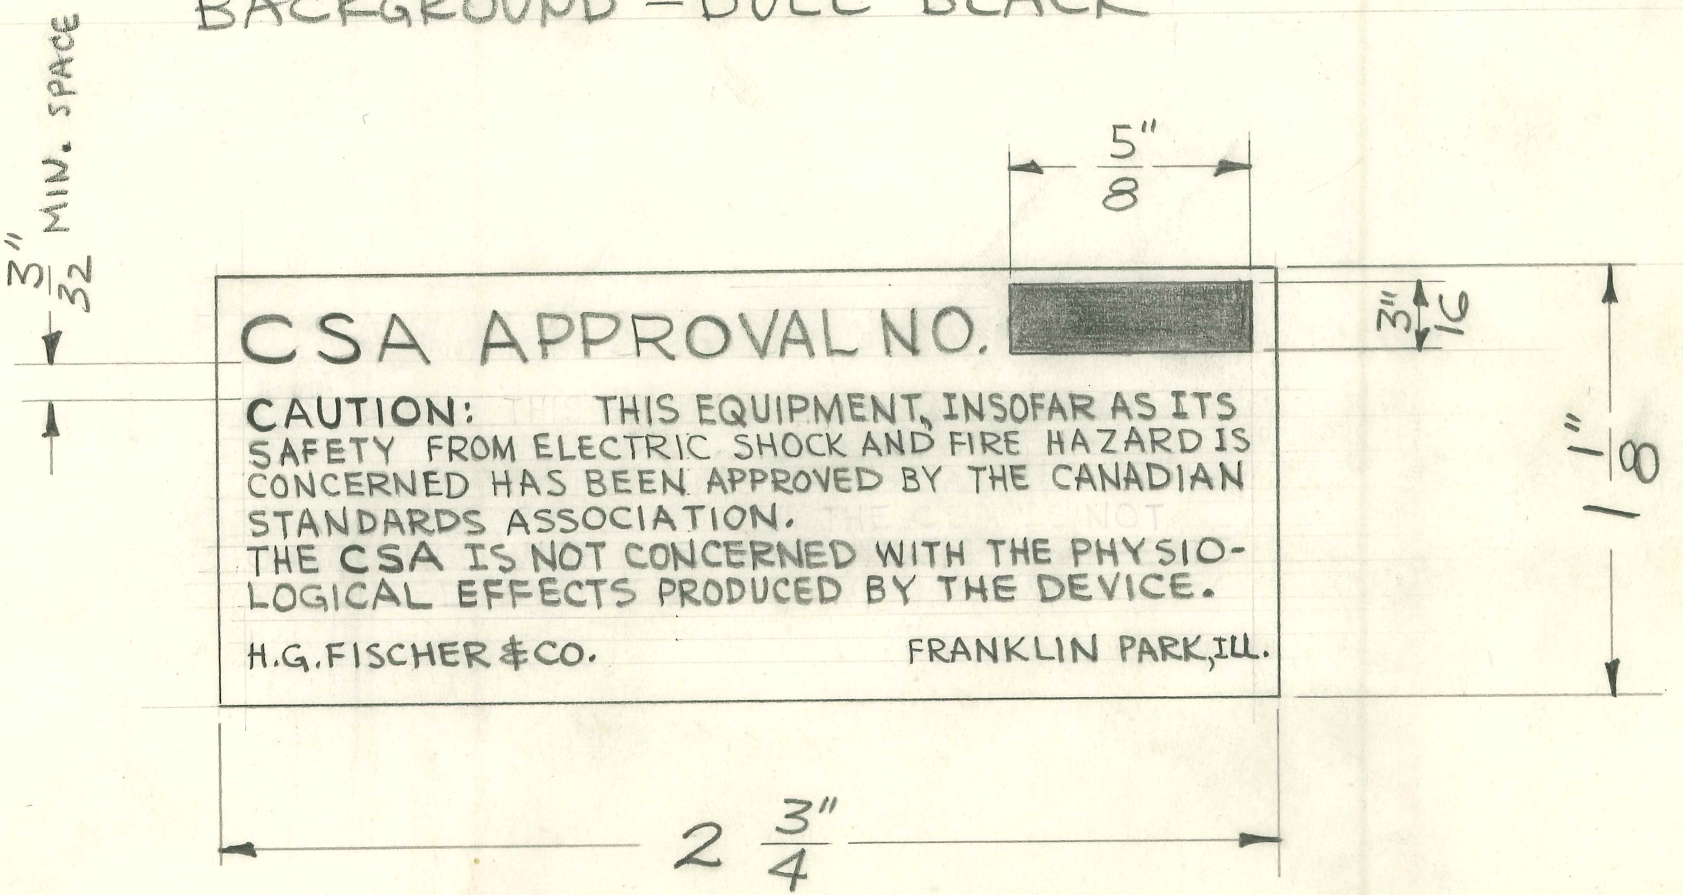

FOLDER #132

TITLE

FISCHER MOD. "10" DIATHERMY

FARRADAY PICK UP LOOP TUBE - FINISHED

H. G. FISCHER & CO.
FRANKLIN PARK, ILLINOIS

DATE 3-3-49 | DR. BY W.J. | CH'K'D. J.V.W.

PART NO. 17635

REVISION	DATE	BY

PATTERN | FINISH | SCALE FULL

TOOLS: RADIUS c'BORE. #11039

MATERIAL: .250" O.D. X .030" WALL SOFT COPPER TUBING

DIMENSIONS
FRACTIONAL ± .015
DECIMAL ± .005
ANGULAR ± ½°
UNLESS OTHERWISE SPECIFIED

2 REQUIRED

TRIM TO DIMENSION & ROUND EDGES INSIDE & OUT AS SHOWN - BOTH ENDS

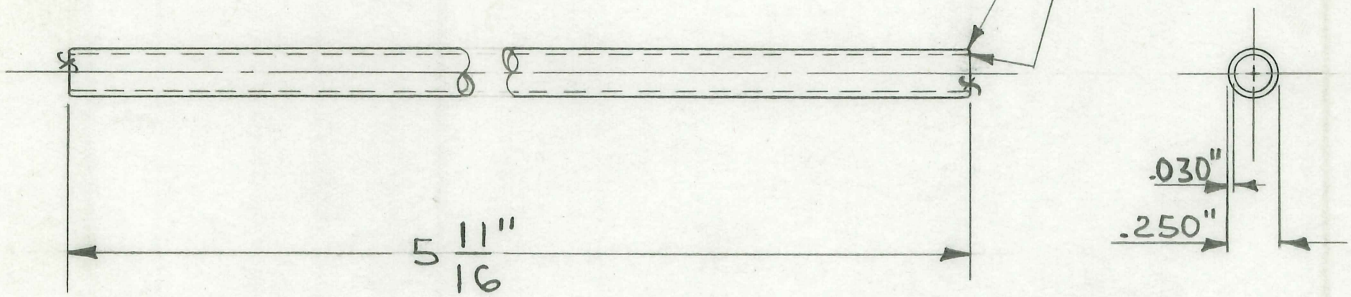

FOLDER #132

TITLE FISCHER MOD. "10" DIATHERMY
MODEL "300" DIATHERMY
THERMAL COMPENSATOR STOP ADJ.

H. G. FISCHER & CO.
FRANKLIN PARK, ILLINOIS

DATE 2-11-49 | DR. BY W.J. | CH'K'D. J.V.W.

PART NO. 17636

REVISION	DATE	BY

PATTERN | FINISH CAD. #23 | SCALE FULL

TOOLS: DRILL JIG #9819

MATERIAL: 1/8" X 3/4" FLAT WIRE

DIMENSIONS UNLESS OTHERWISE SPECIFIED
FRACTIONAL ± .015
DECIMAL ± .005
ANGULAR ± ½°

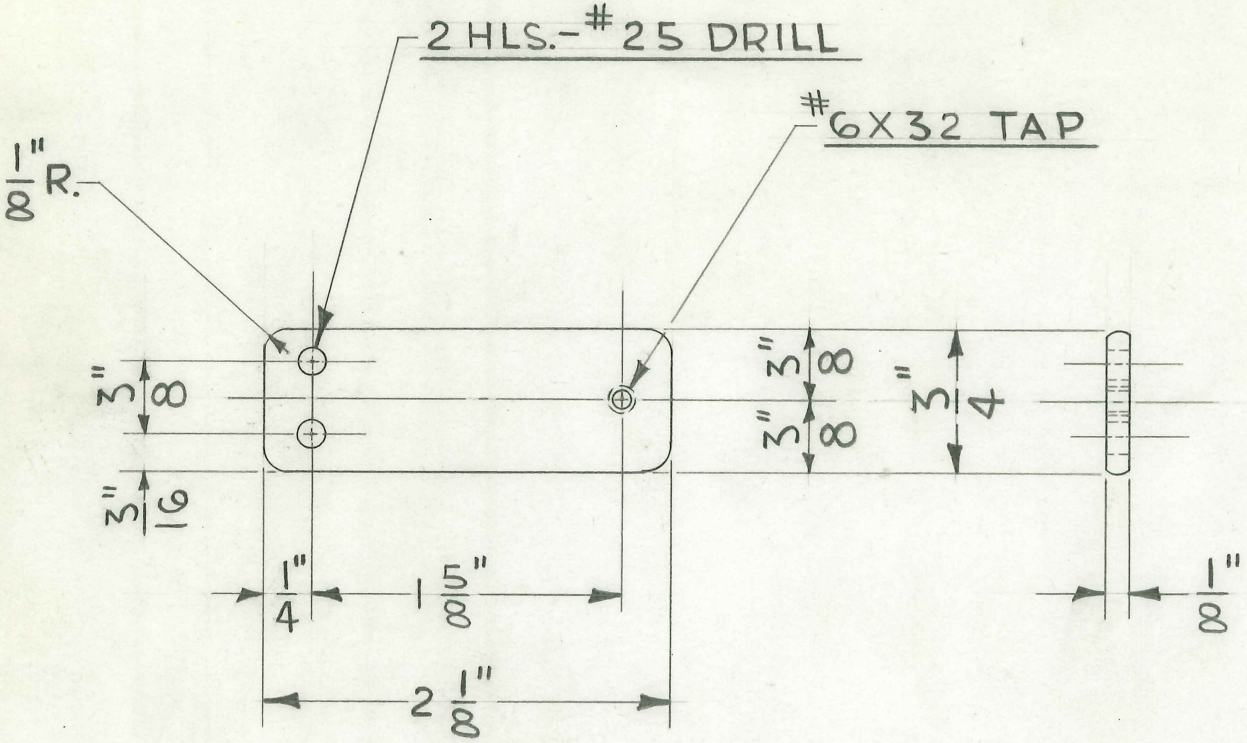

1 REQUIRED

FOLDER #133

TITLE
FISCHER WALL FRAME TILTING BUCKY STAND
C'WEIGHT FOR 8"X10" & 10"X12" BUCKY

H. G. FISCHER & CO.
FRANKLIN PARK, ILLINOIS

DATE 1-7-49 | DR. BY W.J. | CH'K'D. J.V.W.

PART NO. 17638AF

REVISION	DATE	BY
A GROOVES REMOVED	5-11-49	W.J.

PATTERN | FINISH | SCALE FULL

TOOLS | MATERIAL 1 3/4 DIA. C.R. STEEL ROD

DIMENSIONS UNLESS OTHERWISE SPECIFIED
FRACTIONAL ± .015
DECIMAL ± .005
ANGULAR ± ½°

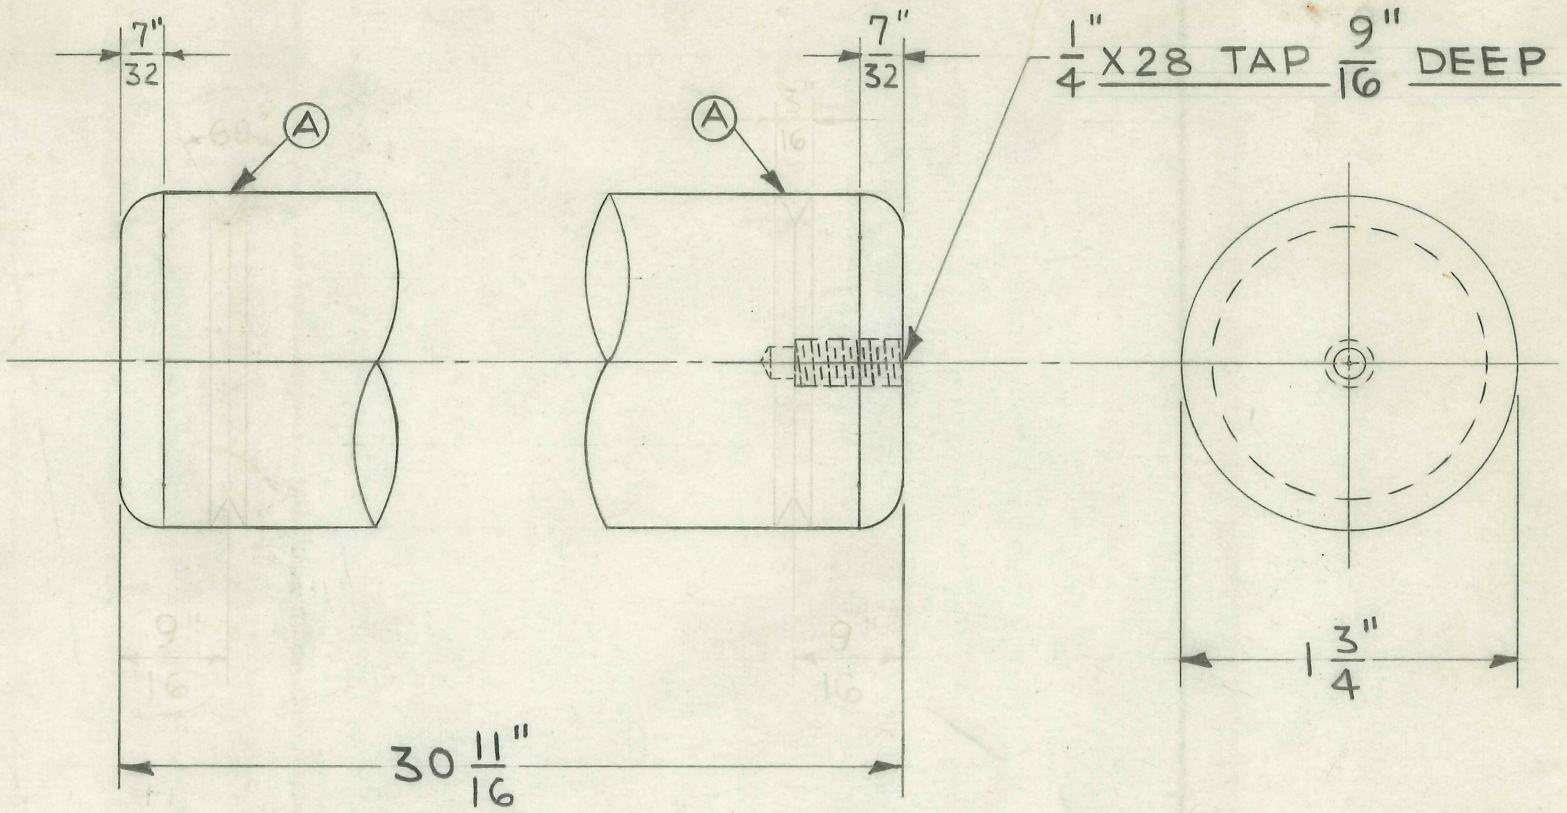

2 REQUIRED

APPROX. 21 Lbs.

FOLDER #134

TITLE
FISCHER WALL FRAME TILTING BUCKY STAND
C'WEIGHT FOR 8"X10" #21444GT-6 AUTOMATIC BUCKY CWT.

H. G. FISCHER & CO.
FRANKLIN PARK, ILLINOIS

PART NO. 17638 1/2

DATE 6-10-70 | DR. BY J.V.W. | CH'K'D J.V.W.

REVISION	DATE	BY

PATTERN | FINISH | SCALE FULL

TOOLS | MATERIAL 1 3/4" DIA. C.R. STEEL ROD

DIMENSIONS UNLESS OTHERWISE SPECIFIED
FRACTIONAL ± .015
DECIMAL ± .005
ANGULAR ± ½°

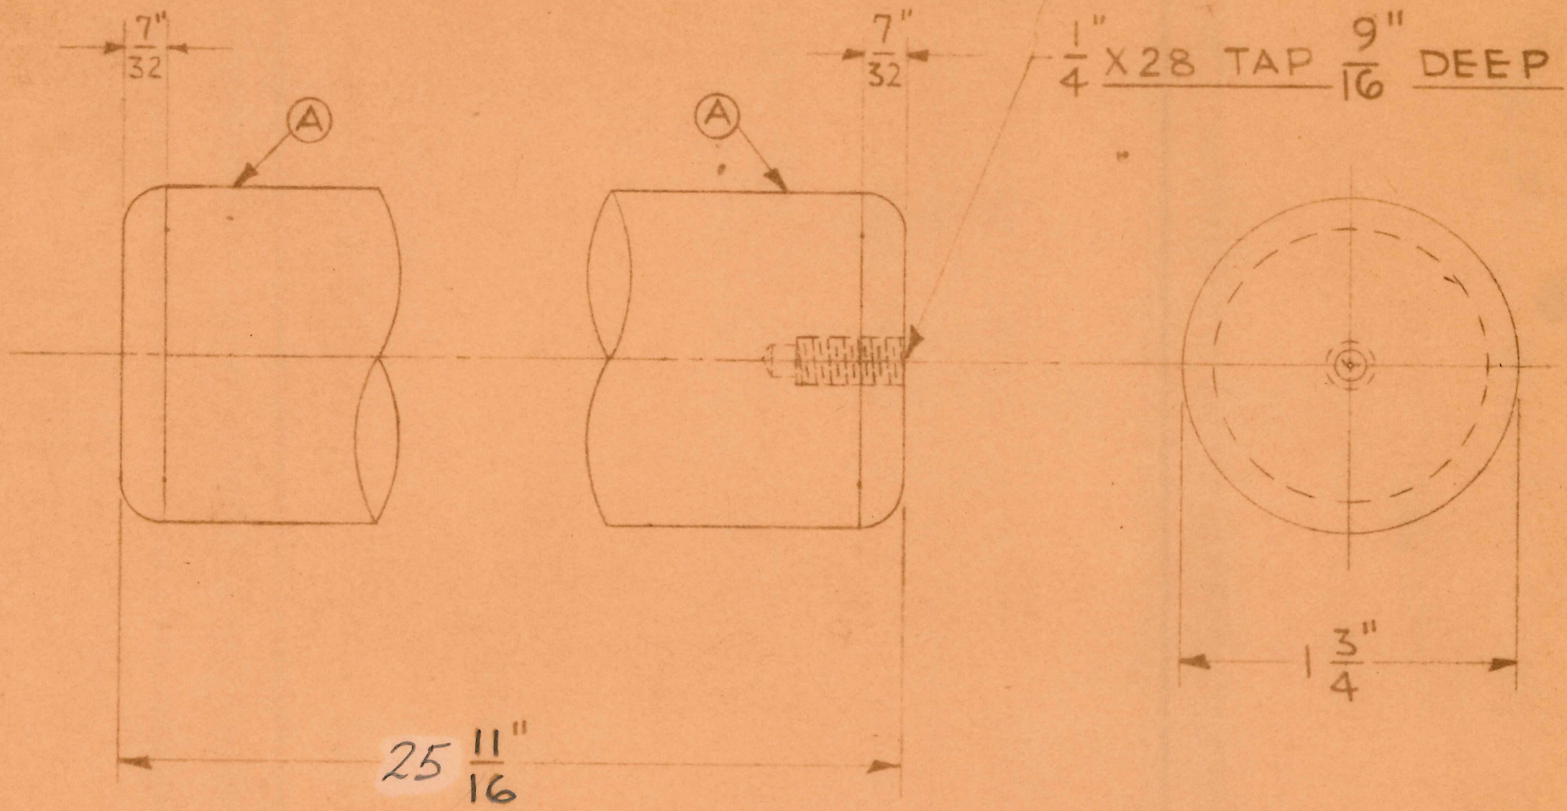

2 REQUIRED

APPROX. 17½ #LBS.

FOLDER #134

TITLE: FISCHER MOD. "300" DIATHERMY AUXILIARY PLATE

H. G. FISCHER & CO.
FRANKLIN PARK, ILLINOIS

PART NO. 17639½

DATE 1-26-50 | DR. BY J.V.W. | CH'K'D.

REVISION	DATE	BY

PATTERN | FINISH | SCALE FULL

TOOLS | MATERIAL: .040" SHEET ALUMINUM

DIMENSIONS UNLESS OTHERWISE SPECIFIED
FRACTIONAL ± .015
DECIMAL ± .005
ANGULAR ± ½°

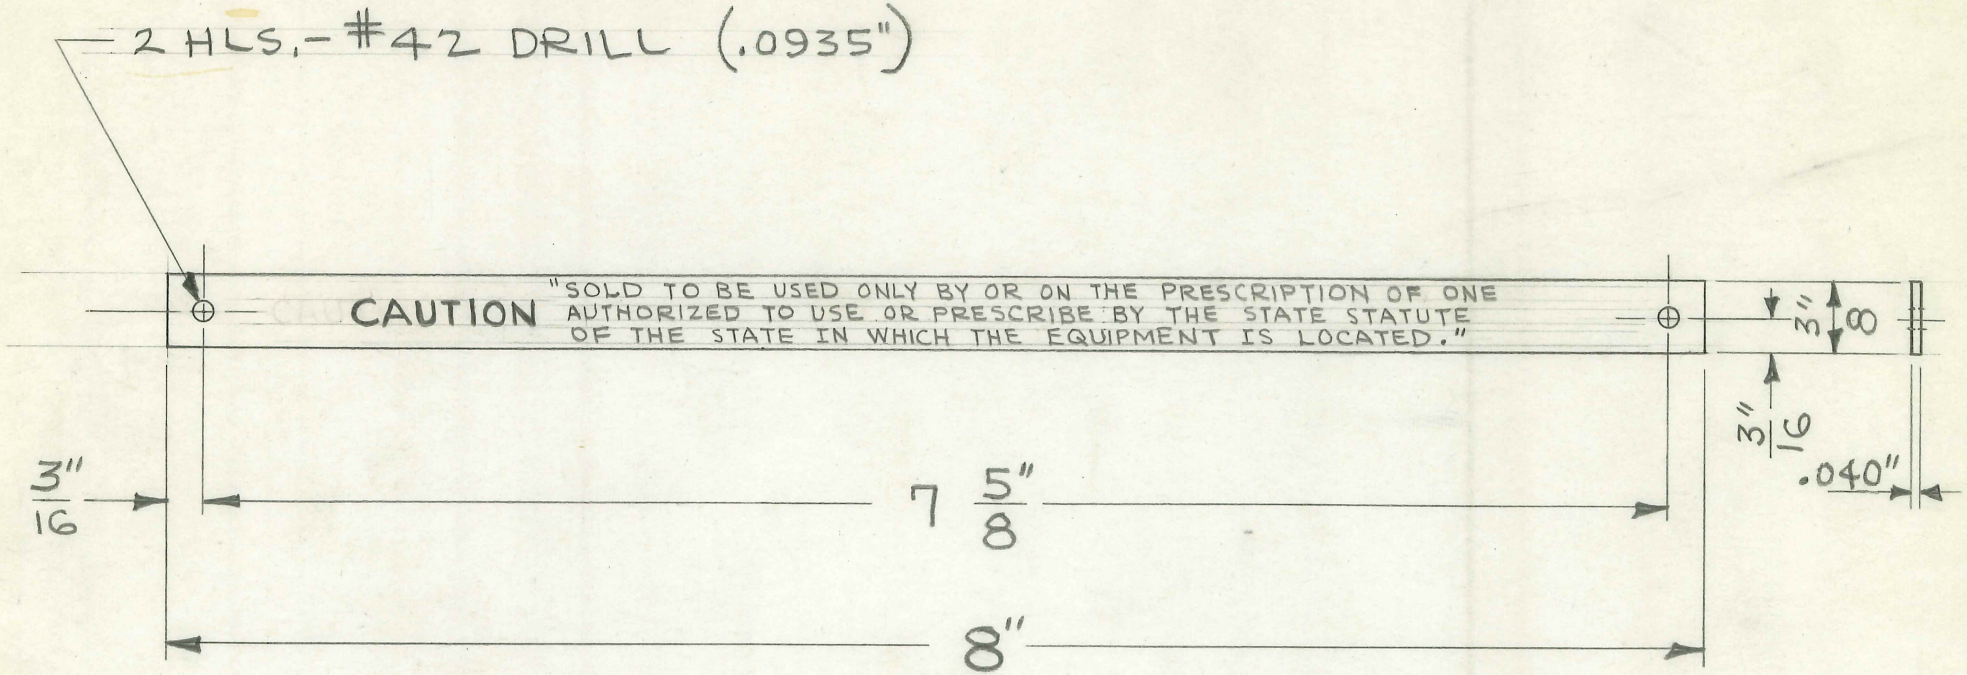

LETTERING - PLAIN ANODIZED ALUMINUM
BACKGROUND - BLACK ANODIZED ALUMINUM
NO BORDER

Note:
THIS PLATE TO BE USED ONLY TO COVER CAUTION NOTE ON CROWE PLATE FISCHER #17639.
AFTER ALL PLATES #17639 IN FISCHER STOCK ARE COVERED WITH THIS NEW CAUTION PLATE THIS PLATE WILL NO LONGER BE NEEDED

FOLDER #133

TITLE: FISCHER MOD. "10" DIATHERMY FOOT SWITCH ADAPTER CONN. CAP ONLY

H. G. FISCHER & CO.
FRANKLIN PARK, ILLINOIS

DATE 12-4-48 DR. BY J.V.W. CH'K'D.

PART NO. 17642F
17643

REVISION	DATE	BY

PATTERN | FINISH | SCALE FULL

TOOLS: DRILL JIG #10007

MATERIAL: CAP FROM { PCE. #17341 OR PCE. #17642

DIMENSIONS
FRACTIONAL ± .015
DECIMAL ± .005
ANGULAR ± ½°
UNLESS OTHERWISE SPECIFIED

2 HLS. - #35 DRILL
C'SUNK. TO $\frac{13}{64}$" FACE

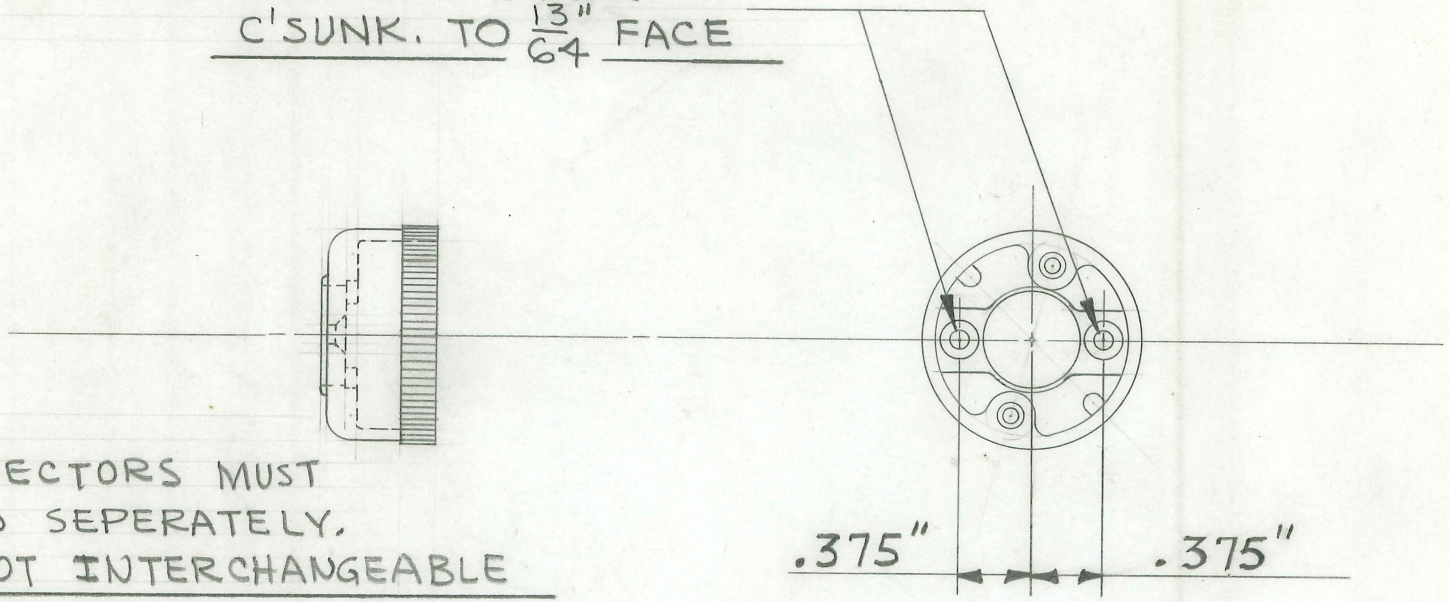

THESE CONNECTORS MUST
BE HANDLED SEPERATELY.
CAPS ARE NOT INTERCHANGEABLE

REMOVE THIS CAP FROM BODY - DRILL & C'SINK.
THEN REASSEMBLE

1 REQUIRED

FOLDER #132

TITLE

FISCHER MOD. "10 A" DIATHERMY
25 CYCLE CABINET BASE COVER SPACER

H. G. FISCHER & CO.
FRANKLIN PARK, ILLINOIS

DATE 2-20-53 | DR. BY W.J. | CH'K'D. J.V.W.

PART NO. 17652 1/2

REVISION	DATE	BY

PATTERN | FINISH | SCALE FULL

TOOLS | MATERIAL 1/2" DIA. BRASS ROD

DIMENSIONS
FRACTIONAL ± .015
DECIMAL ± .005
ANGULAR ± ½°
UNLESS OTHERWISE SPECIFIED

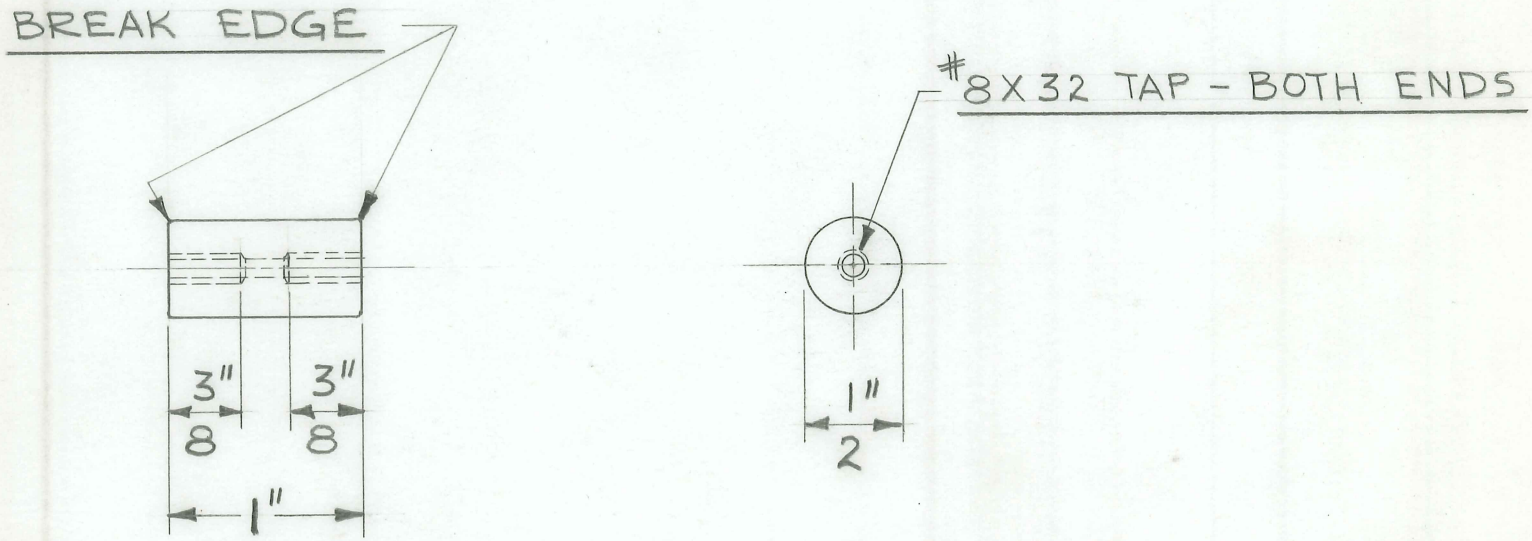

2 REQUIRED

FOLDER #132

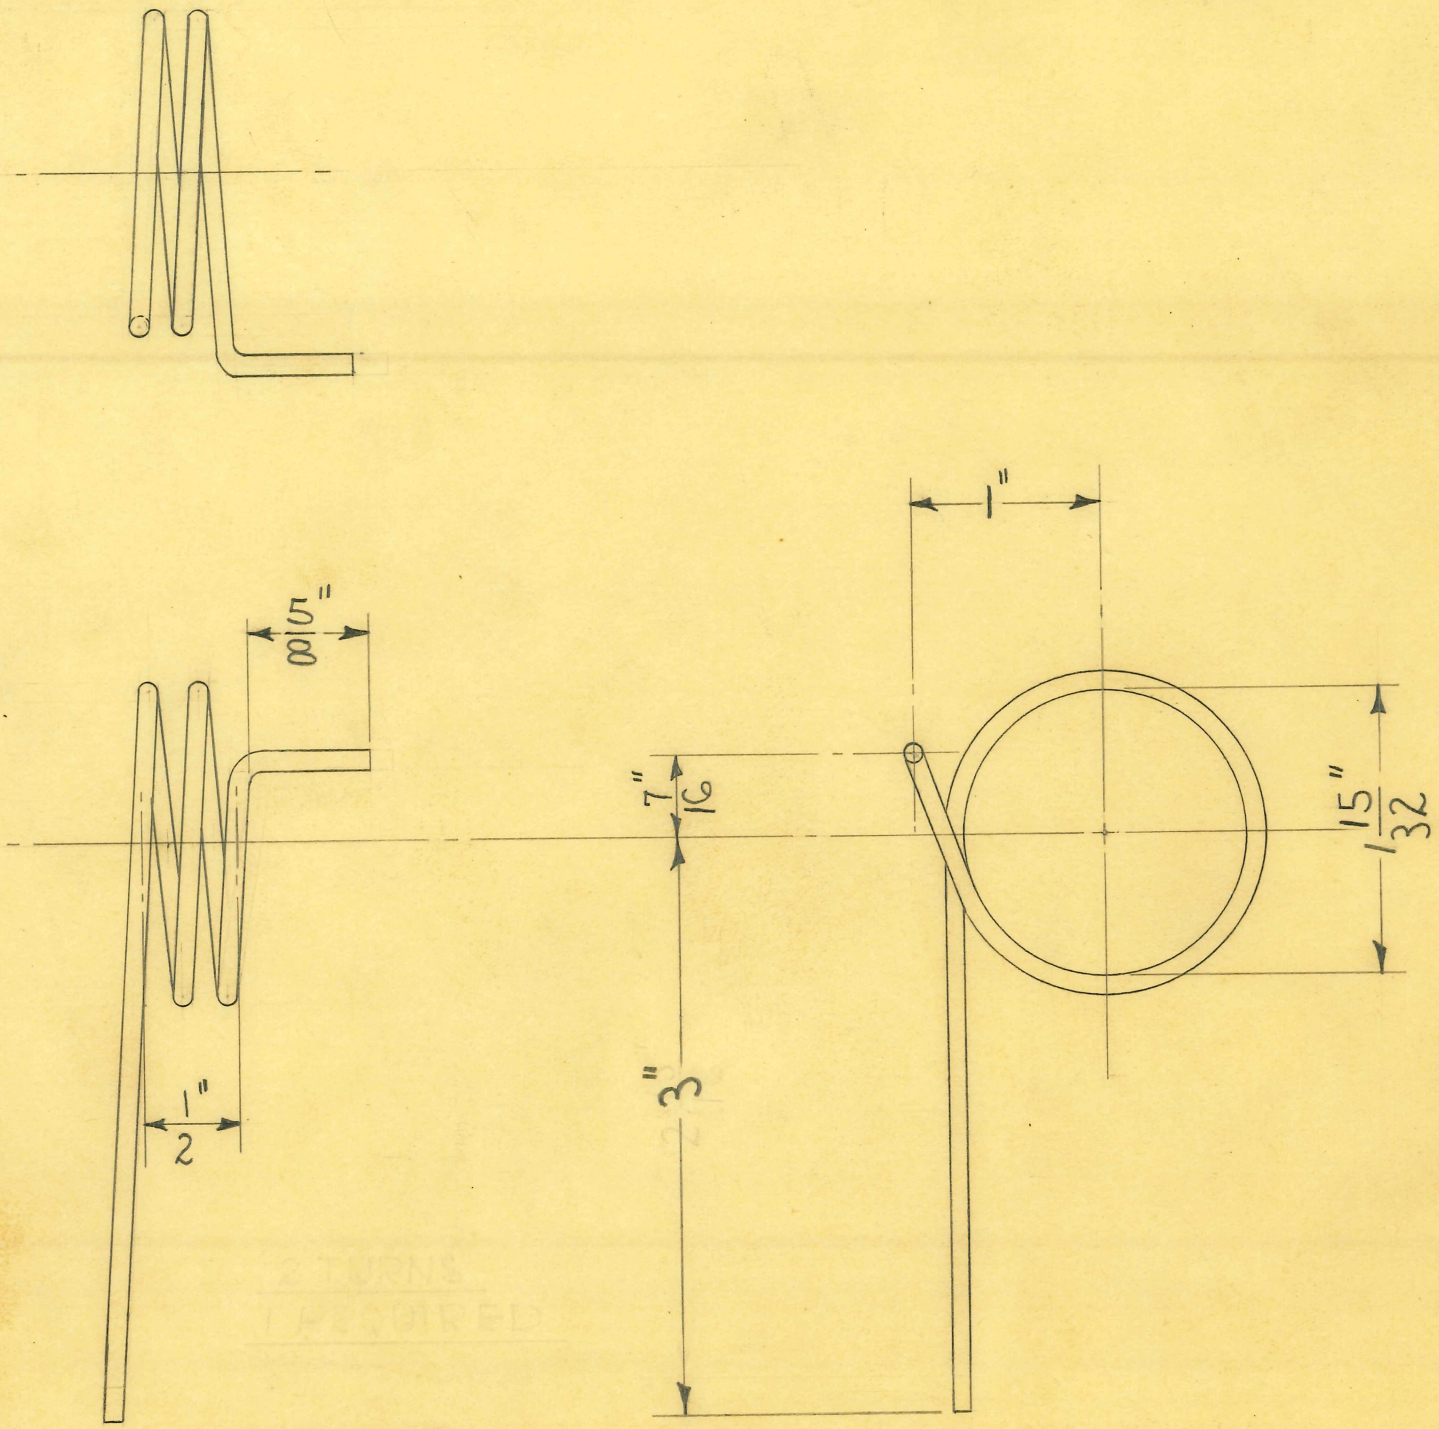

2 TURNS

1 REQUIRED

FORMING MANDREL TOOL #9009-9023

DIMENSIONS	
FRACTIONAL	± .015
DECIMAL	± .005
ANGULAR	± 1/2°

UNLESS OTHERWISE SPECIFIED

SIZE	#10 GA. (.102")	ISSUE 5-12-48	W.J.
KIND	BARE COPPER	CHANGED	
SHAPE	WIRE	"	
FINISH		"	
TEMP.		"	
PATT.		"	

TITLE: FISCHER MOD. "10" DIATHERMY
MODEL "300" PORTABLE DIATHERMY
LINK CIRCUIT COIL - RIGHT

H. G. FISCHER & CO.
2335 WABANSIA AVE.
CHICAGO, ILL.

CAT. NO.

PART NO. 17656

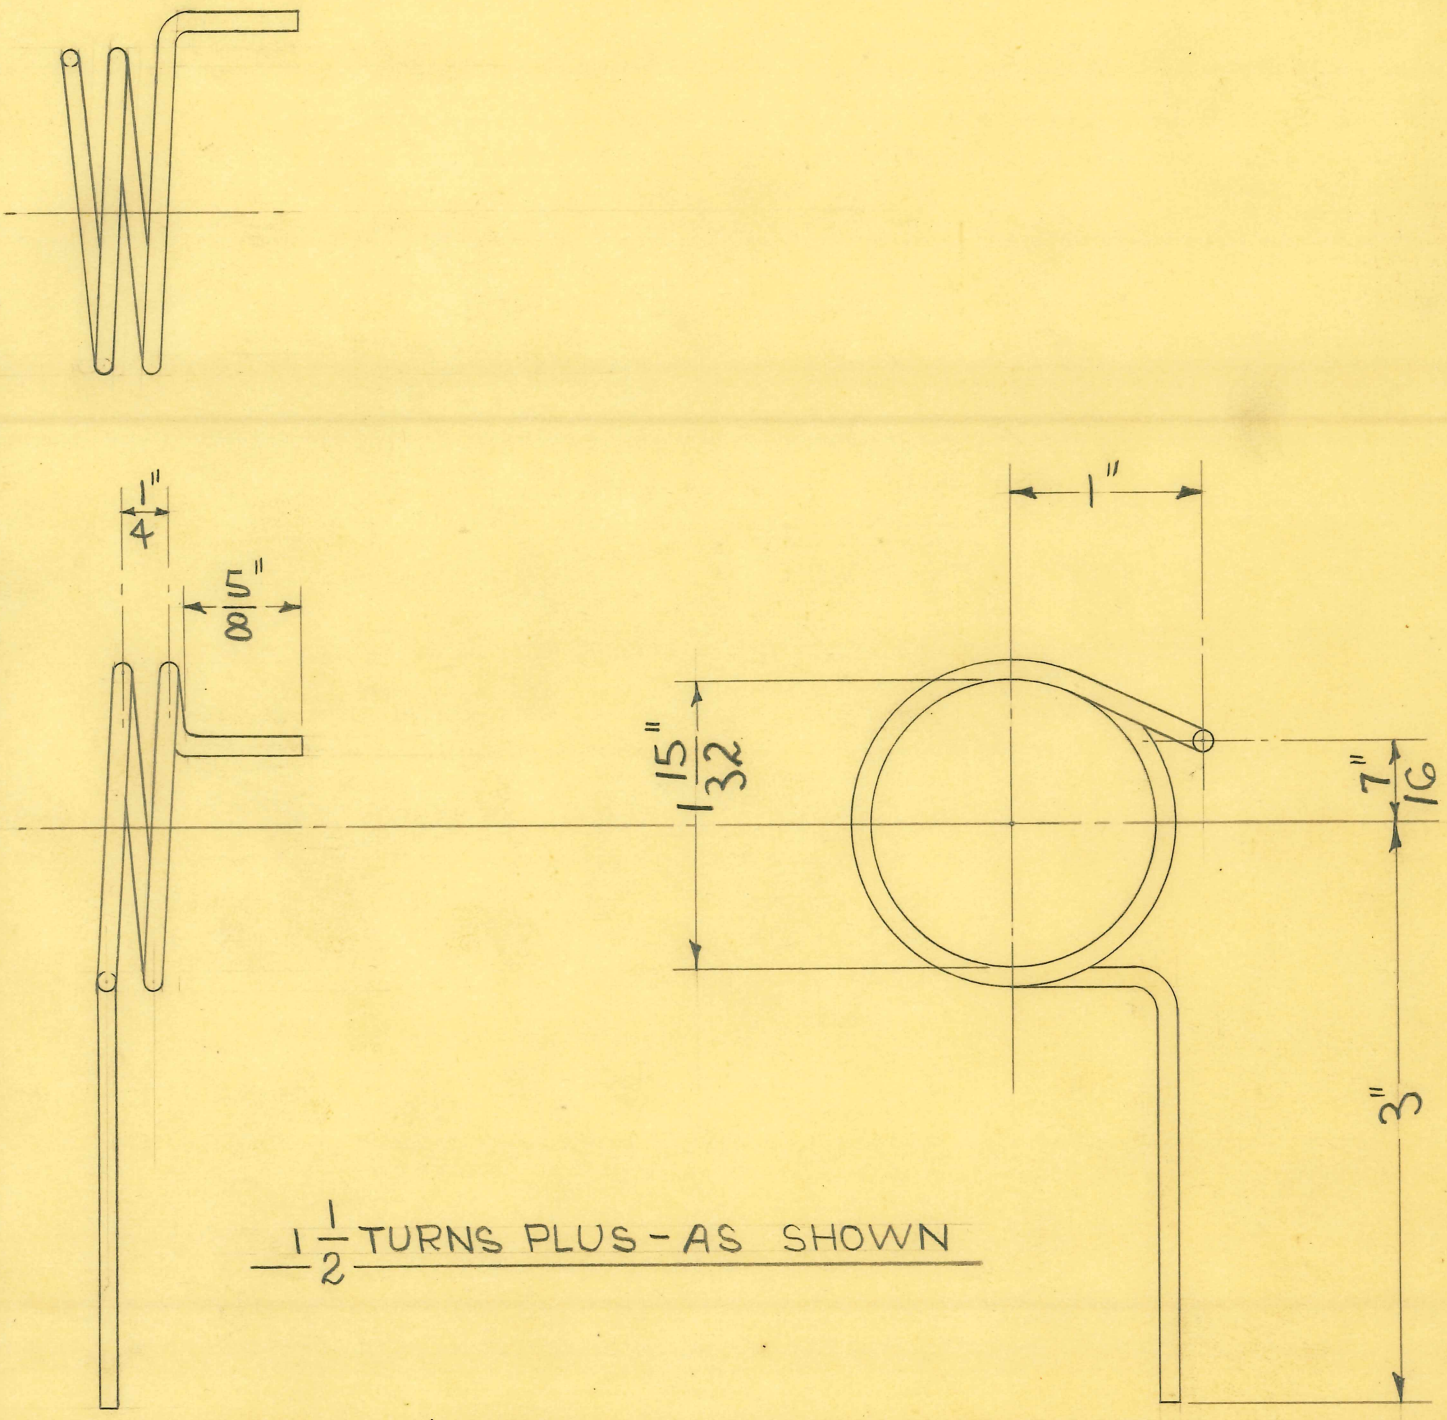

1 1/2 TURNS PLUS - AS SHOWN

1 REQUIRED

FORMING MANDREL TOOL #9009-9023

DIMENSIONS	
FRACTIONAL	± .015
DECIMAL	± .005
ANGULAR	± 1/2°

UNLESS OTHERWISE SPECIFIED

SIZE	#10GA.(.102")	ISSUE 5-12-48	W.J.
KIND	BARE COPPER	CHANGED	
SHAPE	WIRE	"	
FINISH		"	
TEMP.		"	
PATT.		"	

TITLE: FISCHER MOD. "10" DIATHERMY
MODEL "300" PORTABLE DIATHERMY
LINK CIRCUIT COIL - LEFT

H. G. FISCHER & CO.
2335 WABANSIA AVE.
CHICAGO, ILL.

CAT. NO.

PART NO. 17657

NEXT ASSEMBLY	
NUMBER	QTY.

NUMBER 17659

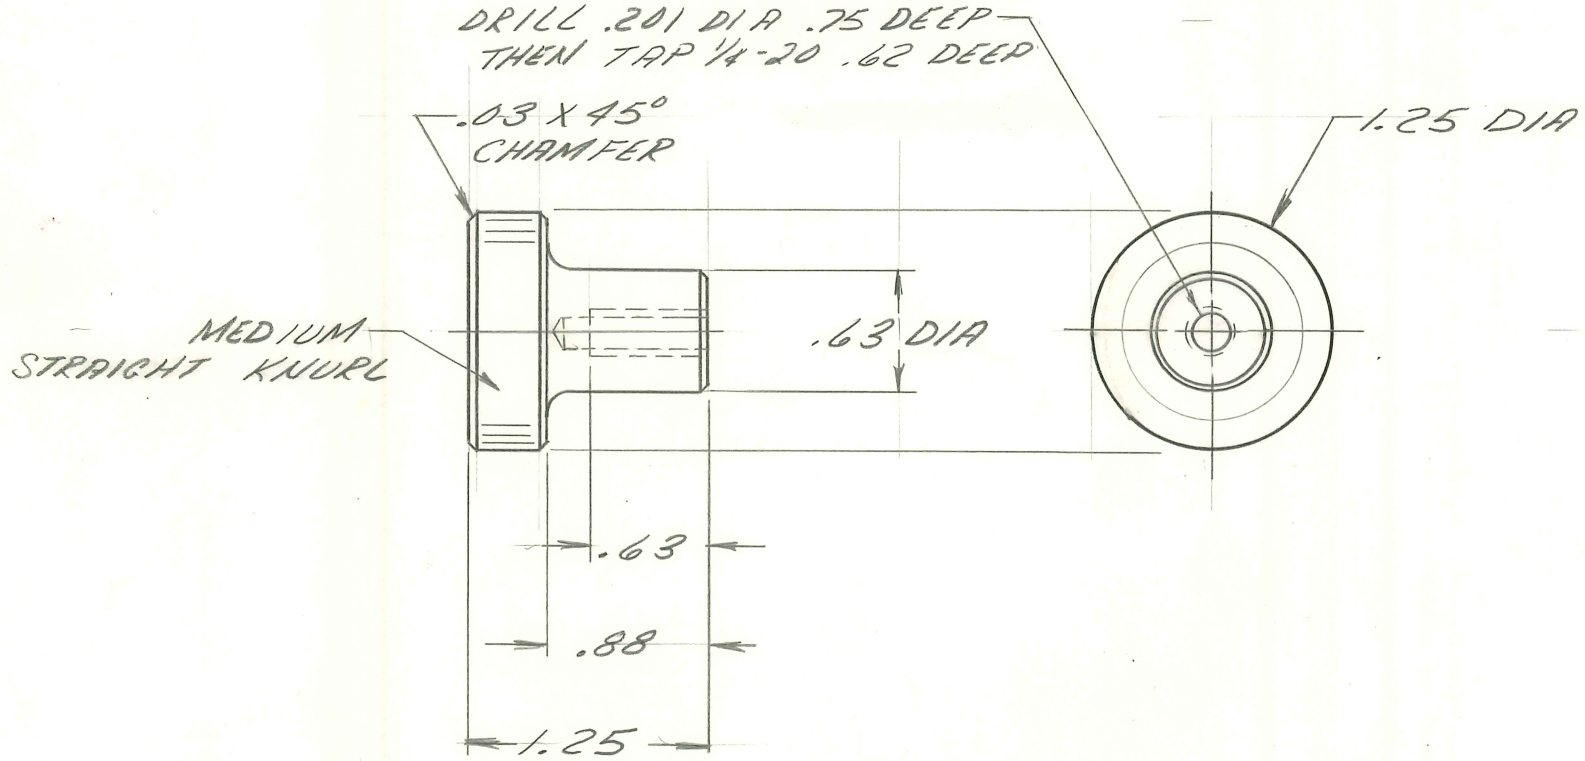

LTR	DESCRIPTION	ECO	DATE

REVISIONS

UNLESS OTHERWISE SPECIFIED
DIMENSIONS ARE IN : INCHES
TOLERANCES

DECIMALS			ANGLES
.X	.XX	.XXX	±½°
±.030	±.010	±.005	

MATERIAL: 1¼ DIA CRS

SPEC. NO.

~~ENG. SPEC.~~ FIN 123

SPEC. NO.

GRACO
Minneapolis, Minn.

DRAWN 5-23-12 Michael

CHECKED KVS 5-23-12

ENGINEER

APPROVED

TITLE: TILTING FRAME LOCK KNOB

FEDERAL STOCK NO.

SIZE	CODE IDENT. NO.	NUMBER
A		17659

SCALE	NET WEIGHT	SHEET 1 OF 1

GRACO FORM NO. 315-093 REV. 9-71

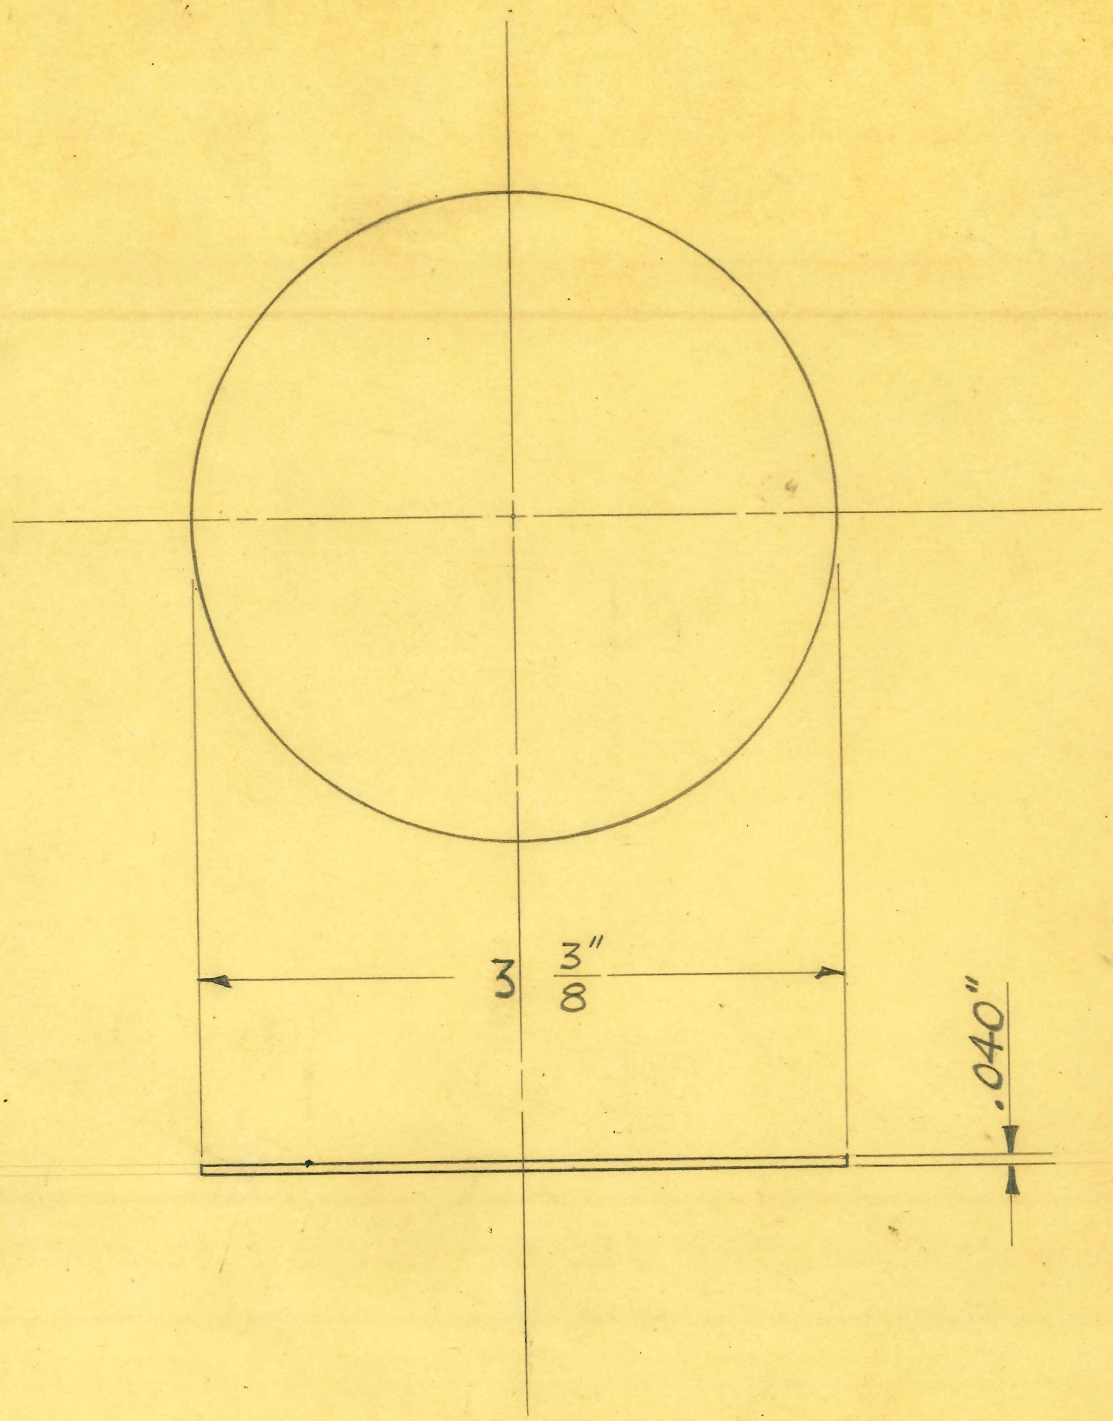

SIZE	.040" SHEET	ISSUE 8-29-46	J.V.W.
KIND	ALUMINUM	CHANGED	
SHAPE		"	
FINISH		"	
TEMP.		"	
PATT.		"	

TITLE: "GA-15" – "TC-30-96" ≠ "TV-30-96"
1 MM. ALUMINUM FILTER

H. G. FISCHER & CO.
2335 WABANSIA AVE.
CHICAGO, ILL.

CAT. NO.

PART NO. 12793

TITLE: FISCHER "TC-30-96" MOBILE STAND HEAD SUPP. TUBE CLAMP WING SCREW	H. G. FISCHER & CO. FRANKLIN PARK, ILLINOIS		PART NO. 12798A
	DATE 5-24-49	DR. BY W.J.	CH'K'D. J.V.W.
PATTERN 1734	FINISH CHROME # 2	SCALE FULL	DIMENSIONS: FRACTIONAL ± .015; DECIMAL ± .005; ANGULAR ± ½°; UNLESS OTHERWISE SPECIFIED
TOOLS: TURNING JAWS # 11543	MATERIAL: FROM 13753 80-10-10 BRONZE CASTING		

REVISION	DATE	BY

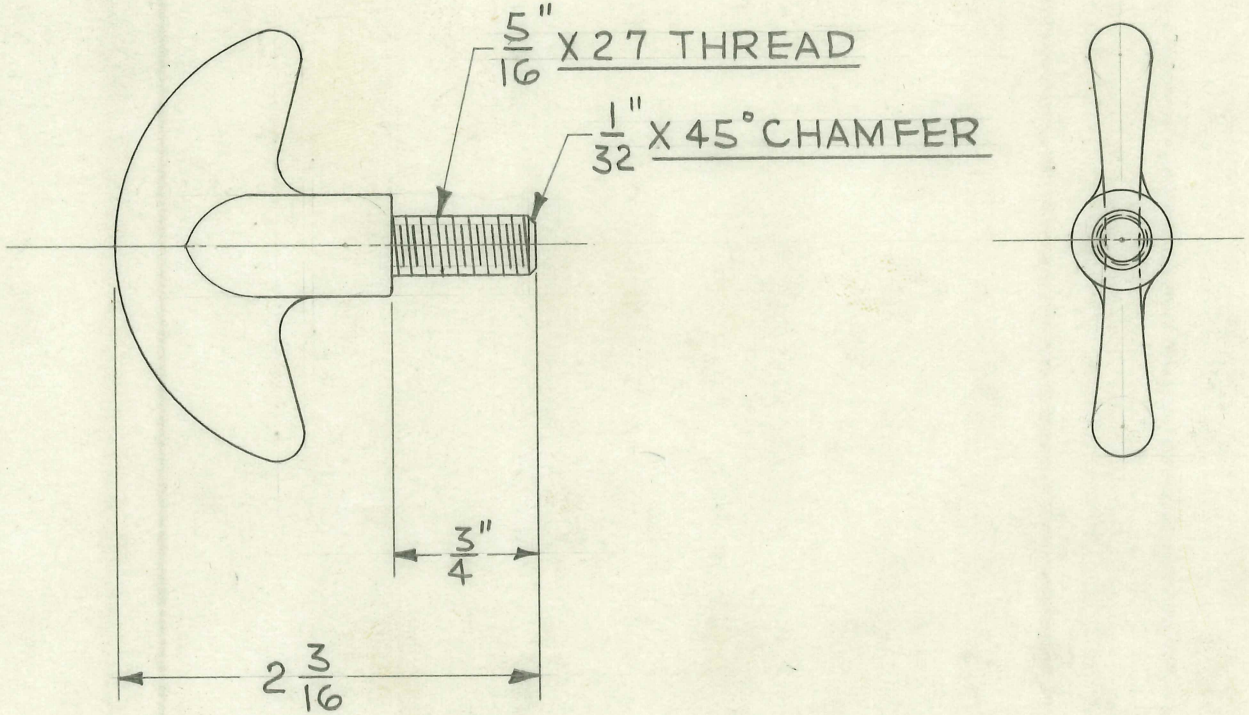

1 REQUIRED

FOLDER #101

TITLE FISCHER "TC-30-96" MOBILE STAND
HEAD SUPP. TUBE CLAMP SLUG

H. G. FISCHER & CO.
FRANKLIN PARK, ILLINOIS

DATE 10-27-48 | DR. BY K.S. | CH'K'D. J.V.W.

PART NO. 12799

REVISION	DATE	BY

PATTERN | FINISH | SCALE FULL

TOOLS

MATERIAL 1/4" DIA. BRASS ROD

DIMENSIONS
FRACTIONAL ± .015
DECIMAL ± .005
ANGULAR ± ½°
UNLESS OTHERWISE SPECIFIED

BREAK SHARP EDGES

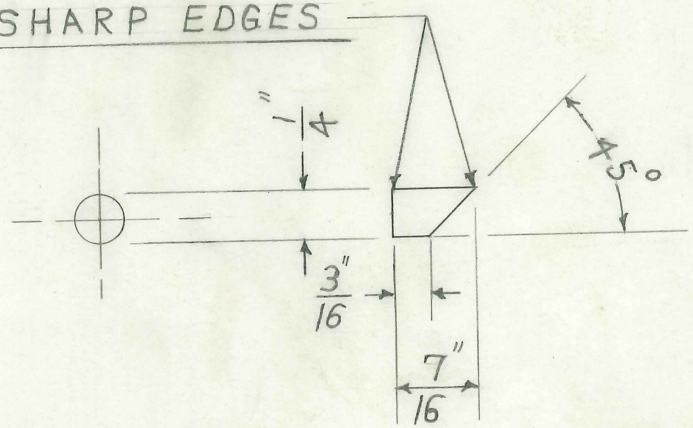

1 REQUIRED

FOLDER #101

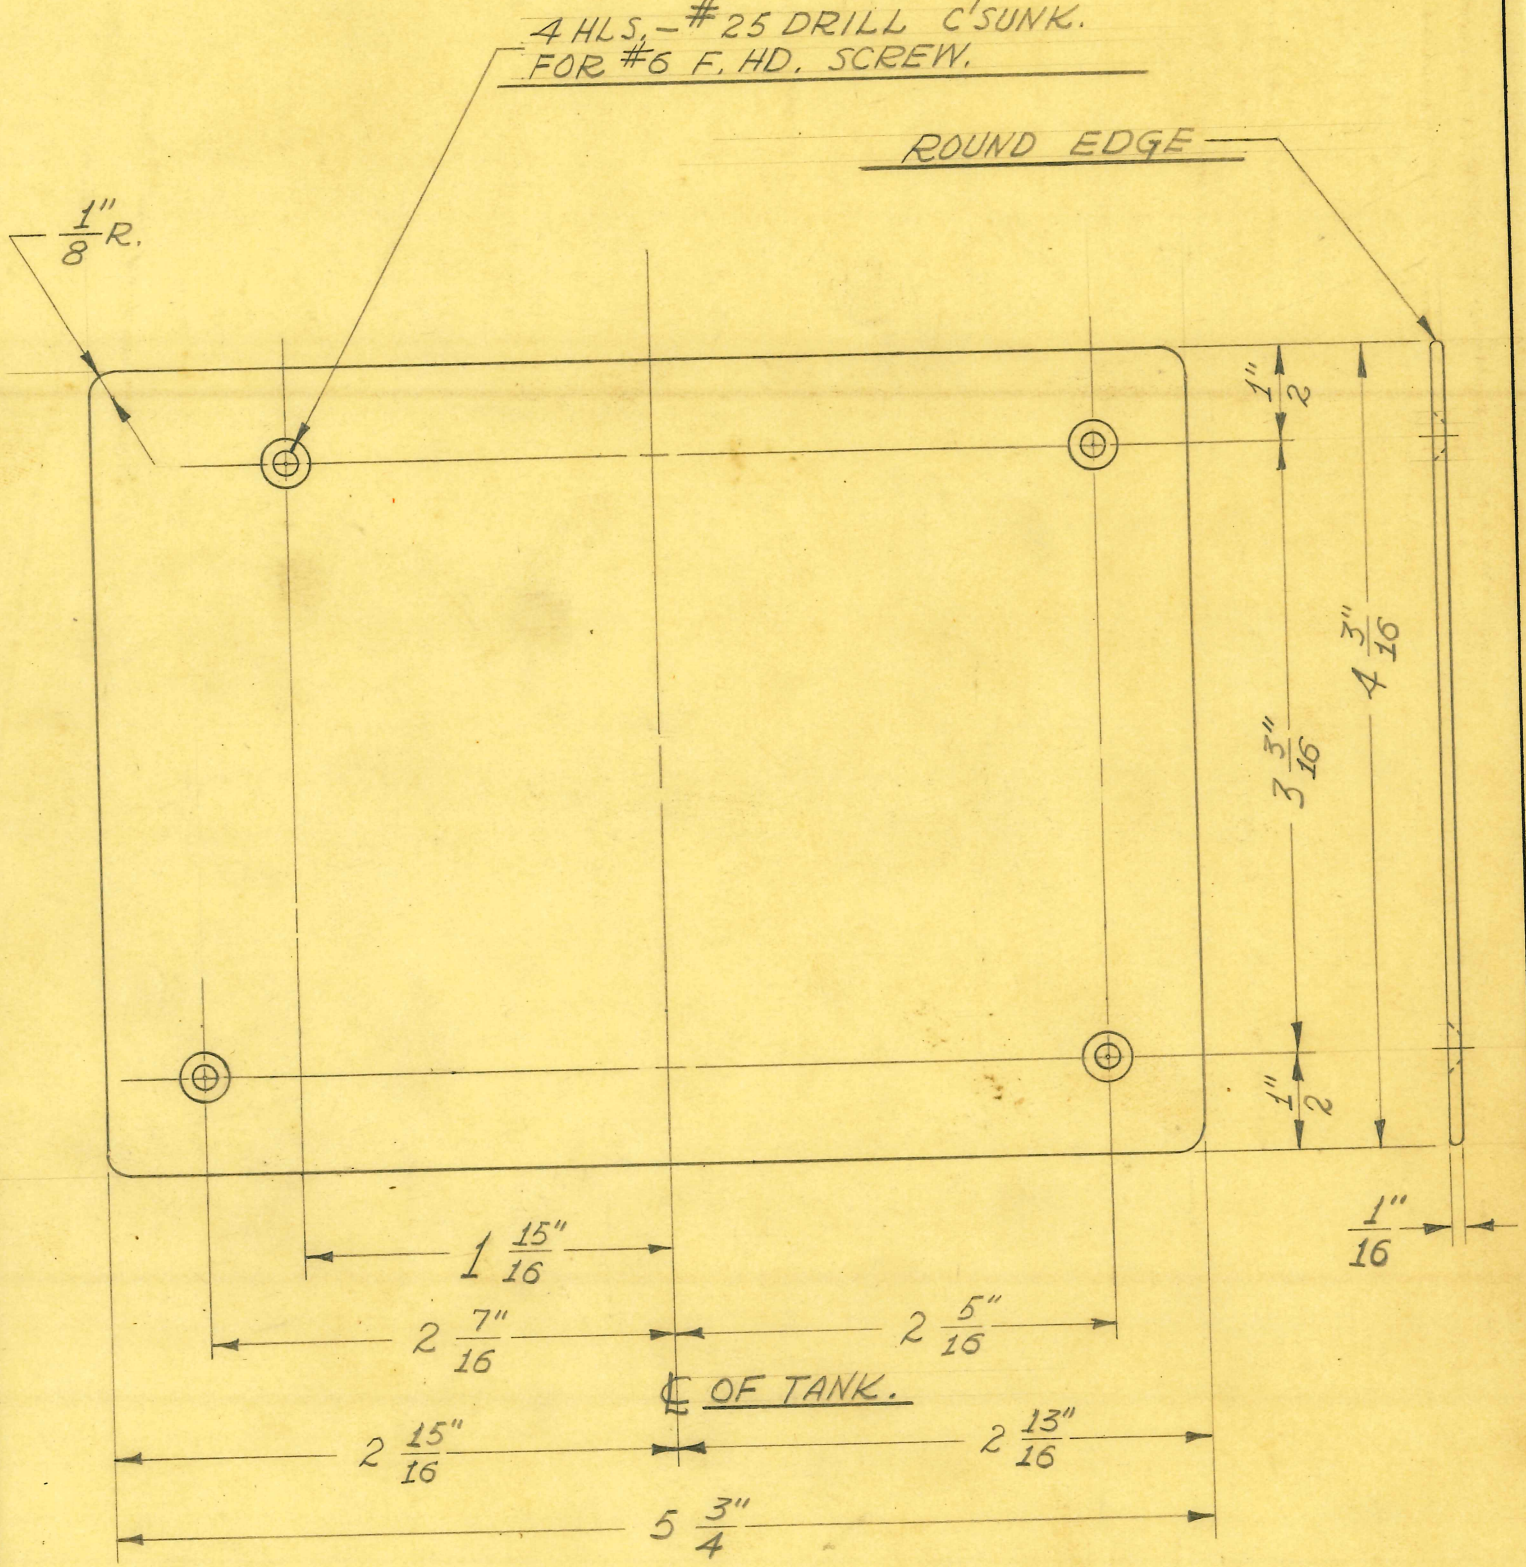

1 REQUIRED

SIZE	1/16" SHEET	ISSUE 8-30-39	J.W.
KIND	LEAD	CHANGED	
SHAPE		"	
FINISH		"	
TEMP.		"	

TITLE: "X-RAY" BARRIER FRONT PLATE

H. G. FISCHER & CO.
2335 WABANSIA AVE.
CHICAGO, ILL.

CAT. NO.

PART NO. 12803

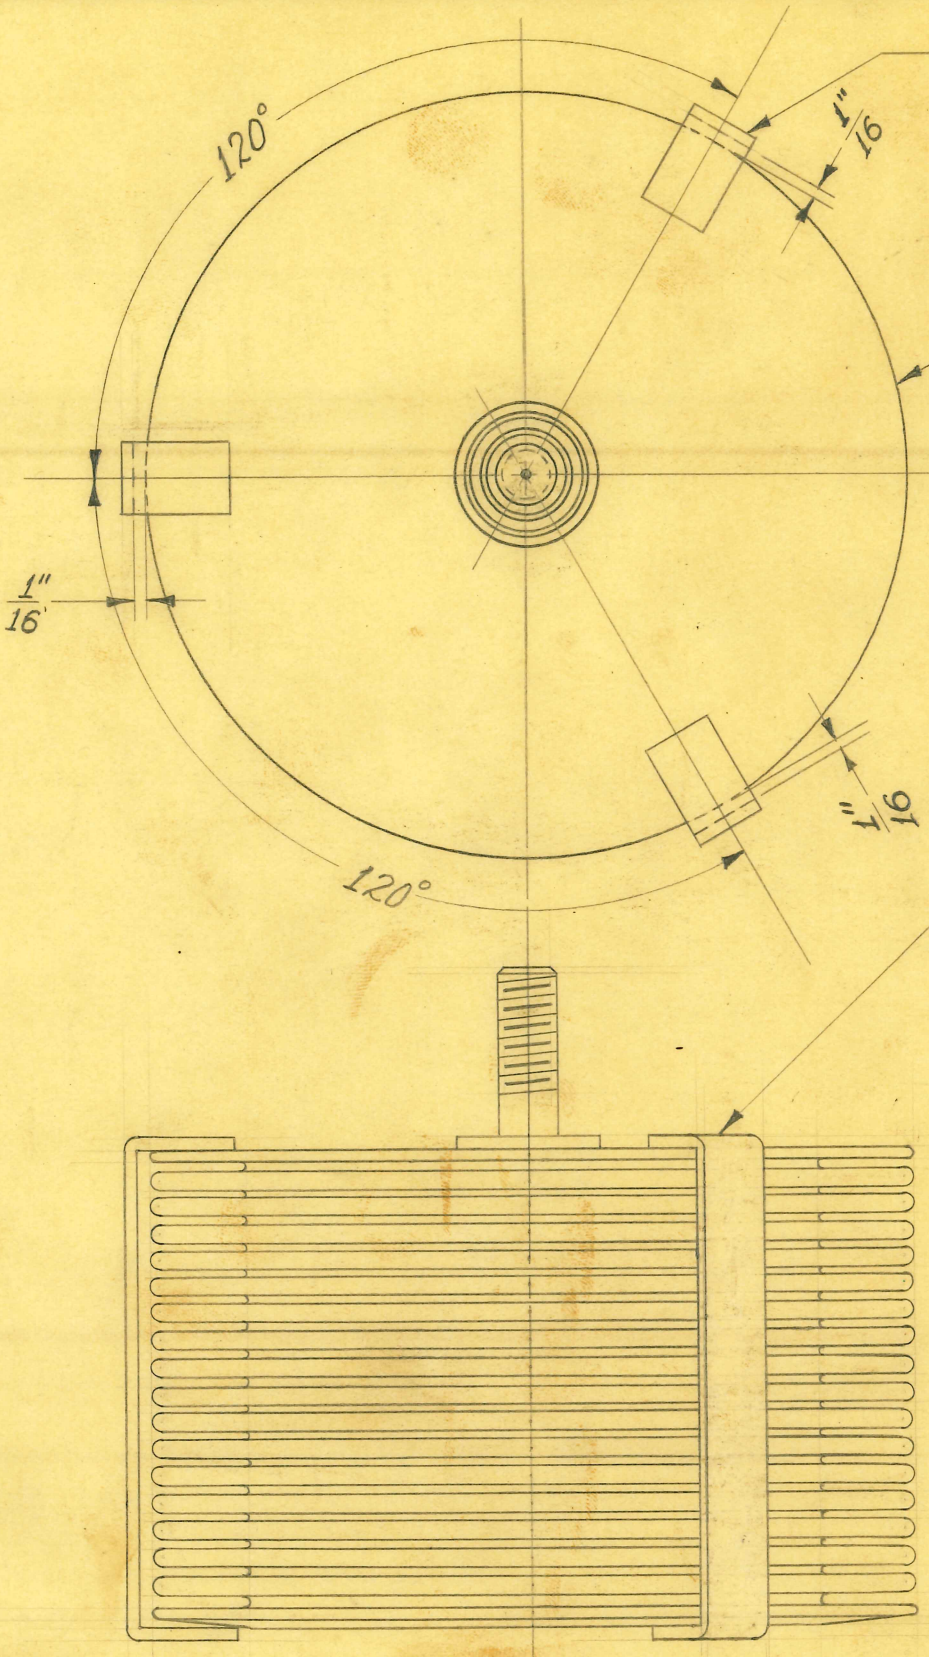

3 REQUIRED

SIZE		ISSUE 9-1-39	J.W.
KIND		CHANGED	
SHAPE		"	
FINISH		"	
TEMP.		"	
PATT.		"	

TITLE:

TRANSFORMER BELLOWS ASSEMBLY

H. G. FISCHER & CO.
2335 WABANSIA AVE.
CHICAGO, ILL.

CAT. NO.

PART NO. 12807G

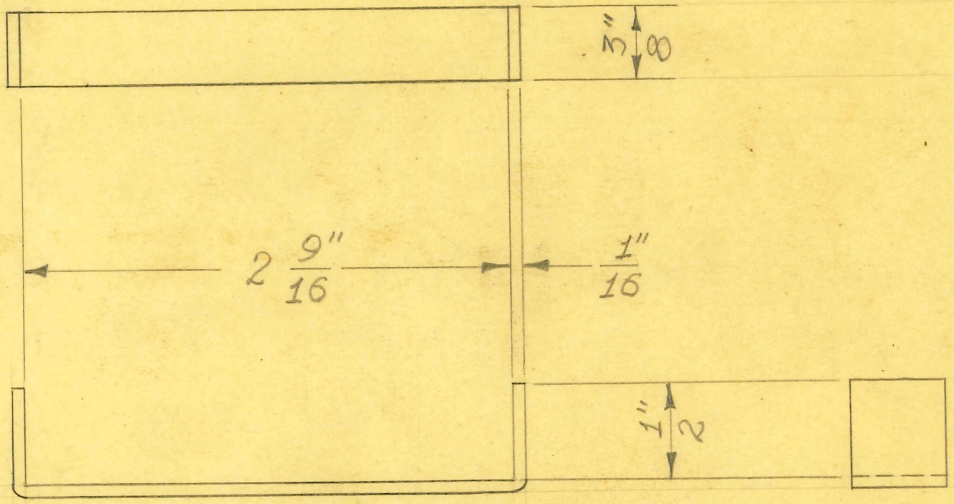

9 REQUIRED

SIZE	1/16" SHEET	ISSUE 9-1-39	J.W.
KIND	BRASS	CHANGED	
SHAPE		"	
FINISH		"	
TEMP.		"	

TITLE: TRANSFORMER BELLOW ALIGNING STRAP

H. G. FISCHER & CO.
2335 WABANSIA AVE.
CHICAGO, ILL.

CAT. NO.

PART NO. 12808

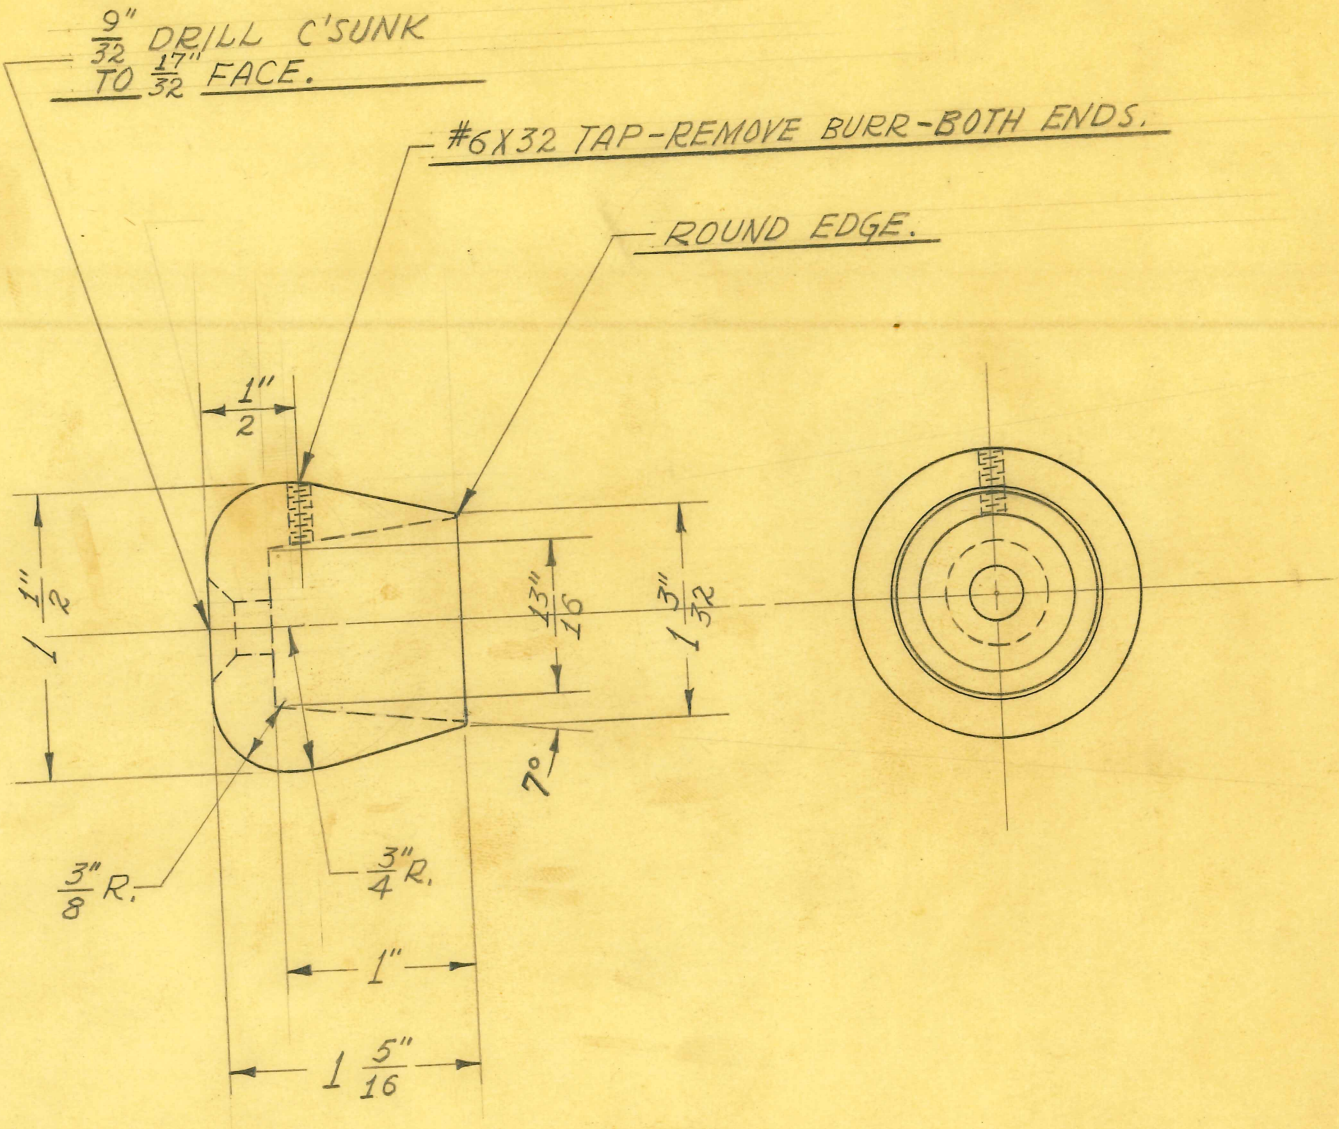

1 REQUIRED

SIZE	1 ½" DIAM.	ISSUE 9-21-39	J.W.
KIND	ALUM. ROD	CHANGED	
SHAPE		"	
FINISH		"	
TEMP.		"	
		"	

TITLE: "X-RAY" TUBE RADIATOR

H. G. FISCHER & CO.
2335 WABANSIA AVE.
CHICAGO, ILL.

CAT. NO.

PART NO. 12811

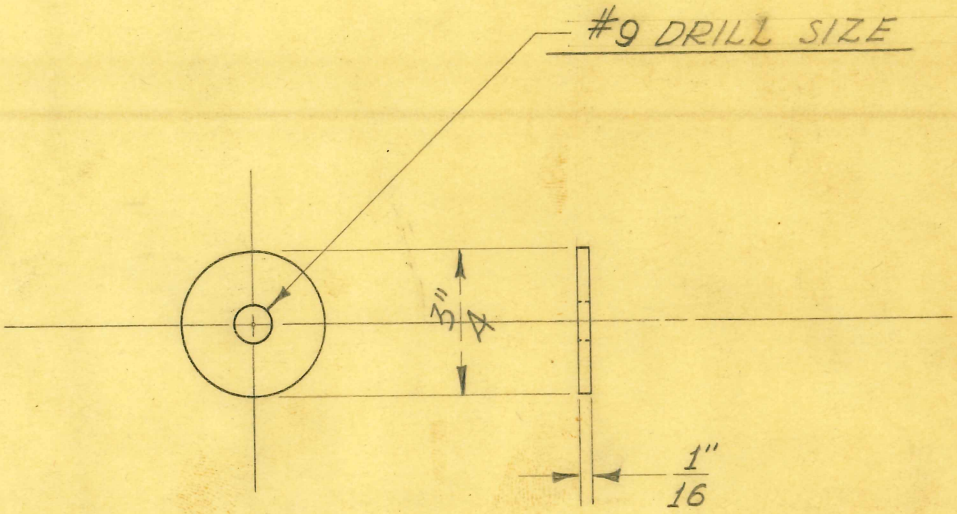

4 REQUIRED

SIZE	1/16" SHEET	ISSUE 8-31-39	J.W.
KIND	VELLUMOID	CHANGED	
SHAPE		"	
FINISH		"	
TEMP.		"	
PATT.		"	

TITLE:

"X-RAY" TUBE CLAMP STUD GASKET

H. G. FISCHER & CO.
2335 WABANSIA AVE.
CHICAGO, ILL.

CAT. NO.

PART NO. 12812

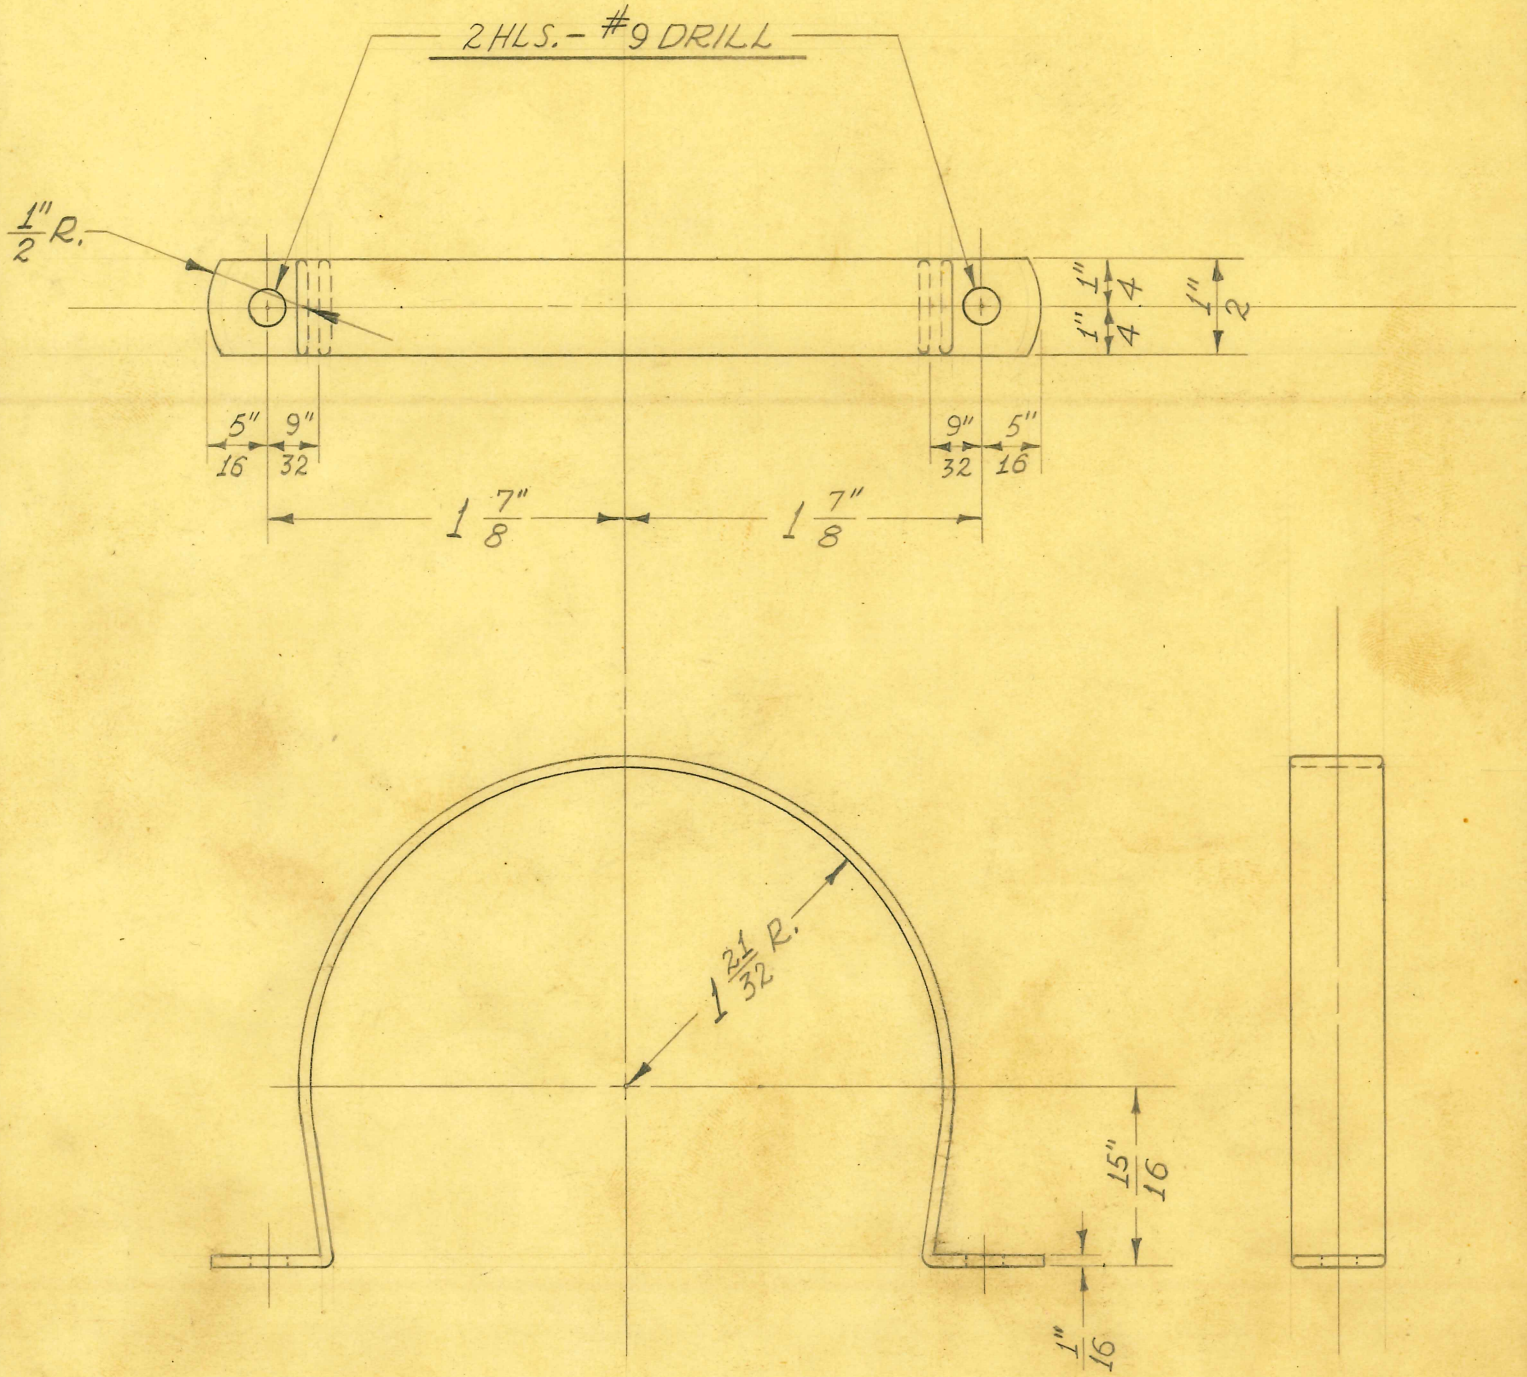

DEVELOPED LENGTH 8 1/4"

2 REQUIRED

SIZE	1/2" X 1/16"	ISSUE 8-30-39	J.W.
KIND	FLAT WIRE	CHANGED	
SHAPE		"	
FINISH		"	
TEMP.		"	
PATT.		"	

TITLE: "X-RAY" TUBE CLAMP STRAP

H. G. FISCHER & CO.
2335 WABANSIA AVE.
CHICAGO, ILL.

CAT. NO.

PART NO. 12815

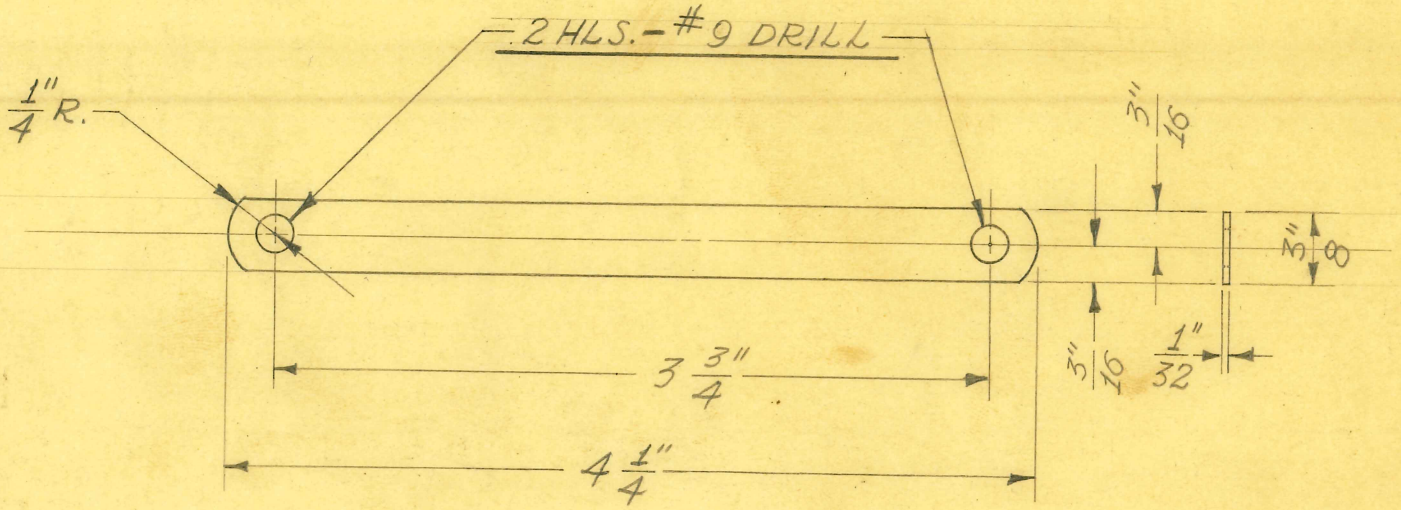

1 REQUIRED

SIZE	1/32" SHEET	ISSUE 8-31-39	J.W.
KIND	BRASS	CHANGED	
SHAPE		"	
FINISH		"	
TEMP.		"	
PATT.		"	

TITLE:

"X-RAY" TUBE GROUND STRIP

H. G. FISCHER & CO.
2338 WABANSIA AVE.
CHICAGO, ILL.

CAT. NO.

PART NO. 12816

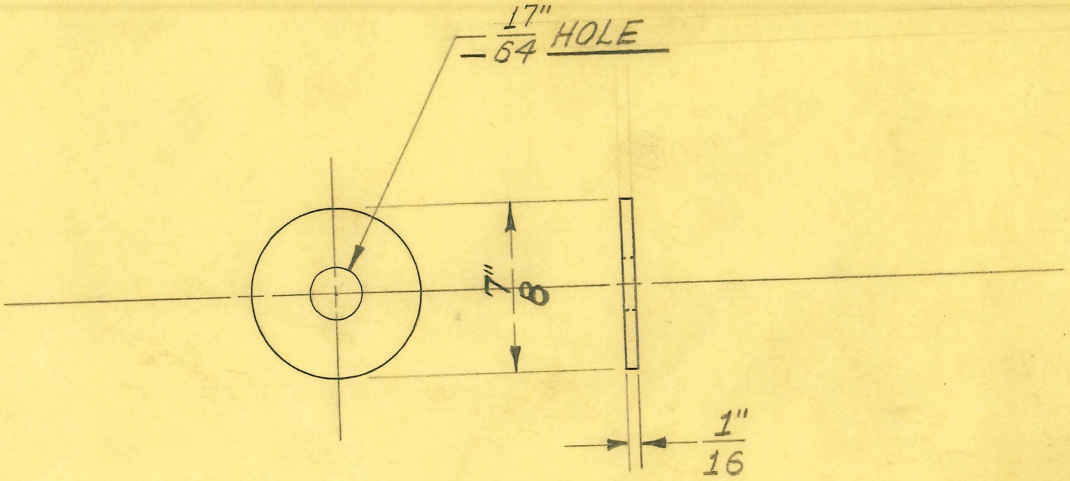

2 REQUIRED

SIZE	1/16" SHEET	ISSUE 11-10-39	J.W.
KIND	VELLUMOID	CHANGED	
SHAPE		"	
FINISH		"	
TEMP.		"	

TITLE:

TRANSF. TERMINAL STUD GASKET-LARGE

H. G. FISCHER & CO.
2335 WABANSIA AVE.
CHICAGO, ILL.

CAT. NO.

PART NO. 12817

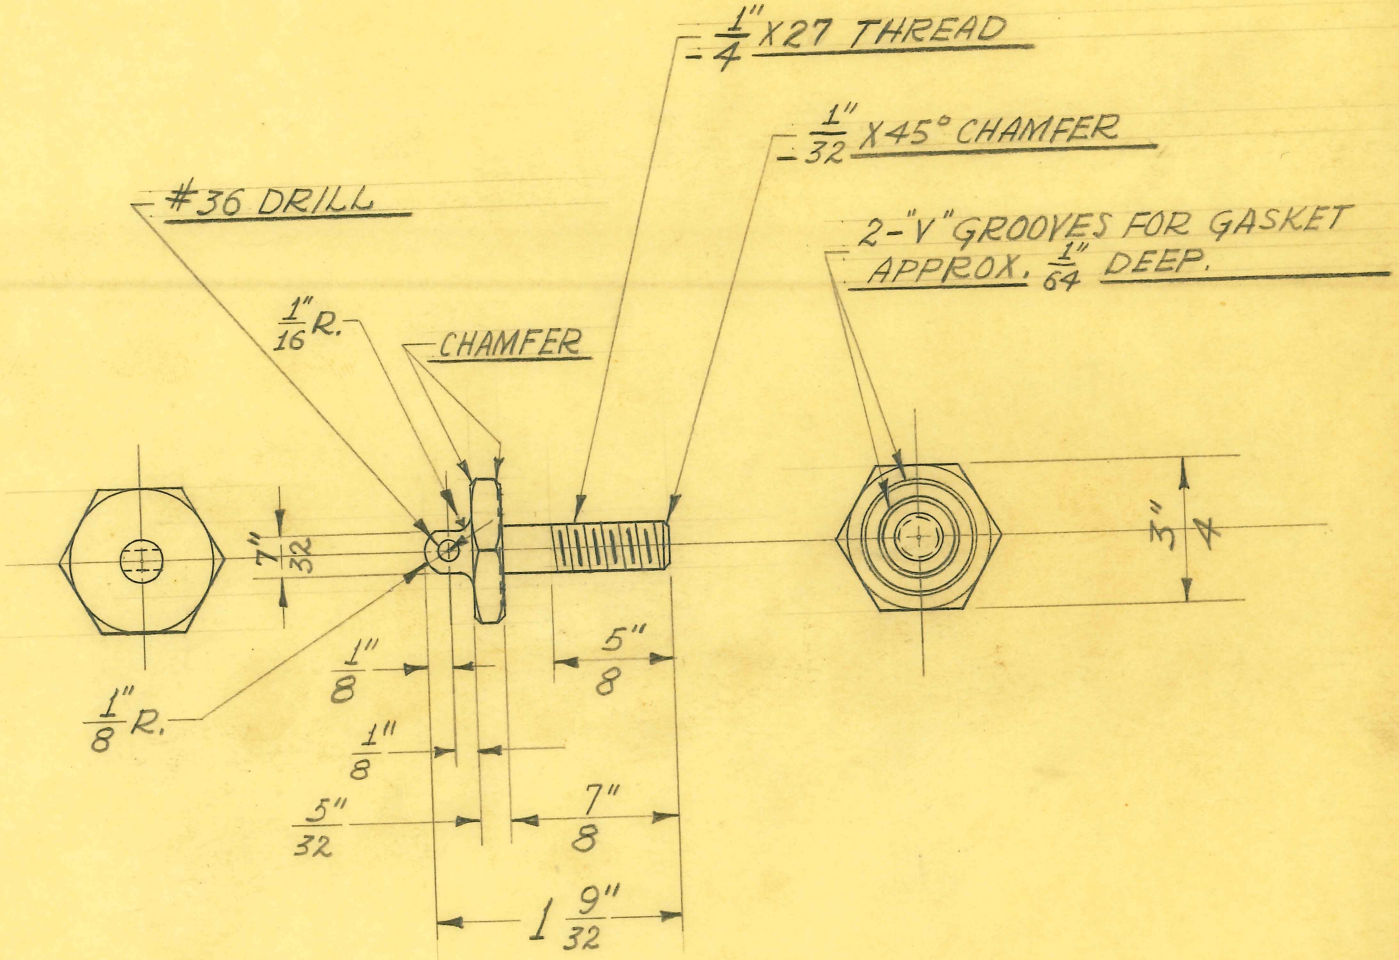

2 REQUIRED

SIZE	3/4" HEX.	ISSUE 11-10-39	J.W.	TITLE: TRANSFORMER TERMINAL STUD -LARGE
KIND	BRASS. ROD	CHANGED		
SHAPE		"		
FINISH		"		
TEMP.		"		
PATT.		"		

H. G. FISCHER & CO.
2335 WABANSIA AVE.
CHICAGO, ILL.

CAT. NO.

PART NO. 12818

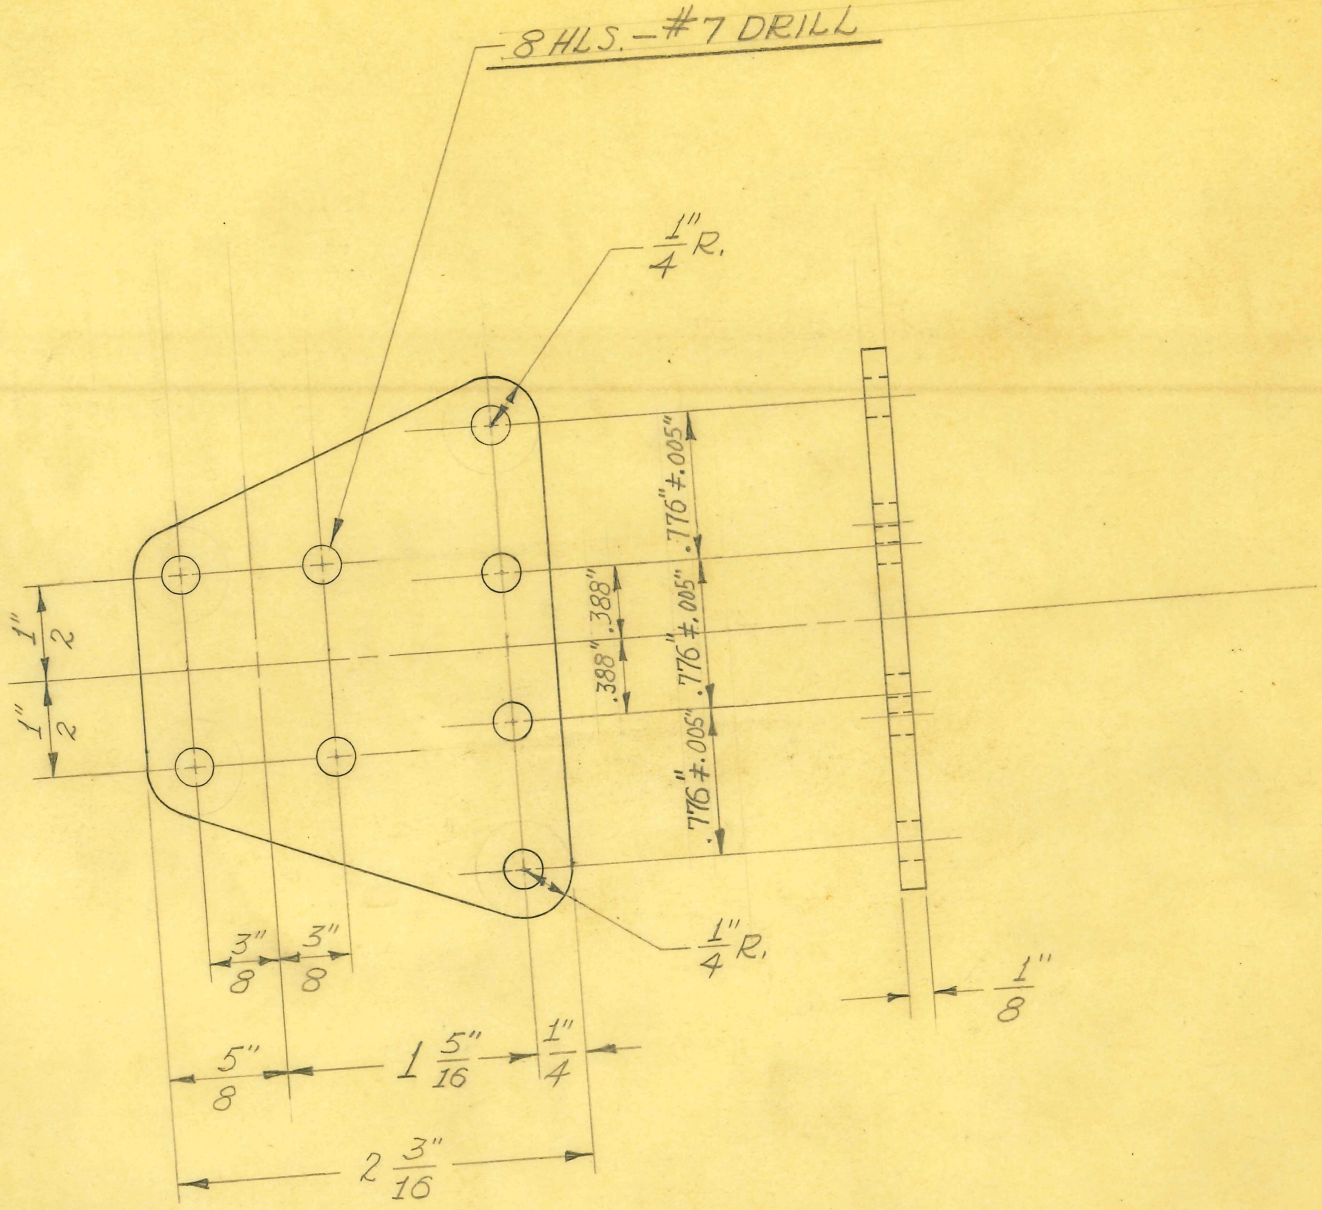

2 REQUIRED

SIZE	1/8" SHEET	ISSUE	
KIND	C.R. STEEL	CHANGED	
SHAPE		"	
FINISH	CAD. #23	"	
TEMP.		"	

TITLE: TRANSFORMER MOUNTING PLATE

H. G. FISCHER & CO.
2335 WABANSIA AVE.
CHICAGO, ILL.

CAT. NO.

PART NO. 12819

TITLE
FISCHER "TCR" X-RAY UNIT
SLIDE STOP BUSHING (FOR LONG UPRIGHTS)

H. G. FISCHER & CO.
FRANKLIN PARK, ILLINOIS

PART NO. 12821

DATE 10-27-49 | DR. BY J.N.W. | CH'K'D.

REVISION	DATE	BY

PATTERN | FINISH AS INDICATED BELOW | SCALE FULL

TOOLS | MATERIAL $\frac{5}{8}$" DIA. ALUMINUM ROD

DIMENSIONS
FRACTIONAL ± .015
DECIMAL ± .005
ANGULAR ± ½°
UNLESS OTHERWISE SPECIFIED

SCRATCH FINISH THESE TWO FACES WITH FINE EMERY CLOTH

BREAK SHARP EDGES BOTH ENDS

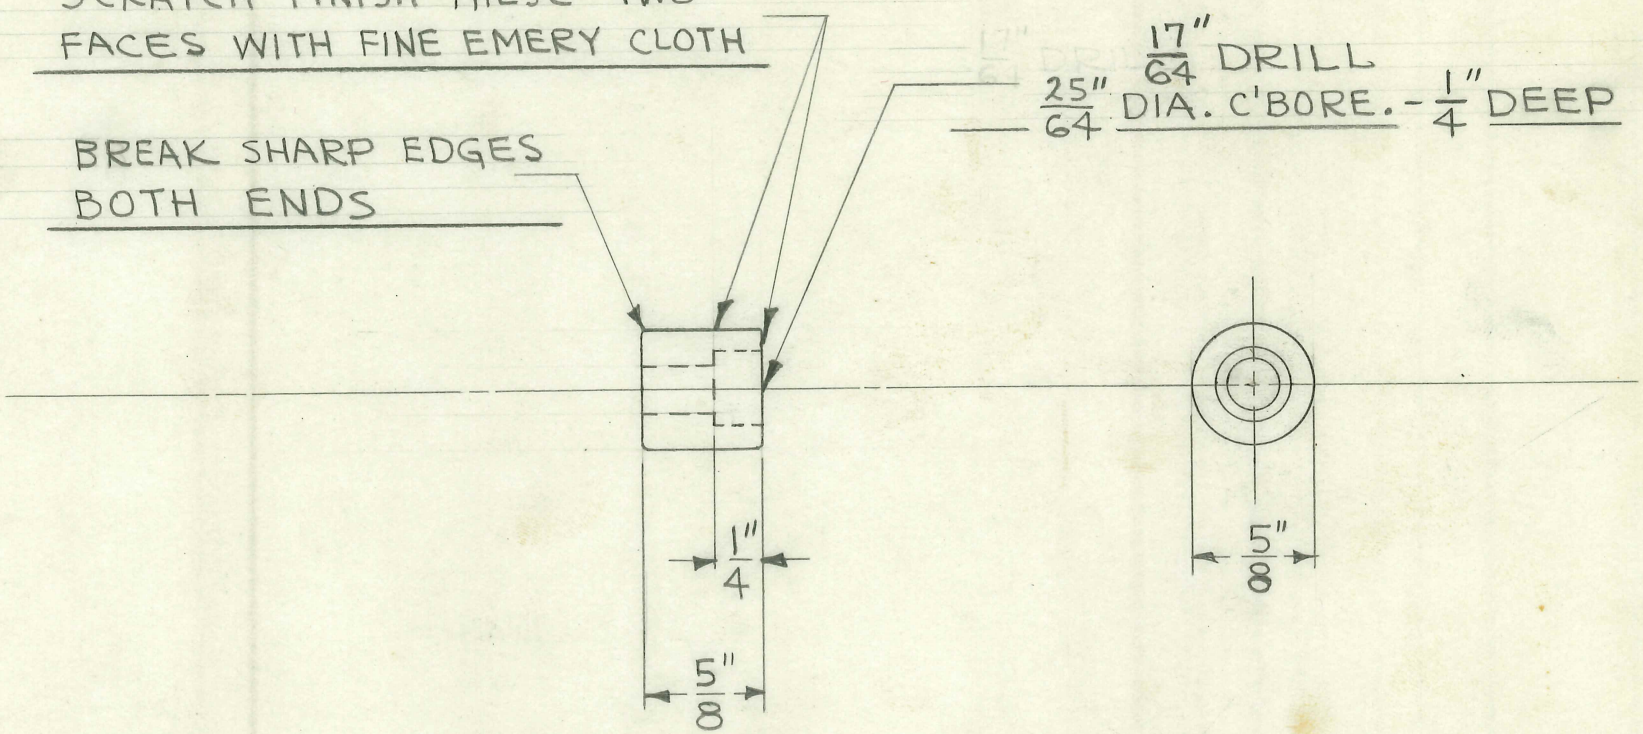

1 REQUIRED

FOLDER # 101

TITLE
FISCHER "TCR" X-RAY UNIT
SLIDE STOP RING

H. G. FISCHER & CO.
FRANKLIN PARK, ILLINOIS

DATE 10-28-49 DR. BY J.V.W. CH'K'D.

PART NO. 12822

REVISION	DATE	BY

PATTERN | FINISH PAINTED | SCALE FULL

TOOLS

MATERIAL FROM #13851
OR
#13851F MAY BE USED
EXCEPT C'BORE, 7/16" BOSS AS SHOWN

DIMENSIONS
FRACTIONAL ± .015
DECIMAL ± .005
ANGULAR ± ½°
UNLESS OTHERWISE SPECIFIED

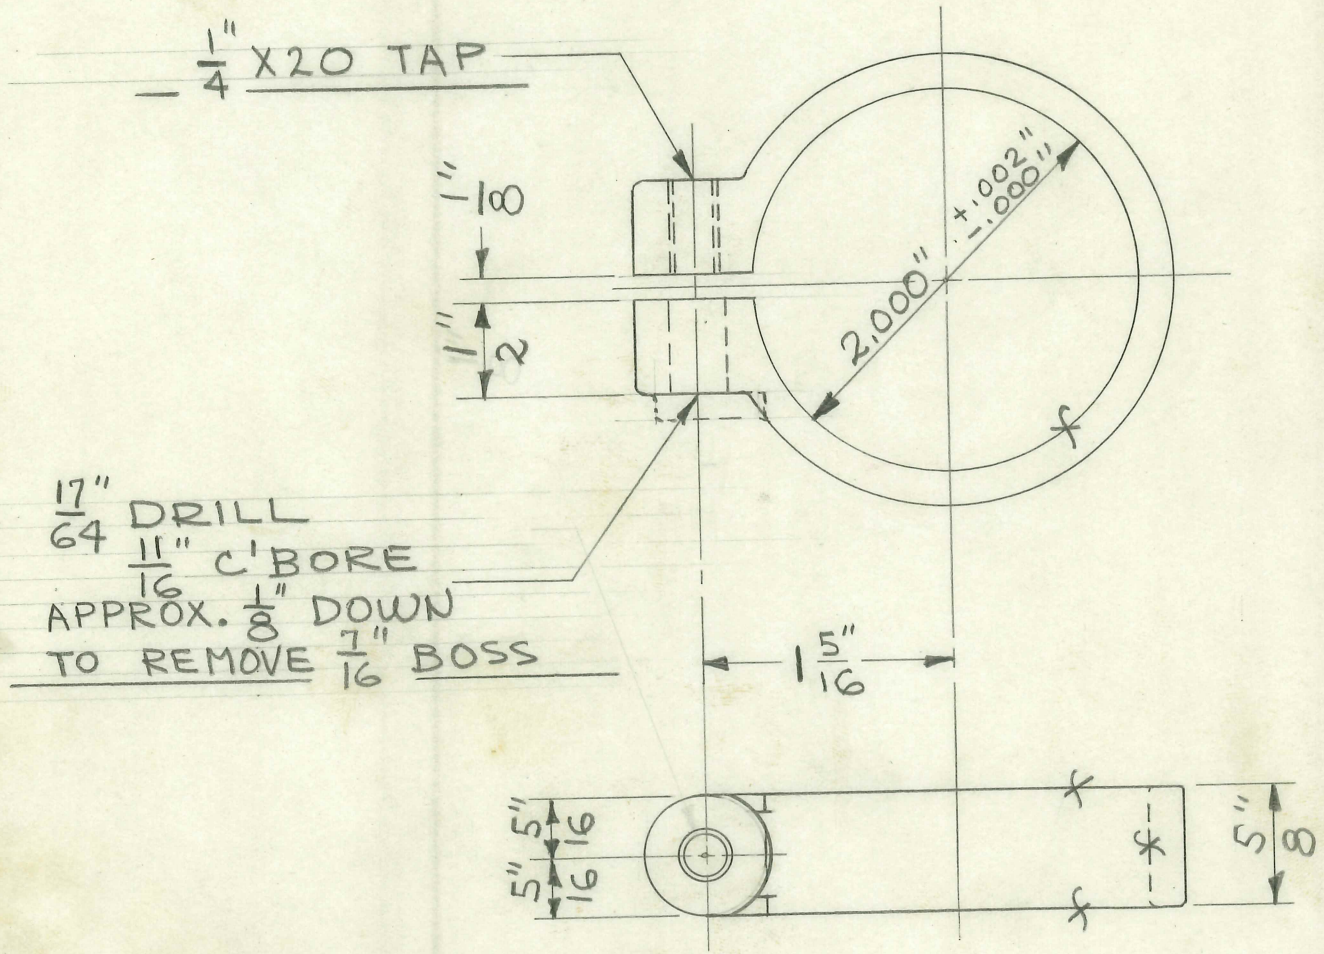

1 REQUIRED

FOLDER #101

2 HLS — # 9 DRILL

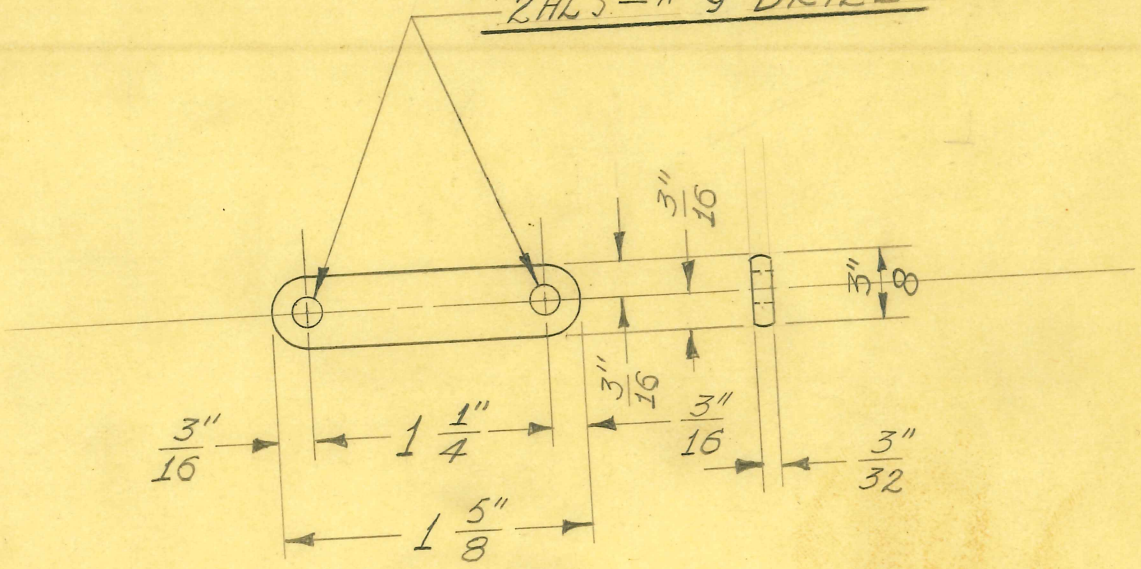

4 REQUIRED

SIZE	3/8" X 3/32"	ISSUE 8-25-39	J.W.	TITLE: FILAMENT TRANSF. CLAMP STRAP
KIND	FLAT WIRE	CHANGED		
SHAPE		"		
FINISH		"		
TEMP.		"		

H. G. FISCHER & CO.
2335 WABANSIA AVE.
CHICAGO, ILL.

CAT. NO.

PART NO. 12824

TITLE FISCHER MOD. "TC-50" S.P. MOBILE X-RAY CONDENSER CLAMP	H. G. FISCHER & CO. FRANKLIN PARK, ILLINOIS	PART NO. 12829	
	DATE 5-6-49 DR. BY W. J. CH'K'D. J.V.W.	REVISION	DATE BY
PATTERN / FINISH / SCALE FULL	DIMENSIONS: FRACTIONAL ± .015, DECIMAL ± .005, ANGULAR ± ½° UNLESS OTHERWISE SPECIFIED		
TOOLS DRILL JIG # 11067, BENDING FIX. # 11068	MATERIAL 20 GA. (.032") PHOSPHOR BRONZE		

1 REQUIRED

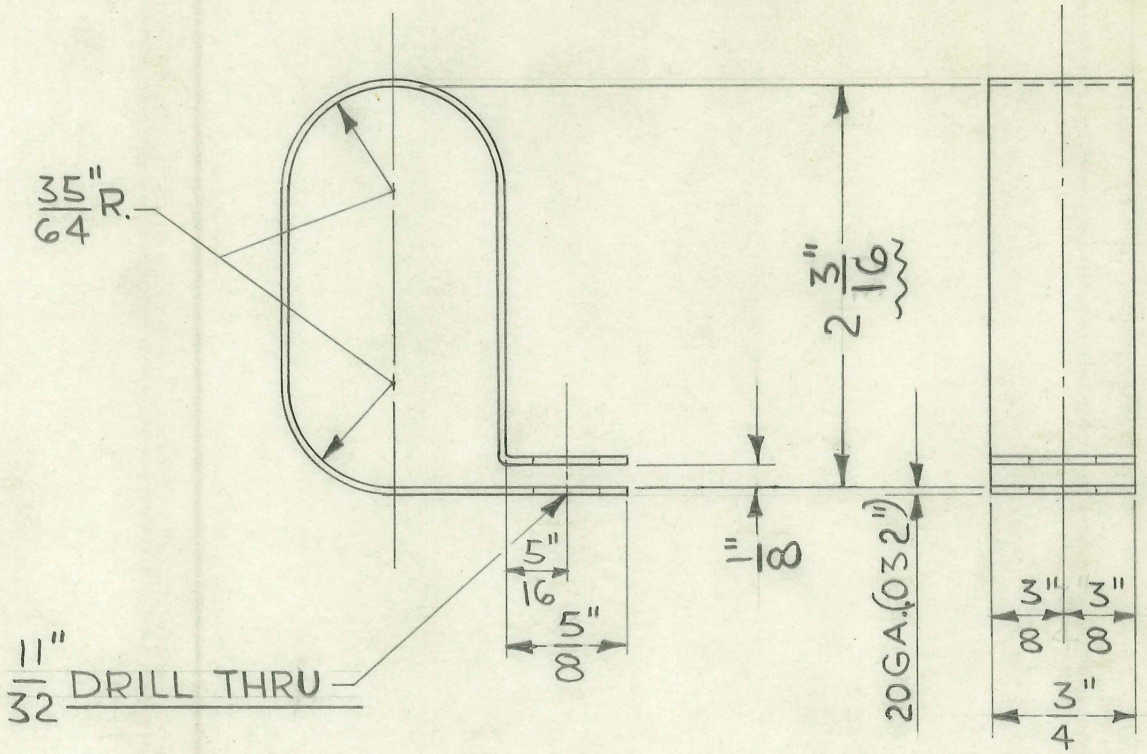

REMOVE ALL SHARP EDGES & CORNERS

DEVELOPED LENGTH 7 1/16"

FOLDER #101

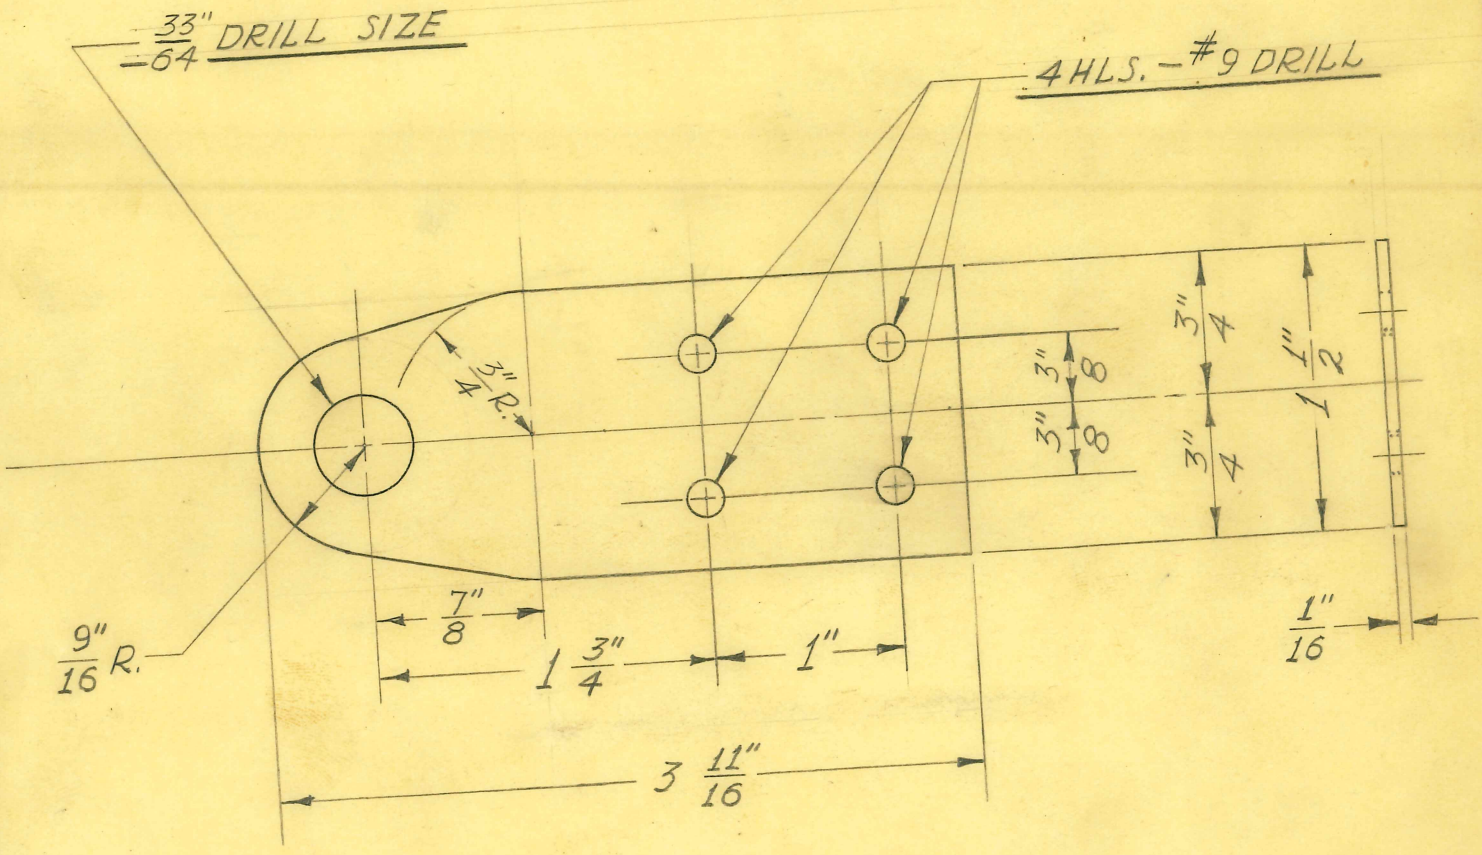

1 REQUIRED

SIZE	1/16" SHEET	ISSUE 10-4-39	J.W.
KIND	CORPRENE	CHANGED	
SHAPE		"	
FINISH		"	
TEMP.		"	

TITLE:
FISCHER MOD.
"X-RAY" TRANSFORMER SUPPORT GASKET – LEFT

H. G. FISCHER & CO.
2335 WABANSIA AVE.
CHICAGO, ILL.

CAT. NO.

PART NO. 12830

TITLE
TRANSFORMER CLAMP & FILLET
TRANSFORMER SUPPORT LEFT.

H. G. FISCHER & CO.
FRANKLIN PARK, ILLINOIS

PART NO. 12836

DATE 9-16-68 | DR. BY AD | CH'K'D. T. K.

REVISION	DATE	BY

PATTERN	FINISH	SCALE
		~~X~~

MATERIAL ~~X~~

TOOLS

DIMENSIONS—UNLESS OTHERWISE SPECIFIED:

FRACTIONAL	± .015	THREAD CHAMFER
DECIMAL	± .005	UP TO 5/16 D.-1/32 X 45°
ANGULAR	± 1/2°	3/8 D. & OVER - 1/16 X 45°

REMOVE ALL BURRS & SHARP CORNERS

USED ON	QTY.	USED ON	QTY.

PURCHASE:

CASTINGS IRON PATTERN #1889

ACCEPTABLE SOURCE:

CHICAGO HARDWARE FOUNDRY CO.

DO NOT SCALE DRAWING.

TITLE: TC-50 SECONDARY COIL PAPER TUBE

H. G. FISCHER & CO.
FRANKLIN PARK, ILLINOIS

DATE 2-8-56 | DR BY C.E.K. | CH'K'D. J.N.W.

1284072

REVISION	DATE	BY

PATTERN | FINISH | SCALE FULL

MATERIAL 2½" DIA. INSIDE X 2 1/16" DIA. OUTSIDE CARDBOARD TUBE

TOOLS

DIMENSIONS UNLESS OTHERWISE SPECIFIED
FRACTIONAL ± .015
DECIMAL ± .005
ANGULAR ± ½°

IN ASSEM. DEPT.
BRASS EYELET, PC. NO. 16464A
USE 1/8" DIA. PUNCH, (WHITNEY NO. 5 JR.)

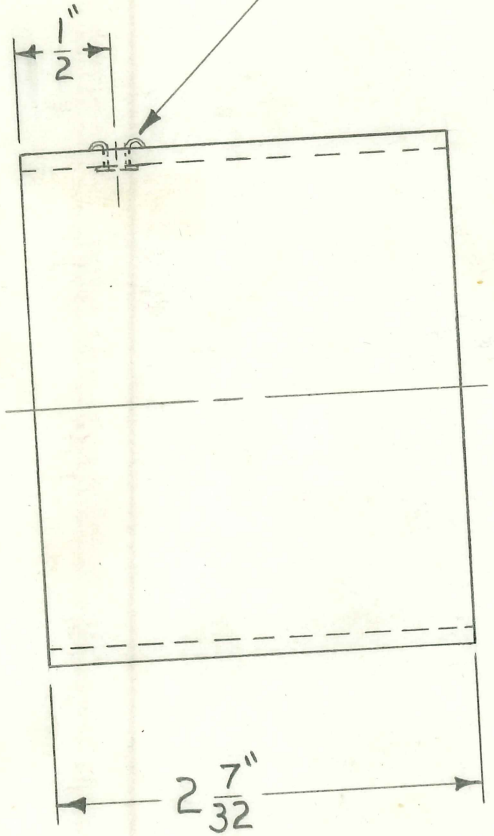

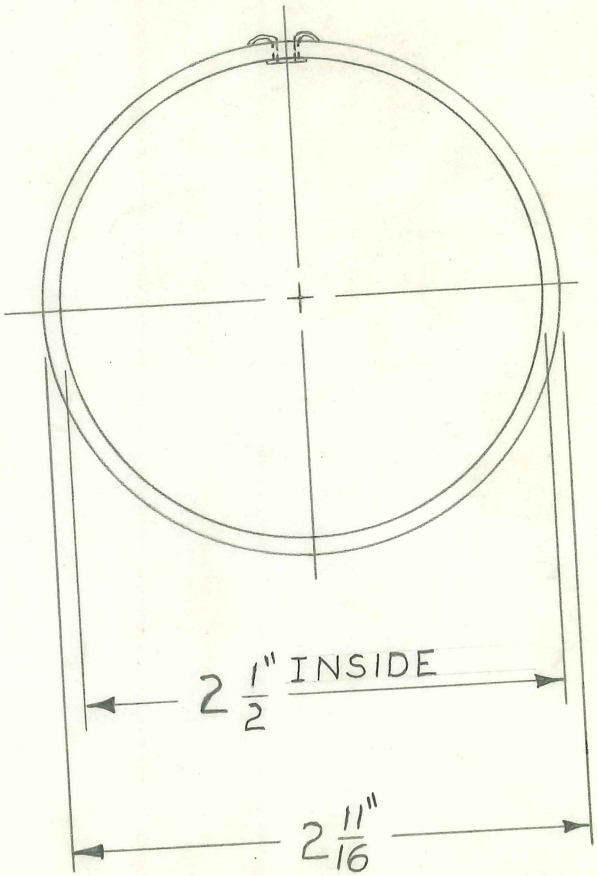

FOLDER # 101

TITLE MOD. "NTM" X-RAY UNIT
SECONDARY COIL SPACER

H. G. FISCHER & CO.
FRANKLIN PARK, ILLINOIS

PART NO. 12842

PATTERN	FINISH	SCALE FULL

MATERIAL 2 1/2" I.D. X 2 3/4" O.D. NAT. BAKELITE ROD

TOOLS

DATE 3·31·67 | DR. BY B. K. | CH'K'D. RS

DIMENSIONS—UNLESS OTHERWISE SPECIFIED:
FRACTIONAL ± .015
DECIMAL ± .005
ANGULAR ± 1/2°

THREAD CHAMFER
UP TO 5/16 D. - 1/32 X 45°
3/8 D. & OVER - 1/16 X 45°

REMOVE ALL BURRS & SHARP CORNERS

USED ON	QTY.	USED ON	QTY.

	REVISION	DATE	BY
*	REDRAWN	3·31·67	BK

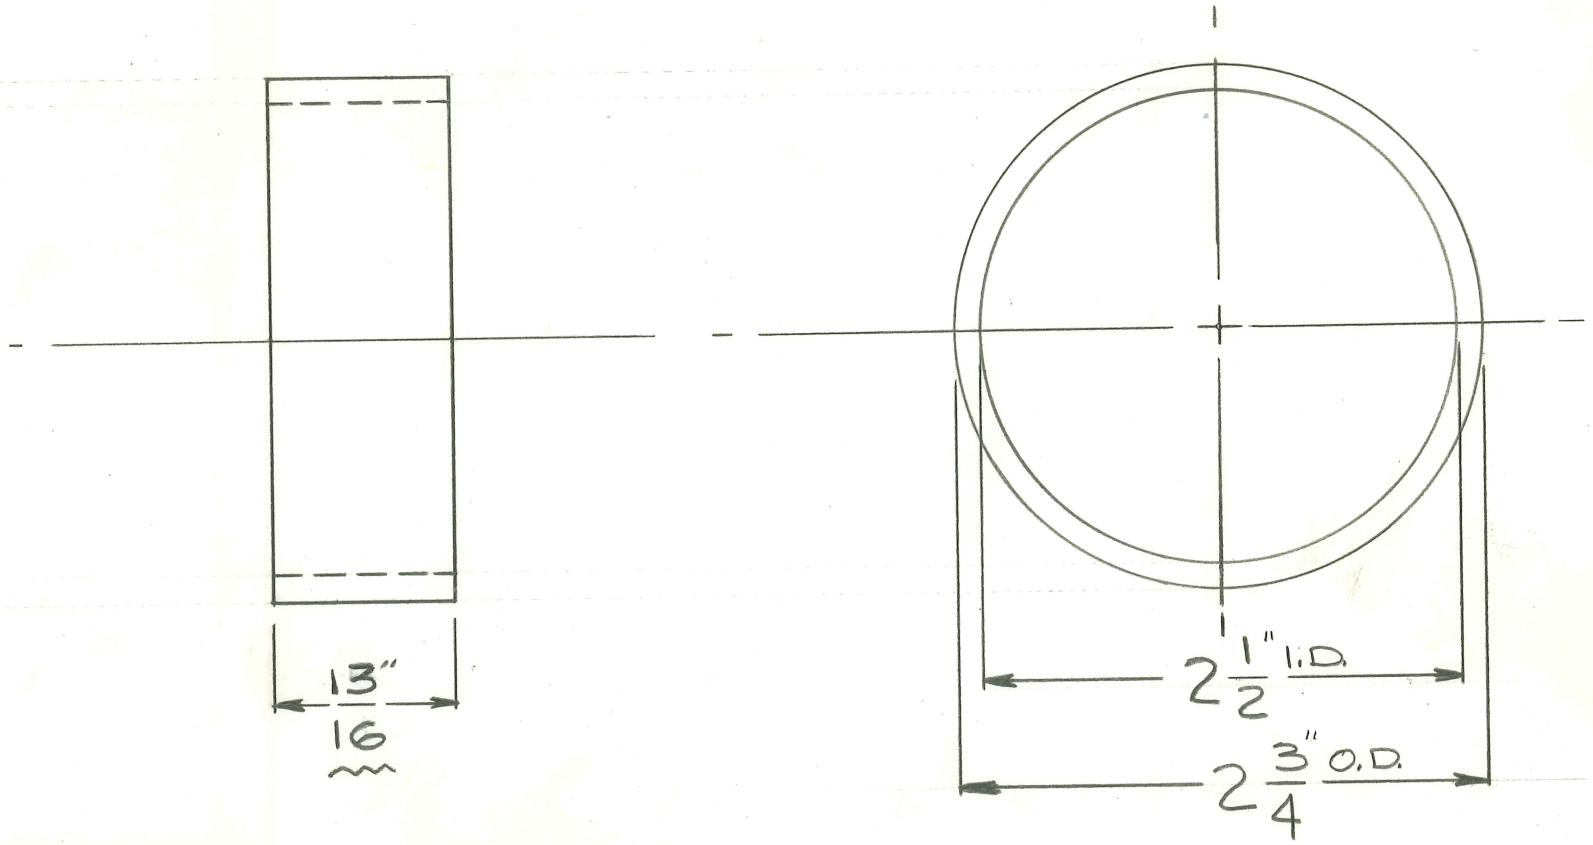

DO NOT SCALE DRAWING.

TITLE
FISCHER "T-50" X-RAY TUBE
CORK STRIP

H. G. FISCHER & CO.
FRANKLIN PARK, ILLINOIS

PART NO. 12854

DATE 2-27-56 | DR BY C.E.K. | CH'K'D. J.V.W.

REVISION	DATE	BY

PATTERN | FINISH | SCALE FULL

TOOLS | MATERIAL 1/32" SHEET SUPER CORK

DIMENSIONS
FRACTIONAL ± .015
DECIMAL ± .005
ANGULAR ± ½°
UNLESS OTHERWISE SPECIFIED

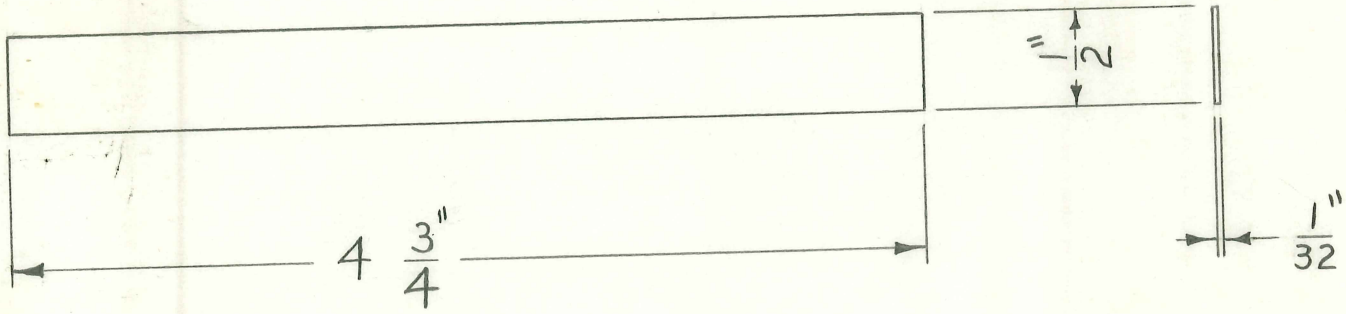

2 REQUIRED

FOLDER #136

TITLE
MODEL "TM-30-96" MOBILE SHOCK-PROOF X-RAY UNIT PIN

H. G. FISCHER & CO.
FRANKLIN PARK, ILLINOIS

DATE 11-11-65 | DR BY K.T.K | CH'K'D. RS.

PART NO. 12858

REVISION	DATE	BY

PATTERN | FINISH | SCALE DOUBLE

TOOLS | MATERIAL 3/16" DIA. LEDLOY

DIMENSIONS
FRACTIONAL ± .015
DECIMAL ± .005
ANGULAR ± ½°
UNLESS OTHERWISE SPECIFIED

USED ON	QTY.
12667GA	2

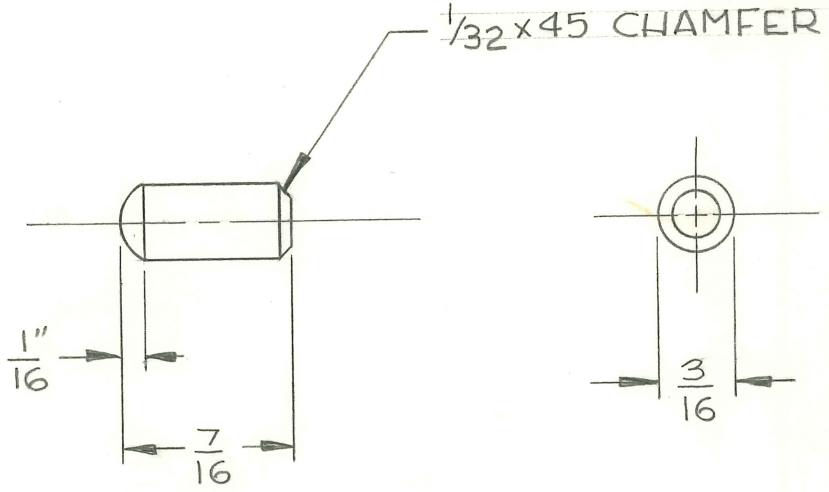

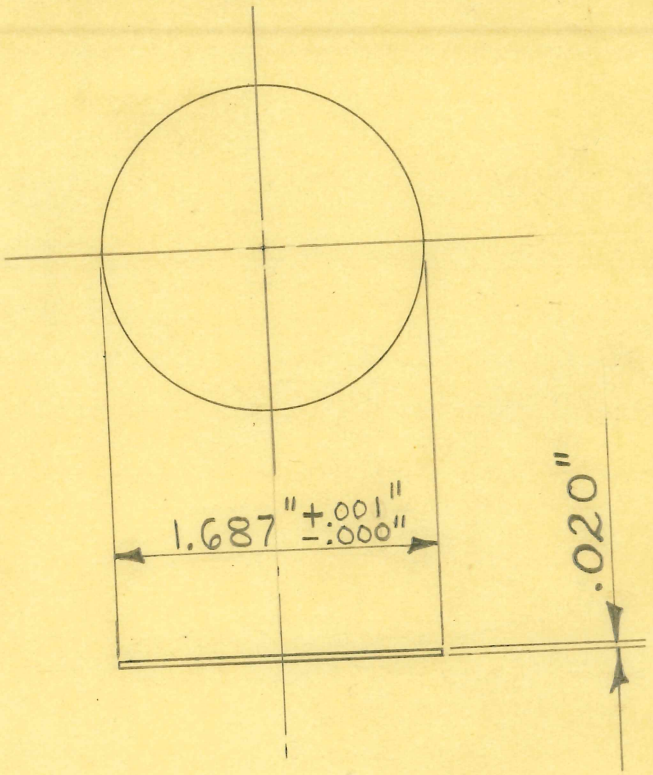

BLANKING DIE TOOL # 7866

DIMENSIONS	
FRACTIONAL	± .015
DECIMAL	± .005
ANGULAR	± 1/2°

UNLESS OTHERWISE SPECIFIED

SIZE	.020" SHEET	ISSUE 7-26-48	W.J.
KIND	ALUMINUM	CHANGED	
SHAPE		"	
FINISH		"	
TEMP.		"	
		"	

TITLE: "GF & TF" X-RAY
1/2 MM. ALUMINUM FILTER

H. G. FISCHER & CO.
2335 WABANSIA AVE.
CHICAGO. ILL.

CAT. NO.

PART NO. 12871

H. G. FISCHER & CO.
FRANKLIN PARK, ILLINOIS

REVISION	DATE	BY

TITLE "TF" 2½ MM PERMANENT ALUMINUM FILTER

DATE 2-25-58 DR BY J.V.W. CH'K'D.

SCALE FULL

DIMENSIONS
FRACTIONAL ± .015
DECIMAL ± .005
ANGULAR ± ½°
UNLESS OTHERWISE SPECIFIED

PATTERN

FINISH

MATERIAL #10 GA. (.102") SHEET #1100-H14 ALUMINUM

TOOLS BLANKING DIE #12605

STAMP SMALL LETTERS CLOSE TO EDGE.

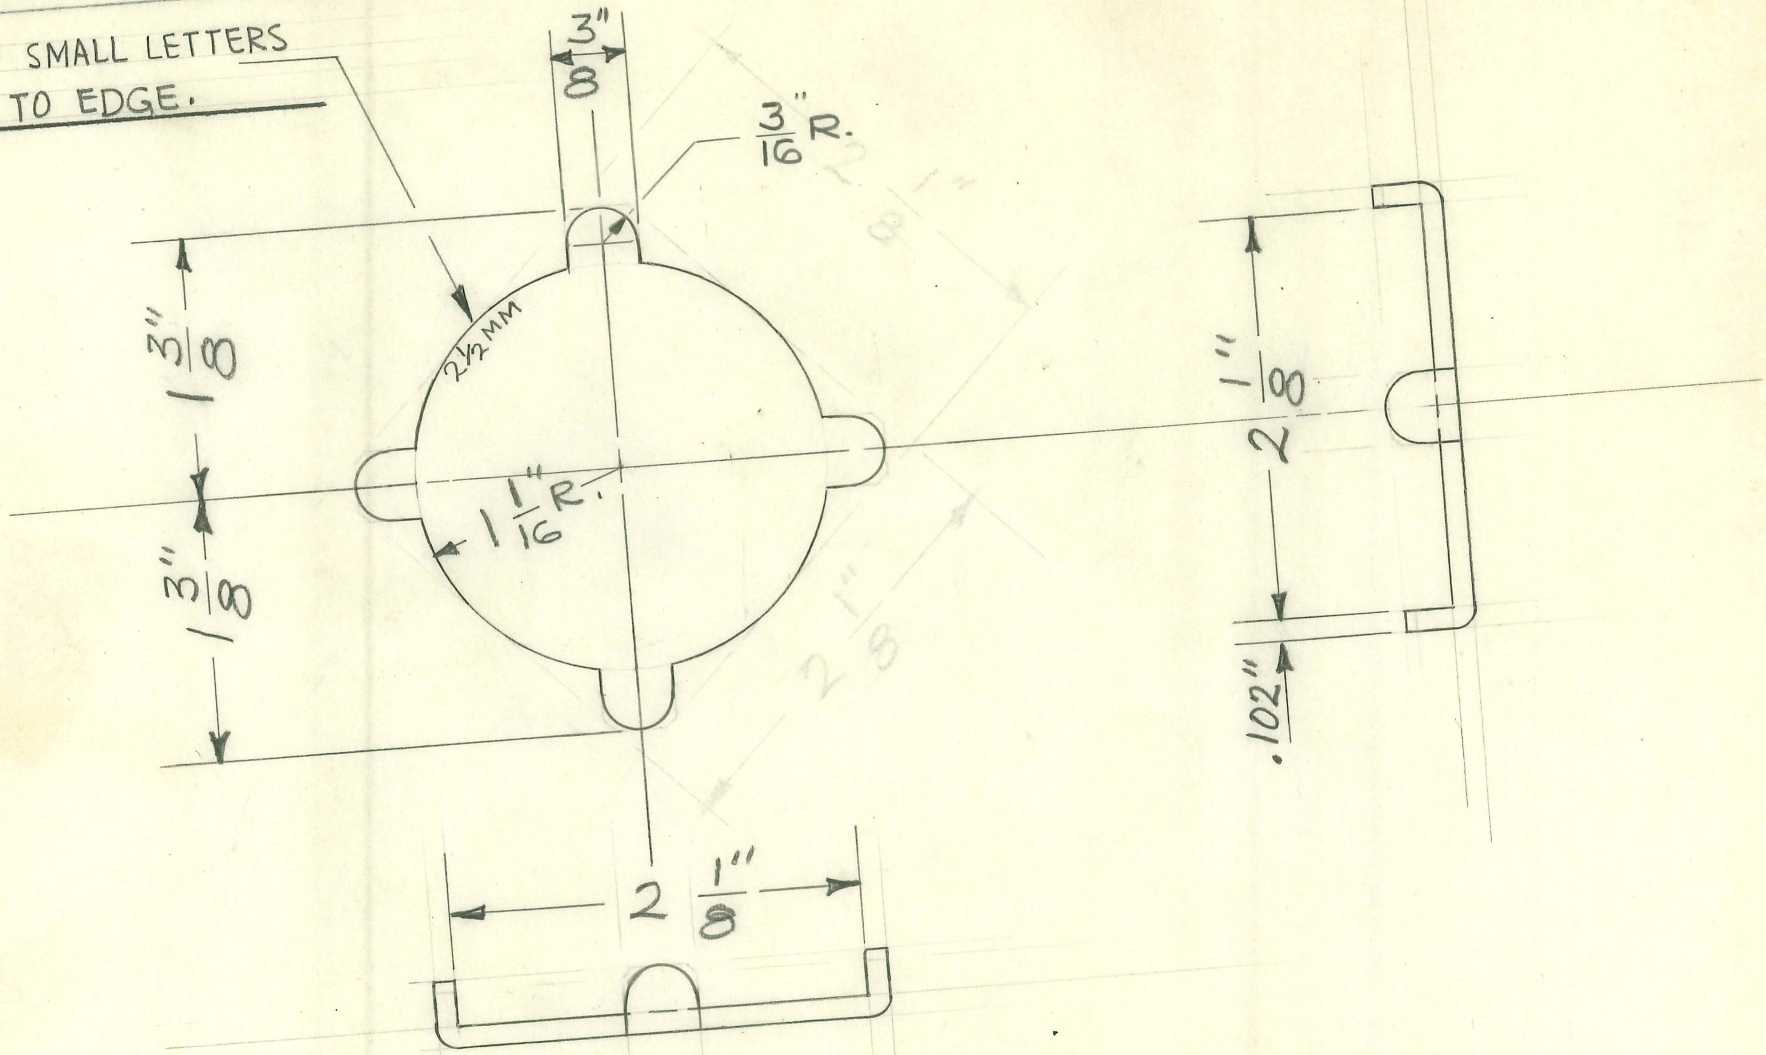

FOLDER #

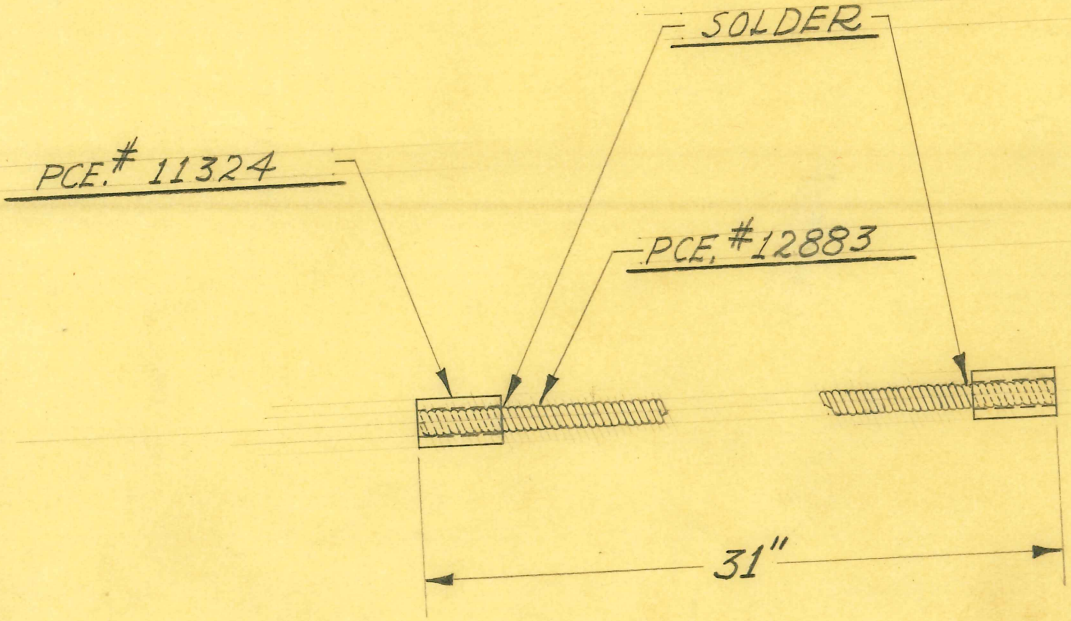

1 REQUIRED

SIZE		ISSUE 1-4-39	J.W.
KIND		CHANGED	
SHAPE		"	
FINISH	CAD. #23	"	
TEMP.		"	
DATE		"	

TITLE: FISCHER MOD. "TF-30-96" S.P. FLUOROSCOPE SHUTTER OPERATING SPRING ASSEM. - SHORT

H. G. FISCHER & CO.
2335 WABANSIA AVE.
CHICAGO, ILL.

CAT. NO.

PART NO. 12881G

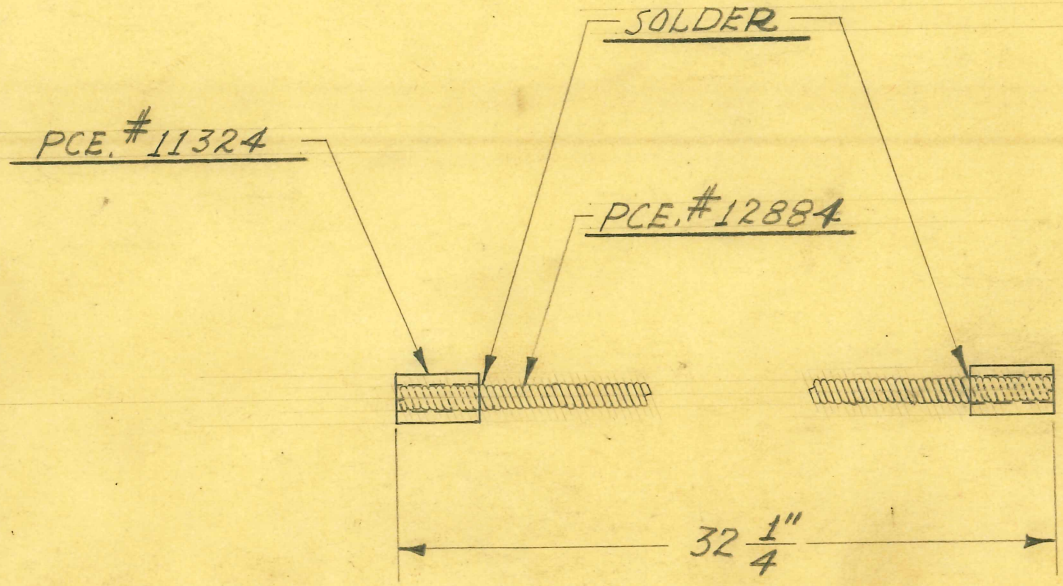

1 REQUIRED

SIZE		ISSUE 1-4-39	J.W.
KIND		CHANGED	
SHAPE		"	
FINISH	CAD. #23	"	
TEMP.		"	
PATT.		"	

TITLE: FISCHER MOD. "TF-30-96" S.P. FLUOROSCOPE SHUTTER OPERATING SPRING ASSEM.- LONG

H. G. FISCHER & CO.
2335 WABANSIA AVE.
CHICAGO, ILL.

CAT. NO.

PART NO. 12882G

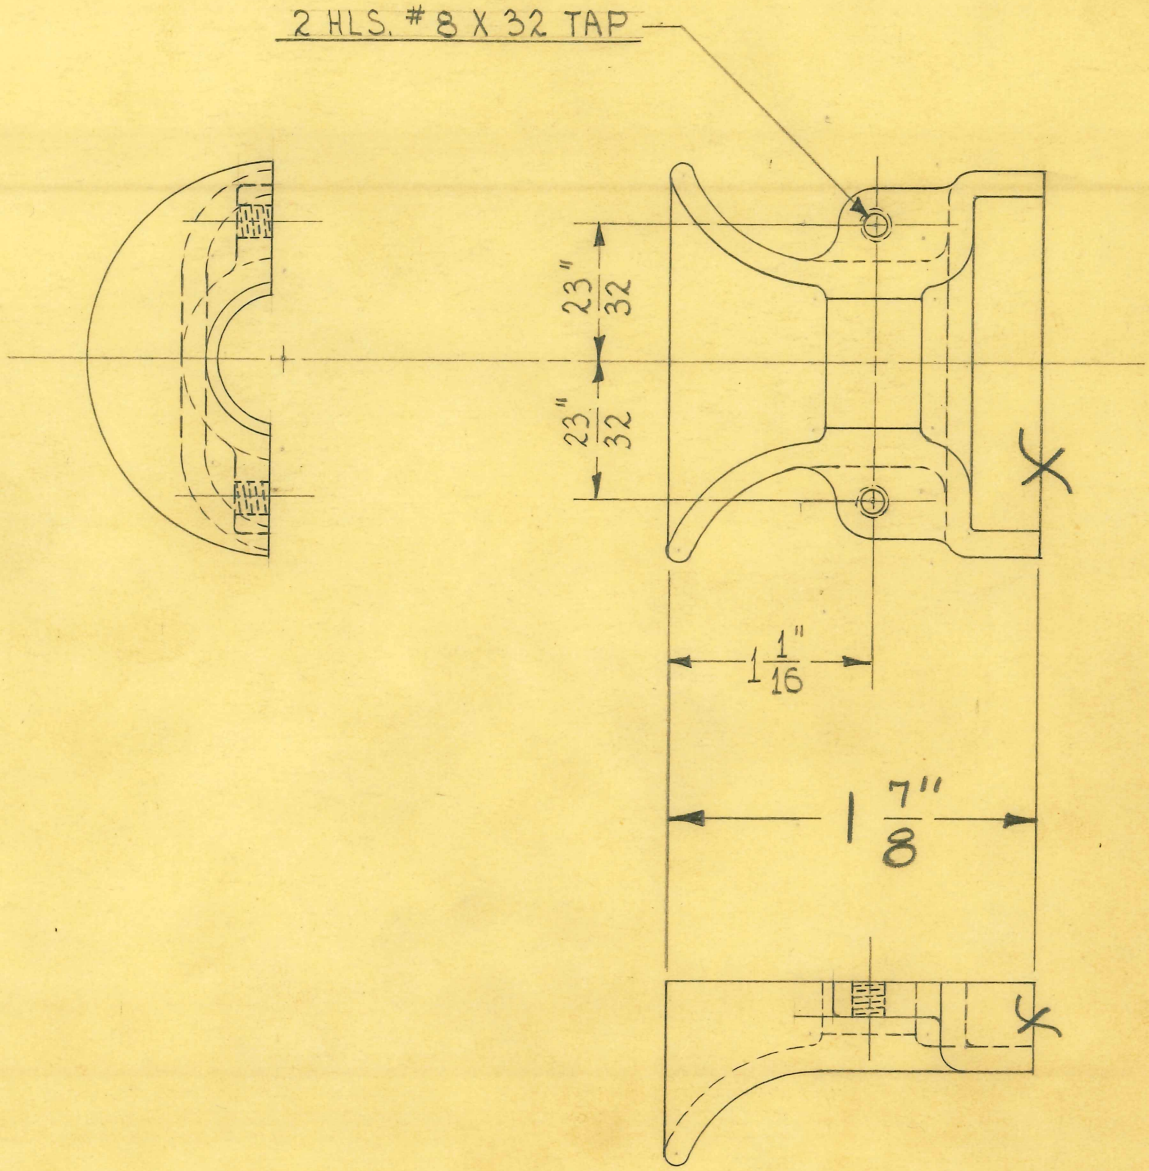

1 REQUIRED

SIZE	#12	ISSUE	HE.
KIND	ALUM. CASTING	CHANGED	
SHAPE		"5-21-47	
FINISH	PAINTED	"	
TEMP.		"	
PATT.	1435	"	

TITLE:
FISCHER MOD." TF-30-96 SHOCKPROOF
FLUOROSCOPE TRANSF. CABLE SUPP. CLAMP

H. G. FISCHER & CO.
2335 WABANSIA AVE.
CHICAGO, ILL.

CAT. NO.

PART NO. 12888FA

TITLE
CONVERSION KIT FOR DEAD MAN SWITCH - SYNCRO TIMER (CASE PLATE)

H. G. FISCHER & CO.
FRANKLIN PARK, ILLINOIS

PART NO. 12889

PATTERN	FINISH	SCALE
	262	FULL

MATERIAL
#18 GAUGE (.049) C. R. S.

TOOLS
DRILL JIG # 4663

DATE	DR. BY	CH'K'D.
6-6-67	CRS	LJB

DIMENSIONS—UNLESS OTHERWISE SPECIFIED:

FRACTIONAL	± .015	THREAD CHAMFER
DECIMAL	± .005	UP TO 5/16 D. - 1/32 X 45°
ANGULAR	± 1/2°	3/8 D. & OVER - 1/16 X 45°

REMOVE ALL BURRS & SHARP CORNERS

USED ON	QTY.	USED ON	QTY.
12843 G	1		

REVISION	DATE	BY

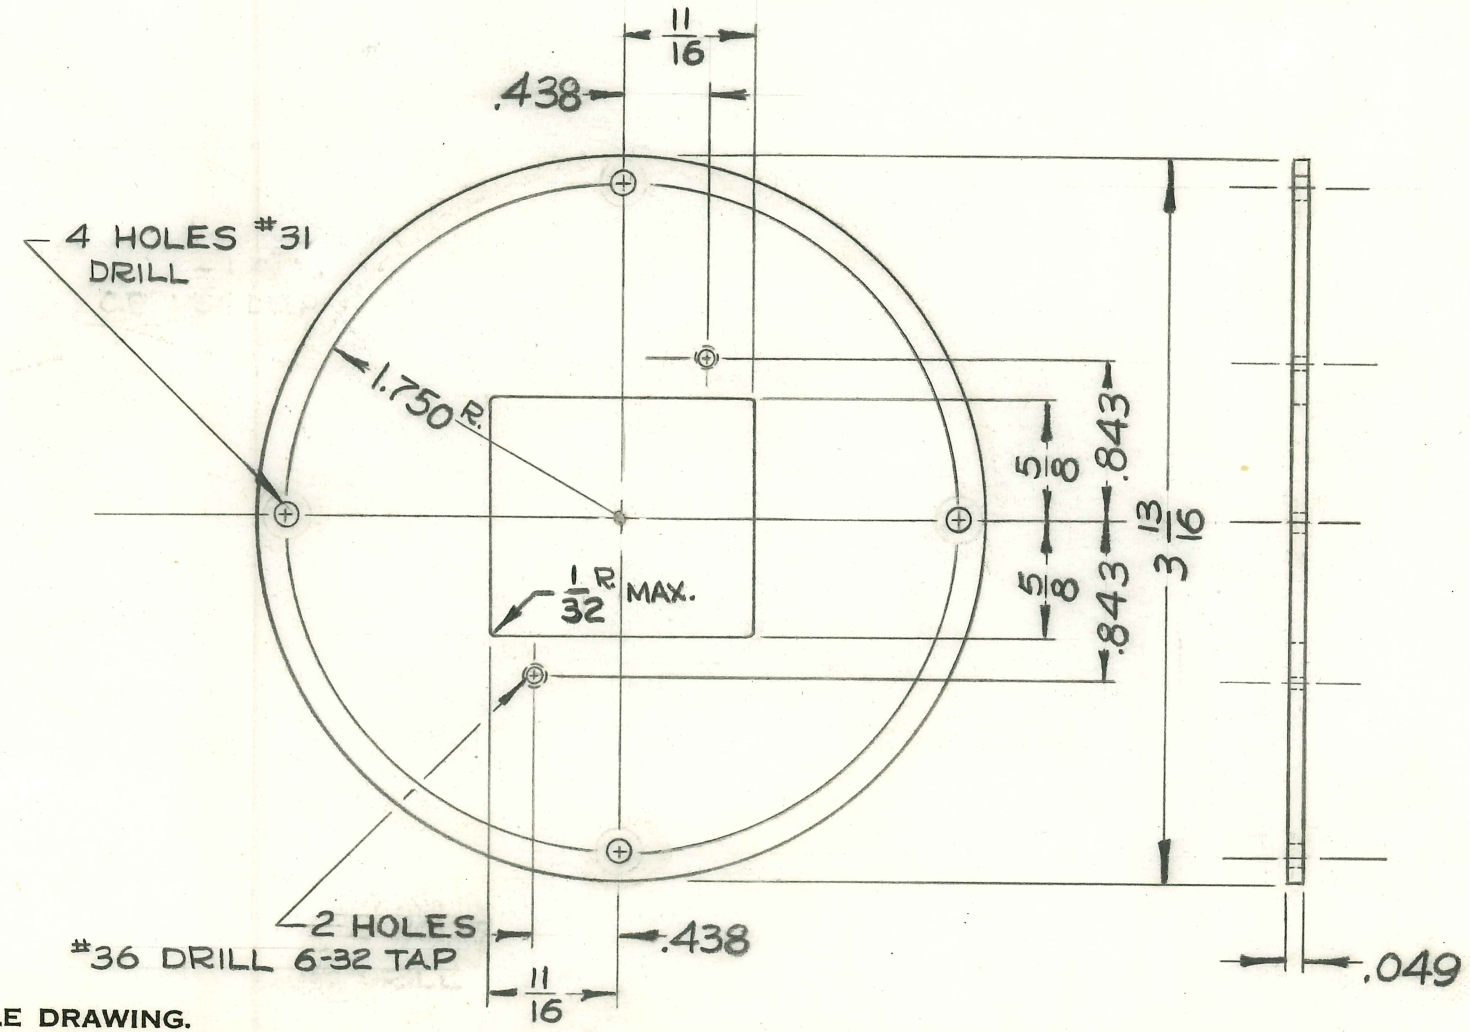

DO NOT SCALE DRAWING.

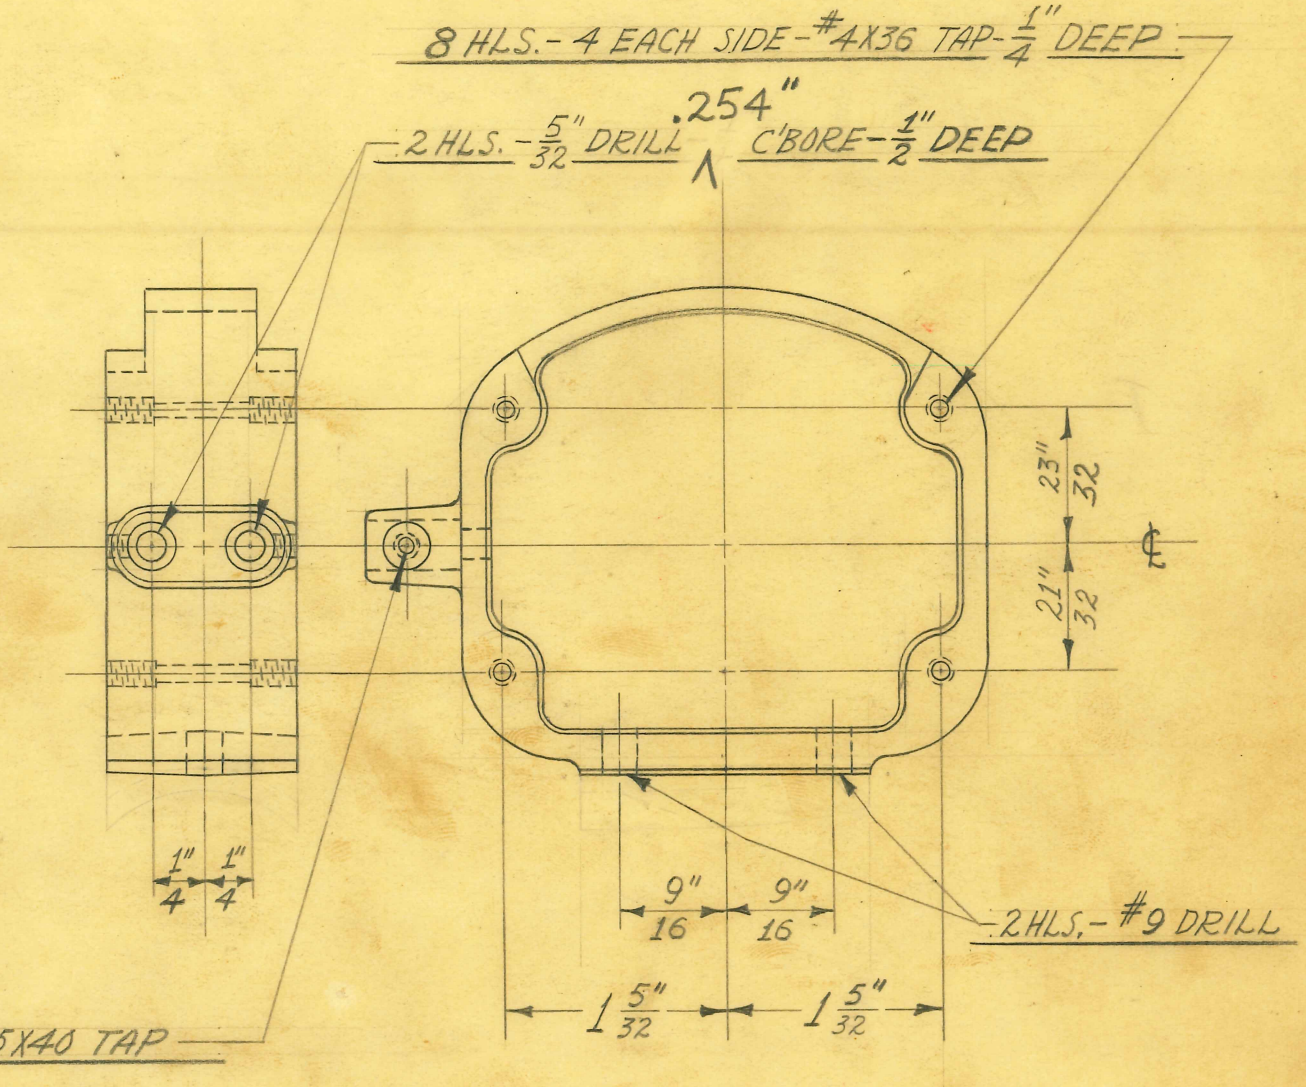

1 REQUIRED

SIZE	#12	ISSUE 11-16-39	J.W.
KIND	ALUM. CASTING	CHANGED	
SHAPE		" 10-3-46	J.V.W.
FINISH	PAINTED	"	
TEMP.		"	
PATT.	1436	"	

TITLE: "TF-30-96"
FISCHER MOD. SHOCKPROOF FLUOROSCOPE
SHUTTER LEVERS HOUSING

H. G. FISCHER & CO.
2335 WABANSIA AVE.
CHICAGO, ILL.

CAT. NO.

PART NO. 12892F

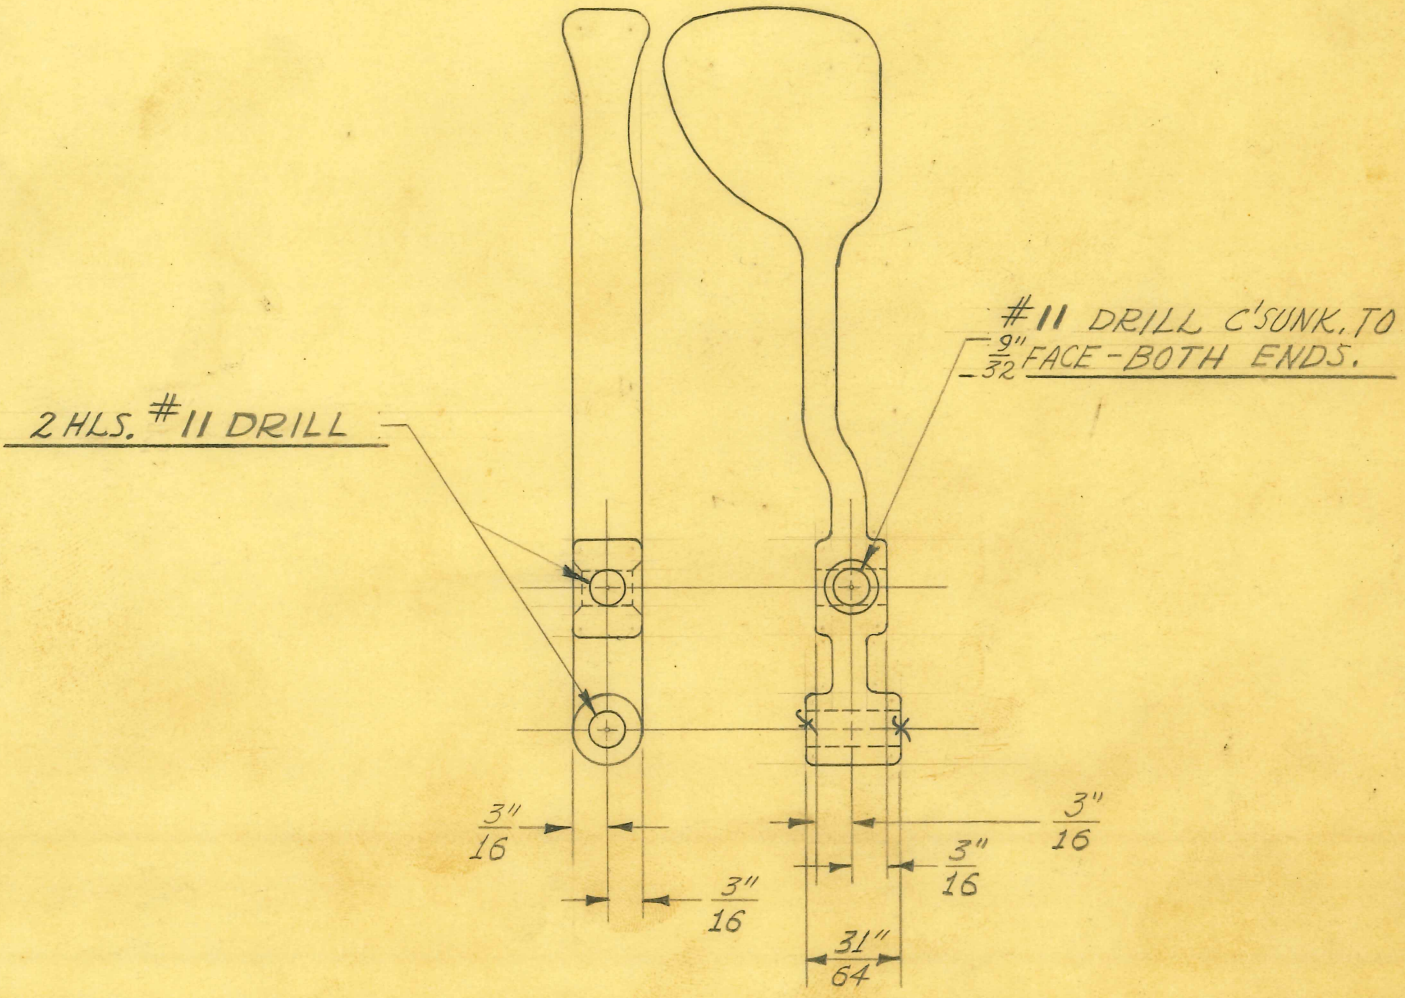

2 REQUIRED

SIZE	#12	ISSUE 11-18-39	J.W.
KIND	ALUM. CASTING	CHANGED	
SHAPE		"	
FINISH	POLISH	"	
TEMP.		"	
PATT.	1437	"	

TITLE: "TF-30-96" FISCHER MOD, SHOCKPROOF FLUOROSCOPE SHUTTER LEVER

H. G. FISCHER & CO.
2335 WABANSIA AVE.
CHICAGO, ILL.

CAT. NO.

PART NO. 12893F

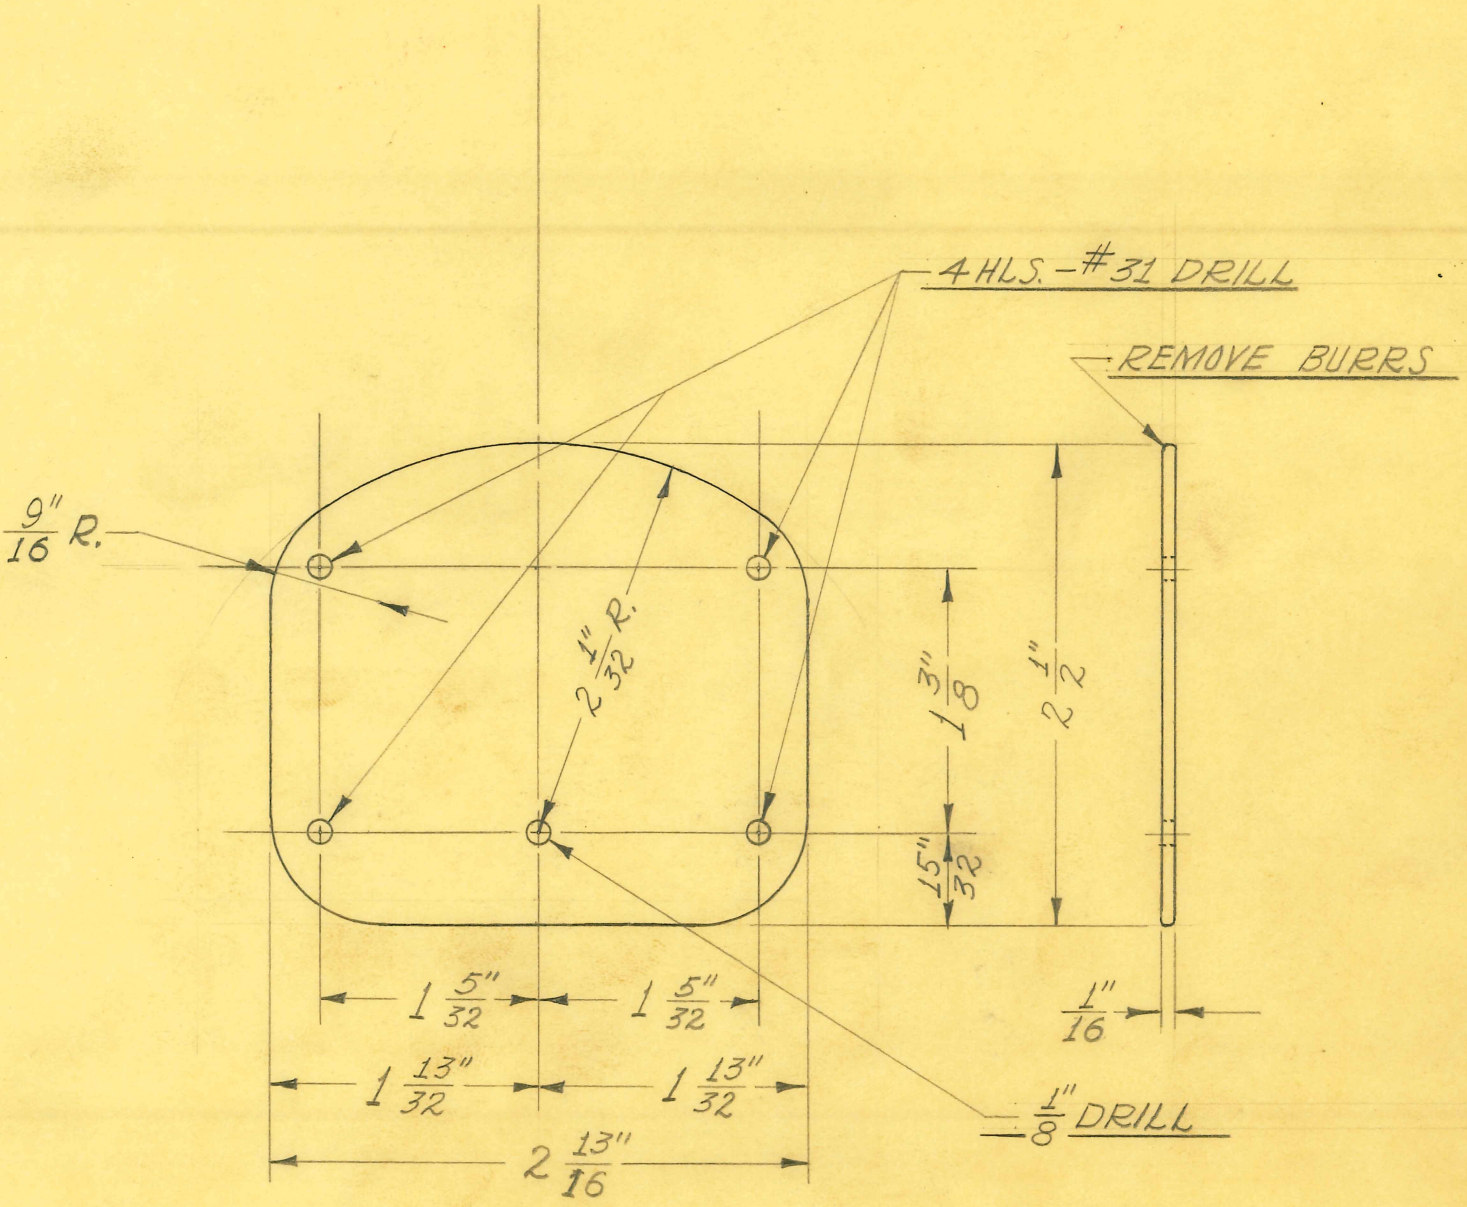

2 REQUIRED

SIZE	1/16" SHEET	ISSUE 11-18-39	J.W.
KIND	C.R. STEEL	CHANGED	
SHAPE		"	
FINISH	PAINTED	"	
TEMP.		"	
PATT.		"	

TITLE: "TF-30-96"
FISCHER MOD. SHOCKPROOF FLUOROSCOPE
SHUTTER LEVERS HOUSING COVER

H. G. FISCHER & CO.
2335 WABANSIA AVE.
CHICAGO, ILL.

CAT. NO.

PART NO. 12894

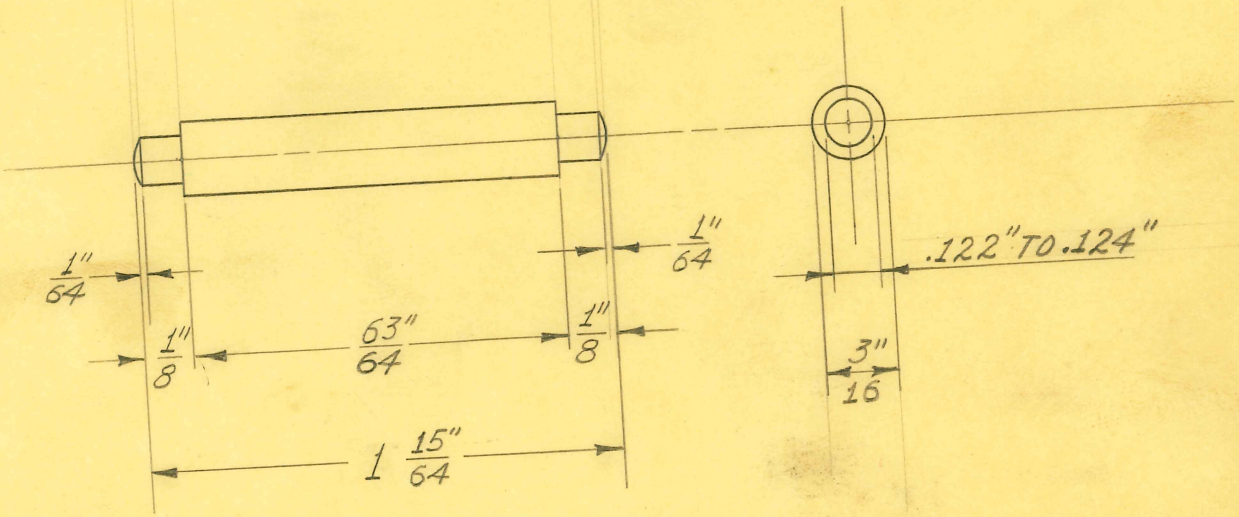

SCALE ~ 2 DIAMETERS

1 REQUIRED

SIZE	3/16" DIAM.	ISSUE 11-20-35	J.W.
KIND	C.R. STEEL	CHANGED	
SHAPE	ROD	"	
FINISH	CHR. WH. #3	"	
TEMP.		"	
		"	

TITLE: "TF-30-96" FISCHER MOD. SHOCKPROOF FLUOROSCOP
SHUTTER LEVER SWIVEL PIN

H. G. FISCHER & CO.
2335 WABANSIA AVE.
CHICAGO, ILL.

CAT. NO.

PART NO. 12895

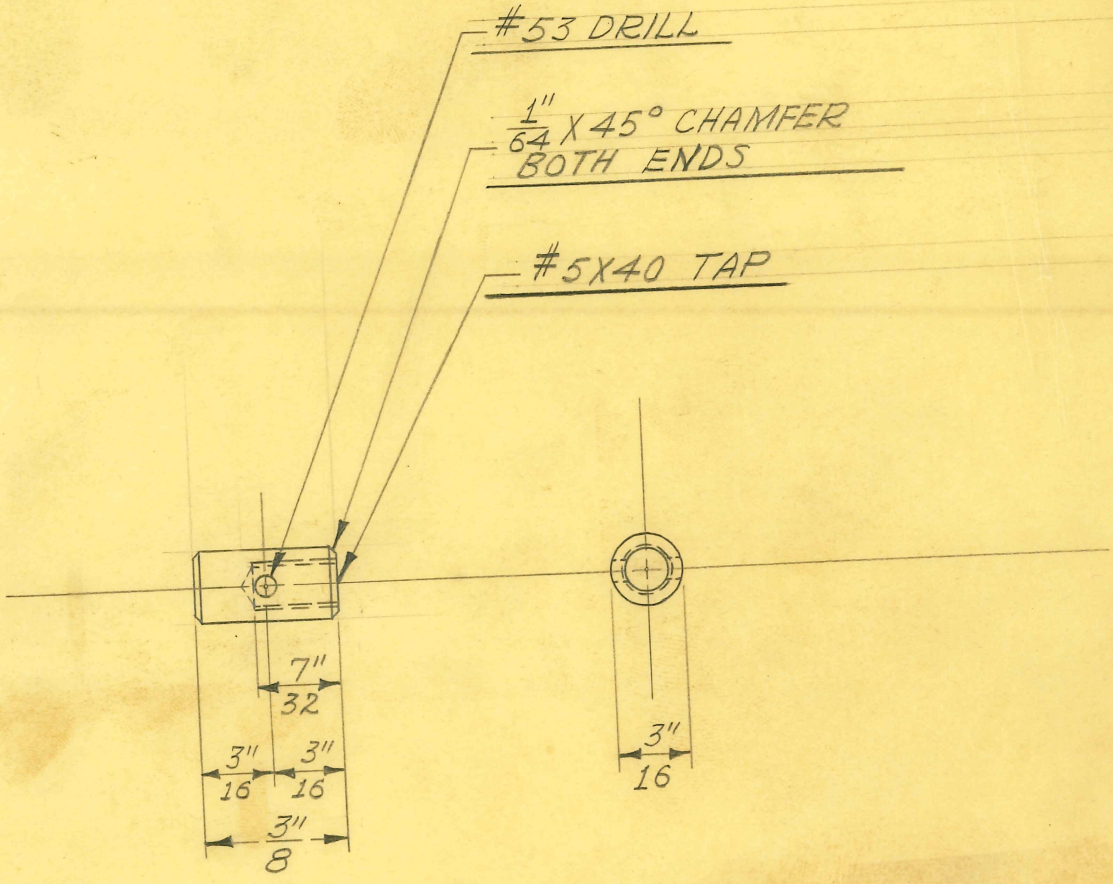

SCALE ~ 2 DIAMETERS

2 REQUIRED

SIZE	3/16" DIAM.	ISSUE 11-18-39	J.W.
KIND	C.R. STEEL	CHANGED	
SHAPE	ROD	"	
FINISH		"	
TEMP.		"	
PATT.		"	

TITLE: "TF-30-96" FISCHER MOD. SHOCKPROOF FLUOROSCOPE SHUTTER LEVER OPERATING WIRE CLAMP PIECE

H. G. FISCHER & CO.
2338 WABANSIA AVE.
CHICAGO, ILL.

CAT. NO.

PART NO. 12896

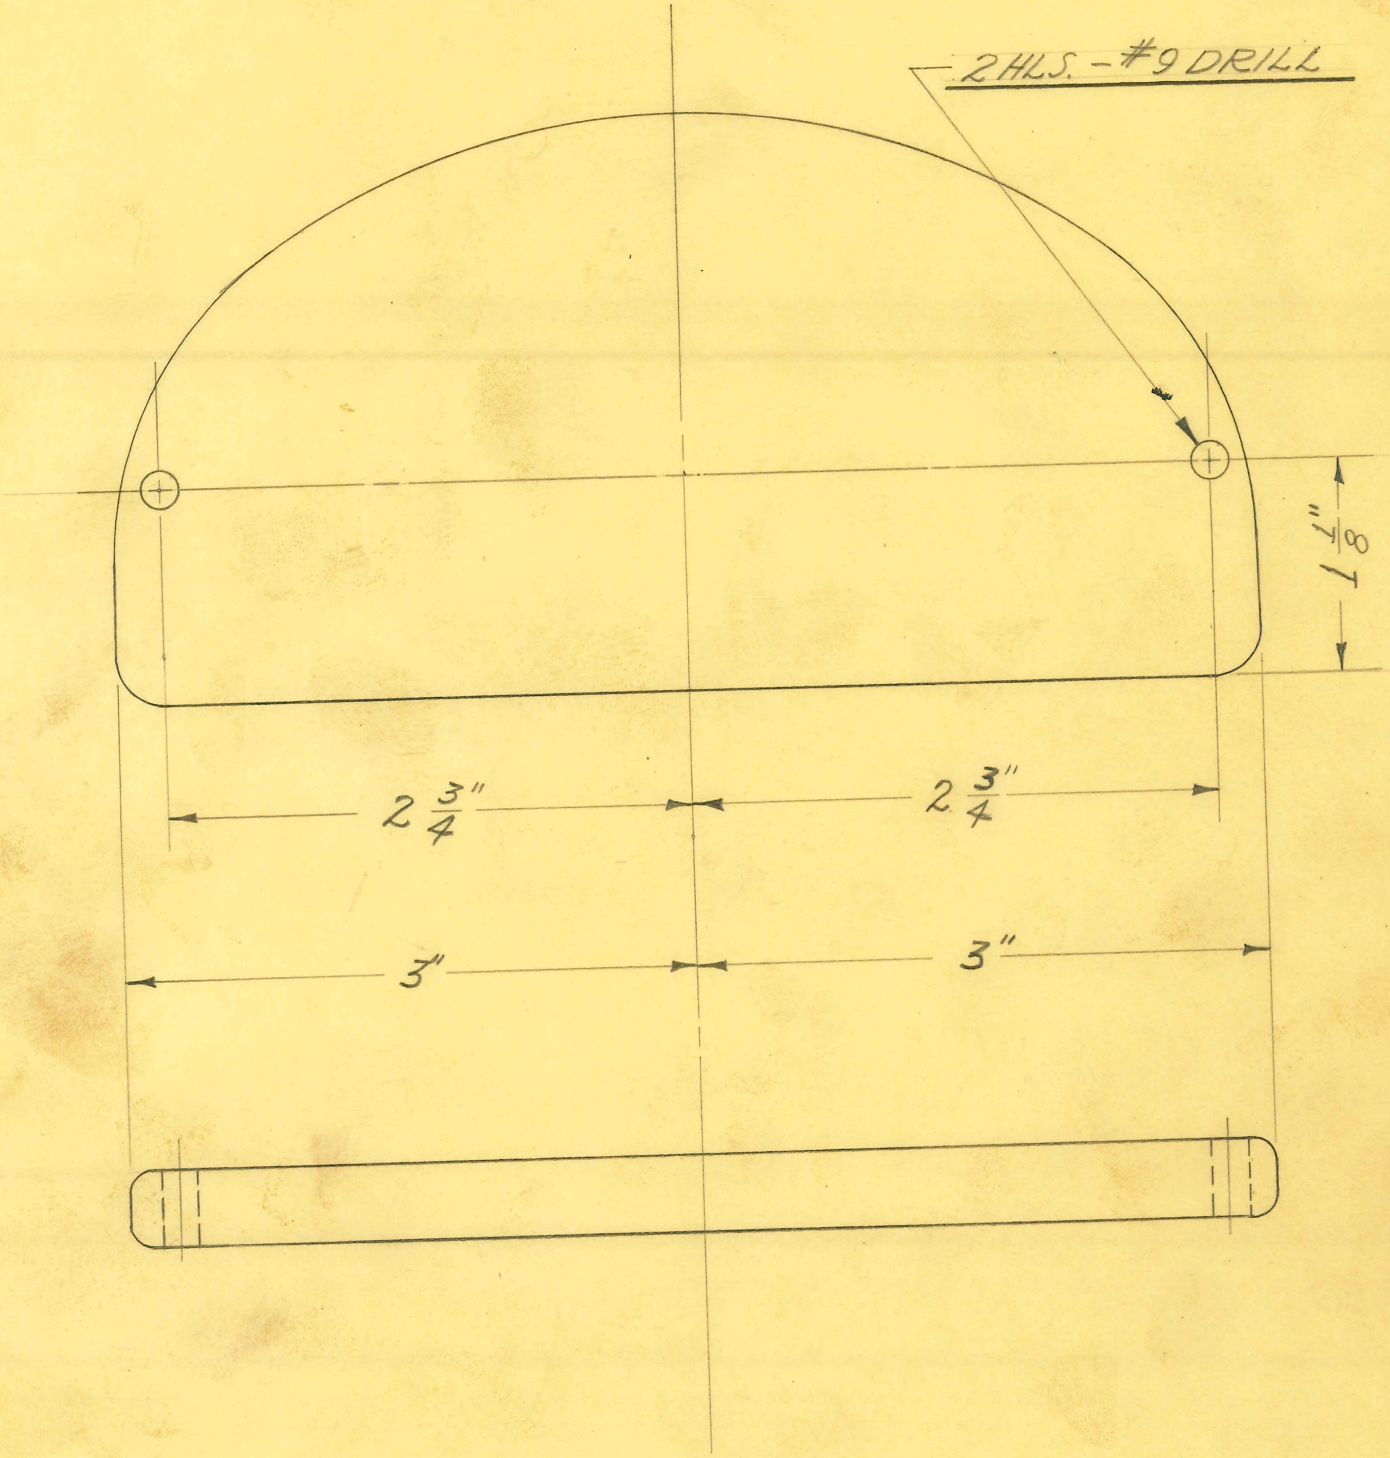

2 REQUIRED

SIZE	IRON	ISSUE 10-17-40	J.V.W.
KIND	CASTING	CHANGED	
SHAPE		"	
FINISH	PAINTED	"	
TEMP.		"	
PAT.	1525	"	

TITLE: FISCHER MOD. "TF-30-96" S.P. FLUOROSCOPE FLUOROSCOPIC SCREEN C'BALANCE. PLATE

H. G. FISCHER & CO.
2335 WABANSIA AVE.
CHICAGO, ILL.

CAT. NO.

PART NO. 12902F

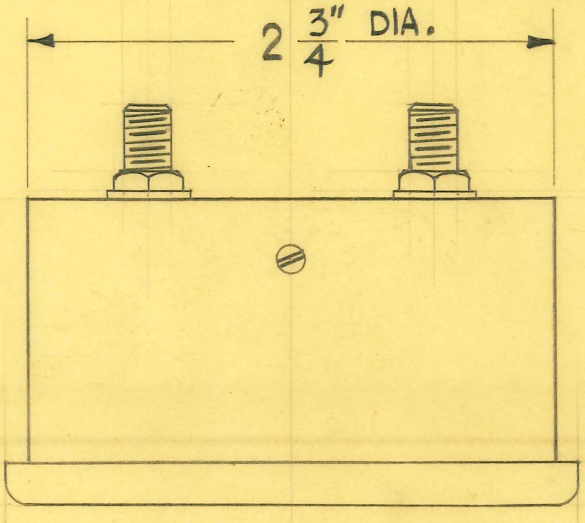

4 HLS-#25 DRILL-C'SUNK.
FOR #6 OVAL HD. SCR.

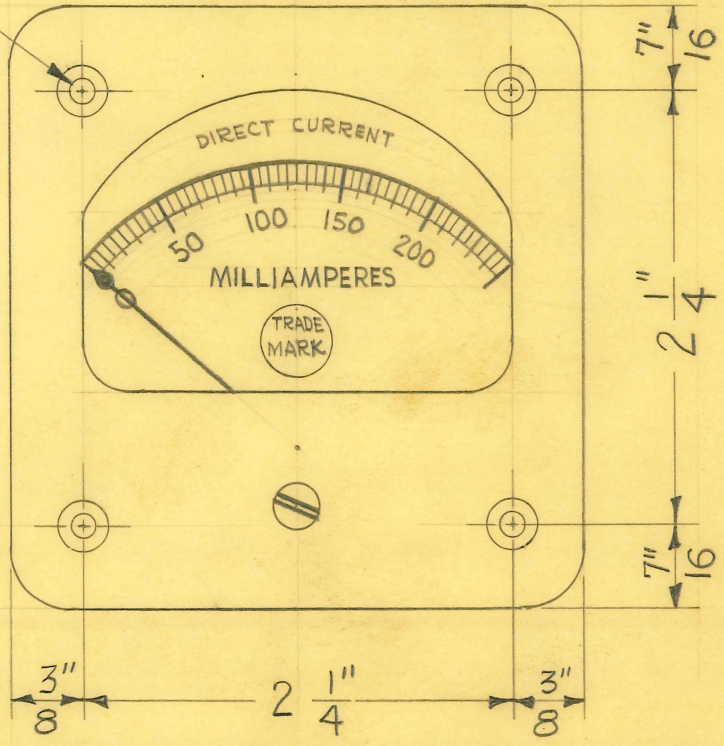

SIZE		ISSUE 2-17-42	J.V.W.
KIND		CHANGED	
SHAPE		"	
FINISH		"	
TEMP.		"	
DATE		"	

TITLE:
FISCHER MOD. "PMA" MILLIAMPERE METER

H. G. FISCHER & CO.
2335 WABANSIA AVE.
CHICAGO, ILL.

CAT. NO.

PART NO. 12966G

#10X32 TAP TO BOTTOM
5/16" DEEP

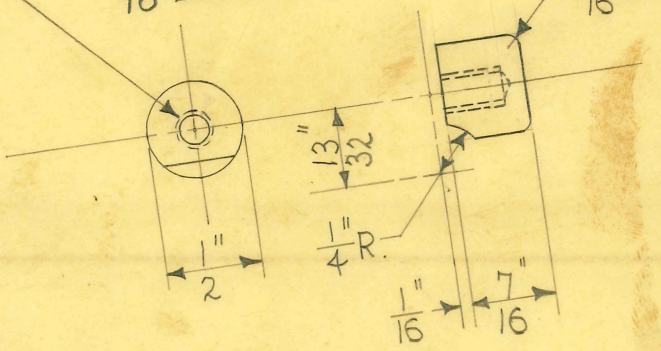

1/2" DIAM. BRASS ROD

#52 DRILL CSK. BOTH SIDES FOR RIVETING. 1/16" C.R. STEEL PIN RIVETED OVER ON BOTH ENDS.

Pc. No. 12997A

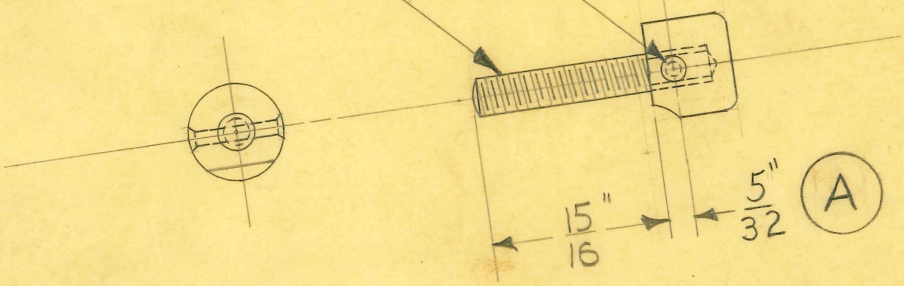

1 REQUIRED

REVISION	DATE	BY
A WAS 1/8"	4-18-56	C.K.

DRILL JIG #12408

SIZE		ISSUE 5-29-40	H.E.
KIND		CHANGED	
SHAPE		"	
FINISH	CAD. #23	"	
		"	

TITLE: FISCHER MOD. "TF-30-96" S.P. FLUOR
SCREEN FRAME SWIVEL-FRICTION LOCK-

H. G. FISCHER & CO.
2335 WABANSIA AVE.
CHICAGO, ILL.

CAT. NO.

PART NO. 12

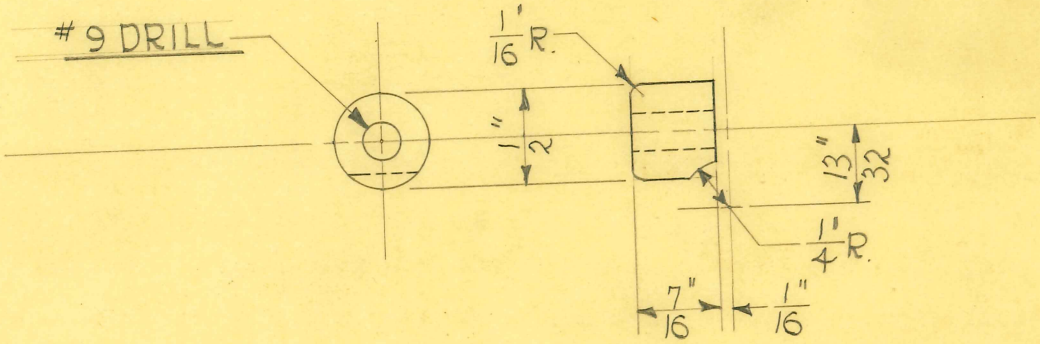

1 REQUIRED

SIZE	½" DIAM.	ISSUE 5-28-40	HE.
KIND	BRASS ROD	CHANGED	
SHAPE		"	
FINISH	CAD. #23	"	
TEMP.		"	
PATT.		"	

TITLE: FISCHER MOD. "TF-30-96" S.P. FLUOROSCOPE-SCREEN FRAME SWIVEL-FRICTION LOCK-FRONT

H. G. FISCHER & CO.
2335 WABANSIA AVE.
CHICAGO, ILL.

CAT. NO.

PART NO. 12976

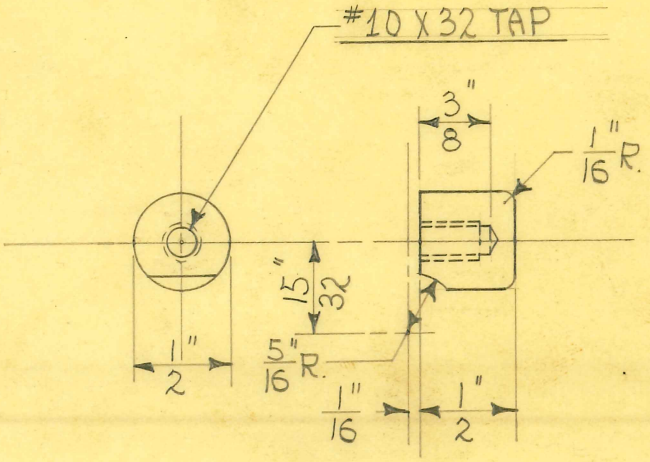

1/2" DIAM. BRASS ROD

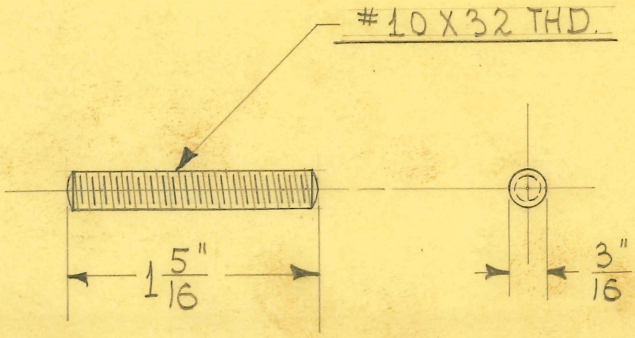

3/16" DIAM. C.R. STEEL ROD

#52 DRILL CSK. BOTH SIDES. FOR RIVETING. 1/16" C.R. STEEL PIN RIVETED OVER ON BOTH ENDS.

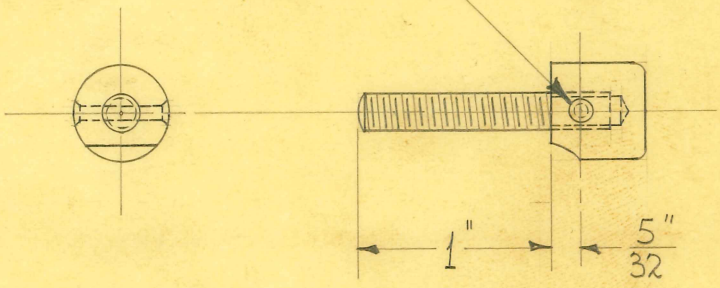

1 REQUIRED

SIZE		ISSUE 5-27-40	HE.
KIND		CHANGED	
SHAPE		"	
FINISH	CAD. #23	"	
TEMP.		"	
PATT.		"	

TITLE: FISCHER MOD. "TF-30-96" S.P. FLUOROSCOPE - SCREEN FORK SWIVEL - FRICTION LOCK - REAR

H. G. FISCHER & CO.
2335 WABANSIA AVE.
CHICAGO, ILL.

CAT. NO.

PART NO. 12977G

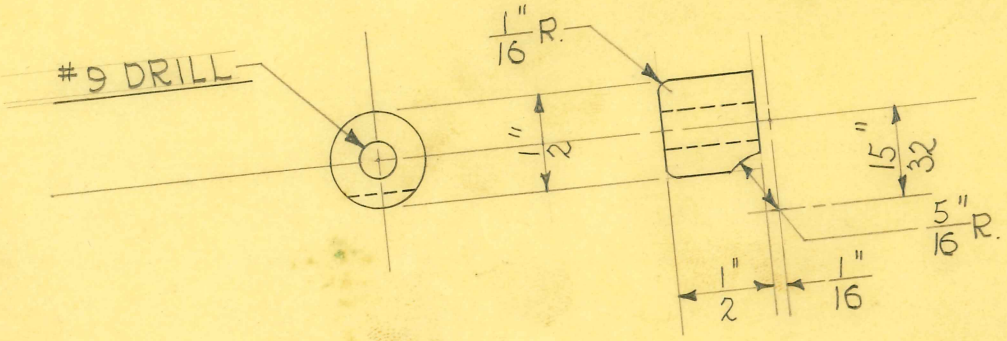

1 REQUIRED

SIZE	1/2" DIAM.	ISSUE 5-27-40	HE.
KIND	BRASS ROD	CHANGED	
SHAPE		"	
FINISH	CAD. #23	"	
TEMP.		"	

TITLE: FISCHER MOD. "TF-30-96" S.P. FLUOROSCOP
SCREEN FORK SWIVEL - FRICTION LOCK - FR

H. G. FISCHER & CO.
2335 WABANSIA AVE.
CHICAGO, ILL.

CAT. NO.

PART NO. 1297

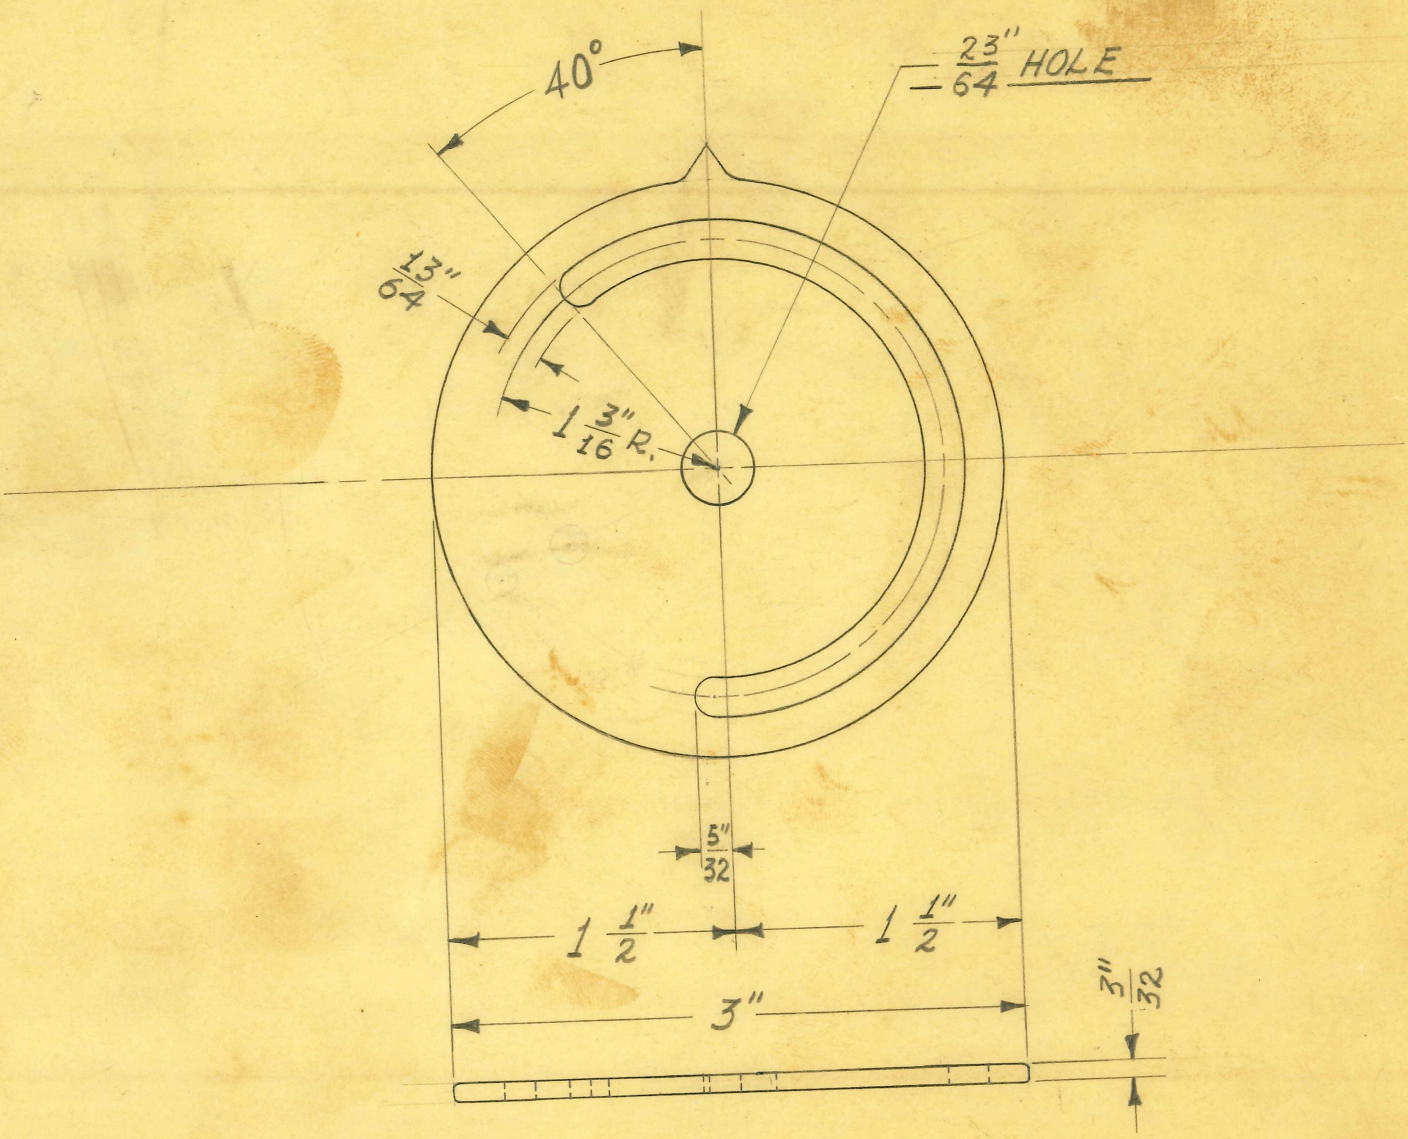

1 REQUIRED

SIZE	3/32" SHEET	ISSUE 2-26-40	J.W.
KIND	C.R. STEEL	CHANGED	
SHAPE		"	
FINISH		"	
TEMP.		"	
		"	

TITLE: FISCHER MOD. "TF-30-96" S.P. FLUOROSCOPE TRANSF. HEAD CLAMP & INDICATOR PLATE -BLANK

H. G. FISCHER & CO.
2335 WABANSIA AVE.
CHICAGO, ILL.

CAT. NO.

PART NO. 12981

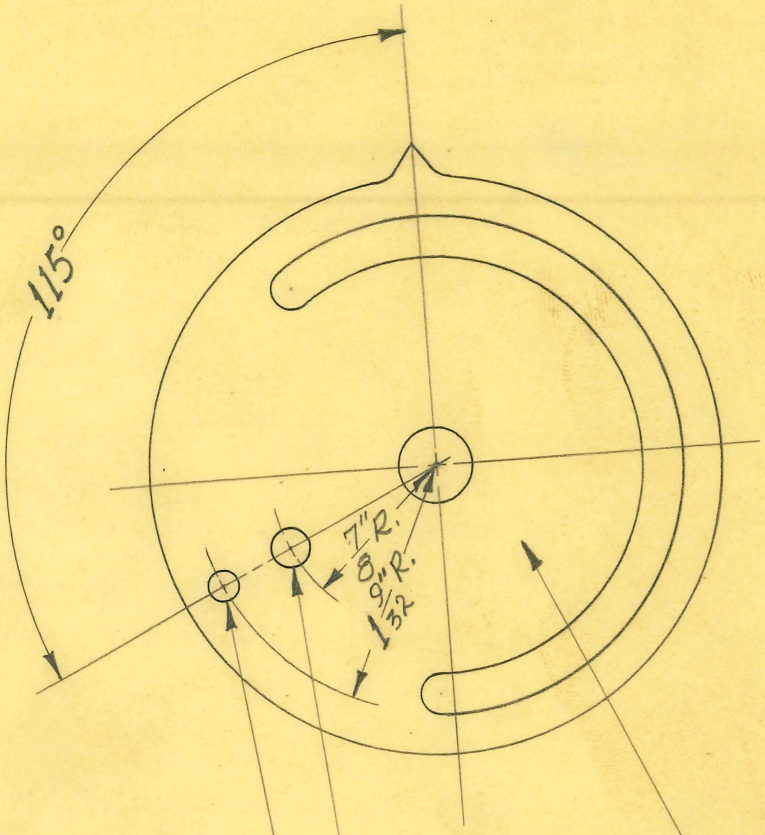

#9 DRILL

CHROME #2 - POLISH
THIS FACE & EDGE ONL

5/32" REAMER

1 REQUIRED

SIZE	FROM	ISSUE 2-23-40	J.W.
KIND		CHANGED	
SHAPE		"	
FINISH	CHR. #2 SEE NOTE	"	
TEMP.		"	

TITLE: FISCHER MOD. "TF-30-96" S.P. FLUOROSCO
TRANSF. HEAD CLAMP & INDICATOR PLA

H. G. FISCHER & CO.
2338 WABANSIA AVE.
CHICAGO, ILL.

CAT. NO.

PART NO. 1298

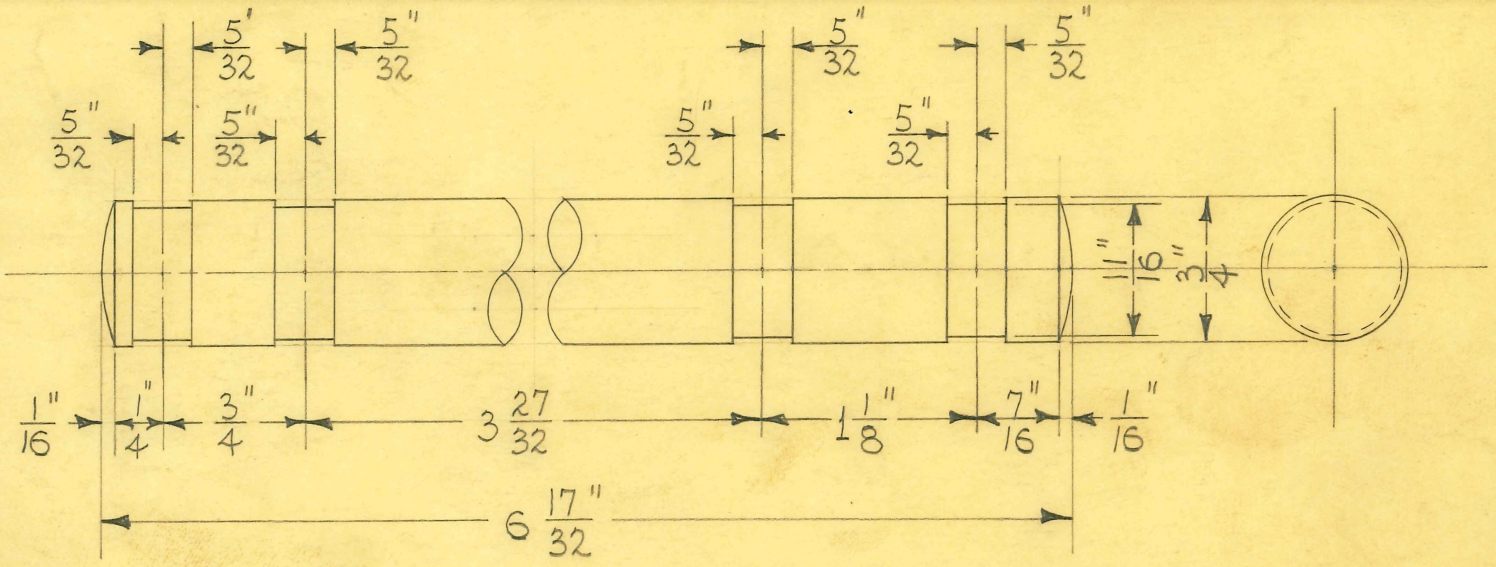

REMOVE ALL SHARP EDGES

2 REQUIRED

SIZE	3/4" DIAM.	ISSUE 1-25-40	HE.
KIND	JEWELERS ROD	CHANGED	
SHAPE		"	
FINISH	CAD. #23	"	
TEMP.		"	
PATT.		"	

TITLE: FISCHER MOD. "TF-30-96" S.P. FLUOROSCOPE-SCREEN FRAME SUPP. ARM BRACE ROD (SHORT)

H. G. FISCHER & CO.
2335 WABANSIA AVE.
CHICAGO, ILL.

CAT. NO.

PART NO. 12987

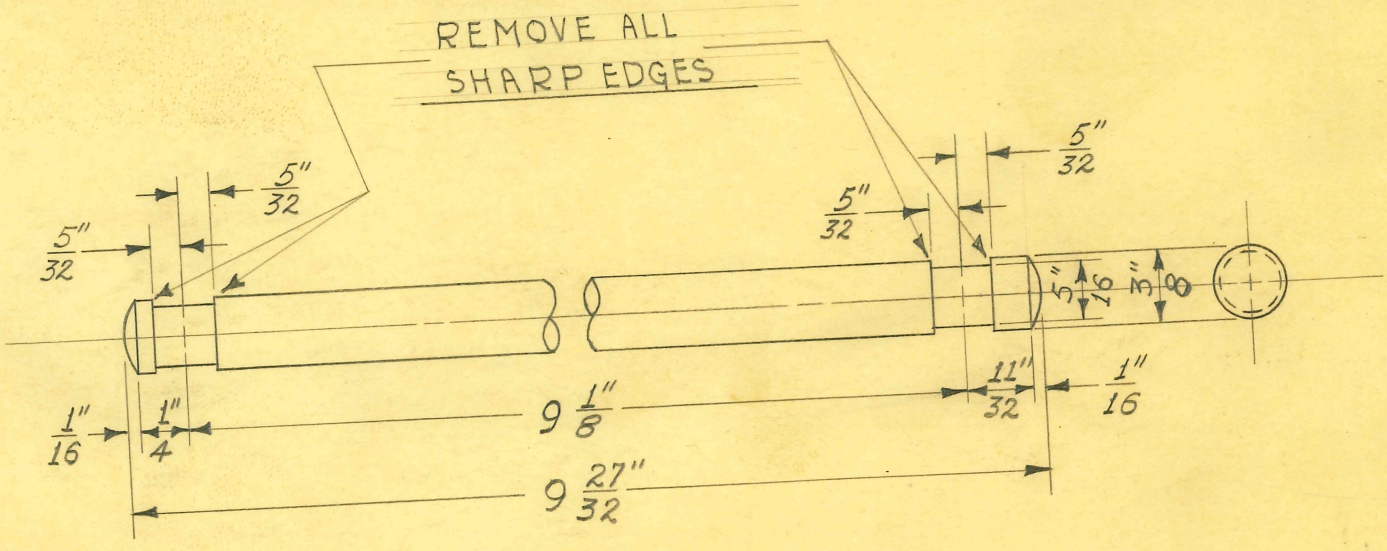

1 REQUIRED

SIZE	3/8" DIAM.	ISSUE 3-11-40	J.W.
KIND	JEWELERS ROD	CHANGED	
SHAPE		"	
FINISH	DULITE #8	"	
TEMP.		"	

TITLE: FISCHER MOD. "TF-30-96" S.P. FLUOROSCOPE TRANSF. SWINGING ARM ROD

H. G. FISCHER & CO.
2335 WABANSIA AVE.
CHICAGO, ILL.

CAT. NO.

PART NO. 12991

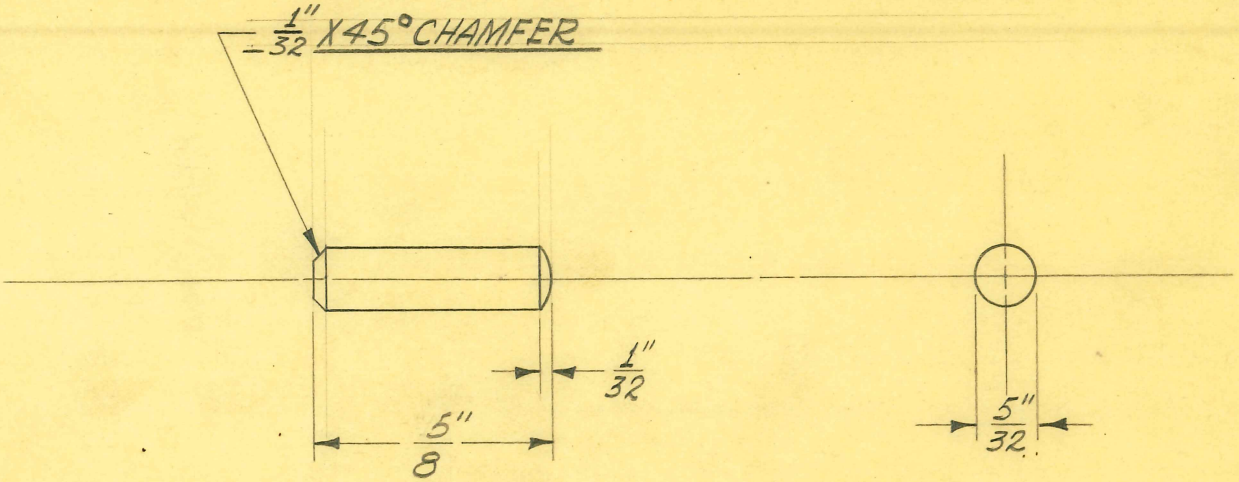

SCALE ÷ DOUBLE SIZE

1 REQUIRED

SIZE	5/32" DIAM.	ISSUE 3-11-40	J.W.
KIND	C.R. STEEL	CHANGED	
SHAPE		"	
FINISH	CHROME #2 POL. ROUNDED END ONLY	"	
TEMP.		"	
PATT.		"	

TITLE: FISCHER MOD. "TF-30-96" S.P. FLUOROSCOPE INDICATOR PLATE ALIGNING PIN

H. G. FISCHER & CO.
2335 WABANSIA AVE.
CHICAGO, ILL.

CAT. NO.

PART NO. 12992

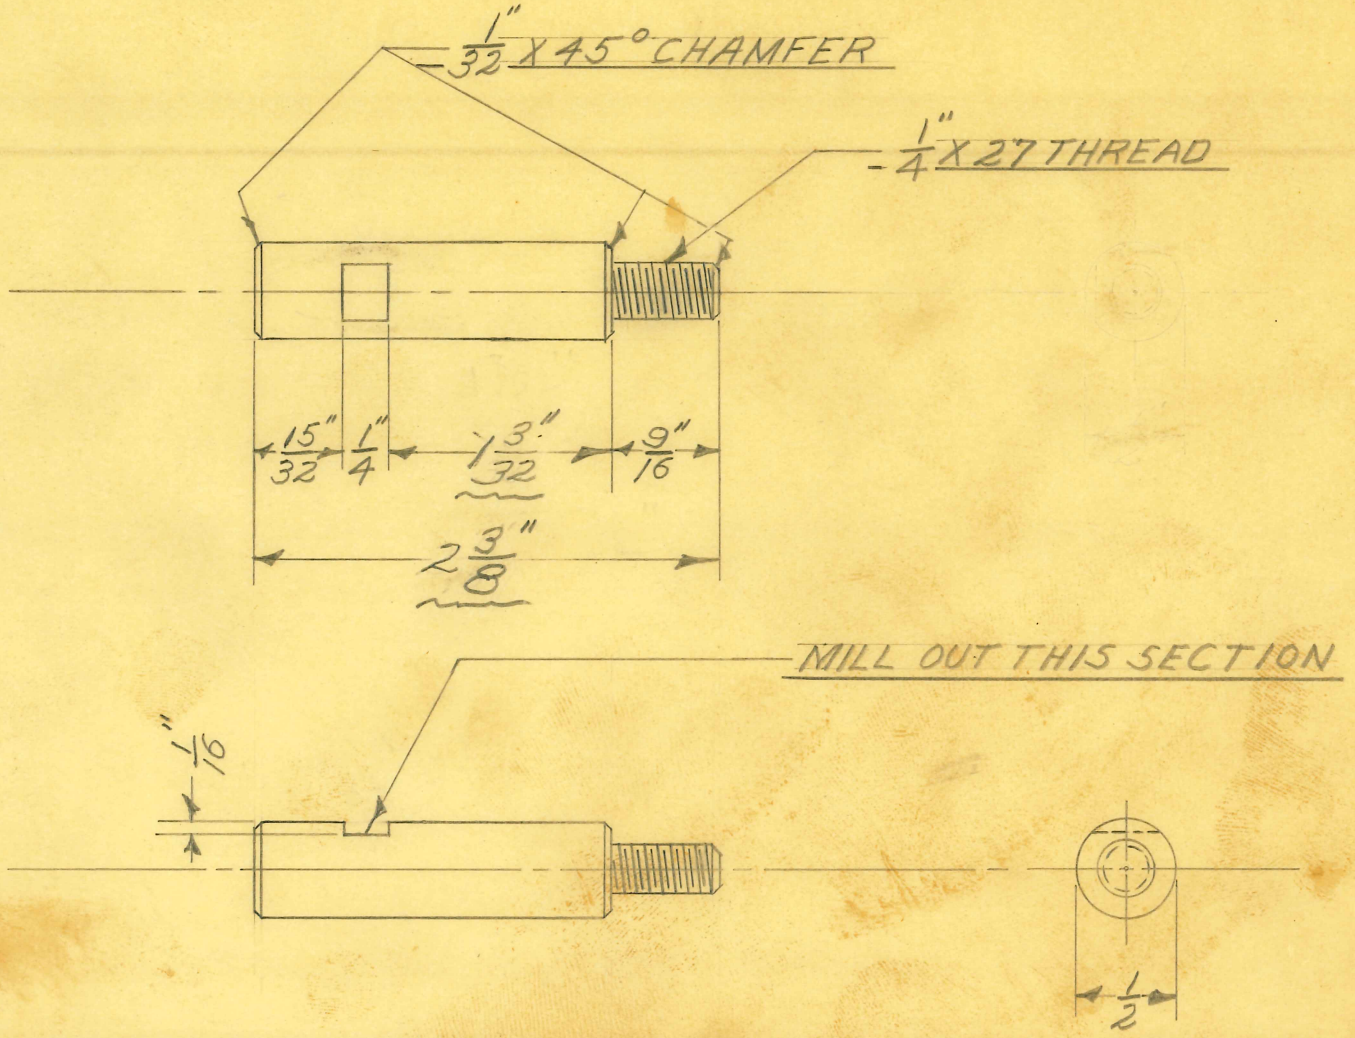

2-REQUIRED

SIZE	½" DIAM.	ISSUE 8-19-47	JMF.
KIND	C.R. STEEL	CHANGED	
SHAPE		"	
FINISH	CAD # 23	"	
TEMP.		"	
PATT.		"	

TITLE:
FISCHER MOD. "TF-30-96" S.P. FLUOROSCOPE SCREEN FORK LOCK SHAFT

H. G. FISCHER & CO.
2335 WABANSIA AVE.
CHICAGO, ILL.

CAT. NO.

PART NO. 12993A

TITLE

FISCHER MOD. "TF-30-96" S.P. FLUOROSCOPE

FLUOROSCOPIC SCREEN CLAMP STRIP HOLDER

H. G. FISCHER & CO.
FRANKLIN PARK, ILLINOIS

PART NO. 12996A

DATE 6-6-50 | DR. BY W.J. | CH'K'D.

REVISION	DATE	BY

PATTERN | FINISH | SCALE FULL

TOOLS: BLANKING DIE # 6533 O-1

MATERIAL: 1/16" X 1 3/8" SHEARED C.R. STEEL

DIMENSIONS UNLESS OTHERWISE SPECIFIED
FRACTIONAL ± .015
DECIMAL ± .005
ANGULAR ± ½°

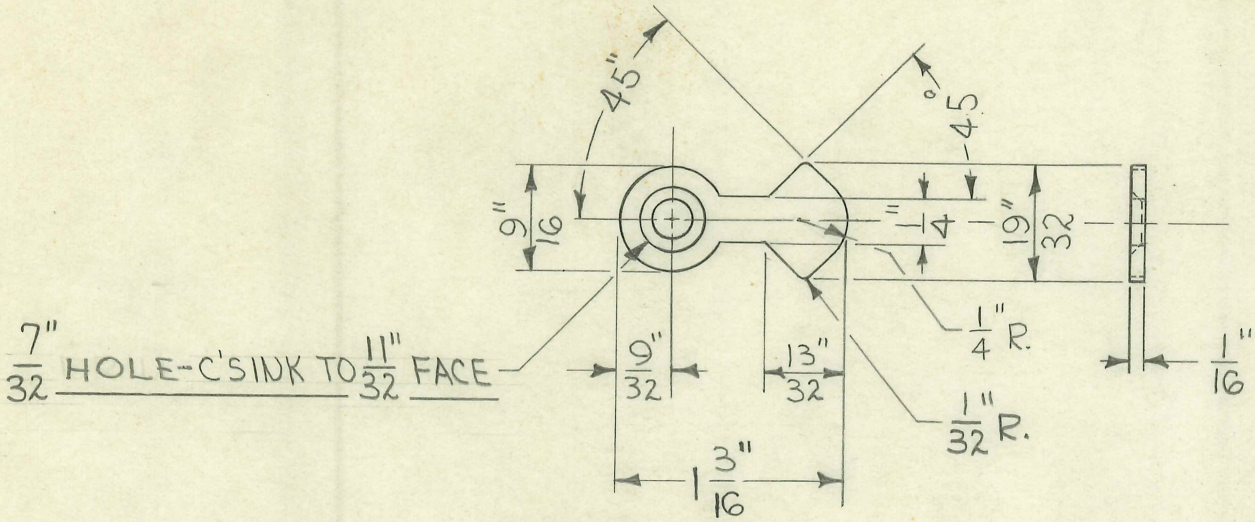

4 REQUIRED

FOLDER #102

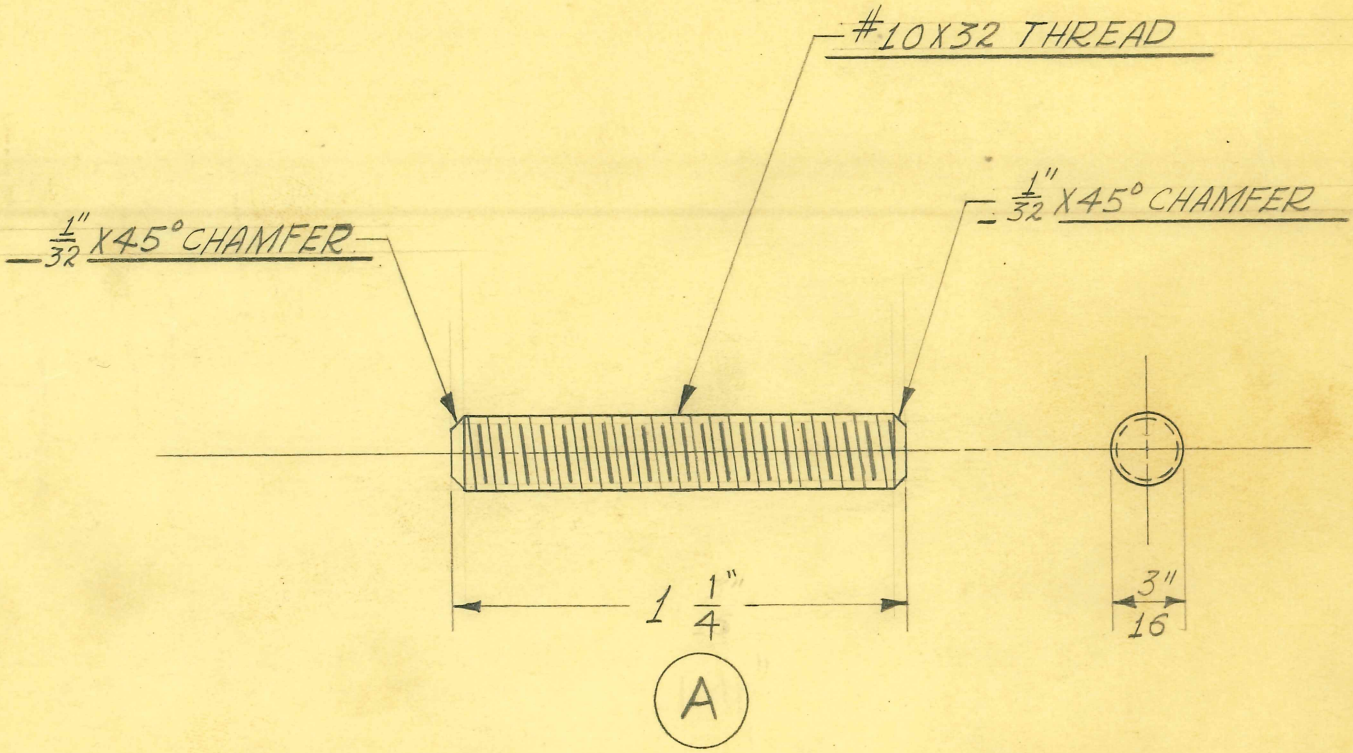

1 REQUIRED

REVISION		DATE	BY
A	WAS 1 3/16"	4-18-56	C.K.

SIZE	3/16" DIAM.	ISSUE 3-20-40	J.W.
KIND	C.R. STEEL	CHANGED	
SHAPE		"	
FINISH	CAD. #23	"	
TEMP.		"	
PATT.		"	

TITLE: FISCHER MOD. "TF-30-96" S.P. FLUOROSCOPE TRANSF. CLAMP & IND. PLATE STUD

H. G. FISCHER & CO.
2338 WABANSIA AVE.
CHICAGO, ILL.

CAT. NO.

PART NO. 12997A

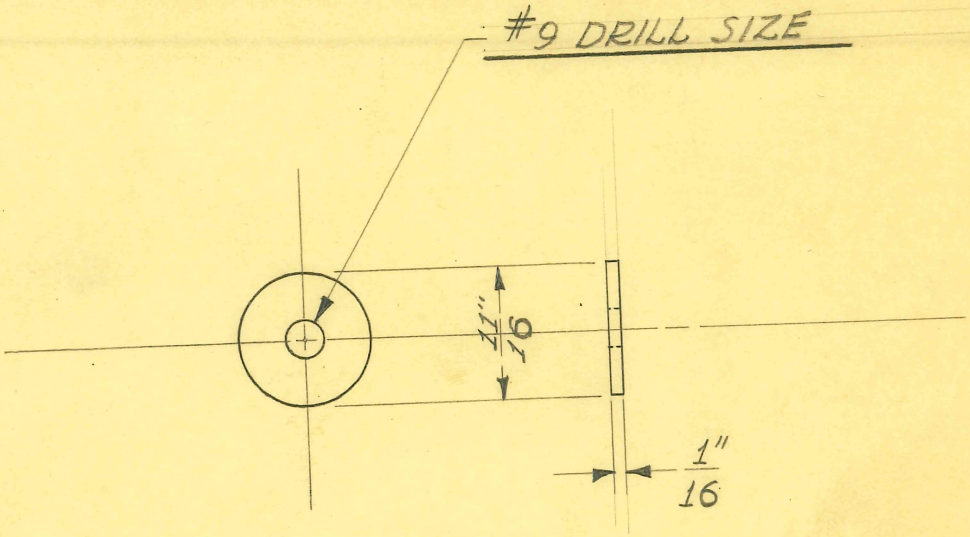

10 REQUIRED

SIZE	1/16" SHEET	ISSUE 4-16-40	J.W.	TITLE: FISCHER MOD. "B" SHORT WAVE STAND-OFF INS. LEAD WASHER - LARGE
KIND	LEAD	CHANGED		
SHAPE		"		
FINISH		"		
TEMP.		"		
PATT.		"		

H. G. FISCHER & CO.
2335 WABANSIA AVE.
CHICAGO, ILL.

CAT. NO.

PART NO. 13061

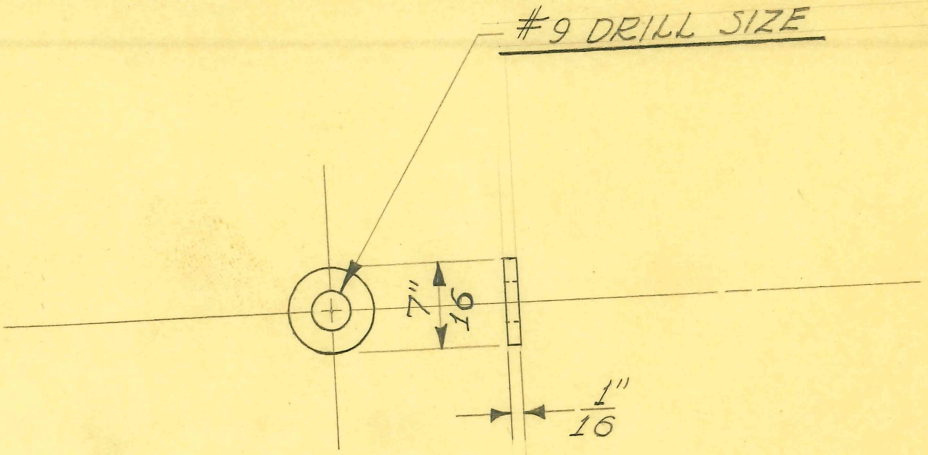

10 REQUIRED

SIZE	1/16" SHEET	ISSUE 4-16-40	J.W.
KIND	LEAD	CHANGED	
SHAPE		"	
FINISH		"	
TEMP.		"	
		"	

TITLE: FISCHER MOD. "B" SHORT WAVE STAND-OFF INS. LEAD WASHER-SMALL

H. G. FISCHER & CO.
2335 WABANSIA AVE.
CHICAGO, ILL.

CAT. NO.

PART NO. 13062

2 HLS. - #27 DRILL THRU

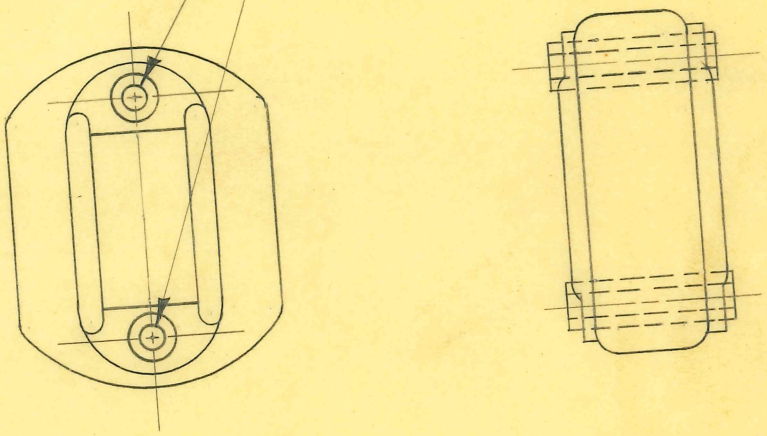

1 REQUIRED

SIZE	FROM 9149G	ISSUE 4-16-40	J.W.
KIND		CHANGED	
SHAPE		"	
FINISH		"	
TEMP.		"	

TITLE: FISCHER MOD. "B" SHORT WAVE 7500 VOLT. (.002 MFD.) FIXED CONDENSER (DRILLED)

H. G. FISCHER & CO.
2335 WABANSIA AVE.
CHICAGO, ILL.

CAT. NO.

PART NO. 13063

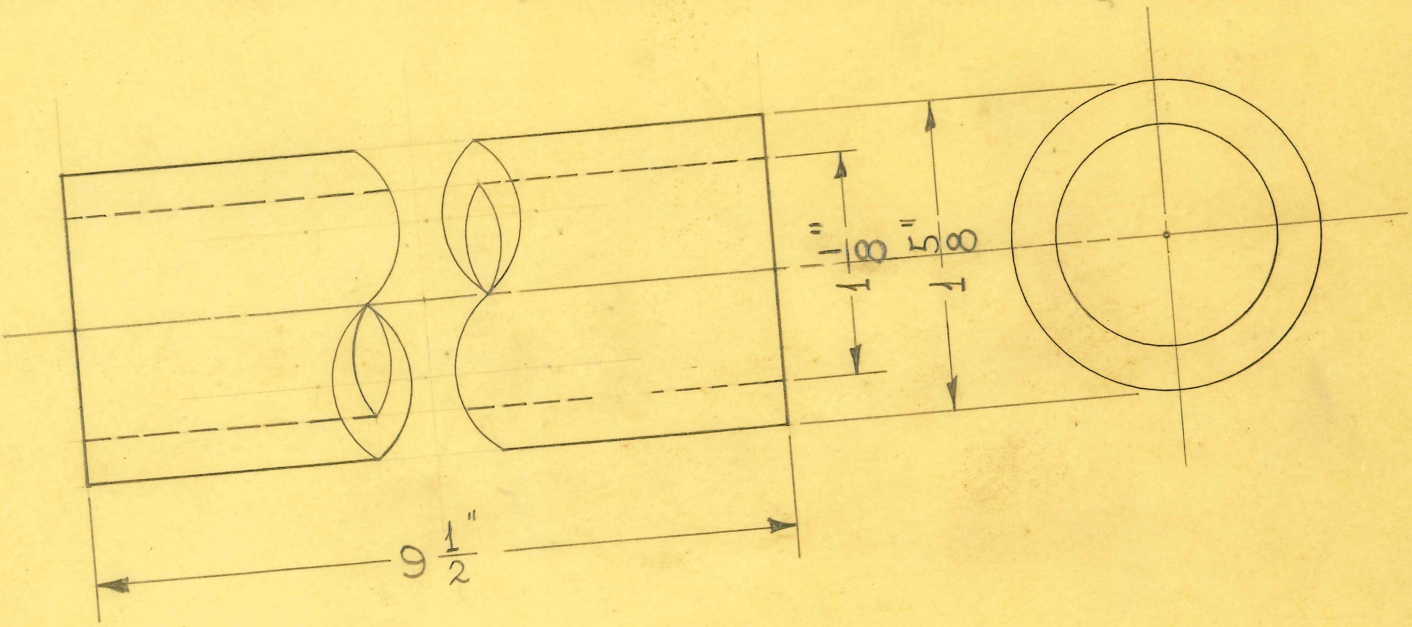

2 REQUIRED

SIZE	1 5/8" O.D. X 1 1/8" I.D.	ISSUE 8-6-45	HE.	TITLE: FISCHER "RF-100" X-RAY APP. ~ FILAME
KIND	HARD RUBBER	CHANGED		TRANSFORMER SECONDARY RUBBER TU
SHAPE	TUBING	"		
FINISH	#33 GROUND	"		
TEMP.		"		
		"		

H. G. FISCHER & CO.
2335 WABANSIA AVE.
CHICAGO, ILL.

CAT. NO.

PART NO. 1325

TITLE: FISCHER MOD. "RF-100" X-RAY H.T. CABLE ASSEM. STRAIN RELIEF

H. G. FISCHER & CO.
FRANKLIN PARK, ILLINOIS

PART NO. 13280

DATE 3-31-50 | DR. BY W. J. | CH'K'D. J.V.W.

REVISION	DATE	BY

PATTERN | FINISH | SCALE FULL

TOOLS | MATERIAL: .010" BLOCK TIN

DIMENSIONS
FRACTIONAL ± .015
DECIMAL ± .005
ANGULAR ± ½°
UNLESS OTHERWISE SPECIFIED

2 REQUIRED

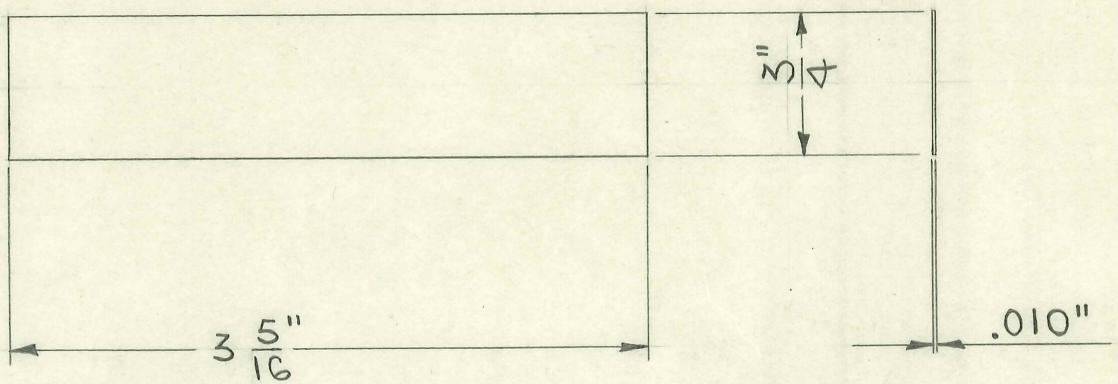

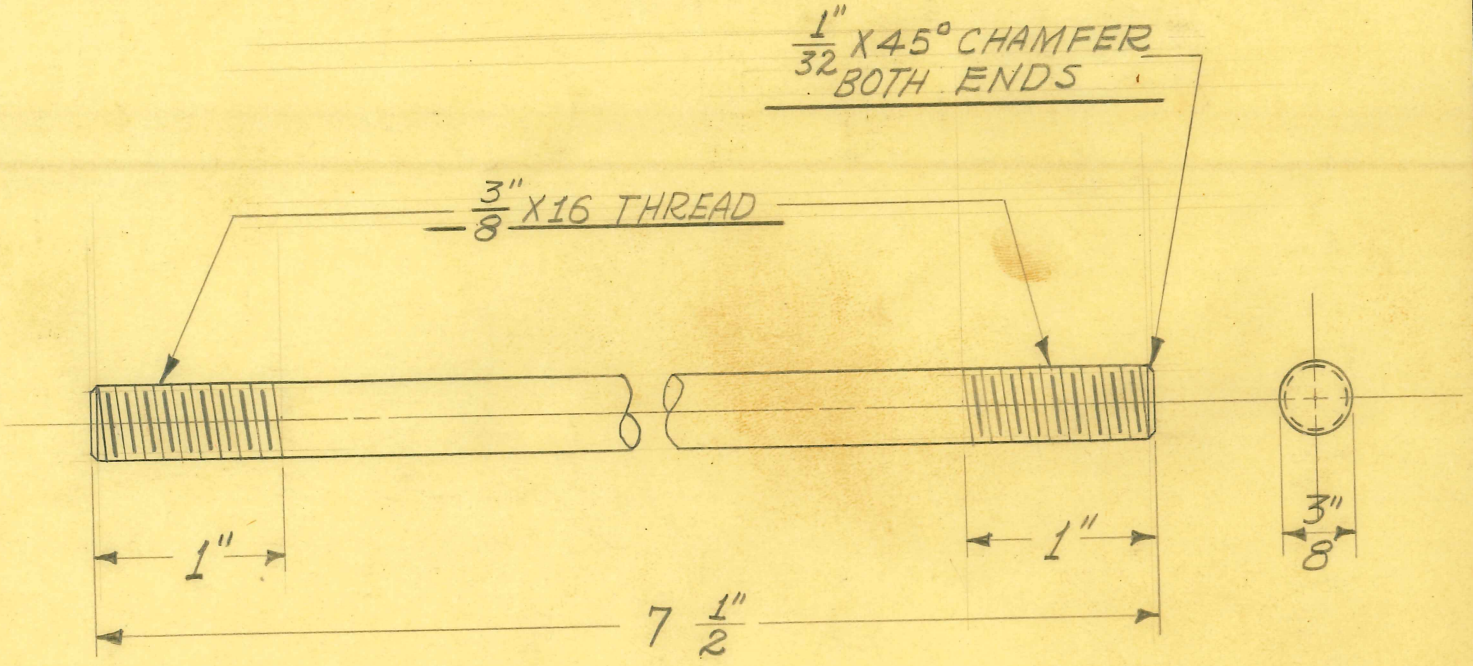

2 REQUIRED

SIZE	3/8" DIAM.	ISSUE 6-13-40	J.W.
KIND	C.R. STEEL	CHANGED	
SHAPE	ROD	"	
FINISH		"	
TEMP.		"	
		"	

TITLE: FISCHER MOD. "100" X-RAY UNIT POWER TRANSFORMER STUD

H. G. FISCHER & CO.
2335 WABANSIA AVE.
CHICAGO, ILL.

CAT. NO.

PART NO. 13284

TITLE FISCHER "RF-100"
FILAMENT TRANSF. CLAMP STRAP

H. G. FISCHER & CO.
FRANKLIN PARK, ILLINOIS

PART NO. 13285B

DATE 12-11-50 DR. BY J.V.W. CH'K'D.

REVISION	DATE	BY

PATTERN | FINISH | SCALE FULL

TOOLS: DRILL JIG #8897

MATERIAL: $\frac{1}{4}$" x $\frac{1}{2}$" C.R. STEEL BAR

DIMENSIONS UNLESS OTHERWISE SPECIFIED
FRACTIONAL ± .015
DECIMAL ± .003
ANGULAR ± ½°

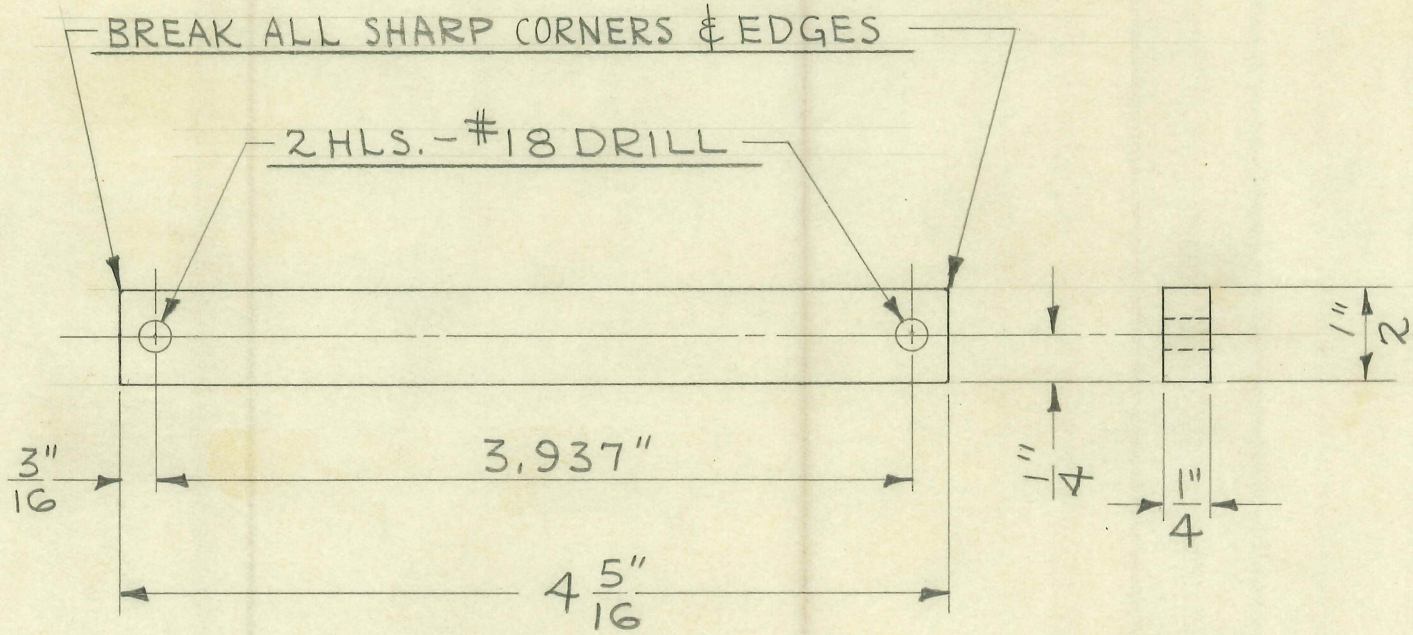

2 REQUIRED

FOLDER #106

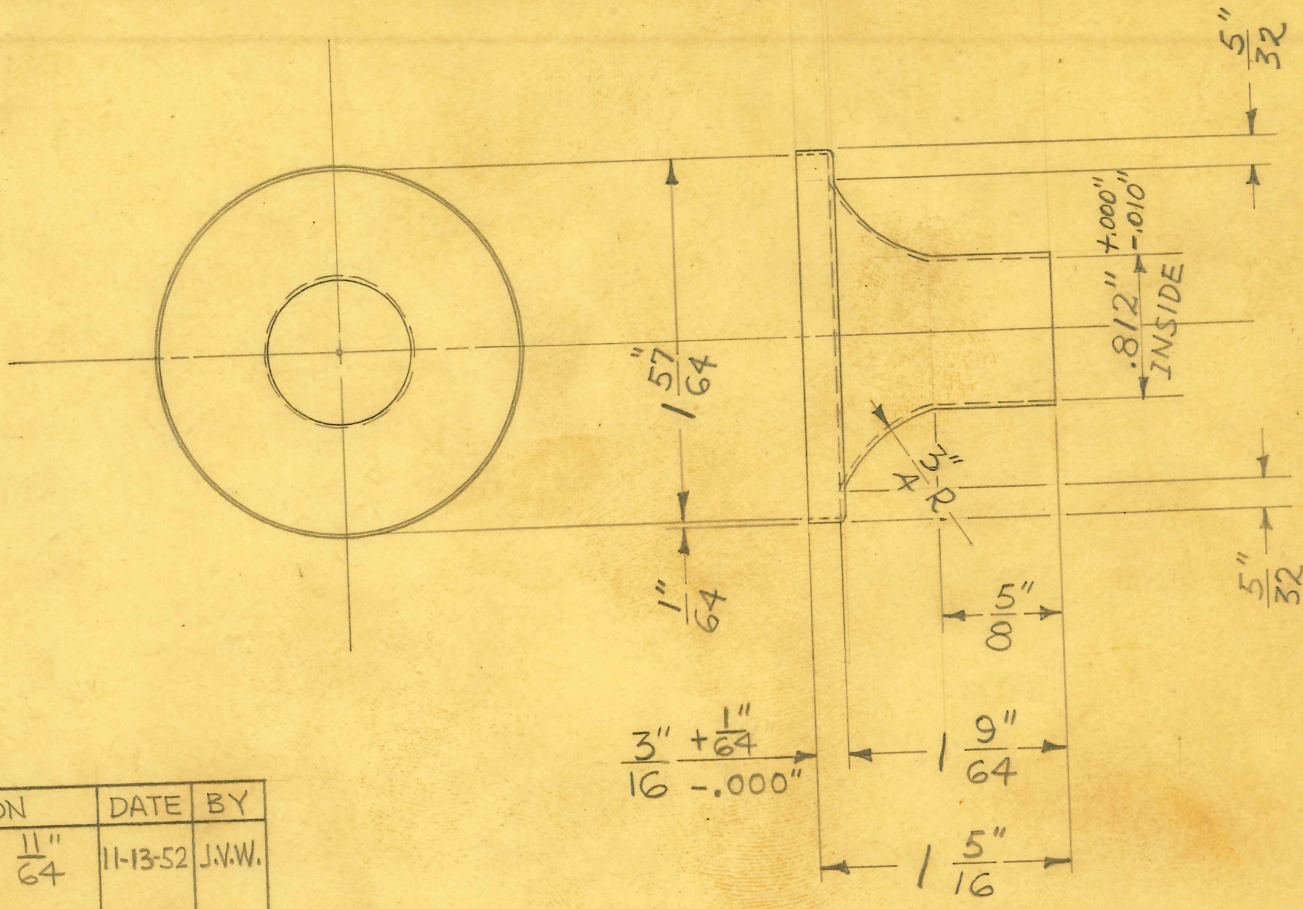

REVISION		DATE	BY
A	WAS 11/64	11-13-52	J.V.W.

1/64 SHEET BRASS

SIZE		ISSUE 6-26-46	J.V.W.
KIND		CHANGED	
SHAPE		"	
FINISH		"	
TEMP.		"	
DATE		"	

TITLE: FISCHER "RF-100" X-RAY UNIT
H. T. POST PLUG CAP

H. G. FISCHER & CO.
2335 WABANSIA AVE.
CHICAGO, ILL.

CAT. NO.

PART NO. 13291B

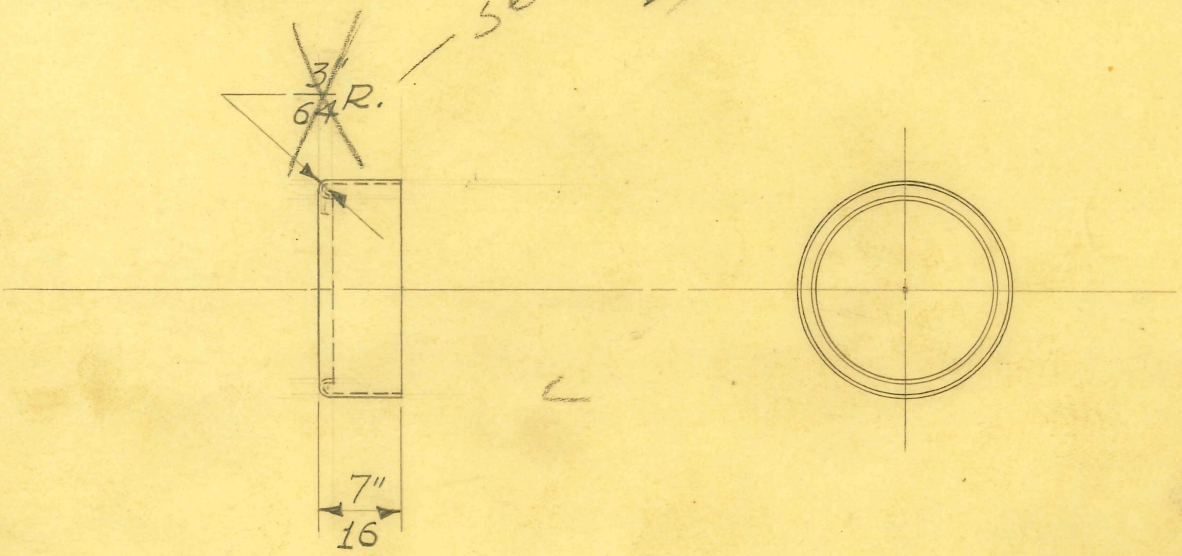

See J.W. Ike 20660G

4 REQUIRED

SIZE	FROM 13292F	ISSUE 9-18-40	J.V.W.
KIND		CHANGED	
SHAPE		"	
FINISH		"	
TEMP.		"	
PATT.		"	

TITLE:
FISCHER MOD. "100" X-RAY UNIT
H.T. CABLE FLEXIBLE SLEEVE FERRULE

H. G. FISCHER & CO.
2335 WABANSIA AVE.
CHICAGO, ILL.

CAT. NO.

PART NO. 13292F

HAND PUNCH #13293 — HAND PUNCH BOX Y-5

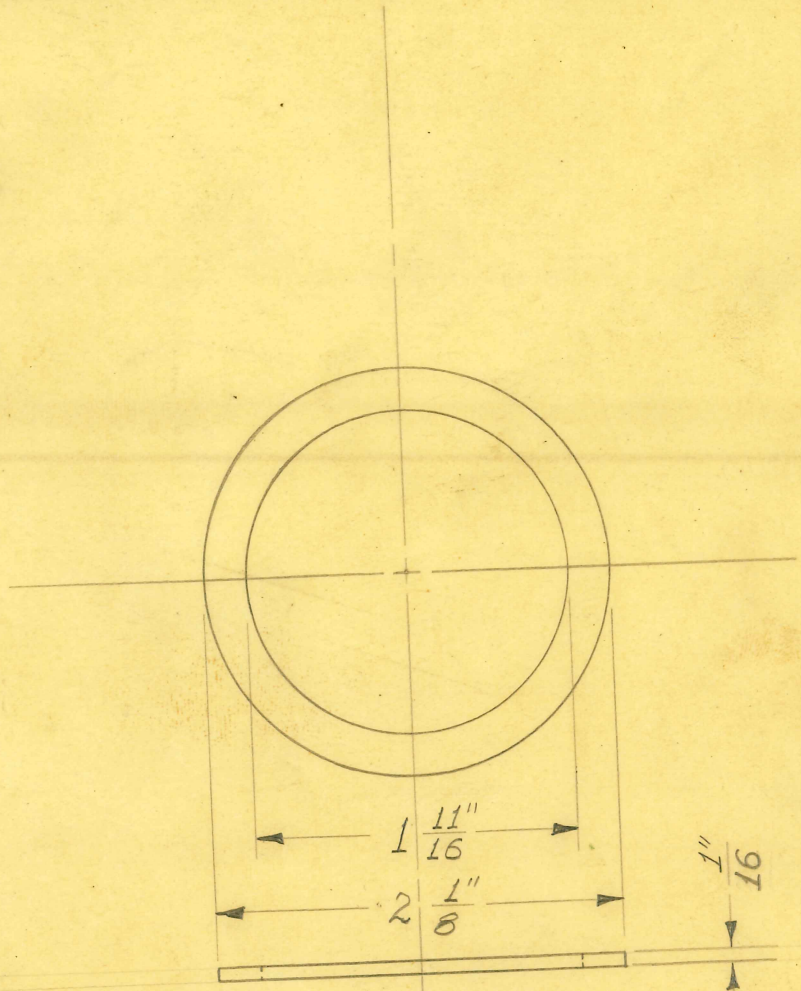

4 REQUIRED

1/16" SHEET NEOPRENE #2065 – #70 DUROMETER TEST

SIZE	~~1/16" SHEET~~	ISSUE 6-17-40	J.W.	TITLE: FISCHER MOD. "100" X-RAY UNIT H. T. POST SOCKET GASKET
KIND	~~NEOPRENE~~	CHANGED 10-23-40	J.W.	
SHAPE		"		
FINISH		"		
TEMP.		"		
PART		"		

H. G. FISCHER & CO.
2335 WABANSIA AVE.
CHICAGO, ILL.

CAT. NO.

PART NO. 13293A

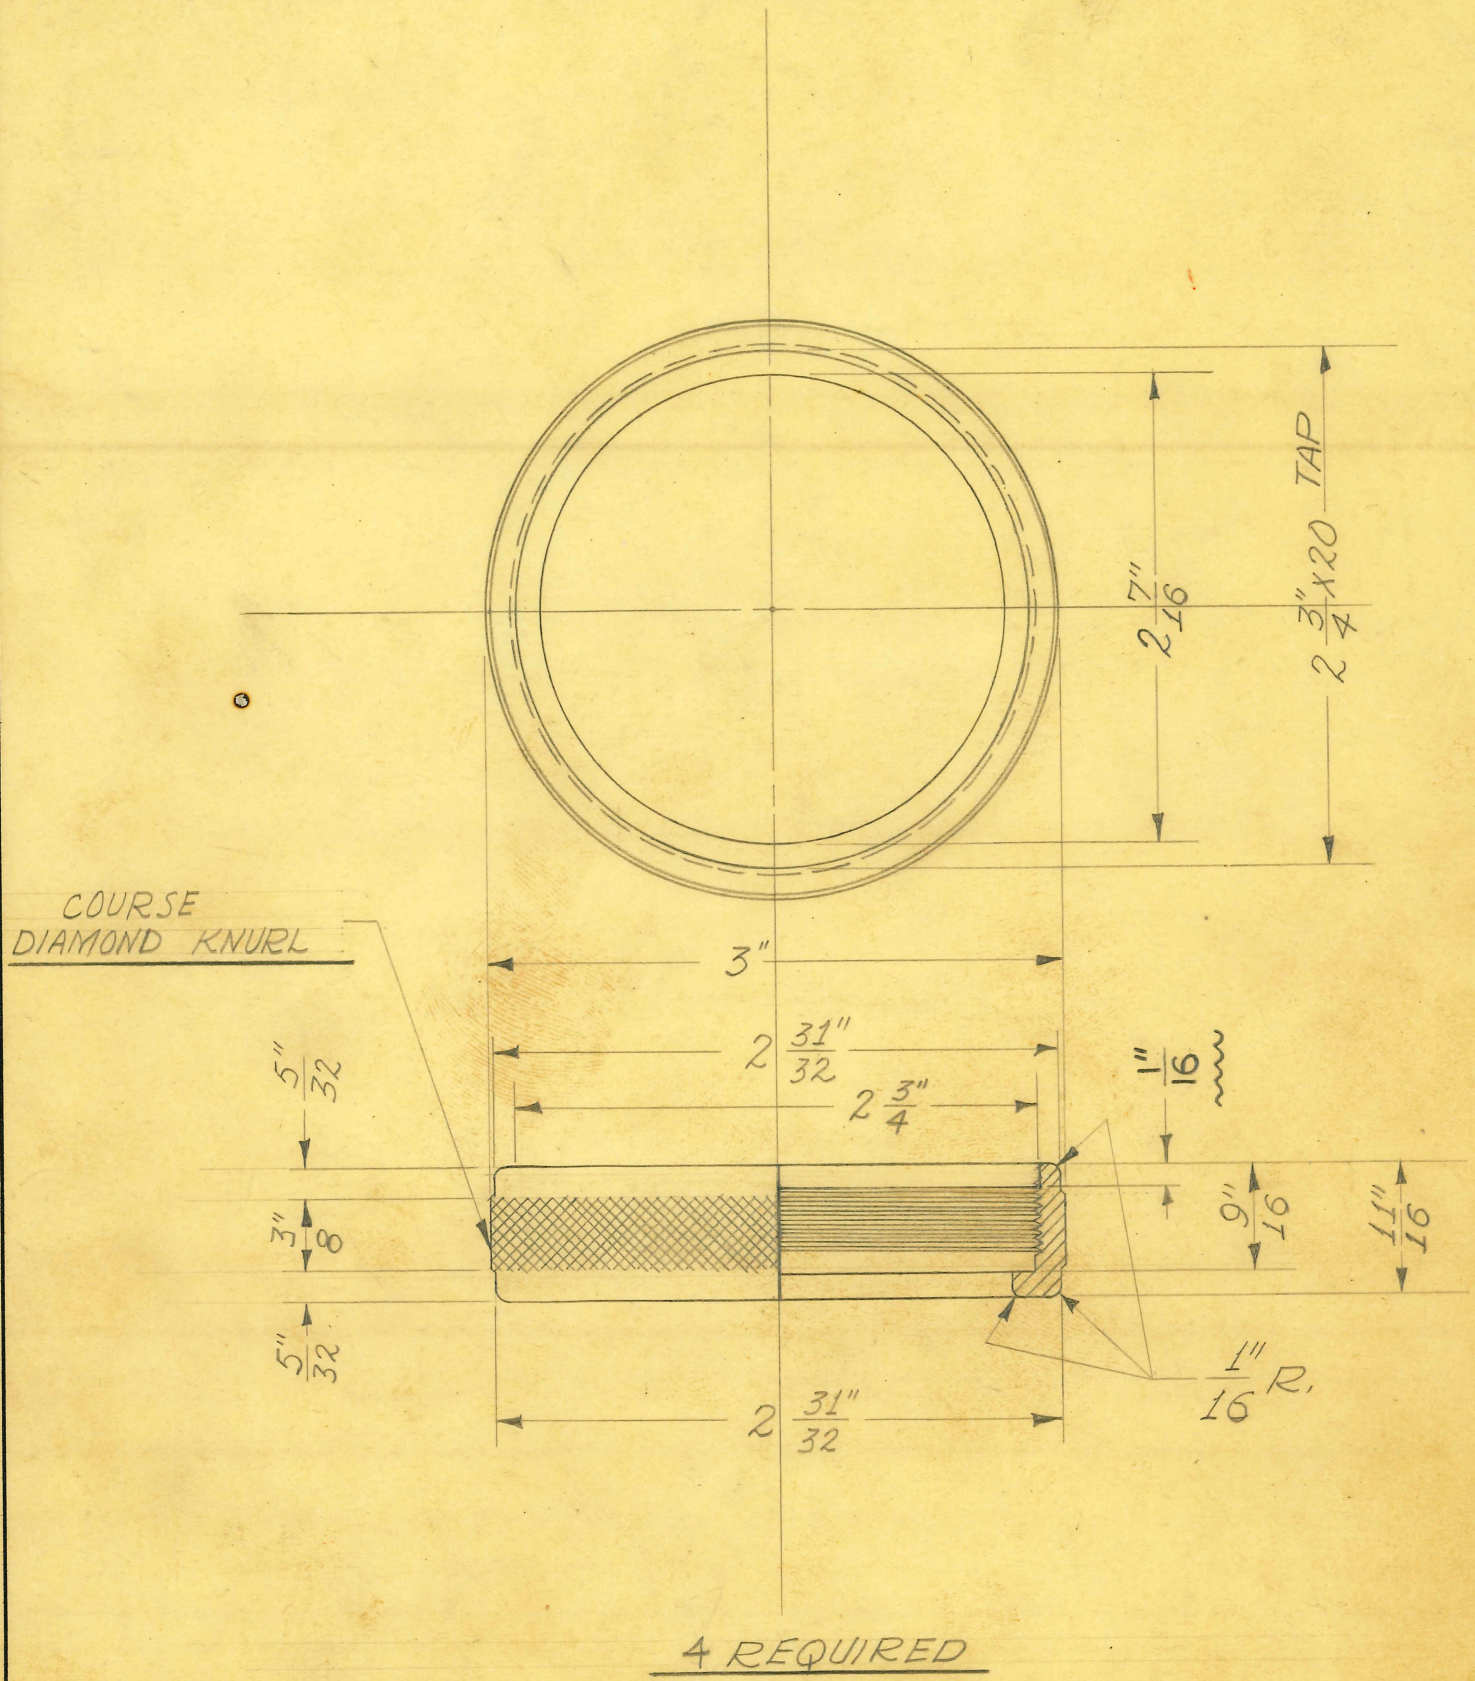

4 REQUIRED

SIZE	BRASS	ISSUE 6-14-40	J.W.
KIND	CASTING	CHANGED	
SHAPE		"	
FINISH	CHROME #2	"	
TEMP.		"	
PATT.	1577	"	

TITLE:
FISCHER MOD. "100" X-RAY UNIT
H.T. POST PLUG - RETAINING RING

H. G. FISCHER & CO.
2338 WABANSIA AVE.
CHICAGO, ILL.

CAT. NO.

PART NO. 13295F

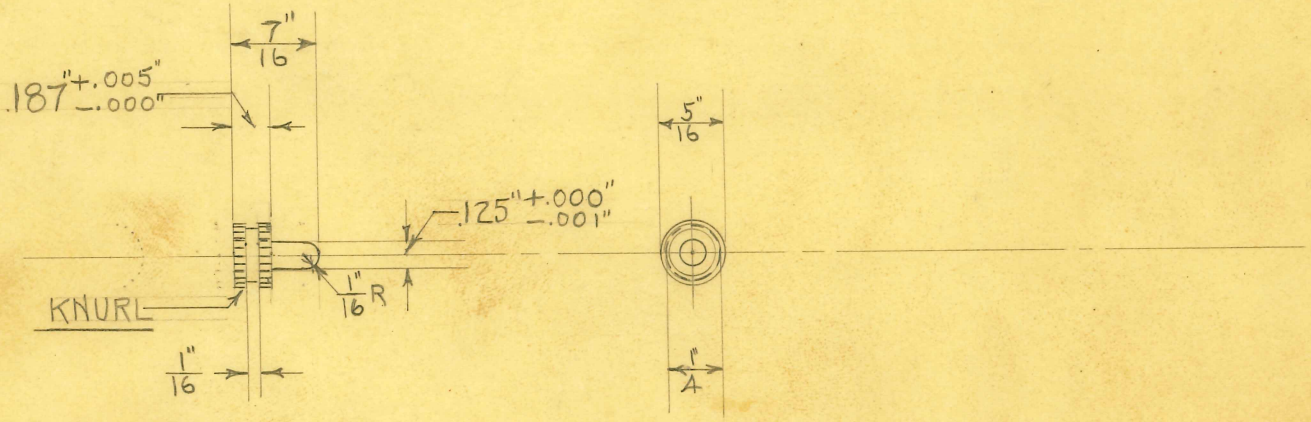

3-REQUIRED

SIZE	5/16 DIA.	ISSUE 6-24-40	C.E.A.
KIND	PHOS. BRZE.	CHANGED	
SHAPE		"	
FINISH		"	
TEMP.		"	
PATT.		"	

TITLE: FISCHER MOD. "100" X-RAY UNIT
H.T. POST PLUG - INSERT

H. G. FISCHER & CO.
2338 WABANSIA AVE.
CHICAGO, ILL.

CAT. NO.

PART NO. 13303

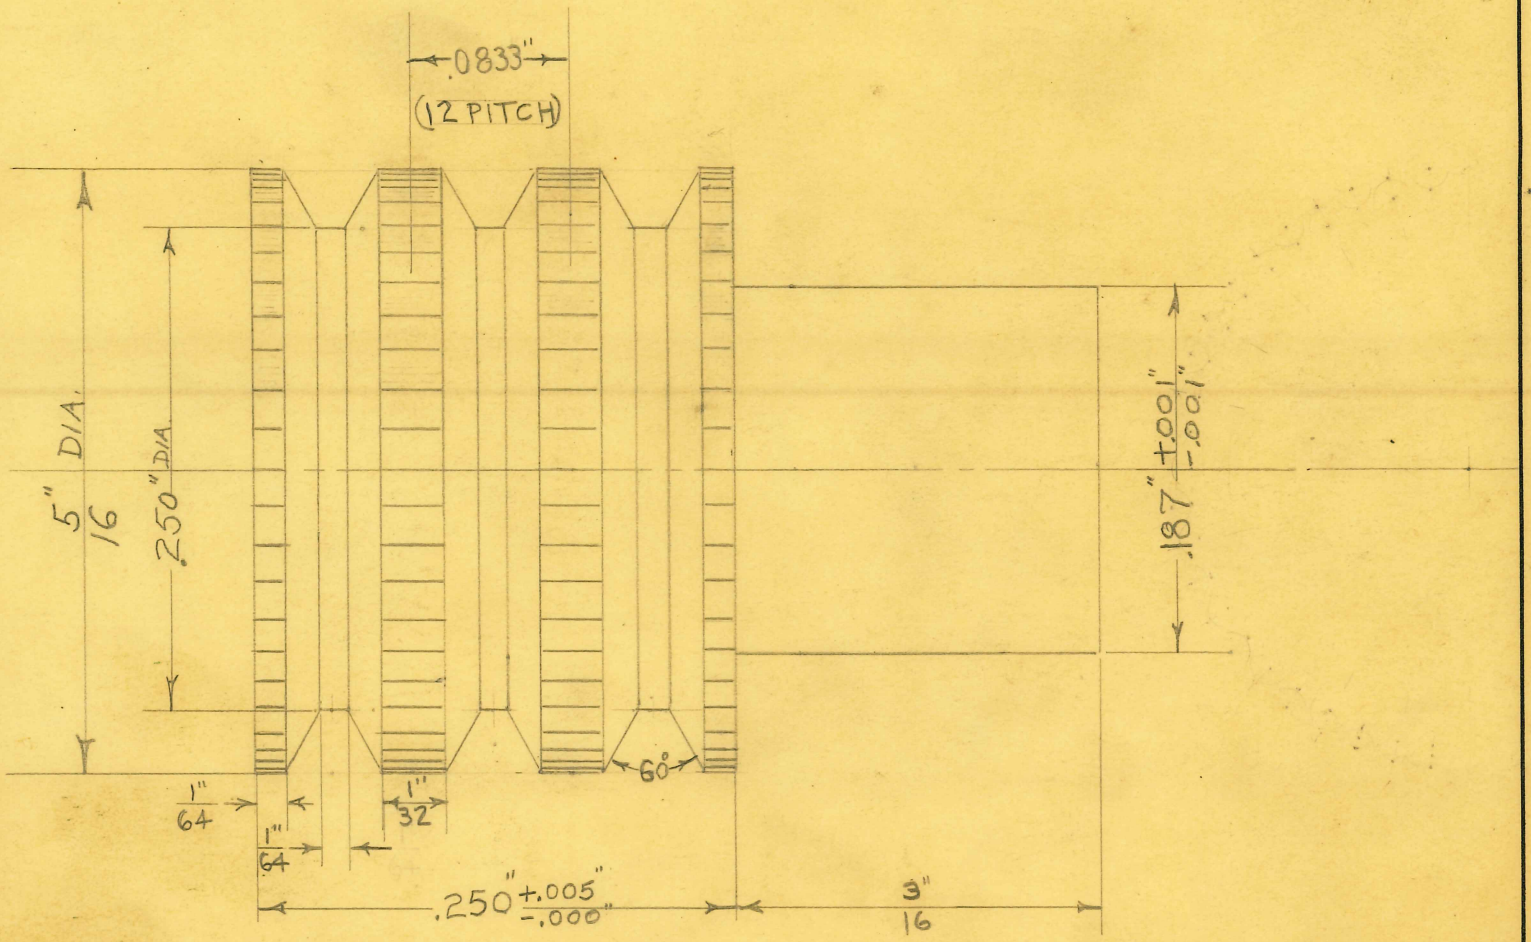

SCALE – 10/1

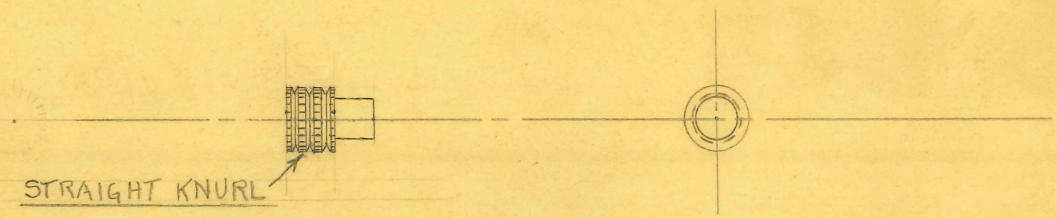

FULL SIZE

3 REQUIRED

NOTE – FINISHED PIECES MUST BE FREE FROM OIL & CHIPS

SIZE	5/16 DIA.	ISSUE 1-22-41	664
KIND	BRASS ROD	CHANGED	
SHAPE		"	
FINISH		"	
TEMP.		"	
PATT.		"	

TITLE: FISCHER MODEL "100" XRAY UNIT
H.T. POST SOCKET INSERT

H. G. FISCHER & CO.
2338 WABANSIA AVE.
CHICAGO, ILL.

CAT. NO.

PART NO. 13304

TITLE
FISCHER MOD. "100" X-RAY UNIT
H.T. CABLE FLEXIBLE SLEEVE

H. G. FISCHER & CO.
FRANKLIN PARK, ILLINOIS

PART NO. 13305G

DATE 4-12-54 DR BY W.J. CH'K'D. J.V.W.

REVISION	DATE	BY

PATTERN | FINISH | SCALE FULL

TOOLS

MATERIAL U.I. TUBING FLEXIBLE STAINLESS STEEL WITH CHROME FERRULE ATTACHED TO ONE END – $\frac{63}{64}$" I.D. X 12" LONG
AMERICAN BRASS CO.

DIMENSIONS
FRACTIONAL ± .015
DECIMAL ± .005
ANGULAR ± ½°
UNLESS OTHERWISE SPECIFIED

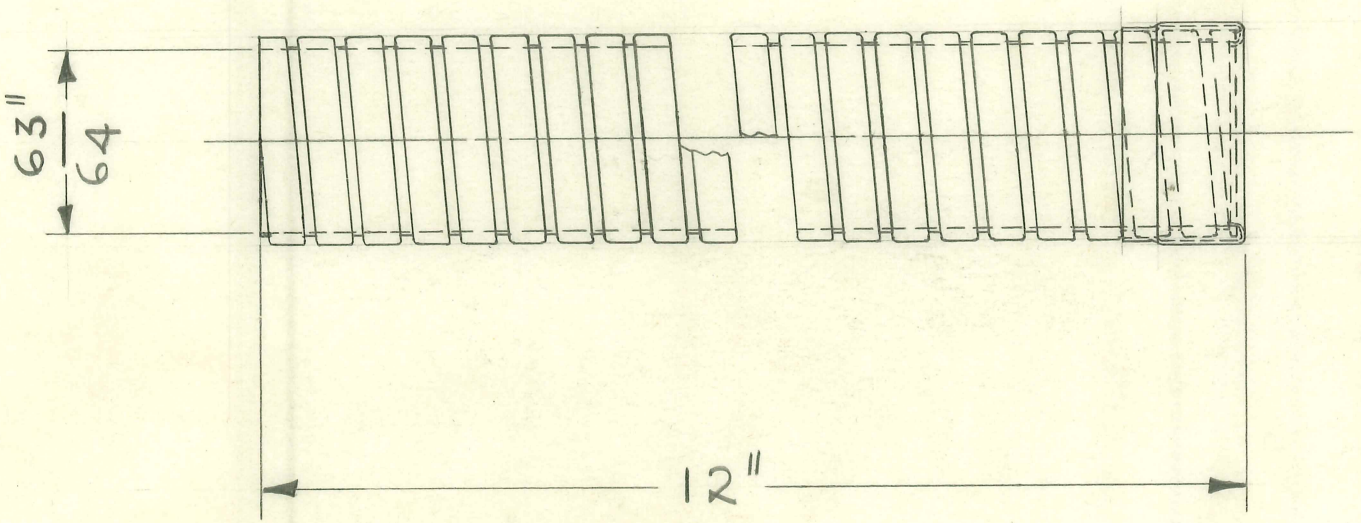

1 REQUIRED

FOLDER #106

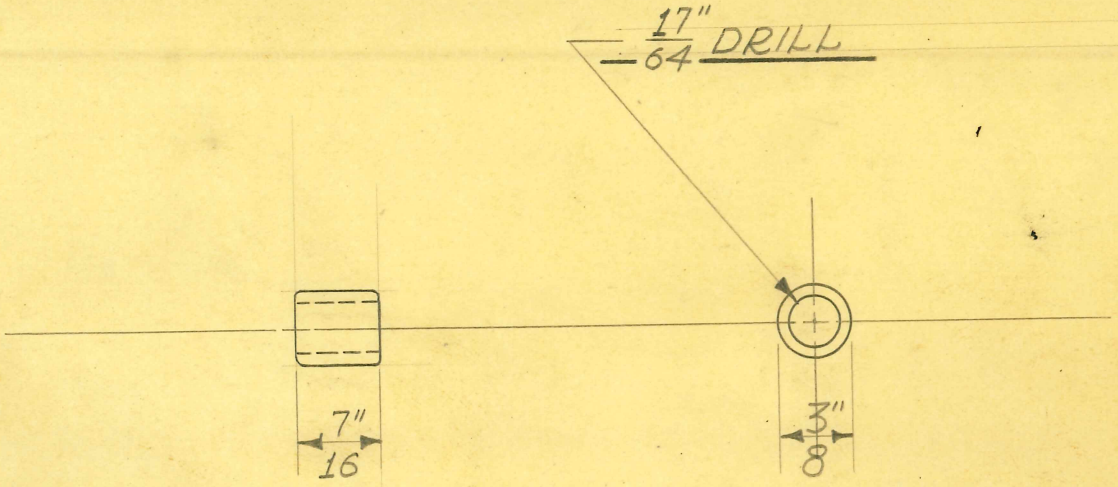

2 REQUIRED

SIZE	3/8" DIAM.	ISSUE 7-10-40	J.W.	TITLE: FISCHER MOD. "100" X-RAY UNIT COUNTERWEIGHT BEARING SPACER
KIND	C.R. STEEL	CHANGED		
SHAPE		"		
FINISH	CAD. #23	"		
TEMP.		"		
PATT.		"		

H. G. FISCHER & CO.
2335 WABANSIA AVE.
CHICAGO, ILL.

CAT. NO.

PART NO. 13313

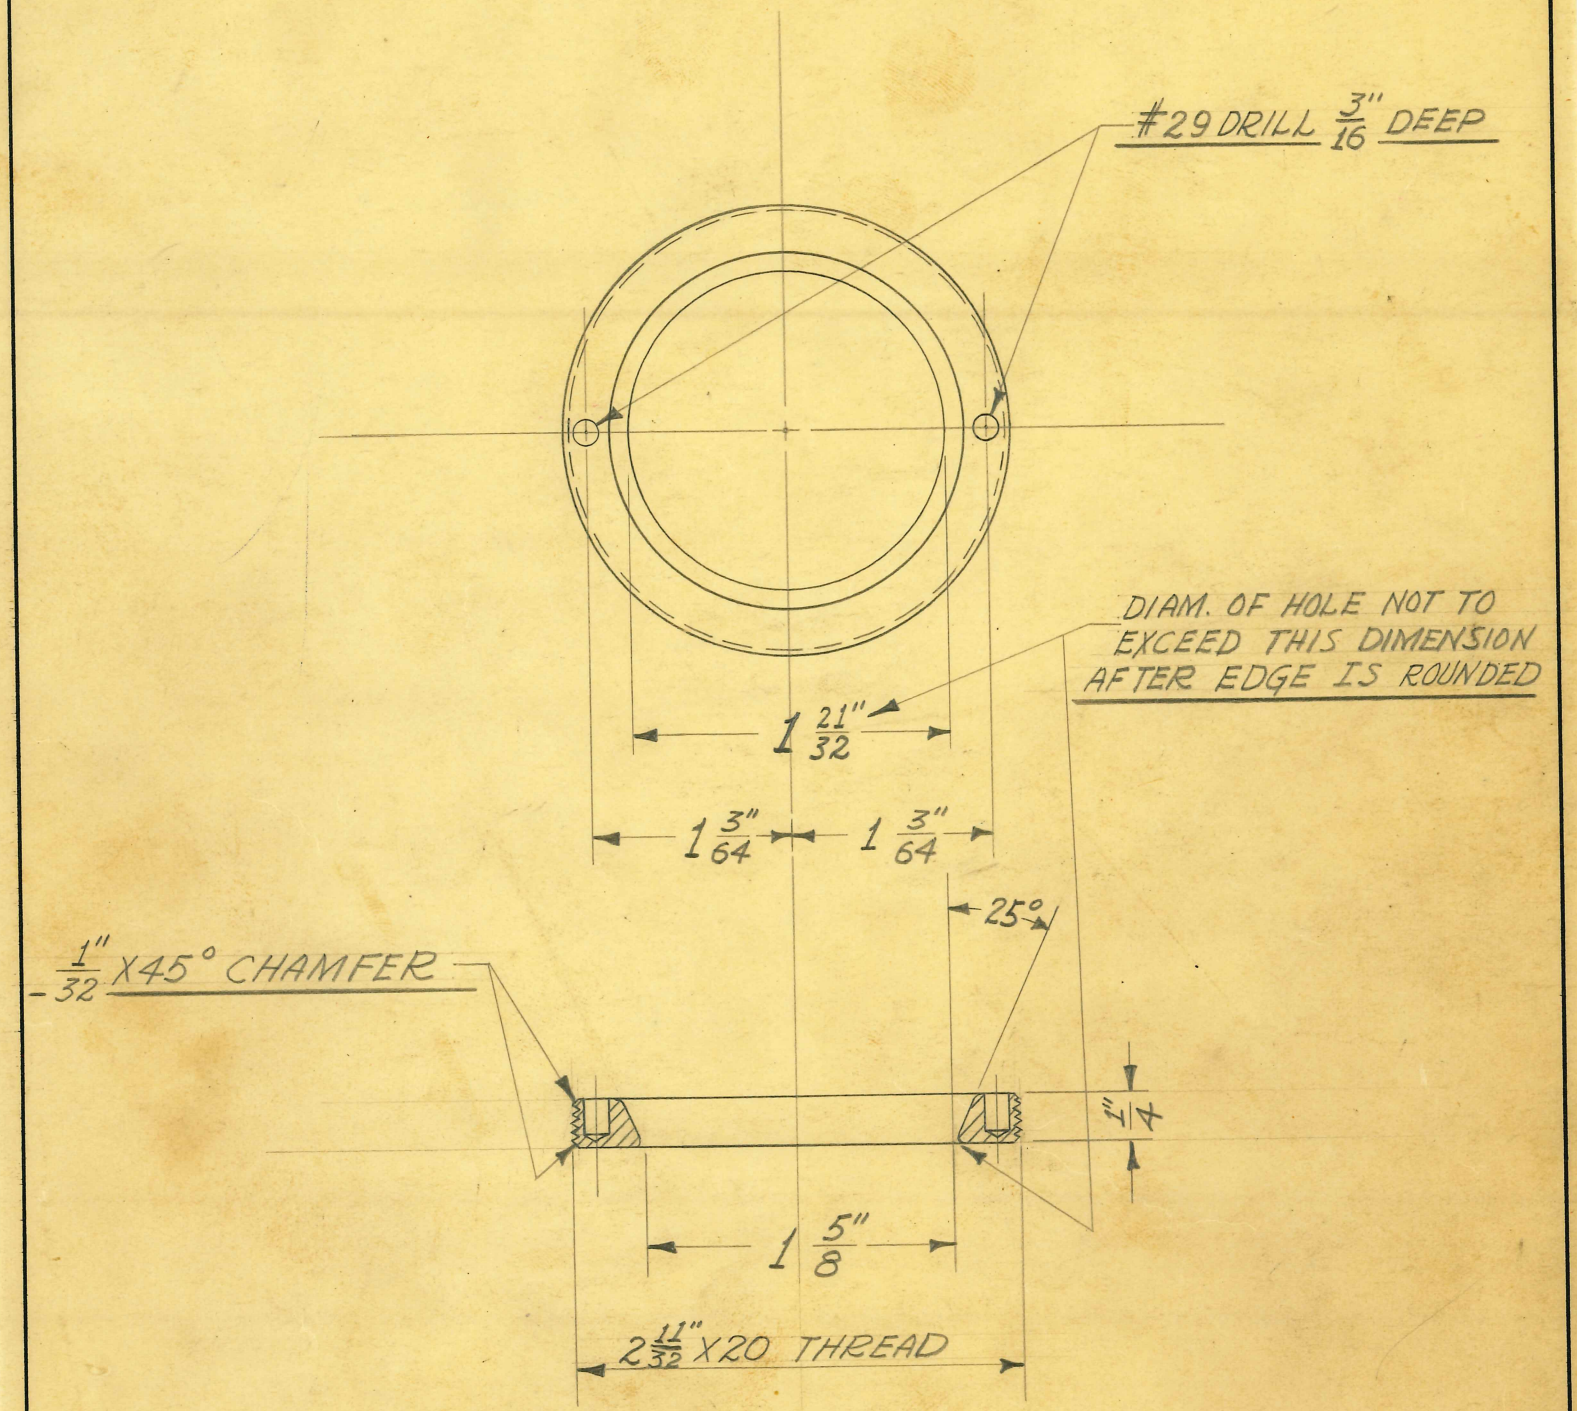

1 REQUIRED

SIZE	#12	ISSUE 7-9-40	J.W.
KIND	ALUM. CASTING	CHANGED	
SHAPE		"	
FINISH		"	
TEMP.		"	
PATT.	1618	"	

TITLE: FISCHER MOD. 100" X-RAY UNIT
X-RAY WINDOW CLAMP RING

H. G. FISCHER & CO.
2335 WABANSIA AVE.
CHICAGO, ILL.

CAT. NO.

PART NO. 13314F

TITLE

FISCHER MOD. "100-96" DIAGNOSTIC X-RAY BASE STOP ROD

H. G. FISCHER & CO.
FRANKLIN PARK, ILLINOIS

PART NO. 13321A

DATE	DR. BY	CH'K'D.
9-7-50	W. J.	

REVISION	DATE	BY

PATTERN	FINISH	SCALE
	CAD. #23	FULL

TOOLS

MATERIAL 13/16" DIA. C.R. STEEL

DIMENSIONS UNLESS OTHERWISE SPECIFIED

FRACTIONAL	± .015
DECIMAL	± .005
ANGULAR	± ½°

1 REQUIRED

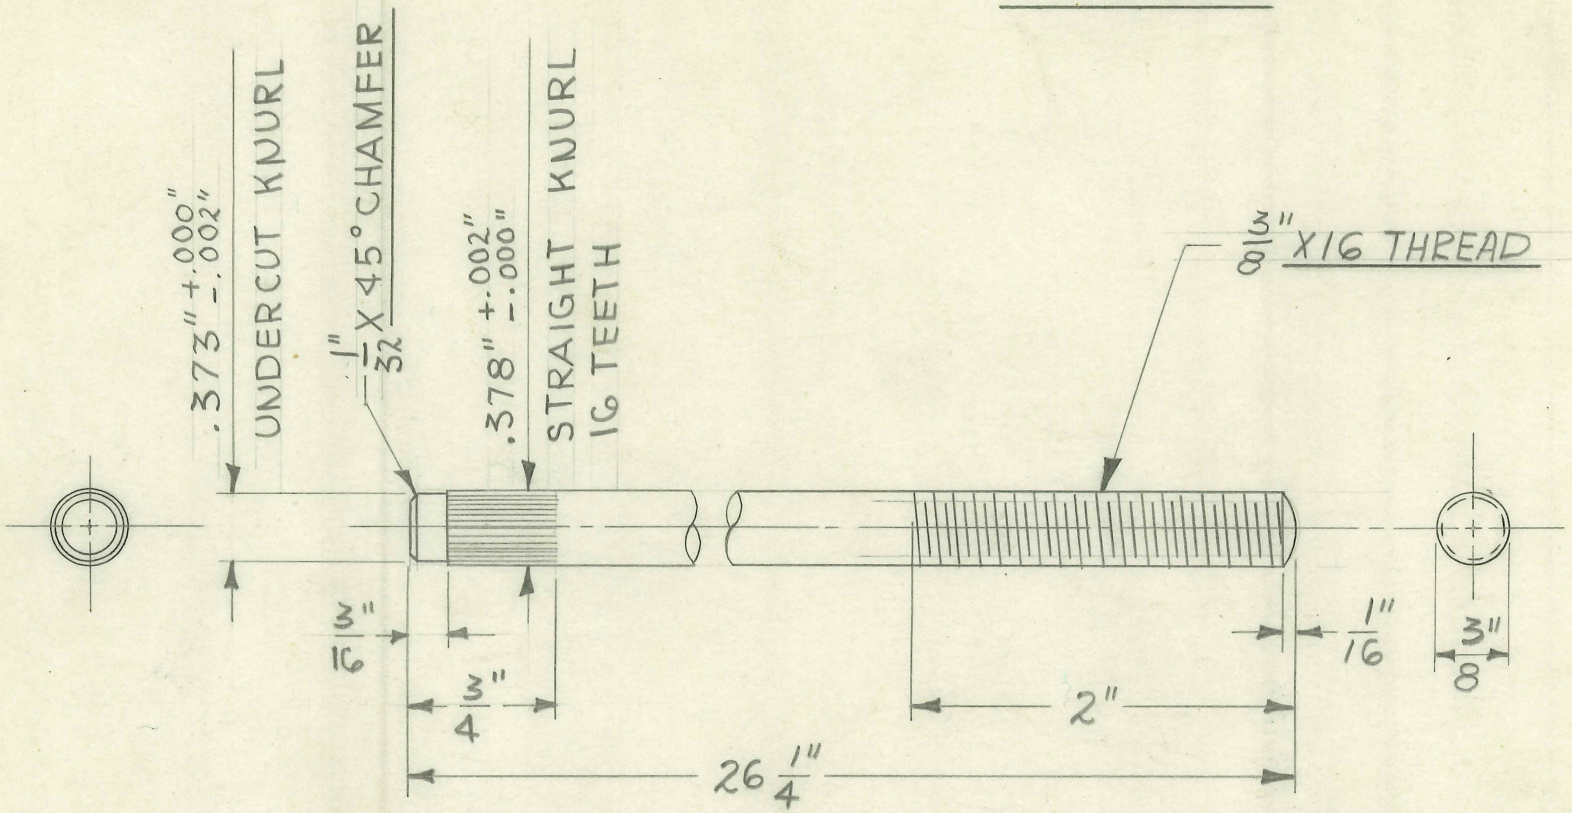

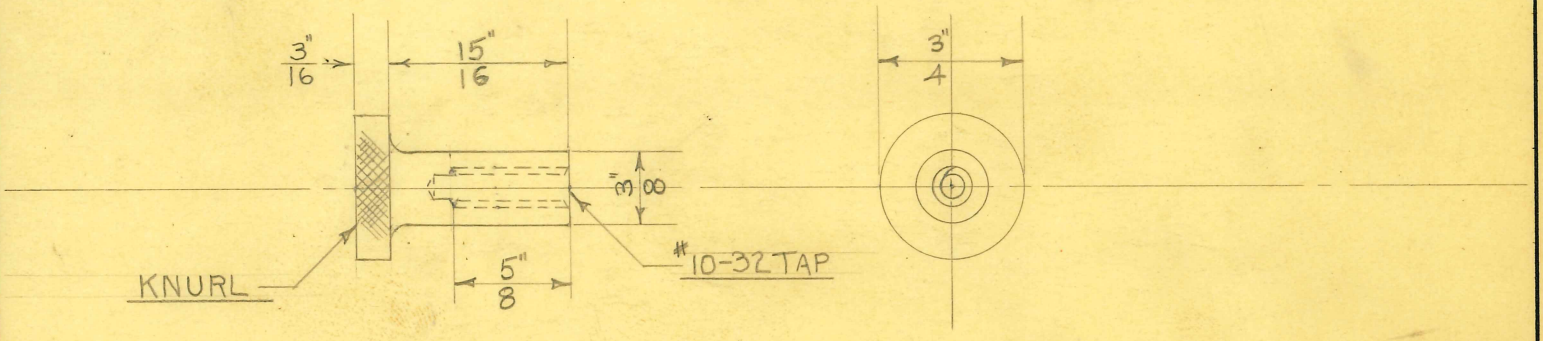

1 REQUIRED

SIZE	3/4 DIA.	ISSUE 8-7-40	C.E.A.	TITLE: FISCHER MODEL "100-96" X-RAY UNIT
KIND	BRASS ROD	CHANGED		TUBE HEAD SUPPORT BEARING RING - CLAMPING NUT
SHAPE		"		
FINISH	#2 CHROME	"		
TEMP.		"		
PATT.		"		

H. G. FISCHER & CO.
2335 WABANSIA AVE.
CHICAGO, ILL.

CAT. NO.

PART NO. 13331

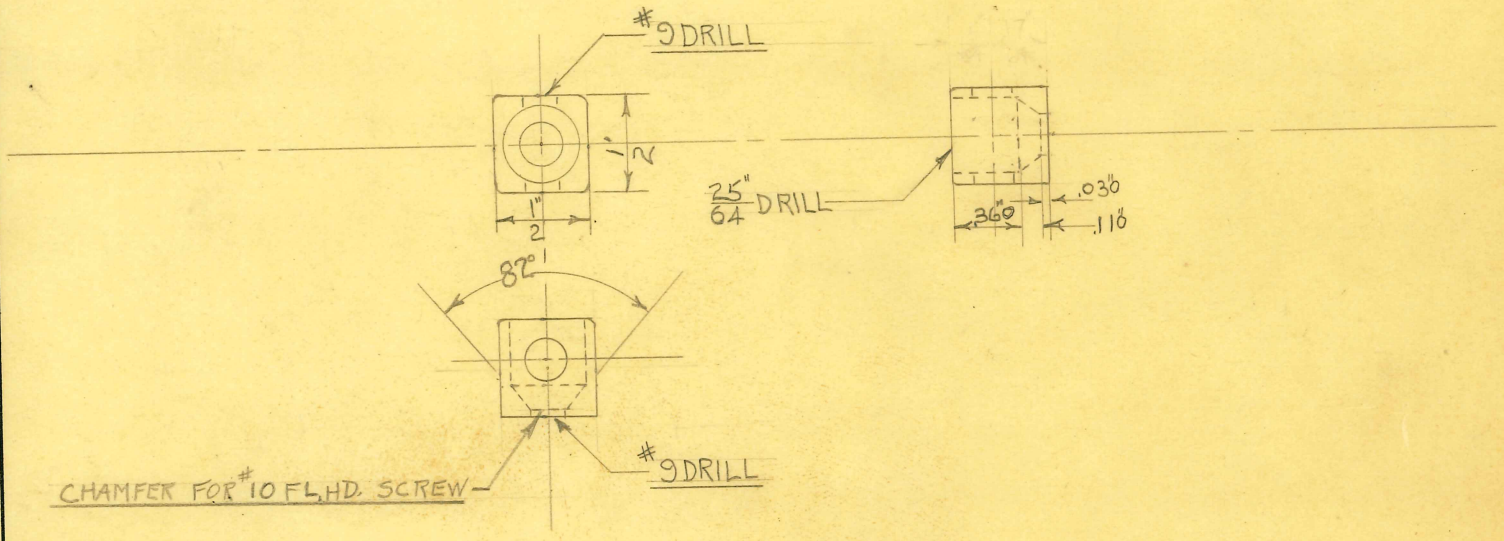

1 REQUIRED

SIZE	1/2" SQ	ISSUE 8-9-40	C.E.A.
KIND	BRASS ROD	CHANGED	
SHAPE		"	
FINISH	#2 CHROME	"	
TEMP.		"	
PATT.		"	

TITLE: FISCHER MODEL "100-96" X-RAY UNIT
TUBE HEAD SUPPORT BEARING RING - CLAMPING LUG

H. G. FISCHER & CO.
2335 WABANSIA AVE.
CHICAGO, ILL.

CAT. NO.

PART NO. 13332

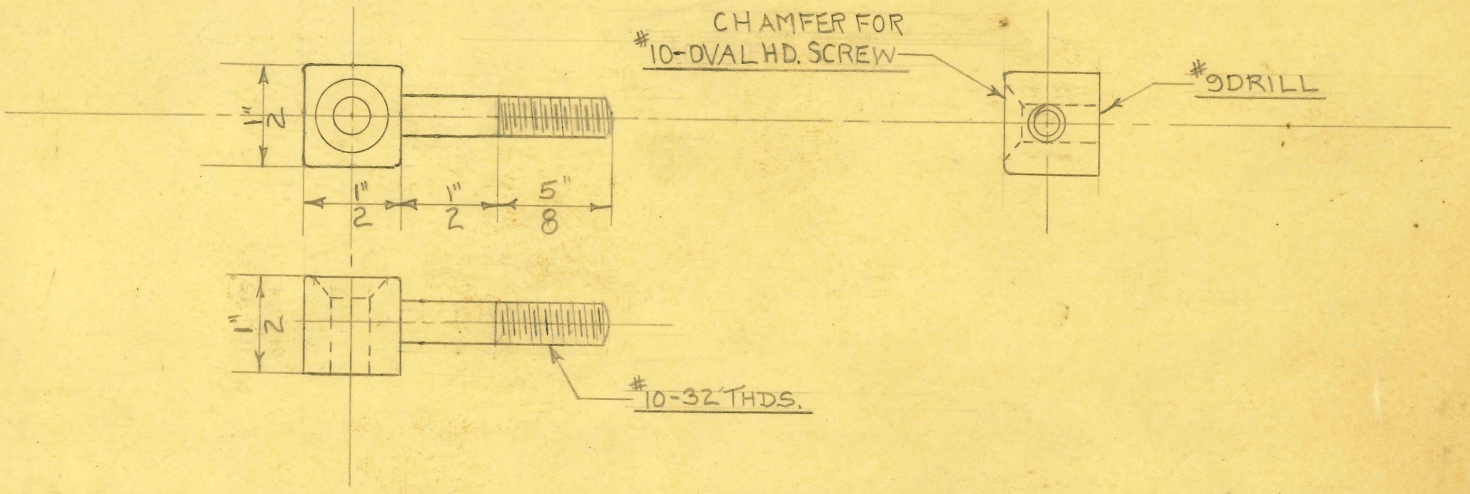

1-REQUIRED

SIZE	1/2" SQ	ISSUE 8-3-40	C.E.A.
KIND	BRASS ROD	CHANGED	
SHAPE		"	
FINISH	#2 CHROME	"	
TEMP.		"	
PATT.		"	

TITLE: FISCHER MODEL "100-96" X-RAY UNIT
TUBE HEAD SUPPORT BEARING RING—CLAMPING BOLT

H. G. FISCHER & CO.
2335 WABANSIA AVE.
CHICAGO, ILL.

CAT. NO.

PART NO. 13333

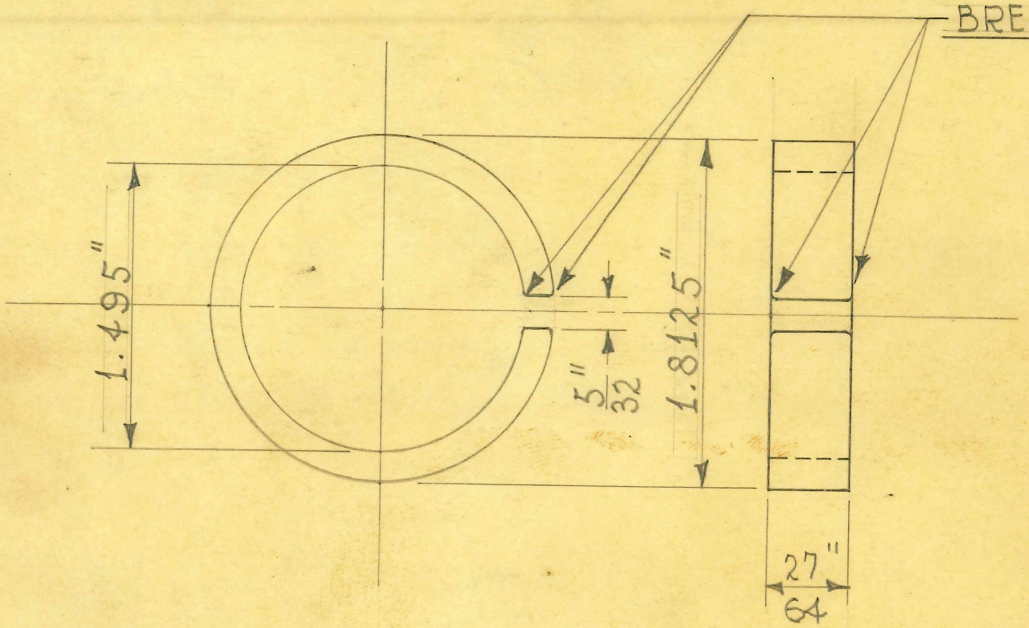

1 REQUIRED

SIZE	1⅞ O.D. X .219"	ISSUE 7-24-40	HE.
KIND	WALL-SEAMLESS	CHANGED	
SHAPE	STEEL TUBING	"	
FINISH		"	
TEMP.		"	
PATT.		"	

TITLE: FISCHER MOD. 100-96 TUBE STAND-TUBE HEAD SIDE-HORIZ. OUTER TUBE PLUG FRICTION SLEEVE

H. G. FISCHER & CO.
2335 WABANSIA AVE.
CHICAGO, ILL.

CAT. NO.

PART NO. 13369

TITLE
FISCHER MOD. "100-96" X-RAY UNIT
BASE STOP ROD - KNOB

H. G. FISCHER & CO.
FRANKLIN PARK, ILLINOIS

PART NO. 13381A

DATE	DR BY	CH'K'D J.V.W.

REVISION	DATE	BY

PATTERN

FINISH POLISH TOP OF HEAD

SCALE FULL

TOOLS

MATERIAL 2 1/4" DIA. ALUMINUM ROD #17ST

DIMENSIONS
FRACTIONAL ± .015
DECIMAL ± .005
ANGULAR ± ½°
UNLESS OTHERWISE SPECIFIED

1 REQUIRED

DIAMOND KNURL
MEDIUM

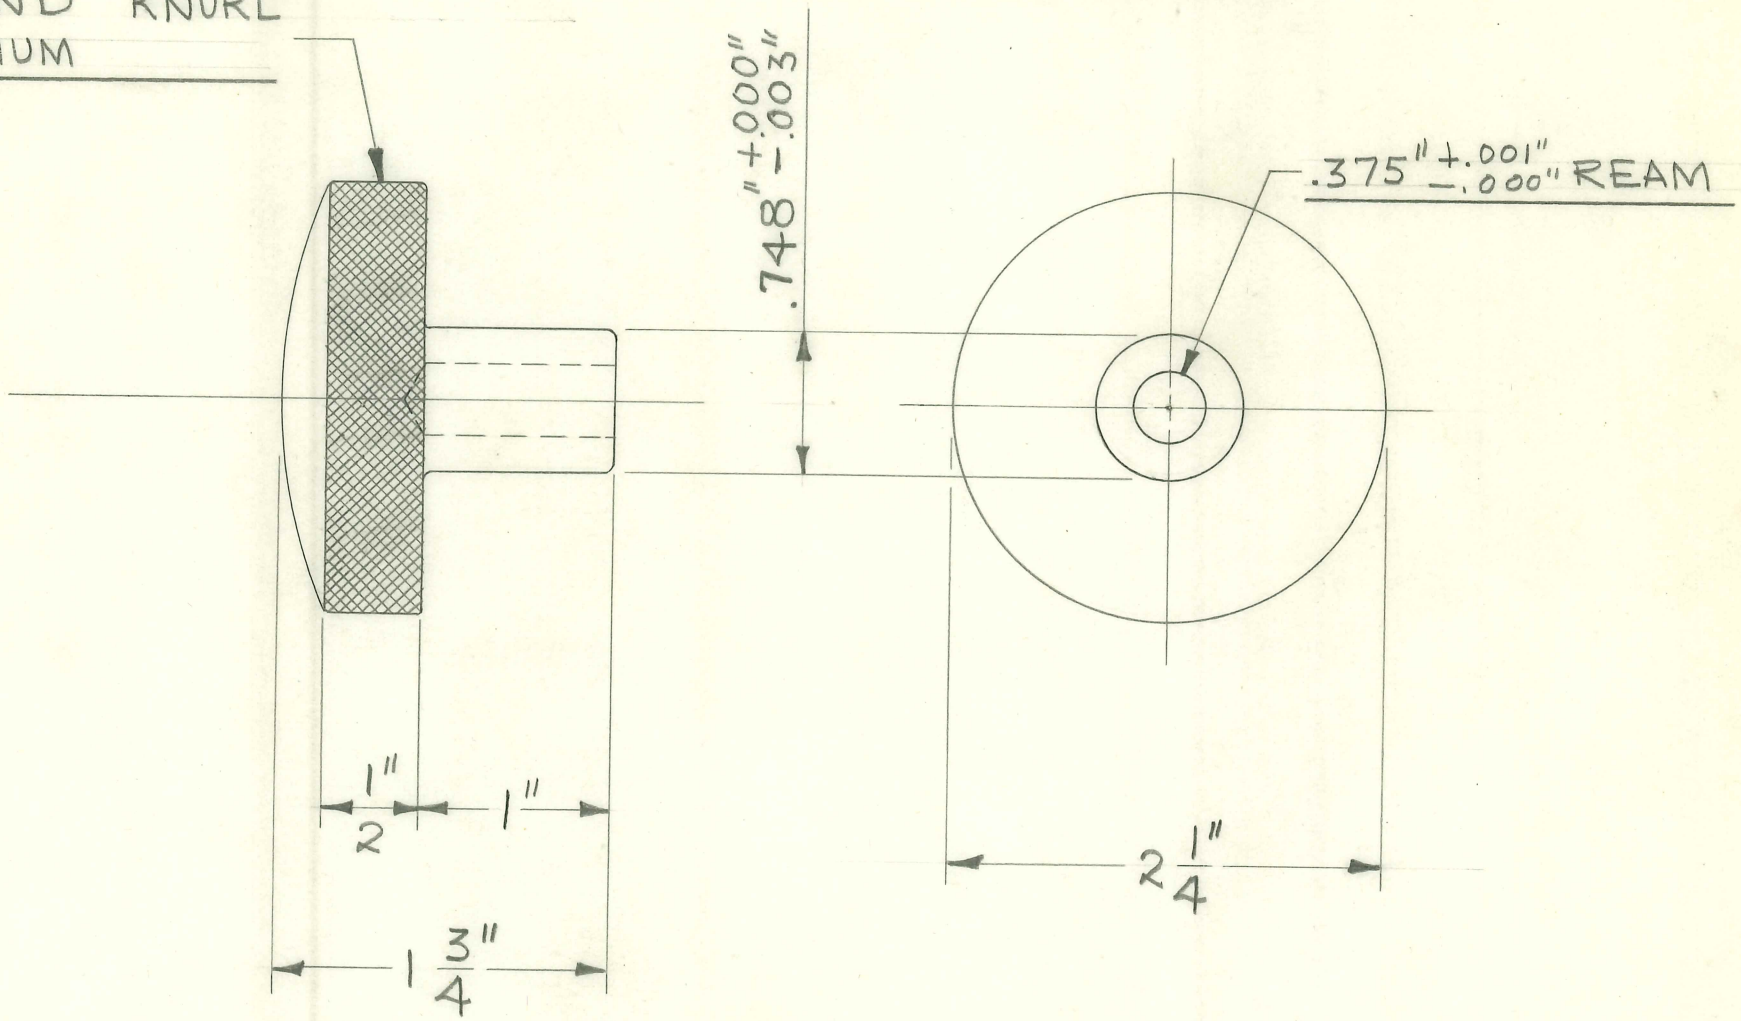

FOLDER #107

TITLE
FISCHER MOD. "100-96" DIAGNOSTIC S.P.
X-RAY – X-RAY WINDOW

PATTERN | FINISH | SCALE FULL

MATERIAL CLEAR G.E. LEXAN

TOOLS

H. G. FISCHER & CO.
FRANKLIN PARK, ILLINOIS

DATE 12-11-67 | DR. BY RSB | CH'K'D.

DIMENSIONS—UNLESS OTHERWISE SPECIFIED:
FRACTIONAL ± .015
DECIMAL ± .005
ANGULAR ± 1/2°
THREAD CHAMFER
UP TO 5/16 D. - 1/32 X 45°
3/8 D. & OVER - 1/16 X 45°

REMOVE ALL BURRS & SHARP CORNERS

USED ON	QTY.	USED ON	QTY.
13340GD	1		

PART NO. 13384 B

REVISION	DATE	BY
B ALTERED, SEE BULL. 428	12-11-67	RSB

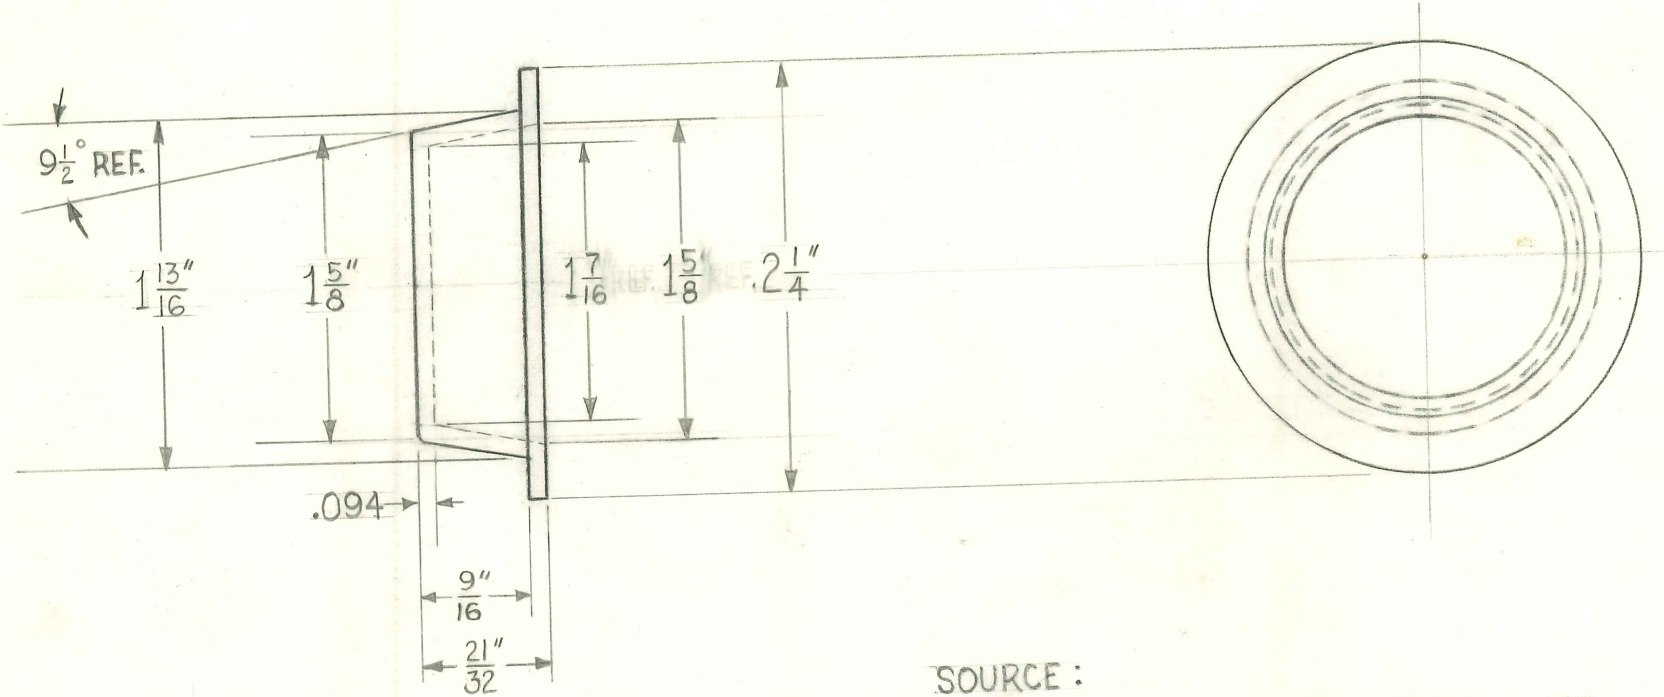

SOURCE:
EUREKA X-RAY TUBE CORP.

DO NOT SCALE DRAWING.

REMOVE - METAL SHIELD - HOUSING & MECHANIZM FROM BASE - SCREW SHIELD ONTO BASE & #27 DRILL AS SHOWN — REMOVE METAL SHIELD FROM BASE & RE-DRILL METAL SHIELD $\frac{9}{16}$" DRILL - MAKE NECESSARY CHANGES IN WIRING OF MECHANIZM & RE-ASSEMBLE.

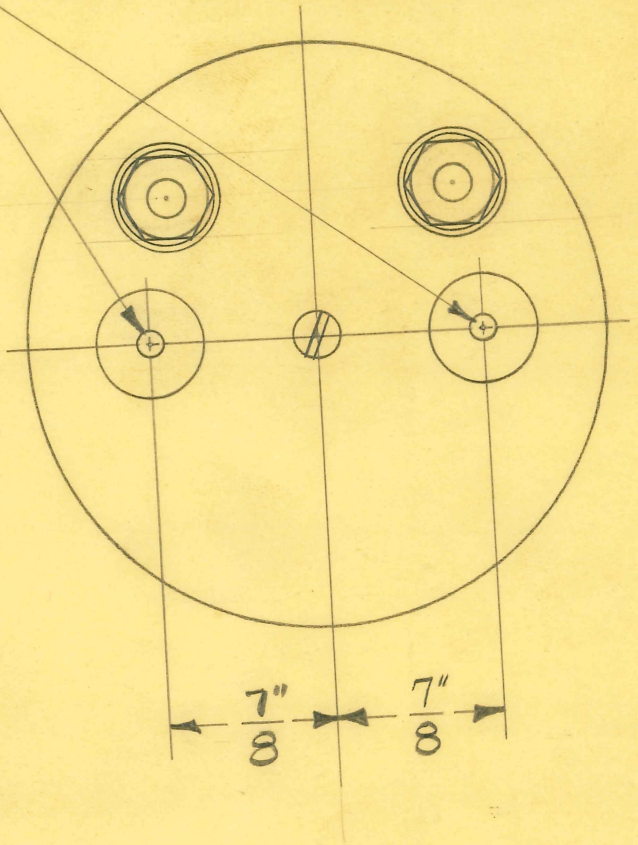

1 REQUIRED

SIZE	FROM 13394G	ISSUE 4-28-42	J.V.W.
KIND		CHANGED	
SHAPE		"	
FINISH		"	
TEMP.		"	

TITLE: FISCHER MOD. "RF-100" X-RAY CONTROL BOX VOLTMETER

H. G. FISCHER & CO.
2335 WABANSIA AVE.
CHICAGO, ILL.

CAT. NO.

PART NO. 13394GF

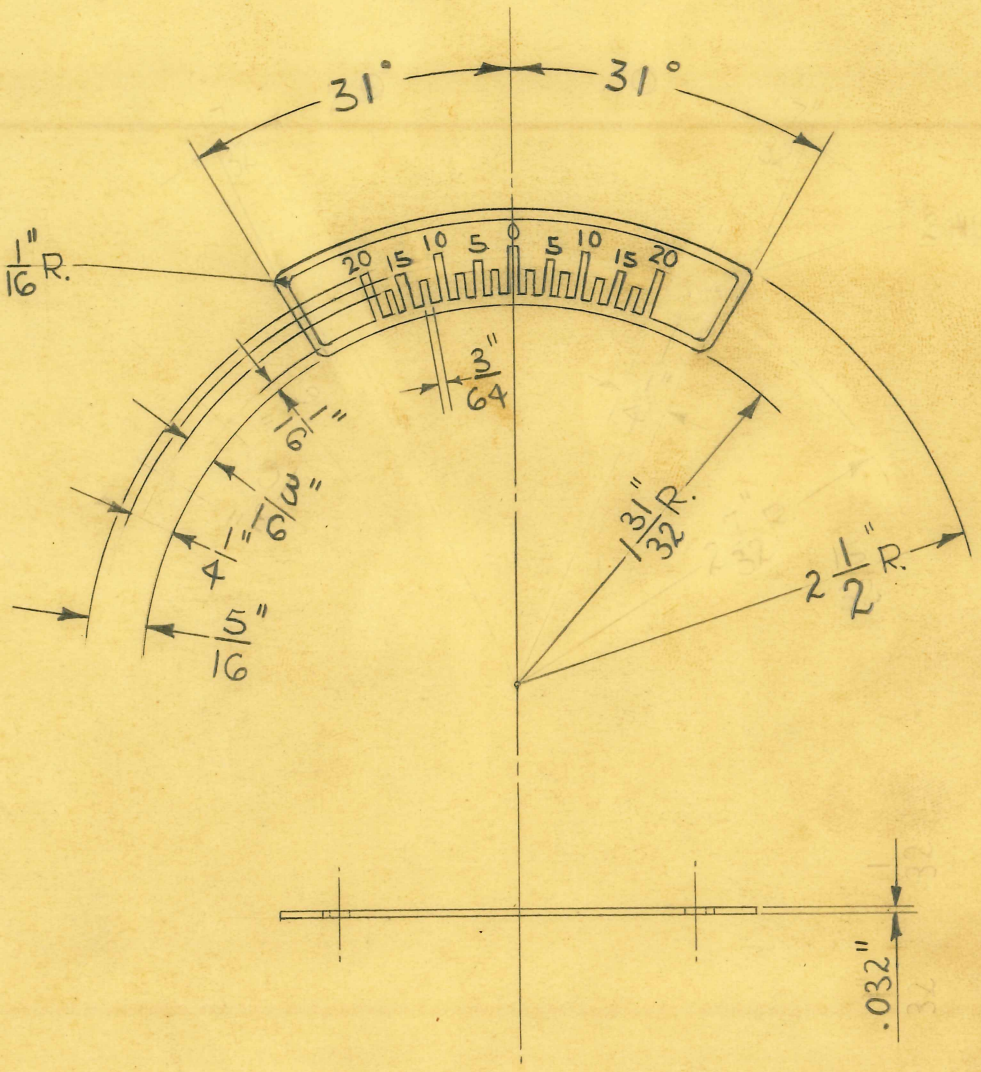

1 REQUIRED

DIMENSIONS	
FRACTIONAL	± .015
DECIMAL	± .005
ANGULAR	± 1/2°

UNLESS OTHERWISE SPECIFIED

SIZE	20GA. 032"	ISSUE 4-15-48	W.J.
KIND	ALUM.	CHANGED	
SHAPE		"	
FINISH		"	
TEMP.		"	
		"	

TITLE: FISCHER MOD. "RF-100" DIAGNOSTIC X-RAY VERTICAL ANGLE PLATE

H. G. FISCHER & CO.
2335 WABANSIA AVE.
CHICAGO, ILL.

CAT. NO.

PART NO. 13397A

TITLE

FISCHER MOD. "RF-100" DIAGNOSTIC X-RAY VERTICAL ANGLE PLATE

H. G. FISCHER & CO.
FRANKLIN PARK, ILLINOIS

DATE 5-17-50 DR. BY W.J. CH'K'D.

PART NO. 13397AF

REVISION	DATE	BY

PATTERN | FINISH | SCALE FULL

TOOLS: PERFORATING DIE #9909

MATERIAL: FROM 13397A

DIMENSIONS UNLESS OTHERWISE SPECIFIED

FRACTIONAL	± .015
DECIMAL	± .005
ANGULAR	± ½°

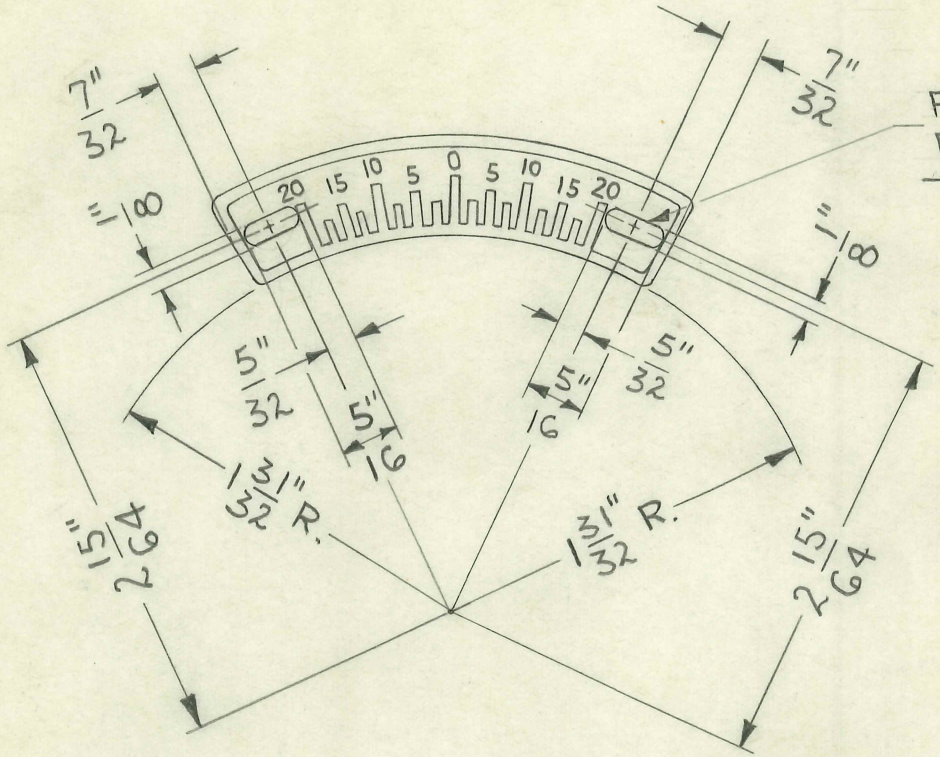

PUNCH 2 SLOTS WITH PERFORATING DIE #9909

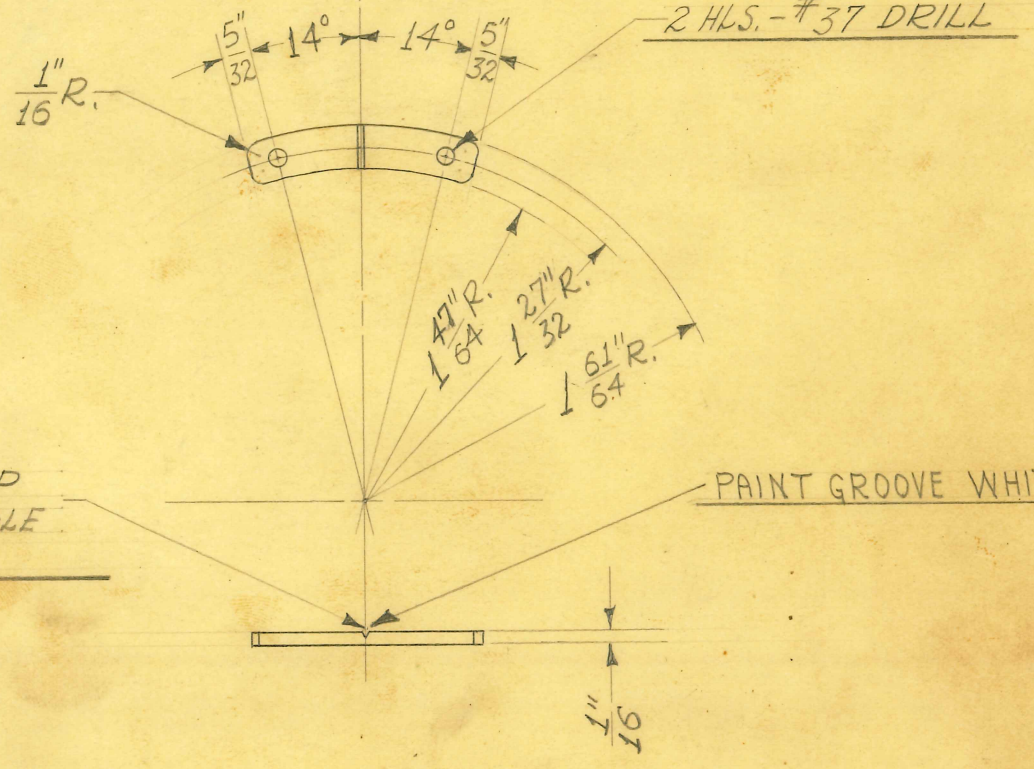

1 REQUIRED

SIZE	1/16" SHEET	ISSUE 8-23-40	J.Y.W.
KIND	BRASS	CHANGED	
SHAPE		"	
FINISH	PAINTED BLACK (SEE ABOVE)	"	
TEMP.		"	
PATT.		"	

TITLE: FISCHER MOD. "100-95" DIAGNOSTIC X-RAY VERTICAL ANGLE INDICATOR

H. G. FISCHER & CO.
2335 WABANSIA AVE.
CHICAGO, ILL.

CAT. NO.

PART NO. 13401

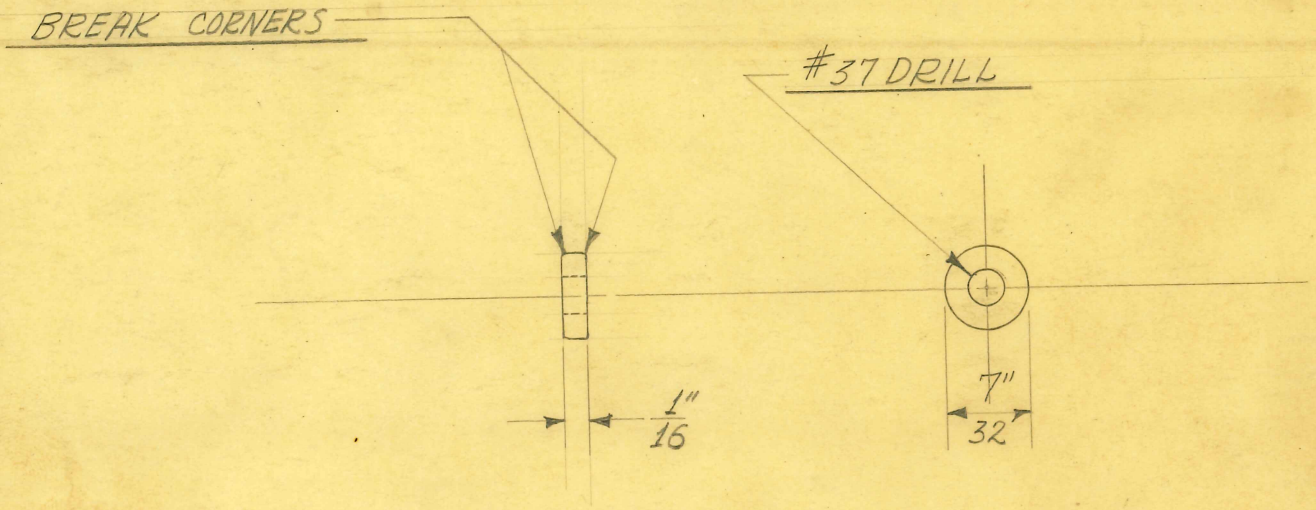

SCALE ÷ DOUBLE SIZE

2 REQUIRED

SIZE	9/32" DIA.	ISSUE 8-23-40	J.V.W.
KIND	BRASS ROD	CHANGED	
SHAPE		"	
FINISH	CAD. #23	"	
TEMP.		"	
PATT.		"	

TITLE: FISCHER MOD. "100-96" DIAGNOSTIC X-RAY VERTICAL ANGLE INDICATOR SPACER

H. G. FISCHER & CO.
2335 WABANSIA AVE.
CHICAGO, ILL.

CAT. NO.

PART NO. 13402

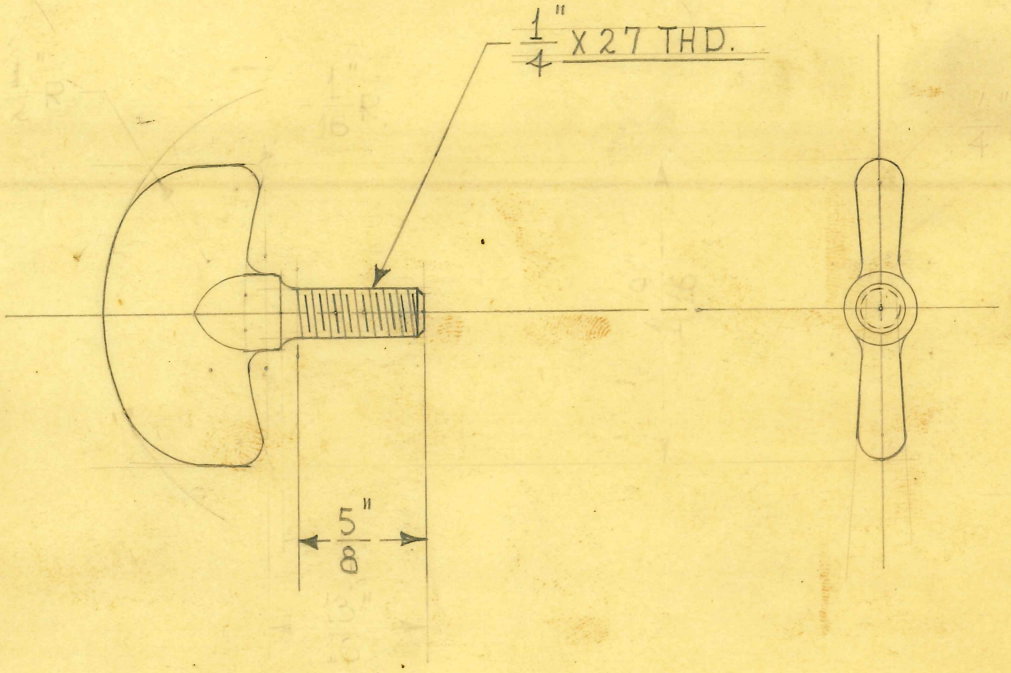

1 REQUIRED

SIZE		ISSUE 9-5-40	HE.
KIND	BRASS CASTING	CHANGED	
SHAPE		"	
FINISH	CHROME #2	"	
TEMP.		"	
PATT.	1623	"	

TITLE: FISCHER MOD. "100-96" X-RAY UNIT - TUBE HEAD CLAMP WING SCREW

H. G. FISCHER & CO.
2335 WABANSIA AVE.
CHICAGO, ILL.

CAT. NO.

PART NO. 13406F

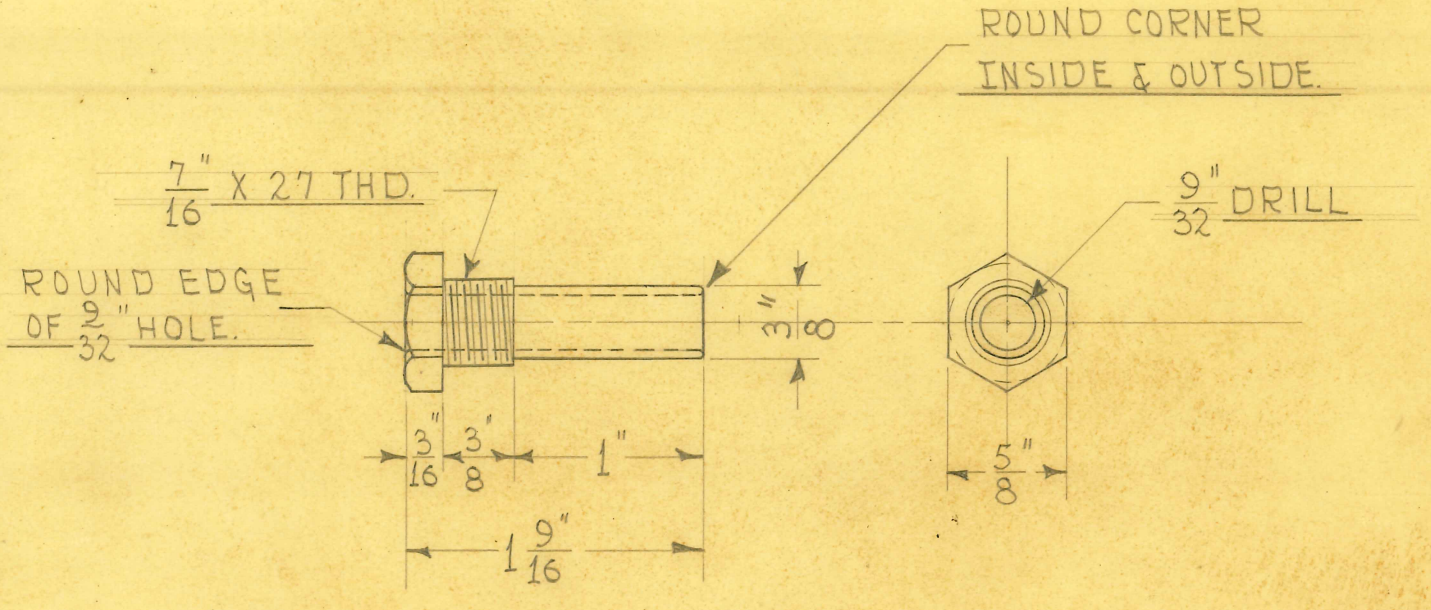

1 REQUIRED

SIZE	5/8" HEX.	ISSUE 8-26-40	HE.
KIND	BRASS ROD.	CHANGED	
SHAPE		"	
FINISH	CHROME #2	"	
TEMP.		"	
PATT.		"	

TITLE: FISCHER MOD. "100-96" X-RAY UNIT - TUBE HEAD BELLOWS TEMP. IND. GUIDE NUT

H. G. FISCHER & CO.
2335 WABANSIA AVE.
CHICAGO, ILL.

CAT. NO.

PART NO. 13411

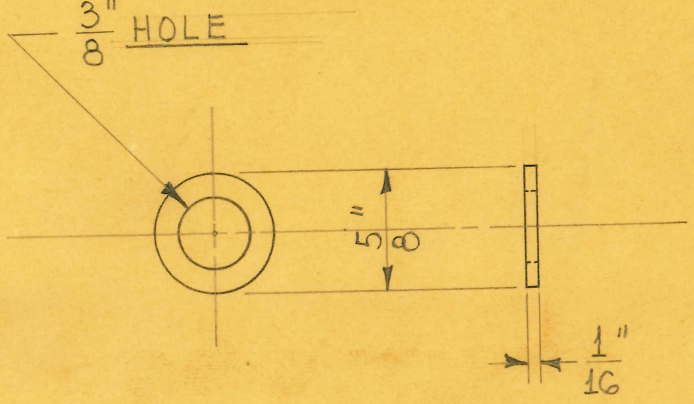

2 REQUIRED

HAND PUNCH #8939 - PUNCH BOX AUX. TOOL ROOM #17

1/16" SHEET NEOPRENE #2065 – #70 DUROMETER TEST

SIZE	~~1/16" SHEET~~	ISSUE 3-5-45	HE.
KIND	~~NEOPRENE~~	CHANGED	
SHAPE		"	
FINISH		"	
TEMP.		"	
PATT.		"	

TITLE: FISCHER MOD. "100-96" X-RAY UNIT - OIL IMMERSED TUBE HOUSING END CAP - OIL FILLER SCREW GASKET

H. G. FISCHER & CO.
2335 WABANSIA AVE.
CHICAGO. ILL.

CAT. NO.

PART NO. 13412 1/2

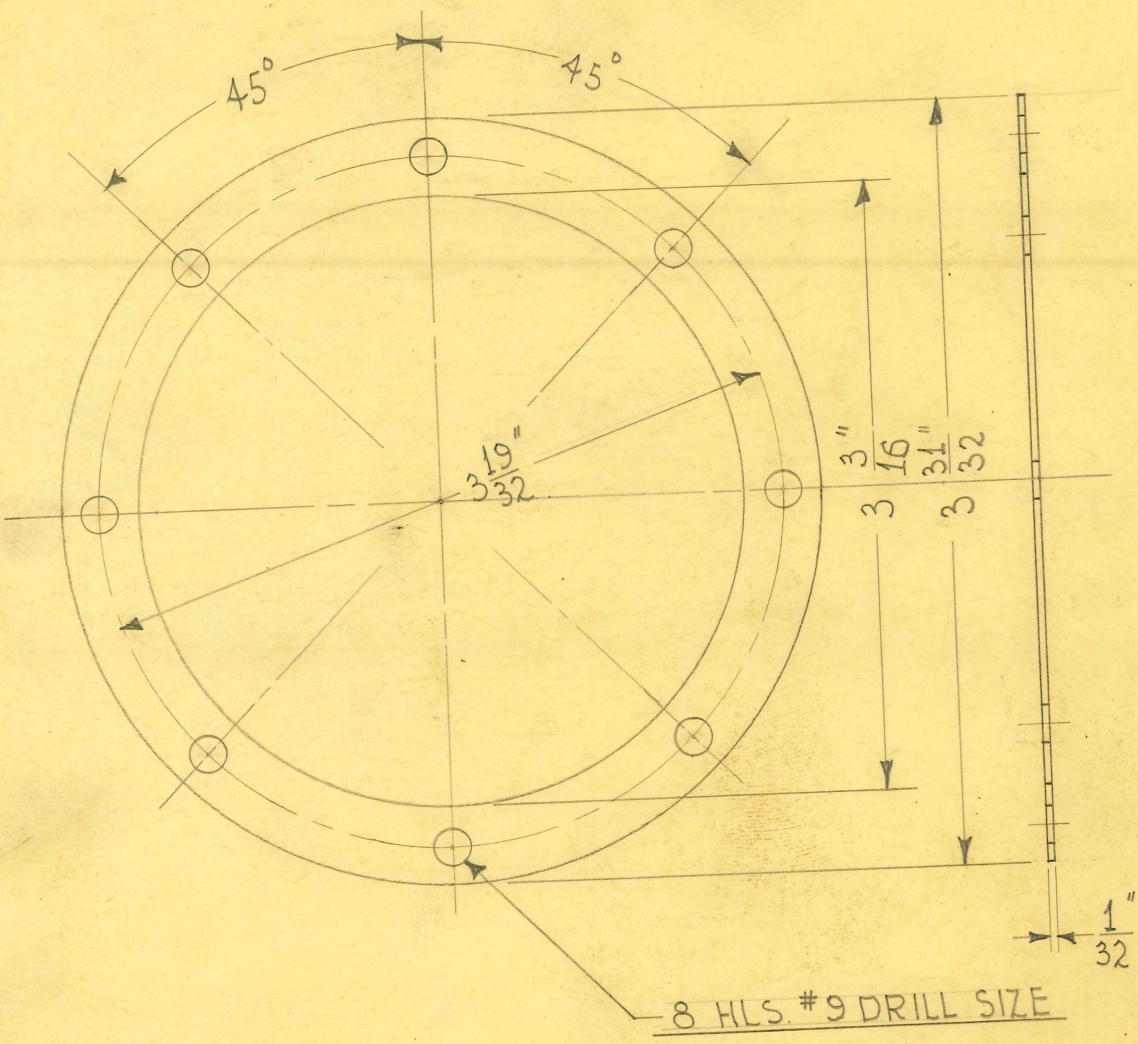

2 REQUIRED

PUNCHING FIX. & PUNCH #8694 BIN Y-5

1/32" SHEET NEOPRENE #2065 – #70 DUROMETER TEST

SIZE	1/32" SHEET	ISSUE 9-4-40	H.E.
KIND	NEOPRENE	CHANGED 10-23-40	J.W.
SHAPE		"	
FINISH		"	
TEMP.		"	
PATT.		"	

TITLE: FISCHER MOD. "100-96" OIL IMMERSED TUBE HOUSING END CAP GASKET

H. G. FISCHER & CO.
2335 WABANSIA AVE.
CHICAGO, ILL.

CAT. NO.

PART NO. 13417A

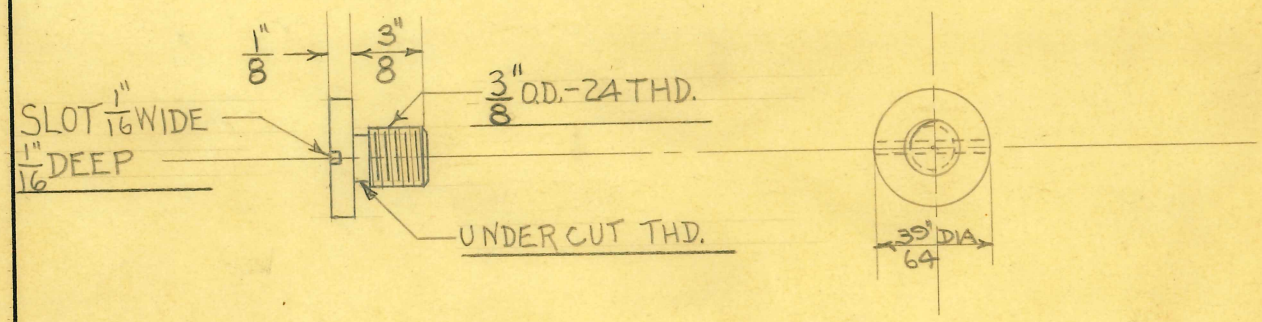

2 REQUIRED

SIZE	5/8 DIA	ISSUE 9-13-40	C.E.A.	**TITLE:** FISCHER MODEL "100-96" X-RAY UNIT OIL IMMERSED TUBE HOUSING END CAP-LEFT.— OIL FILLER SCREW.
KIND	BRASS ROD	CHANGED 3-5-45	HE.	
SHAPE		"		
FINISH	#2 CHROME	"		
TEMP.		"		
PATT.		"		

H. G. FISCHER & CO.
2335 WABANSIA AVE.
CHICAGO, ILL.

CAT. NO.

PART NO. 13419 A

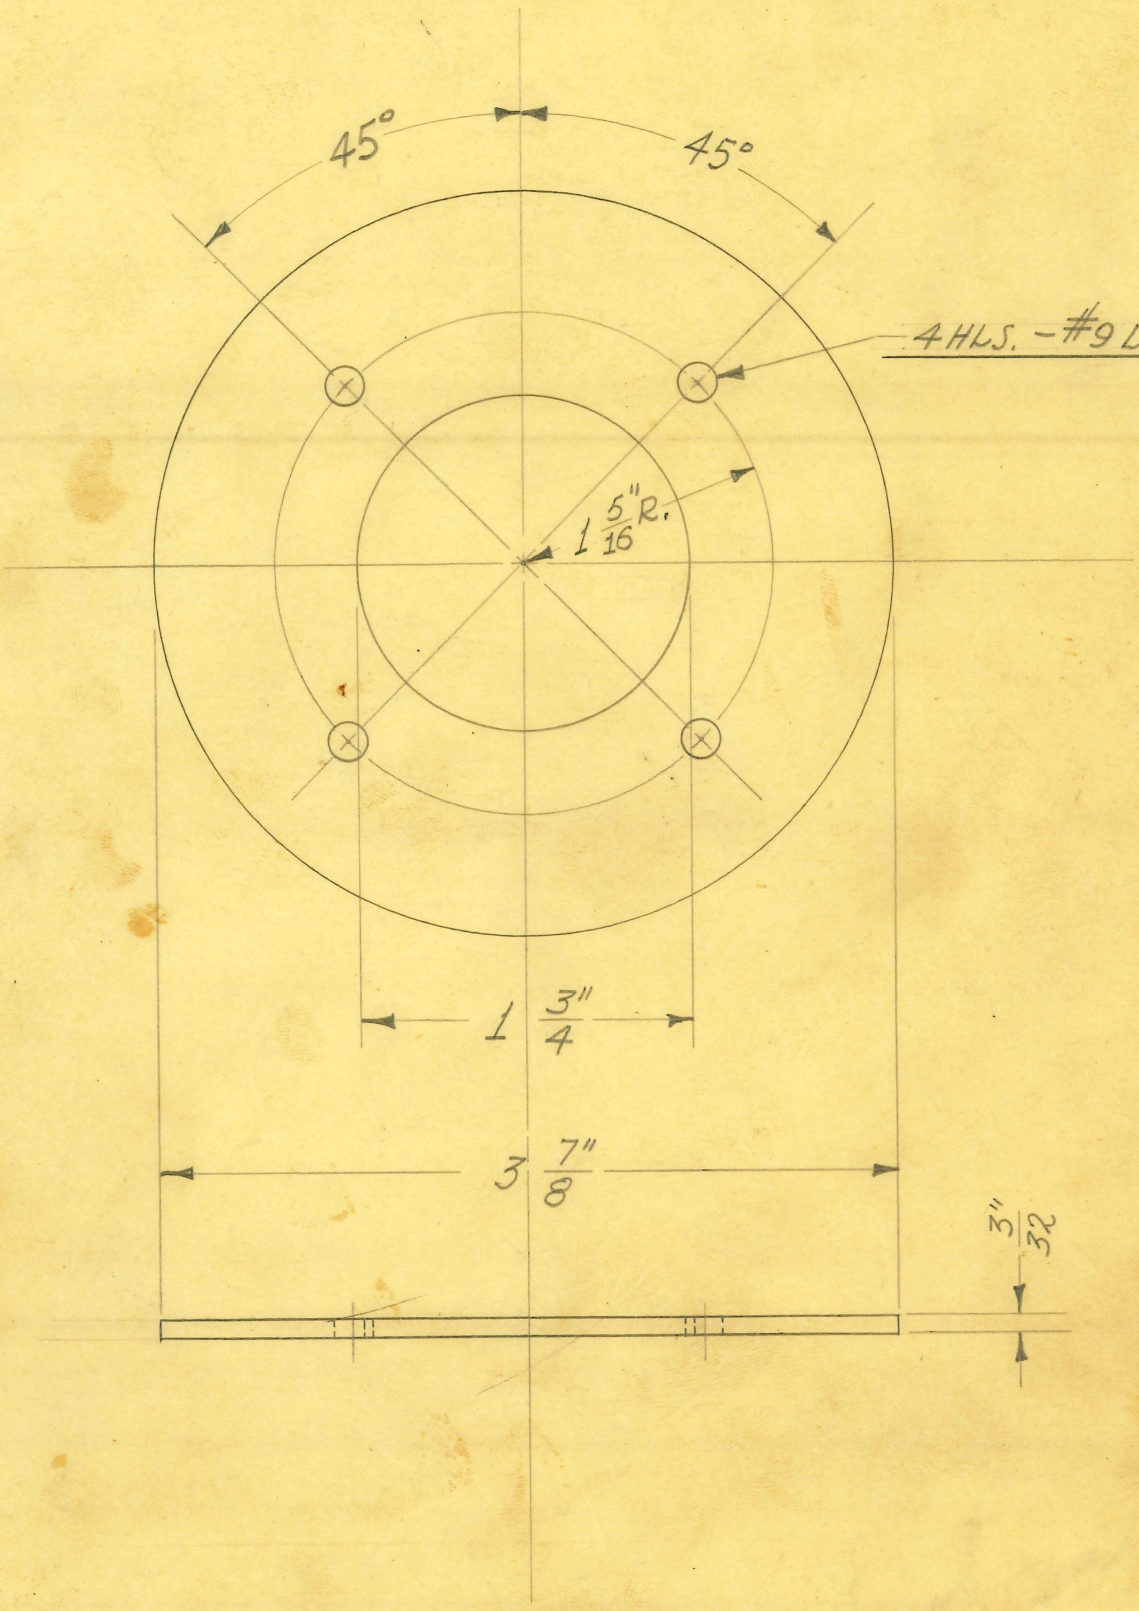

1 REQUIRED

SIZE	3/32" SHEET	ISSUE 9-20-40	J.V.W.
KIND	LEAD	CHANGED	
SHAPE		"	
FINISH	BLK. #80	"	
TEMP.		"	
PATT.		"	

TITLE:
FISCHER MOD. "100-96" DIAGNOSTIC S.P. X-RAY
X-RAY HEAD - LEAD PROTECTION DISC

H. G. FISCHER & CO.
2335 WABANSIA AVE.
CHICAGO, ILL.

CAT. NO.

PART NO. 13424

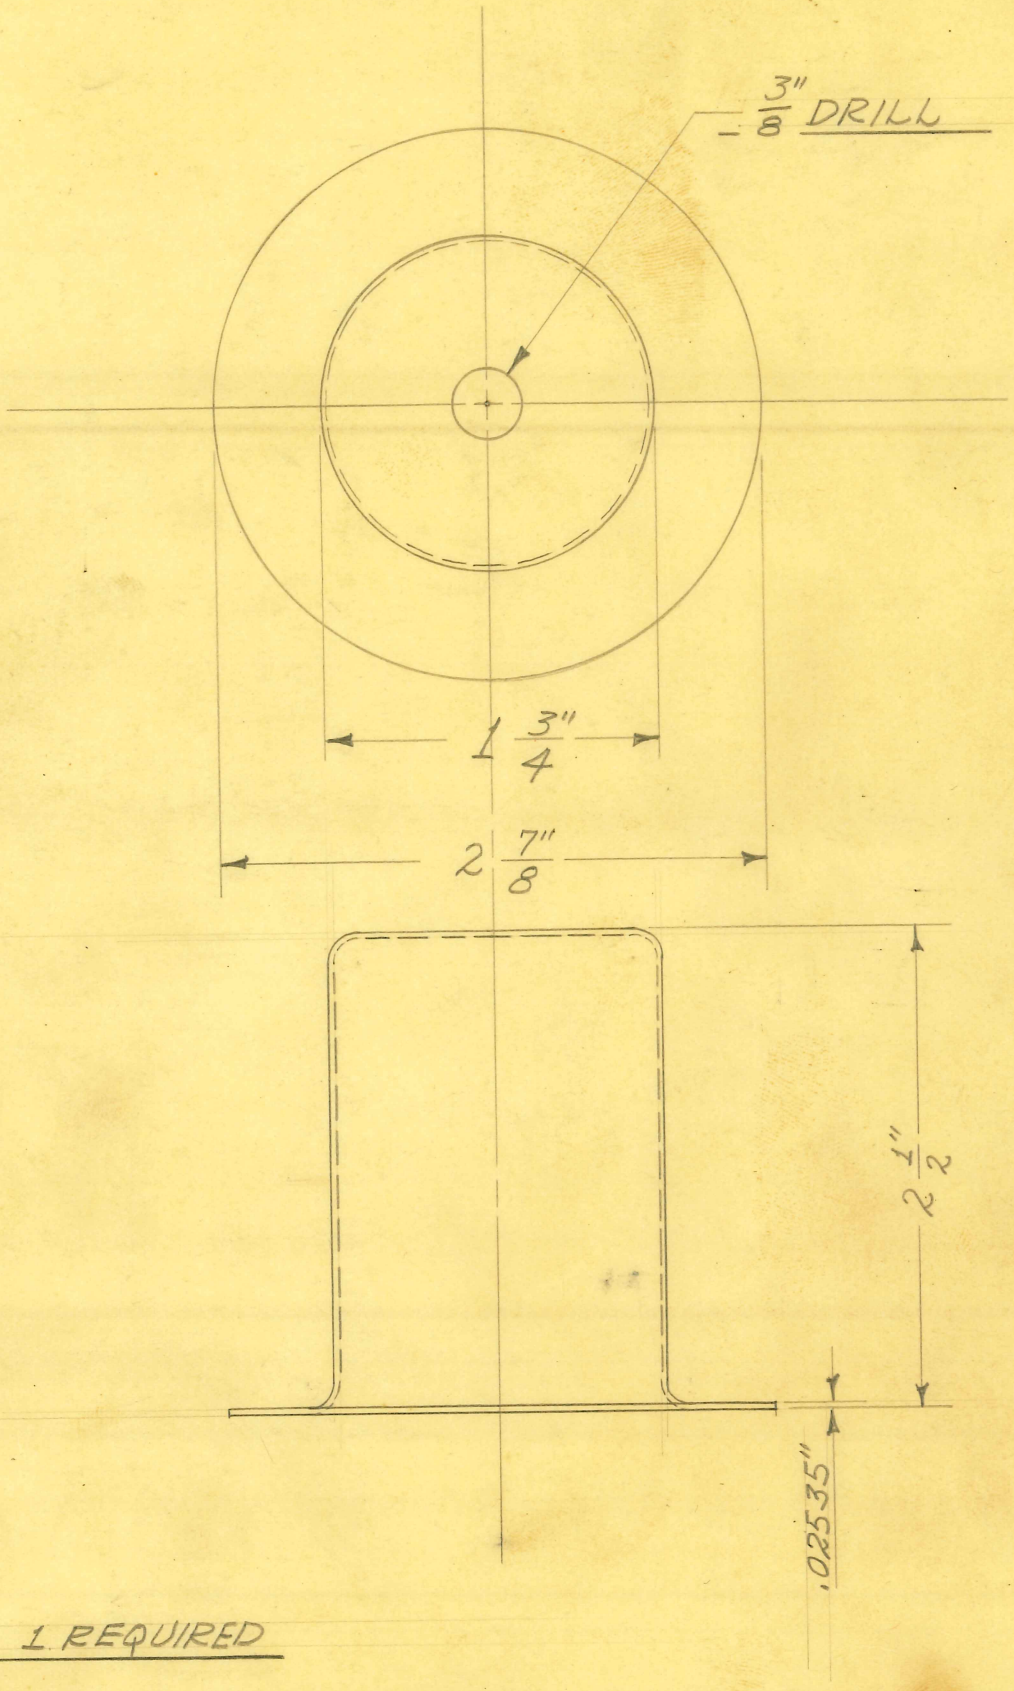

1 REQUIRED

SIZE	#22GA. SHEET	ISSUE 9-24-40	J.V.W.
KIND	BRASS	CHANGED	
SHAPE		"	
FINISH		"	
TEMP.		"	
PATT.		"	

TITLE:
FISCHER MOD. "100-96" DIAGNOSTIC S.P. X-RAY
TUBE HEAD BELLOW EXPANSION CUP

H. G. FISCHER & CO.
2335 WABANSIA AVE.
CHICAGO, ILL.

CAT. NO.

PART NO. 13426F

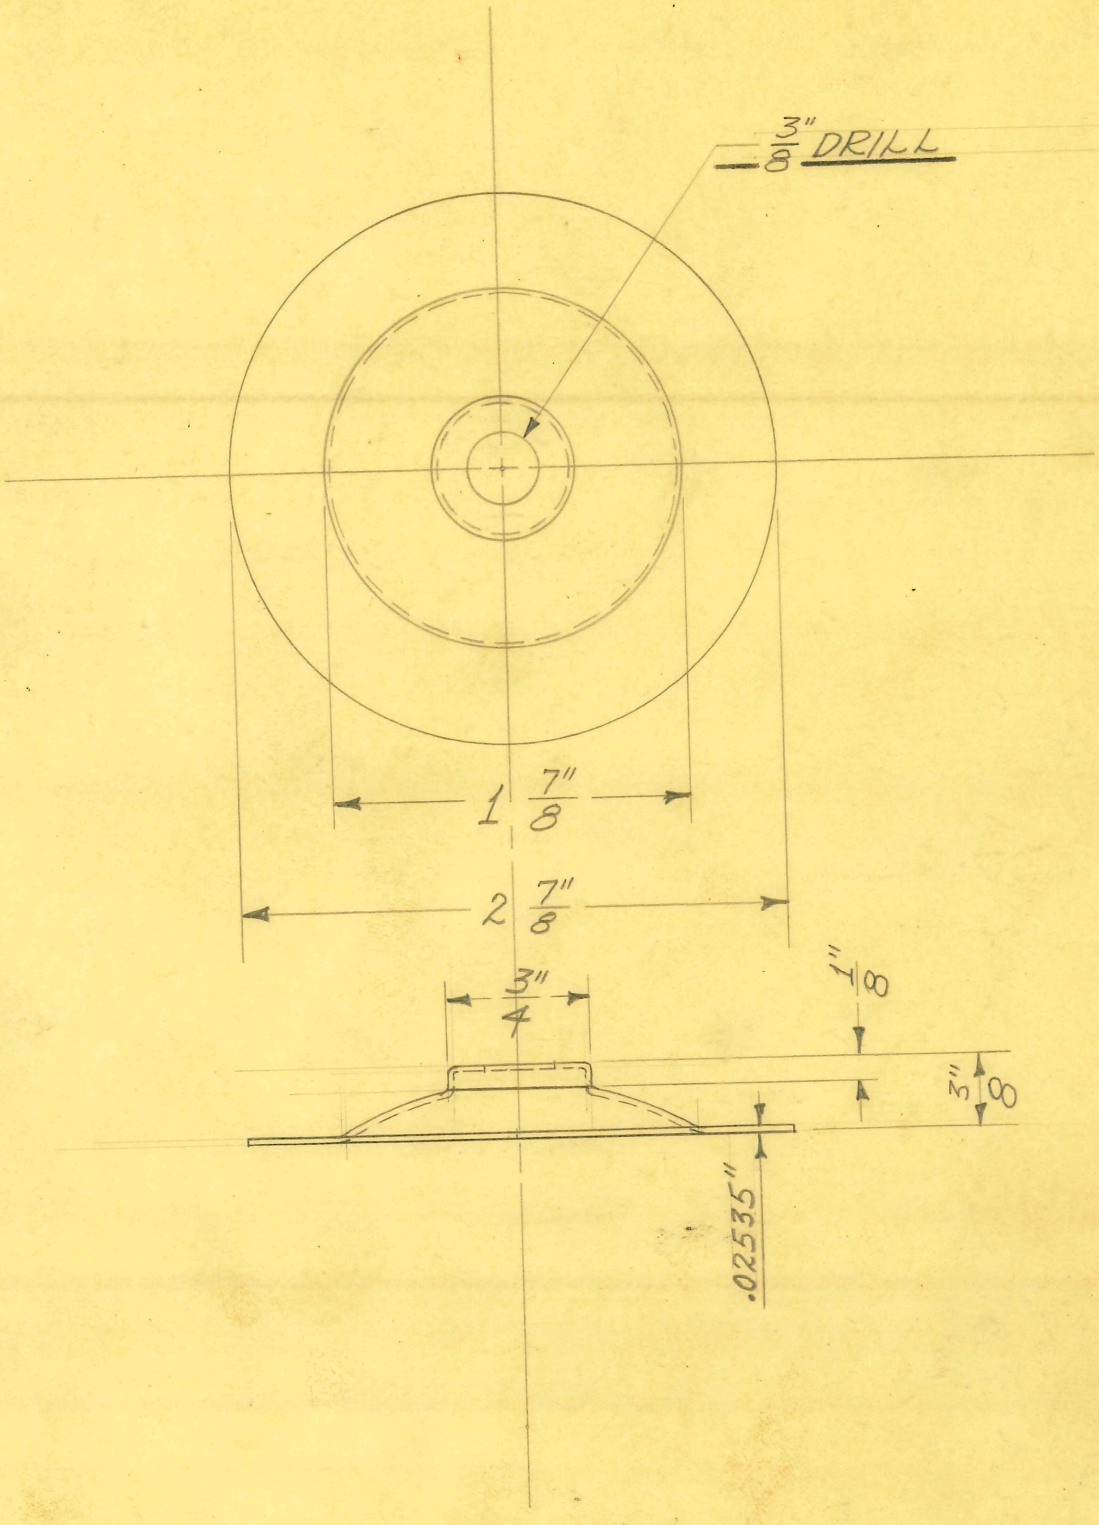

1 REQUIRED

SIZE	#22GA. SHEET	ISSUE 9-24-40	J.V.W.
KIND	BRASS	CHANGED	
SHAPE		"	
FINISH		"	
TEMP.		"	
PATT.		"	

TITLE:
FISCHER MOD. "100-96" DIAGNOSTIC S.P. X-RAY
TUBE HEAD BELLOWS HEAD

H. G. FISCHER & CO.
2335 WABANSIA AVE.
CHICAGO, ILL.

CAT. NO.

PART NO. 13427F

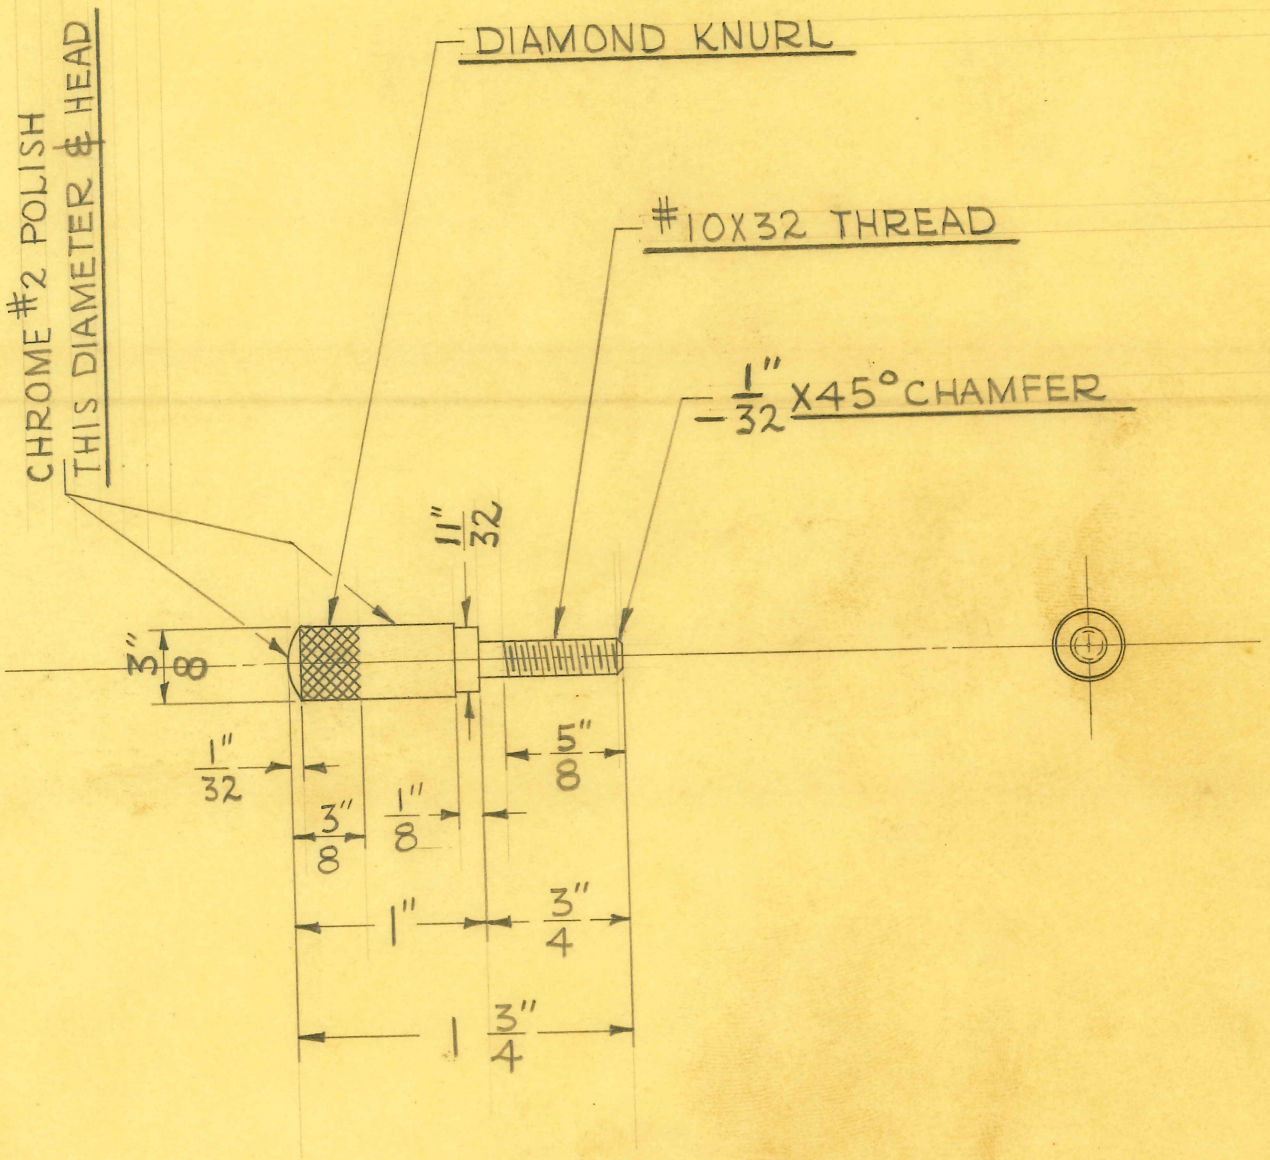

4 REQUIRED

SIZE	3/8" DIA.	ISSUE 1-7-46	J.V.W.	TITLE: FISCHER "RF-100" X-RAY UNIT SHUTTER MOUNTING THUMB SCREW
KIND	C.R. STEEL	CHANGED		
SHAPE		"		
FINISH	CHR. #2	"		
TEMP.		"		
PATT.		"		

H. G. FISCHER & CO.
2335 WABANSIA AVE.
CHICAGO, ILL.

CAT. NO.

PART NO. 13428

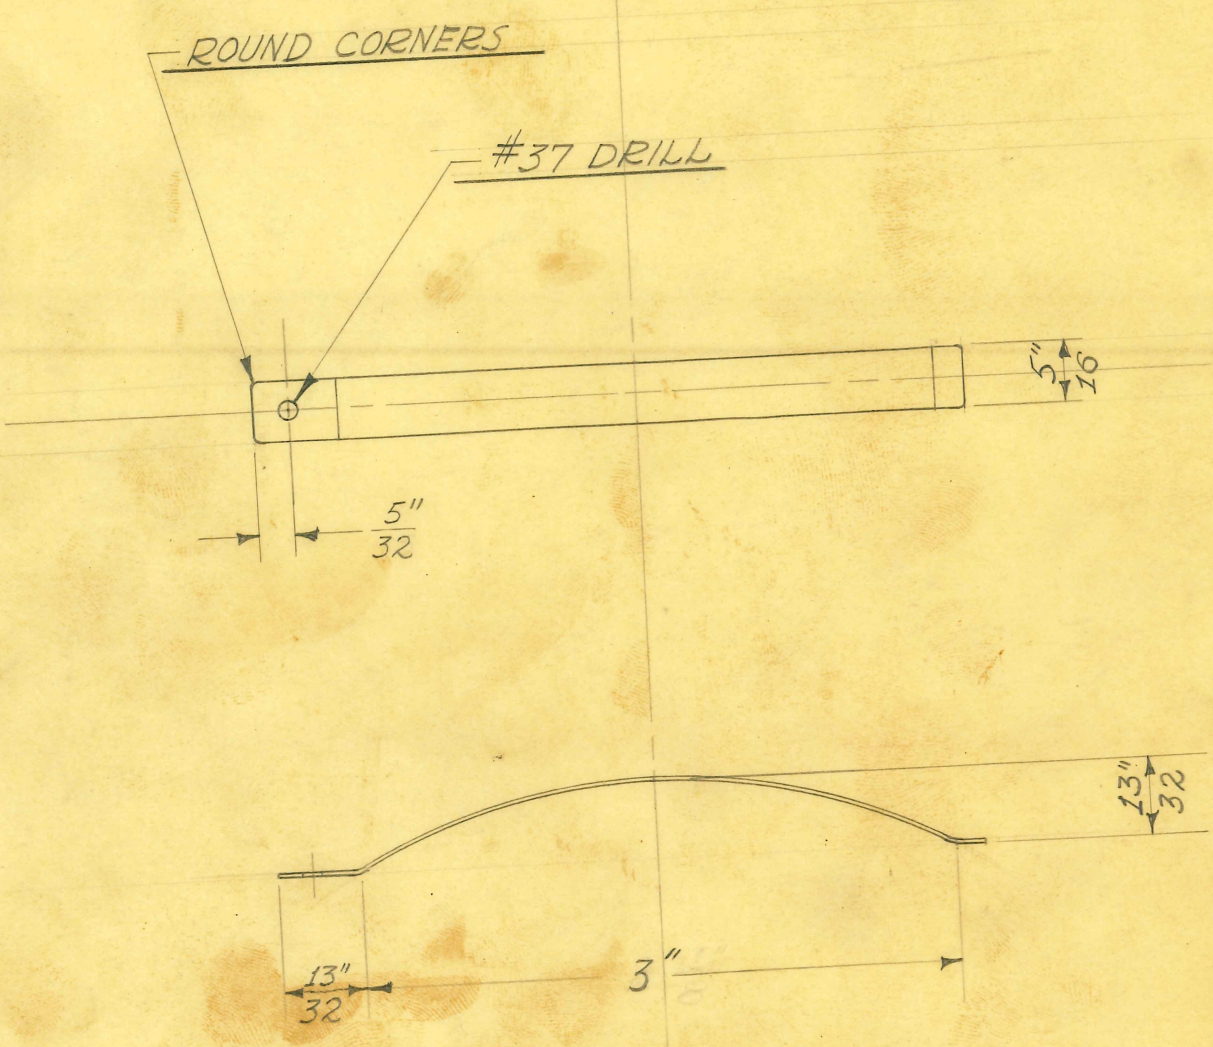

DEVELOPED LENGTH = 3 3/4"

2 REQUIRED

SIZE	.015" SHEET	ISSUE 9-17-40	J.V.W.
KIND	PHOS. BRONZE	CHANGED	
SHAPE		"	
FINISH	CAD. #23	"	
TEMP.		"	
PATT.		"	

TITLE: FISCHER MOD. "100-96" DIAGNOSTIC S.P. X-RAY
X-RAY-FILTER RETAINING SPRING

H. G. FISCHER & CO.
2335 WABANSIA AVE.
CHICAGO, ILL.

CAT. NO.

PART NO. 13429

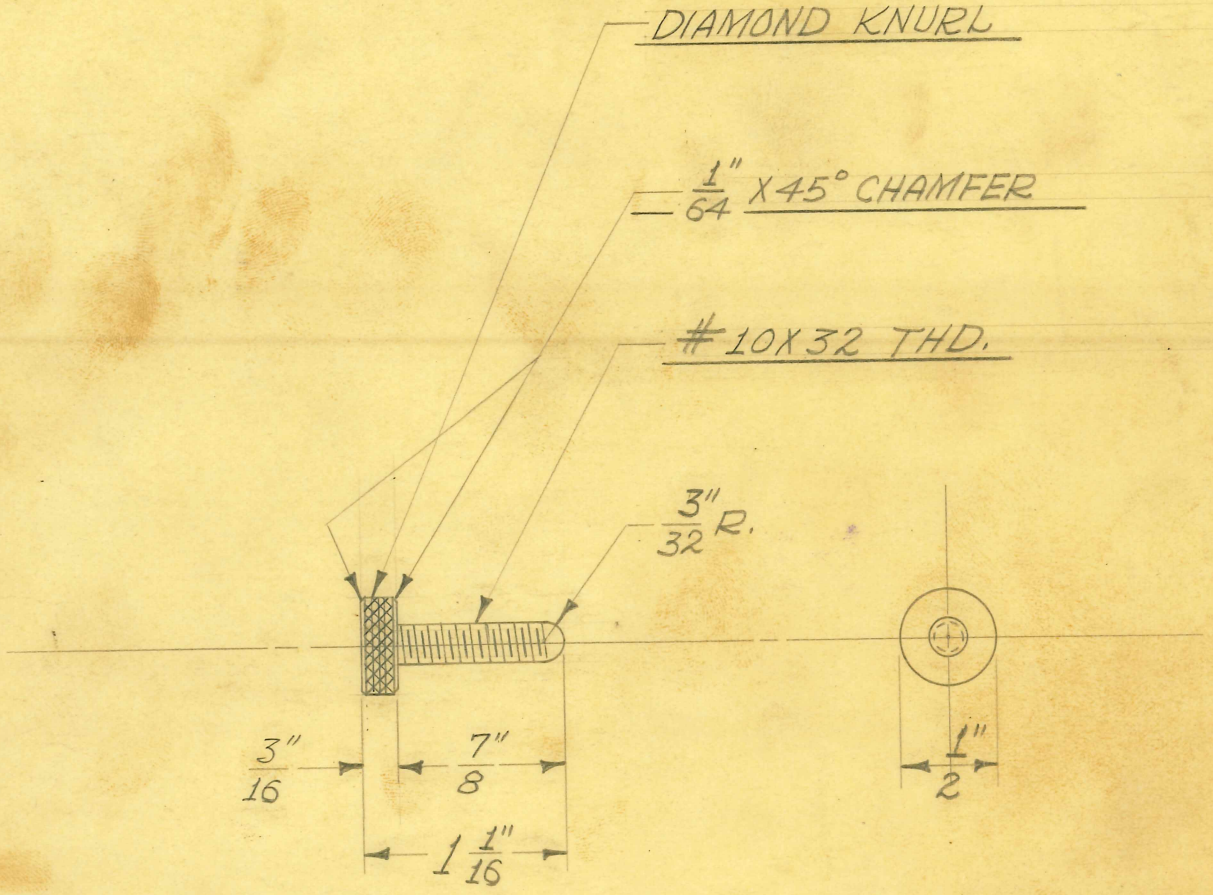

1 REQUIRED

SIZE	1/2" DIAM.	ISSUE 9-17-40	J.V.W.
KIND	C.R. STEEL	CHANGED	
SHAPE		"	
FINISH	CHR. #2	"	
TEMP.		"	
PATT.		"	

TITLE: FISCHER MOD "100-96" DIAGNOSTIC S.P. X-RAY — CONE RETAINING THUMB SCREW.

H. G. FISCHER & CO.
2335 WABANSIA AVE.
CHICAGO, ILL.

CAT. NO.

PART NO. 13430

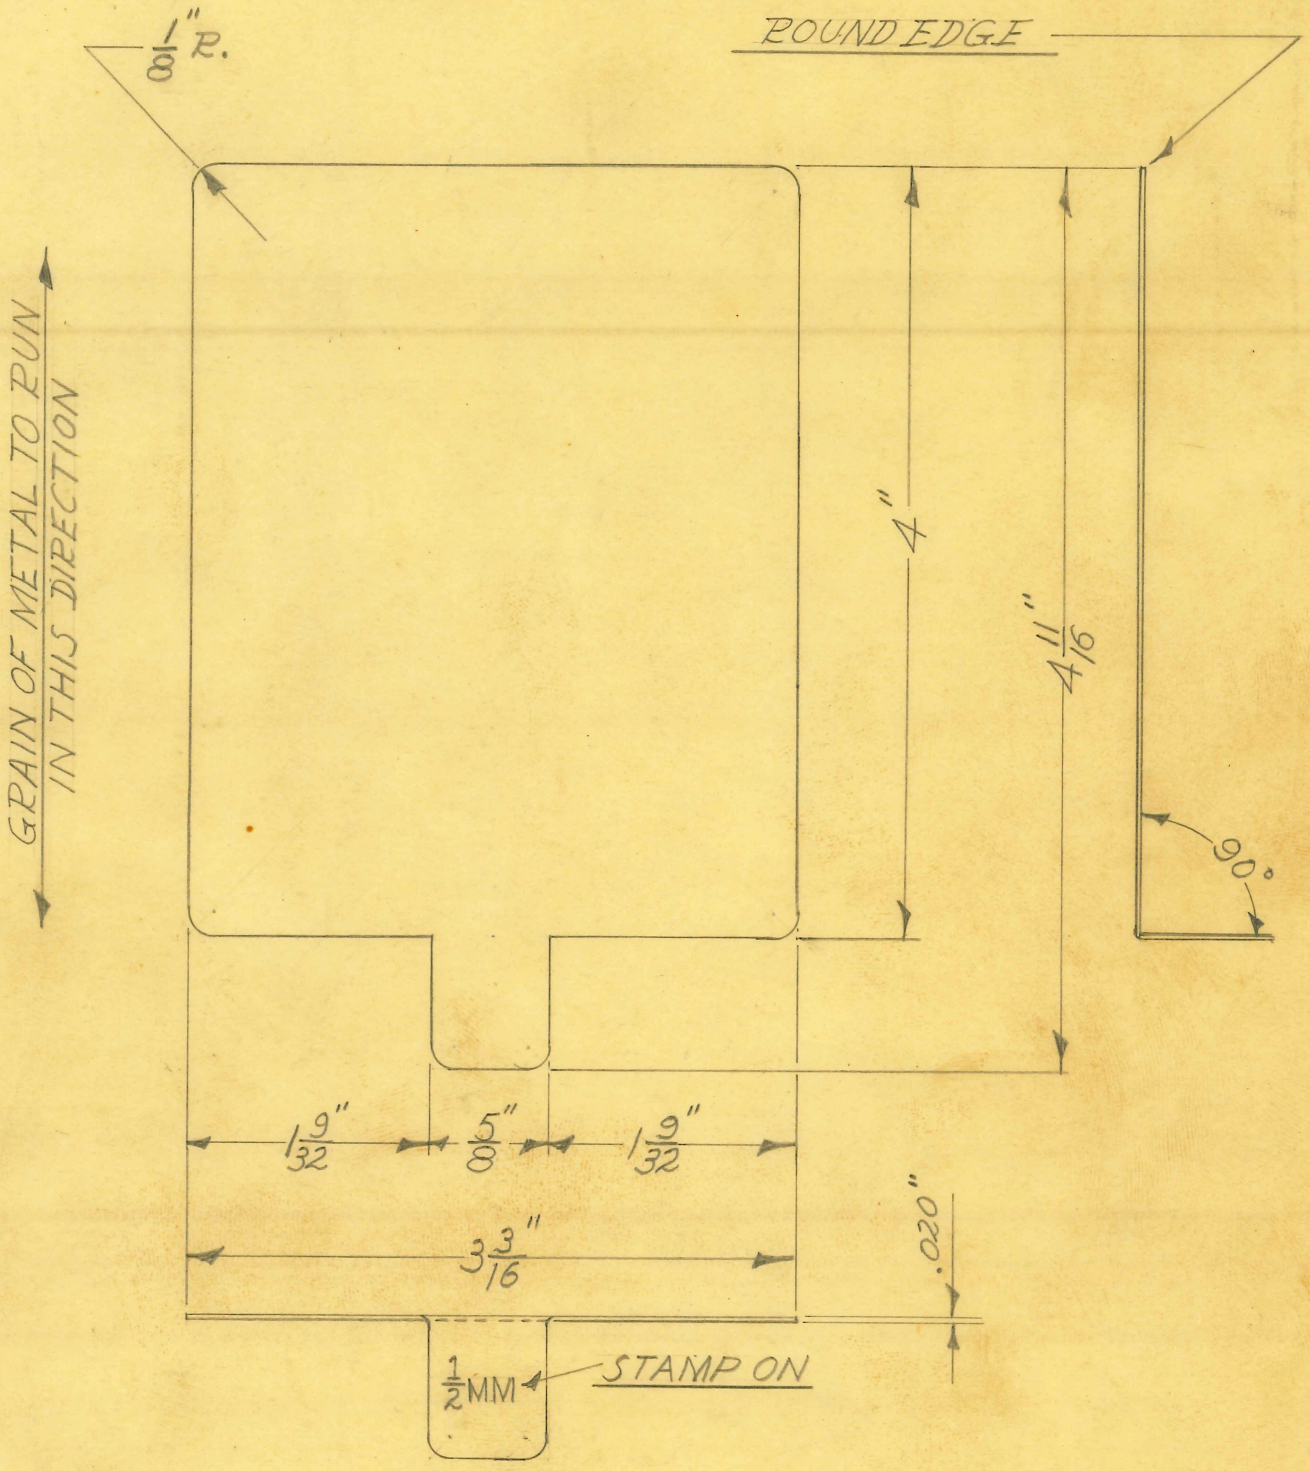

1 REQUIRED

SIZE	.020" SHEET	ISSUE 10-6-47	J.M.F
KIND	ALUMINUM	CHANGED	
SHAPE		"	
FINISH		"	
TEMP.		"	
PATT.		"	

TITLE:
FISCHER MOD. "100-96" DIAGNOSTIC S.P. X-RAY — X-RAY FILTER -

H. G. FISCHER & CO.
2335 WABANSIA AVE.
CHICAGO, ILL.

CAT. NO.

PART NO. 134321/2

TITLE
FISCHER MULTI-SERVICE UNIT
TUBEHEAD FILTER – 2 MM

H. G. FISCHER & CO.
FRANKLIN PARK, ILLINOIS

PART NO. 13432 3/4

DATE 9-23-'55 | DR BY RDL | CH'K'D.

REVISION	DATE	BY

PATTERN | FINISH | SCALE FULL

TOOLS | MATERIAL .080" SHEET ALUMINUM

DIMENSIONS
FRACTIONAL ± .015
DECIMAL ± .005
ANGULAR ± ½°
UNLESS OTHERWISE SPECIFIED

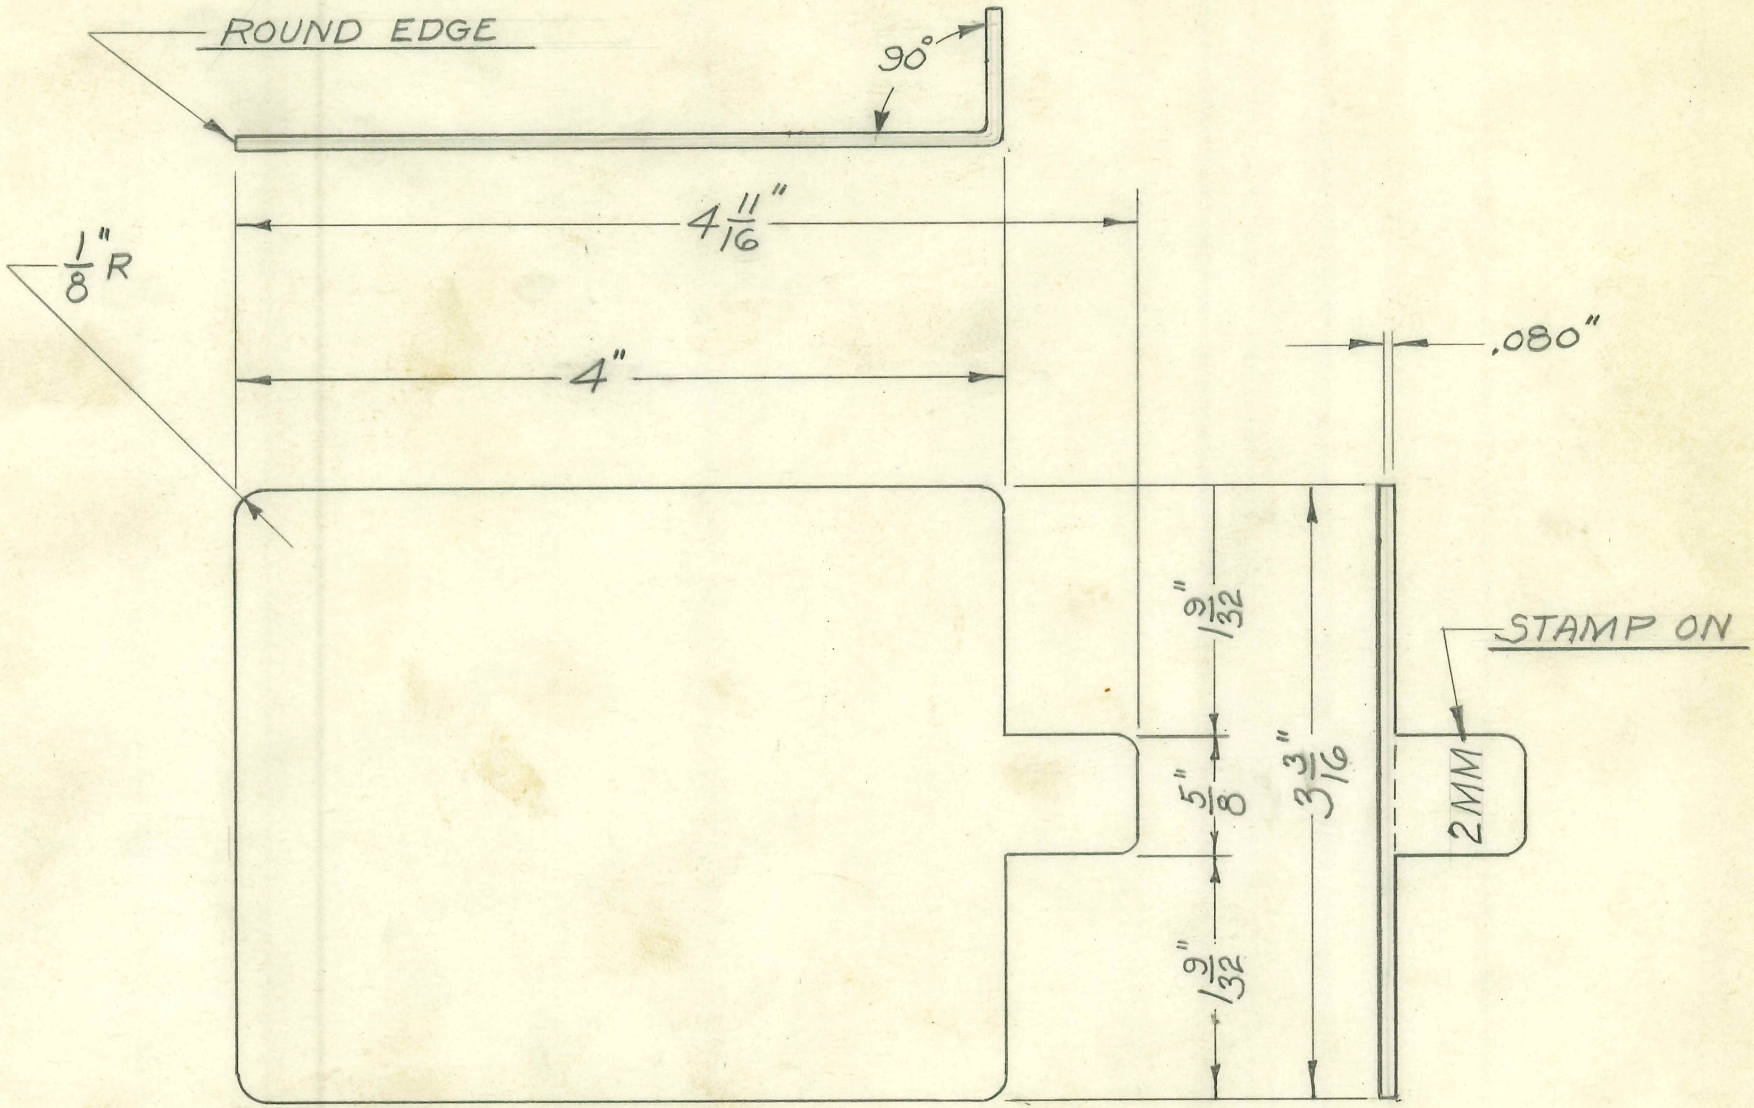

1 REQUIRED

FOLDER #107

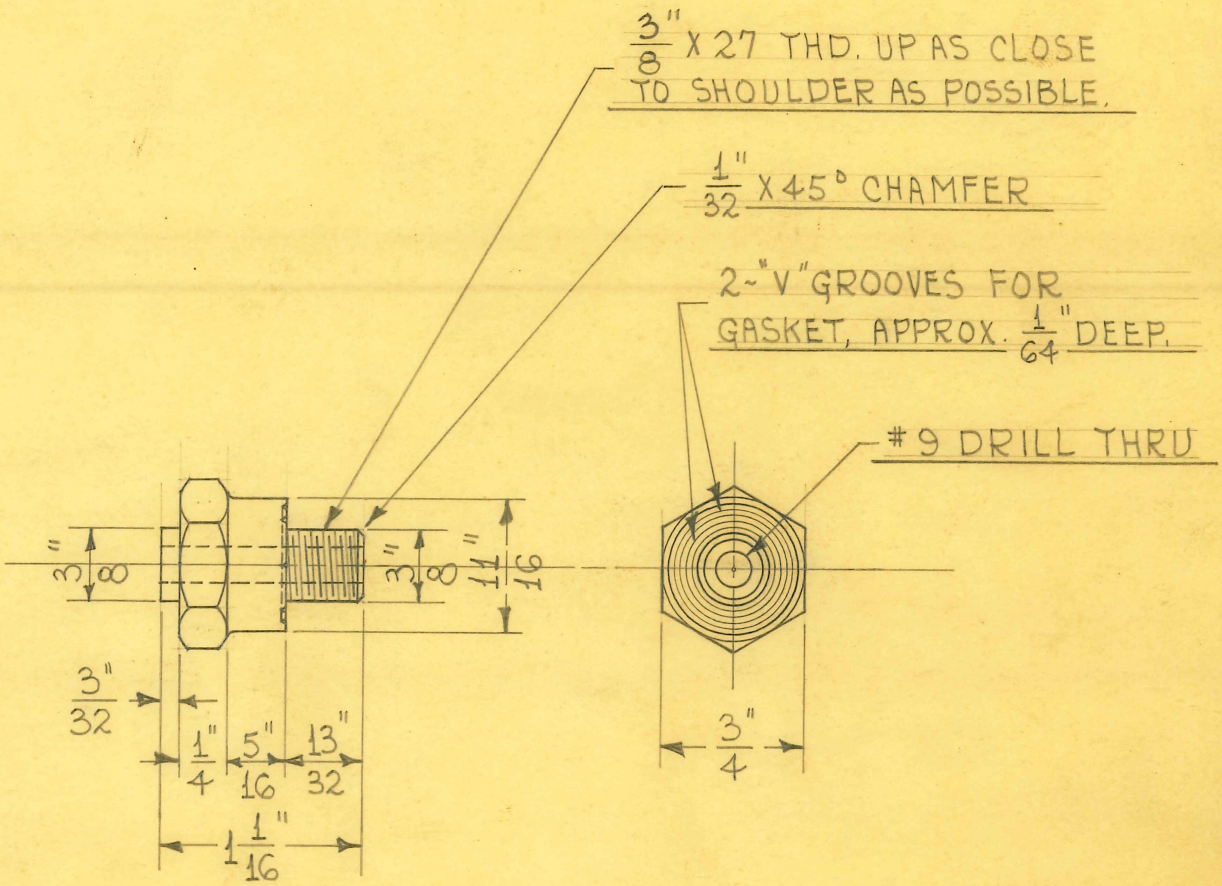

1 REQUIRED

SIZE	3/4" HEX.	ISSUE 7-3-45	HE.
KIND	BRASS ROD	CHANGED	
SHAPE		"	
FINISH		"	
TEMP.		"	
PATT.		"	

TITLE: FISCHER MOD. "100-96" DIAG. S.P. X-RAY-TUBE HEAD BELLOWS SUPPORT BOLT

H. G. FISCHER & CO.
2335 WABANSIA AVE.
CHICAGO, ILL.

CAT. NO.

PART NO. 13438A

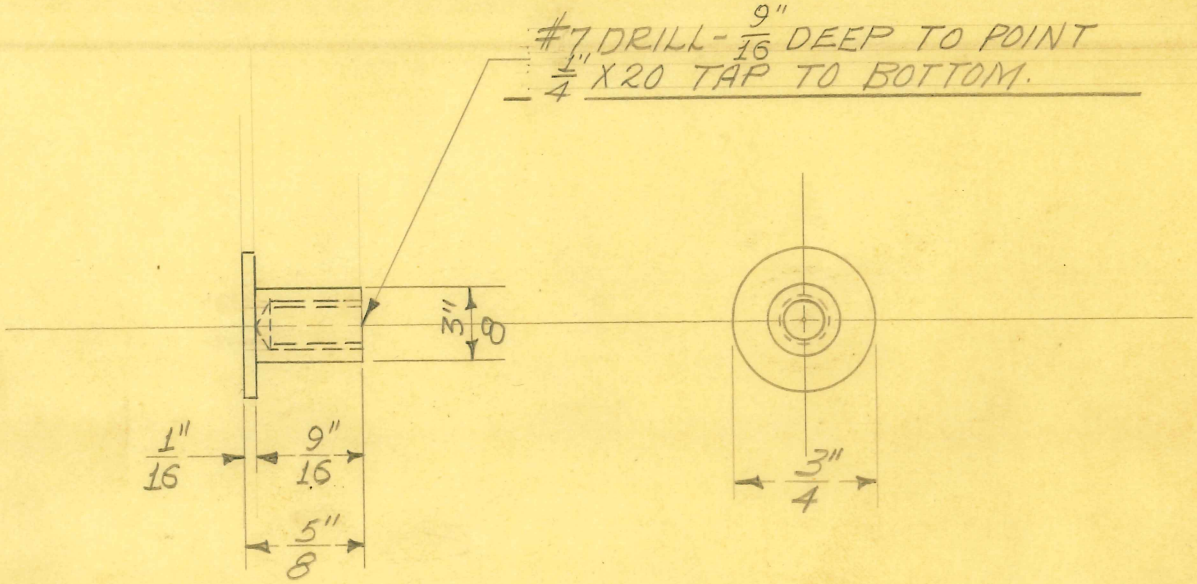

1 REQUIRED

SIZE	3/4" DIA.	ISSUE 9-24-40	J.V.W.
KIND	BRASS ROD	CHANGED	
SHAPE		"	
FINISH		"	
TEMP.		"	
PATT.		"	

TITLE: FISCHER MOD. "100-96" DIAGNOSTIC S.P. X-RAY TUBE HEAD BELLOWS TEMPERATURE INDICATOR SUPPORT NUT

H. G. FISCHER & CO.
2335 WABANSIA AVE.
CHICAGO, ILL.

CAT. NO.

PART NO. 13439

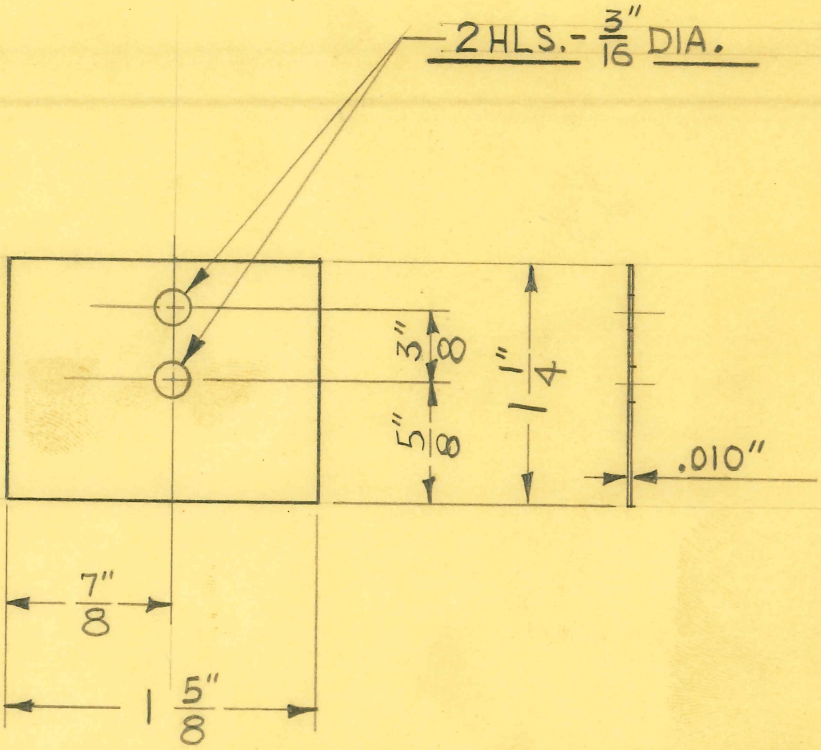

1 REQUIRED

SIZE	FROM 5026¾	ISSUE 4-28-42	J.V.W.
KIND		CHANGED	
SHAPE		"	
FINISH		"	
TEMP.		"	
PATT.		"	

TITLE:
FISCHER MOD. "RF-100" X-RAY UNIT
PREADJUSTMENT SWITCH INSULATING STRIP
-SMALL

H. G. FISCHER & CO.
2335 WABANSIA AVE.
CHICAGO, ILL.

CAT. NO.

PART NO. 13443 1/2

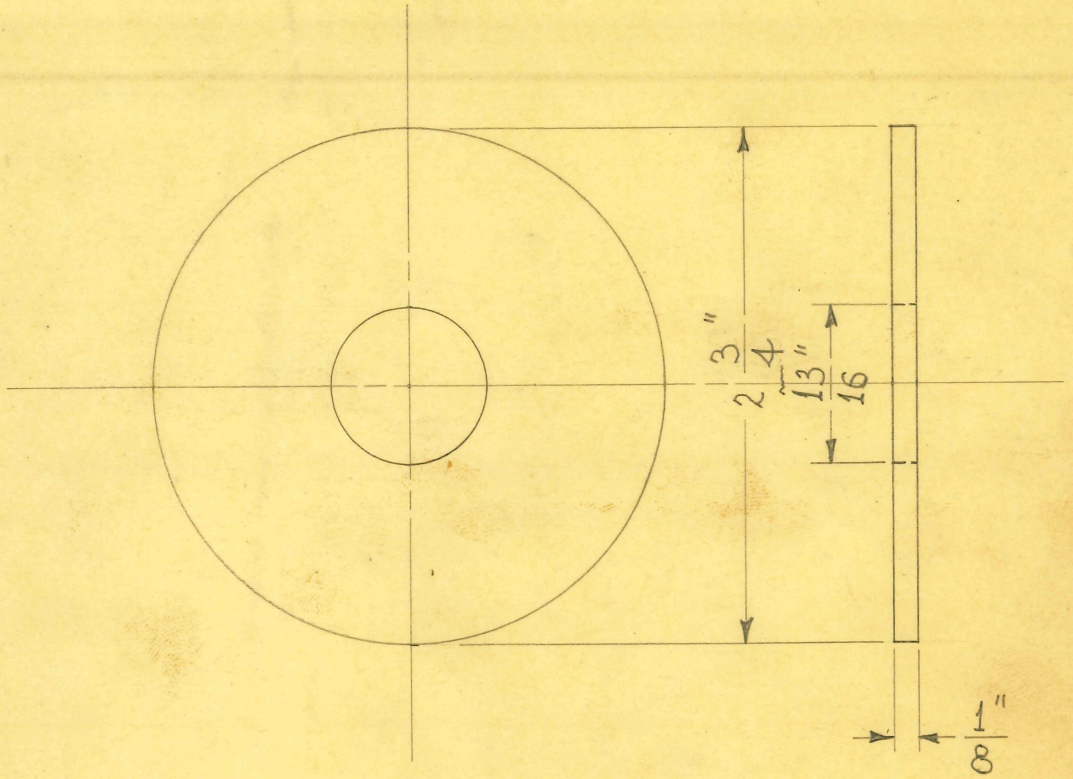

1 REQUIRED

FROM 13465

SIZE	1/8"	ISSUE 10-3-40	HE.
KIND	SHEET LEAD	CHANGED	
SHAPE		"	
FINISH		"	
TEMP.		"	
PATT.		"	

TITLE: TREATMENT CONE LEAD DIAPHRAGM SIZED TO EXPOSE A 1 1/2" DIAM. CIRCLE AT A 6" DISTANCE.

H. G. FISCHER & CO.
2338 WABANSIA AVE.
CHICAGO, ILL.

CAT. NO.

PART NO. 13459

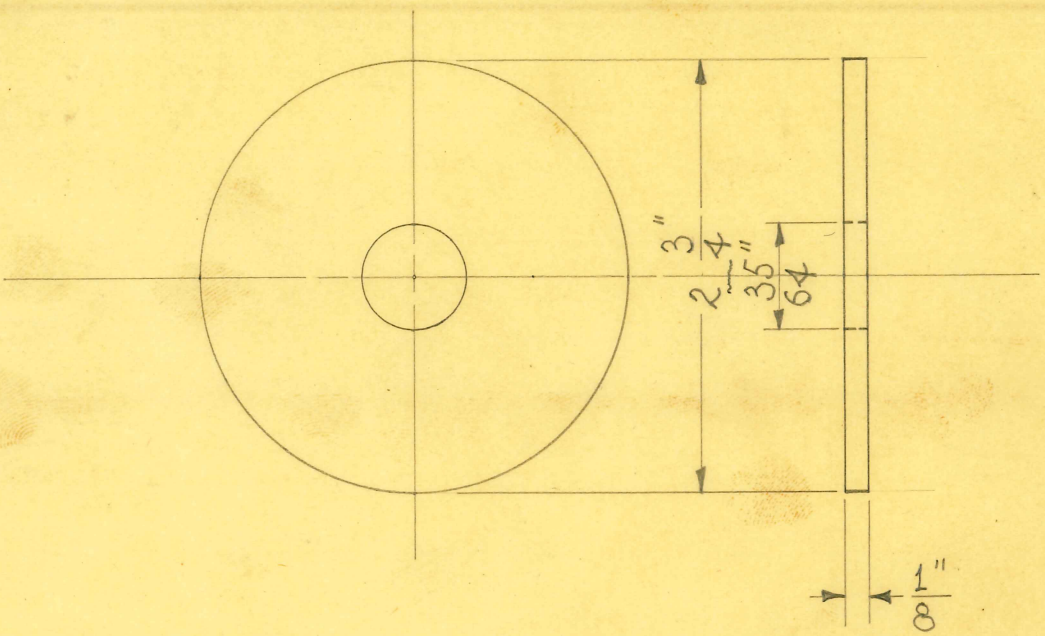

1 REQUIRED

FROM 13465

SIZE	1/8"	ISSUE 10-3-40	HE.
KIND	SHEET LEAD	CHANGED	
SHAPE		"	
FINISH		"	
TEMP.		"	
PATT.		"	

TITLE: TREATMENT CONE LEAD DIAPHRAGM SIZED TO EXPOSE A 1" DIAM. CIRCLE AT A 6" DISTANCE.

H. G. FISCHER & CO.
2338 WABANSIA AVE.
CHICAGO, ILL.

CAT. NO.

PART NO. 13463

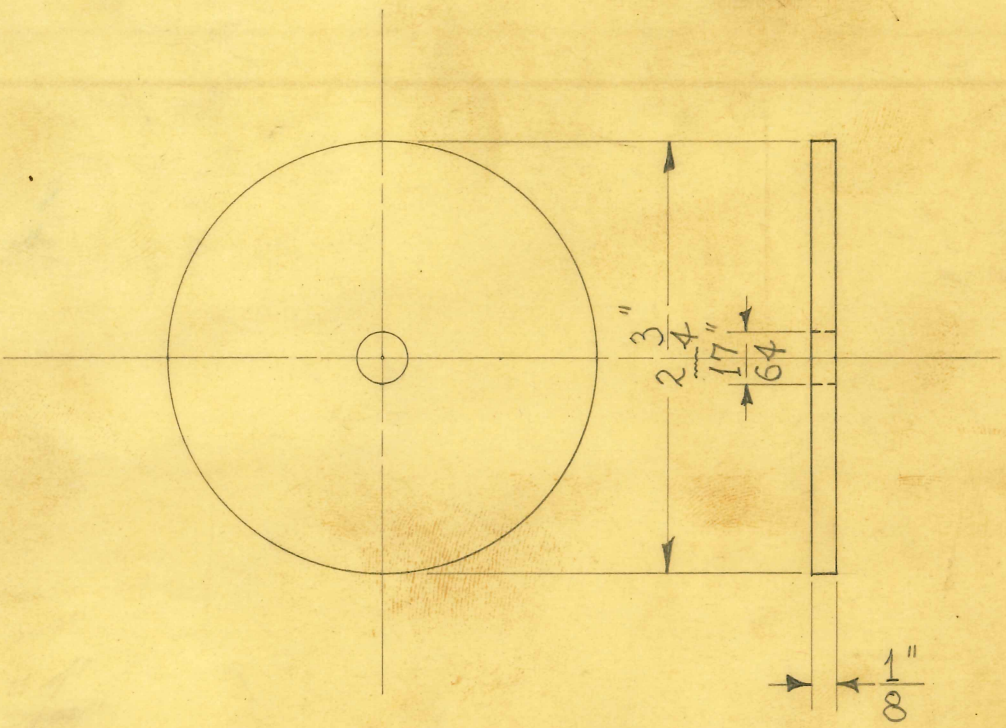

1 REQUIRED

BLANK & PIERCE DIE #7659 (BIN P-4)

SIZE	1/8"	ISSUE 10-3-40	HE.
KIND	SHEET LEAD	CHANGED	
SHAPE		"	
FINISH		"	
TEMP.		"	
PATT.		"	

TITLE: TREATMENT CONE LEAD DIAPHRAGM SIZED TO EXPOSE A $\frac{1}{2}$" DIAMETER CIRCLE AT 6" DISTANCE

H. G. FISCHER & CO.
2338 WABANSIA AVE.
CHICAGO, ILL.

CAT. NO.

PART NO. 13465

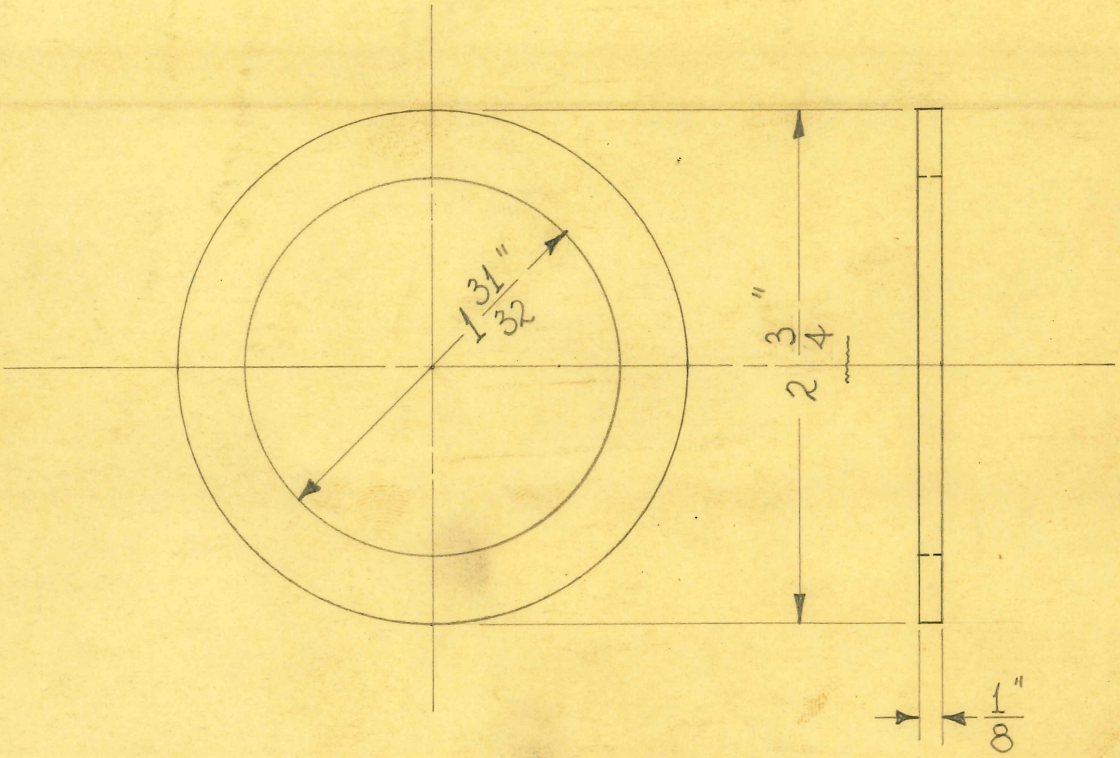

1 REQUIRED
FROM 13465

SIZE	1/8"	ISSUE 10-2-40	HE
KIND	SHEET LEAD	CHANGED	
SHAPE		"	
FINISH		"	
TEMP.		"	
PATT.		"	

TITLE: X-RAY CONE LEAD DIAPHRAGM SIZED TO EXPOSE A 18" DIAM. CIRCLE AT 30" DISTANCE

H. G. FISCHER & CO.
2335 WABANSIA AVE.
CHICAGO, ILL.

CAT. NO.

PART NO. 13468

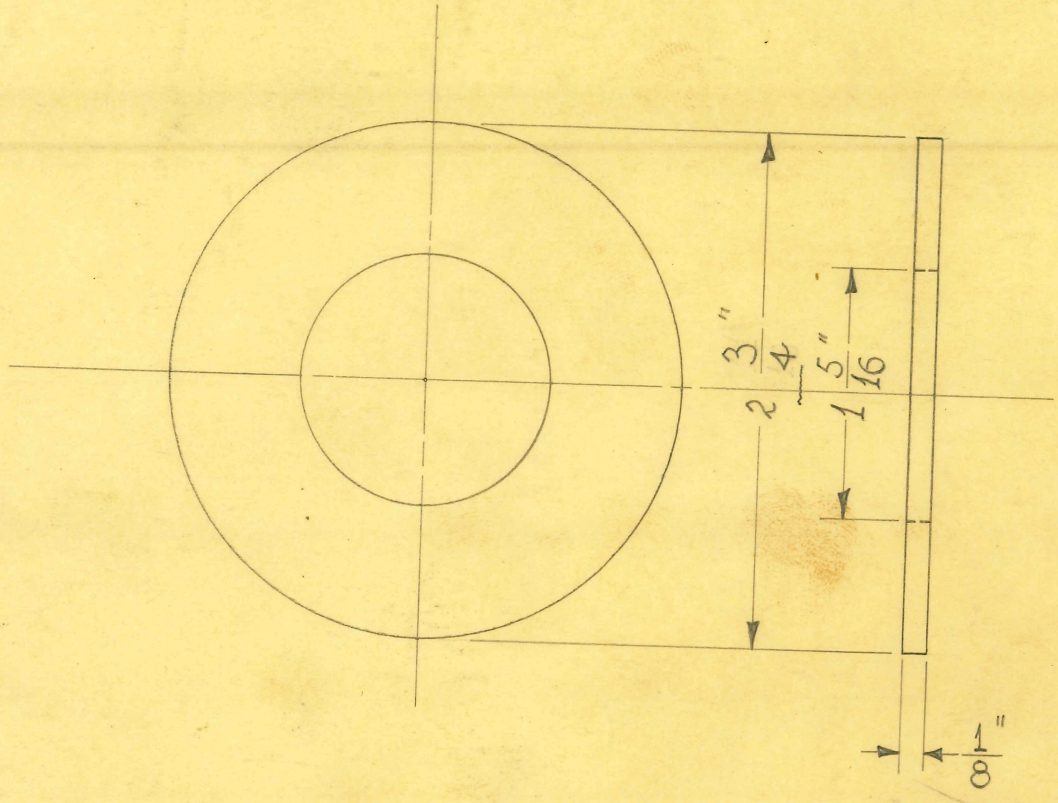

1 REQUIRED
FROM 13465

SIZE	1/8"	ISSUE 10-2-40	HE.
KIND	SHEET LEAD	CHANGED	
SHAPE		"	
FINISH		"	
TEMP.		"	
PATT.		"	

TITLE: X-RAY CONE LEAD DIAPHRAGM SIZED TO EXPOSE A 12" DIAM. CIRCLE AT 30" DISTANCE.

H. G. FISCHER & CO.
2335 WABANSIA AVE.
CHICAGO, ILL.

CAT. NO.

PART NO. 13472

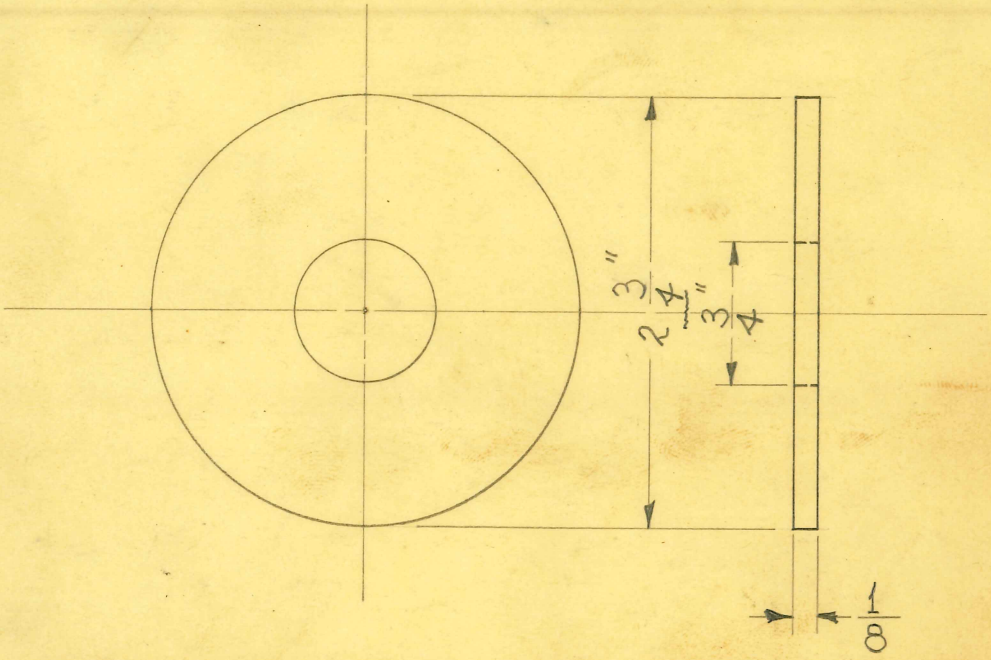

1 REQUIRED

FROM 13465

SIZE	1/8"	ISSUE 10-1-40	HE
KIND	SHEET LEAD	CHANGED	
SHAPE		"	
FINISH		"	
TEMP.		"	
PATT.		"	

TITLE: X-RAY CONE LEAD DIAPHRAGM SIZED TO EXPOSE A 7" DIAM. CIRCLE AT 30" DISTANCE

H. G. FISCHER & CO.
2335 WABANSIA AVE.
CHICAGO, ILL.

CAT. NO.

PART NO. 13474

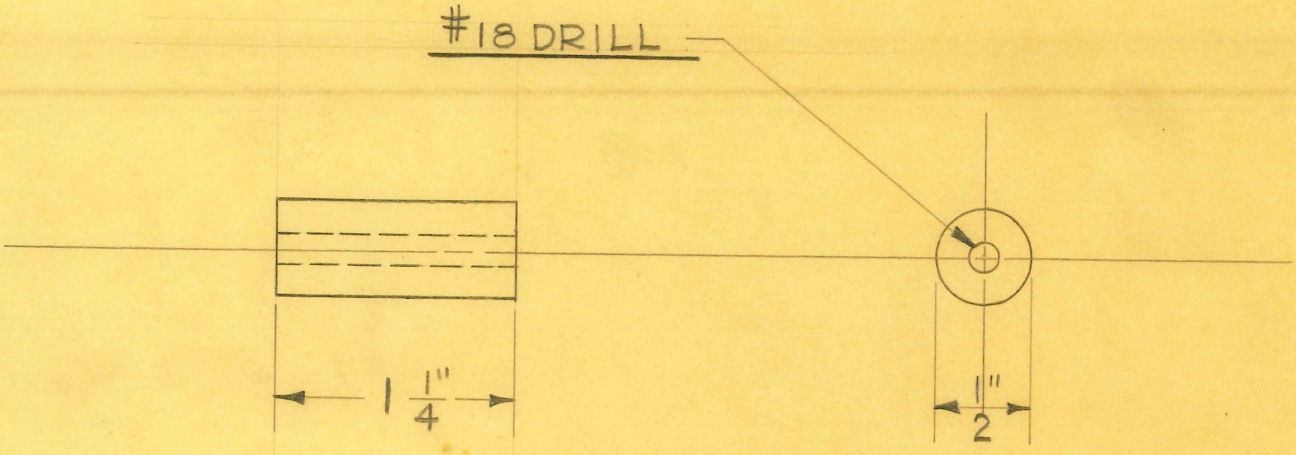

8 REQUIRED

SIZE	1/2" DIA.	ISSUE 2-27-41	J.V.W.
KIND	BAKELITE	CHANGED	
SHAPE	ROD	"	
FINISH		"	
TEMP.		"	
PATT.		"	

TITLE:
3 PHASE STEPDOWN TRANSFORMER
MALGHAM BROS.— TERMINAL BOARD SPACER

H. G. FISCHER & CO.
2335 WABANSIA AVE.
CHICAGO, ILL.

CAT. NO.

PART NO. 13538

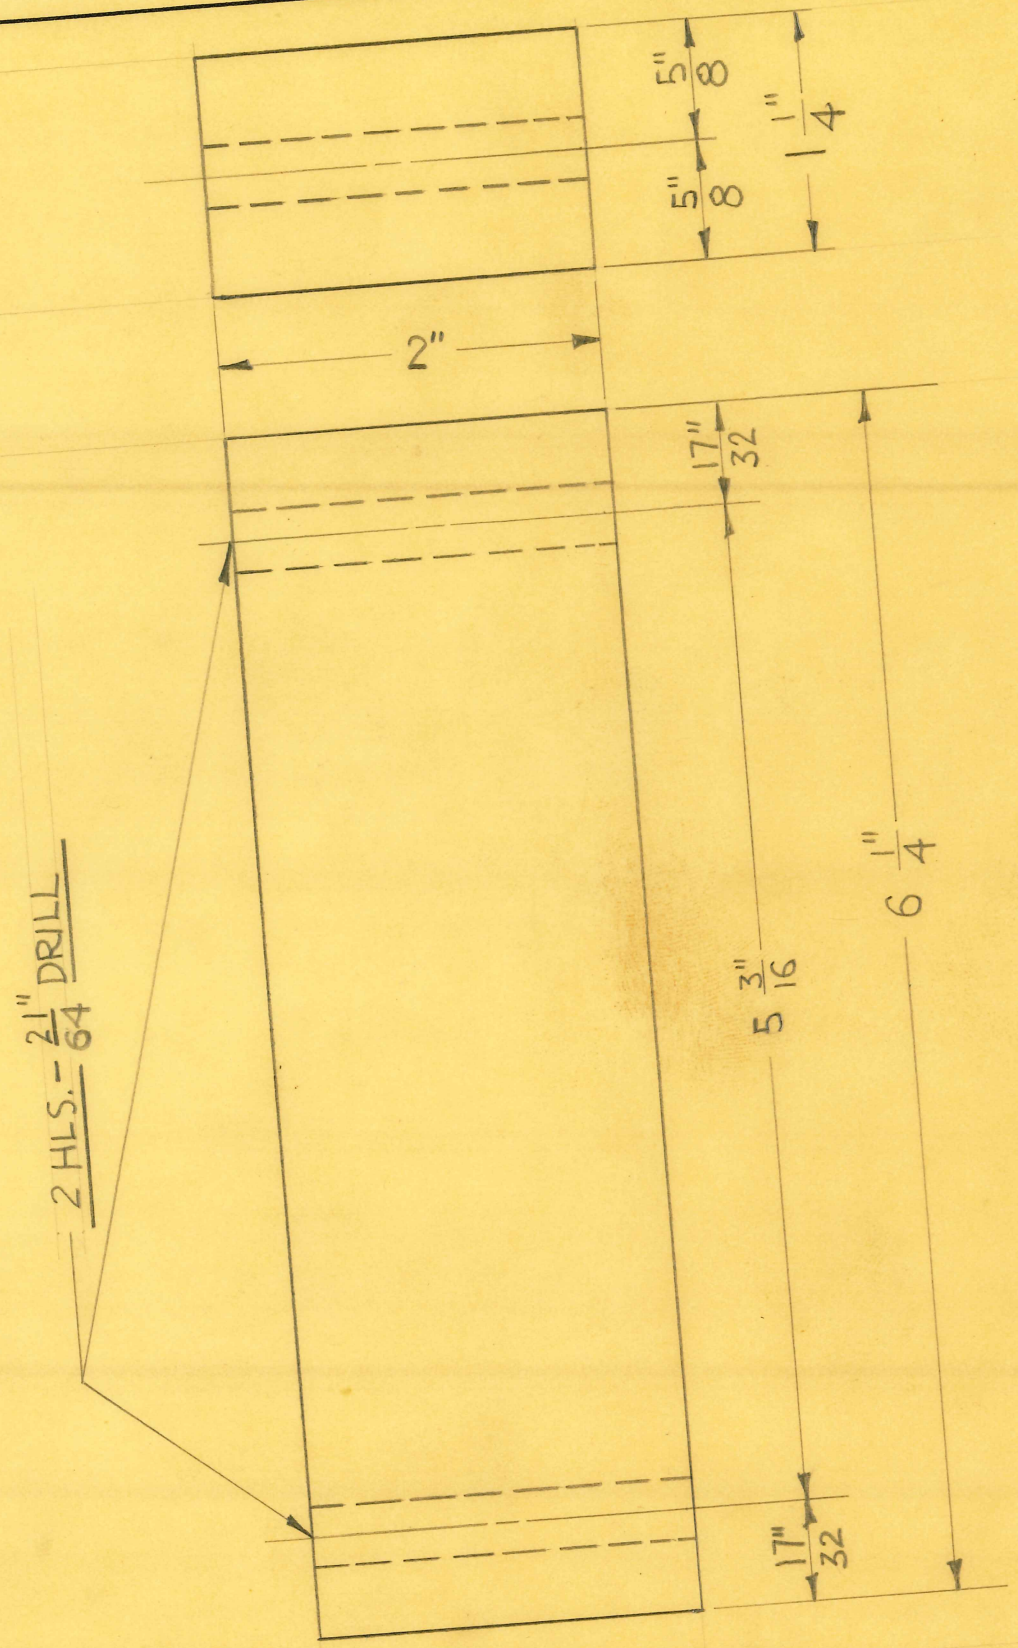

4 REQUIRED

SIZE		ISSUE 2-27-41	J.V.W.
KIND	OAK	CHANGED	
SHAPE		"	
FINISH	SHELLAC	"	
TEMP.		"	

TITLE: 3 PHASE STEPDOWN TRANSFORMER
MALGHAM BROS.- TRANSF. SUPPORT BLOCK

H. G. FISCHER & CO.
2335 WABANSIA AVE.
CHICAGO, ILL.

CAT. NO.

PART NO. 13539

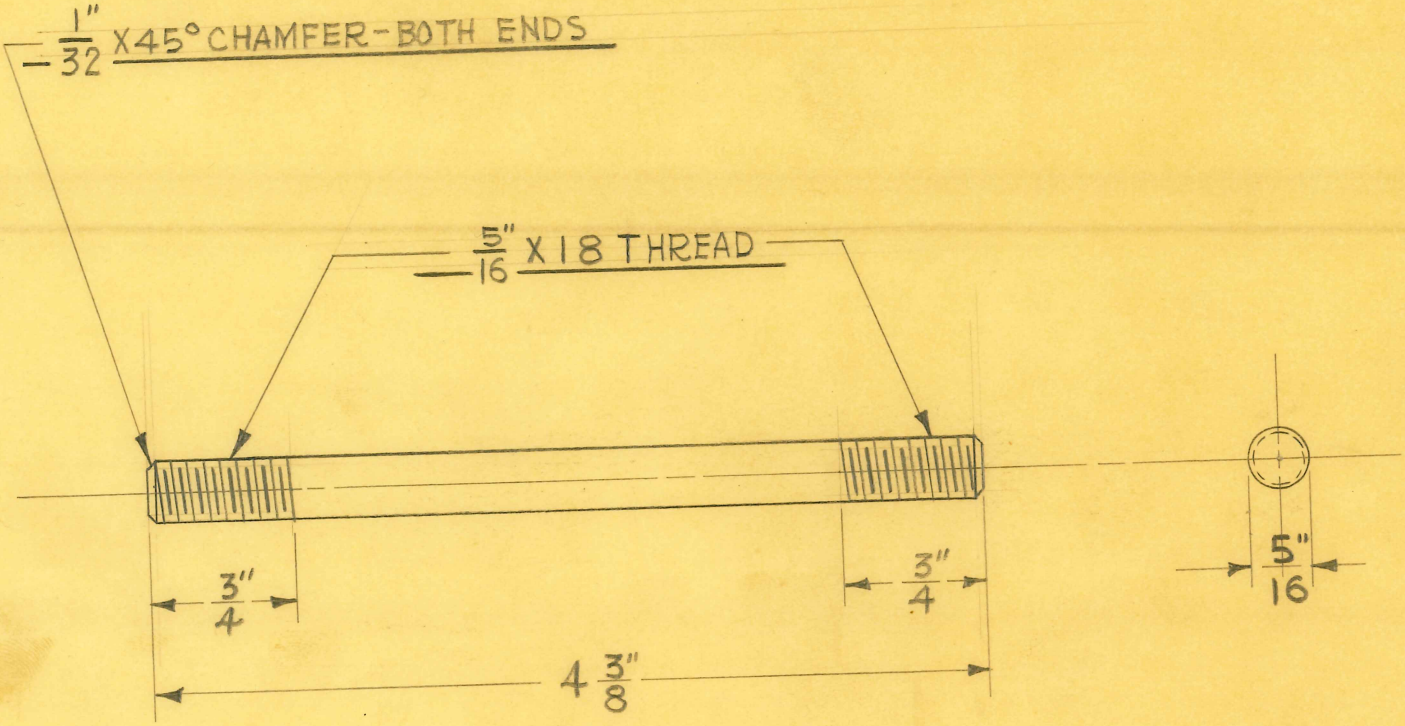

8 REQUIRED

SIZE	5/16" DIA.	ISSUE 2-28-41	J.V.W.
KIND	C.R. STEEL	CHANGED	
SHAPE		"	
FINISH		"	
TEMP.		"	
PATT.		"	

TITLE:
3 PHASE STEPDOWN TRANSFORMER
MALGHAM BROS. - TRANSF. SUPP. STUD

H. G. FISCHER & CO.
2335 WABANSIA AVE.
CHICAGO, ILL.

CAT. NO.

PART NO. 13541

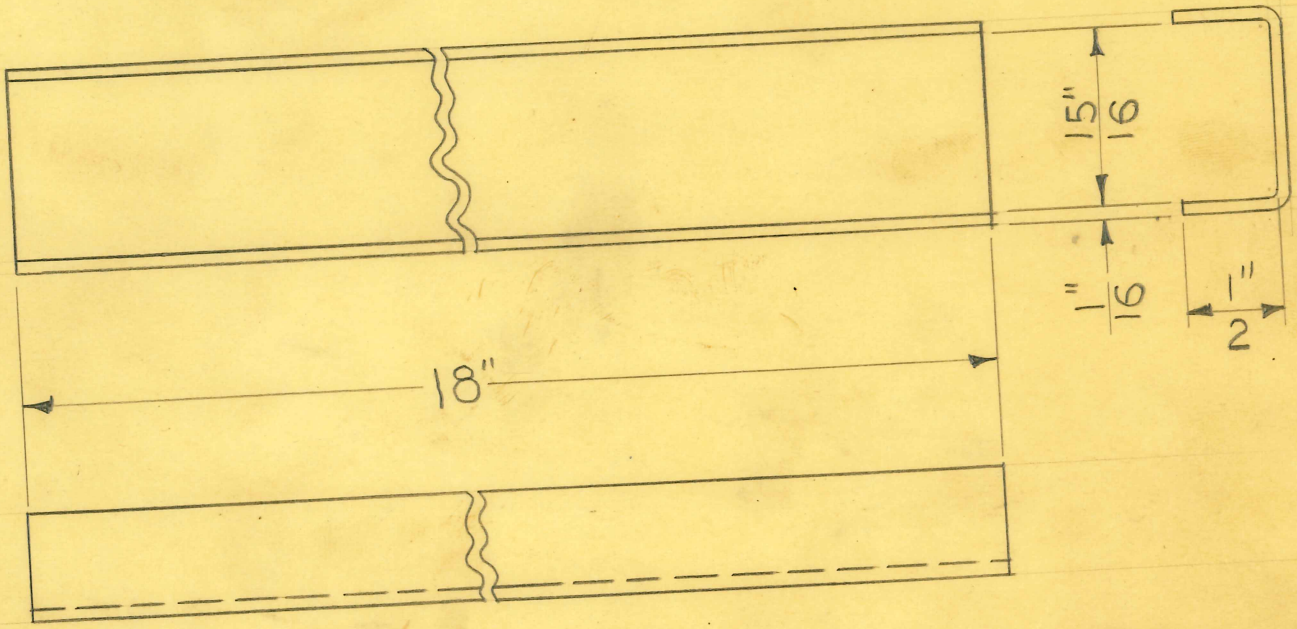

2 REQUIRED

SIZE	1/16" SHEET	ISSUE 9-26-41	J.V.W.
KIND	C.R. STEEL	CHANGED	
SHAPE		"	
FINISH		"	
TEMP.		"	
PATT.		"	

TITLE: WALL MODEL CASSETTE & GRID HOLDER CHANNEL - BLANK

H. G. FISCHER & CO.
2335 WABANSIA AVE.
CHICAGO, ILL.

CAT. NO.

PART NO. 13553

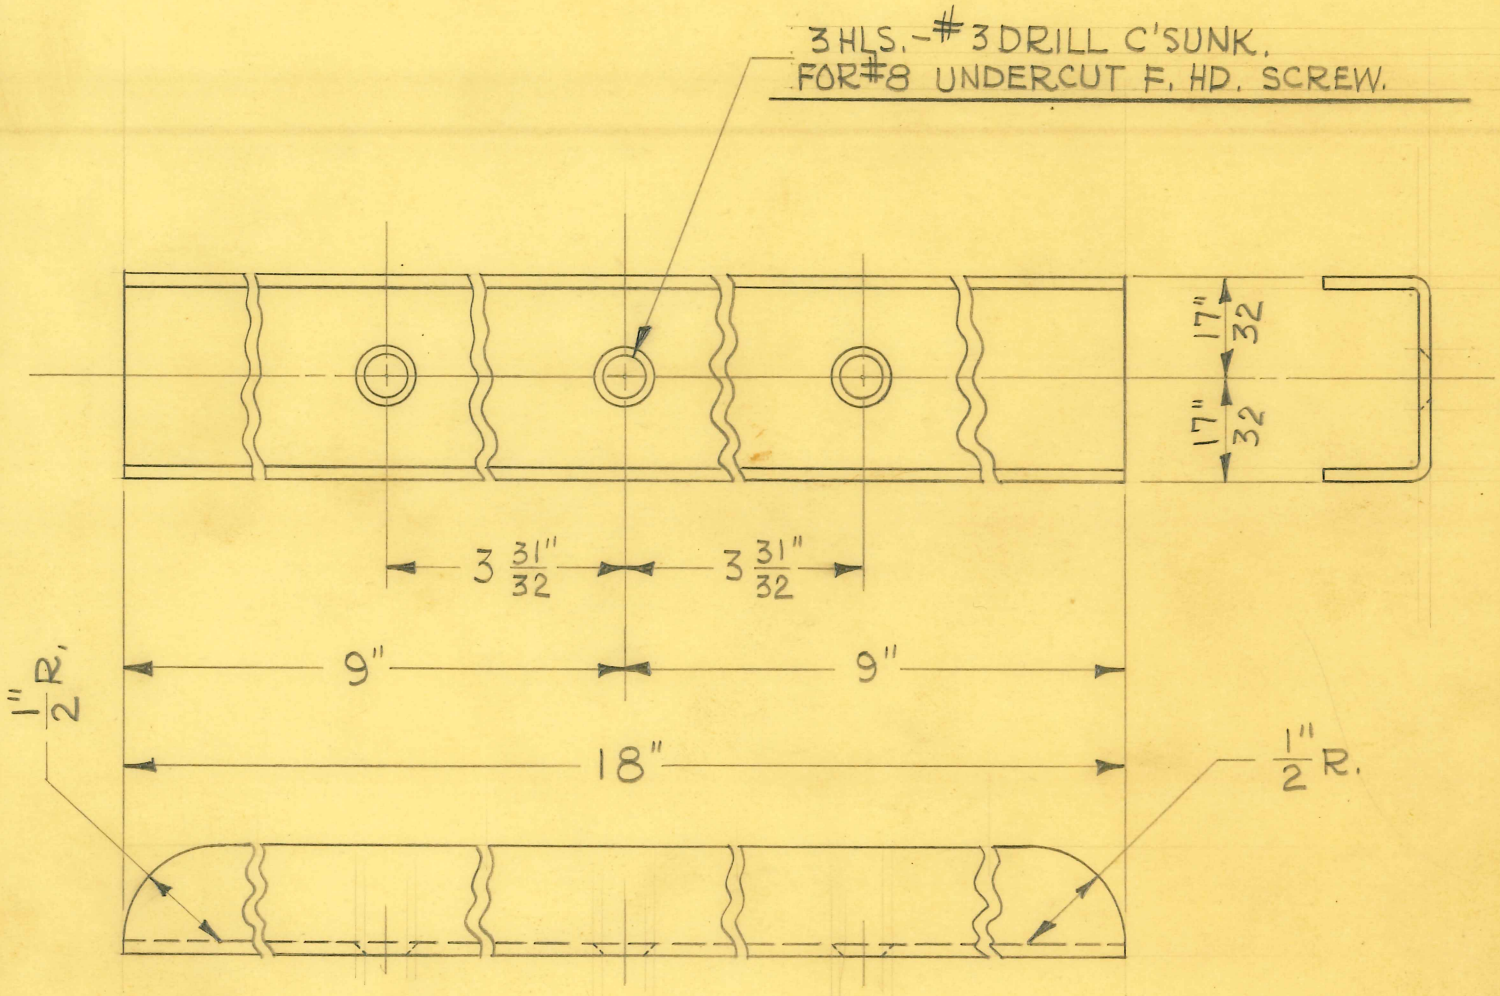

2 REQUIRED

SIZE	FROM #13553	ISSUE 10-14-41	J.V.W.
KIND		CHANGED	
SHAPE		"	
FINISH	WH. CHR. #3	"	
TEMP.		"	
PATT.		"	

TITLE: WALL MODEL CASSETTE & GRID HOLDER CHANNEL

H. G. FISCHER & CO.
2335 WABANSIA AVE.
CHICAGO, ILL.

CAT. NO.

PART NO. 13553F

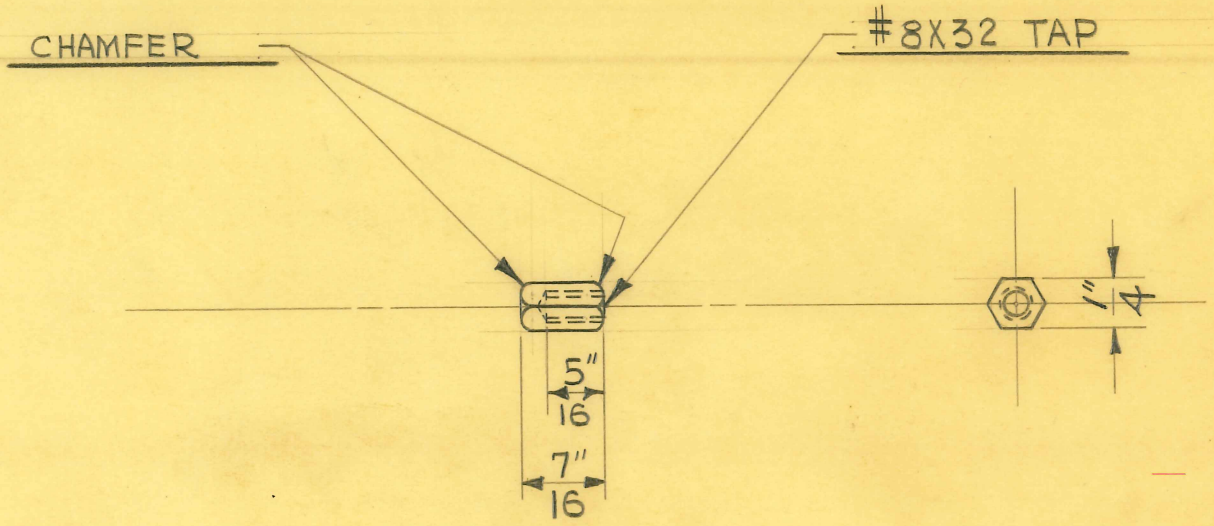

2 REQUIRED

SIZE	1/4" HEX.	ISSUE 12-2-41	J.Y.W.	**TITLE:** WALL MODEL CASSETTE & GRID HOLDER CASSETTE COVER RETAINING SPACER
KIND	C.R. STEEL	CHANGED		
SHAPE		"		
FINISH	WH. CHR. #3	"		
TEMP.		"		
PATT.		"		

H. G. FISCHER & CO.
2335 WABANSIA AVE.
CHICAGO, ILL.

CAT. NO.

PART NO. 13554

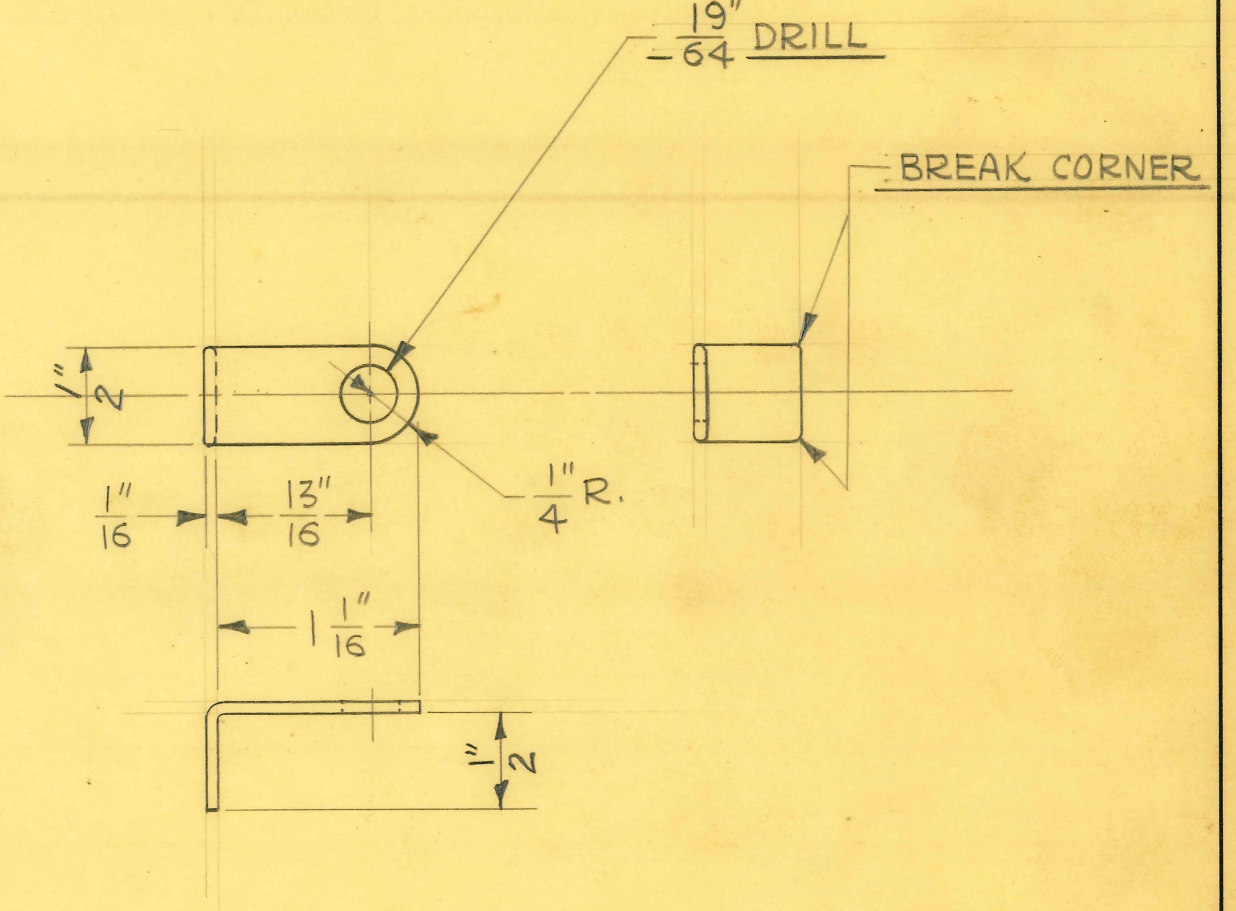

2 REQUIRED

DEVELOPED LENGTH = 1 19/32"

SIZE	1/16" X 1/2"	ISSUE 12-2-41	J.V.W.
KIND	FLAT WIRE	CHANGED	
SHAPE		"	
FINISH		"	
TEMP.		"	
PATT.		"	

TITLE: WALL MODEL CASSETTE & GRID HOLDER
CASSETTE COVER BRACKET

H. G. FISCHER & CO.
2335 WABANSIA AVE.
CHICAGO, ILL.

CAT. NO.

PART NO. 13556

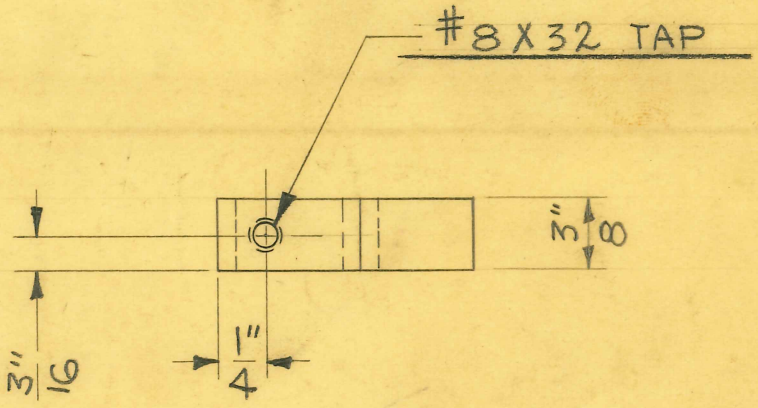

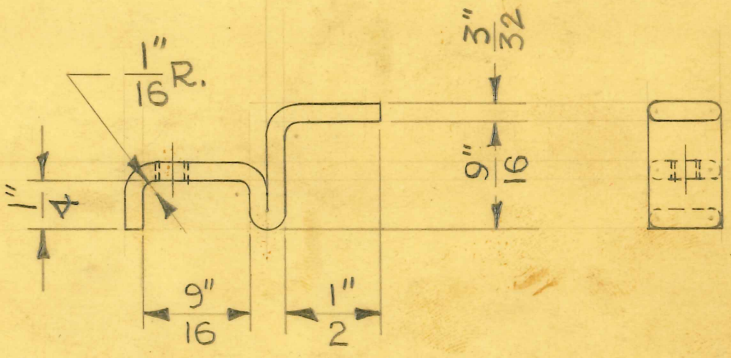

1ST OPER. FORM DIE # 8211 – BIN Q-3
2ND OPER. FORM DIE # 8212 – BIN Q-3
DRILL JIG # 8321

4 REQUIRED

DEVELOPED LENGTH = 2 1/8"

SIZE	3/32" X 3/8"	ISSUE 6-8-42	J.V.W.
KIND	FLAT WIRE	CHANGED	
SHAPE		"	
FINISH		"	
TEMP.		"	
PATT.		"	

TITLE: FISCHER "AGA" S.P. DENTAL X-RAY TRANSF. TANK COVER MOUNTING BRKT.

H. G. FISCHER & CO.
2335 WABANSIA AVE.
CHICAGO, ILL.

CAT. NO.

PART NO. 13609

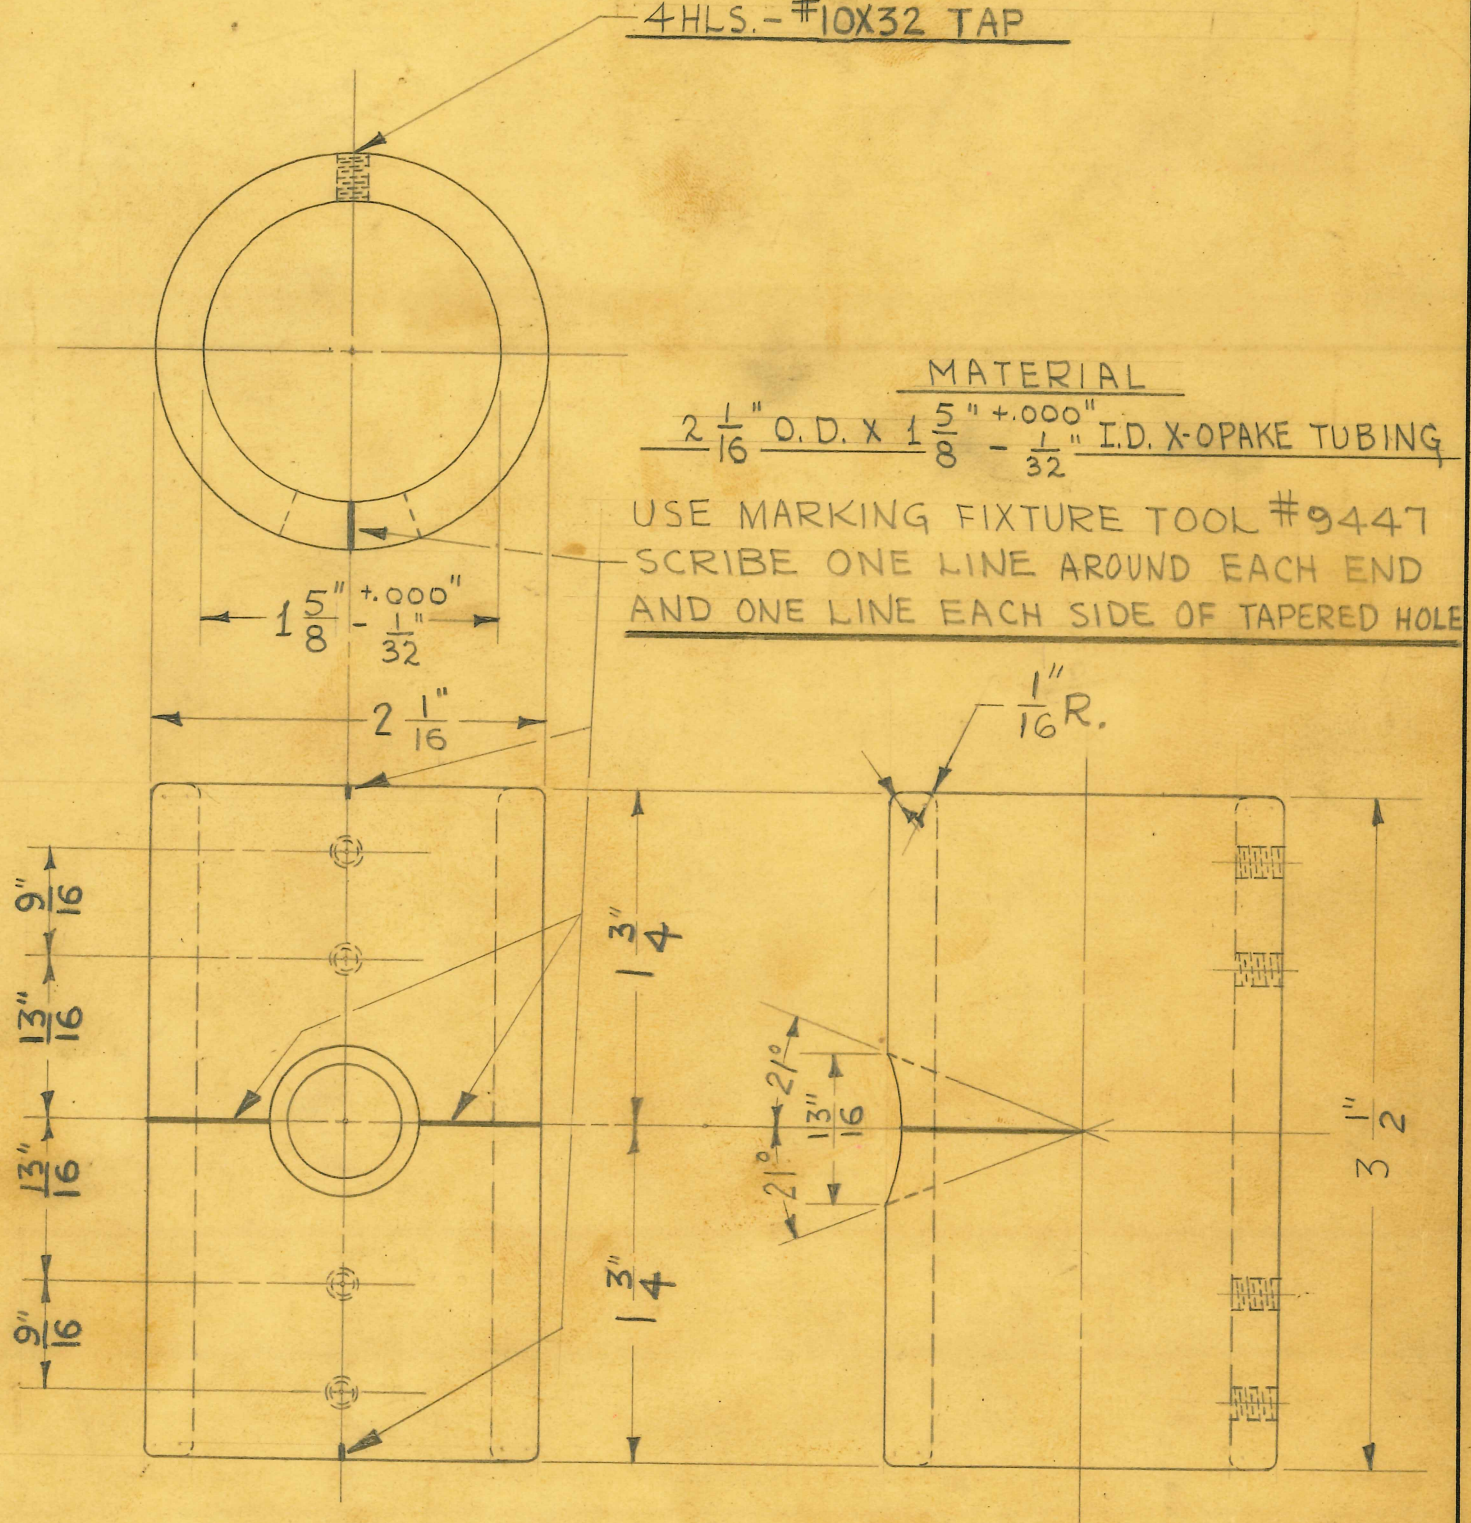

MATERIAL

2 1/16" O.D. X 1 5/8" +.000" - 1/32" I.D. X-OPAKE TUBING

USE MARKING FIXTURE TOOL #9447
SCRIBE ONE LINE AROUND EACH END
AND ONE LINE EACH SIDE OF TAPERED HOLE

1 REQUIRED

SIZE		ISSUE 5-27-41	J.V.W.
KIND	SEE NOTE	CHANGED 2-2-43	H.E.
SHAPE		"	
FINISH		"	
TEMP.		"	
PATT.		"	

TITLE:
U.S.A. SHOCKPROOF DENTAL X-RAY
X-RAY TUBE - SHIELD TUBE

H. G. FISCHER & CO.
2335 WABANSIA AVE.
CHICAGO, ILL.

CAT. NO.

PART NO. 13622B

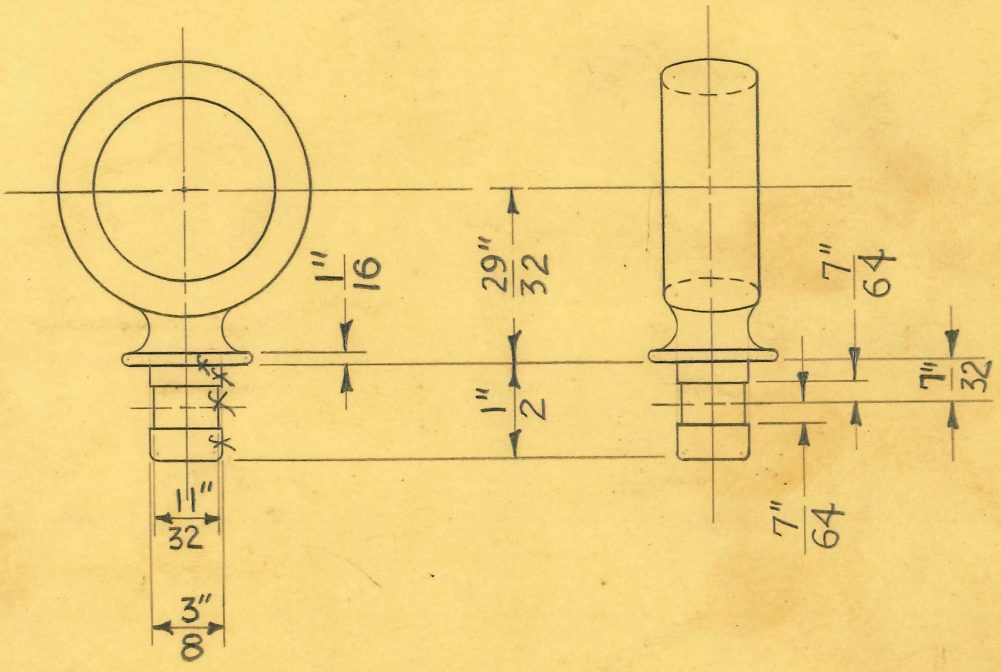

1 REQUIRED

SIZE	BRASS	ISSUE 3-11-42	J.V.W.
KIND	CASTING	CHANGED	
SHAPE		"	
FINISH	BLACK #49	"	
TEMP.		"	
PATT.	1884	"	

TITLE:
FISCHER MOD. "AGA" DENTAL X-RAY UNIT
TRANSF. SUPP. ARM-UPPER-CABLE GUIDE

H. G. FISCHER & CO.
2335 WABANSIA AVE.
CHICAGO, ILL.

CAT. NO.

PART NO. 13659BF

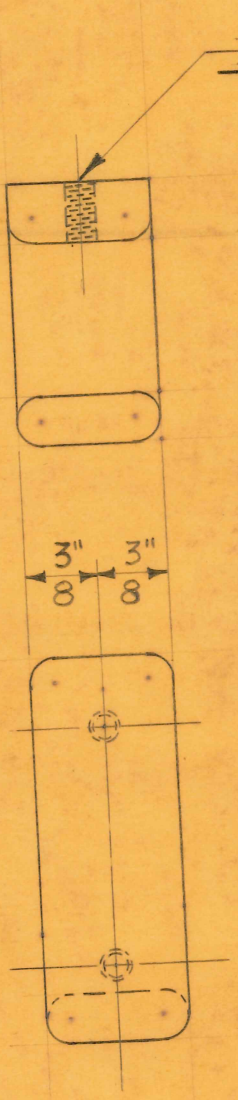

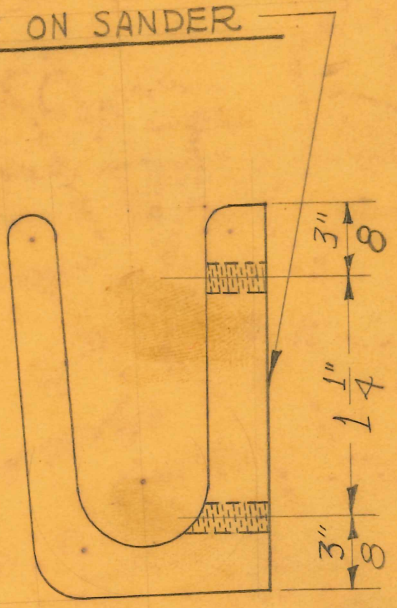

2 REQUIRED

SIZE	BRASS	ISSUE 1-22-41	J.V.W.
KIND	CASTING	CHANGED	
SHAPE		"	
FINISH	PAINTED	"	
TEMP.		"	

TITLE: ARMY. SHOCKPROOF DENTAL X-RAY UNIT
LINE CABLE SUPPORT BRACKET

H. G. FISCHER & CO.
2335 WABANSIA AVE.
CHICAGO, ILL.

CAT. NO.

PART NO. 13678F

NEW HAND PUNCH #8903 - HAND PUNCH BOX Y-5

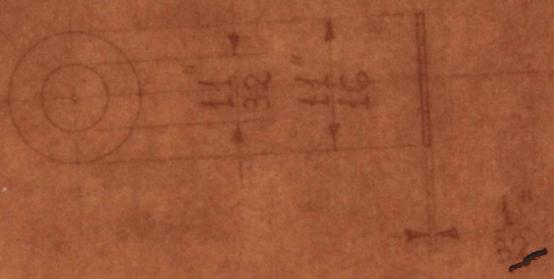

1 REQUIRED

1/32" SHEET NEOPRENE #2065 - #70 DUROMETER TEST

SIZE	6" x 6" SHEET	ISSUED 7-12-45	
KIND	NEOPRENE	CHANGED	
SHAPE		"	
FINISH		"	
TEMP.		"	
PART		"	

TITLE: U.S.A. SHOCKPROOF DENTAL X-RAY TRANSFORMER OIL PLUG GASKET

H. G. FISCHER & CO.
2338 WABANSIA AVE.
CHICAGO, ILL.

CAT. NO.

PART NO. 13721A

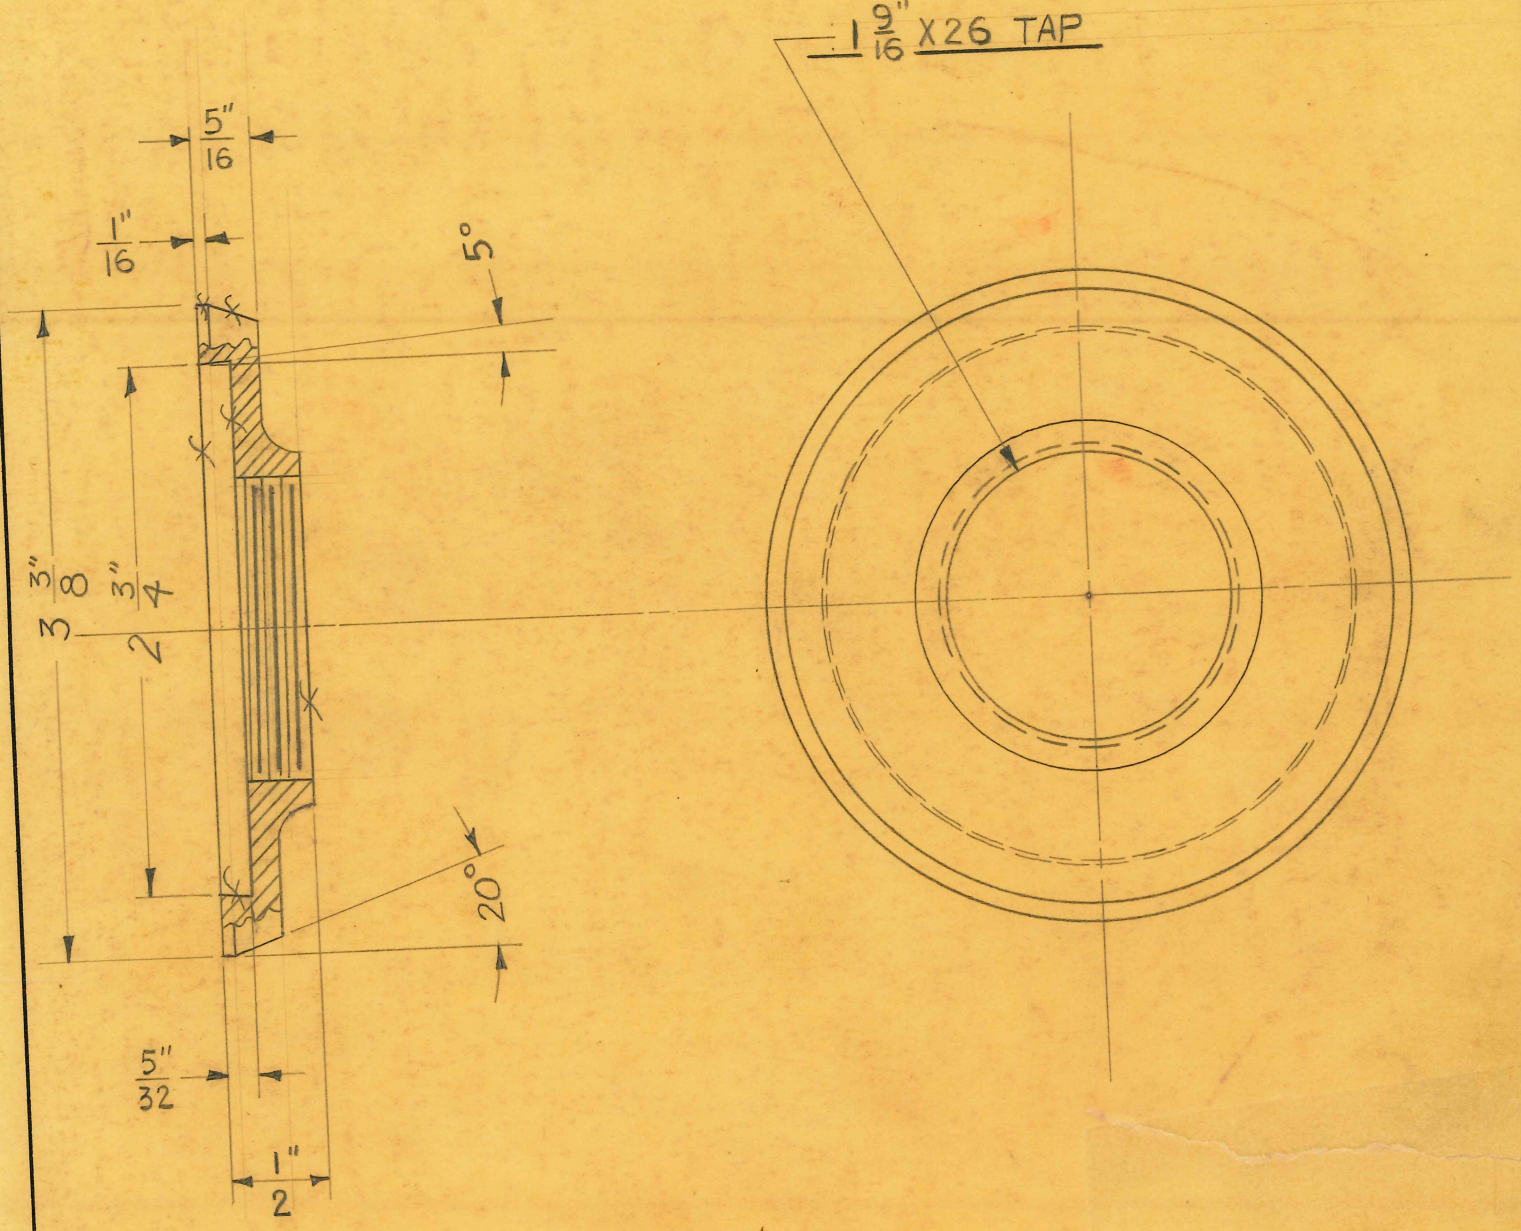

1 REQUIRED

ALL SURFACES MARKED WITH "f" TO BE CAD. PLATED.
REMAINING SURFACE TO BE PAINTED.

SIZE	IRON	ISSUE 5-12-41	J.Y.W.
KIND	CASTING	CHANGED	
SHAPE		"	
FINISH	SEE NOTE	"	
TEMP.		"	
PATT	1746	"	

TITLE: FISCHER "RF-100" X-RAY UNIT
DENTAL CONE BASE

H. G. FISCHER & CO.
2335 WABANSIA AVE.
CHICAGO, ILL.

CAT. NO.

PART NO. 13776F

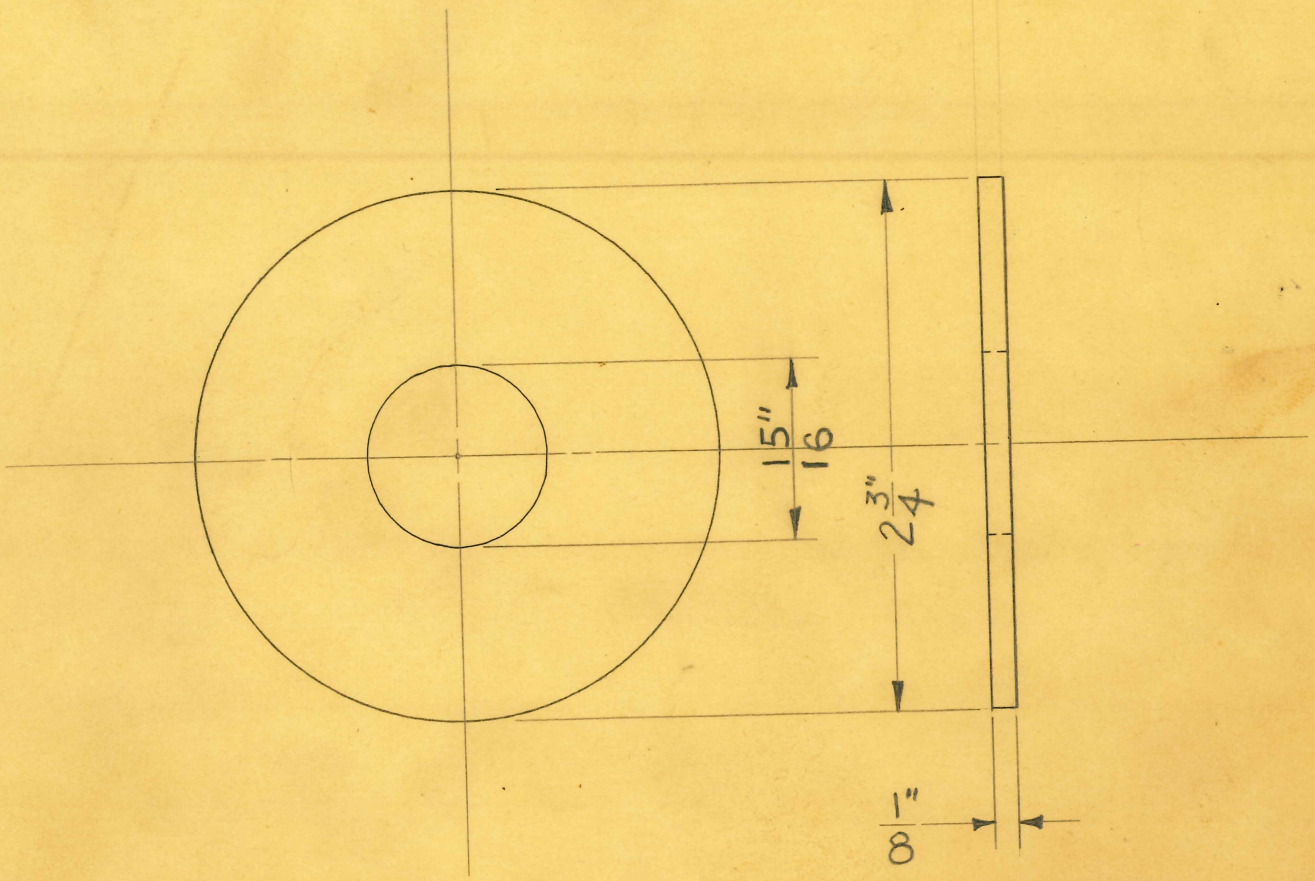

1 REQUIRED

SIZE	FROM 13465	ISSUE 5-12-41	J.V.W.
KIND		CHANGED	
SHAPE		"	
FINISH		"	
TEMP.		"	
PATT.		"	

TITLE:
FISCHER "RF-100" X-RAY UNIT
DENTAL CONE LEAD DIAPHRAGM

H. G. FISCHER & CO.
2335 WABANSIA AVE.
CHICAGO, ILL.

CAT. NO.

PART NO. 13778

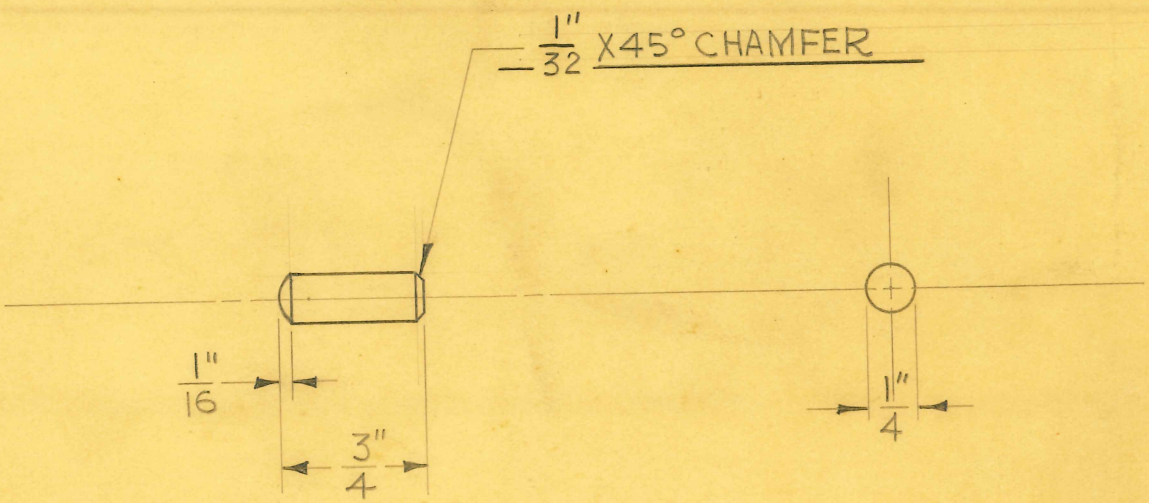

1 REQUIRED

SIZE	1/4" DIA.	ISSUE 6-2-41	J.V.W.
KIND	C.R. STEEL	CHANGED	
SHAPE		"	
FINISH		"	
TEMP.		"	
PATT.		"	

TITLE: FISCHER MOBILE MOD. DENTAL X-RAY SWIVEL ARM SUPPORT BEARING PIN

H. G. FISCHER & CO.
2335 WABANSIA AVE.
CHICAGO, ILL.

CAT. NO.

PART NO. 13803

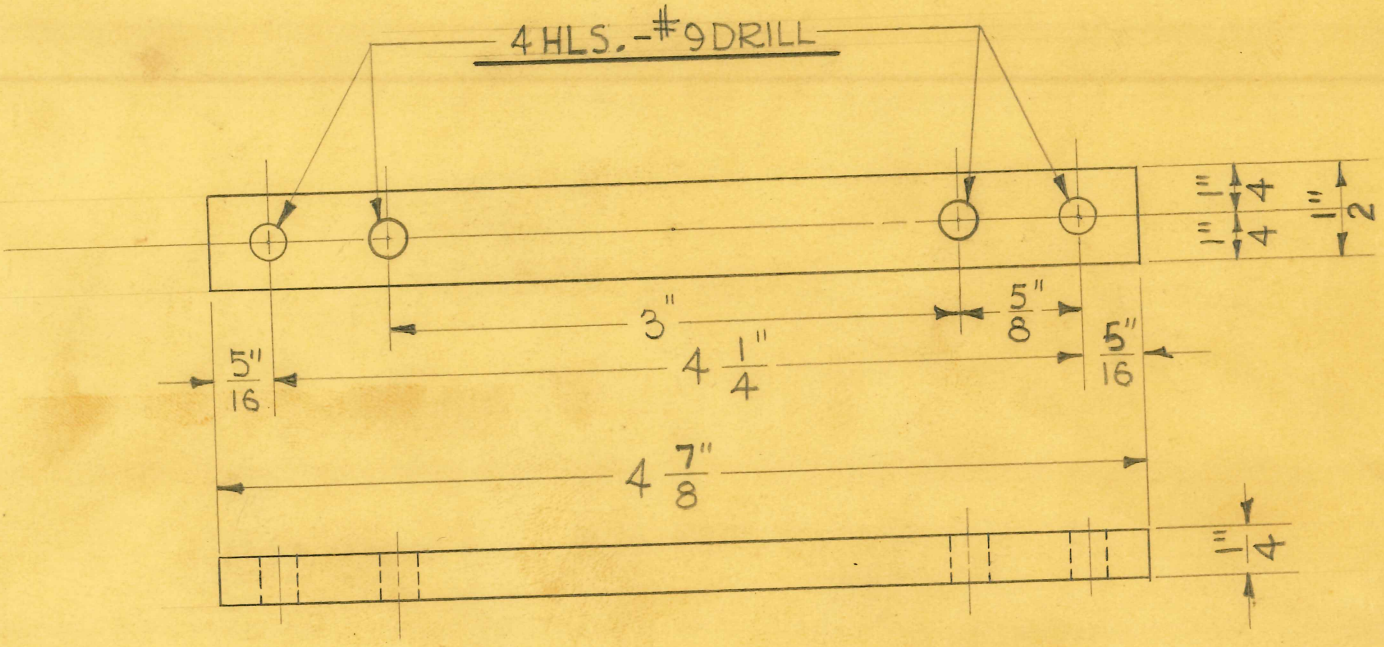

2 REQUIRED

SIZE	1/2" X 1/4"	ISSUE 4-9-41	J.V.W.	TITLE: FISCHER MOBILE DENTAL X-RAY UNIT AUTO. TRANSF. CLAMP
KIND	C.R.S. STEEL	CHANGED		
SHAPE	BAR	" 9-29-44	H.E.	
FINISH	BLACK #80	"		
TEMP.		"		
PATT.		"		

H. G. FISCHER & CO.
2335 WABANSIA AVE.
CHICAGO, ILL.

CAT. NO.

PART NO. 13822A

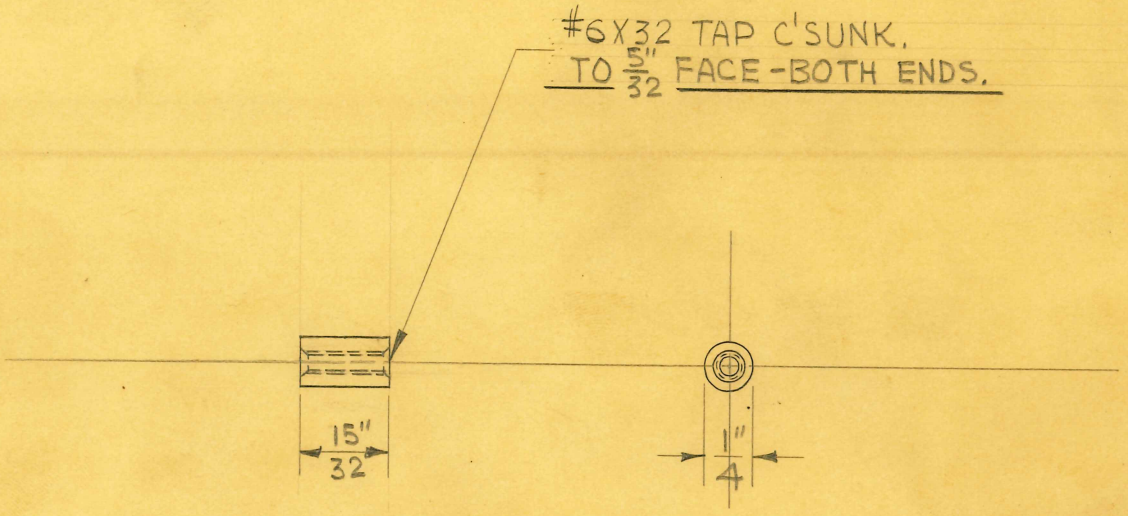

1 REQUIRED

SIZE	1/4" DIA.	ISSUE 4-10-41	J.V.W.
KIND	BRASS ROD	CHANGED	
SHAPE		"	
FINISH		"	
TEMP.		"	
PATT.		"	

TITLE: FISCHER MOBILE DENTAL X-RAY UNIT
CONTROL BOX RHEOSTAT ALIGNING PIN

H. G. FISCHER & CO.
2335 WABANSIA AVE.
CHICAGO, ILL.

CAT. NO.

PART NO. 13829

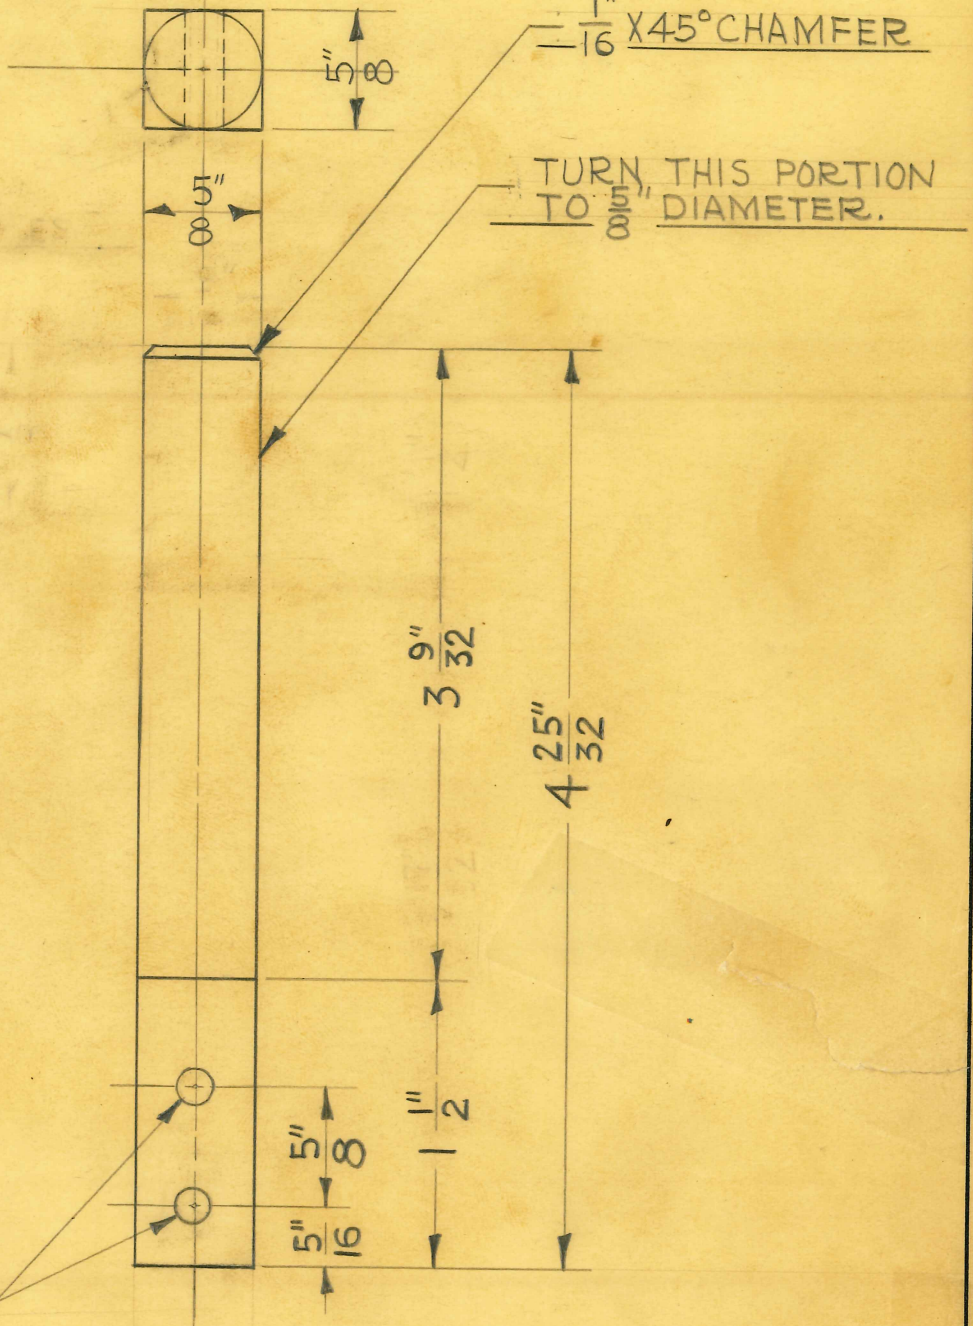

1 REQUIRED

CHROME #2 POLISH 5/8" SQUARE AND 1" OF 5/8" ROUND

SIZE	5/8" SQUARE	ISSUE 10-9-41	J.V.W.
KIND	C.R. STEEL	CHANGED	
SHAPE		"	
FINISH	~~DULITE #8~~	"	
TEMP.		"	
PATT.		"	

TITLE:
FISCHER WALL MODEL DENTAL X-RAY
WALL FASTENING TIE ROD

H. G. FISCHER & CO.
2335 WABANSIA AVE.
CHICAGO, ILL.

CAT. NO.

PART NO. 13838

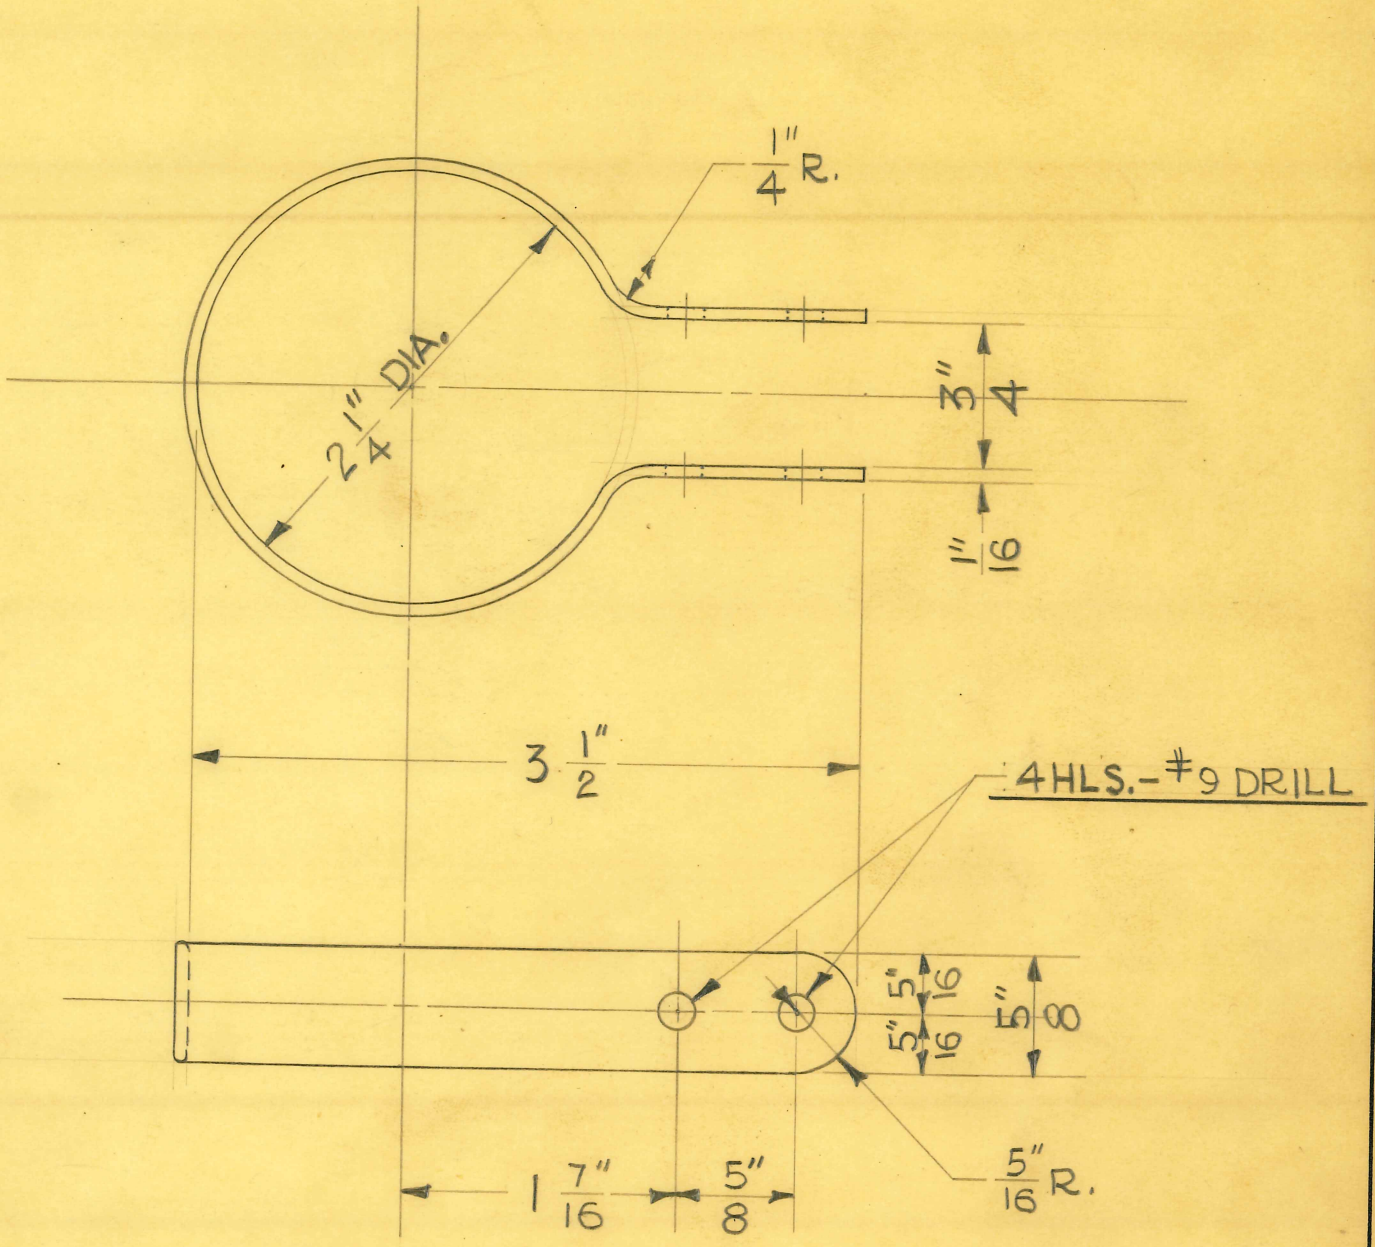

DEVELOPED LENGTH = 9"

CHROME #2 POLISH
OUTSIDE & EDGES

1 REQUIRED

SIZE	1/16" X 5/8"	ISSUE 10-23-41	J.V.W.
KIND	FLAT WIRE	CHANGED	
SHAPE		"	
FINISH	~~DU-LITE #8~~	"	
TEMP.		"	
PATT.		"	

TITLE: FISCHER WALL MODEL DENTAL X-RAY WALL FASTENING STRAP

H. G. FISCHER & CO.
2338 WABANSIA AVE.
CHICAGO, ILL.

CAT. NO.

PART NO. 13839

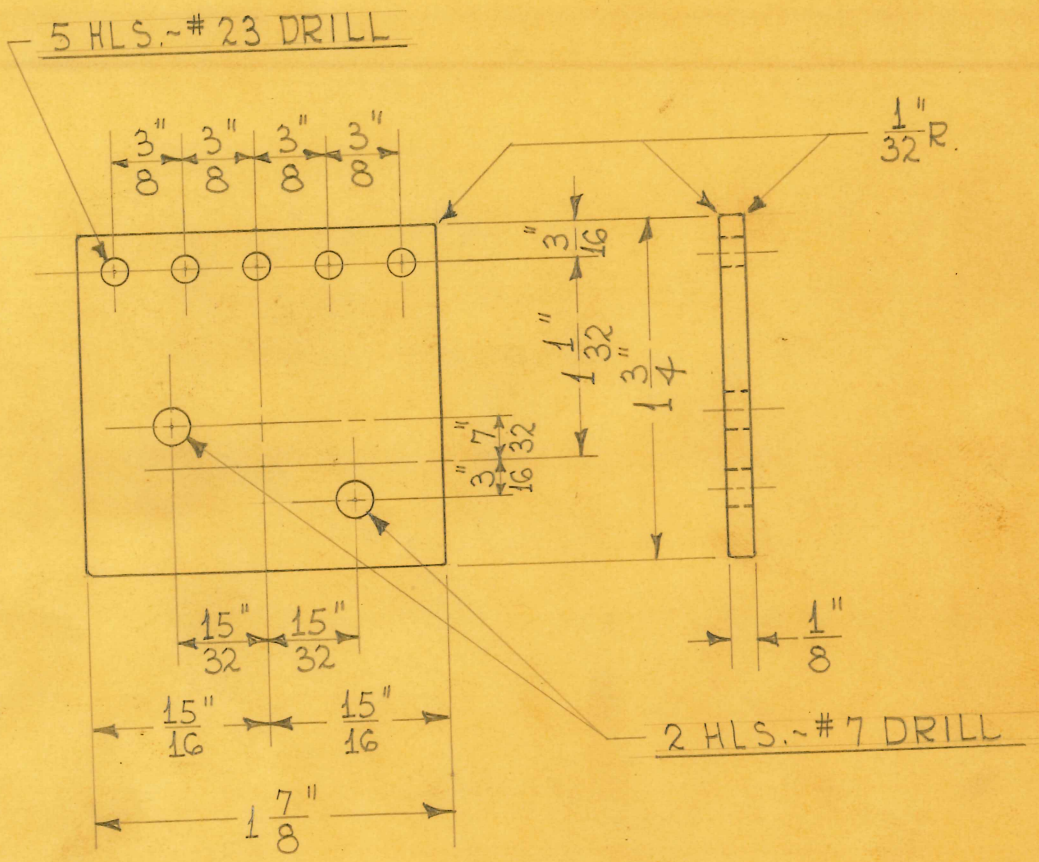

2 REQUIRED

SIZE	1/8" X 1 7/8"	ISSUE 8-1-44	FE.
KIND	SHEARED	CHANGED	
SHAPE	C.R. STEEL	"	
FINISH	CAD. #23	"	
TEMP.		"	
PATT.		"	

TITLE: WALL MODEL DENTAL X-RAY UNIT ~ TRANSFORMER MOUNTING PLATE

H. G. FISCHER & CO.
2335 WABANSIA AVE.
CHICAGO. ILL.

CAT. NO.

PART NO. 13842A

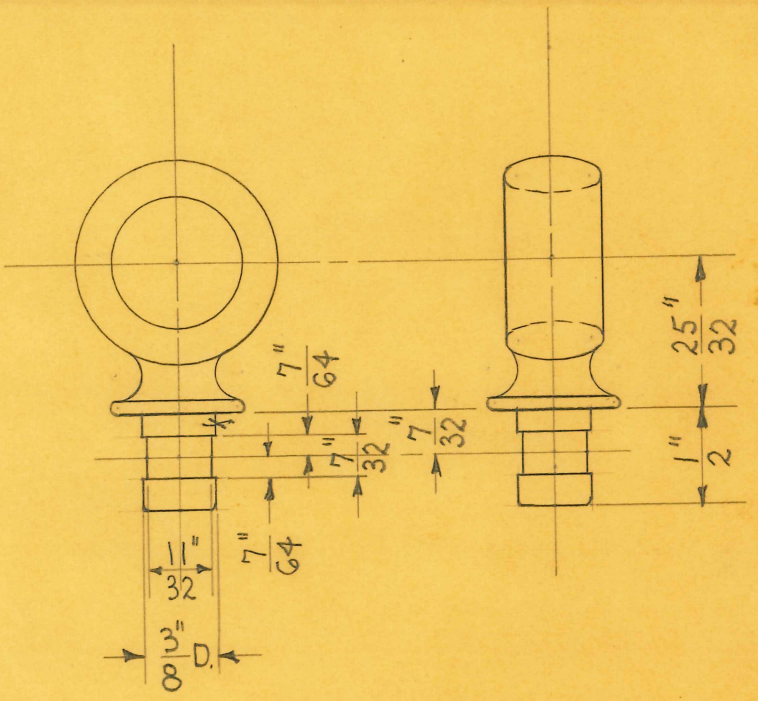

1 REQUIRED

SIZE	#12	ISSUE 4-3-44	HE.
KIND	ALUM. CASTING	CHANGED	
SHAPE		"	
FINISH	PAINTED	"	
TEMP.		"	
PATT.	1676	"	

TITLE: FISCHER MOD. "CMDX" DENTAL X-RAY UNIT~ TRANSF. SUPP. ARM-UPPER- CABLE GUIDE

H. G. FISCHER & CO.
2335 WABANSIA AVE.
CHICAGO, ILL.

CAT. NO.

PART NO. 13844F

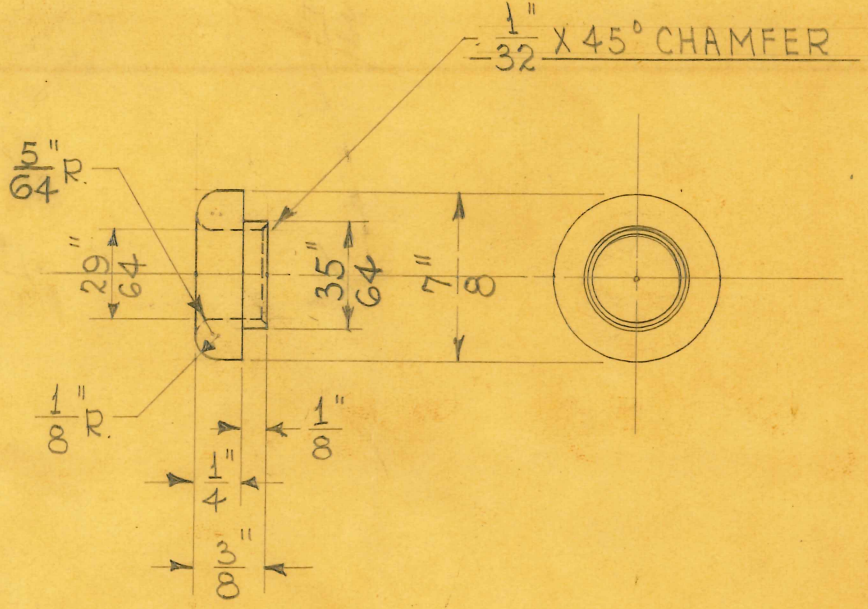

2 REQUIRED

SIZE	7/8" DIA.	ISSUE 6-14-44	HE.
KIND	C.R. STEEL	CHANGED	
SHAPE	ROD	"	
FINISH		"	
TEMP.		"	
PATT.		"	

TITLE: FISCHER MOBILE DENTAL X-RAY UNIT-
LINE & TIMER CORD BUSHING

H. G. FISCHER & CO.
2335 WABANSIA AVE.
CHICAGO. ILL.

CAT. NO.

PART NO. 13845

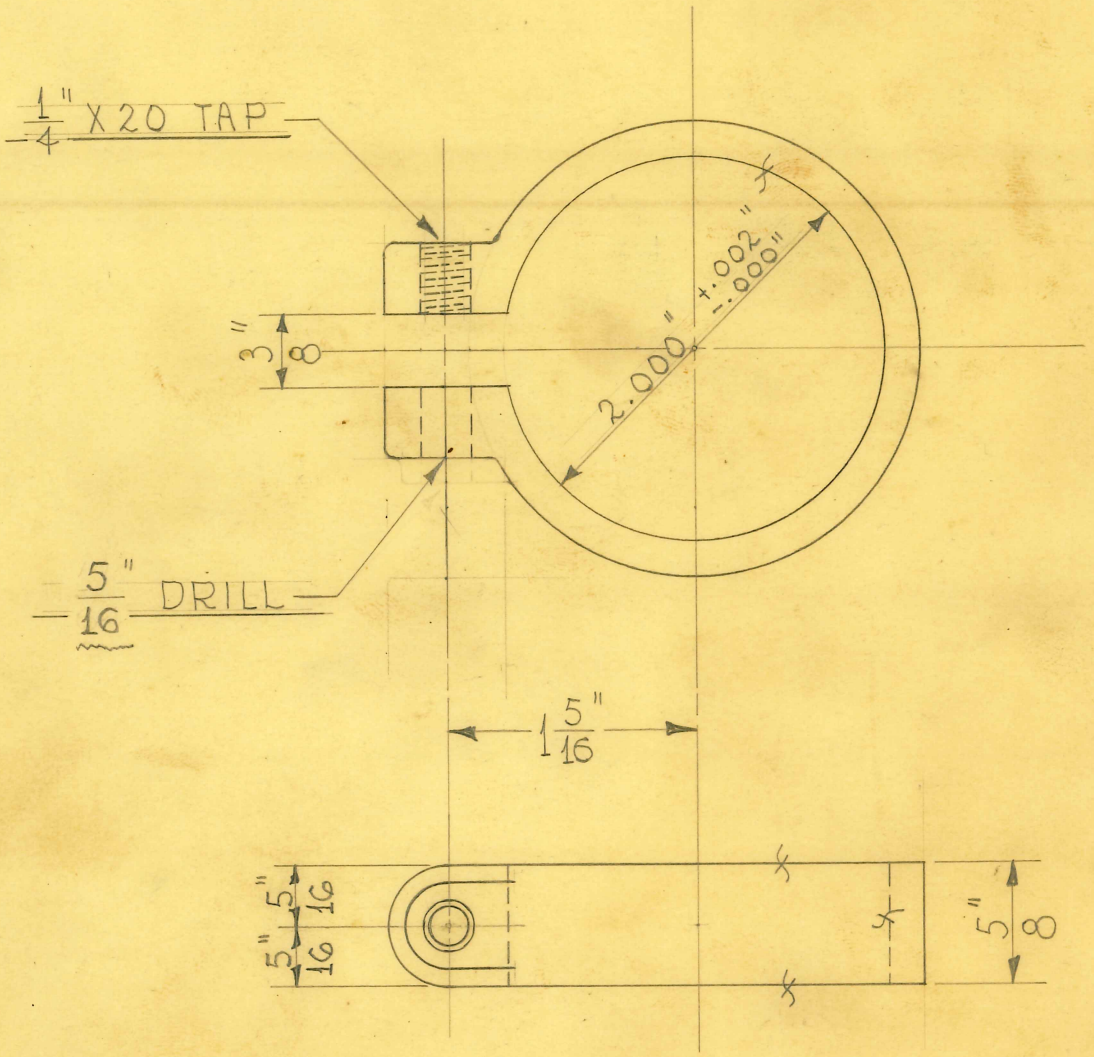

1 REQUIRED

SIZE	#80-10-10	ISSUE 11-18-41	HE
KIND	BRONZE CASTING	CHANGED	
SHAPE		"	
FINISH		"	
TEMP.		"	
PATT.	1833	"	

TITLE: FISCHER DENTAL X-RAY UNIT-
SWIVEL ARM SUPPORT LOCK RING

H. G. FISCHER & CO.
2338 WABANSIA AVE.
CHICAGO, ILL.

CAT. NO.

PART NO. 13851F

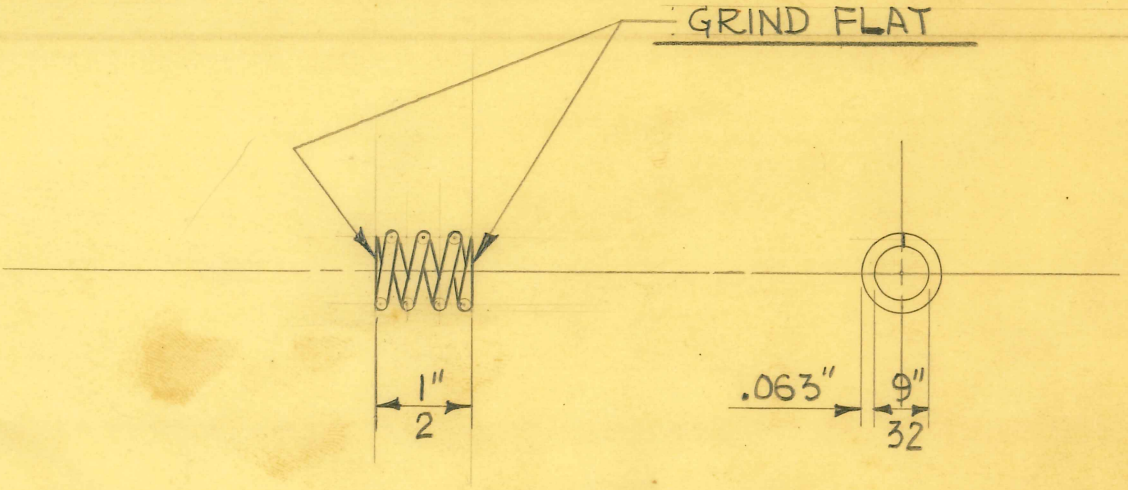

4 TURNS

1 REQUIRED

SIZE	#26 GA. (.063")	ISSUE 12-3-41	J.V.W.
KIND	MUSIC WIRE	CHANGED	
SHAPE		"	
FINISH		"	
TEMP.		"	
PATT.		"	

TITLE: FISCHER DENTAL X-RAY UNIT
SWIVEL ARM SUPP. LOCK RING SPRING

H. G. FISCHER & CO.
2335 WABANSIA AVE.
CHICAGO, ILL.

CAT. NO.

PART NO. 13852

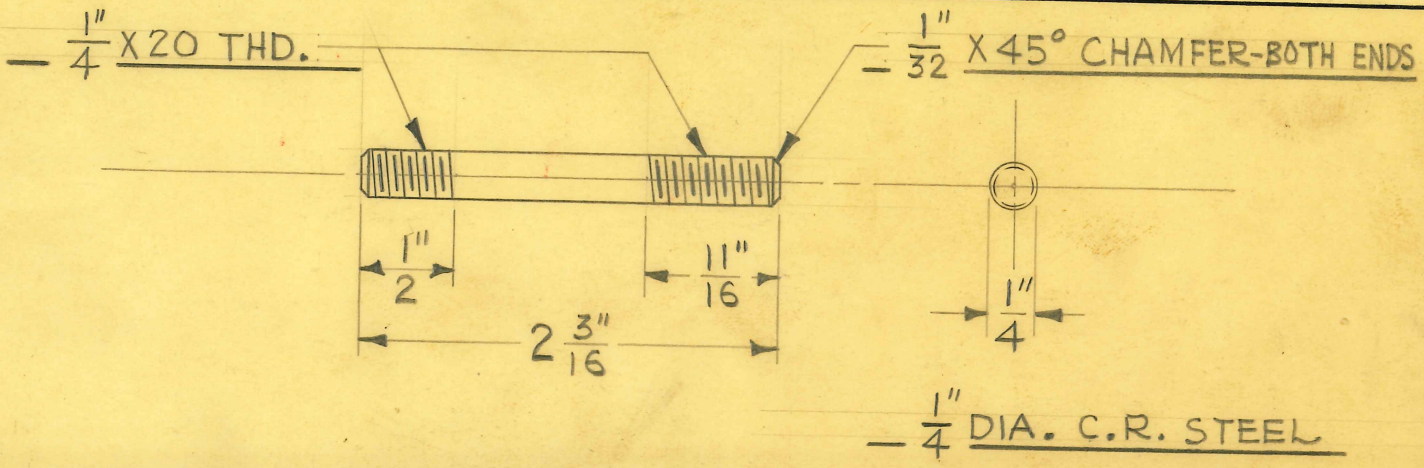

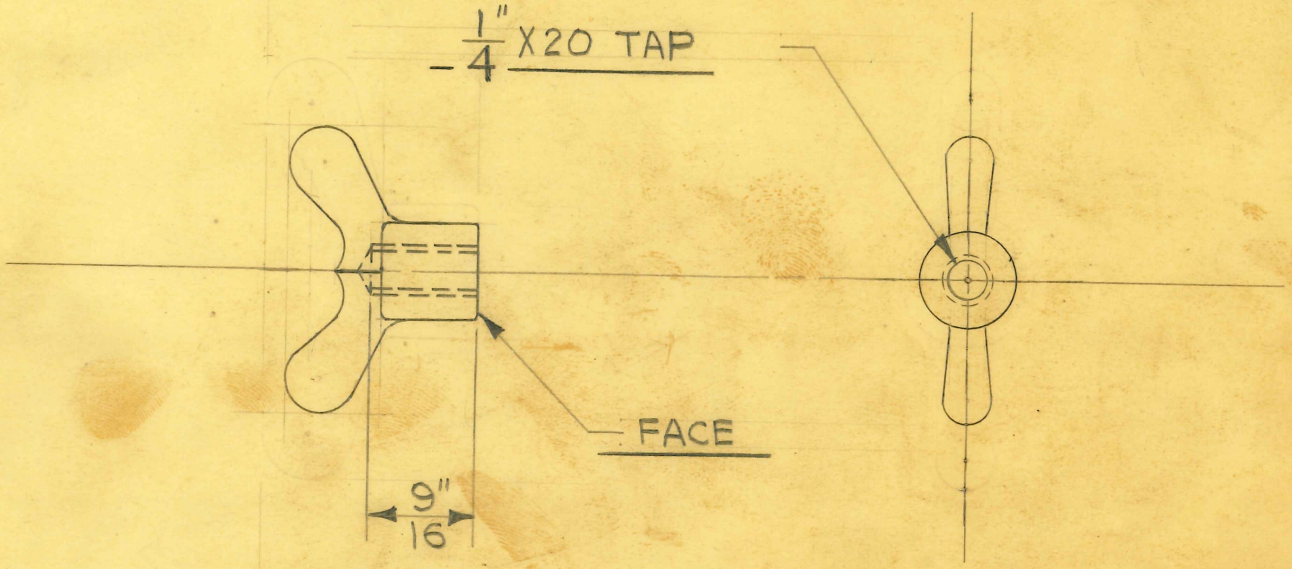

FROM 9306

SCREW STUD IN TIGHT. - #52 DRILL C'SINK. BOTH ENDS FOR RIVETING. INSERT 1/16" DIA. C.R. STEEL PIN, RIVET BOTH ENDS & FILE SMOOTH.

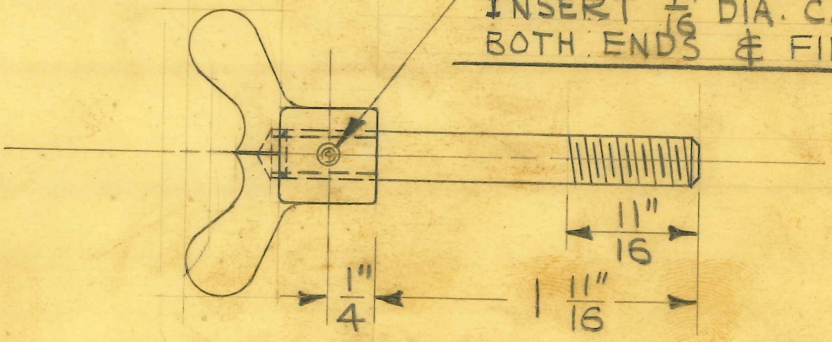

1 REQUIRED

SIZE		ISSUE 12-3-41	J.V.W.
KIND		CHANGED	
SHAPE		" 5-31-44	HE.
FINISH	PAINTED	"	
TEMP.		"	
PATT.		"	

TITLE:
FISCHER DENTAL X-RAY UNIT
SWIVEL ARM SUPP. LOCK RING - WING SCREW

H. G. FISCHER & CO.
2338 WABANSIA AVE.
CHICAGO, ILL.

CAT. NO.

PART NO. 13853G

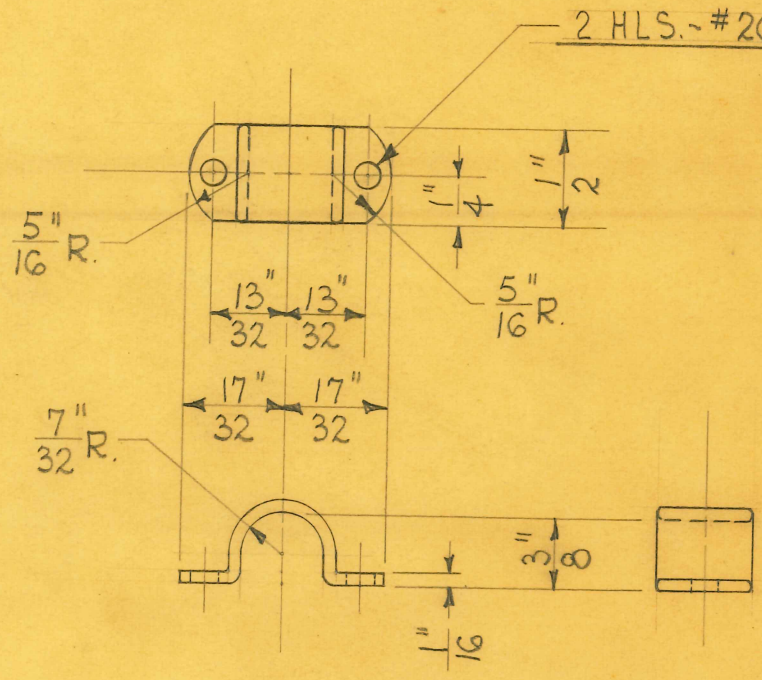

DEVELOPED LENGTH~ 1 17/32"

1 REQUIRED

SIZE	1/16" X 1/2"	ISSUE 4-3-44	HE.
KIND	FLAT WIRE	CHANGED	
SHAPE		"	
FINISH	WH. CHR. #3	"	
TEMP.		"	
PATT.		"	

TITLE: FISCHER MOD. "CMDX" DENTAL X-RAY UNIT- ARMS PIVOT HEAD ~ CABLE CLAMP

H. G. FISCHER & CO.
2335 WABANSIA AVE.
CHICAGO. ILL.

CAT. NO.

PART NO. 13862

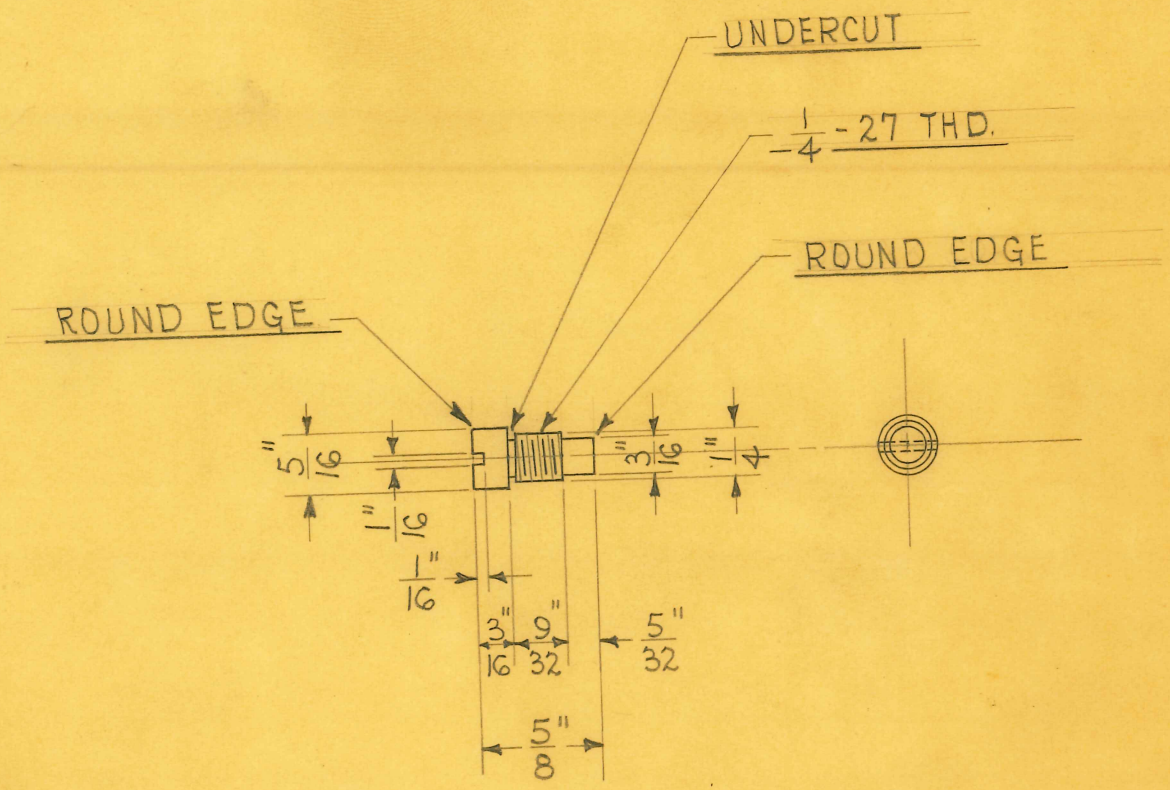

1 REQUIRED

SIZE	5/16" DIAM	ISSUE 3-31-44	HE.
KIND	C.R. STEEL	CHANGED	
SHAPE	ROD	"	
FINISH	CHROME #2	"	
TEMP.	(HEAD ONLY)	"	
PATT.		"	

TITLE: FISCHER MODEL "CMDX" DENTAL X-RAY UNIT-
HEAD UPPER SWIVEL CONN.-SUPP. SCREW

H. G. FISCHER & CO.
2335 WABANSIA AVE.
CHICAGO. ILL.

CAT. NO.

PART NO. 13863

CUT 8~40° SEGMENTS FROM ONE BLANK.

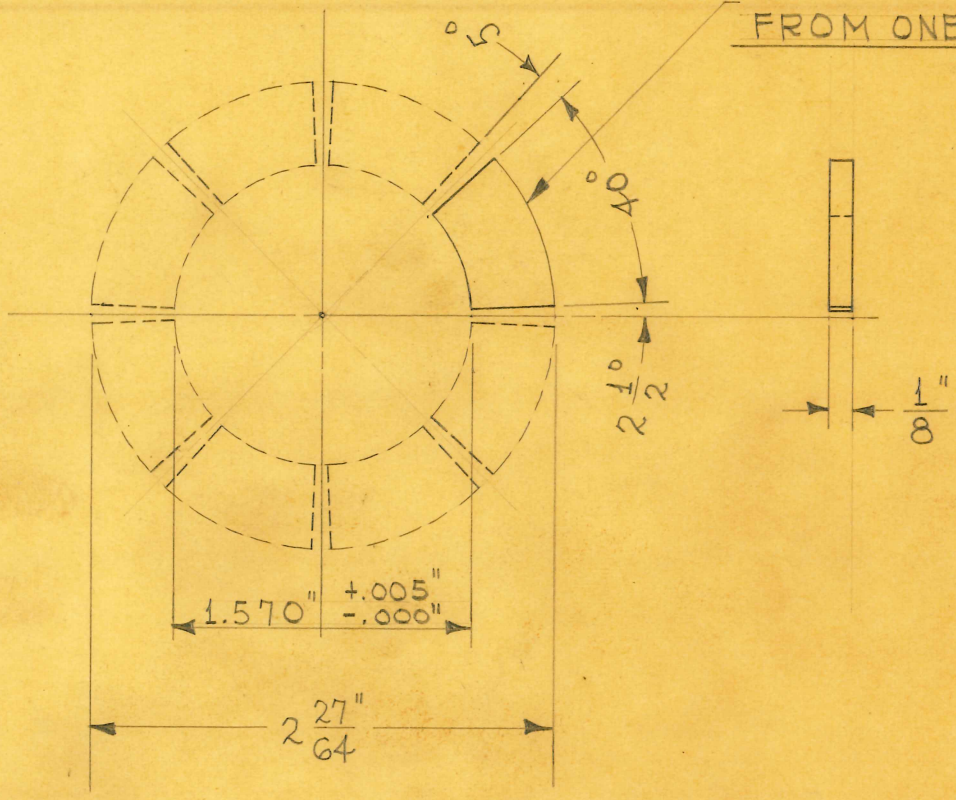

4 REQUIRED

SIZE	1/8" SHEET	ISSUE 9-27-44	H.E.
KIND	C.R. STEEL	CHANGED	
SHAPE		"	
FINISH		"	
TEMP.		"	
PATT.		"	

TITLE: FISCHER MOD. "CMDX" DENTAL X-RAY UNIT~ TRANSF. HEAD & FORK STOP WASHER SEGMENT

H. G. FISCHER & CO.
2338 WABANSIA AVE.
CHICAGO. ILL.

CAT. NO.

PART NO. 13864A

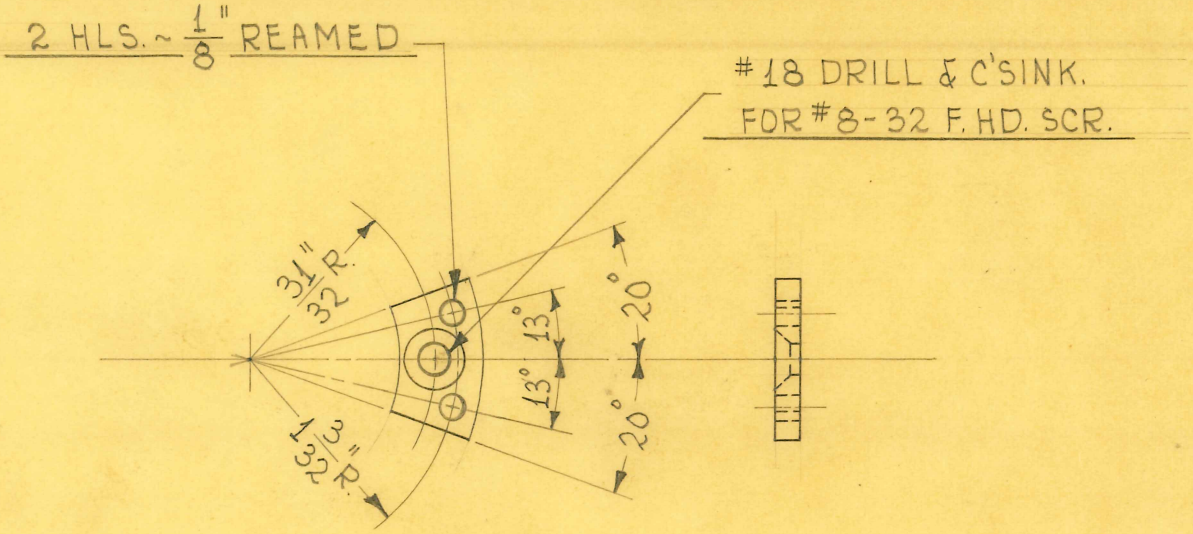

1 REQUIRED

SIZE	FROM	ISSUE 9-27-44	HE.
KIND		CHANGED	
SHAPE		"	
FINISH	WH. CHR. #3	"	
TEMP.		"	
PATT.		"	

TITLE: FISCHER MOD. "CMDX" DENTAL X-RAY UNIT - TRANSF. HEAD SUPP. ~ STOP SEGMENT

H. G. FISCHER & CO.
2335 WABANSIA AVE.
CHICAGO, ILL.

CAT. NO.

PART NO. 13864AF

2-PC.# 13864A SPOT WELDED TO WASHER TOP & BOTTOM AS SHOWN.

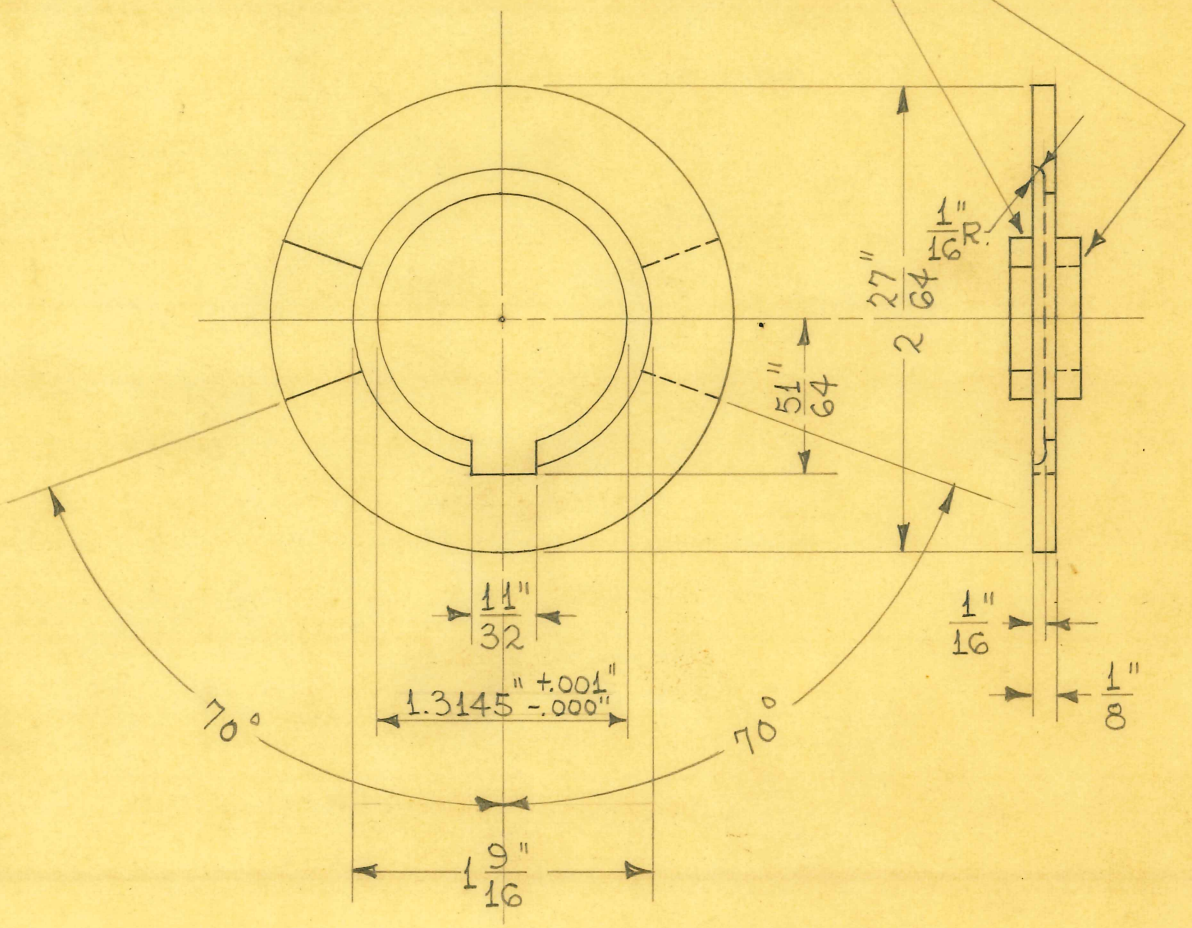

1 REQUIRED

SIZE	1/8" SHEET	ISSUE 9-28-44	HE.
KIND	C.R. STEEL	CHANGED	
SHAPE		"	
FINISH	WH. CHR. #3	"	
TEMP.		"	
PATT.		"	

TITLE: FISCHER MOD. "CMDX" DENTAL X-RAY UNIT- TRANSF. HEAD & FORK FLOATING STOP WASHER.

H. G. FISCHER & CO.
2333 WABANSIA AVE.
CHICAGO. ILL.

CAT. NO.

PART NO. 13865GA

3 HLS. #18 DRL. CSK.
FOR #8 - 32 F. HD. SCR.

PC. #13864A SPOT WELDED
TO WASHER AS SHOWN

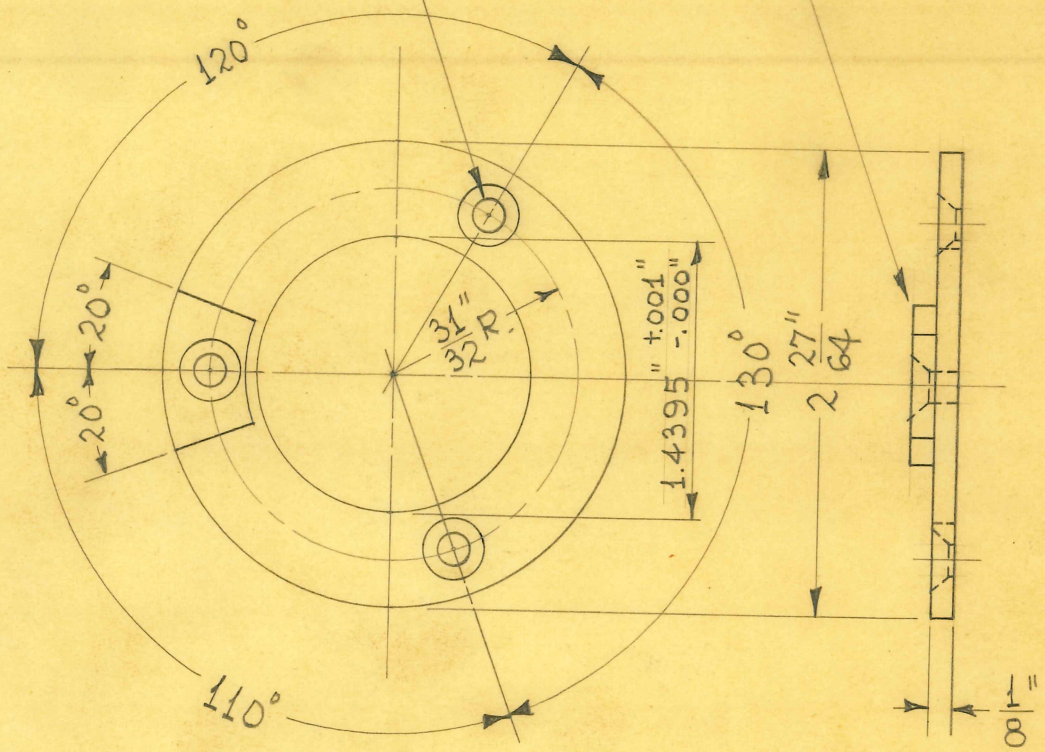

1 REQUIRED

SIZE	1/8" SHEET	ISSUE 9-27-44	HE.
KIND	C.R. STEEL	CHANGED	
SHAPE		..	
FINISH	WH. CHR. #3	..	
TEMP.		..	
PATT.		..	

TITLE: FISCHER MOD. "CMDX" DENTAL X-RAY UNIT - TRANSF. HEAD & FORK SUPPORTING WASHER

H. G. FISCHER & CO.
2338 WABANSIA AVE.
CHICAGO. ILL.

CAT. NO.

PART NO. 13866GA

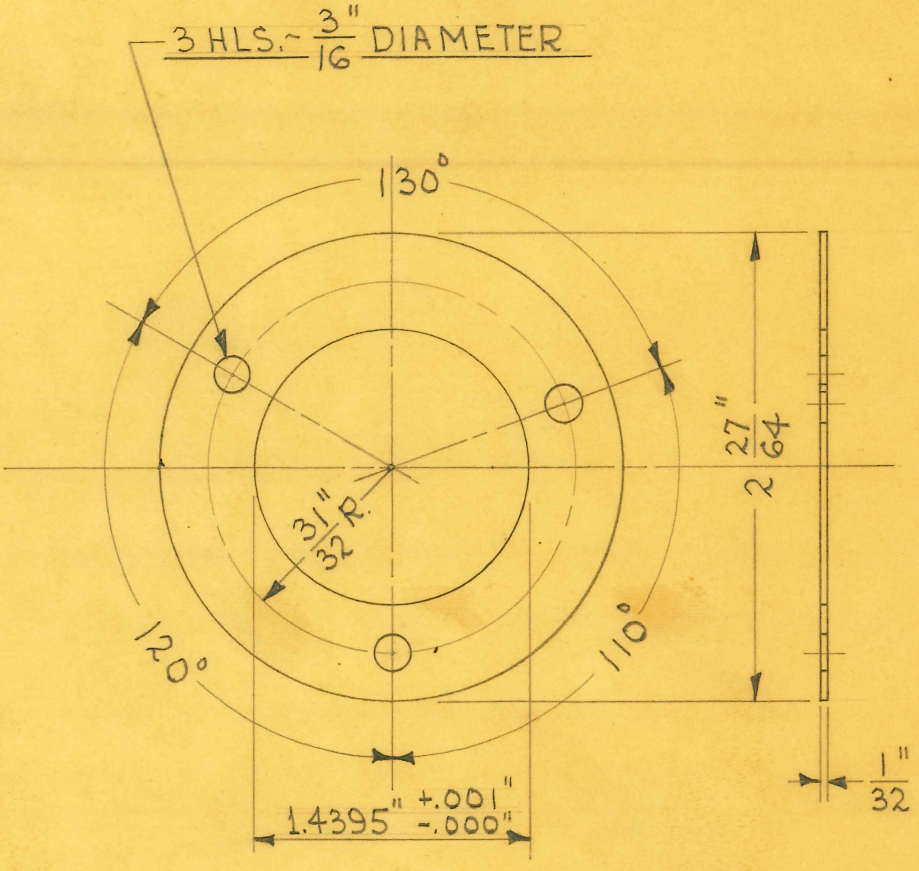

1 REQUIRED

SIZE	1/32" SHEET	ISSUE 4-5-44	HE.
KIND	BLACK FIBRE	CHANGED	
SHAPE		"	
FINISH		"	
TEMP.		"	
PATT.		"	

TITLE: FISCHER MOD. "CMDX" DENTAL X-RAY UNIT~ TRANSF. HEAD FORK FRICTION WASHER

H. G. FISCHER & CO.
2335 WABANSIA AVE.
CHICAGO, ILL.

CAT. NO.

PART NO. 13868

TITLE
FISCHER "CMDX" DENTAL X VETERANS ADMINISTRATION
CONTROL BOX SWITCH BUSHING - PLAIN

PATTERN

FINISH CAD. #23

SCALE FULL

TOOLS

MATERIAL
1 1/4" DIA. BRASS ROD

H. G. FISCHER & CO.
FRANKLIN PARK, ILLINOIS

DATE 9-6-50 DR. BY W. J. CH'K'D. J.V.W.

DIMENSIONS
FRACTIONAL ± .015
DECIMAL ± .005
ANGULAR ± ½°
UNLESS OTHERWISE SPECIFIED

15615

REVISION	DATE	BY

1 REQUIRED

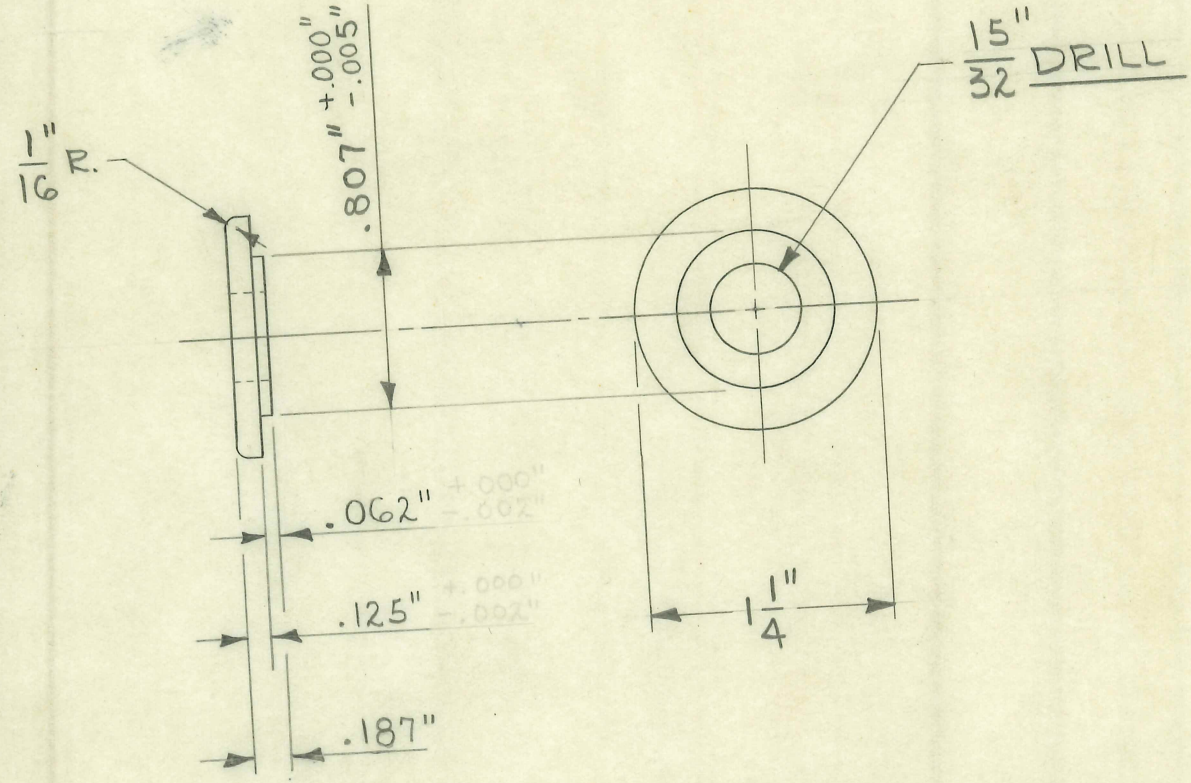

FOLDER #99A

TITLE
FISCHER "CMDX" DENTAL X VETERANS ADMINIST.
COUTROL BOX - SWITCH BUSHING - THREADED

H. G. FISCHER & CO.
FRANKLIN PARK, ILLINOIS

PART NO. 13874

DATE 9-6-50 | DR. BY W. J. | CH'K'D. J.V.W.

REVISION	DATE	BY

PATTERN | FINISH | SCALE FULL

TOOLS | MATERIAL 1 1/4" DIA. BRASS ROD

DIMENSIONS
FRACTIONAL ± .015
DECIMAL ± .005
ANGULAR ± ½°
UNLESS OTHERWISE SPECIFIED

1 REQUIRED

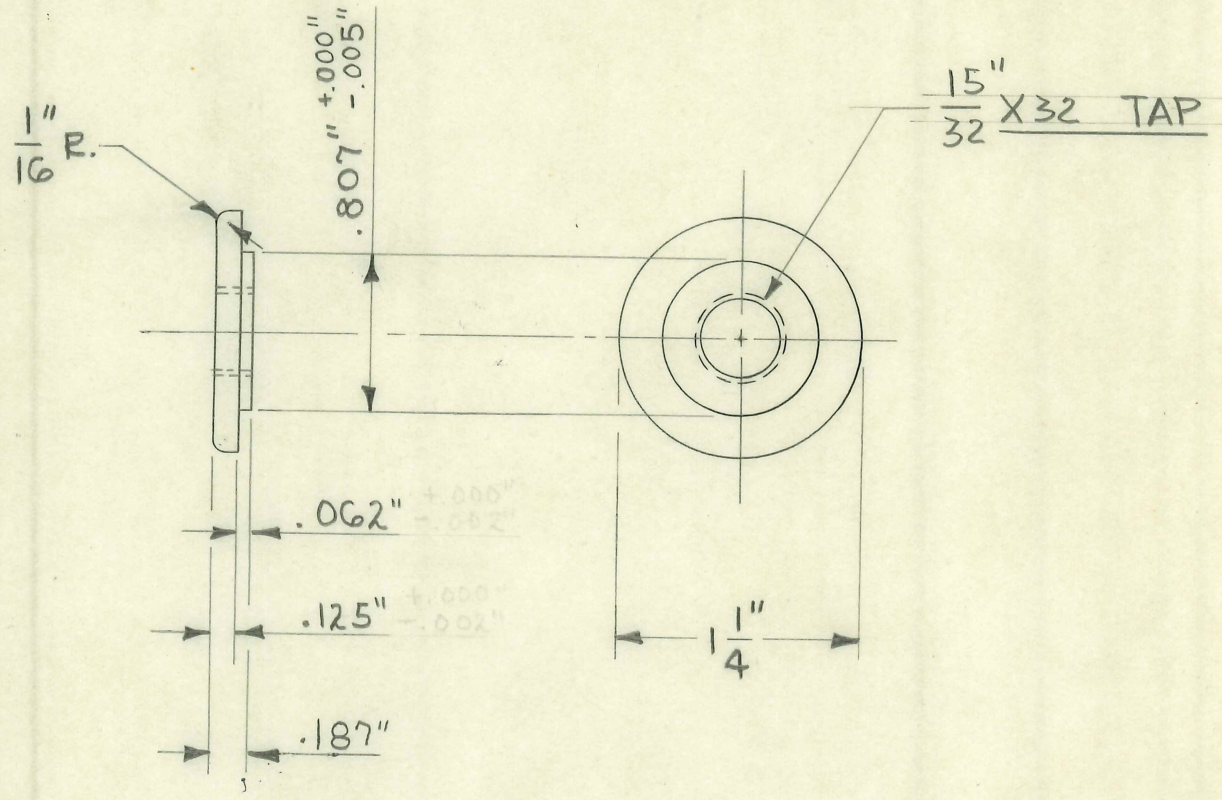

FOLDER #99A

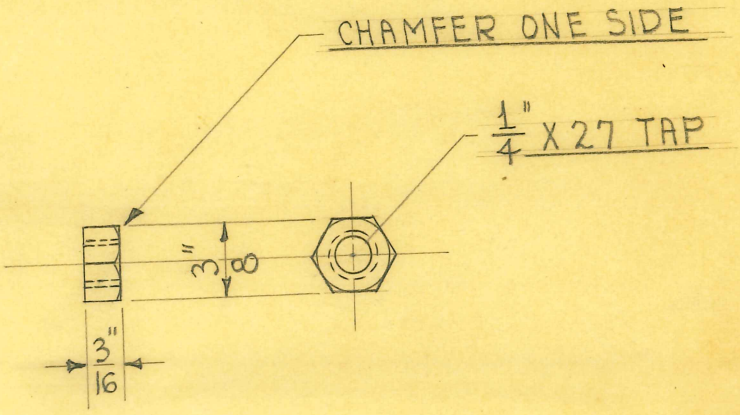

4 REQUIRED

SIZE	3/8" HEX.	ISSUE 1-6-45	HE.
KIND	C.R. STEEL	CHANGED	
SHAPE	ROD	"	
FINISH	CAD. #23	"	
TEMP.		"	
PATT.		"	

TITLE: WALL MODEL DENTAL X-RAY UNIT-
TUBE MOUNTING STUD NUT

H. G. FISCHER & CO.
2338 WABANSIA AVE.
CHICAGO, ILL.

CAT. NO.

PART NO. 13876

O.D. HAND PUNCH #8889 - WMDX BOX Q-1
I.D. HAND PUNCH #8890 - WMDX BOX Q-1

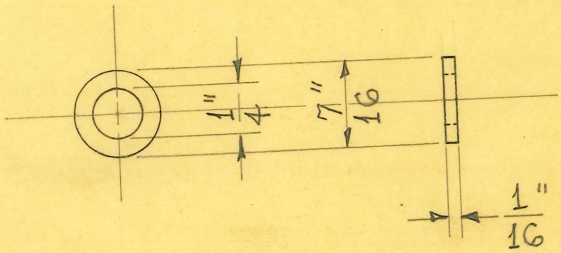

4 REQUIRED

1/16" SHEET NEOPRENE #2065 - #70 DUROMETER TEST

SIZE	~~1/16" SHEET~~	ISSUE 1-6-45	HE.
KIND	~~NEOPRENE~~	CHANGED	
SHAPE		"	
FINISH		"	
TEMP.		"	
PATT.		"	

TITLE: WALL MODEL DENTAL X-RAY UNIT~ TUBE MOUNTING STUD GASKET

H. G. FISCHER & CO.
2335 WABANSIA AVE.
CHICAGO. ILL.

CAT. NO.

PART NO. 13878

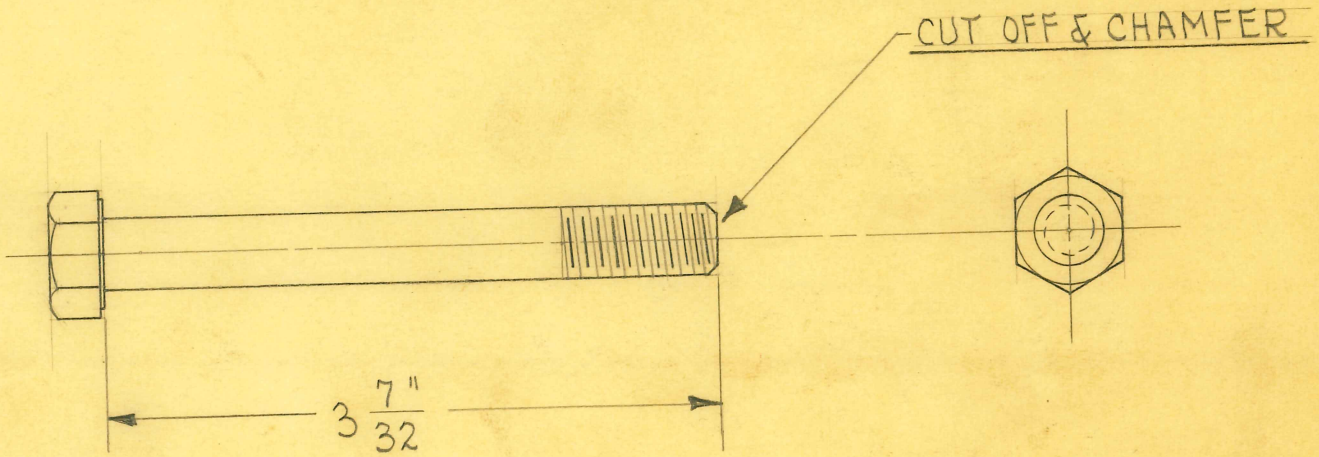

FROM ÷ 3/8"-16 X 3 1/2" HEX. HEAD CAP SCREW

1 REQUIRED

SIZE		ISSUE 12-7-44	HE.
KIND		CHANGED	
SHAPE		"	
FINISH	CAD. #23	"	
TEMP.		"	
PATT.		"	

TITLE: FISCHER MOBILE DENTAL X-RAY UNIT- UPRIGHT TUBE ADJUSTMENT BOLT

H. G. FISCHER & CO.
2335 WABANSIA AVE.
CHICAGO, ILL.

CAT. NO.

PART NO. 13885

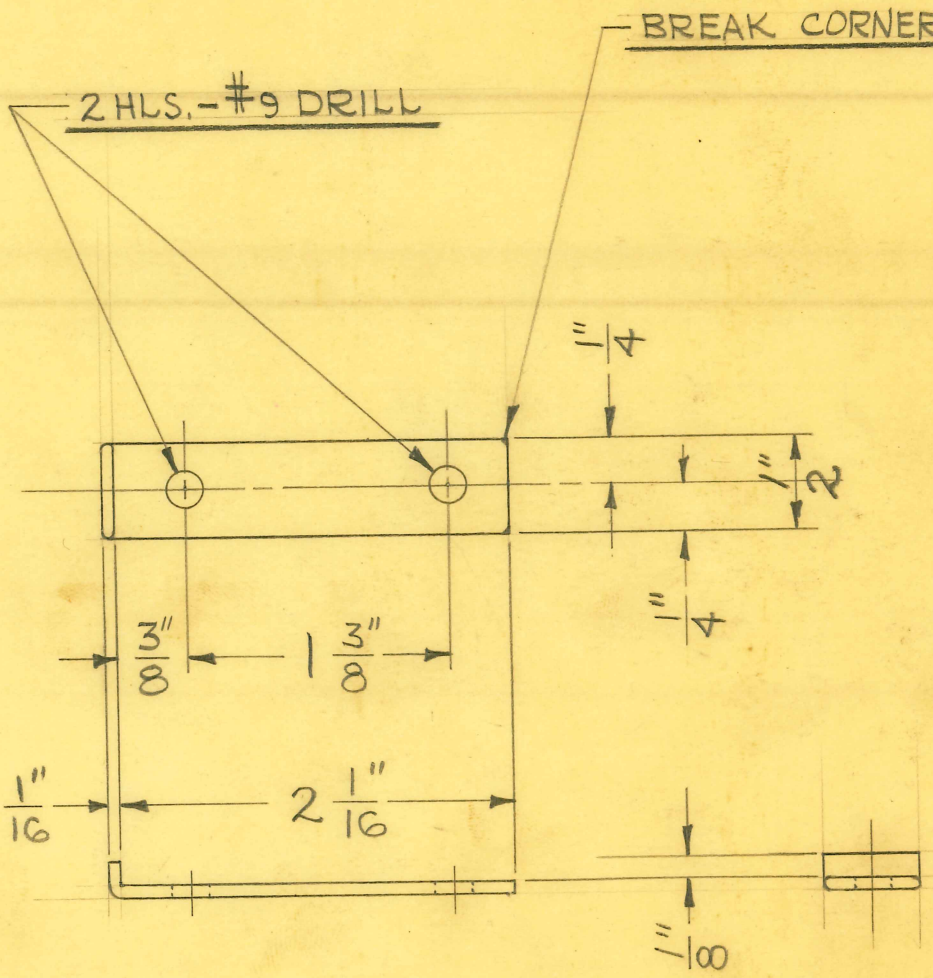

1 REQUIRED

SIZE	1/16" X 1/2"	ISSUE 3-28-46	J.V.W.
KIND	FLAT WIRE	CHANGED	
SHAPE		"	
FINISH		"	
TEMP.		"	
PATT.		"	

TITLE: WALL MODEL DENTAL X-RAY UNIT
RESISTOR SUPPORT

H. G. FISCHER & CO.
2335 WABANSIA AVE.
CHICAGO, ILL.

CAT. NO.

PART NO. 13886

BREAK SHARP
CORNERS & EDGES

2 HLS. - #8 X 32 TAP

2 HLS. - #9 DRILL

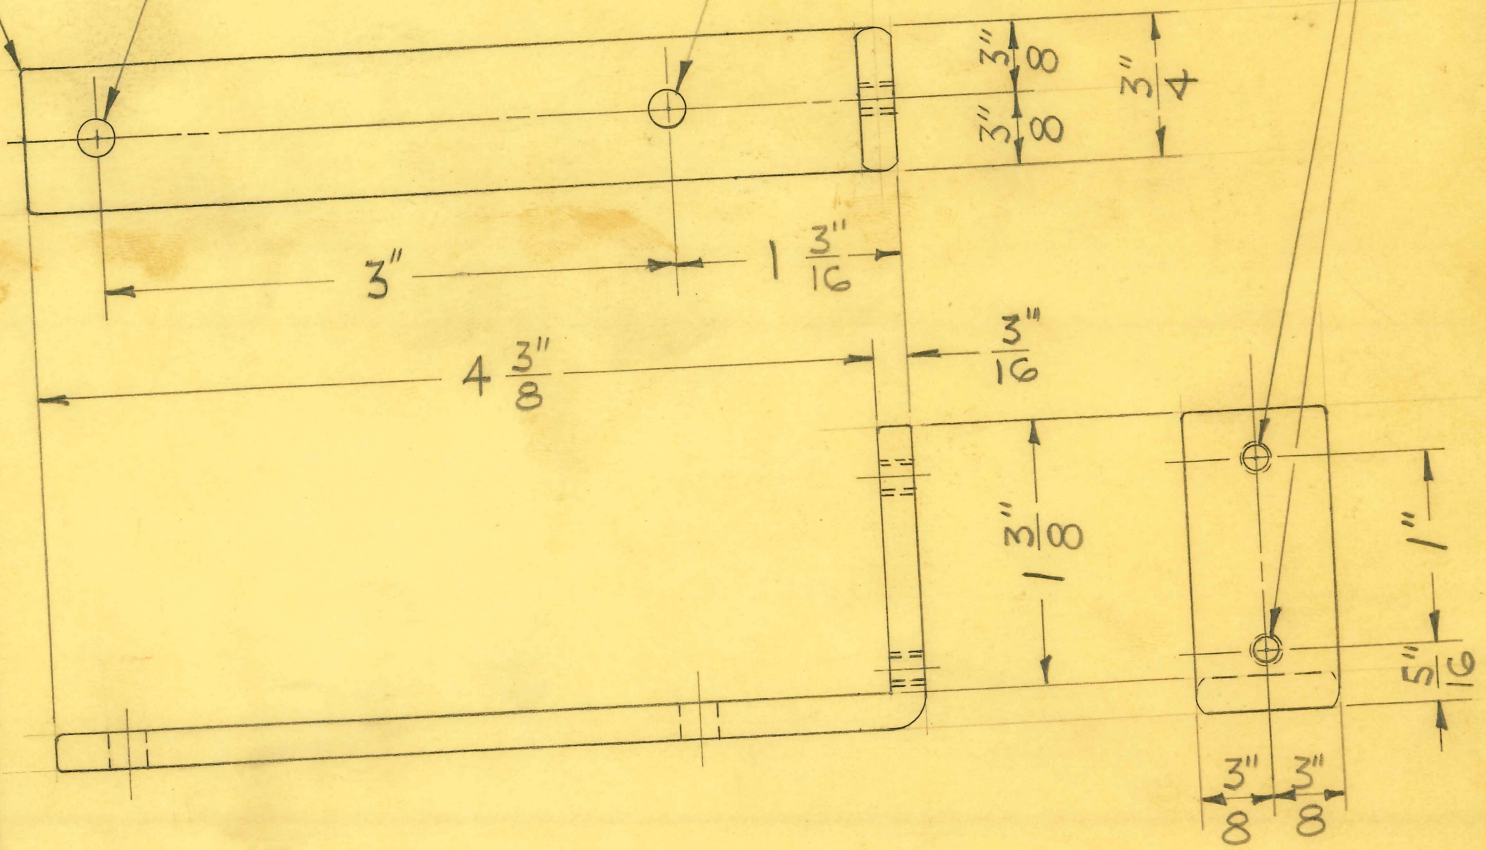

2 REQUIRED

SIZE	3/16" X 3/4"	ISSUE 4-3-46	J.V.W.	TITLE: WALL MODEL DENTAL X-RAY UNIT AUTO TRANSFORMER SUPPORT - REAR
KIND	FLAT WIRE	CHANGED		
SHAPE		"		
FINISH	CAD. #23	"		
TEMP.		"		
PATT.		"		

H. G. FISCHER & CO.
2335 WABANSIA AVE.
CHICAGO, ILL.

CAT. NO.

PART NO. 13887

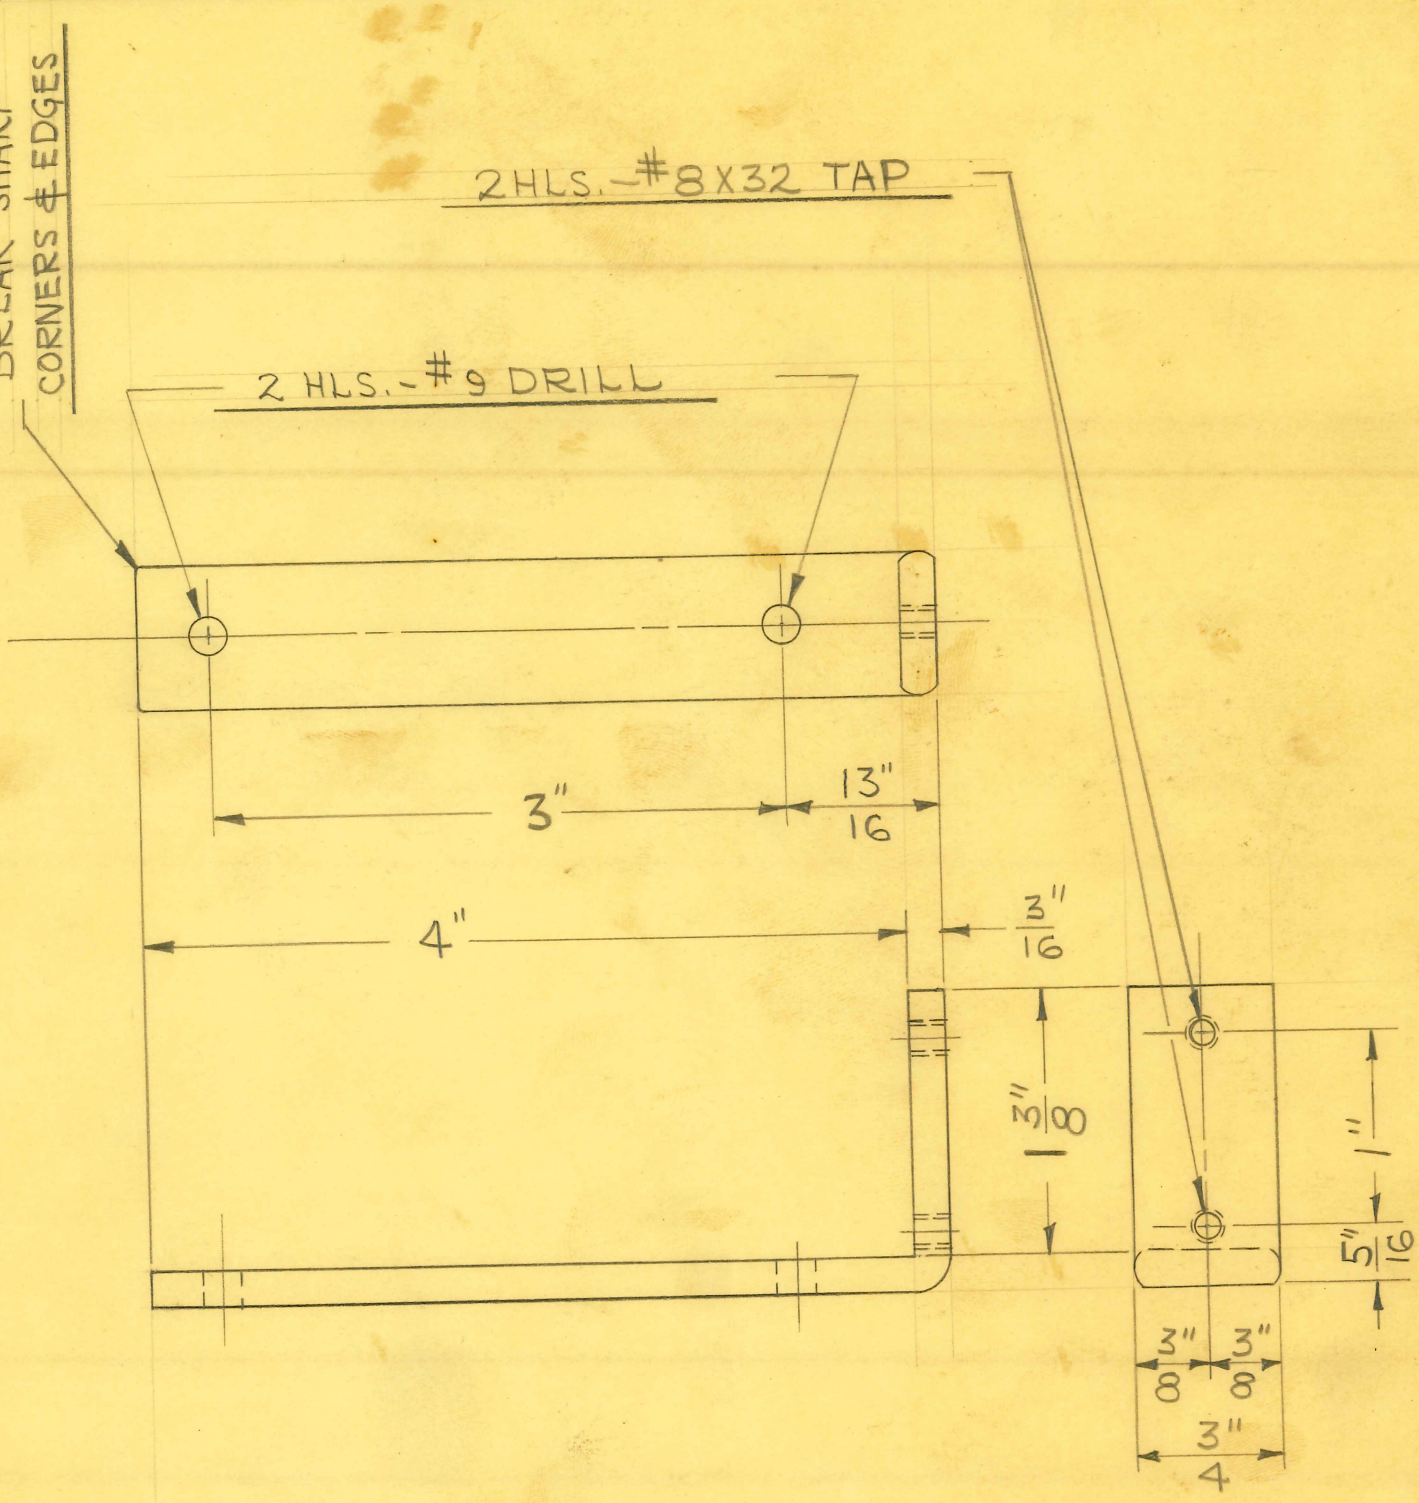

2 REQUIRED

SIZE	3/16" X 3/4"	ISSUE 3-28-46	J.V.W.
KIND	FLAT WIRE	CHANGED	
SHAPE		"	
FINISH	CAD. #23	"	
TEMP.		"	
PATT.		"	

TITLE:
WALL MODEL DENTAL X-RAY UNIT
AUTO TRANSFORMER SUPPORT - FRONT

H. G. FISCHER & CO.
2338 WABANSIA AVE.
CHICAGO, ILL.

CAT. NO.

PART NO. 13889

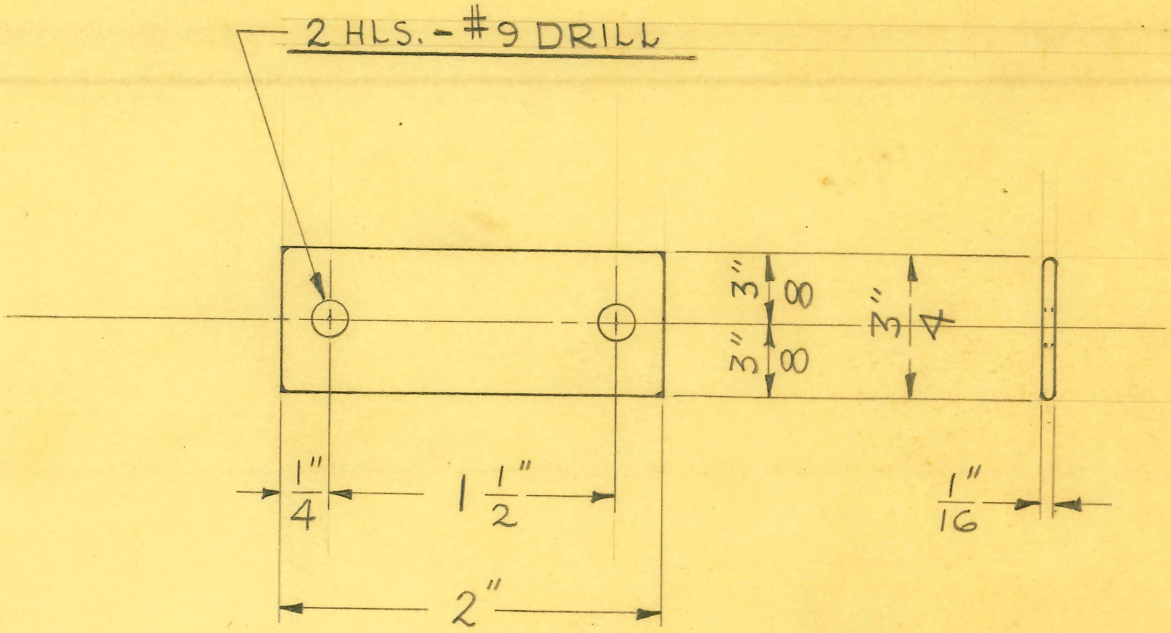

2 REQUIRED

SIZE	1/16" X 3/4"	ISSUE 5-8-46	J.V.W.	**TITLE:** STABILIZED WALL MODEL DENTAL-X STABILIZER CLAMP PLATE
KIND	FLAT WIRE	CHANGED		
SHAPE		"		
FINISH	CAD. #23	"		
TEMP.		"		
PATT.		"		

H. G. FISCHER & CO.
2338 WABANSIA AVE.
CHICAGO, ILL.

CAT. NO.

PART NO. 13890

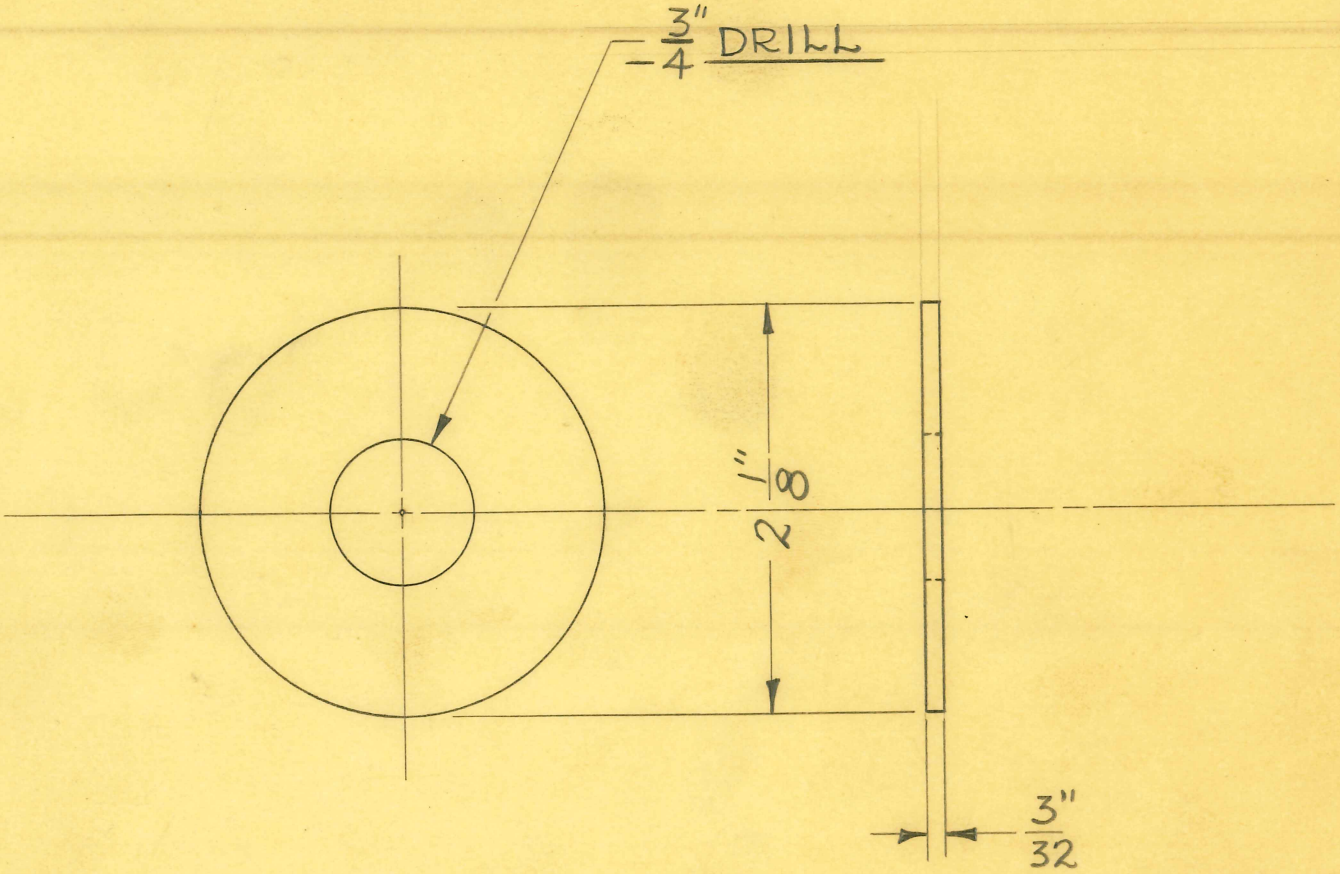

1 REQUIRED

SIZE	3/32" SHEET	ISSUE 2-20-47	J.V.W.
KIND	LEAD	CHANGED	
SHAPE		"	
FINISH		"	
TEMP.		"	
PATT.		"	

TITLE:
FISCHER DENTAL X-RAY UNIT
12" DENTAL CONE LEAD DIAPHRAGM

H. G. FISCHER & CO.
2335 WABANSIA AVE.
CHICAGO, ILL.

CAT. NO.

PART NO. 13893

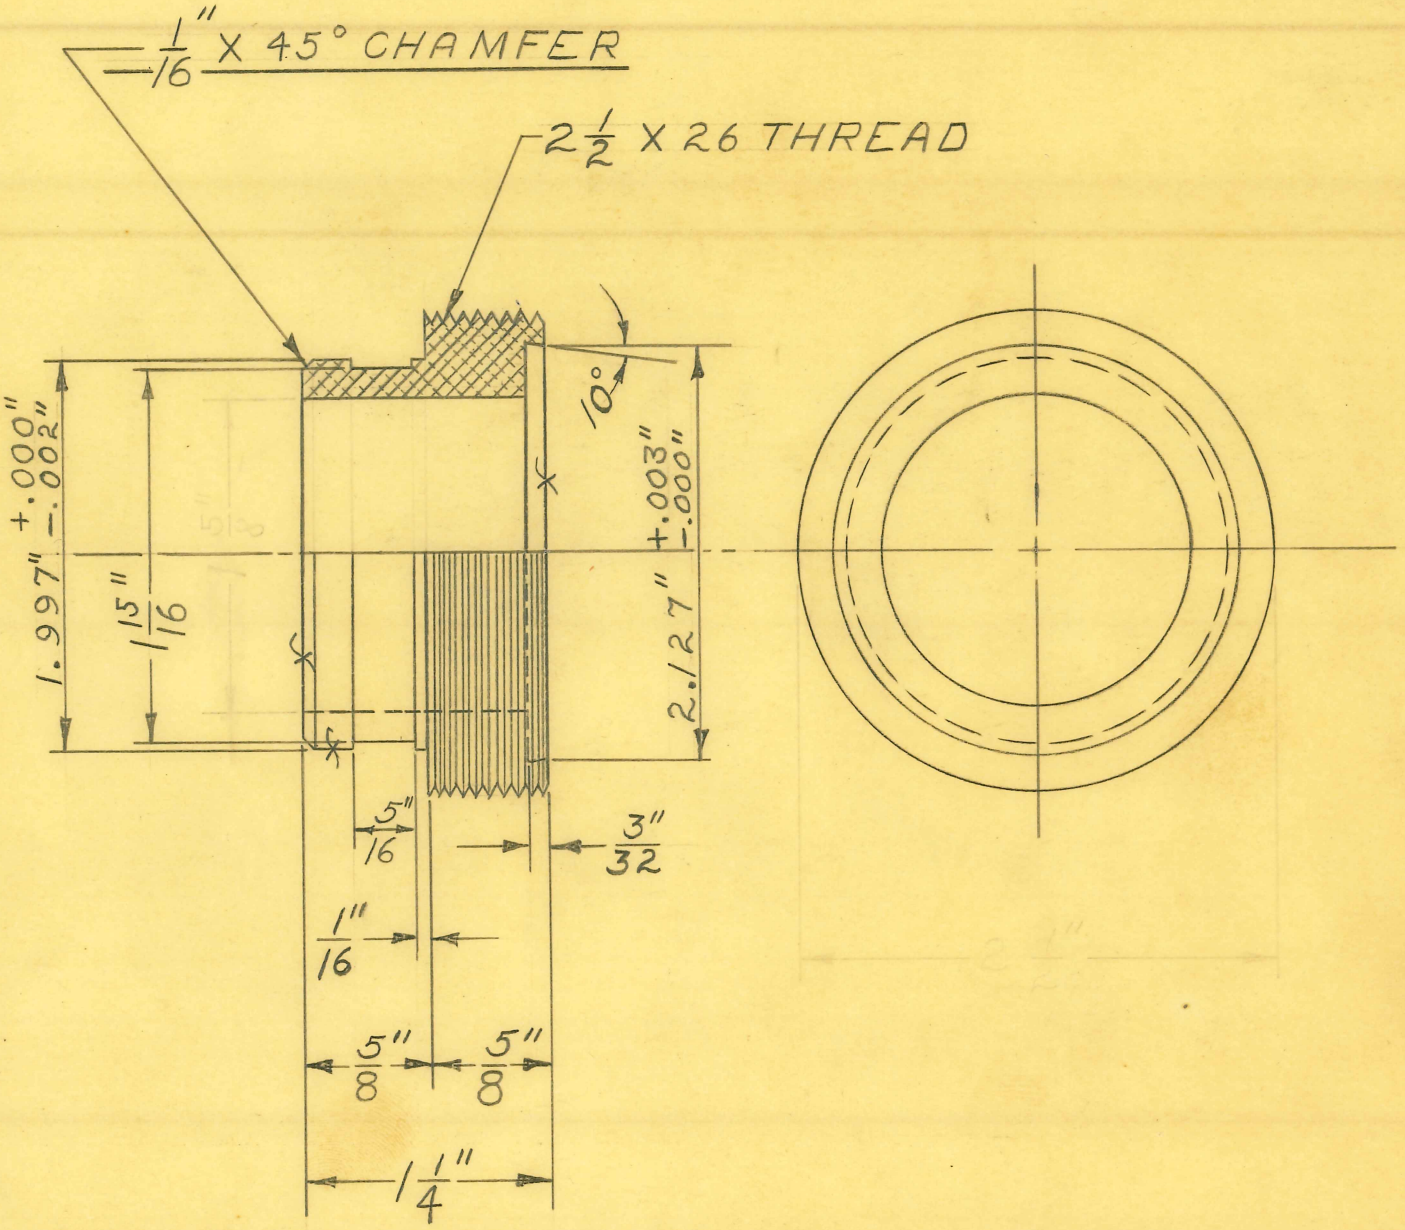

SIZE	#12 ALUM.	ISSUE 5-12-47	W.J.
KIND	CASTING	CHANGED	
SHAPE		"	
FINISH		"	
TEMP.		"	
PATT.	2220	"	

TITLE: FISCHER DENTAL X-RAY UNIT
12" & 20" DENTAL CONE BASE

H. G. FISCHER & CO.
2335 WABANSIA AVE.
CHICAGO, ILL.

CAT. NO.

PART NO. 13896F

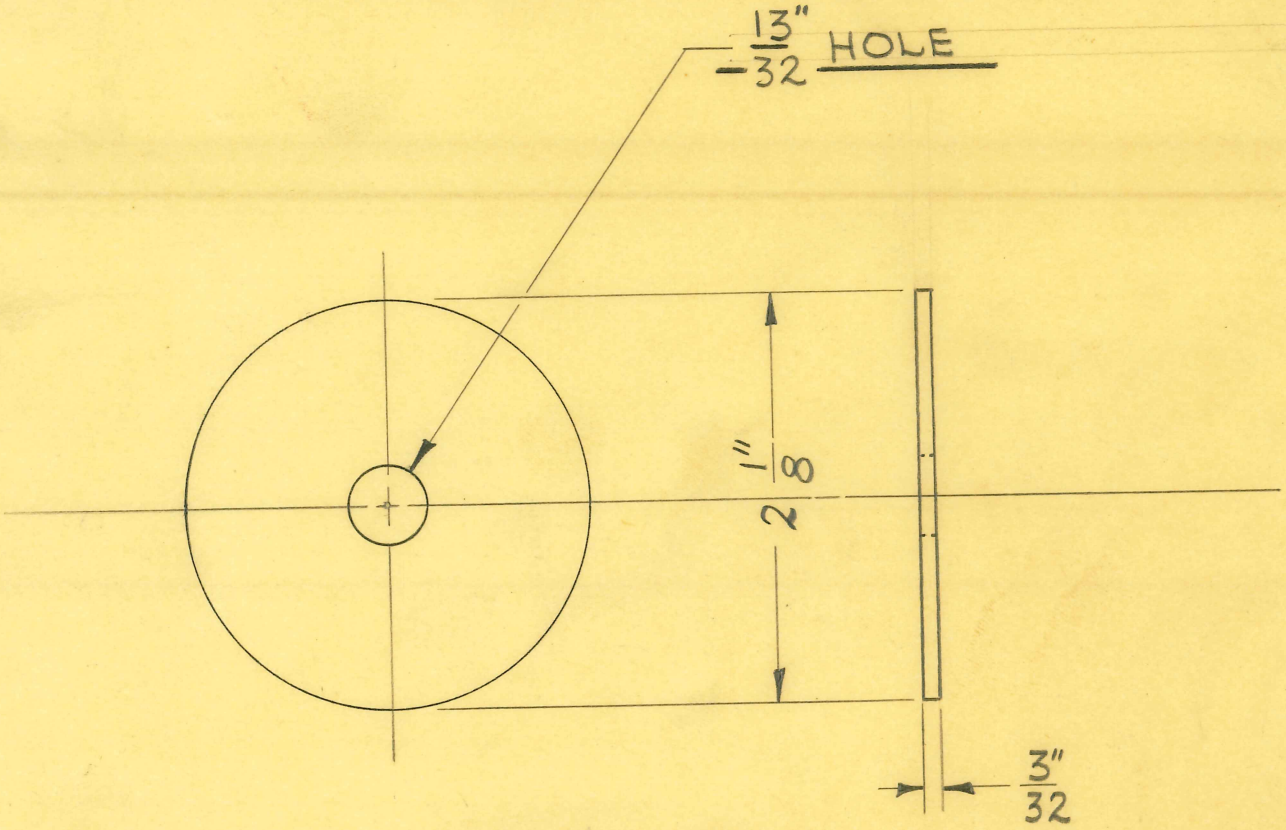

1 REQUIRED

SIZE	3/32" SHEET	ISSUE 2-20-47	J.V.W.
KIND	LEAD	CHANGED	
SHAPE		"	
FINISH		"	
TEMP.		"	
PATT.		"	

TITLE: FISCHER DENTAL X-RAY UNIT
20" DENTAL CONE LEAD DIAPHRAGM

H. G. FISCHER & CO.
2335 WABANSIA AVE.
CHICAGO. ILL.

CAT. NO.

PART NO. 13897

TITLE DENTAL FILTER - DIAPHRAGM

H. G. FISCHER & CO.
FRANKLIN PARK, ILLINOIS

DATE 11-28-60 | DR BY RCT | CH'K'D.

PART NO. 13904 B

REVISION		DATE	BY
B	WAS .064	7-20-62	RCT

PATTERN | FINISH | SCALE FULL

TOOLS

MATERIAL #14 GA. .080" SHEET
ALUMINUM #1100-H14

DIMENSIONS
FRACTIONAL ± .015
DECIMAL ± .005
ANGULAR ± ½°
UNLESS OTHERWISE SPECIFIED

CATALOG # 3551

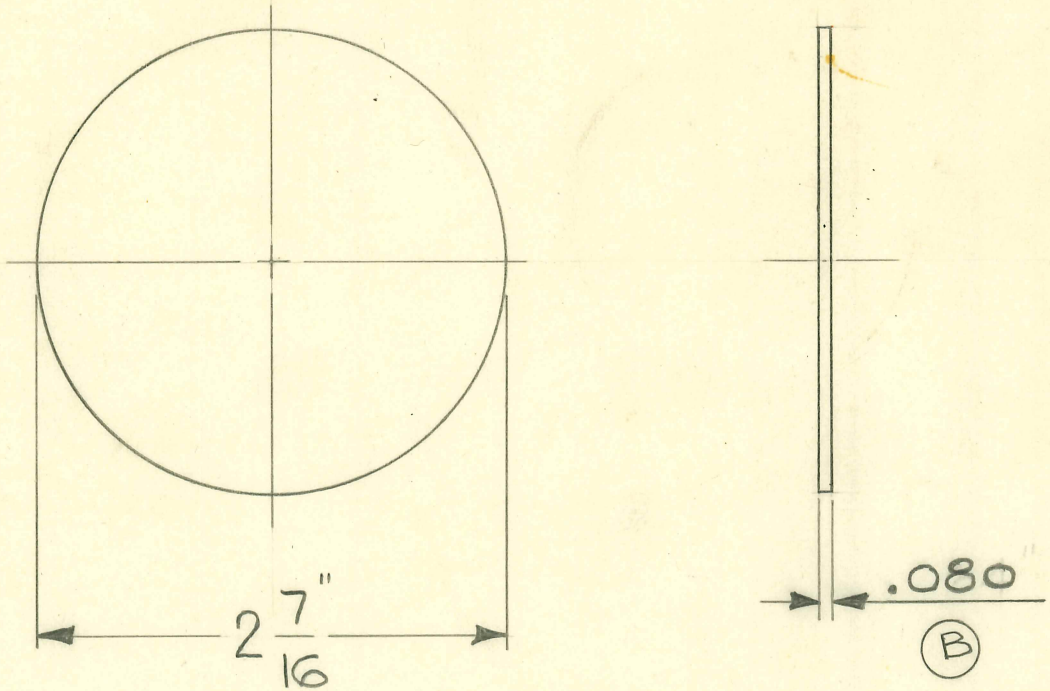

1-REQUIRED

FOLDER # 99

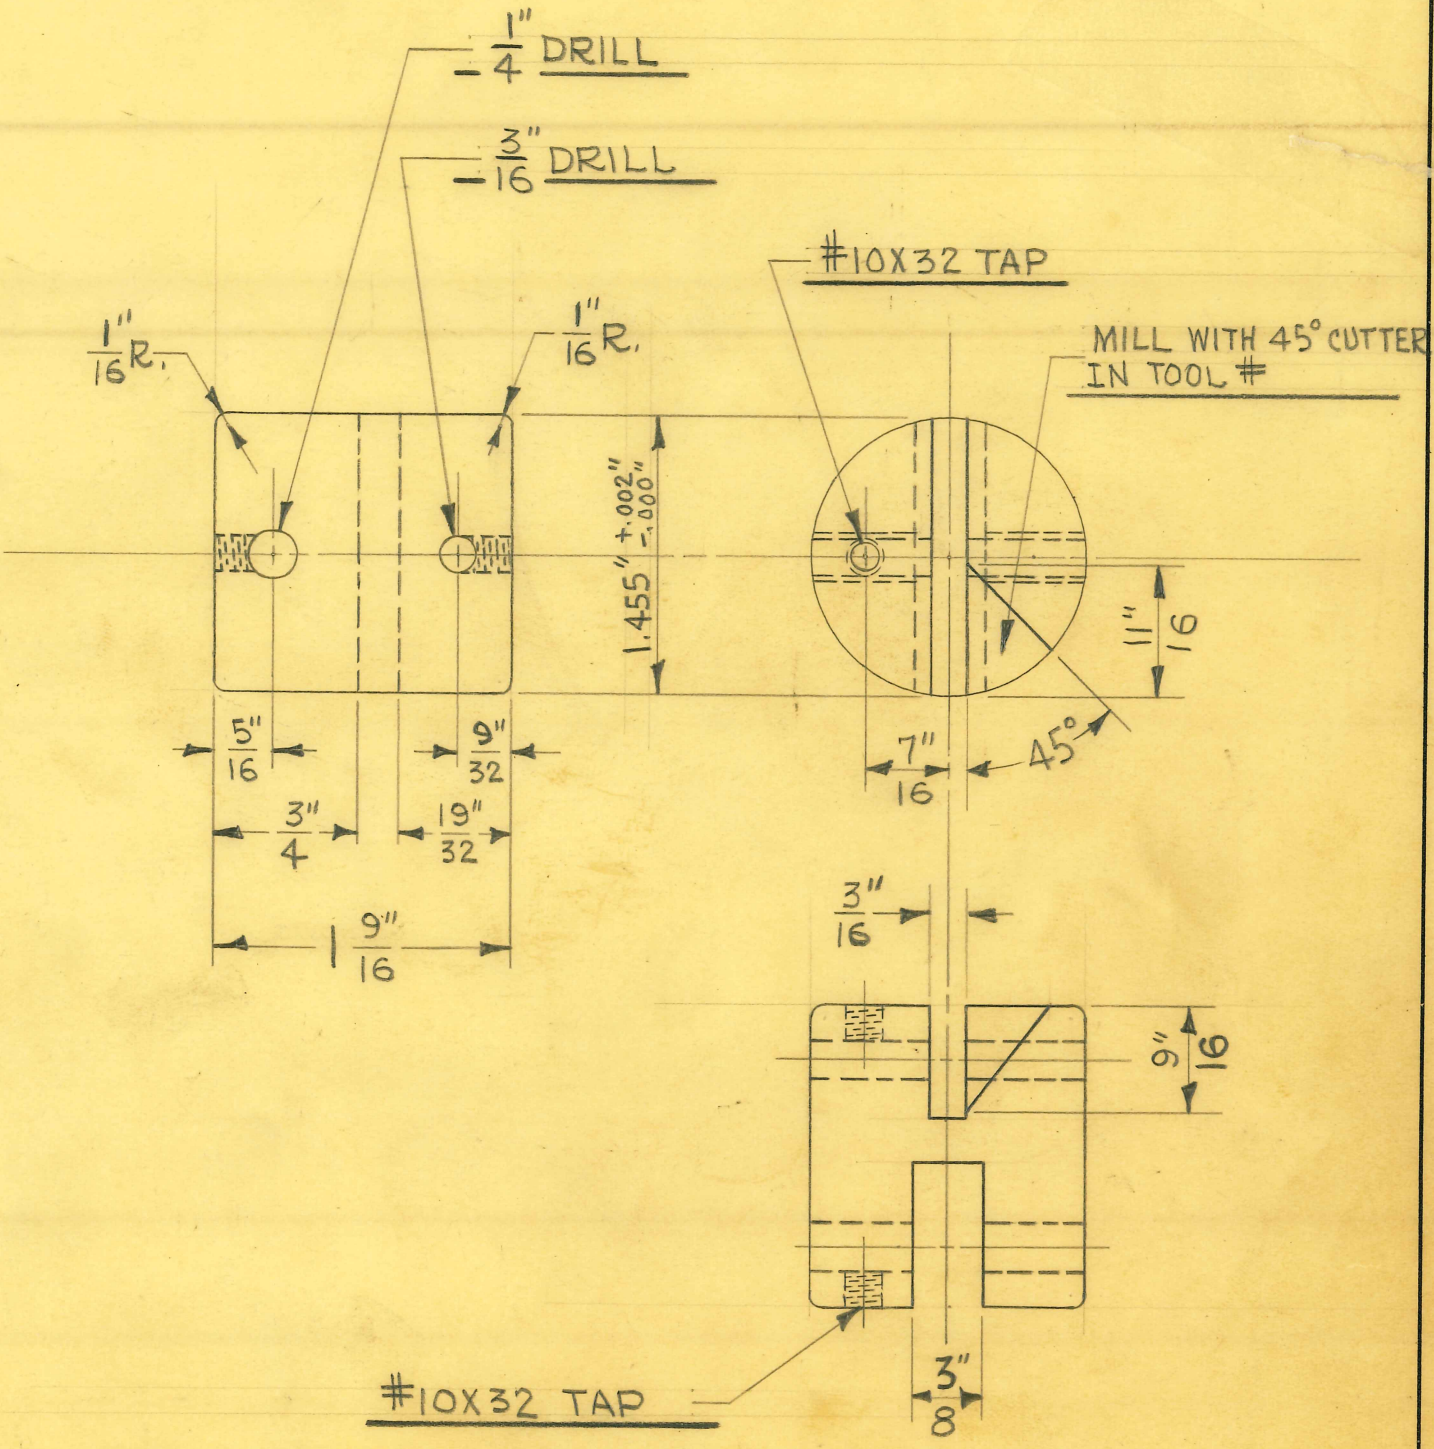

2 REQUIRED

SIZE	1½" DIA.	ISSUE 12-29-41	J.V.W.
KIND	BRASS ROD	CHANGED	
SHAPE		"	
FINISH		"	
TEMP.		"	
PATT.		"	

TITLE:
FISCHER MOD. "MVDX" MOBILE DENTAL X
COUNTERBALANCE SPRING PLUNGER

H. G. FISCHER & CO.
2335 WABANSIA AVE.
CHICAGO, ILL.

CAT. NO.

PART NO. 13906

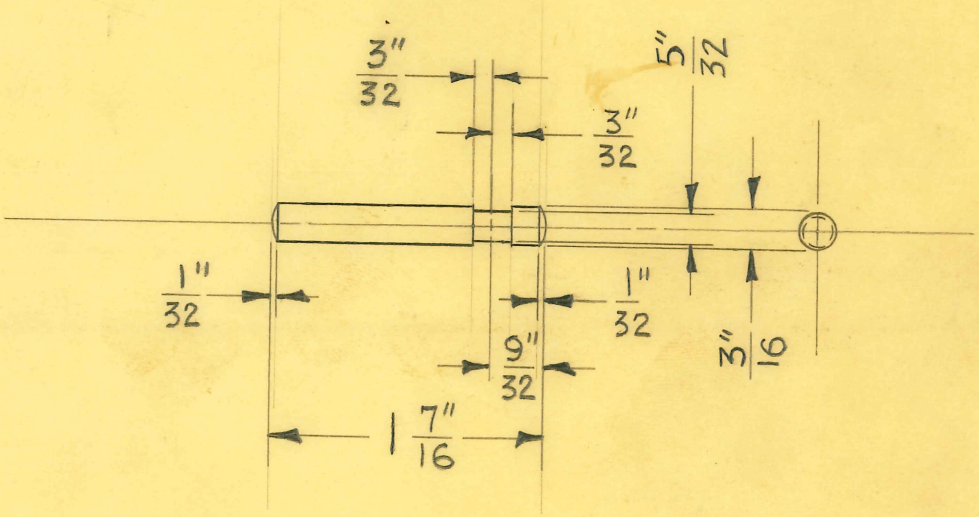

2 REQUIRED

SIZE	3/16" DIA.	ISSUE 12-29-41	J.V.W.
KIND	C.R. STEEL	CHANGED	
SHAPE		"	
FINISH		"	
TEMP.		"	
PATT.		"	

TITLE: FISCHER MOD. "MVDX" MOBILE DENTAL X COUNTERBALANCE SPRING PLUNGER SHAFT

H. G. FISCHER & CO.
2335 WABANSIA AVE.
CHICAGO, ILL.

CAT. NO.

PART NO. 13907

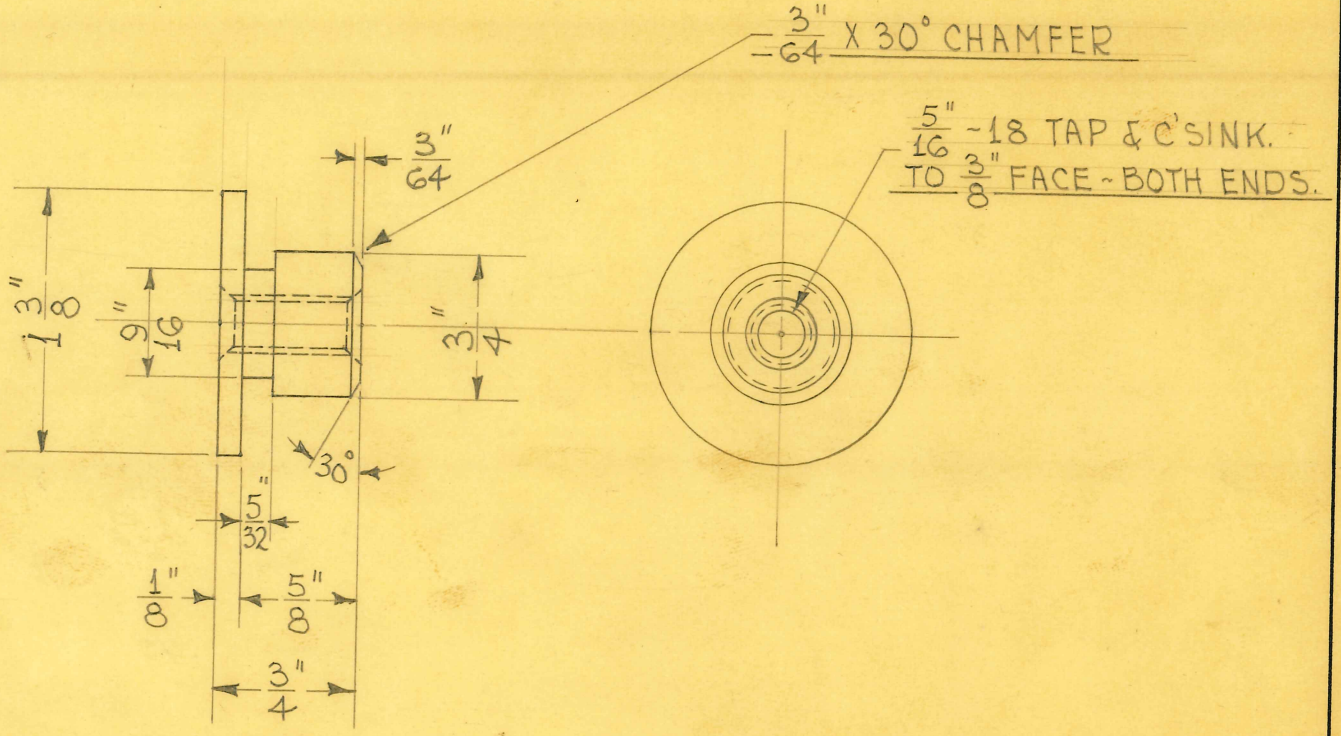

SIZE	1 3/8" DIAM.	ISSUE 9-19-44	HE.
KIND	BRASS ROD	CHANGED	
SHAPE		"	
FINISH		"	
TEMP.		"	
PATT.		"	

TITLE: FISCHER MOD. "MYDX" DENTAL X-RAY UNIT - C'BALANCE. SPRING SUPPORT PLUG - BLANK

H. G. FISCHER & CO.
2335 WABANSIA AVE.
CHICAGO. ILL.

CAT. NO.

PART NO. 13912

CUT THREAD WITH A No. 1 ~ 10 D.P. CUTTER, USING TOOL #7359.

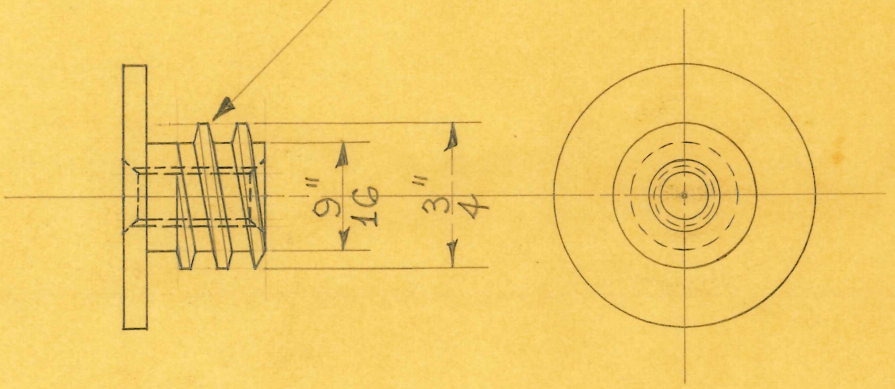

2 REQUIRED

SIZE	FROM 13912	ISSUE 9-19-44	HE.
KIND		CHANGED	
SHAPE		"	
FINISH		"	
TEMP.		"	
PATT.		"	

TITLE: FISCHER MOD. "MVDX" DENTAL X-RAY UNIT ~ C' BALANCE. SPRING SUPPORT PLUG

H. G. FISCHER & CO.
2335 WABANSIA AVE.
CHICAGO. ILL.

CAT. NO.

PART NO. 13912F

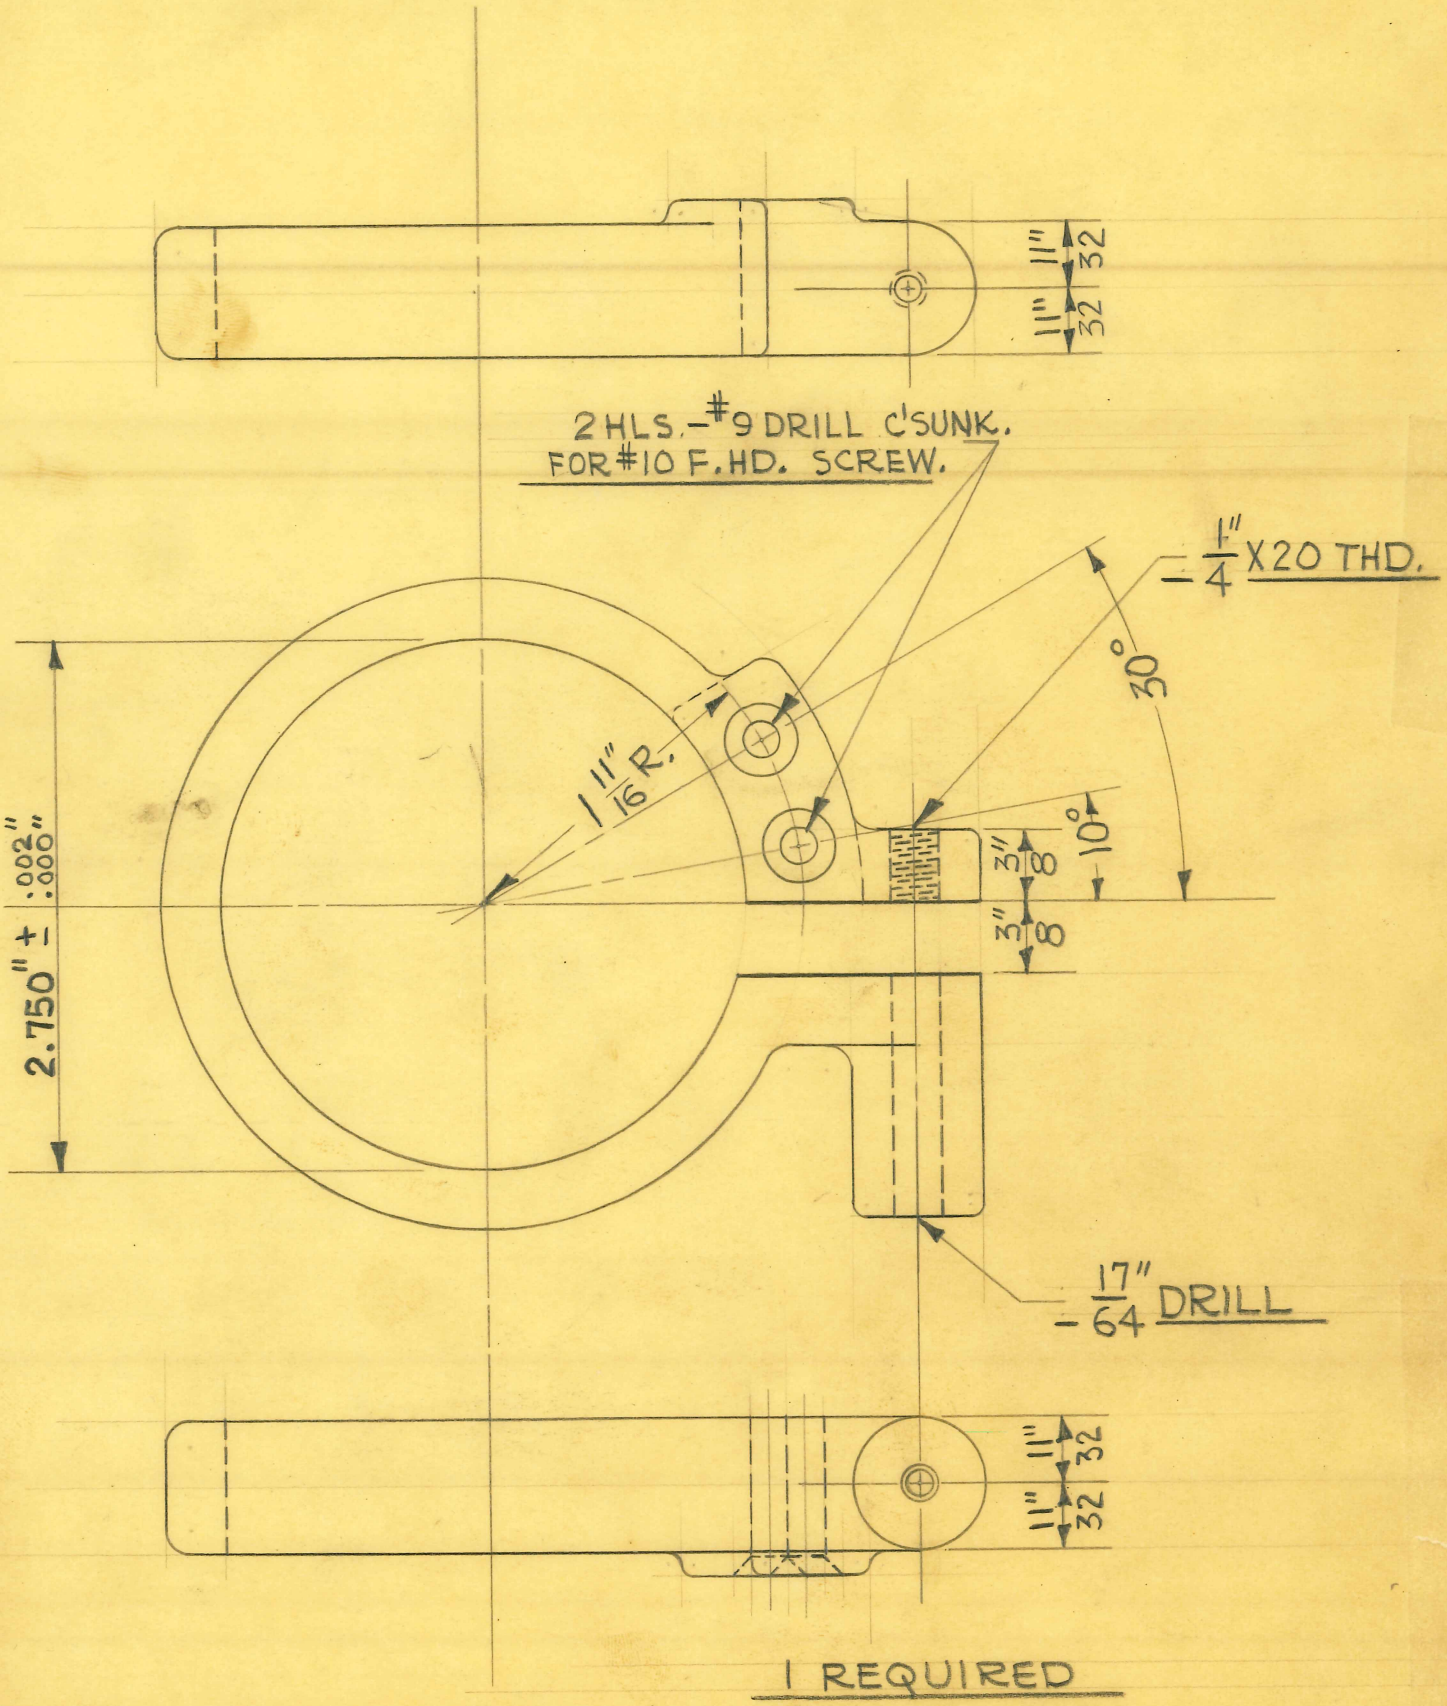

1 REQUIRED

SIZE	80-10-10	ISSUE 1-5-41	J.V.W.
KIND	BRONZE CASTING	CHANGED	
SHAPE		"	
FINISH	PAINTED	"	
TEMP.		"	
PATT.	1854	"	

TITLE: FISCHER MOD. "WVDX" DENTAL X-RAY SWIVEL ARM SUPP. LOCK RING

H. G. FISCHER & CO.
2335 WABANSIA AVE.
CHICAGO, ILL.

CAT. NO.

PART NO. 13913F

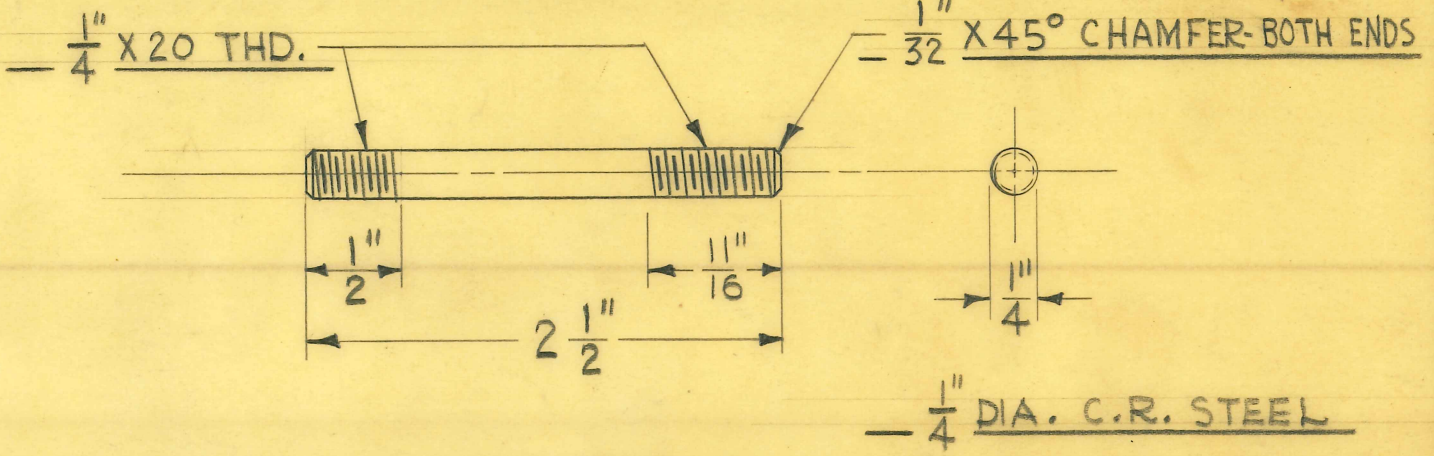

1/4" DIA. C.R. STEEL

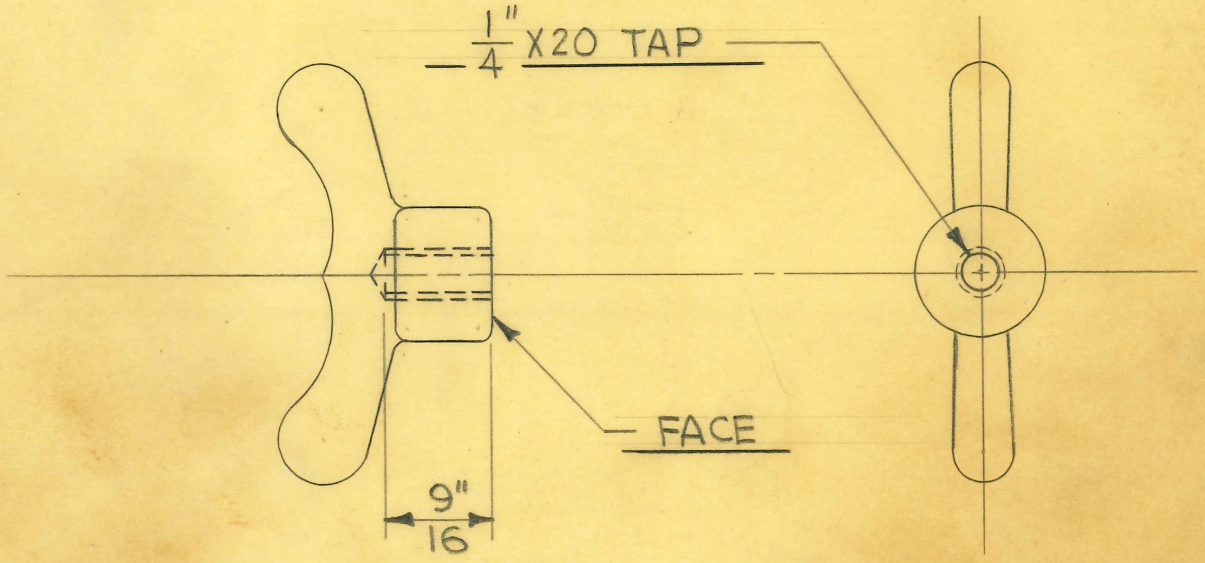

FROM 5705

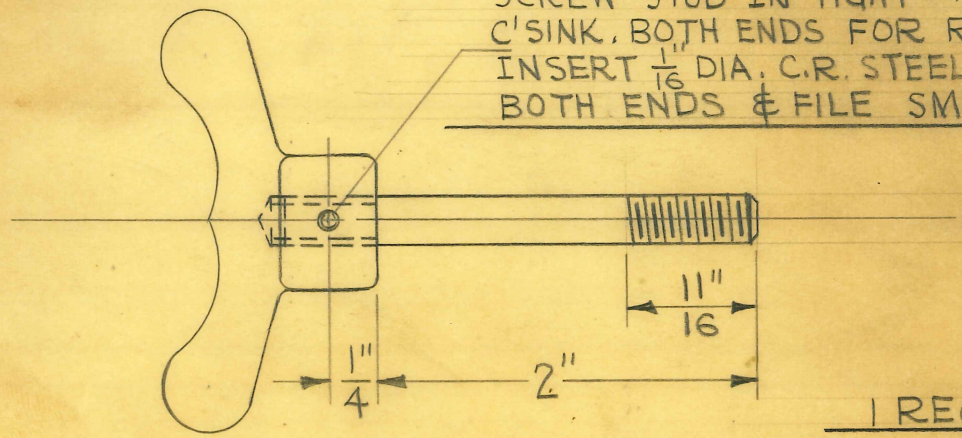

SCREW STUD IN TIGHT - #52 DRILL C'SINK. BOTH ENDS FOR RIVETING. INSERT 1/16" DIA. C.R. STEEL PIN, RIVET BOTH ENDS & FILE SMOOTH.

1 REQUIRED

SIZE		ISSUE 1-5-41	J.V.W.
KIND		CHANGED	
SHAPE		"	
FINISH		"	
TEMP.		"	
PATT.		"	

TITLE:
FISCHER "WVDX" DENTAL X-RAY
SWIVEL ARM SUPP. LOCK RING-WING SCREW

H. G. FISCHER & CO.
2335 WABANSIA AVE.
CHICAGO, ILL.

CAT. NO.

PART NO. 13914G

SECURE LEAD DIAPHRAGM BY FORCING EDGE AGAINST INSIDE EDGE OF DEPRESSION IN ALUMINUM PIECE. (WITH CIRCULAR TOOL IN ARBOR PRESS)

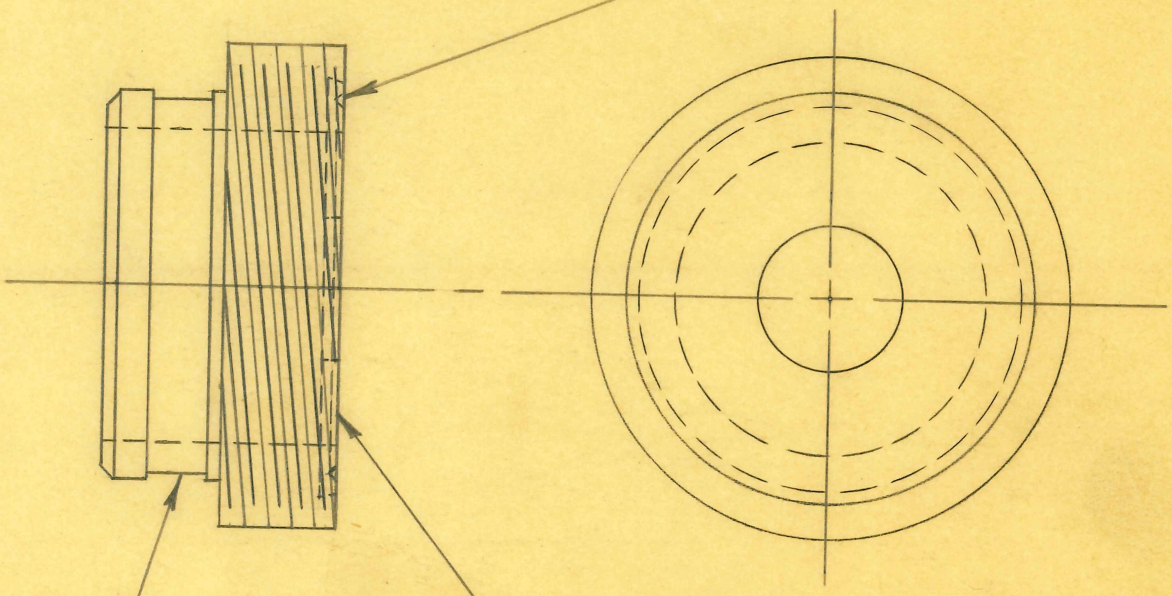

PCE. #13896F

PCE. #13893

SIZE		ISSUE 5-12-47	W.J.
KIND		CHANGED	
SHAPE		"	
FINISH		"	
TEMP.		"	
PATT.		"	

TITLE:
FISCHER DENTAL X-RAY UNIT
12" DENTAL CONE BASE ASSEMBLY

H. G. FISCHER & CO.
2335 WABANSIA AVE.
CHICAGO, ILL.

CAT. NO.

PART NO. 13917G

SECURE LEAD DIAPHRAGM FORCING EDGE AGAINST INSIDE EDGE OF DEPRESSION IN ALUMINUM PIECE. (WITH CIRCULAR TOOL IN ARBOR PRESS)

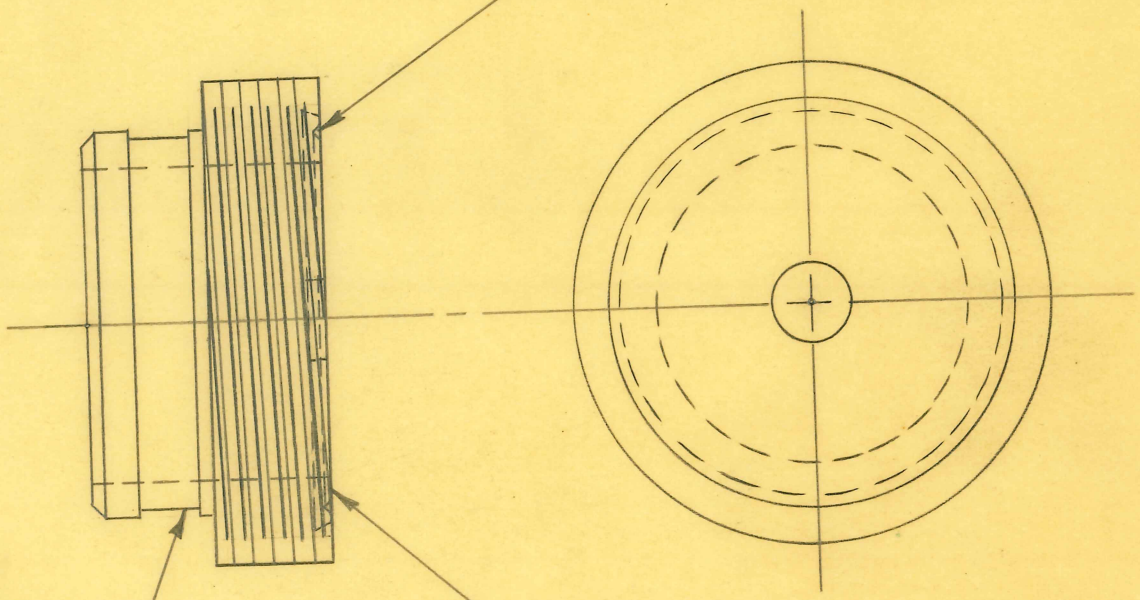

PCE. # 13896F

PCE. # 13897

SIZE		ISSUE 5-12-47	W.J
KIND		CHANGED	
SHAPE		"	
FINISH		"	
TEMP.		"	
		"	

TITLE: FISCHER DENTAL X-RAY UNIT
20" DENTAL CONE BASE ASSEMBLY

H. G. FISCHER & CO.
2338 WABANSIA AVE.
CHICAGO, ILL.

CAT. NO.

PART NO. 13918G

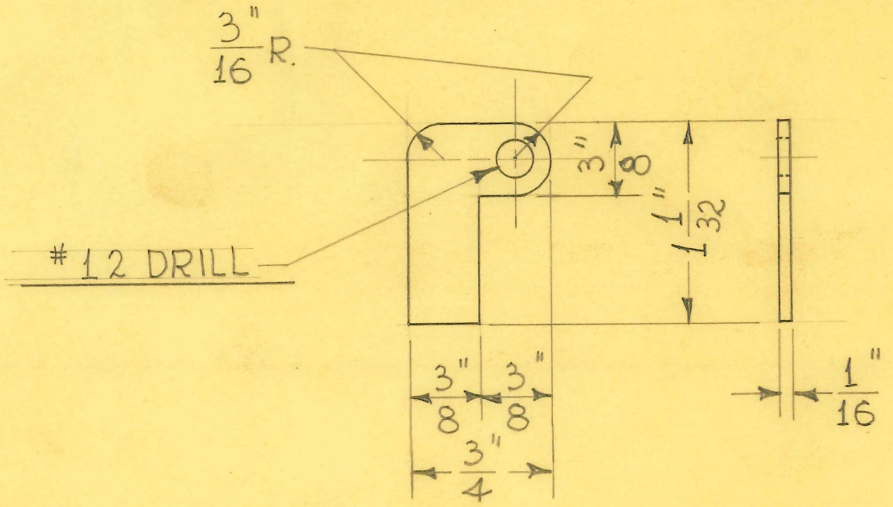

2 REQUIRED

SIZE	1/16" SHEET	ISSUE 11-25-42	
KIND	C.R. STEEL	CHANGED	
SHAPE		"	
FINISH		"	
TEMP.		"	
PATT.		"	

TITLE: ARMY SHOCKPROOF DENTAL X-RAY UNIT- TRANSF. SHIELD BRKT. MTG. (BLANK)

H. G. FISCHER & CO.
2335 WABANSIA AVE.
CHICAGO, ILL.

CAT. NO.

PART NO. 13943

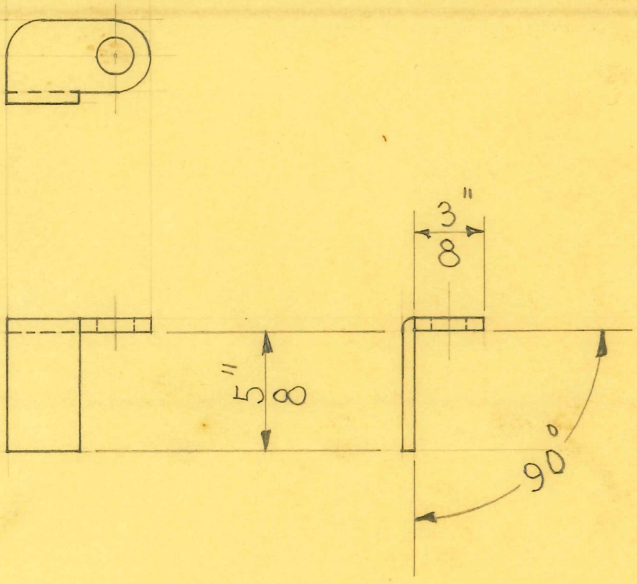

1 REQUIRED

SIZE	FROM 13943	ISSUE 11-25-42	HE.
KIND		CHANGED	
SHAPE		"	
FINISH		"	
TEMP.		"	
PATT.		"	

TITLE: ARMY SHOCKPROOF DENTAL X-RAY UNIT-
TRANSF. SHIELD BRKT. MTG. -(LEFT)

H. G. FISCHER & CO.
2335 WABANSIA AVE.
CHICAGO, ILL.

CAT. NO.

PART NO. 13943F

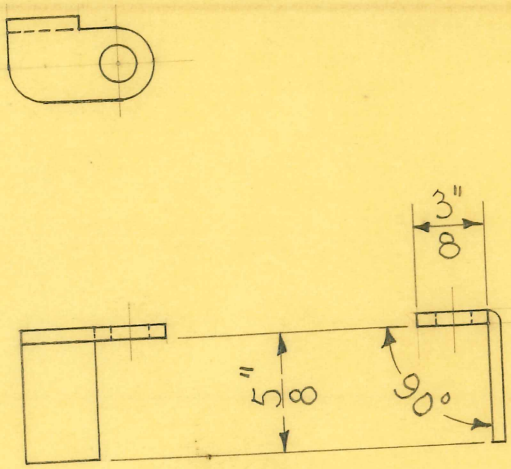

1 REQUIRED

SIZE	FROM 13943	ISSUE 11-25-42	HE.
KIND		CHANGED	
SHAPE		"	
FINISH		"	
TEMP.		"	

TITLE: ARMY SHOCKPROOF DENTAL X-RAY UNIT- TRANSF. SHIELD BRKT. MTG.- (RIGHT)

H. G. FISCHER & CO.
2335 WABANSIA AVE.
CHICAGO, ILL.

CAT. NO.

PART NO. 13944

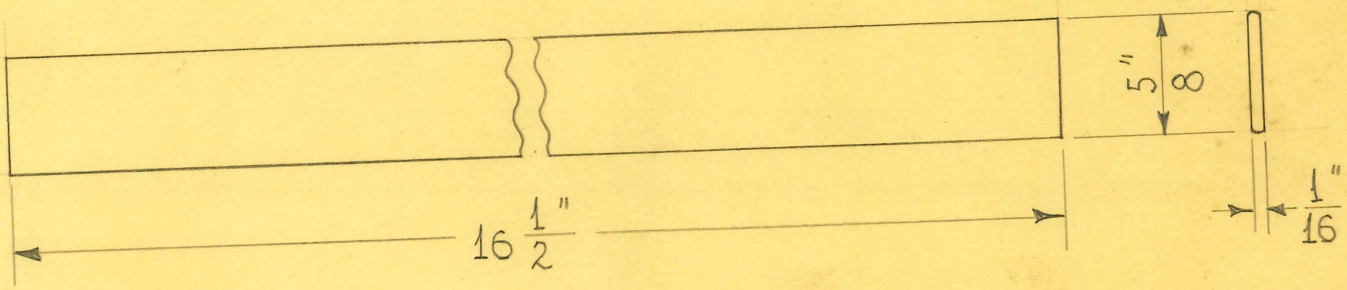

1 REQUIRED

SIZE	5/8" X 1/16"	ISSUE 11-28-42	HE
KIND	FLAT WIRE	CHANGED	
SHAPE		"	
FINISH		"	
TEMP.		"	

TITLE: ARMY SHOCKPROOF DENTAL X-RAY UNIT~ TRANSF. SHIELD BRKT. STRIP

H. G. FISCHER & CO.
2335 WABANSIA AVE.
CHICAGO, ILL.

CAT. NO.

PART NO. 13945

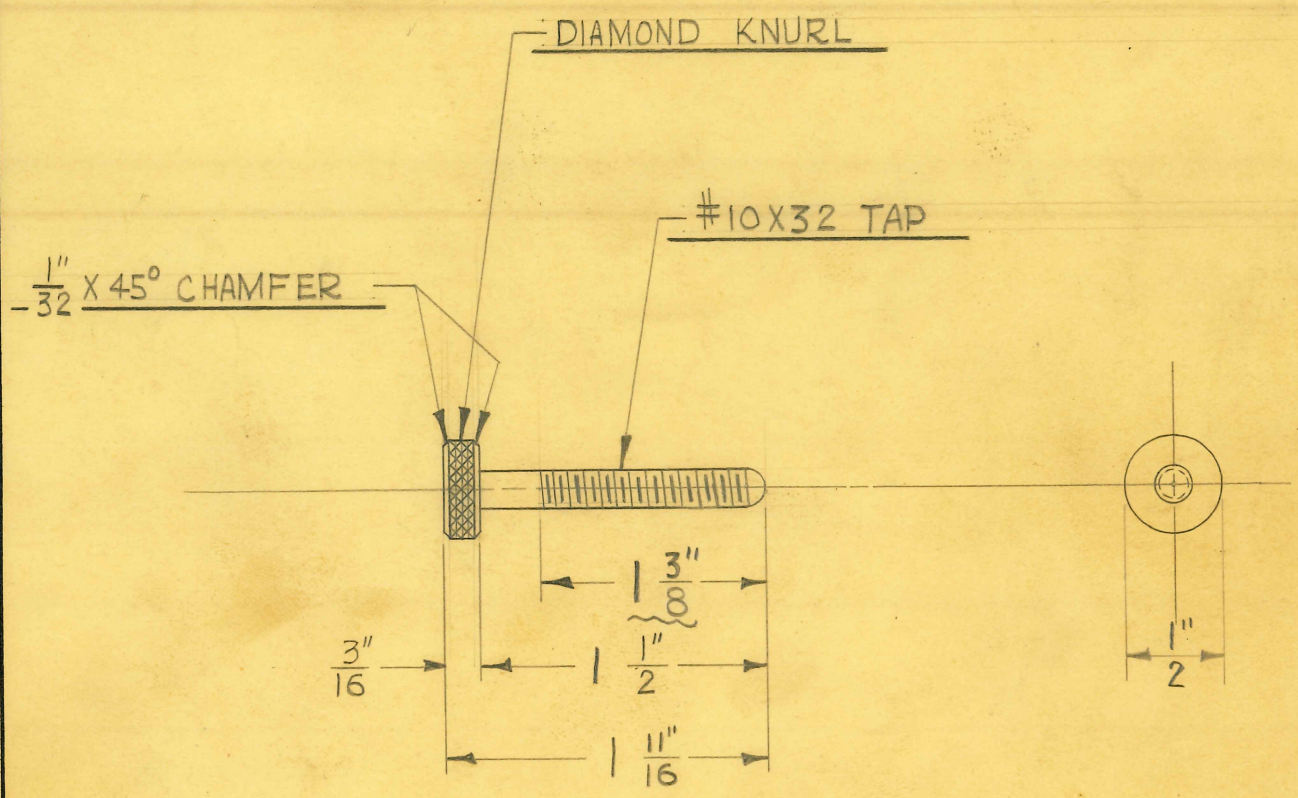

1 REQUIRED

SIZE	1/2" DIA.	ISSUE 4-25-41	J.V.W.
KIND	C.R. STEEL	CHANGED	
SHAPE		"	
FINISH	SATIN CHR. #4	"	
TEMP.		"	
		"	

TITLE:
U.S.NAVY X-RAY UNIT
CONE CLAMP THUMB SCREW

H. G. FISCHER & CO.
2335 WABANSIA AVE.
CHICAGO, ILL.

CAT. NO.

PART NO. 13959

TITLE U.S. NAVY X-RAY UNIT
X-RAY TUBE SHEILD

H. G. FISCHER & CO.
FRANKLIN PARK, ILLINOIS

DATE 3-30-61 DR BY RCT CH'K'D. J.V.W.

PART NO. 13968C

REVISION	DATE	BY

PATTERN | FINISH | SCALE FULL

TOOLS

MATERIAL
2 1/2" O.D. x 2 1/16" +.000" -.030" I.D.
X-RAY PROOF MATERIAL

DIMENSIONS
FRACTIONAL ± .015
DECIMAL ± .005
ANGULAR ± ½°
UNLESS OTHERWISE SPECIFIED

ALLOW FOR FINISH ON ALL SURFACES

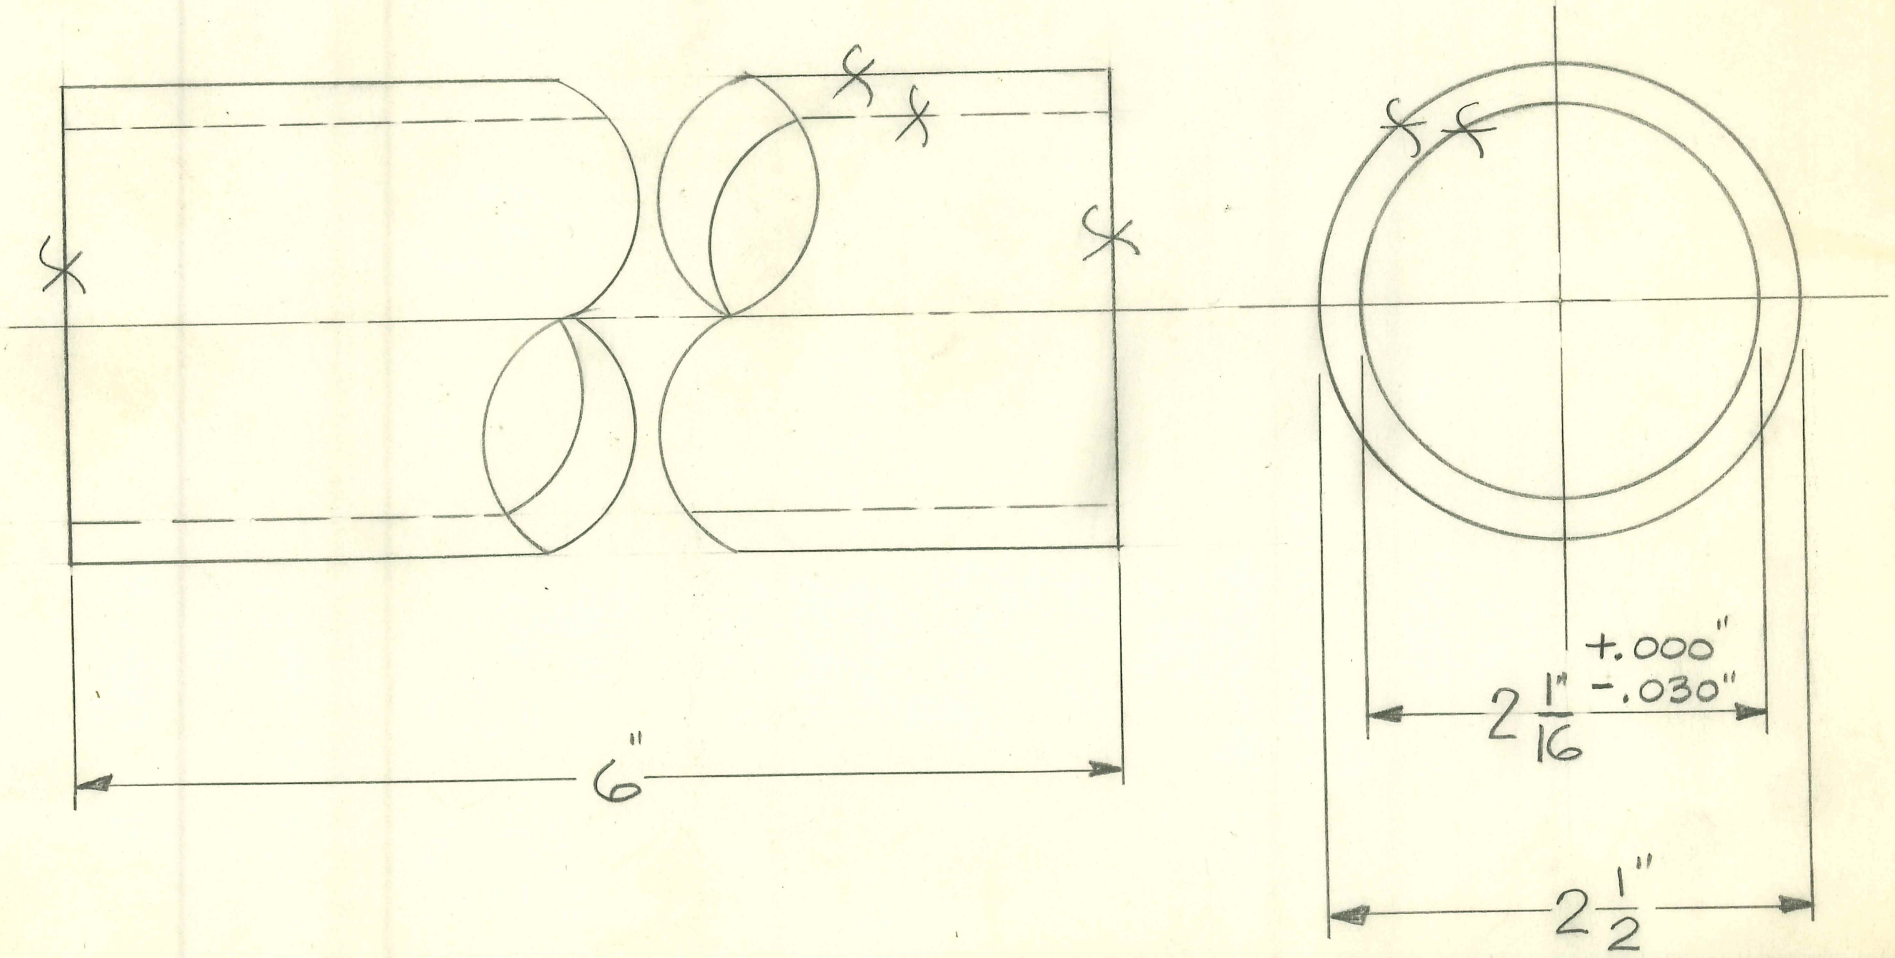

FOLDER # 110

TITLE: FISCHER MOBILE BEDSIDE UNIT
1½ mm. ALUMINUM FILTER

H. G. FISCHER & CO.
FRANKLIN PARK, ILLINOIS

PART NO. 13976

DATE 10-1-51 | DR. BY J.V.W. | CH'K'D.

REVISION	DATE	BY

PATTERN | FINISH | SCALE FULL

TOOLS | MATERIAL .064" x 3 3/4 SHEARED SHEET ALUM.

DIMENSIONS
FRACTIONAL ± .015
DECIMAL ± .005
ANGULAR ± ½°
UNLESS OTHERWISE SPECIFIED

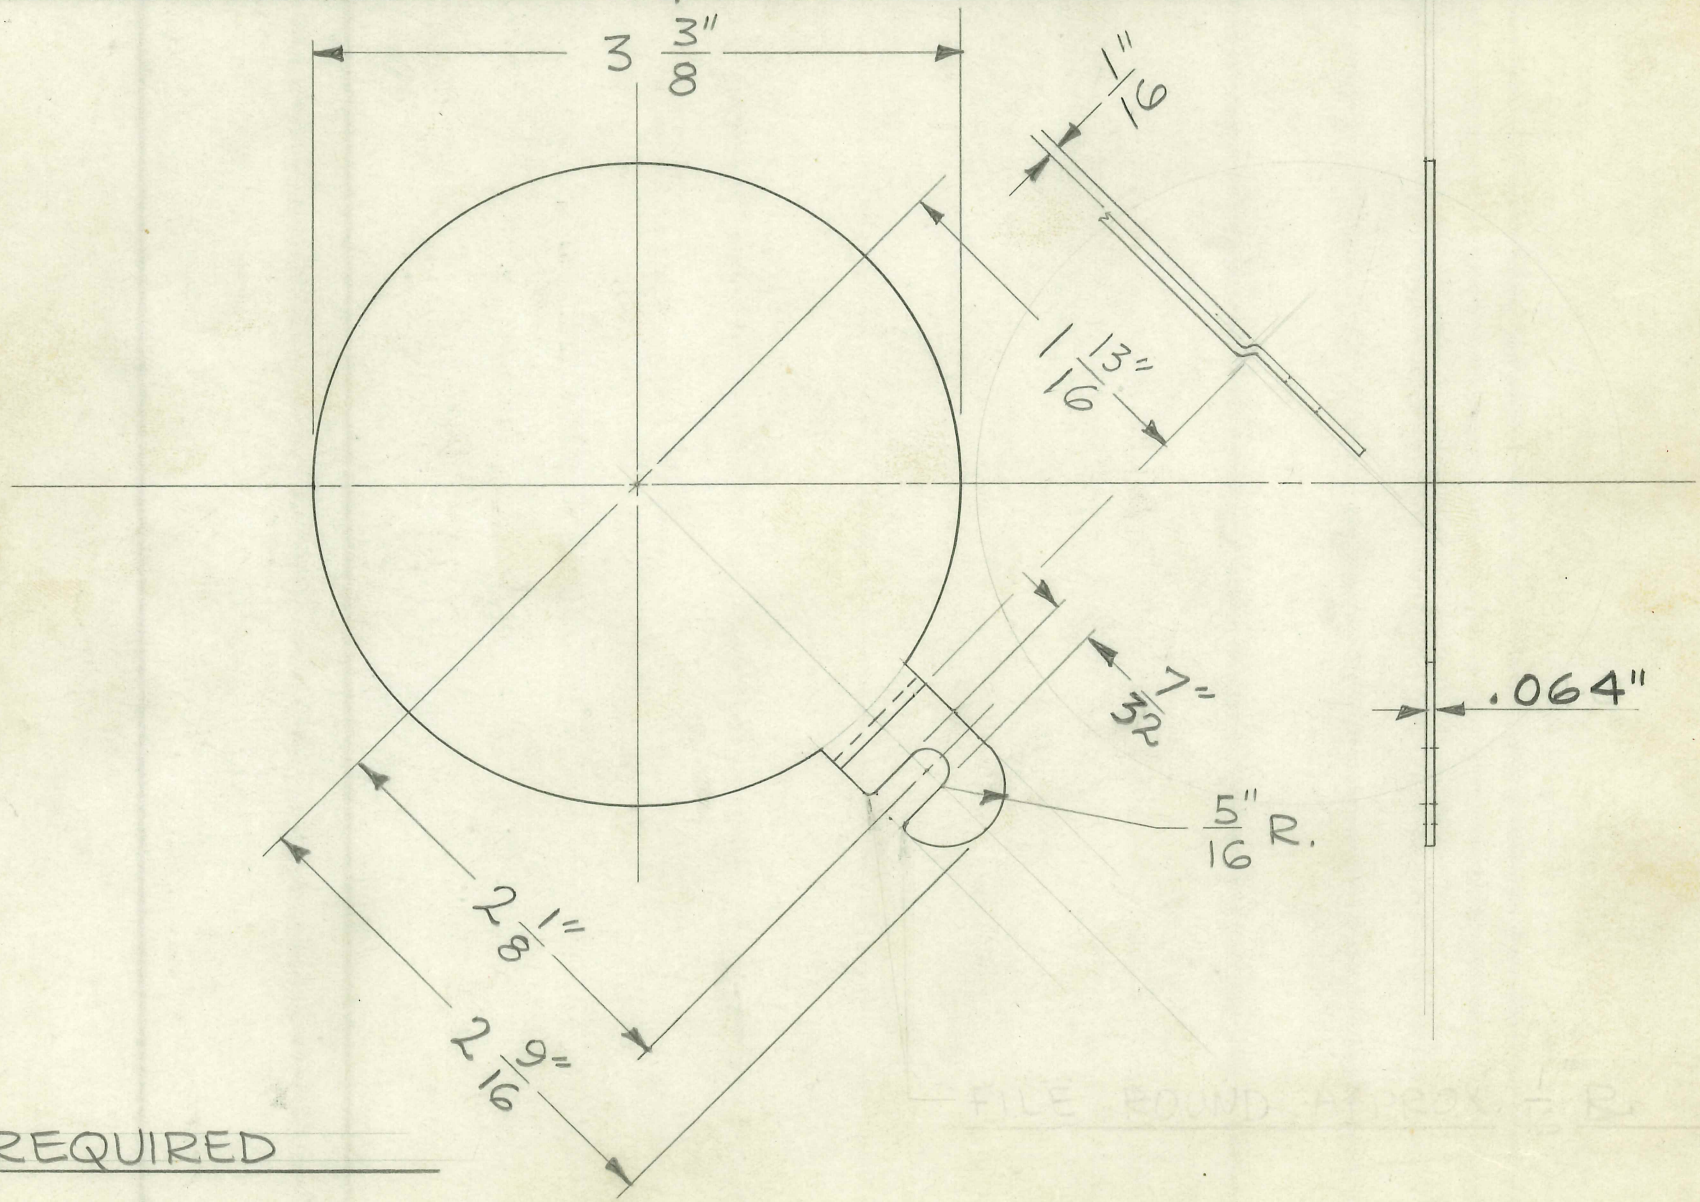

1 REQUIRED

FOLDER #110

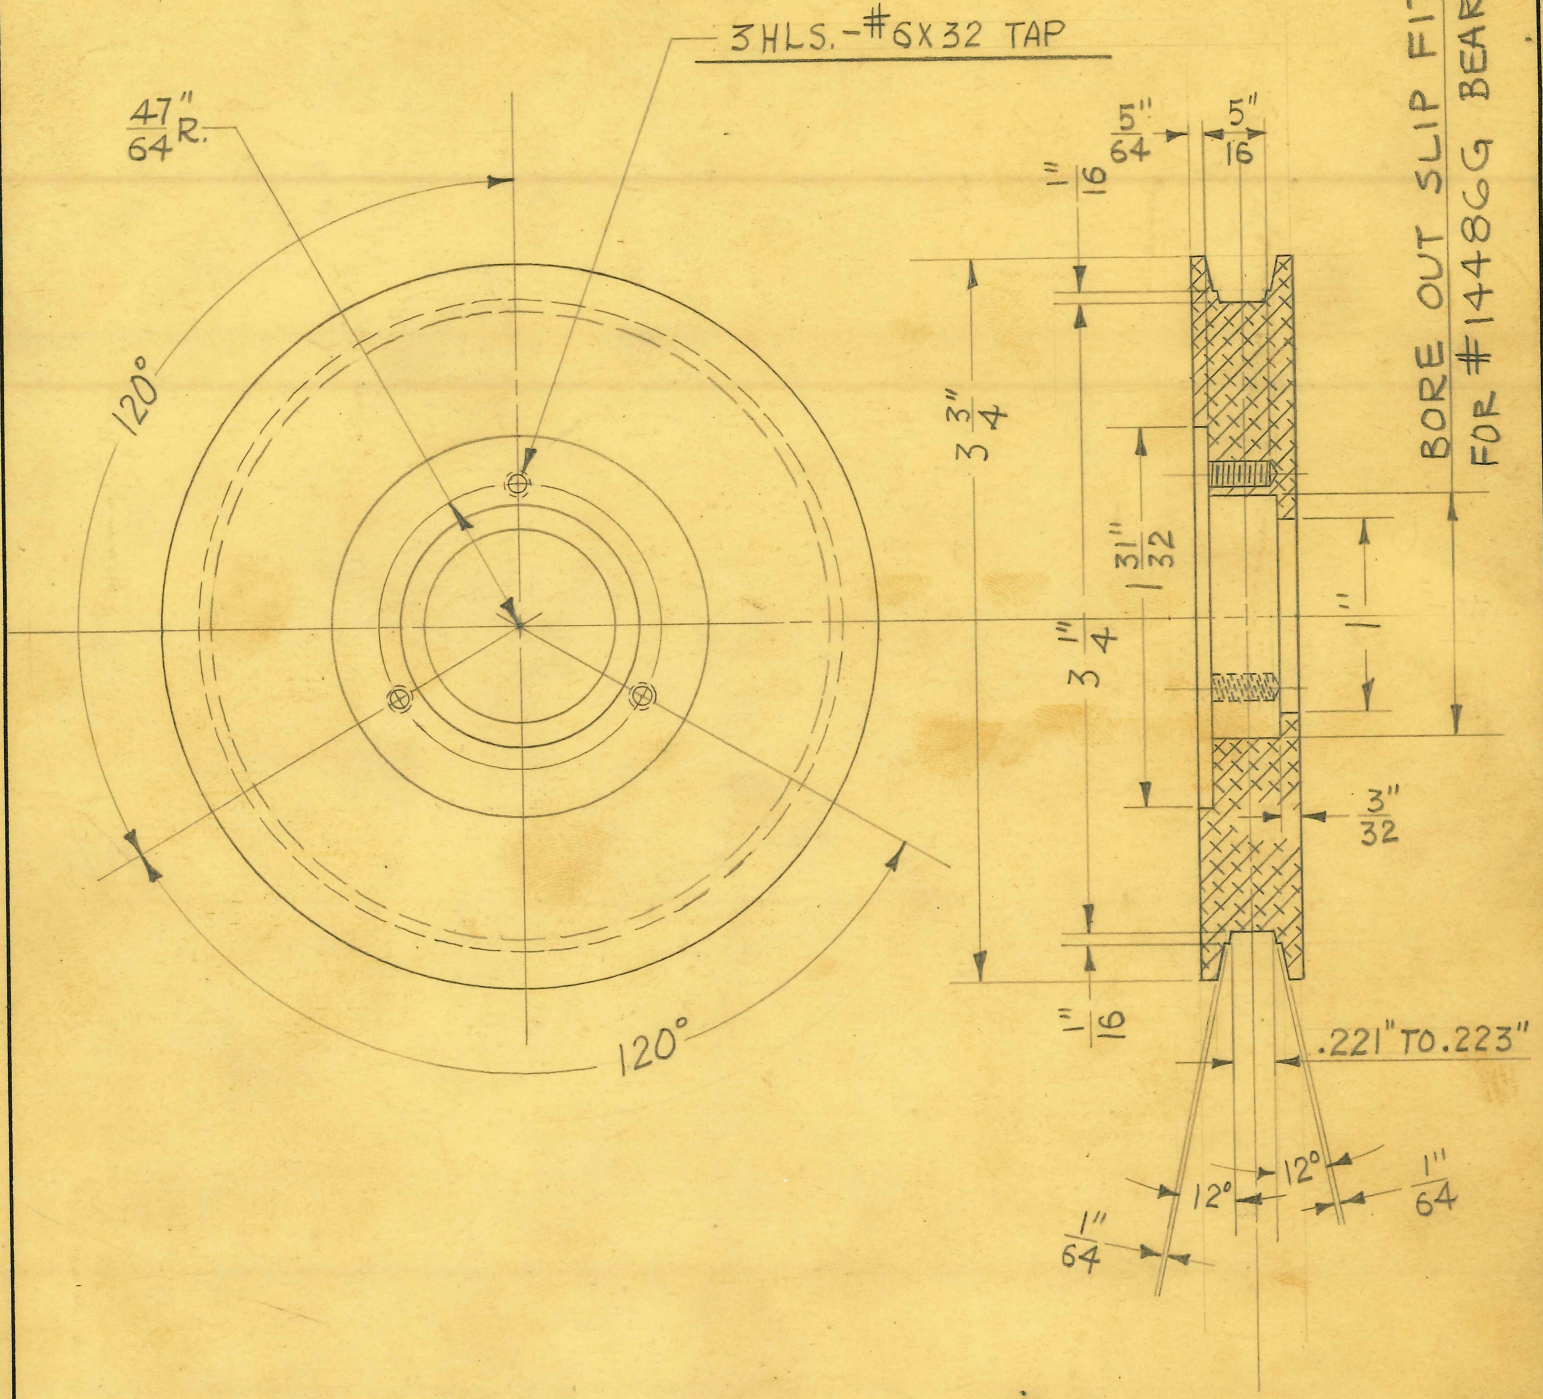

2 REQUIRED

SIZE	IRON	ISSUE 4-4-41	J.V.W.
KIND	CASTING	CHANGED	
SHAPE		"	
FINISH	WH. CHR. #3	"	
TEMP.		"	
PATT.	1722	"	

TITLE:
U.S. NAVY X-RAY UNIT
COUNTERWEIGHT PULLEY

H. G. FISCHER & CO.
2335 WABANSIA AVE.
CHICAGO, ILL.

CAT. NO.

PART NO. 14006F

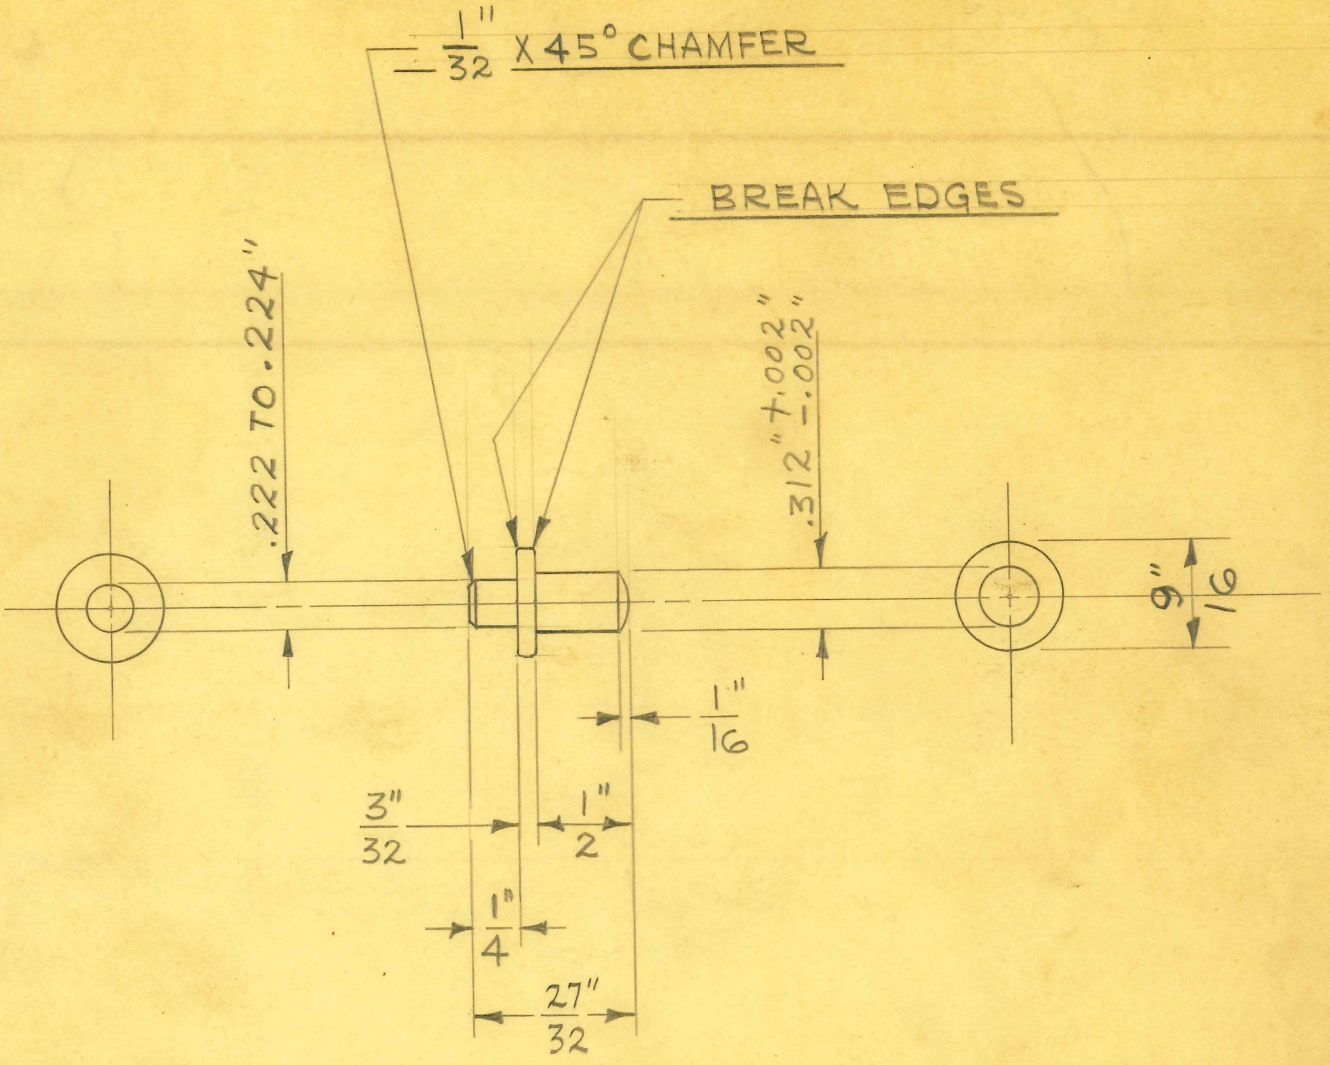

2 REQUIRED

SIZE	9/16" DIA.	ISSUE 8-21-46	J.V.W.	**TITLE:** FISCHER "TV-30-96" X-RAY UNIT LEAD LINED CABINET - DOOR HINGE PIN
KIND	C.R. STEEL	CHANGED		
SHAPE		"		
FINISH		"		
TEMP.		"		
PATT.		"		

H. G. FISCHER & CO.
2335 WABANSIA AVE.
CHICAGO, ILL.

CAT. NO.

PART NO. 14032

TITLE: FISCHER MOBILE BEDSIDE UNIT
LEAD DIAPHRAGM FOR 1.5" DIA. CIRCLE

H. G. FISCHER & CO.
FRANKLIN PARK, ILLINOIS

PART NO. 14058

DATE 5-21-51 | DR. BY J.V.W. | CH'K'D.

REVISION	DATE	BY

PATTERN | FINISH | SCALE FULL

TOOLS
PERF. DIE #7660 (P-7)
INSERT & PUNCH # 11586

MATERIAL
FROM #13465

DIMENSIONS
FRACTIONAL ± .015
DECIMAL ± .005
ANGULAR ± ½°
UNLESS OTHERWISE SPECIFIED

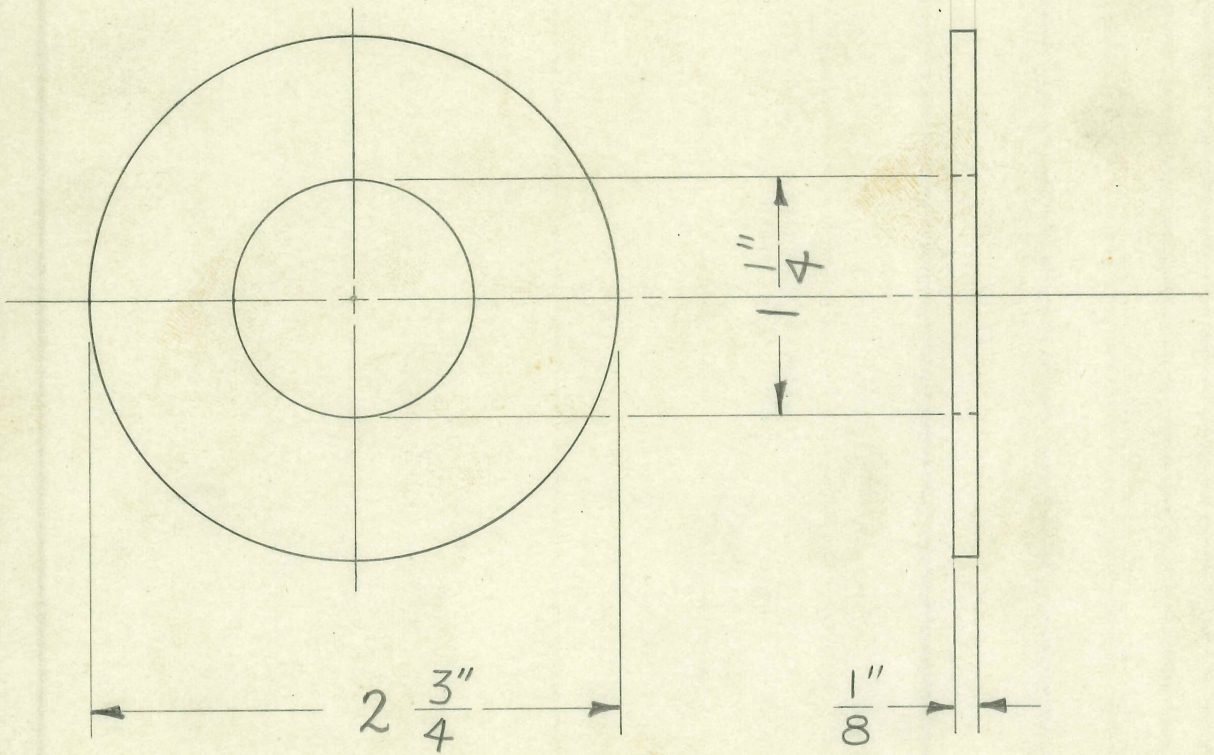

1 REQUIRED

FOLDER #110

TITLE FISCHER "ANM" X-RAY UNIT TRANSF. PANEL X-RAY WINDOW	H. G. FISCHER & CO. FRANKLIN PARK, ILLINOIS		PART NO. 14088
	DATE 2-26-52	DR. BY J.V.W.	CH'K'D.
PATTERN	FINISH	SCALE FULL	DIMENSIONS FRACTIONAL ± .015 DECIMAL ± .005 ANGULAR ± ½° UNLESS OTHERWISE SPECIFIED
TOOLS	MATERIAL $\frac{1}{8}$" SHEET CLEAR POLYSTYRENE		

REVISION	DATE	BY

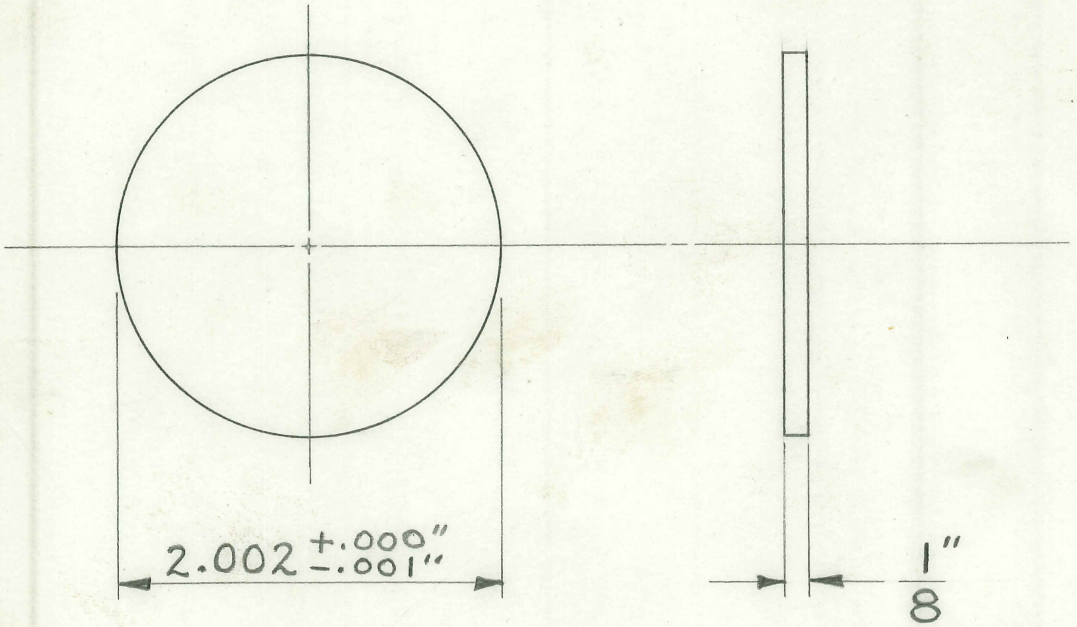

1 REQUIRED

TITLE FISCHER "A.N.M." X-RAY

X-RAY SHIELD CONE

H. G. FISCHER & CO.
FRANKLIN PARK, ILLINOIS

PART NO. 14092

DATE 2-22-52 | DR. BY W.J. | CH'K'D. J.V.W.

REVISION	DATE	BY

PATTERN | FINISH | SCALE FULL

TOOLS | MATERIAL FROM 13964 1/2 F

DIMENSIONS
FRACTIONAL ± .015
DECIMAL ± .005
ANGULAR ± ½°
UNLESS OTHERWISE SPECIFIED

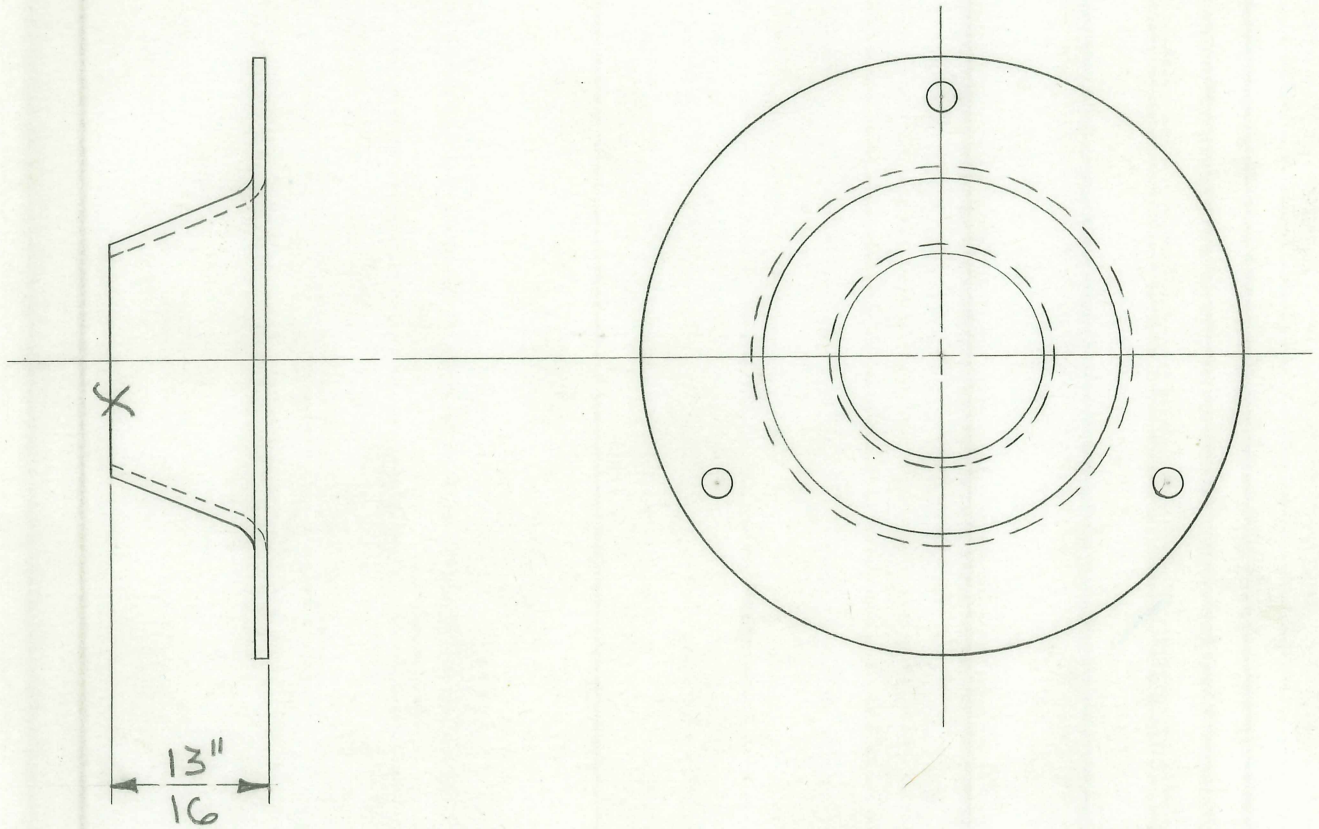

1 REQUIRED

TITLE: FISCHER "ANM" X-RAY 15" CONE BASE

H. G. FISCHER & CO.
FRANKLIN PARK, ILLINOIS

PART NO. 14096

DATE 5-13-52 DR. BY J.N.W. CH'K'D.

REVISION	DATE	BY

PATTERN

FINISH CAD. #23

SCALE FULL

TOOLS: DRILL JIG # 11727

MATERIAL: $3\frac{3}{8}$" DIA. BRASS ROD

DIMENSIONS
FRACTIONAL ± .015
DECIMAL ± .005
ANGULAR ± ½°
UNLESS OTHERWISE SPECIFIED

4 HLS. $\frac{1}{8}$" DRILL – $\frac{5}{16}$" C'BORE, BOTTOM SIDE $\frac{1}{16}$" DEEP

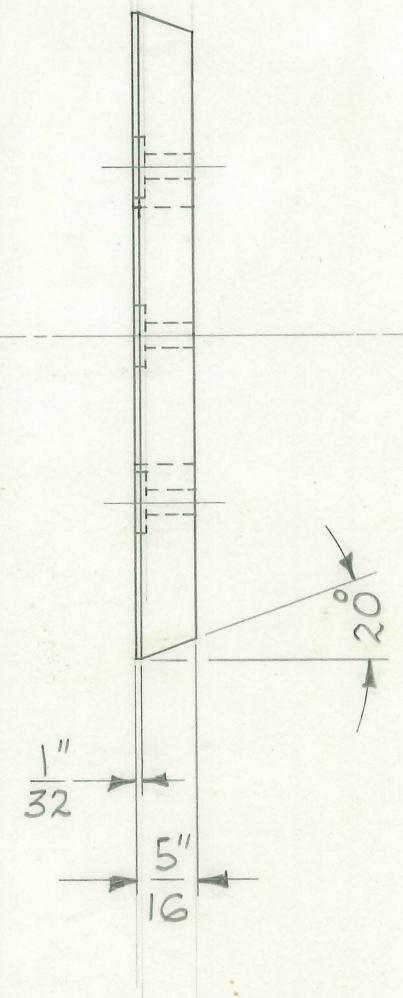

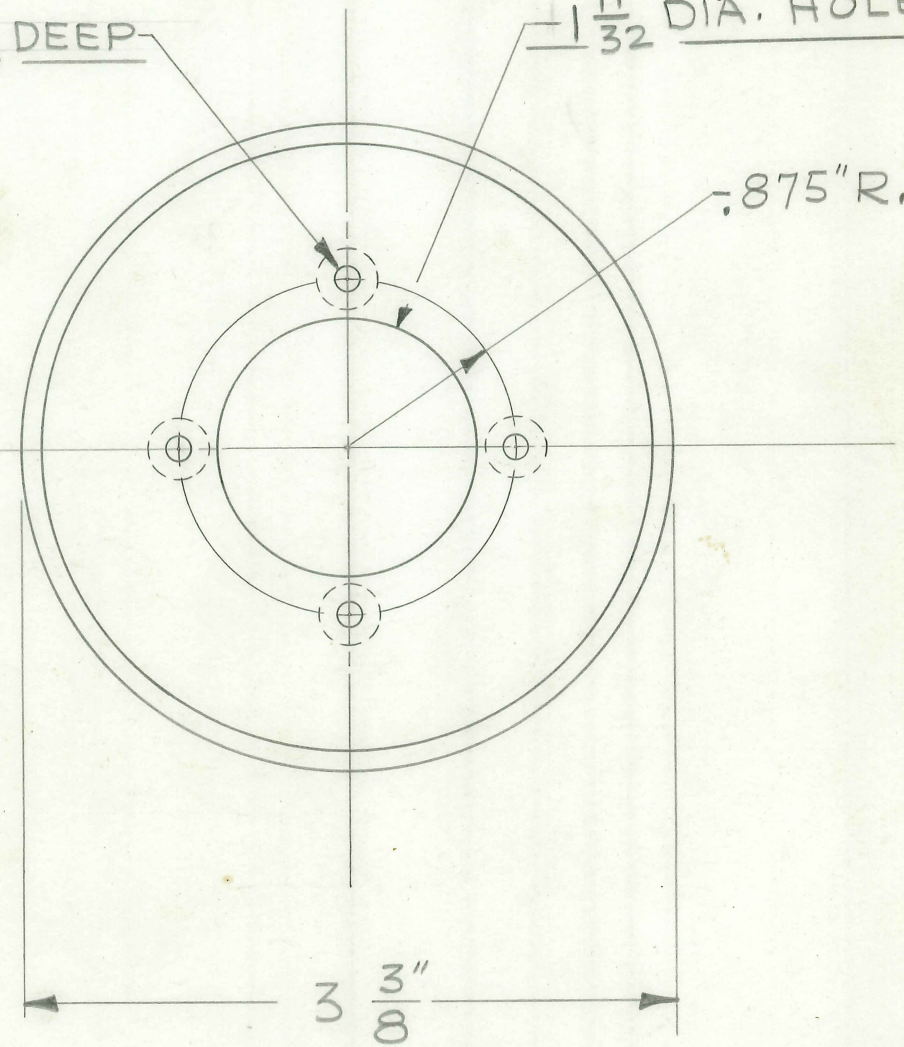

1 REQUIRED

TITLE FISCHER "ANM" X-RAY
9" CONE BASE

H. G. FISCHER & CO.
FRANKLIN PARK, ILLINOIS

PART NO. 14097

DATE 5-13-52 | DR. BY J.V.W. | CH'K'D.

REVISION	DATE	BY

PATTERN | FINISH CAD. #23 | SCALE FULL

TOOLS: DRILL JIG # 11726

MATERIAL: $3\frac{3}{8}$" DIA. BRASS ROD

DIMENSIONS UNLESS OTHERWISE SPECIFIED
FRACTIONAL ± .015
DECIMAL ± .005
ANGULAR ± ½°

4 HLS. - $\frac{1}{8}$" DRILL - $\frac{5}{16}$" C'BORE. BOTTOM SIDE $\frac{1}{16}$" DEEP

$\frac{13}{16}$" DIA. HOLE.

.625" R.

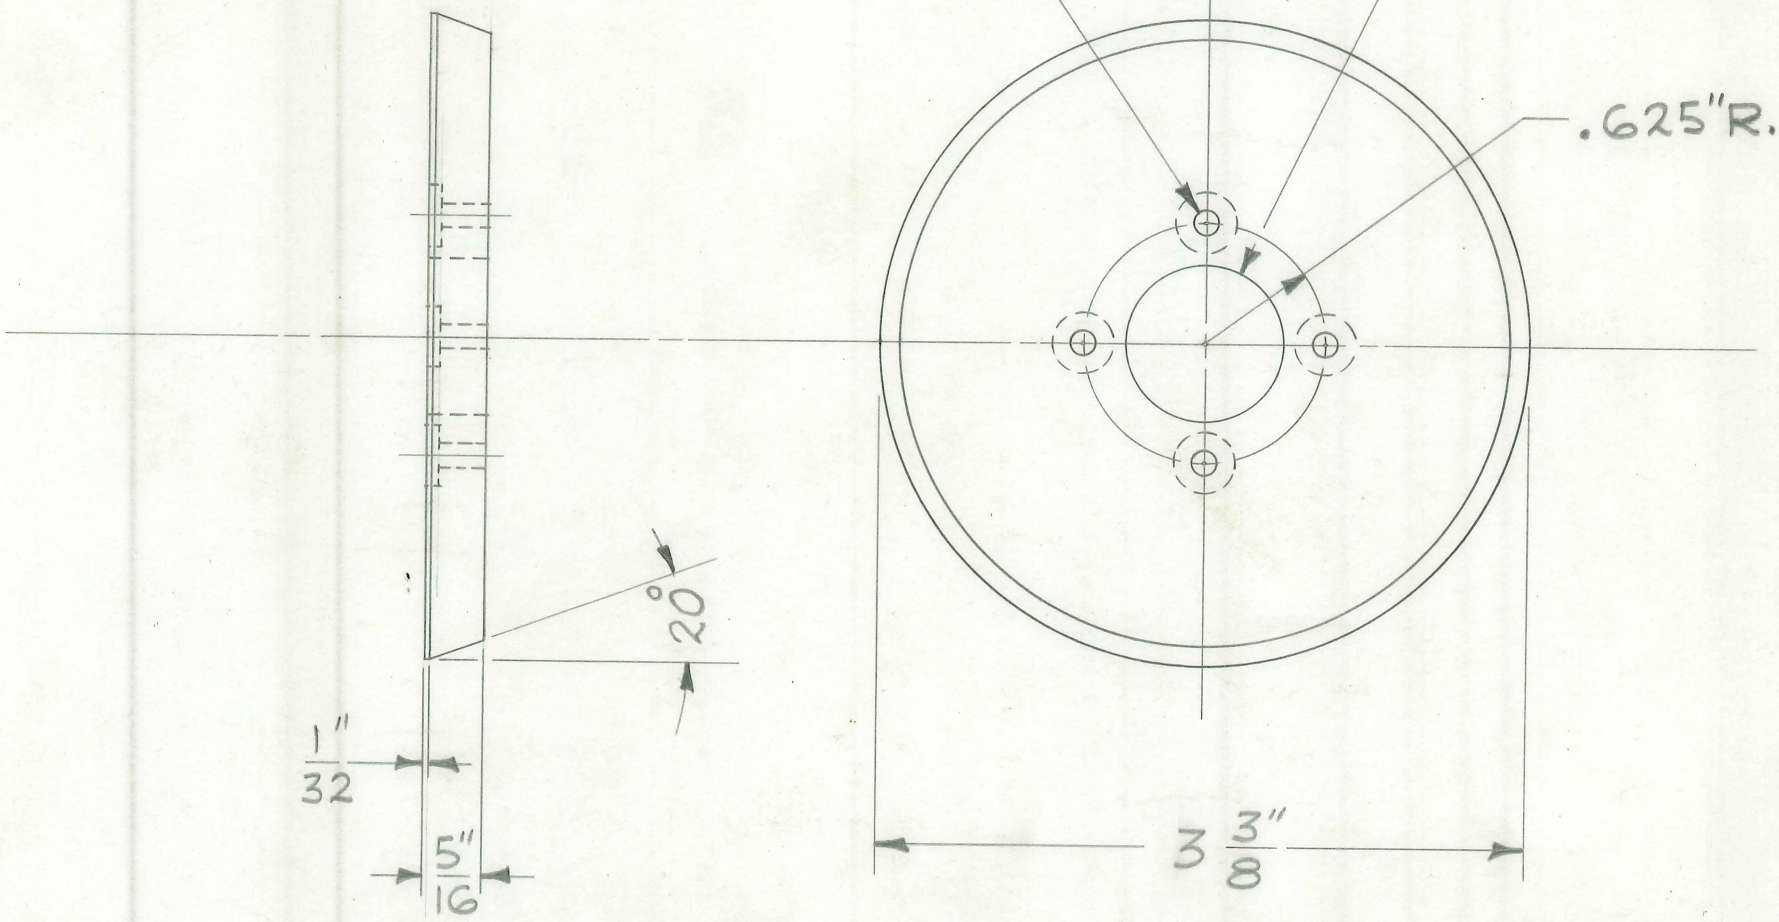

1 REQUIRED

TITLE FISCHER "ANM" X-RAY CWT. PULLEY BUSHING

H. G. FISCHER & CO.
FRANKLIN PARK, ILLINOIS

PART NO. 14099

DATE 5-26-52 DR. BY J.V.W. CH'K'D.

REVISION	DATE	BY

PATTERN | FINISH | SCALE FULL

TOOLS | MATERIAL $1\frac{1}{4}$" DIA. BRASS ROD

DIMENSIONS
FRACTIONAL ± .015
DECIMAL ± .005
ANGULAR ± ½°
UNLESS OTHERWISE SPECIFIED

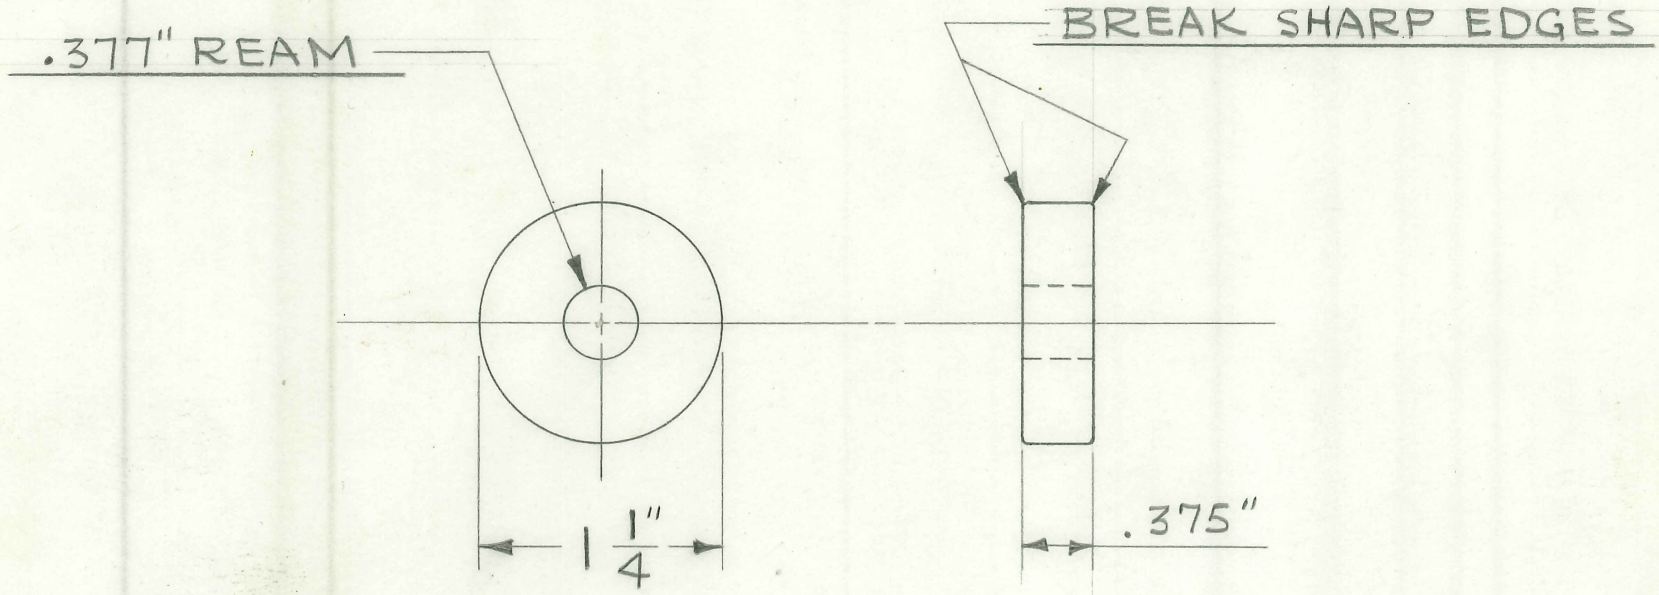

1 REQUIRED

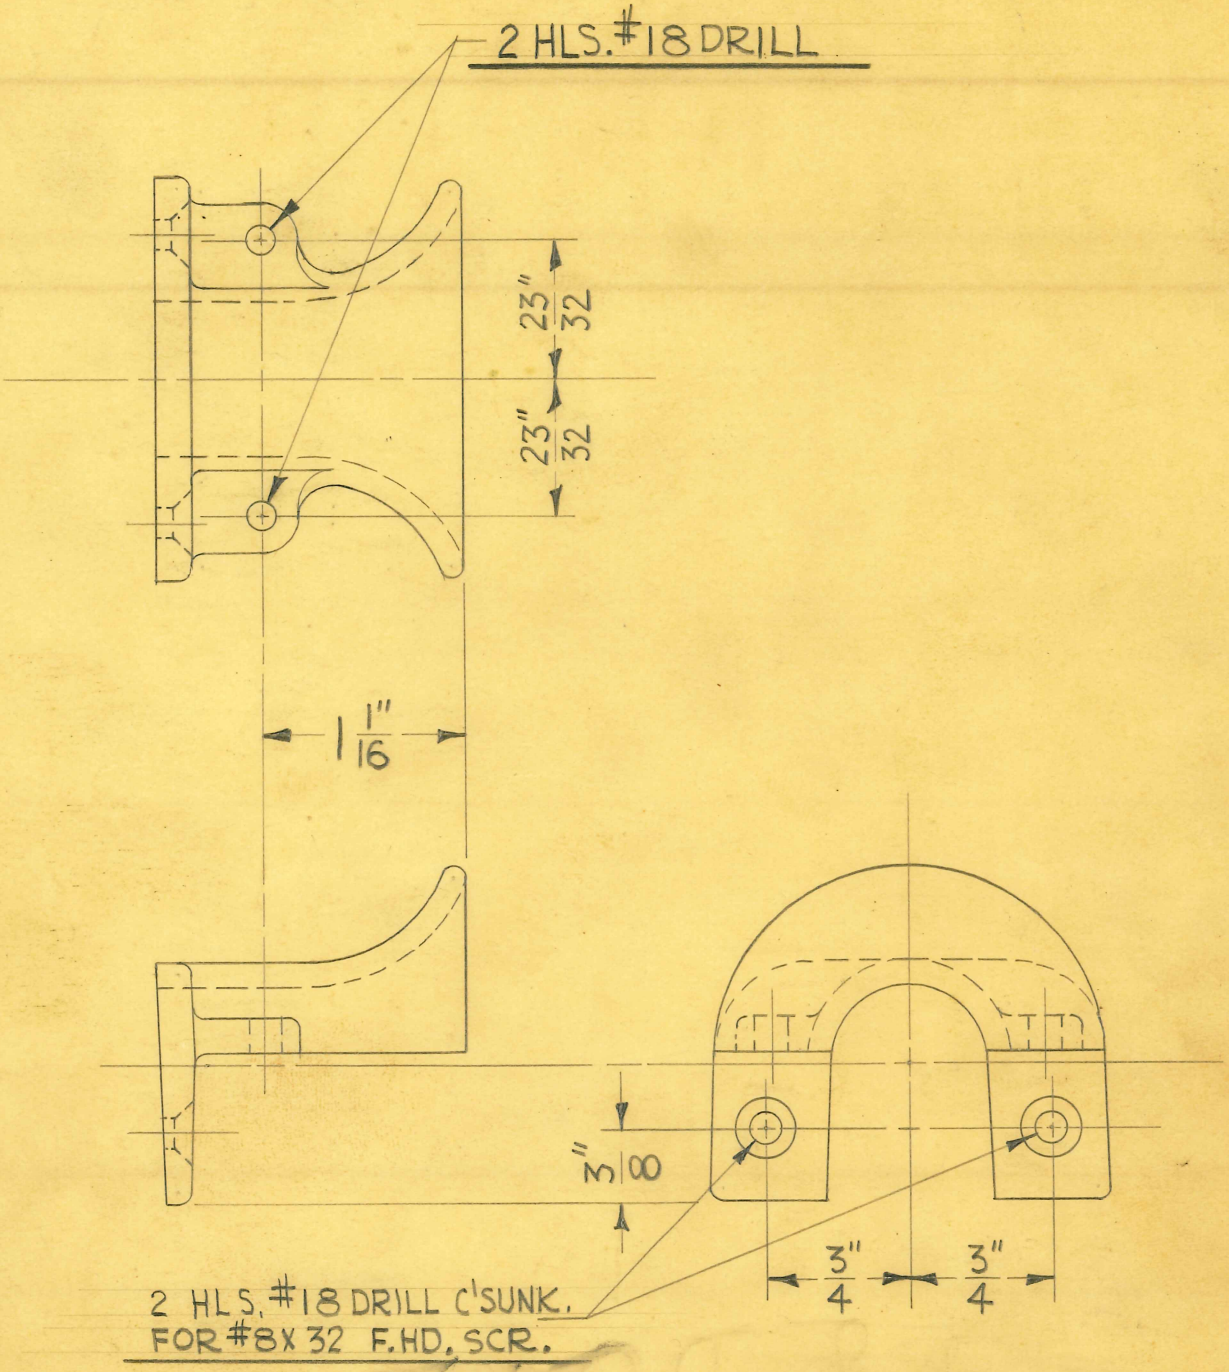

1 REQUIRED

RS.

SIZE	#12	ISSUE 8-15-41	J.V.W.
KIND	ALUMINUM	CHANGED	
SHAPE	CASTING	"	
FINISH	PAINTED	"	
TEMP.		"	
PATT.	1795	"	

TITLE:
U.S. NAVY X-RAY UNIT - CONTROL BOX
CABLE SUPPORT

H. G. FISCHER & CO.
2335 WABANSIA AVE.
CHICAGO, ILL.

CAT. NO.

PART NO. 14102F

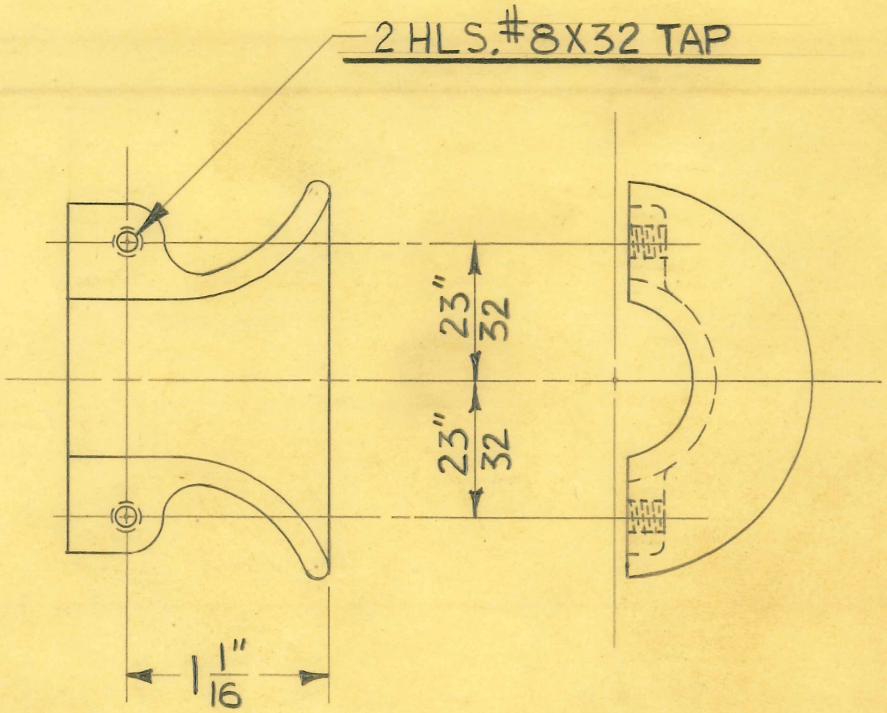

1 REQUIRED

R.S.

SIZE		ISSUE 8-18-41	J.V.W.
KIND	#12 ALUMINUM	CHANGED	
SHAPE		"	
FINISH	PAINTED	"	
TEMP.		"	
PATT.	1794	"	

TITLE: U.S. NAVY X-RAY UNIT-CONTROL BOX CABLE SUPPORT CLAMP

H. G. FISCHER & CO.
2335 WABANSIA AVE.
CHICAGO, ILL.

CAT. NO.

PART NO. 14103F

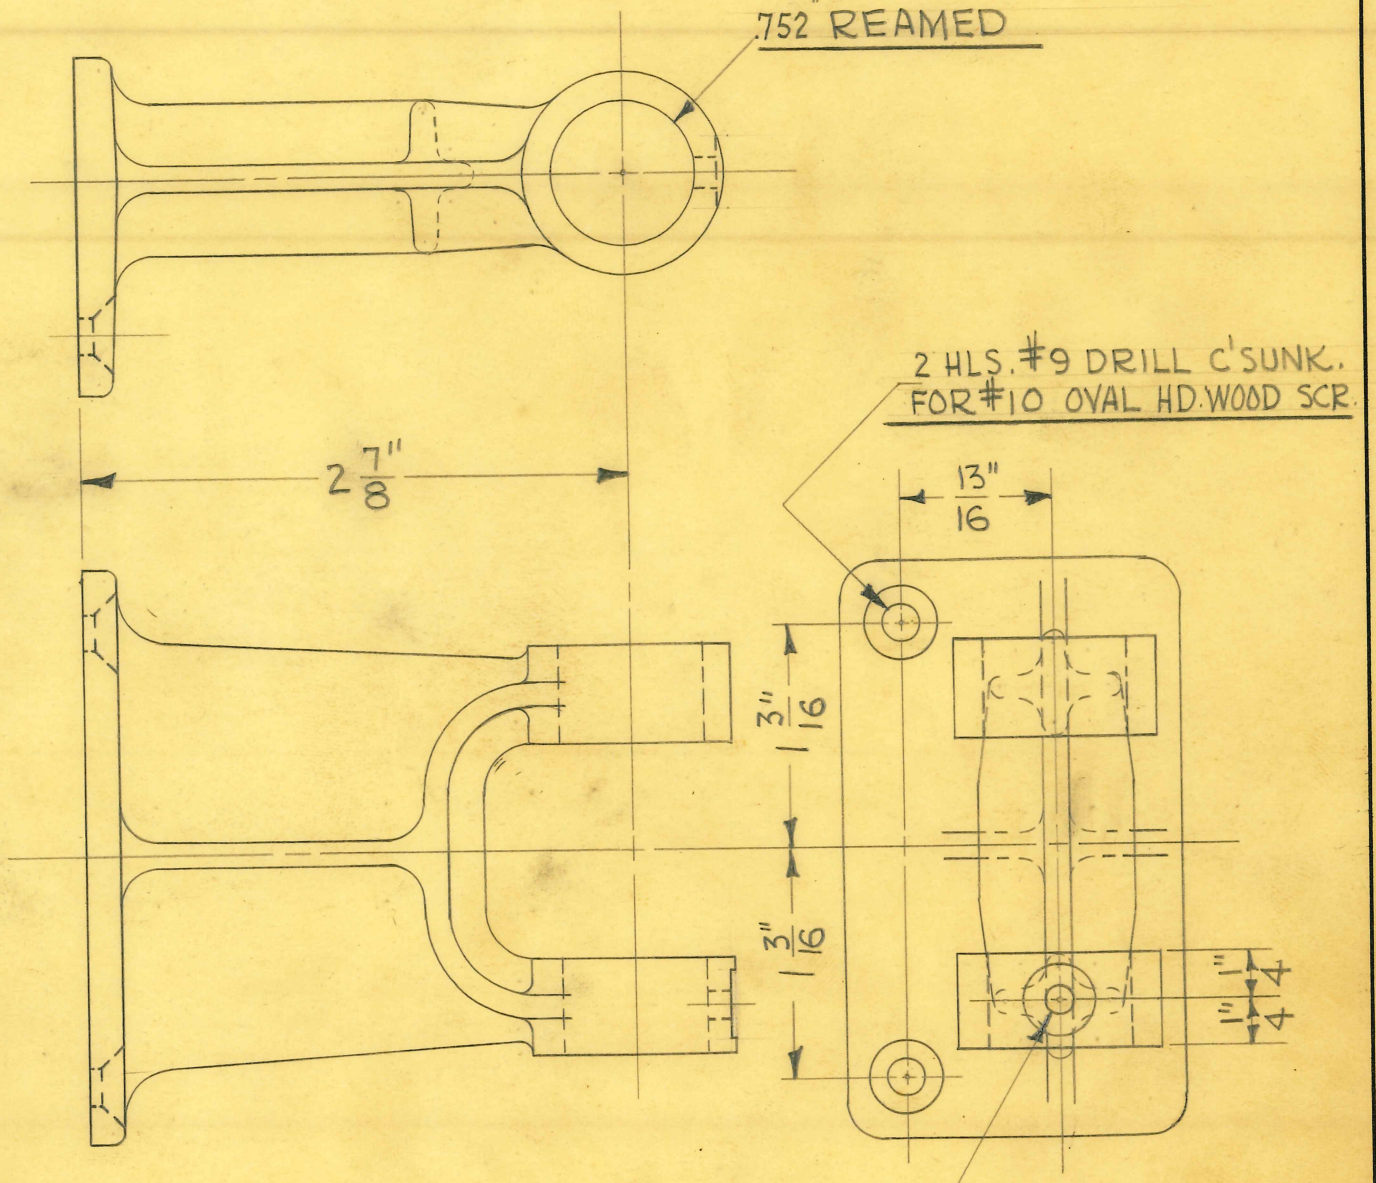

2 REQUIRED

SIZE	IRON	ISSUE 9-11-41	J.V.W.
KIND	CASTING	CHANGED	
SHAPE		"	
FINISH	PAINTED	"	
TEMP.		"	
PATT.	1152	"	

TITLE: TILTING CASSETTE & GRID HOLDER SUPPORT BRACKET - RIGHT

H. G. FISCHER & CO.
2335 WABANSIA AVE.
CHICAGO, ILL.

CAT. NO.

PART NO. 14277

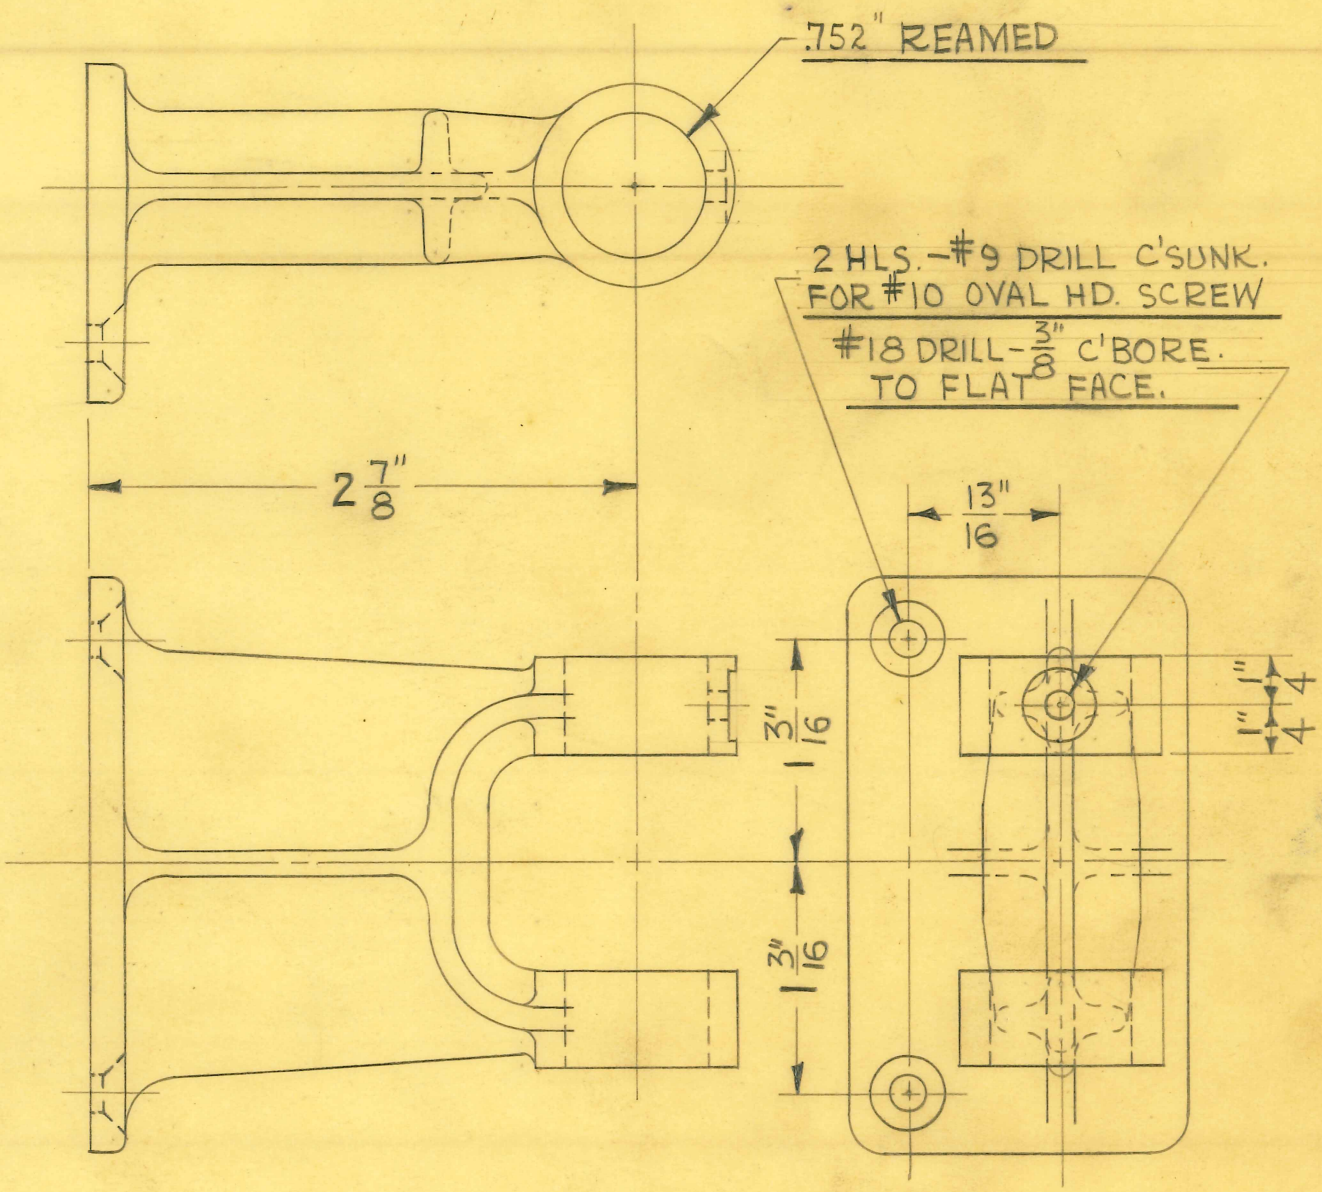

2 REQUIRED

SIZE	IRON	ISSUE 9-11-41	J.V.W.
KIND	CASTING	CHANGED	
SHAPE		"	
FINISH	PAINTED	"	
TEMP.		"	
PATT.	1152	"	

TITLE: TILTING CASSETTE & GRID HOLDER SUPPORT BRACKET - LEFT

H. G. FISCHER & CO.
2335 WABANSIA AVE.
CHICAGO, ILL.

CAT. NO.

PART NO. 14278

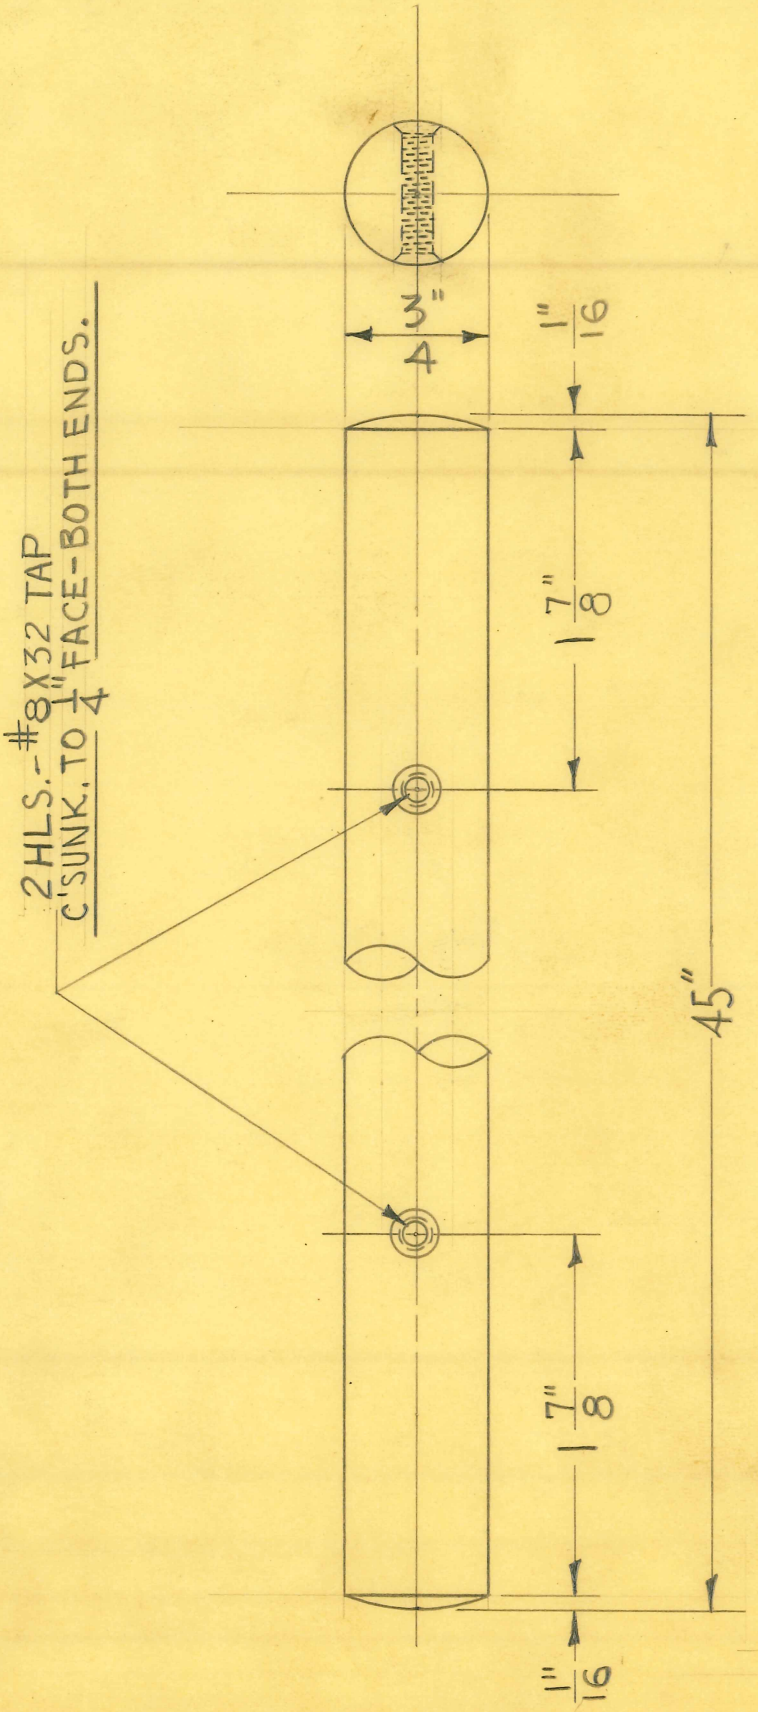

2 REQUIRED

SIZE	3/4" DIA.	ISSUE 9-11-41	J.V.W.
KIND	C.R. STEEL	CHANGED	
SHAPE	ROD	"	
FINISH	SATIN CHR. #4	"	
TEMP.		"	
PATT.		"	

TITLE: TILTING CASSETTE & GRID HOLDER SLIDE ROD

H. G. FISCHER & CO.
2335 WABANSIA AVE.
CHICAGO, ILL.

CAT. NO.

PART NO. 14279

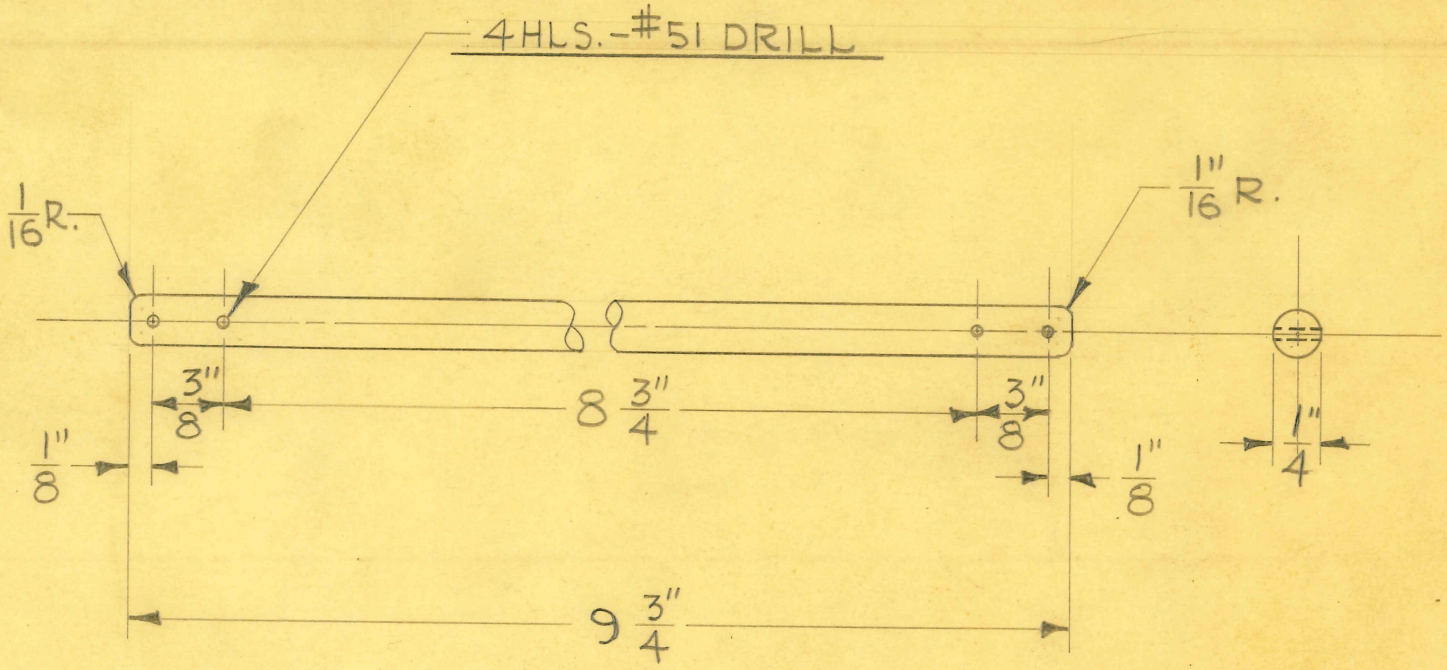

1 REQUIRED

RS

SIZE	1/4" DIA.	ISSUE 9-9-41	J.V.W.
KIND	C.R. STEEL	CHANGED	
SHAPE	ROD	"	
FINISH	CAD. #23	"	
TEMP.		"	
PATT.		"	

TITLE: TILTING CASSETTE & GRID HOLDER CASE SWIVEL ROD - LOWER

H. G. FISCHER & CO.
2335 WABANSIA AVE.
CHICAGO, ILL.

CAT. NO.

PART NO. 14282

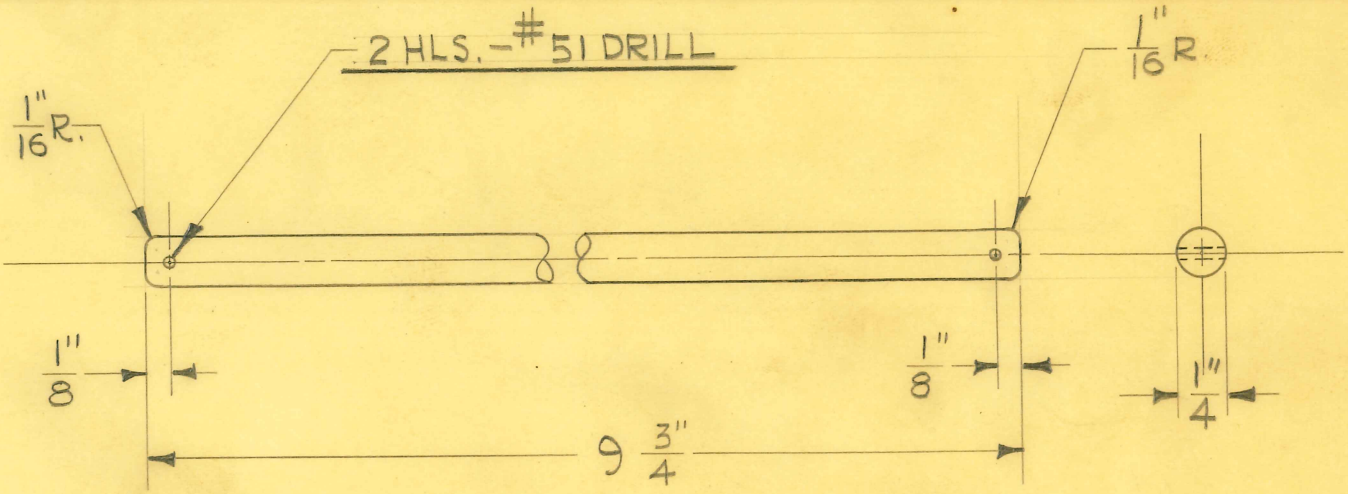

1 REQUIRED

SIZE	1/4" DIA.	ISSUE 9-11-41	J.V.W.
KIND	C.R. STEEL	CHANGED	
SHAPE	ROD	"	
FINISH	CAD. #23	"	
TEMP.		"	

TITLE: TILTING CASSETTE & GRID HOLDER CASE SWIVEL ROD - UPPER

H. G. FISCHER & CO.
2335 WABANSIA AVE.

CAT. NO.

PART NO. 14283

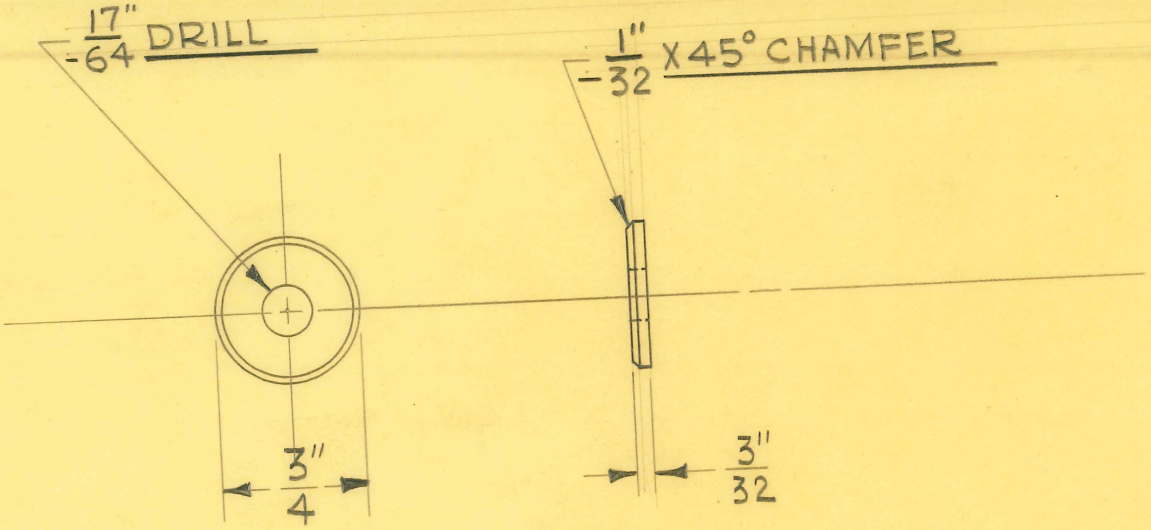

1 REQUIRED

SIZE	3/4" DIA.	ISSUE 9-10-41	J.V.W.
KIND	C.R.STEEL	CHANGED	
SHAPE		"	
FINISH	CAD. #23	"	
TEMP.		"	
		"	

TITLE: TILTING CASSETTE & GRID HOLDER CASE SWIVEL CLAMP WASHER

H. G. FISCHER & CO.
2335 WABANSIA AVE.
CHICAGO, ILL.

CAT. NO.

PART NO. 14284

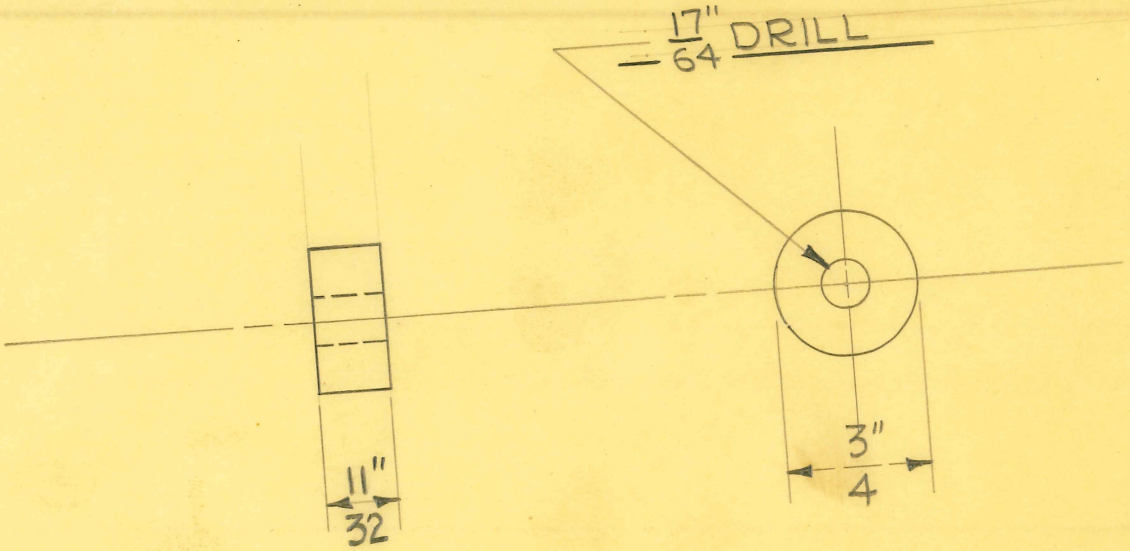

2 REQUIRED

RS.

SIZE	3/4" DIA.	ISSUE 9-10-41	J.V.W.
KIND	C.R. STEEL	CHANGED	
SHAPE		"	
FINISH	CAD. #23	"	
TEMP.		"	

TITLE: TILTING CASSETTE & GRID HOLDER CASE SWIVEL SPACER- THICK

H. G. FISCHER & CO.
2338 WABANSIA AVE.
CHICAGO, ILL.

CAT. NO.

PART NO. 14285

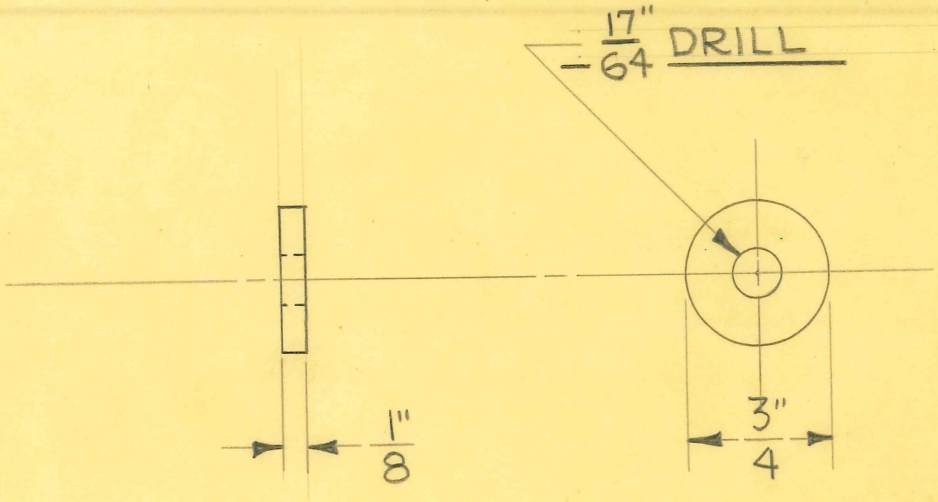

2 REQUIRED

RS.

SIZE	3/4" DIA.	ISSUE 9-10-41	J.V.W.
KIND	C.R. STEEL	CHANGED	
SHAPE		"	
FINISH	CAD. #23	"	
TEMP.		"	
		"	

TITLE: TILTING CASSETTE & GRID HOLDER CASE SWIVEL SPACER - THIN

H. G. FISCHER & CO.
2338 WABANSIA AVE.
CHICAGO, ILL.

CAT. NO.

PART NO. 14286

TITLE TILTING CASSETTE & GRID HOLDER CASE SWIVEL "CLAMP ROD"

H. G. FISCHER & CO.
FRANKLIN PARK, ILLINOIS

PART NO. 14289

DATE	DR BY	CH'K'D.
10-27-65	T. T.	RS

REVISION	DATE	BY

PATTERN	FINISH	SCALE
		FULL

TOOLS

MATERIAL: 1/4 RD. C.R. STEEL

DIMENSIONS
FRACTIONAL ± .015
DECIMAL ± .005
ANGULAR ± ½°
UNLESS OTHERWISE SPECIFIED

USED ON	QTY.
14287GA	1

REMOVE ALL BURRS

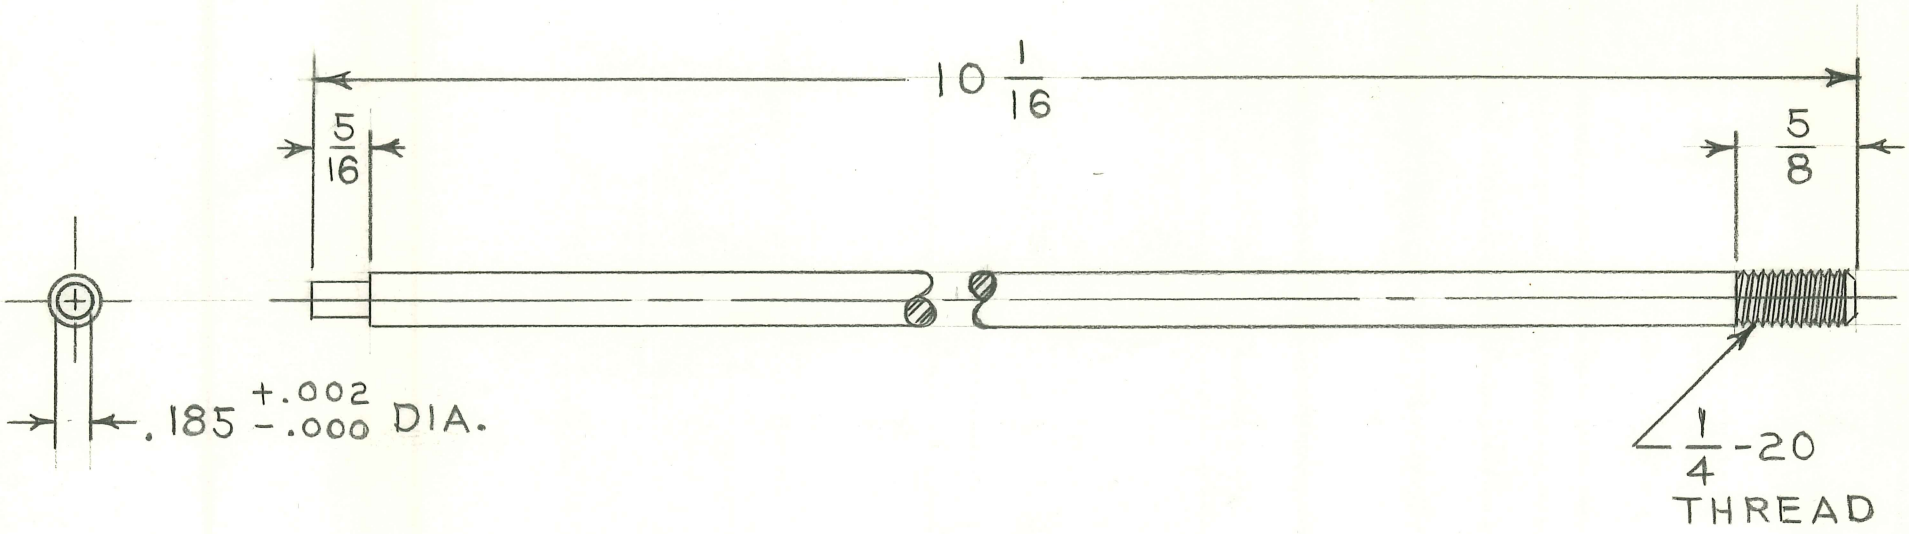

TITLE TILTING CASSETTE & GRID HOLDER CASE SWIVEL "CLAMP ROD KNOB"

H. G. FISCHER & CO.
FRANKLIN PARK, ILLINOIS

PART NO. 14290

DATE 10-28-65 | DR BY T. T. | CH'K'D RS

REVISION	DATE	BY

PATTERN | FINISH | SCALE FULL

TOOLS | MATERIAL 3/4 RD. C.R. STEEL

DIMENSIONS
FRACTIONAL ± .015
DECIMAL ± .005
ANGULAR ± ½°
UNLESS OTHERWISE SPECIFIED

USED ON	QTY.
14287GA	1

REMOVE ALL BURRS

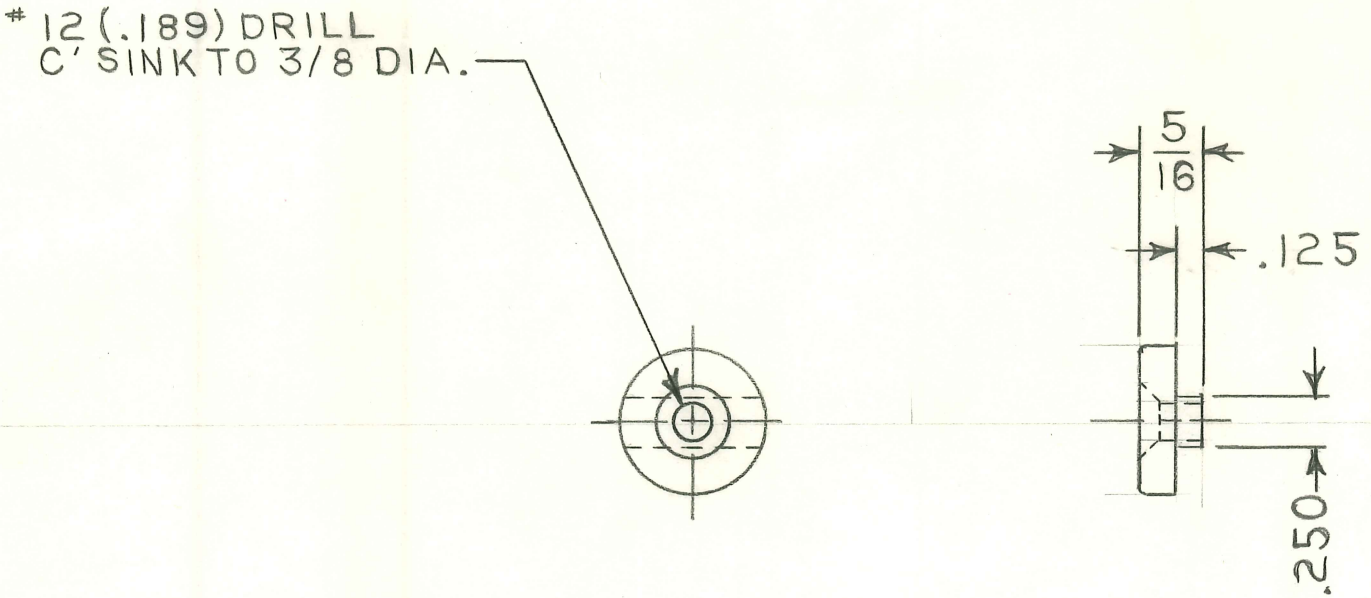

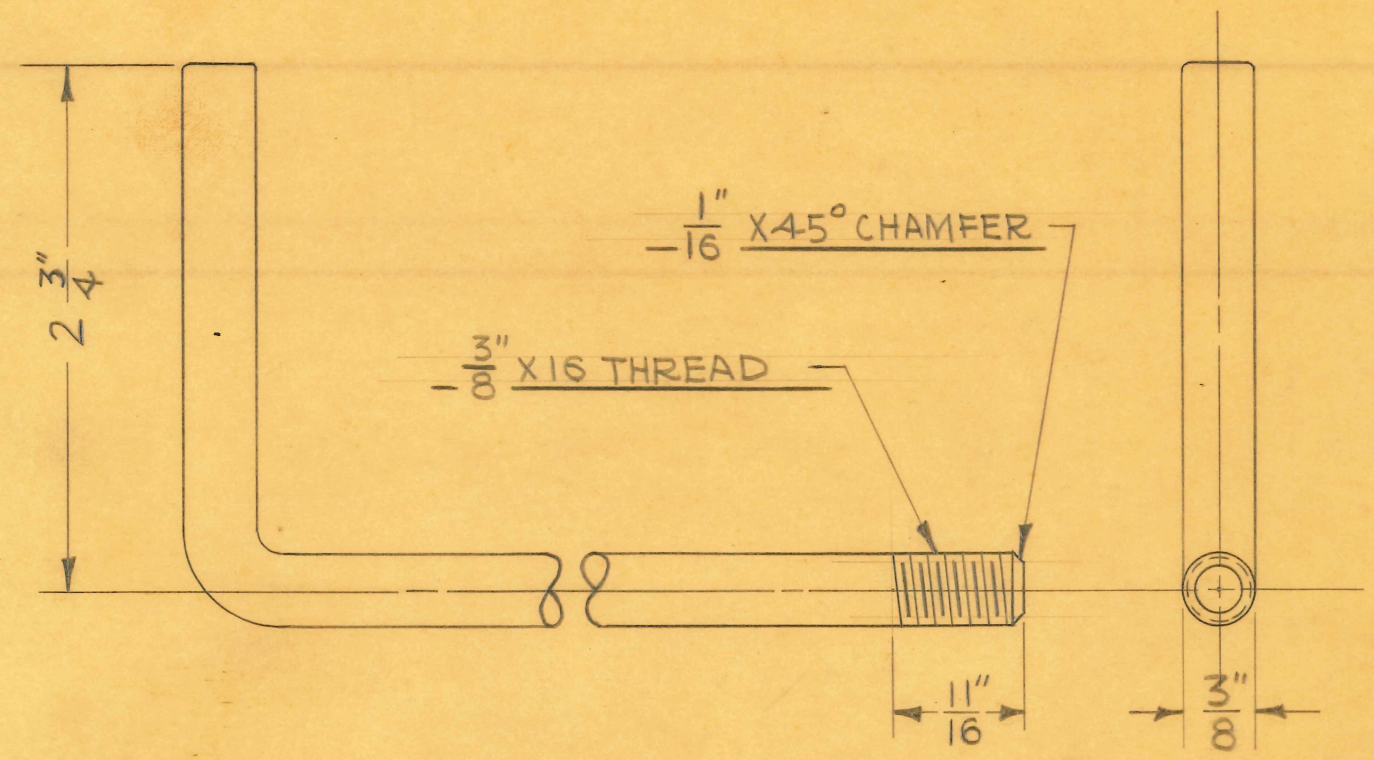

DEVELOPED LENGTH = 10 3/16"

1 REQUIRED

SIZE	3/8" DIA.	ISSUE 7-16-42	J.V.W.
KIND	C.R.STEEL	CHANGED	
SHAPE		" 6-7-51	W.J.
FINISH		"	
TEMP.		"	
PATT.		"	

TITLE: FISCHER "NTM" SHOCKPROOF X-RAY CWT. LEAD SUPP. ROD – SHORT

H. G. FISCHER & CO.
2335 WABANSIA AVE.
CHICAGO, ILL.

CAT. NO.

PART NO. 14309A

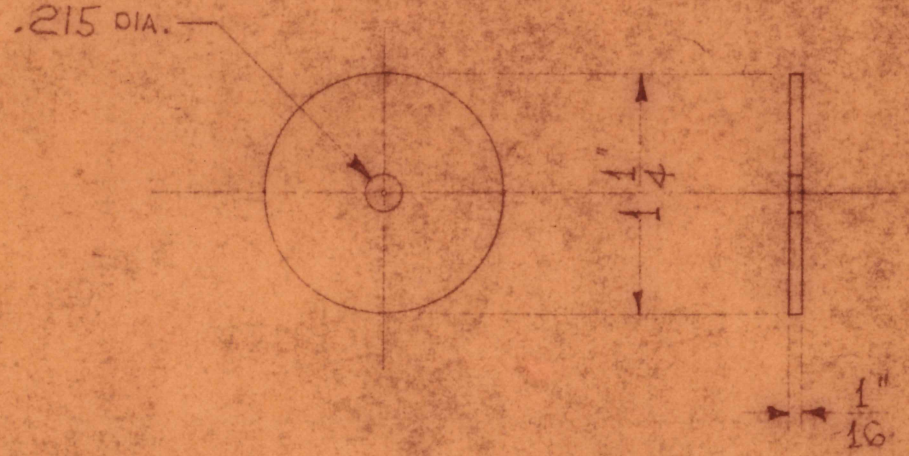

1 REQUIRED

*123 (CADMIUM PLATE)

PURCHASED PART

[redacted]

25200GL	2	
25230GH	2	
19260GH	1	USE ON

AMT

SIZE	1/16" X 1 1/2"	ISSUE 12-4-44	HE
KIND	SHEARED	CHANGED	
[illegible]	C.R. STEEL	"	
FINISH		"	
TEMP.		"	
PATT.		"	

TITLE: FISCHER MOD. "GA-15" LIGHT MOBILE STAND CONTROL BOX SUPPORT ROD WASHER

H. G. FISCHER & CO.
2338 WABANSIA AVE.
CHICAGO ILL.

CAT. NO.

PART NO. 14335-24

TITLE			PART NO.
FISCHER MOD. "PN" PORTABLE X-RAY TRANSF. TANK BEARING MTG. NUT	H. G. FISCHER & CO. FRANKLIN PARK, ILLINOIS	DATE 2-19-57 DR BY C.E.K. CH'K'D. J.V.W.	14357 A

REVISION	DATE	BY

PATTERN	FINISH	SCALE FULL
TOOLS	MATERIAL 3/8" DIA. C.R. STEEL	DIMENSIONS: FRACTIONAL ± .015; DECIMAL ± .005; ANGULAR ± ½°; UNLESS OTHERWISE SPECIFIED

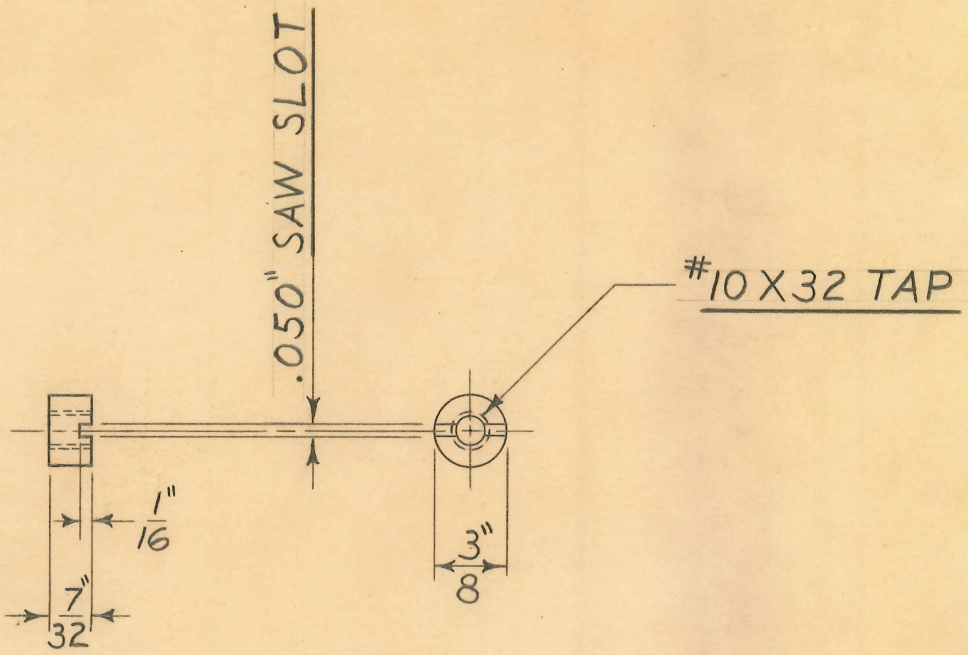

8 REQUIRED

FOLDER # 112

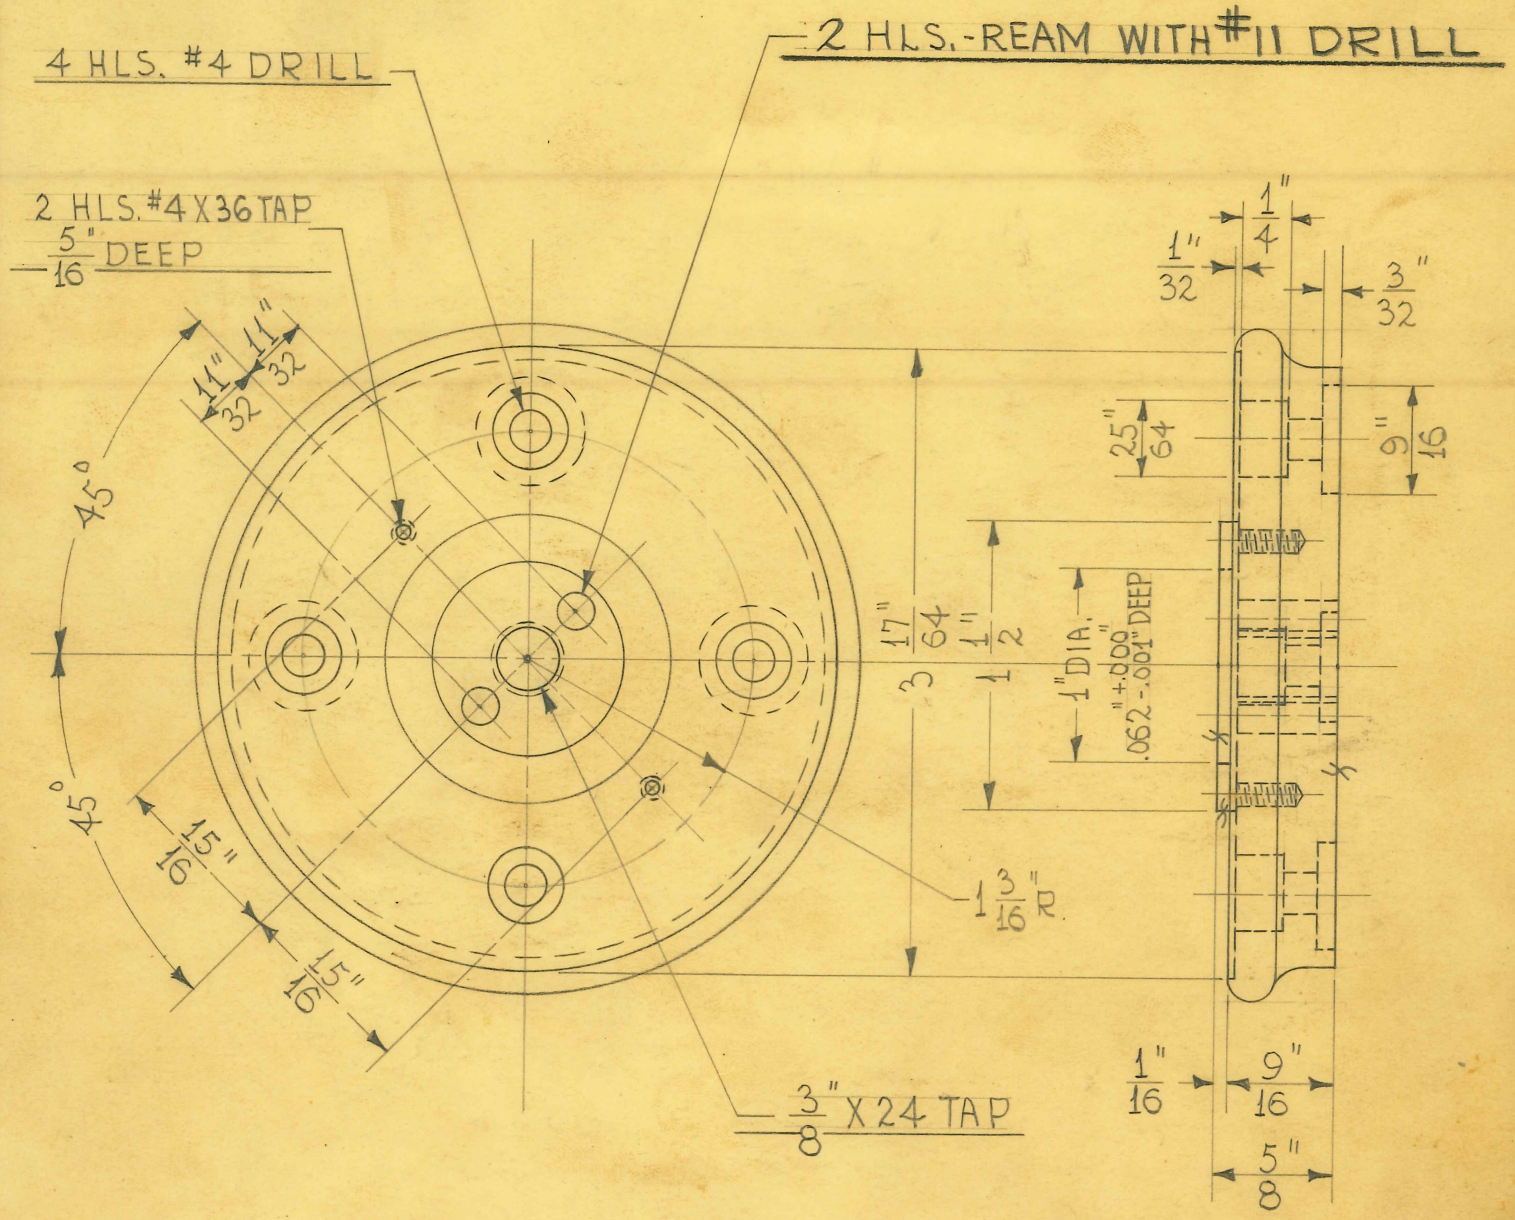

2 REQUIRED

SIZE		ISSUE 10-31-41	H.E.
KIND	ALUM. CASTING	CHANGED	
SHAPE		"	
FINISH	PAINTED	"	
TEMP.		"	
PATT.	1812	"	

TITLE: "TV-30-96" RAD. & FLUOR. UNIT-
TANK BEARING PLATE.

H. G. FISCHER & CO.
2335 WABANSIA AVE.
CHICAGO, ILL.

CAT. NO.

PART NO. 14454F

TITLE: BUSHING & BEARING SUBSTITUTE FOR PCE # 14473 1/2 BEARING

H. G. FISCHER & CO.
FRANKLIN PARK, ILLINOIS

PART NO. S14473 1/2

DATE 12-29-50 DR. BY J.V.W. CH'K'D.

REVISION	DATE	BY

PATTERN | FINISH | SCALE FULL

TOOLS | MATERIAL 1/2" DIA. JEWELERS ROD

DIMENSIONS UNLESS OTHERWISE SPECIFIED
FRACTIONAL ± .015
DECIMAL ± .005
ANGULAR ± 1/2°

BREAK ALL SHARP EDGES

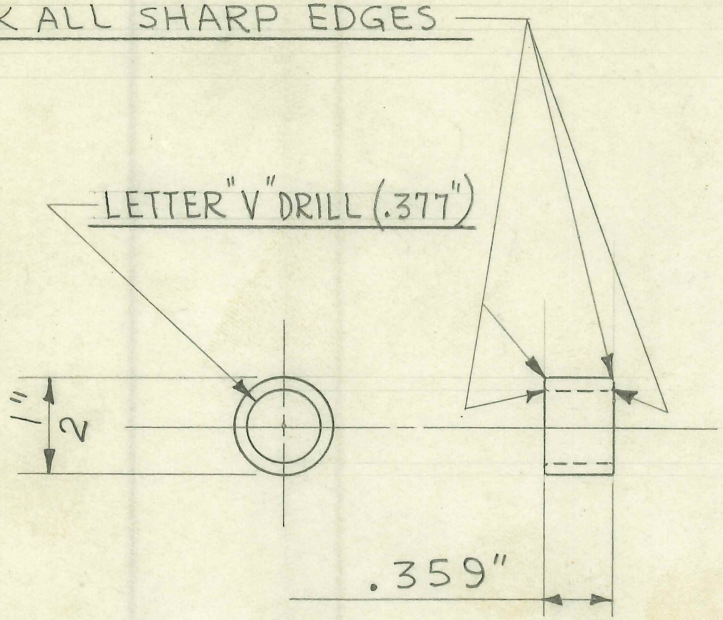

1 REQ. FOR EACH BEARING

PCE. # 17927

PRESS BUSHING INTO BEARING IN ARBOR PRESS

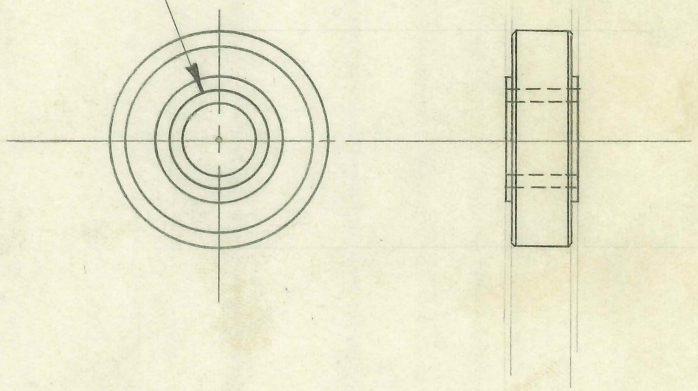

L. C. SMITH
K8A SKF } BEARING

FOLDER #114

4 HLS.~ #49 DRL. THRU CASE
& # 2 X 56 TAP. ~ PULL. OUT
TAPE ABOUT 24" BEFORE DRILLING

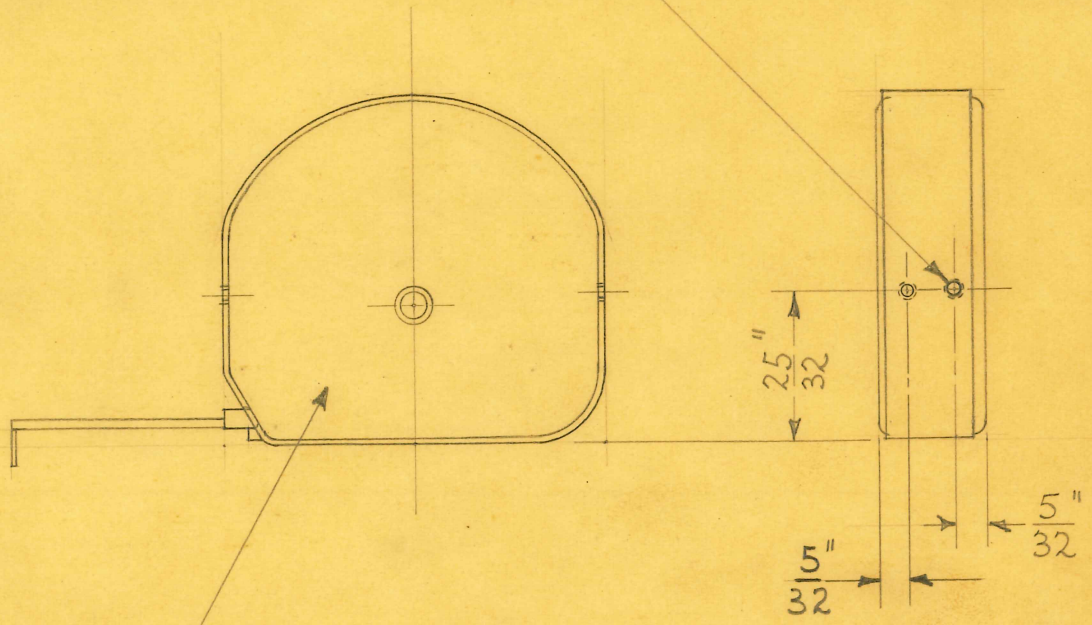

PLACE IN JIG WITH THIS SIDE UP.
(THIS SIDE IS MARKED "ADD 2 INCHES ETC.")

1 REQUIRED

DRILL JIG TOOL #8615

SIZE	FROM 14558G	ISSUE 2-29-44	IE.
KIND		CHANGED	
SHAPE		" 12-15-48	W.J.
FINISH		"	
TEMP.		"	

TITLE: FISCHER "TV-30-96" RAD. & FLUOR. UNIT~ TAPE RULE (DRILLED)

H. G. FISCHER & CO.
2335 WABANSIA AVE.

CAT. NO.

PART NO. 14558GFA

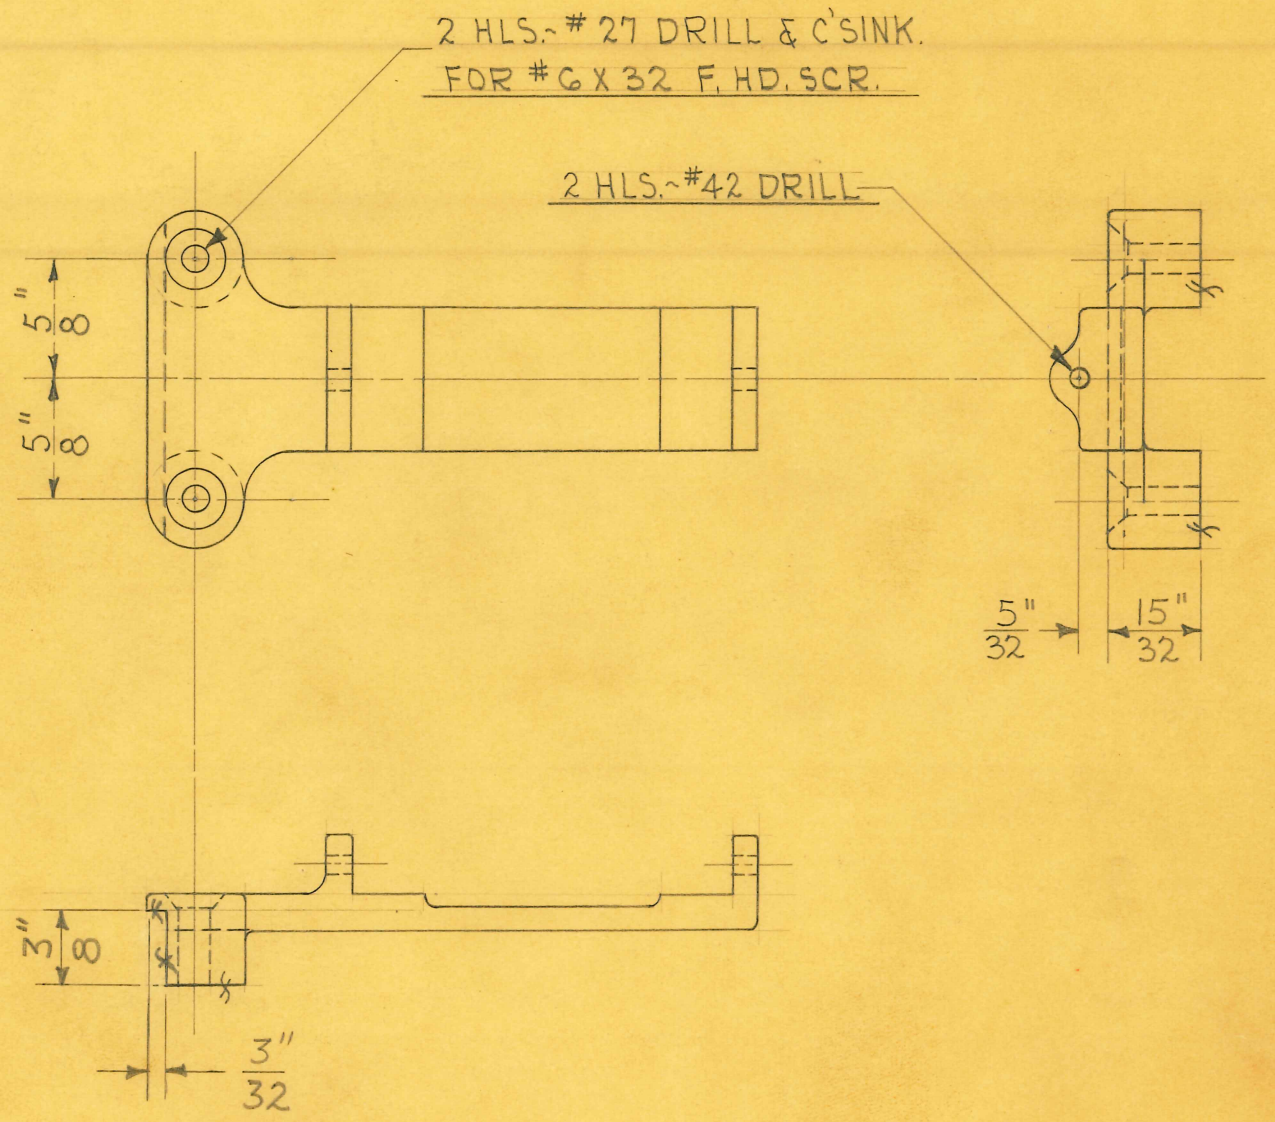

1 REQUIRED

SIZE	#12	ISSUE 2-29-44	H.E.
KIND	ALUM. CASTING	CHANGED	
SHAPE		"6-19-46	J.V.W.
FINISH	PAINTED	"	
TEMP.		"	
PATT.	1994	"	

TITLE: FISCHER "TV-30-96" RAD. & FLUOR. UNIT~ SCALE SUPPORT

H. G. FISCHER & CO.
2335 WABANSIA AVE.
CHICAGO, ILL.

CAT. NO.

PART NO. 14569F

TITLE
FISCHER HEAD CLAMP
TUBING SUPP. ROD

H. G. FISCHER & CO.
FRANKLIN PARK, ILLINOIS

PART NO. 17712

DATE 10-15-48 | DR. BY W. J. | CH'K'D. J.V.W.

REVISION	DATE	BY

PATTERN

FINISH CHROME #2

SCALE FULL

TOOLS DRILL JIG #9960

MATERIAL 5/8 DIA. C.R. STEEL

DIMENSIONS
FRACTIONAL ± .015
DECIMAL ± .005
ANGULAR ± ½°
UNLESS OTHERWISE SPECIFIED

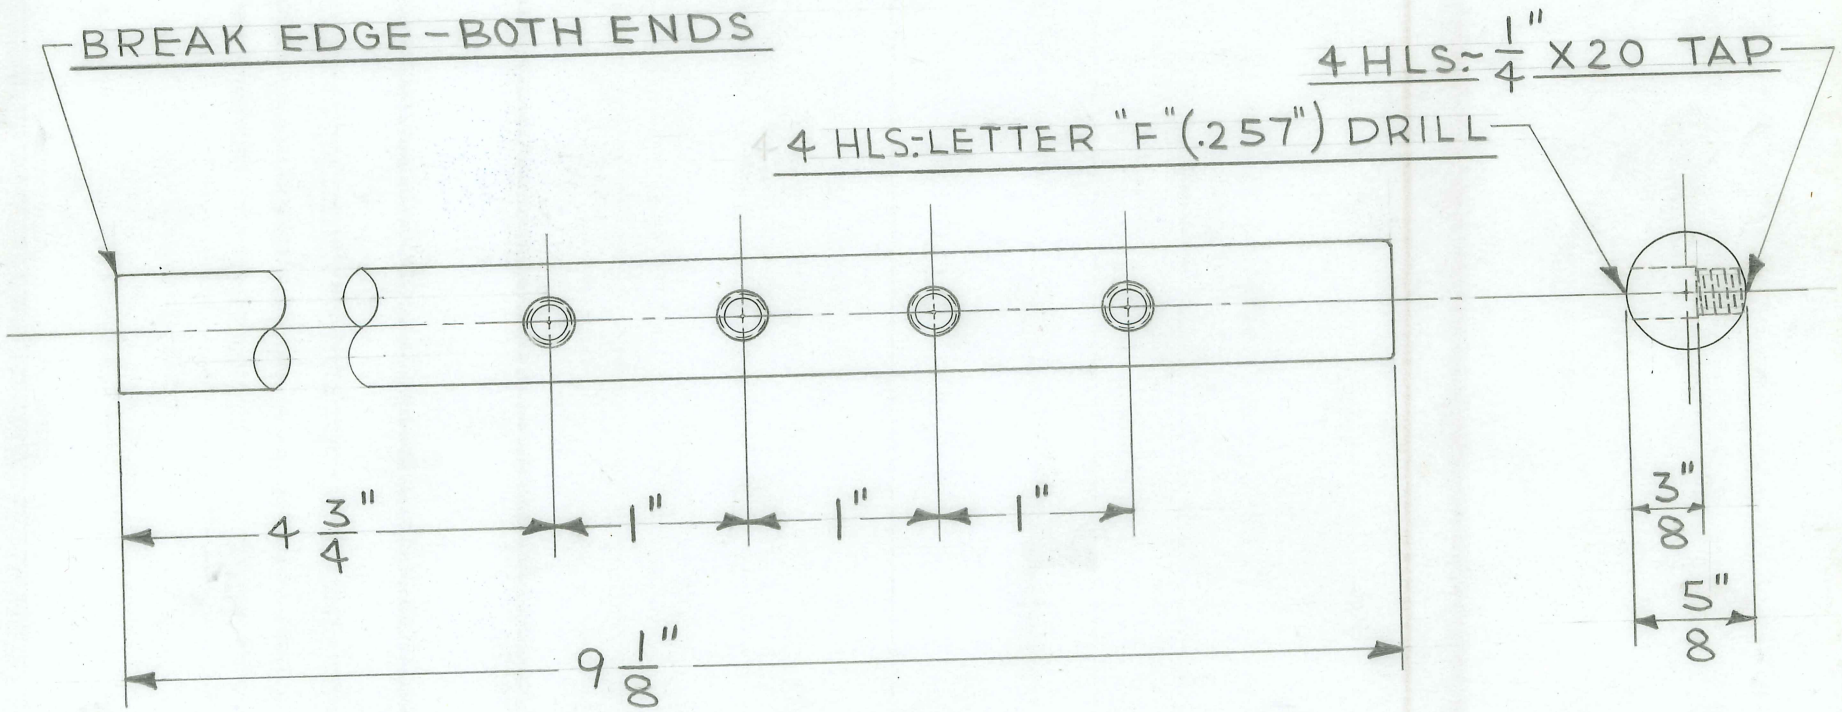

1 REQUIRED

TITLE
FISCHER HEAD CLAMP
CLAMPING ARM RETAINING WASHER

H. G. FISCHER & CO.
FRANKLIN PARK, ILLINOIS

PART NO. 17713

REVISION	DATE	BY

DATE 10-22-48 DR. BY W. J. CH'K'D. J.V.W.

FINISH CHROME #2 SCALE FULL

PATTERN

TOOLS

MATERIAL 1" DIA. C.R. STEEL

DIMENSIONS
FRACTIONAL ± .015
DECIMAL ± .005
ANGULAR ± ½°
UNLESS OTHERWISE SPECIFIED

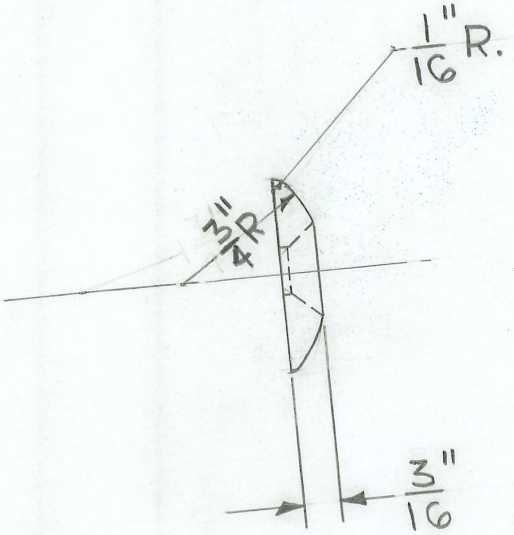

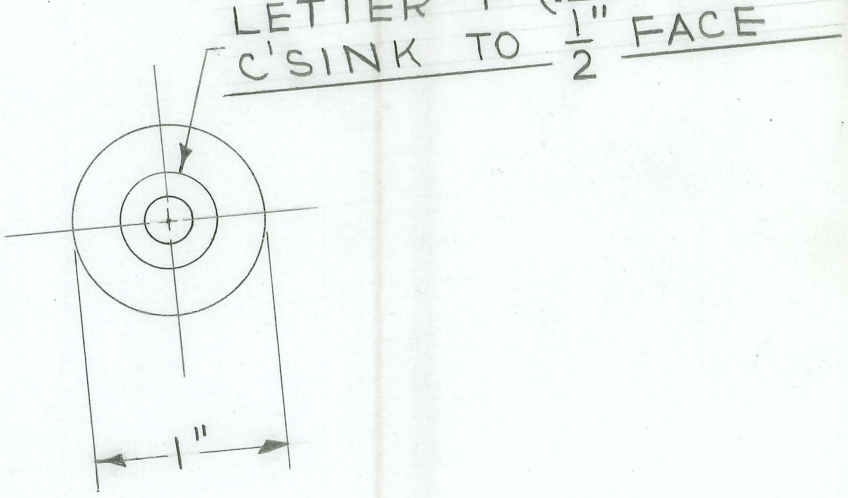

2 REQUIRED

TITLE

FISCHER HEAD CLAMP ADJUSTING ROD STOP BUSHING

H. G. FISCHER & CO.
FRANKLIN PARK, ILLINOIS

DATE 10-13-48 DR. BY W.J. CH'K'D. J.V.W.

PART NO. 17714

REVISION	DATE	BY

PATTERN

FINISH

SCALE FULL

TOOLS

MATERIAL 1 1/2" DIA. C.R. STEEL

DIMENSIONS
FRACTIONAL ± .015
DECIMAL ± .005
ANGULAR ± ½°
UNLESS OTHERWISE SPECIFIED

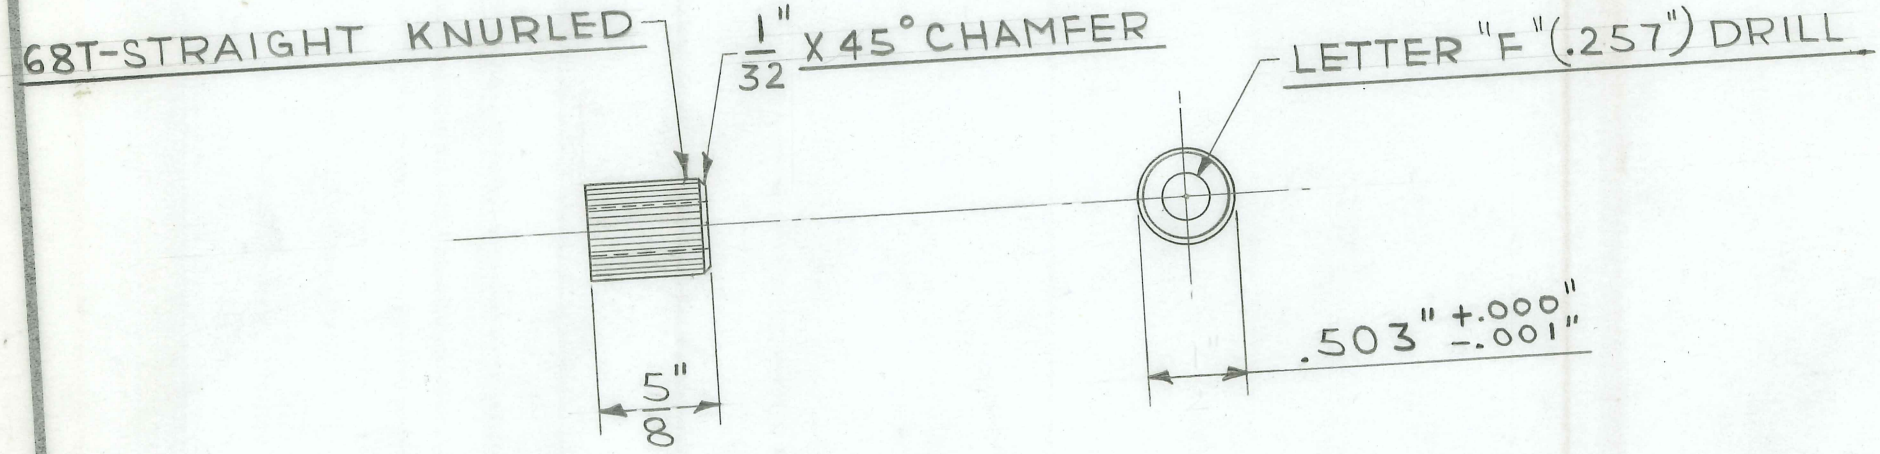

1 REQUIRED

TITLE
FISCHER HEAD CLAMP
ADJUSTING ROD SPACING BUSHING

H. G. FISCHER & CO.
FRANKLIN PARK, ILLINOIS

DATE 10-13-48 | DR. BY W.J. | CH'K'D J.Y.W.

PART NO. 17715

REVISION	DATE	BY

PATTERN | FINISH | SCALE FULL

TOOLS | MATERIAL 7/16" DIA. C.R. STEEL

DIMENSIONS
FRACTIONAL ± .015
DECIMAL ± .005
ANGULAR ± ½°
UNLESS OTHERWISE SPECIFIED

BREAK EDGES - BOTH ENDS

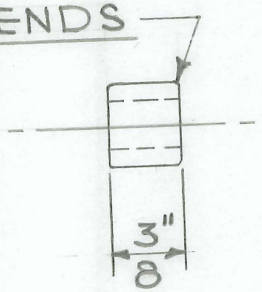

.250" REAMED

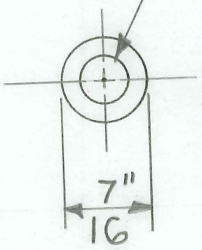

1 REQUIRED

TITLE
FISCHER HEAD CLAMP
ADJ. ROD FOR 8"X10" BUCKY

H. G. FISCHER & CO.
FRANKLIN PARK, ILLINOIS

PART NO. 17716

REVISION	DATE	BY

DATE 10-20-48 | DR. BY W.J. | CH'K'D. J.V.W.

PATTERN | FINISH | SCALE FULL

TOOLS | MATERIAL 1/4" DIA. C.R. STEEL

DIMENSIONS UNLESS OTHERWISE SPECIFIED
FRACTIONAL ± .015
DECIMAL ± .005
ANGULAR ± ½°

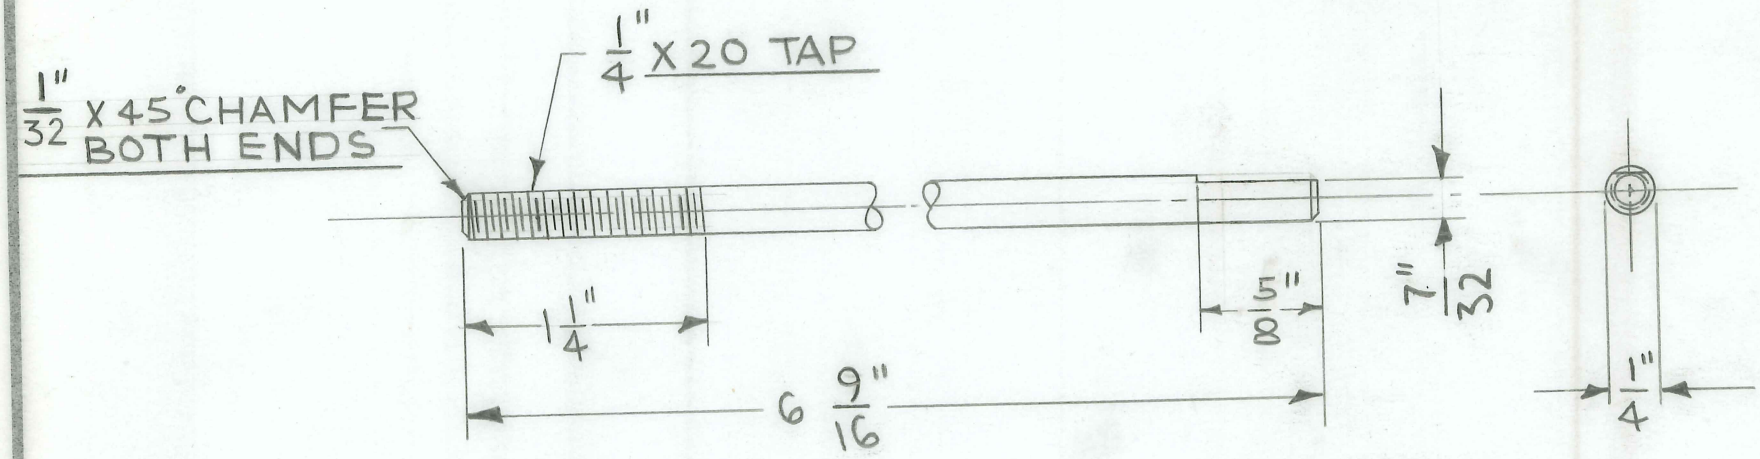

1 REQUIRED

TITLE
FISCHER HEAD CLAMP
ADJ. ROD ASSEM. FOR 8"X10" BUCKY

PATTERN

FINISH CAD.# 23

SCALE FULL

TOOLS
DRILL JIG.# 9967

MATERIAL

H. G. FISCHER & CO.
FRANKLIN PARK, ILLINOIS
DATE 10-21-48 DR. BY W. J. CH'K'D. J.V.W.

DIMENSIONS
FRACTIONAL ± .015
DECIMAL ± .005
ANGULAR ± ½°
UNLESS OTHERWISE SPECIFIED

PART NO. 17717G

REVISION	DATE	BY

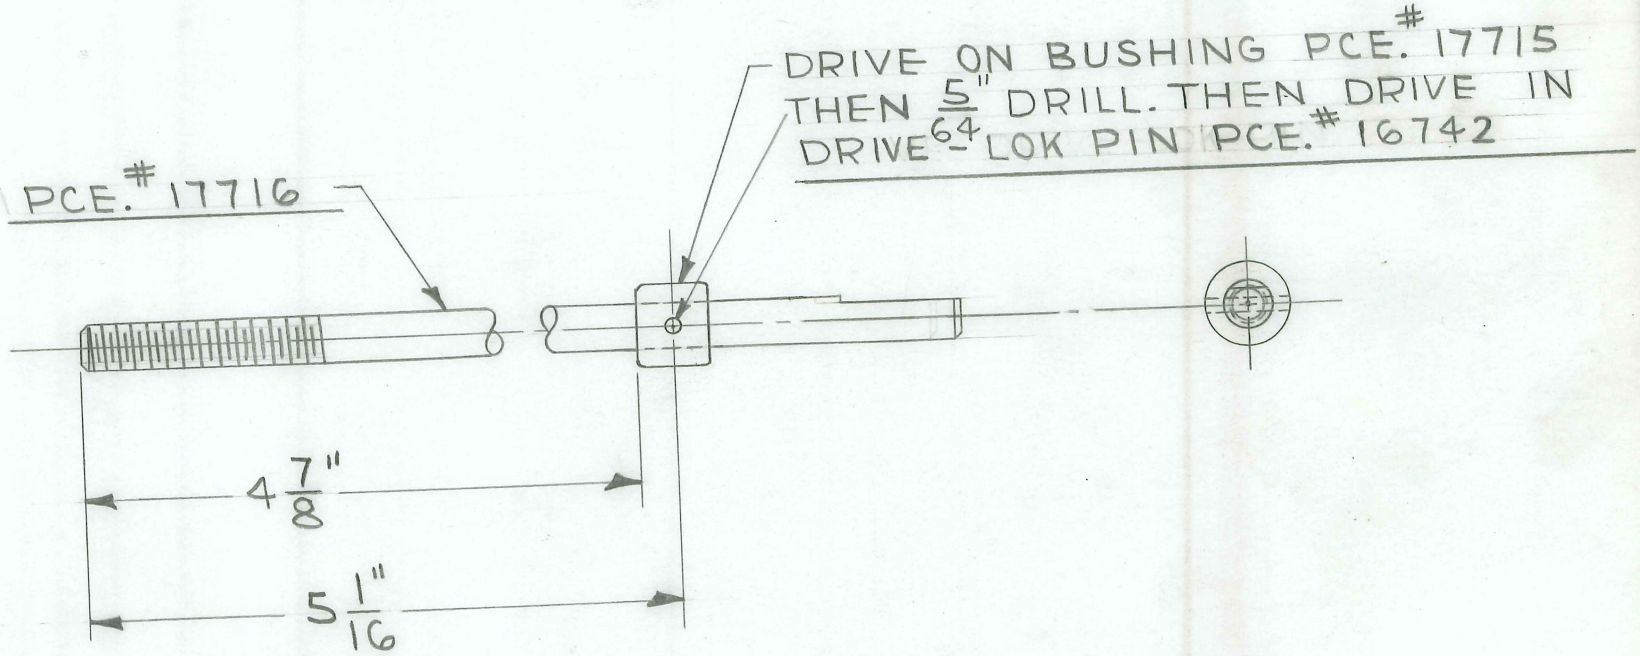

1 REQUIRED

TITLE
FISCHER HEAD CLAMP
ADJ. TUBE FOR 8"X 10" BUCKY

H. G. FISCHER & CO.
FRANKLIN PARK, ILLINOIS

DATE 10-13-48 | DR. BY W.J. | CH'K'D. J.V.W.

PART NO. 17718

REVISION	DATE	BY

SCALE FULL

PATTERN | FINISH

MATERIAL
5/8" O.D X 16 GA. (.065") WALL.
WELDED STEEL TUBING

TOOLS

DIMENSIONS
FRACTIONAL ± .015
DECIMAL ± .005
ANGULAR ± ½°
UNLESS OTHERWISE SPECIFIED

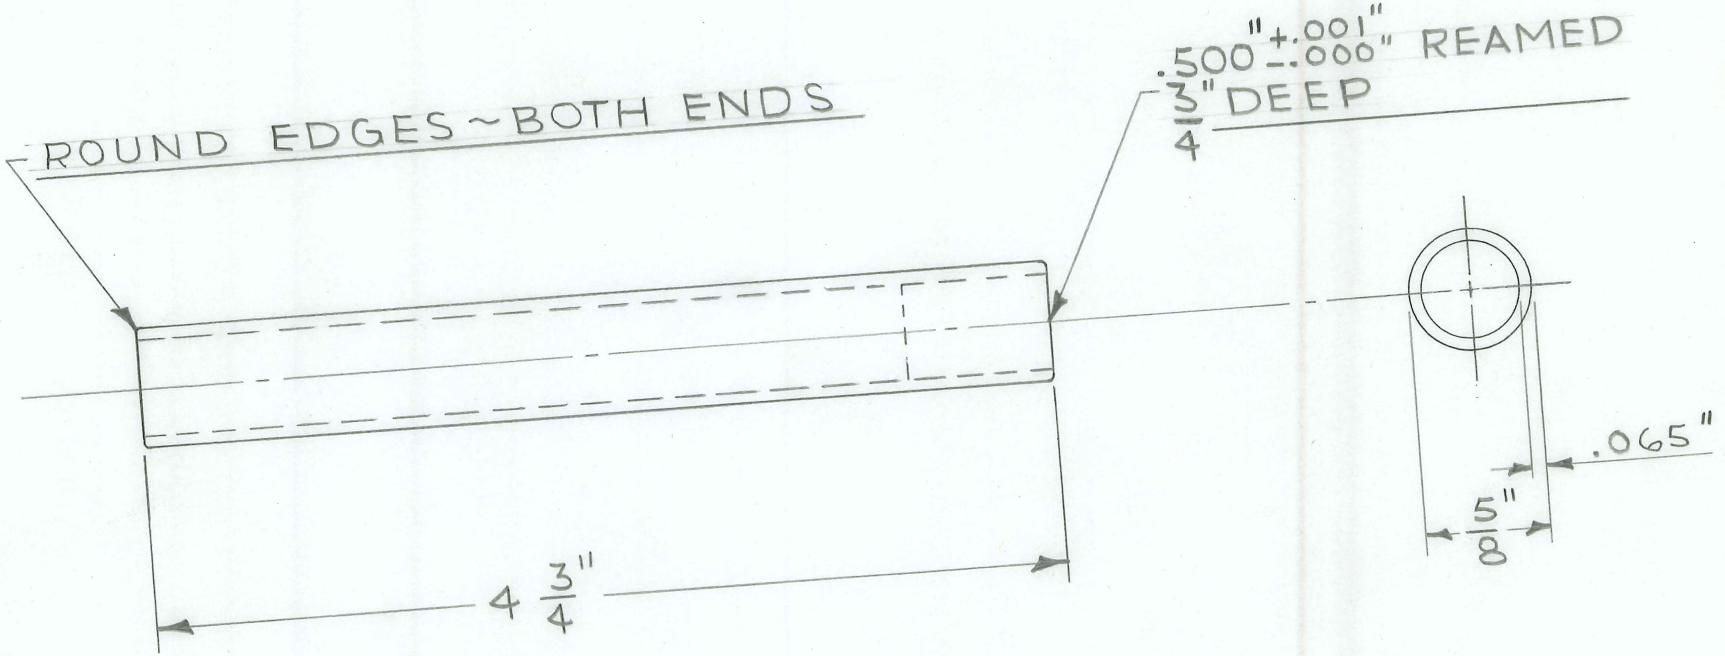

1 REQUIRED

TITLE
FISCHER HEAD CLAMP
ADJUSTING TUBE ASSEM. FOR 8"X10" BUCKY

PATTERN

FINISH CHROME #2

SCALE FULL

MATERIAL

TOOLS

H. G. FISCHER & CO.
FRANKLIN PARK, ILLINOIS

DATE 10-13-48 DR. BY W.J. CH'K'D. J.V.W.

DIMENSIONS
FRACTIONAL ± .015
DECIMAL ± .005
ANGULAR ± ½°
UNLESS OTHERWISE SPECIFIED

PART NO. 17719G

REVISION	DATE	BY

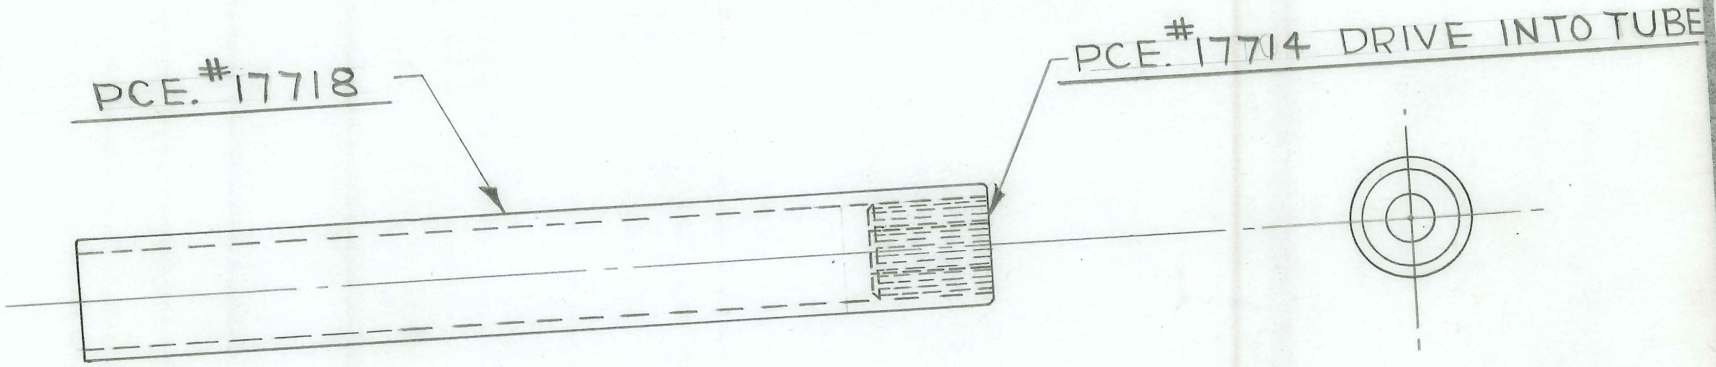

1 REQUIRED

TITLE
FISCHER HEAD CLAMP
ADJ. TUBE FOR TILT TABLE
& L-200

H. G. FISCHER & CO.
FRANKLIN PARK, ILLINOIS

DATE 10-15-48 | DR. BY W. J. | CH'K'D. J.V.W.

PART NO. 17720

REVISION	DATE	BY

PATTERN | FINISH | SCALE FULL

TOOLS

MATERIAL
5/8" O.D. X 16GA. (.065") WALL
WELDED STEEL TUBING

DIMENSIONS
FRACTIONAL ± .015
DECIMAL ± .005
ANGULAR ± ½°
UNLESS OTHERWISE SPECIFIED

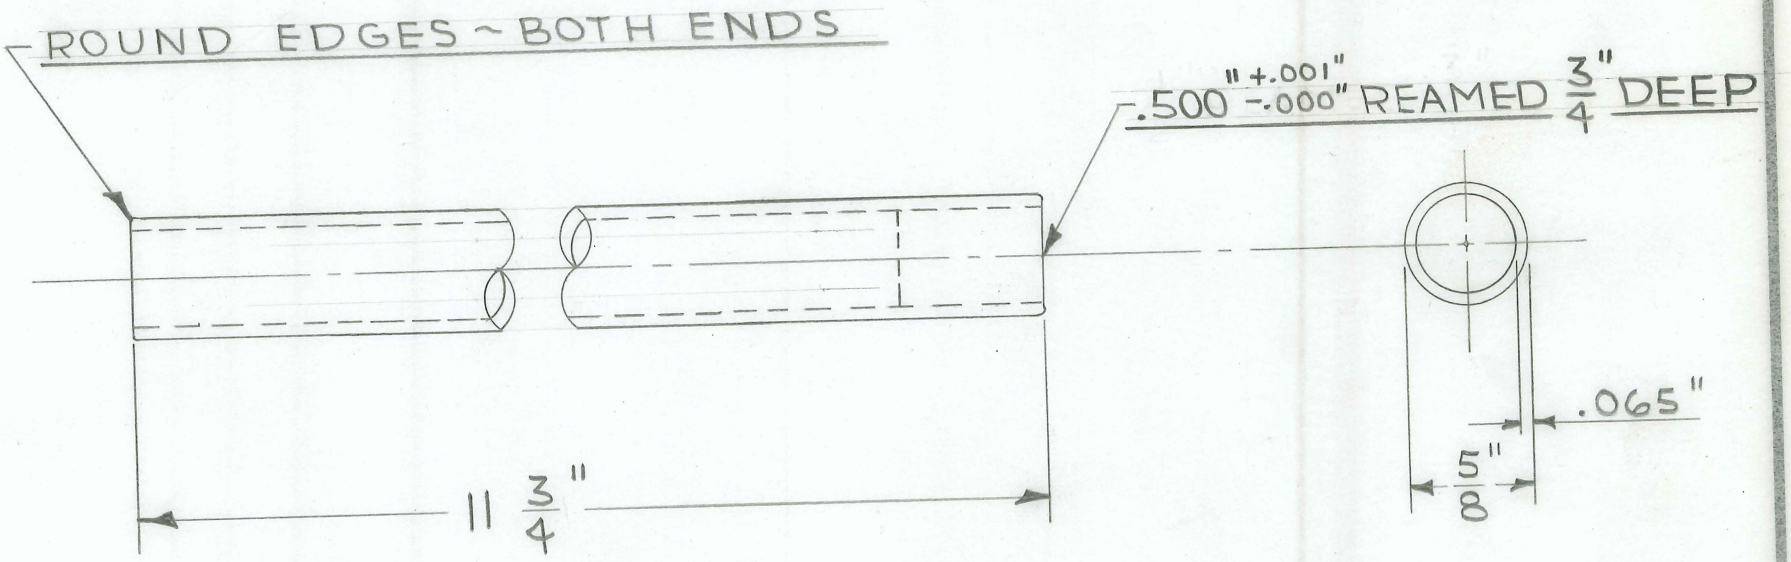

1 REQUIRED

TITLE

FISCHER HEAD CLAMP

ADJ. TUBE ASSEM. FOR TILT TABLE & L-200

H. G. FISCHER & CO.
FRANKLIN PARK, ILLINOIS

DATE 10-13-48 | DR. BY W. J. | CH'K'D. J.V.W.

PART NO. 17721G

REVISION	DATE	BY

PATTERN

FINISH CHROME #2

SCALE FULL

TOOLS

MATERIAL

DIMENSIONS
FRACTIONAL ± .015
DECIMAL ± .005
ANGULAR ± ½°
UNLESS OTHERWISE SPECIFIED

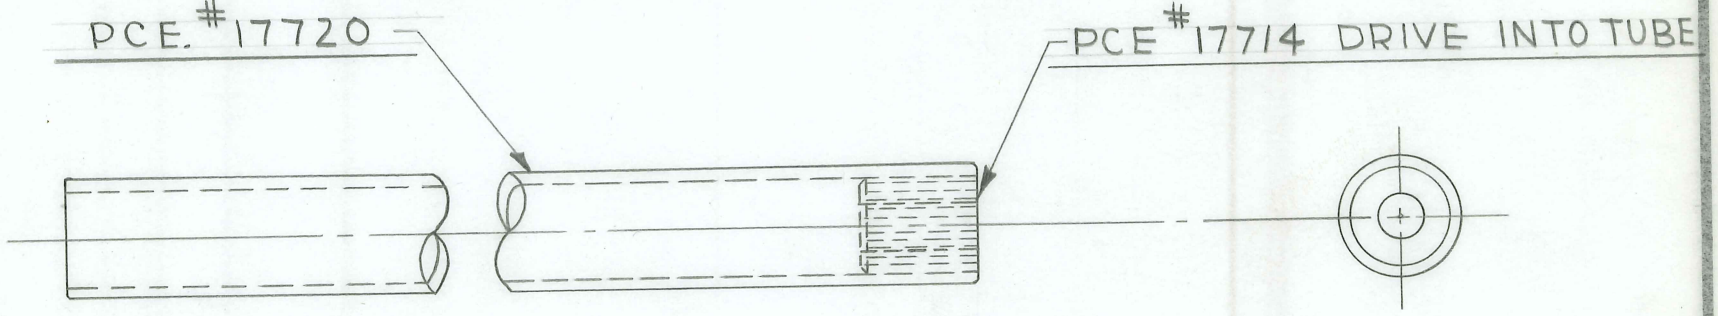

1 REQUIRED

TITLE
FISCHER HEAD CLAMP
ADJ. ROD FOR TILT TABLE & L-200

H. G. FISCHER & CO.
FRANKLIN PARK, ILLINOIS

DATE 10-20-48 | DR. BY W. J. | CH'K'D. J.V.W.

PART NO. 17722

REVISION	DATE	BY

PATTERN | FINISH | SCALE FULL

TOOLS | MATERIAL 1/4" DIA. C.R. STEEL

DIMENSIONS
FRACTIONAL ± .015
DECIMAL ± .005
ANGULAR ± ½°
UNLESS OTHERWISE SPECIFIED

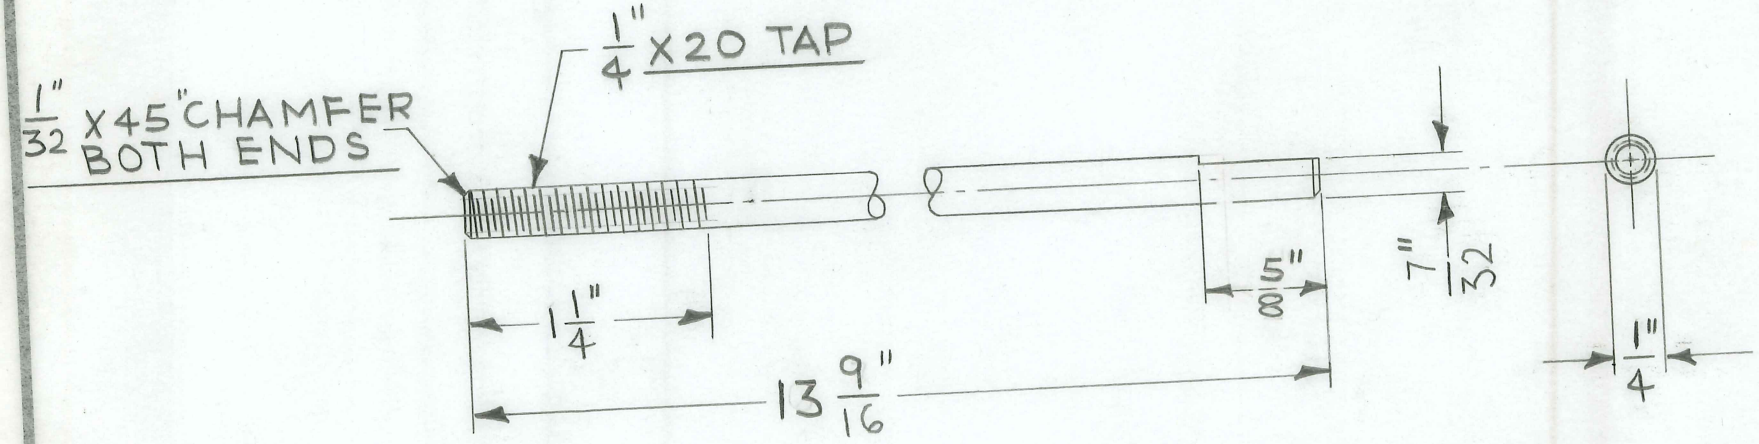

1 REQUIRED

TITLE

FISCHER HEAD CLAMP

ADJ. ROD ASSEM. FOR TILT TABLE & L-200

H. G. FISCHER & CO.
FRANKLIN PARK, ILLINOIS

DATE 10-21-48 DR. BY W. J. CH'K'D.

PART NO. 17723G

REVISION	DATE	BY

PATTERN

FINISH CAD. # 23

SCALE FULL

TOOLS
DRILL JIG. # 9967

MATERIAL

DIMENSIONS
FRACTIONAL ± .015
DECIMAL ± .005
ANGULAR ± ½°
UNLESS OTHERWISE SPECIFIED

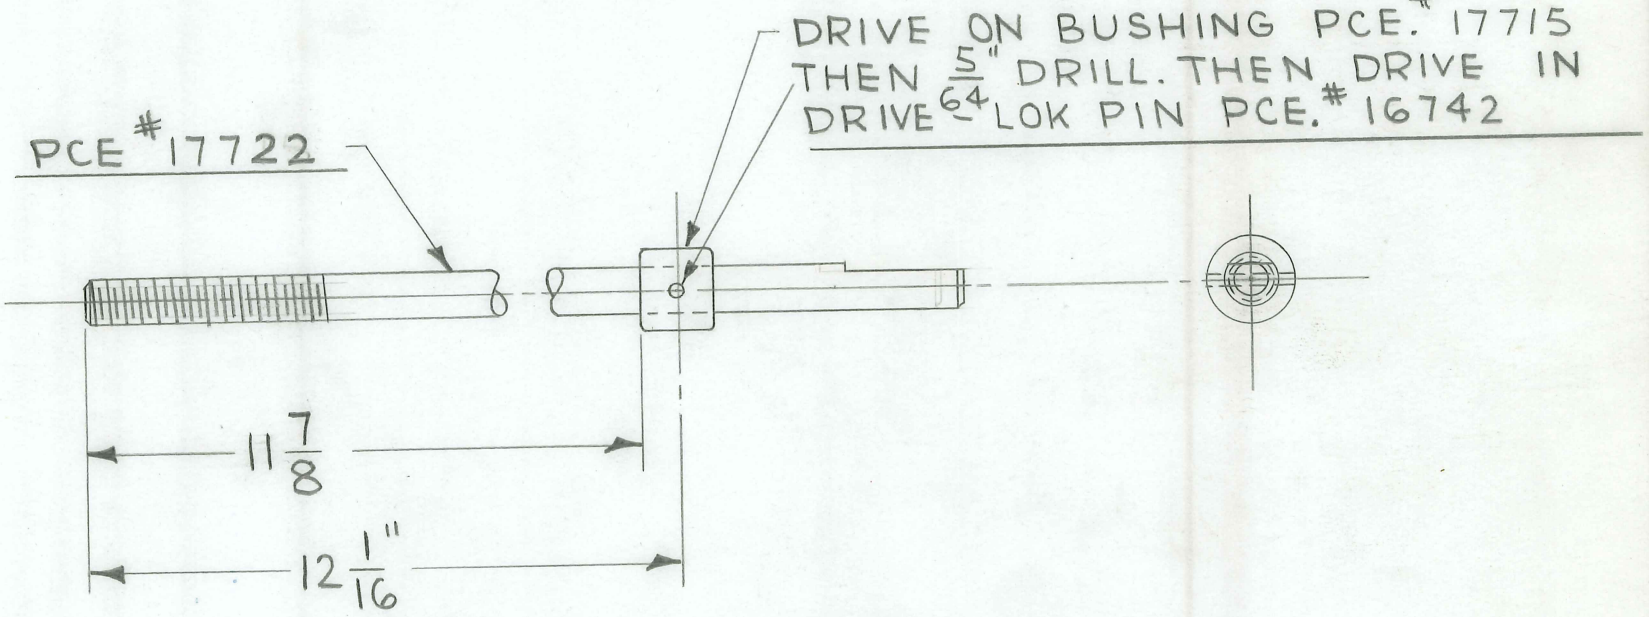

1 REQUIRED

TITLE

FISCHER HEAD CLAMP LOCK KNOB

H. G. FISCHER & CO.
FRANKLIN PARK, ILLINOIS

PART NO. 17724

DATE 10-21-22 | DR. BY W. J. | CH'K'D. J.V.W.

REVISION	DATE	BY

PATTERN | FINISH CHROME #2 | SCALE FULL

TOOLS

MATERIAL 1 1/2 DIA. BRASS ROD

DIMENSIONS
FRACTIONAL ± .015
DECIMAL ± .005
ANGULAR ± ½°
UNLESS OTHERWISE SPECIFIED

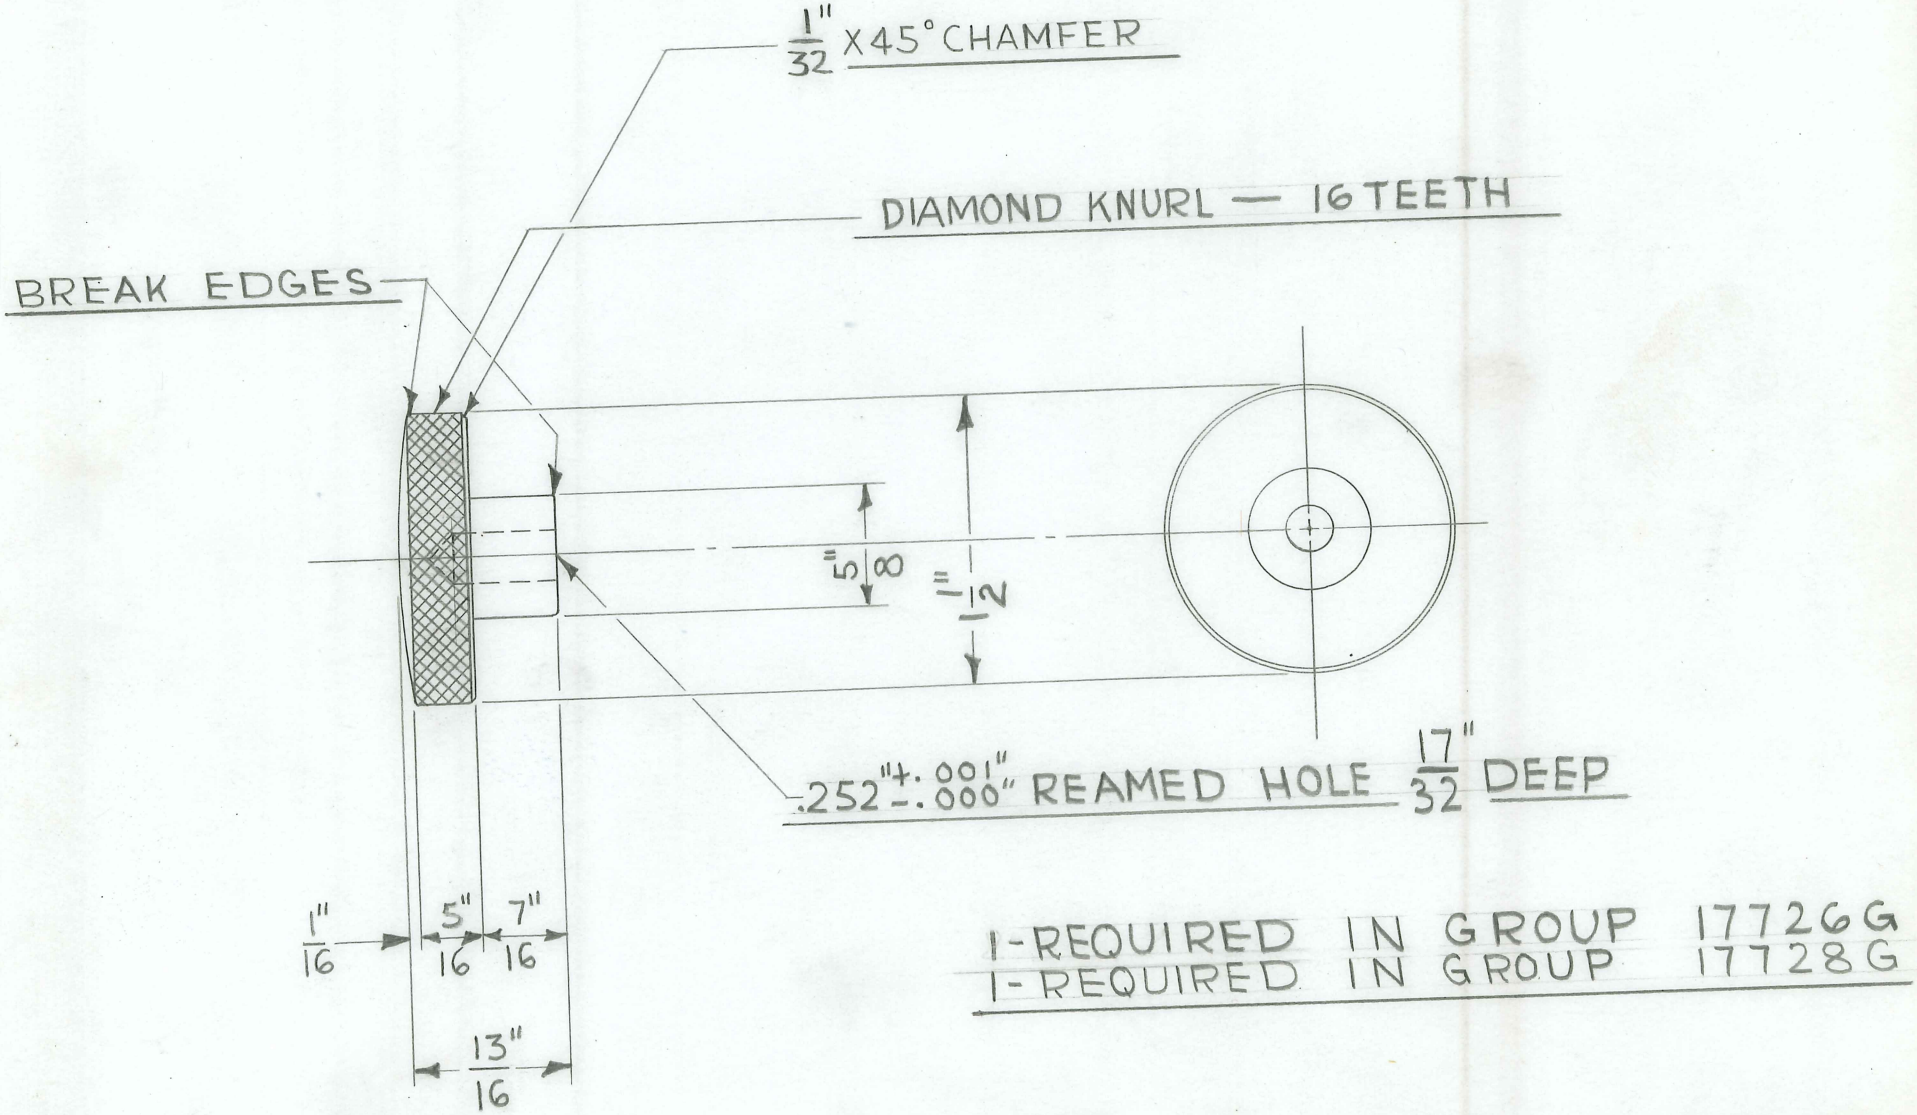

1-REQUIRED IN GROUP 17726G
1-REQUIRED IN GROUP 17728G

TITLE
FISCHER HEAD CLAMP
ADJ. TUBE LOCK STUD

H. G. FISCHER & CO.
FRANKLIN PARK, ILLINOIS

PART NO. 17725

DATE 10-21-48 DR. BY W.J. CH'K'D. J.V.W.

REVISION	DATE	BY

PATTERN

FINISH CAD. #23

SCALE FULL

TOOLS

MATERIAL " 1/4 DIA. C.R. STEEL

DIMENSIONS
FRACTIONAL ± .015
DECIMAL ± .005
ANGULAR ± ½°
UNLESS OTHERWISE SPECIFIED

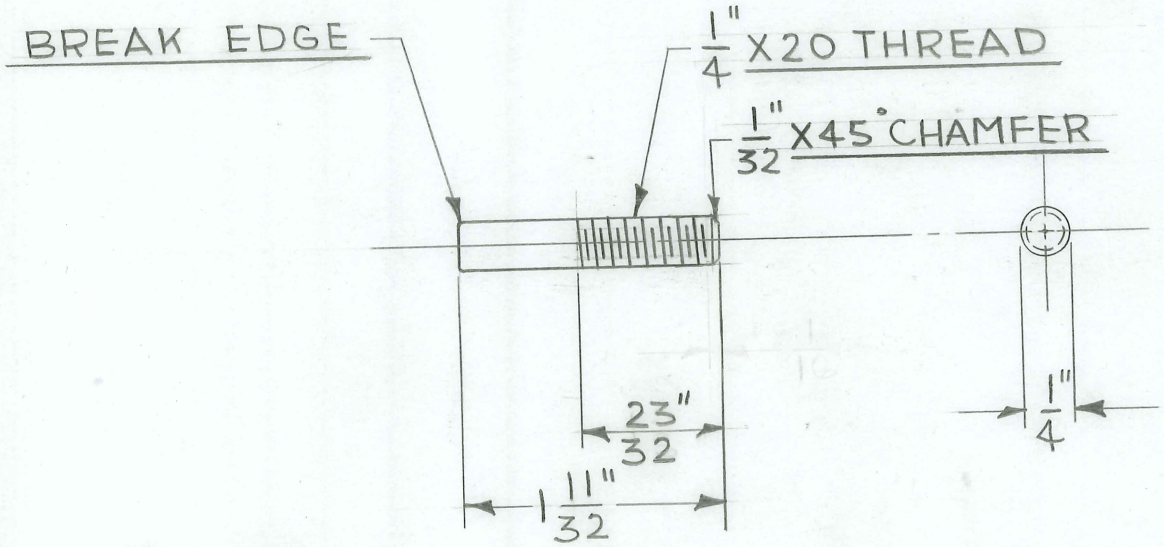

1 REQUIRED

TITLE

FISCHER HEAD CLAMP ADJ. TUBE LOCK ASSEM.

H. G. FISCHER & CO.
FRANKLIN PARK, ILLINOIS

DATE 10-21-48 DR. BY W. J. CH'K'D. J.V.W.

PART NO. 17726G

REVISION	DATE	BY

PATTERN

FINISH

SCALE FULL

TOOLS
DRILL JIG # 9963

MATERIAL

DIMENSIONS
FRACTIONAL ± .015
DECIMAL ± .005
ANGULAR ± ½°
UNLESS OTHERWISE SPECIFIED

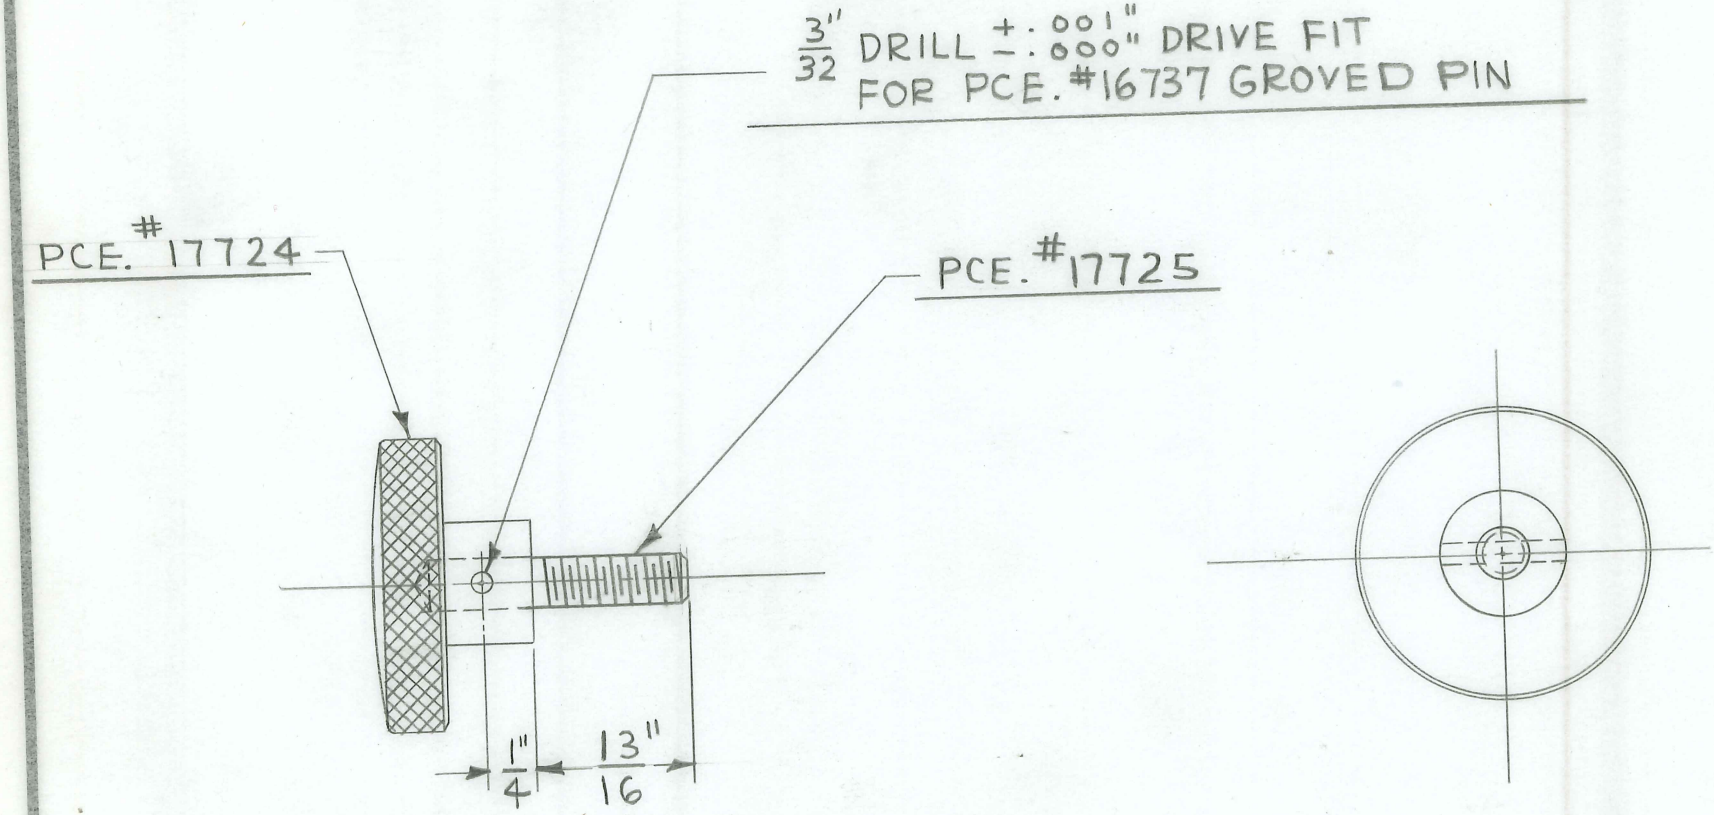

1 REQUIRED

TITLE

FISCHER HEAD CLAMP
TUBING SUPP. ROD LOCK STUD

H. G. FISCHER & CO.
FRANKLIN PARK, ILLINOIS

PART NO. 17727

DATE 10-22-48 DR. BY W. J. CH'K'D. J.V.W.

REVISION	DATE	BY

PATTERN

FINISH CAD. # 23

SCALE FULL

TOOLS

MATERIAL 1/4" DIA. BRASS ROD

DIMENSIONS
UNLESS OTHERWISE SPECIFIED

FRACTIONAL	± .015
DECIMAL	± .005
ANGULAR	± ½°

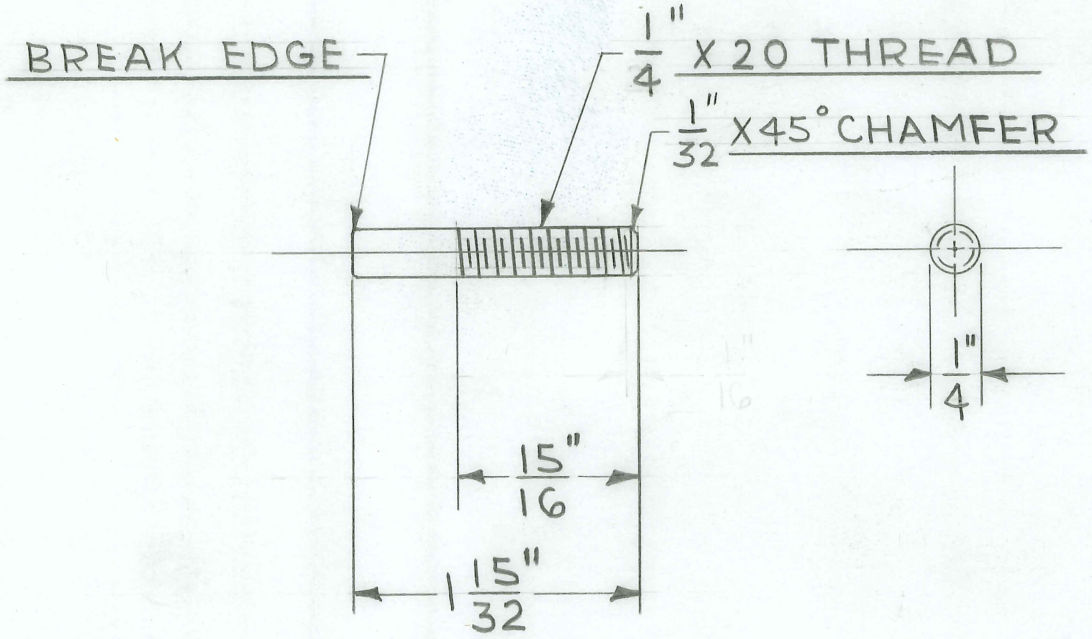

1 REQUIRED

TITLE

FISCHER HEAD CLAMP
TUBING SUPP. ROD LOCK ASSEM.

H. G. FISCHER & CO.
FRANKLIN PARK, ILLINOIS

PART NO. 17728G

DATE 10-22-48 DR. BY W. J. CH'K'D. J.V.W.

REVISION	DATE	BY

PATTERN | FINISH | SCALE FULL

TOOLS: DRILL JIG # 9962

MATERIAL

DIMENSIONS
FRACTIONAL ± .015
DECIMAL ± .005
ANGULAR ± ½°
UNLESS OTHERWISE SPECIFIED

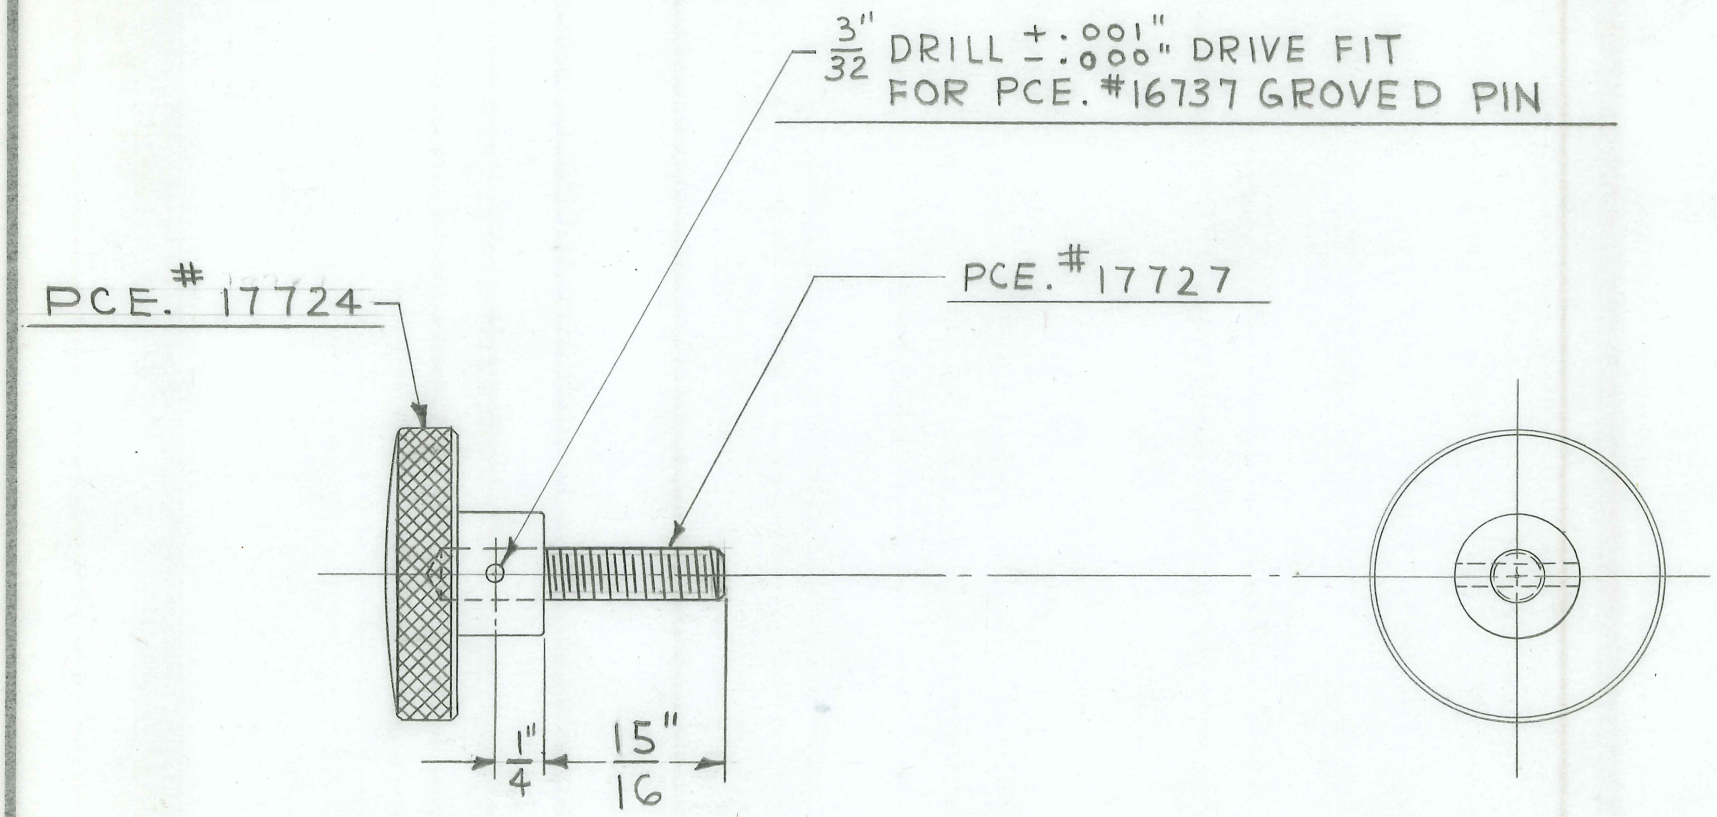

1 REQUIRED

TITLE: FISCHER FLOOR-WALL MOUNTED TILTING BUCKY STAND TIE ROD-TOP (BANTAM)

H. G. FISCHER & CO.
FRANKLIN PARK, ILLINOIS

PART NO. 17733

DATE 11-1-48 | DR. BY K.S. | CH'K'D. J.V.W.

REVISION	DATE	BY

PATTERN | FINISH CAD. #23 | SCALE FULL

TOOLS | MATERIAL $\frac{3}{8}$" DIA. C.R. STEEL

DIMENSIONS UNLESS OTHERWISE SPECIFIED
FRACTIONAL ± .015
DECIMAL ± .005
ANGULAR ± ½°

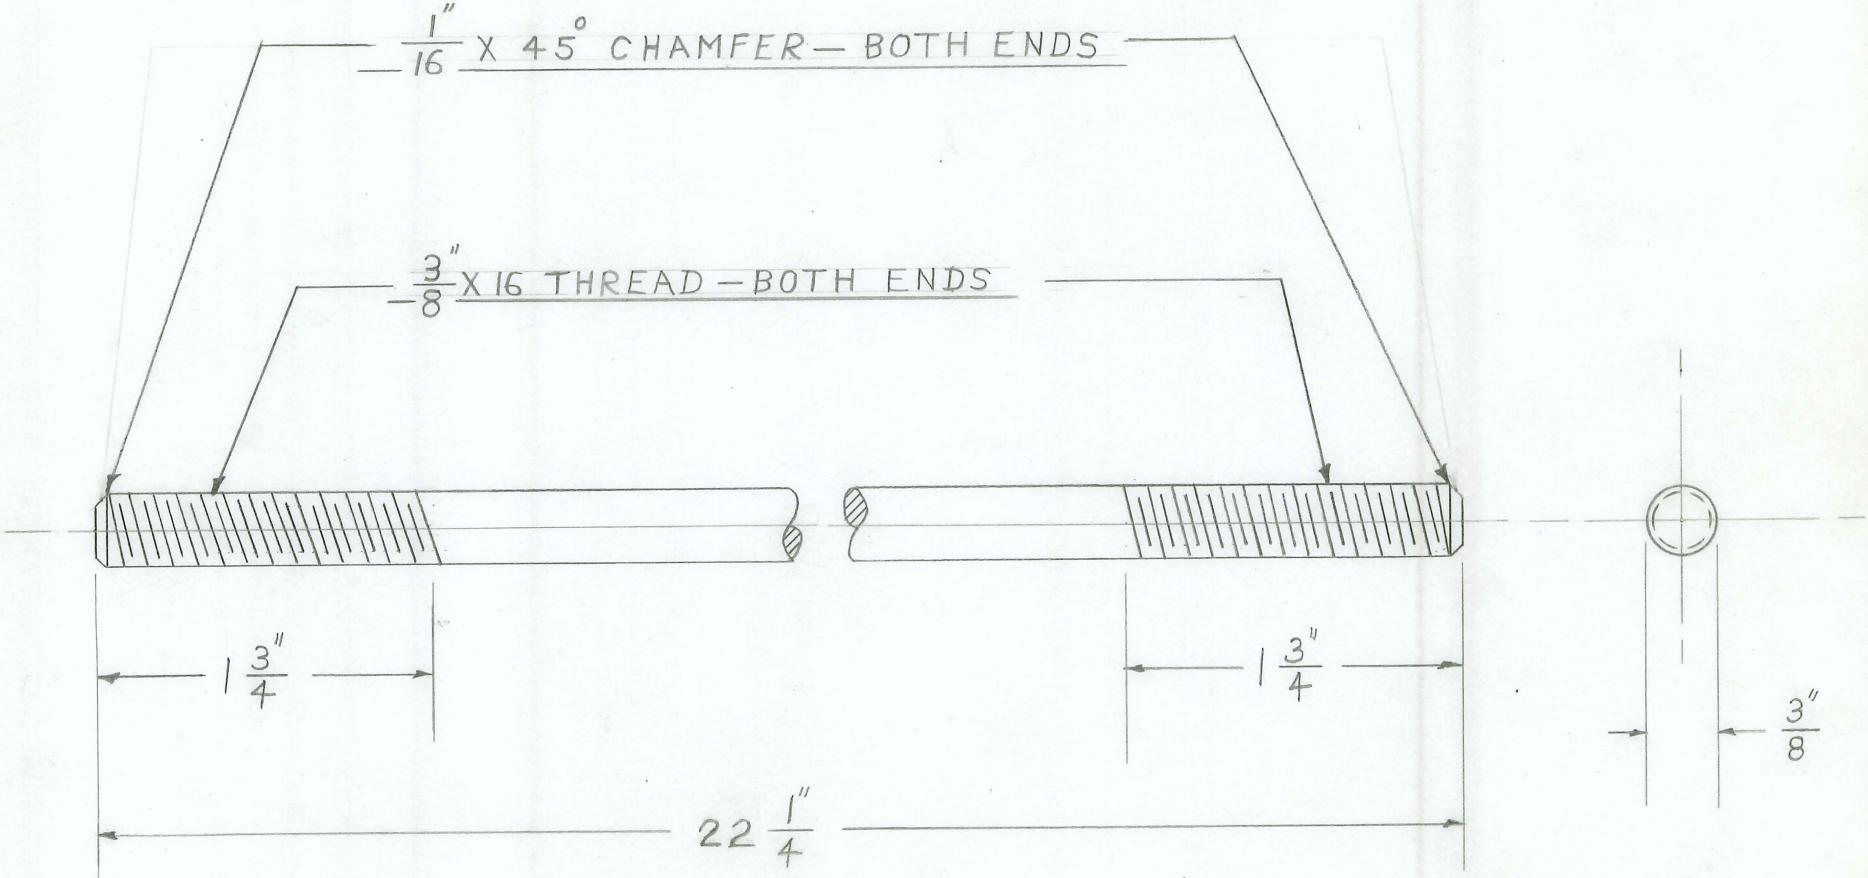

2 REQUIRED

TITLE: FISCHER FLOOR-WALL MOUNTED TILTING BUCKY STAND TIE ROD-BOTTOM (BANTAM)

H. G. FISCHER & CO.
FRANKLIN PARK, ILLINOIS

PART NO. 17734

DATE 11-1-48 | DR. BY K.S. | CH'K'D. J.V.W.

REVISION	DATE	BY

PATTERN

FINISH: CAD. #23

SCALE FULL

TOOLS

MATERIAL $\frac{1}{2}$" DIA. C.R. STEEL

DIMENSIONS
FRACTIONAL ± .015
DECIMAL ± .005
ANGULAR ± ½°
UNLESS OTHERWISE SPECIFIED

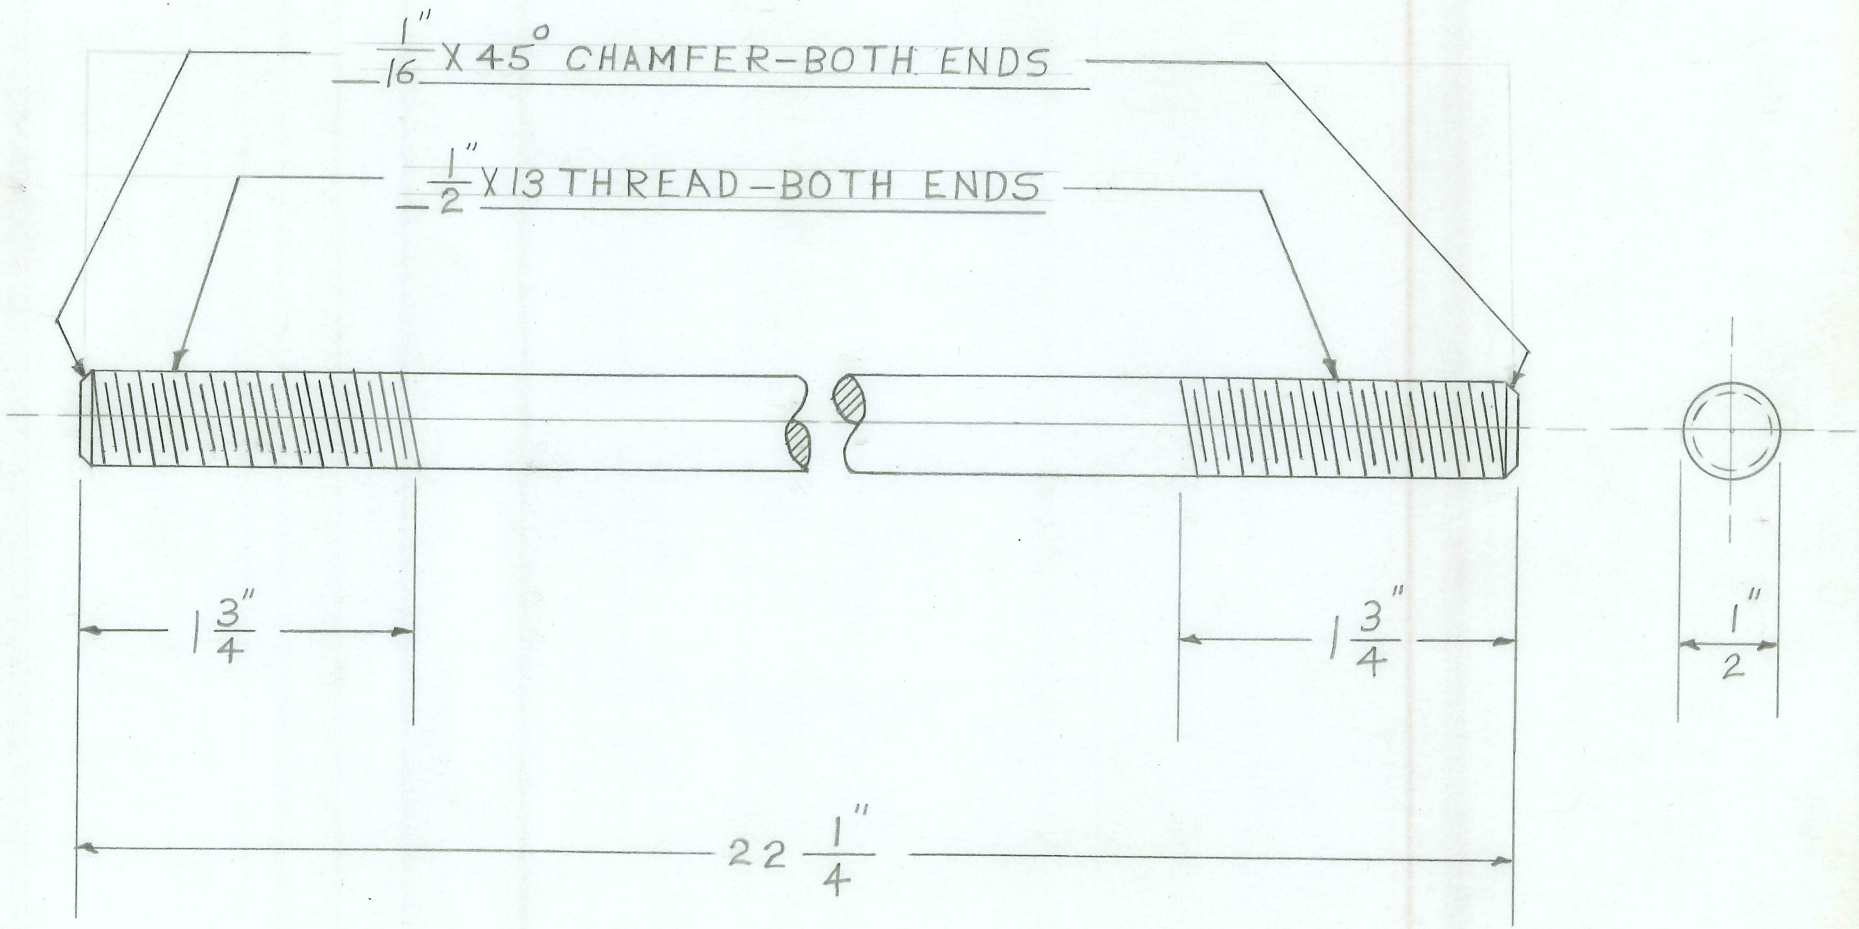

TITLE

WALL FRAME TILTING & NON TILT BUCKY CWT AND CABLE ASS'Y

PATTERN | FINISH | SCALE

MATERIAL

TOOLS

14X36 BUCKY

H. G. FISCHER & CO.
FRANKLIN PARK, ILLINOIS

DATE 4-2-68 DR. BY Kwang CH'K'D.

DIMENSIONS—UNLESS OTHERWISE SPECIFIED:
FRACTIONAL ± .015
DECIMAL ± .005
ANGULAR ± 1/2°
THREAD CHAMFER
UP TO 5/16 D.-1/32 X 45°
3/8 D. & OVER - 1/16 X 45°
REMOVE ALL BURRS & SHARP CORNERS

USED ON	QTY.	USED ON	QTY.
		177855GA	2
		178005GA	2

PART NO. 17738 GA

REVISION	DATE	BY
1 ECO 8604 S.W.R.	5/14/76	JS

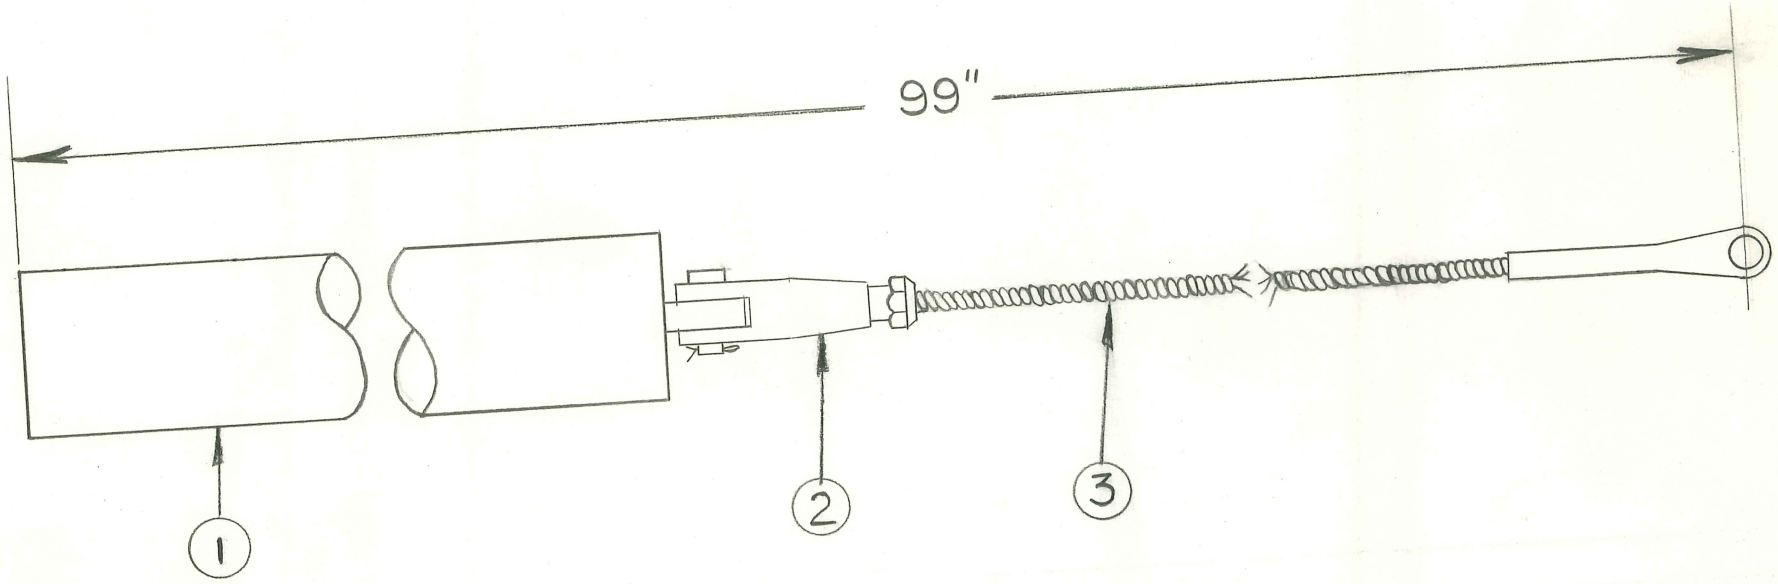

ASS'Y	1	CLEVIS	17919
ASS'Y	1	COUNTER WEIGHT CABLE	17969
ASS'Y	1	11 WEIGHT TUBE ASS'Y	177376
DEPT	AMT	DESCRIPTION	PART NO

TITLE

FISCHER HEAD CLAMP
HORIZ. ADJ. BAR

H. G. FISCHER & CO.
FRANKLIN PARK, ILLINOIS

DATE 12-3-48 | DR. BY W. J. | CH'K'D. J.V.W.

PART NO. 17739

REVISION	DATE	BY

PATTERN | FINISH | SCALE FULL

TOOLS: DRILL JIG # 10004

MATERIAL: 3/4" X 3/8" C.R. STEEL BAR

DIMENSIONS UNLESS OTHERWISE SPECIFIED
FRACTIONAL ± .015
DECIMAL ± .005
ANGULAR ± ½°

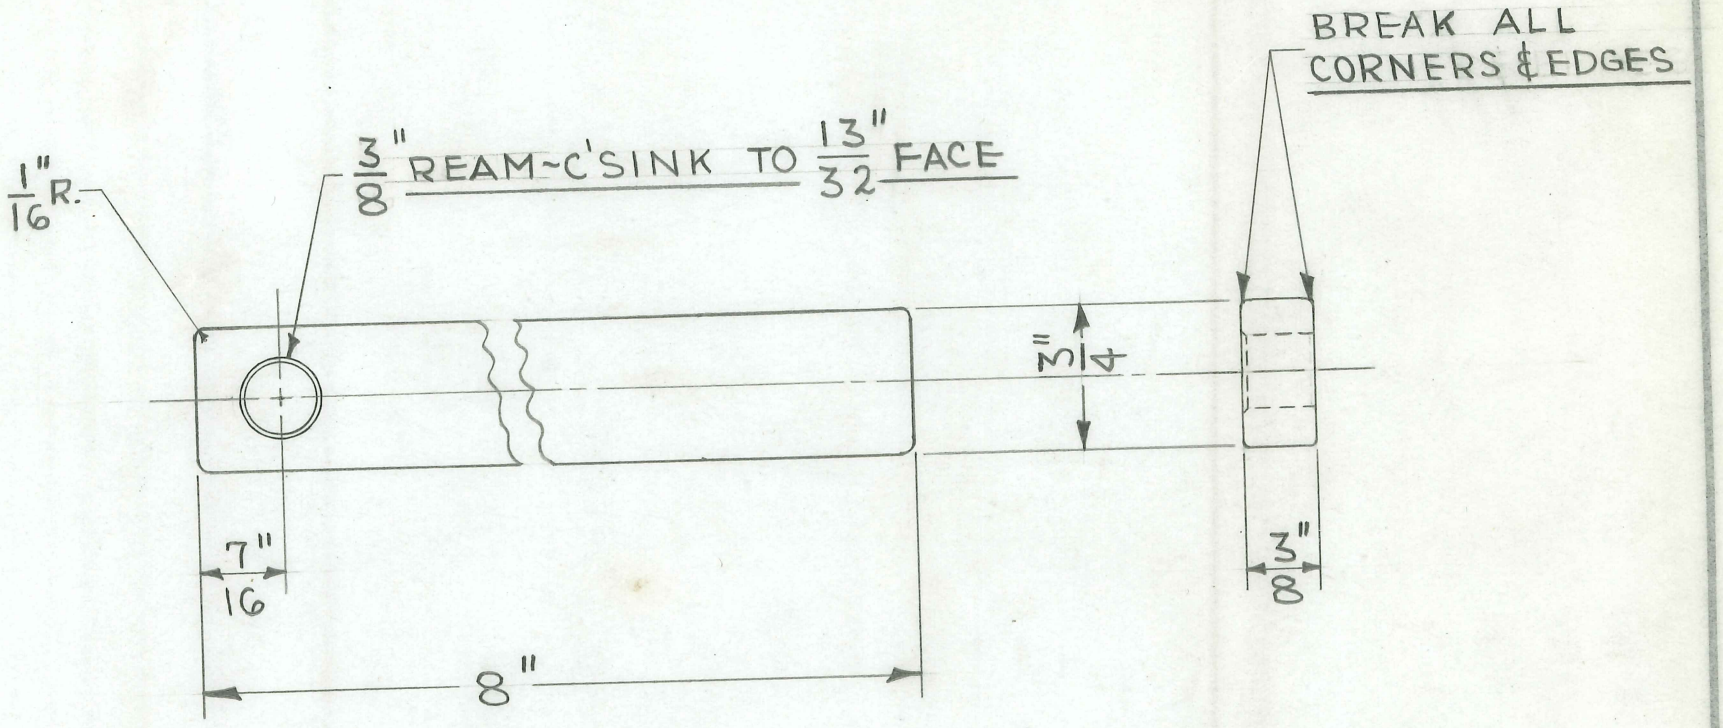

1 REQUIRED

TITLE
FISCHER HEAD CLAMP
VERT. ADJ. ROD

H. G. FISCHER & CO.
FRANKLIN PARK, ILLINOIS

DATE 12-3-48 DR. BY W. J. CH'K'D. J.V.W.

PART NO. 17741

REVISION	DATE	BY

PATTERN | FINISH | SCALE FULL

TOOLS | MATERIAL 1/2" DIA. C.R. STEEL ROD

DIMENSIONS
FRACTIONAL ± .015
DECIMAL ± .005
ANGULAR ± ½°
UNLESS OTHERWISE SPECIFIED

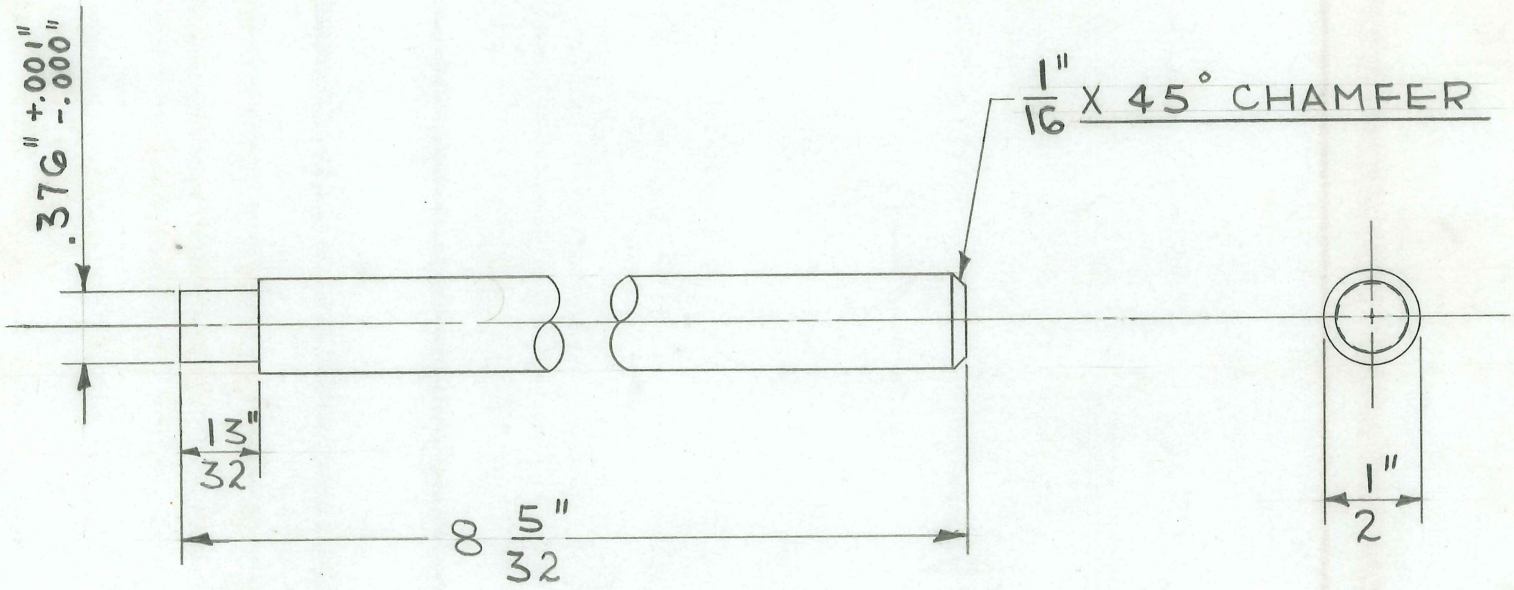

1 REQUIRED

TITLE

FISCHER HEAD CLAMP
ADJ. KNOB

H. G. FISCHER & CO.
FRANKLIN PARK, ILLINOIS

DATE 12-3-48 | DR. BY W. J. | CH'K'D. J.V.W.

PART NO. 17742F

REVISION	DATE	BY

PATTERN | FINISH | SCALE FULL

TOOLS | MATERIAL FROM 17742

DIMENSIONS
FRACTIONAL ± .015
DECIMAL ± .005
ANGULAR ± ½°
UNLESS OTHERWISE SPECIFIED

1 REQUIRED

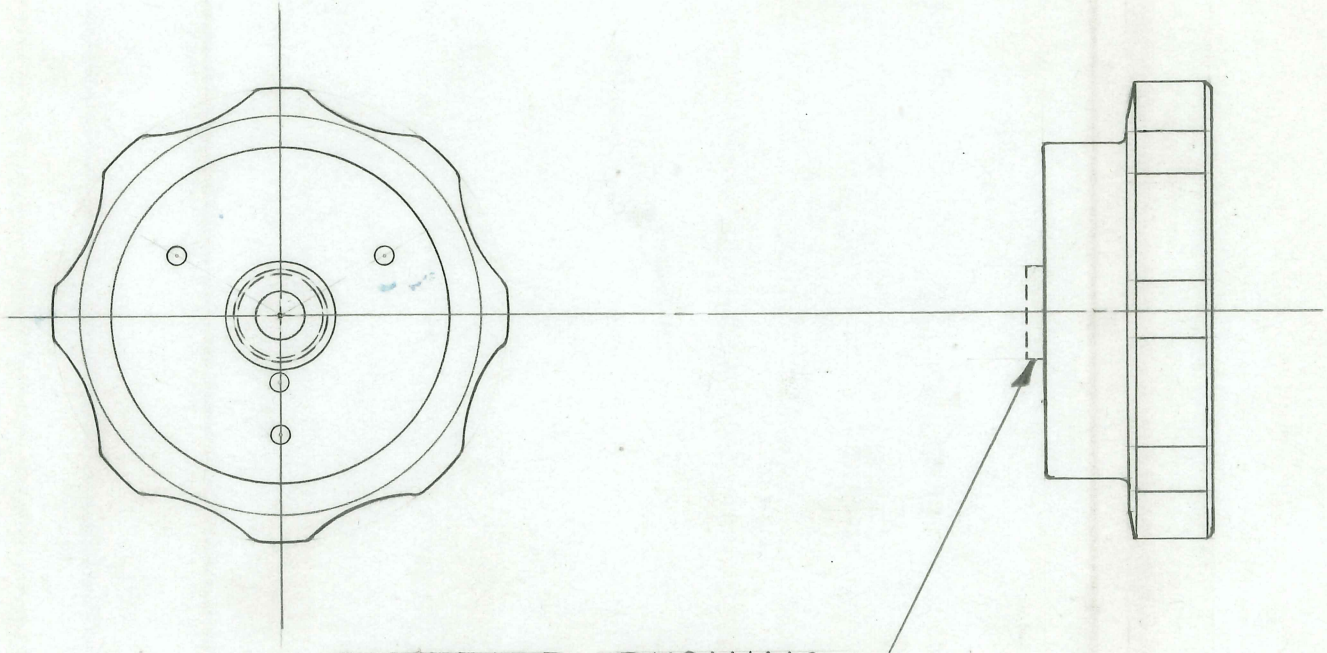

SPOTFACE BUSHING INDICATED BY DOTTED LINES DOWN TO BAKELITE SURFACE

TITLE
FISCHER HEAD CLAMP
ADJ. ROD FOR THOMPSON BRACKET

H. G. FISCHER & CO.
FRANKLIN PARK, ILLINOIS

DATE 12-3-48 | DR. BY W.J. | CH'K'D. J.V.W.

PART NO. 17743

REVISION	DATE	BY

PATTERN | FINISH | SCALE FULL

TOOLS

MATERIAL 1/4 DIA. C.R. STEEL ROD

DIMENSIONS
FRACTIONAL ± .015
DECIMAL ± .005
ANGULAR ± ½°
UNLESS OTHERWISE SPECIFIED

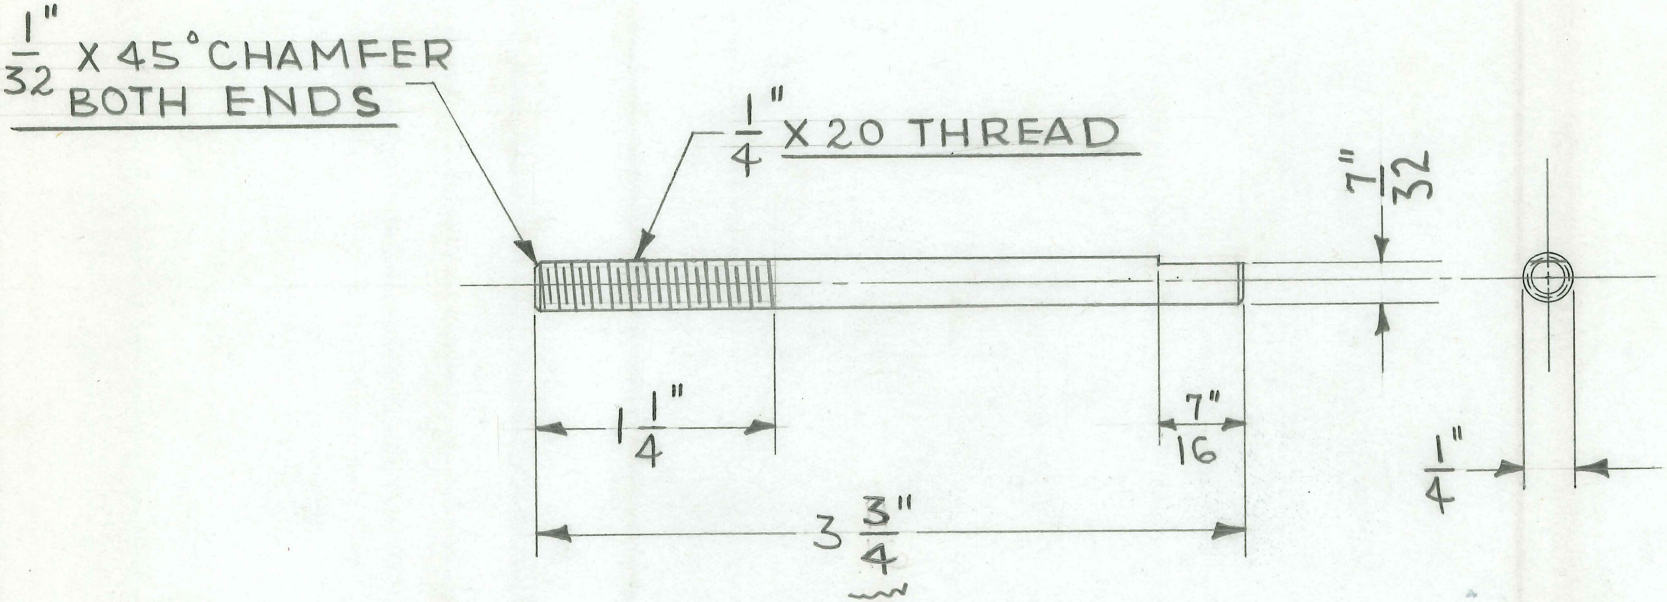

1 REQUIRED

TITLE

FISCHER HEAD CLAMP
ADJ. ROD ASSEM. FOR THOMPSON BRACKET

H. G. FISCHER & CO.
FRANKLIN PARK, ILLINOIS

DATE 12-3-48 | DR. BY W.J. | CH'K'D. J.V.W.

PART NO. 17744G

REVISION	DATE	BY

PATTERN | FINISH CAD. #23 | SCALE FULL

TOOLS: DRILL JIG # 10002

MATERIAL

DIMENSIONS
FRACTIONAL ± .015
DECIMAL ± .005
ANGULAR ± ½°
UNLESS OTHERWISE SPECIFIED

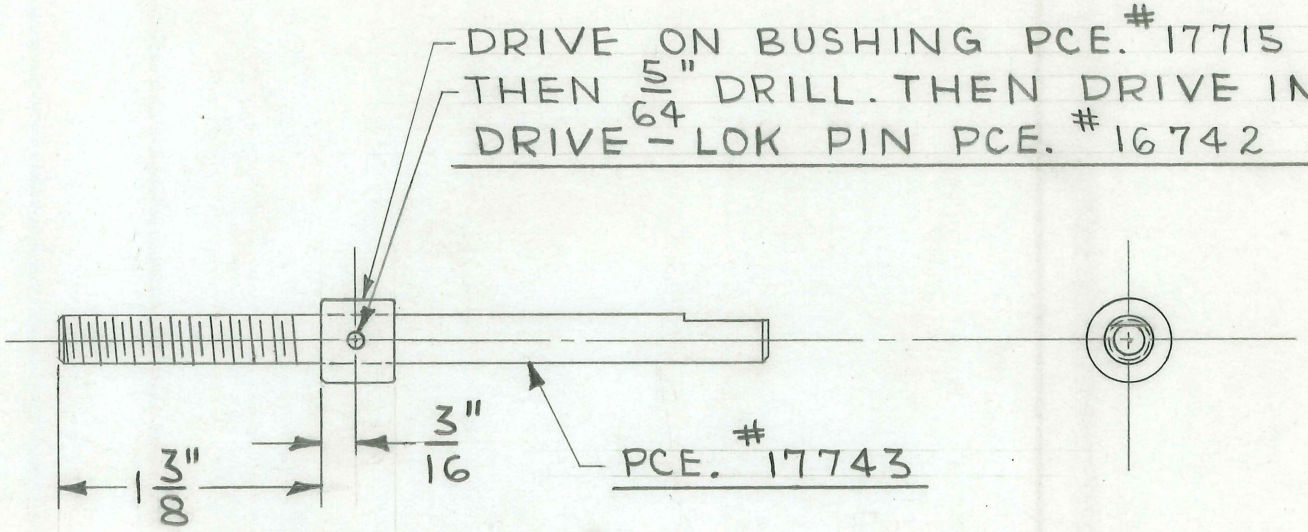

1 REQUIRED

TITLE

~~FISCHER HEAD CLAMP~~

LOCK STUD ASSEMBLY

H. G. FISCHER & CO.
FRANKLIN PARK, ILLINOIS

DATE 10-16-50 | DR. BY W.J. | CH'K'D. J.V.W.

PART NO. 17745G

REVISION		DATE	BY
A	WAS 17746	4-13-56	C.K.
B	WAS 17186A		
C	" 17186B	3/6/62	RGT
1	SEE ECO 0118	5/30/74	A.S.T.
2	" " 0224	8/30/74	J.

PATTERN | FINISH | SCALE FULL

TOOLS: DRILL JIG #9618

MATERIAL: 1 PCE. # 19173
1 PCE. # 17746 - #123 1 PCE. # 16739

DIMENSIONS UNLESS OTHERWISE SPECIFIED
FRACTIONAL ± .015
DECIMAL ± .005
ANGULAR ± ½°

DRIVE PIN NEST TOOL #13813

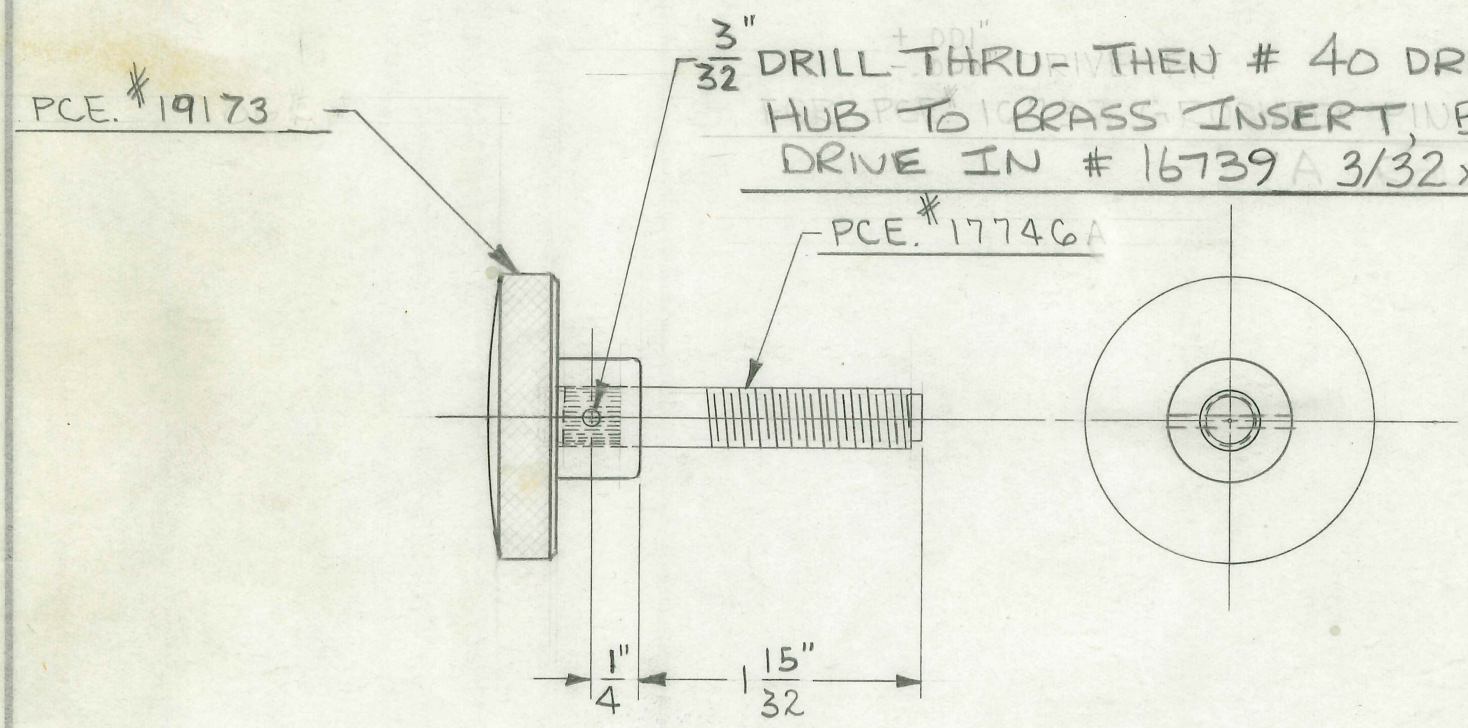

1 REQUIRED

USED ON: 38115G

FINAL ASSY'S: 17785G
17785.5G
17800.5G
17800G
3813xG

TITLE

FISCHER HEAD CLAMP
LOCK STUD

H. G. FISCHER & CO.
FRANKLIN PARK, ILLINOIS

PART NO. 17746 A

DATE 10-16-50 DR. BY W.J. CH'K'D. J.V.W.

REVISION		DATE	BY
B	ADD THD. TOLERANCE E.C.O. 1365	11/2/71	AP
1	ECO #0178	7/15/74	A.T.
2	ECO #0224	9/6/74	A.T.

PATTERN | FINISH CAD. #123 | SCALE FULL

TOOLS | MATERIAL $\frac{5}{16}$" DIA. C.R. STEEL

DIMENSIONS UNLESS OTHERWISE SPECIFIED
FRACTIONAL ± .015
DECIMAL ± .005
ANGULAR ± ½°

1 REQUIRED

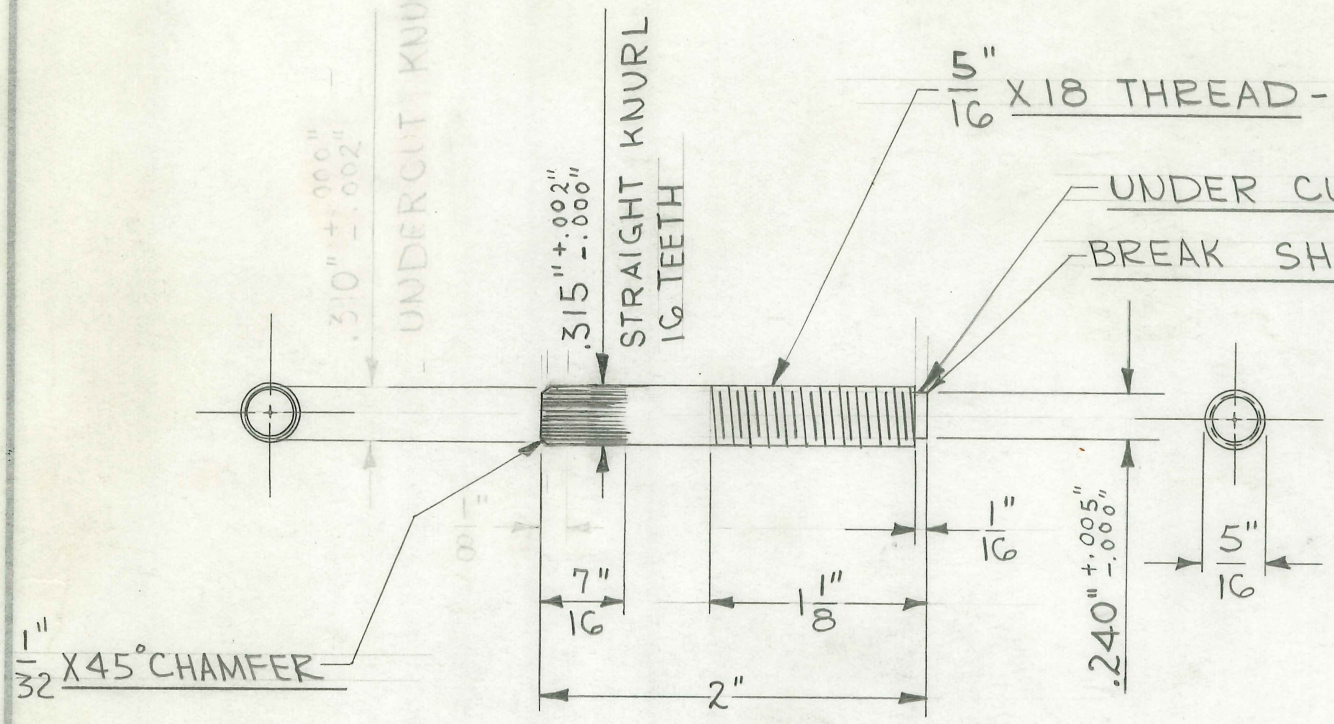

TITLE
FISCHER WALL FRAME TILTING BUCKY STAND
C'WEIGHT CABLE CONNECTOR

H. G. FISCHER & CO.
FRANKLIN PARK, ILLINOIS

PART NO. 17749 AF

DATE 1-16-52 | DR. BY W.J. | CH'K'D. RS

REVISION	DATE	BY

PATTERN | FINISH | SCALE FULL

TOOLS | MATERIAL FROM 17749

DIMENSIONS
FRACTIONAL ± .015
DECIMAL ± .005
ANGULAR ± ½°
UNLESS OTHERWISE SPECIFIED

2 REQUIRED

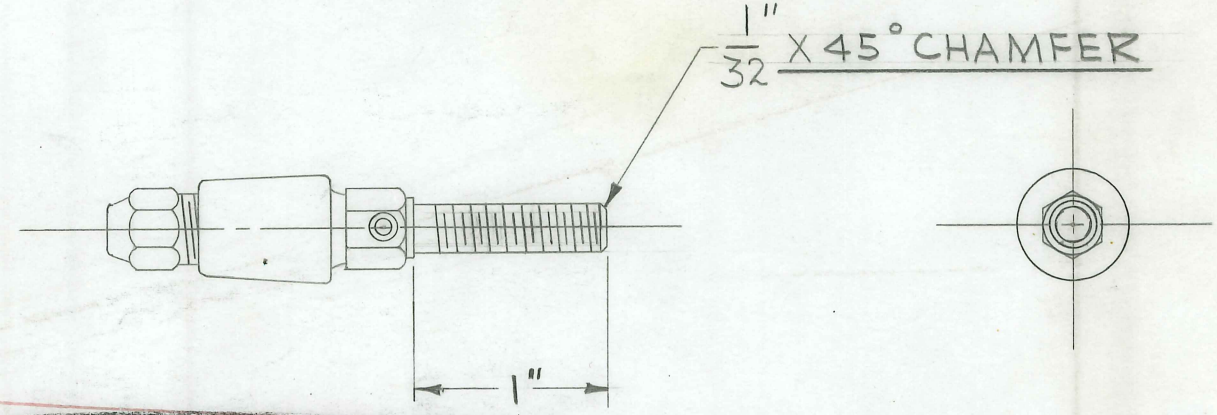

TITLE FISCHER WALL FRAME TILTING BUCKY STAND ANGULATOR PLATE BLANK

H. G. FISCHER & CO.
FRANKLIN PARK, ILLINOIS

PART NO. 17753 A

DATE 9-11-62 | DR BY R.W. | CH'K'D. RCT

REVISION	DATE	BY
A REVISED	9/11/62	RCT
B WAS 1/8 X 5/16 E.C.O. 1541	7-4-71	J.W.L.

PATTERN | FINISH PAINTED BLACK #84 | SCALE FULL

TOOLS 4 11/16 BLANK DIE
25/32 PUNCH

MATERIAL #20 GA. (.035) SHEET C.R.S.

DIMENSIONS UNLESS OTHERWISE SPECIFIED
FRACTIONAL ± .015
DECIMAL ± .005
ANGULAR ± 1/2°

~~PERF. DIE #9900~~
7/16 DIE INSERT
PUNCH & NEST
TOOL # 9997
TO BE USED WITH
MASTER DIE #9938

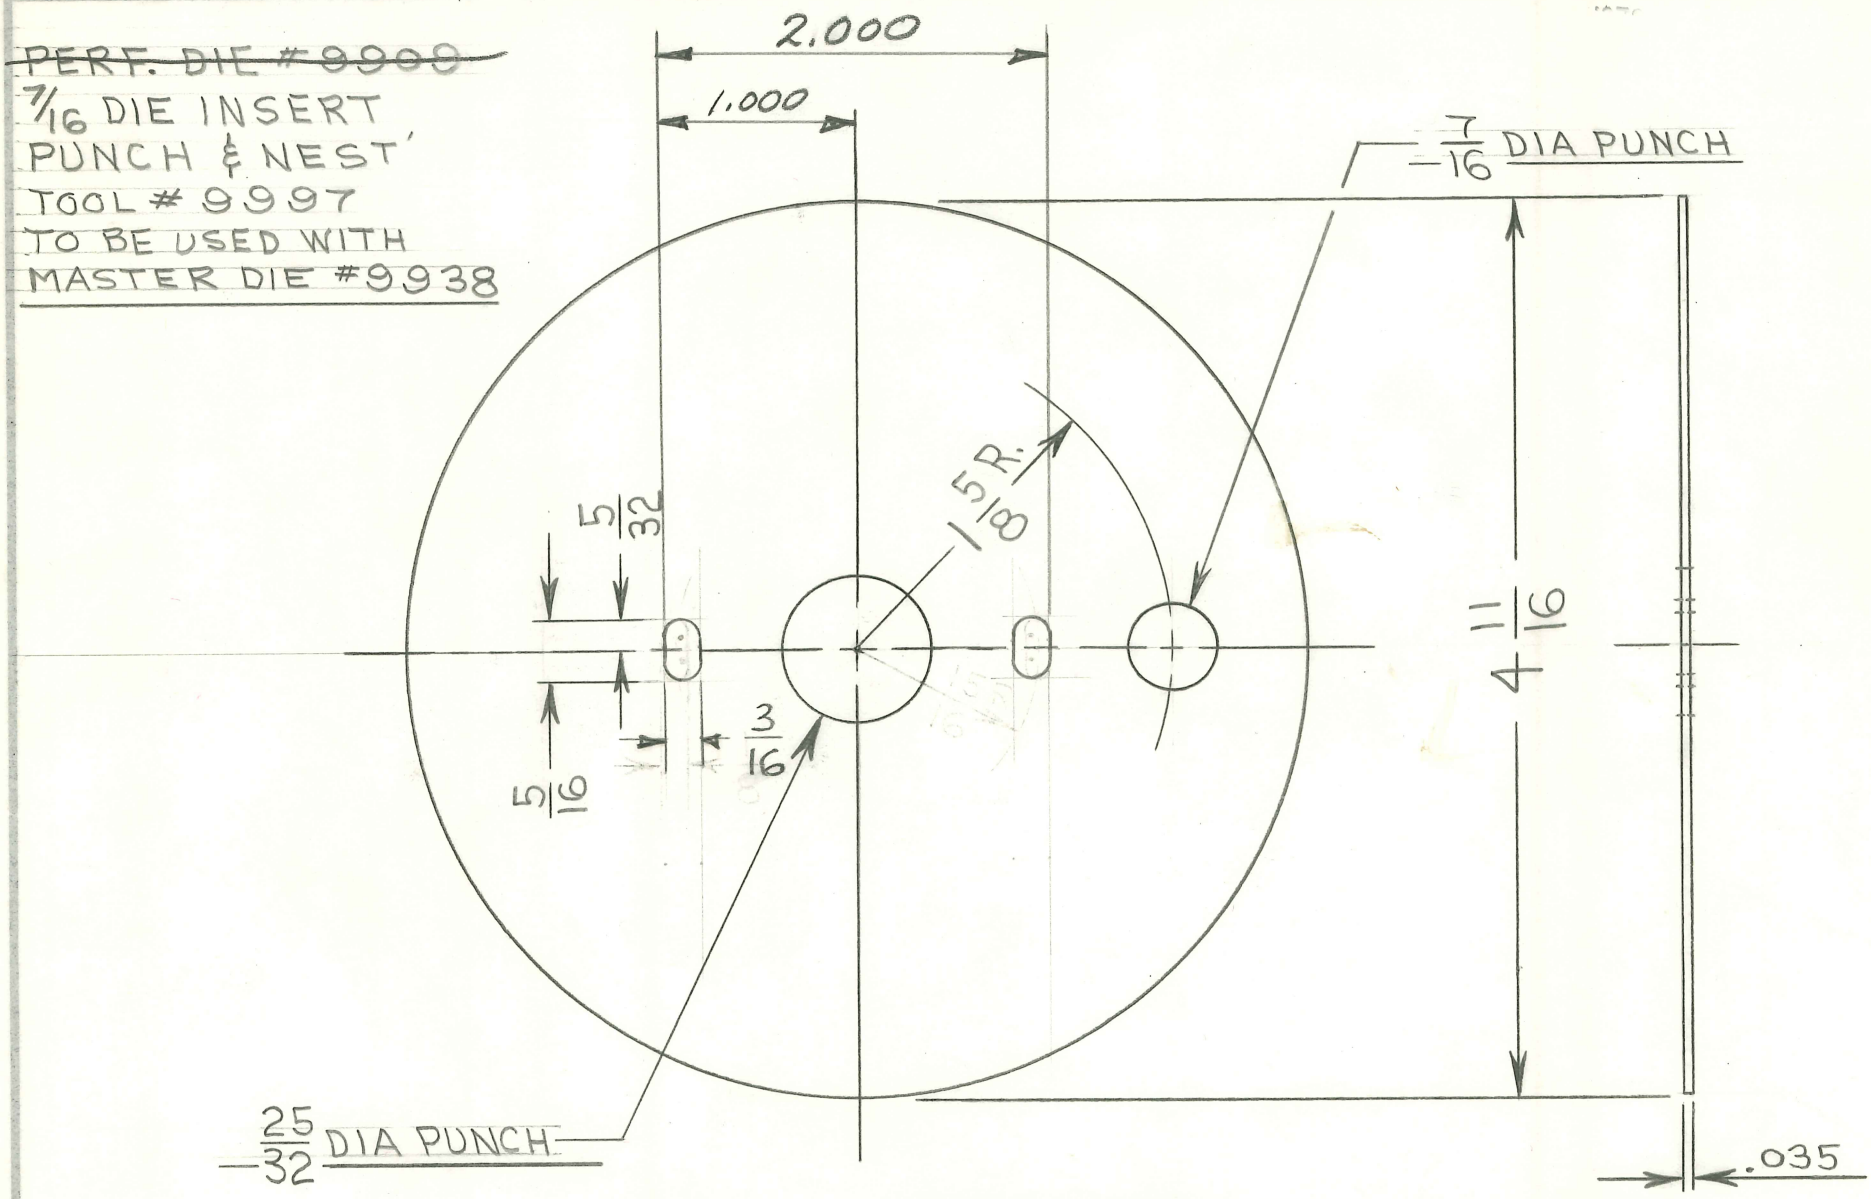

1-REQUIRED

TITLE

FISCHER WALL FRAME TILTING BUCKY STAND
ANGLE REGULATOR PLATE

H. G. FISCHER & CO.
FRANKLIN PARK, ILLINOIS

DATE 3-31-49 | DR. BY W.J. | CH'K'D. J.V.W.

PART NO. 17753AF

REVISION	DATE	BY
A REVISED	9/11/62	RCT

PATTERN | FINISH SEE NOTE | SCALE FULL

TOOLS 4"/16 BLANK DIE
25/32 PUNCH

MATERIAL FROM # 17753A

DIMENSIONS UNLESS OTHERWISE SPECIFIED
FRACTIONAL ± .015
DECIMAL ± .005
ANGULAR ± ½°

1 REQUIRED

NOTE:
ZERO MARKS - "0" - MUST BE ON CENTER-LINE AS SHOWN

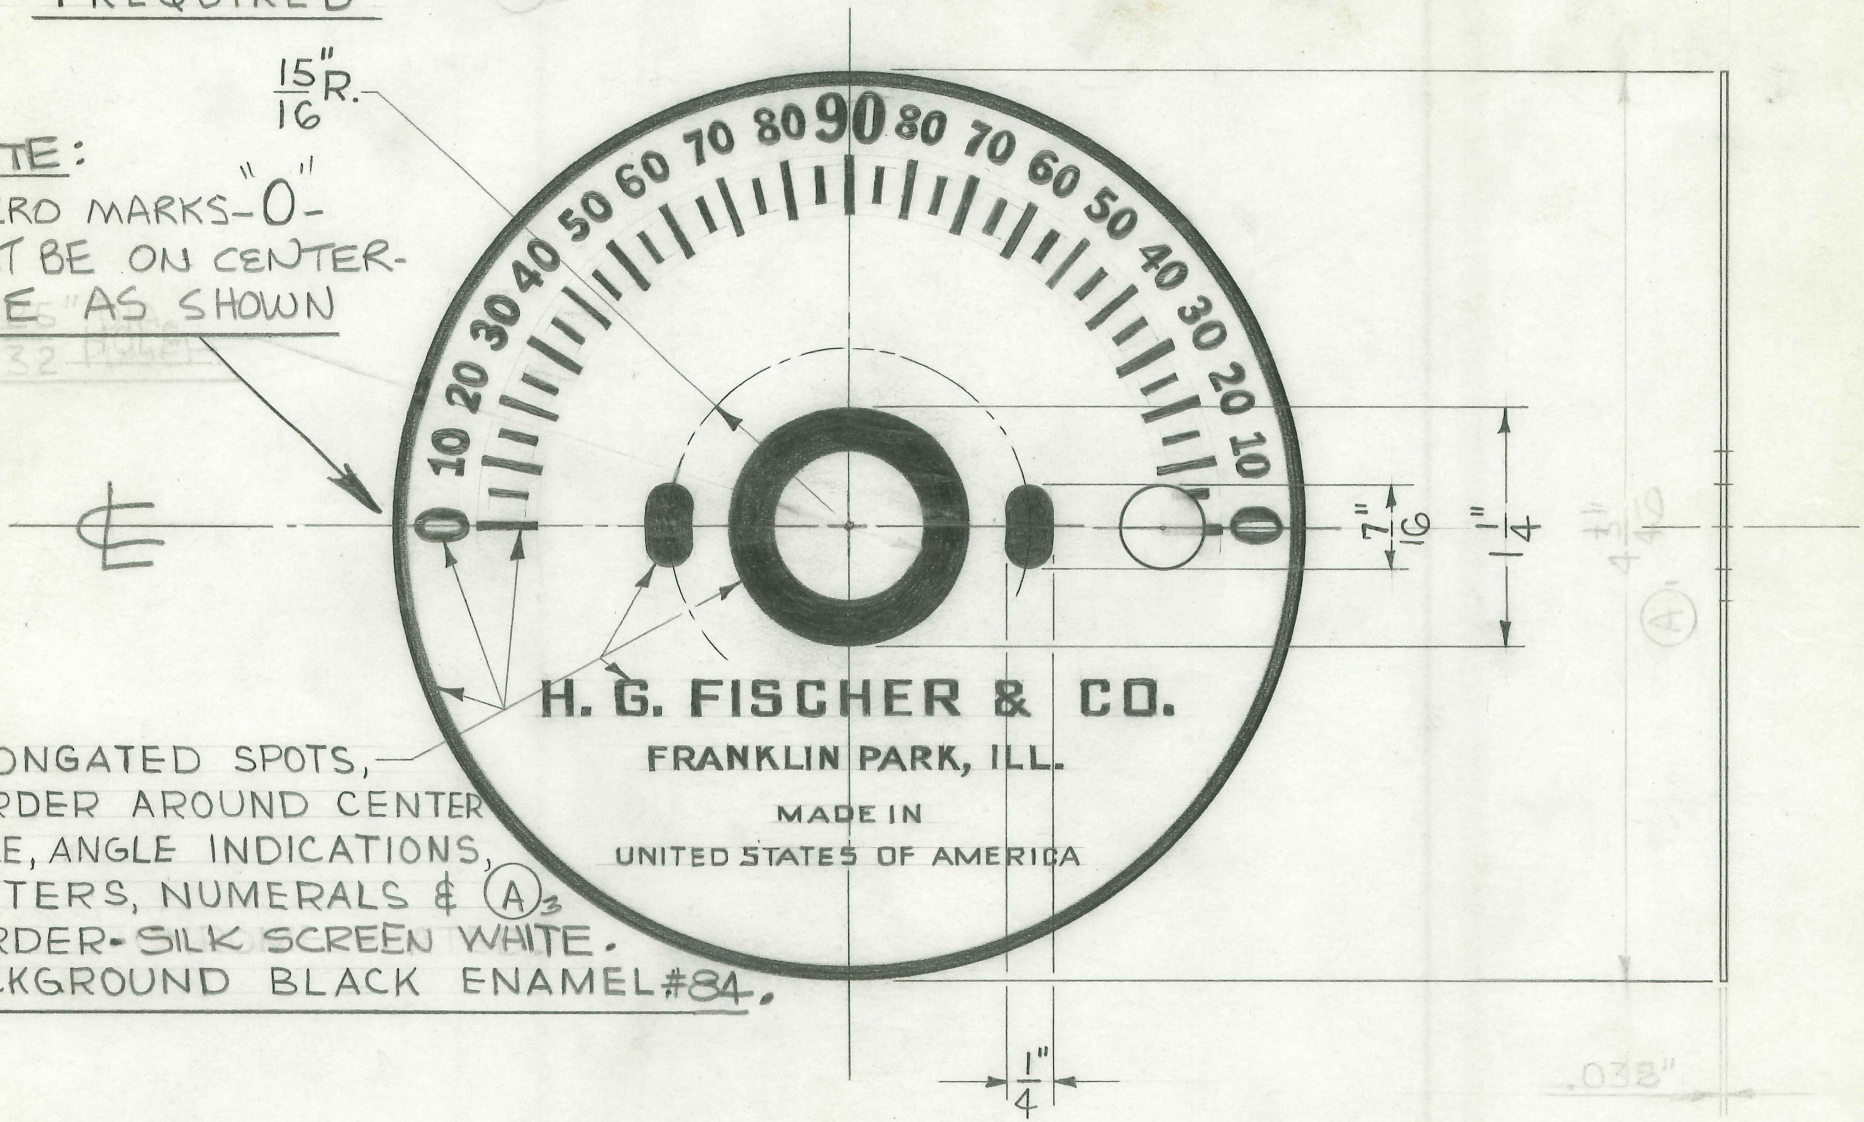

ELONGATED SPOTS, BORDER AROUND CENTER HOLE, ANGLE INDICATIONS, LETTERS, NUMERALS & (A)3
BORDER - SILK SCREEN WHITE.
BACKGROUND BLACK ENAMEL #84.

TITLE

FISCHER TILTING BUCKY STAND
ANGLE INDICATOR

PATTERN | FINISH | SCALE FULL

TOOLS | MATERIAL

H. G. FISCHER & CO.
FRANKLIN PARK, ILLINOIS

DATE | DR. BY A.A.S. | CH'K'D.

DIMENSIONS
FRACTIONAL ± .015
DECIMAL ± .005
ANGULAR ± ½°
UNLESS OTHERWISE SPECIFIED

PART NO. 17758

REVISION	DATE	BY

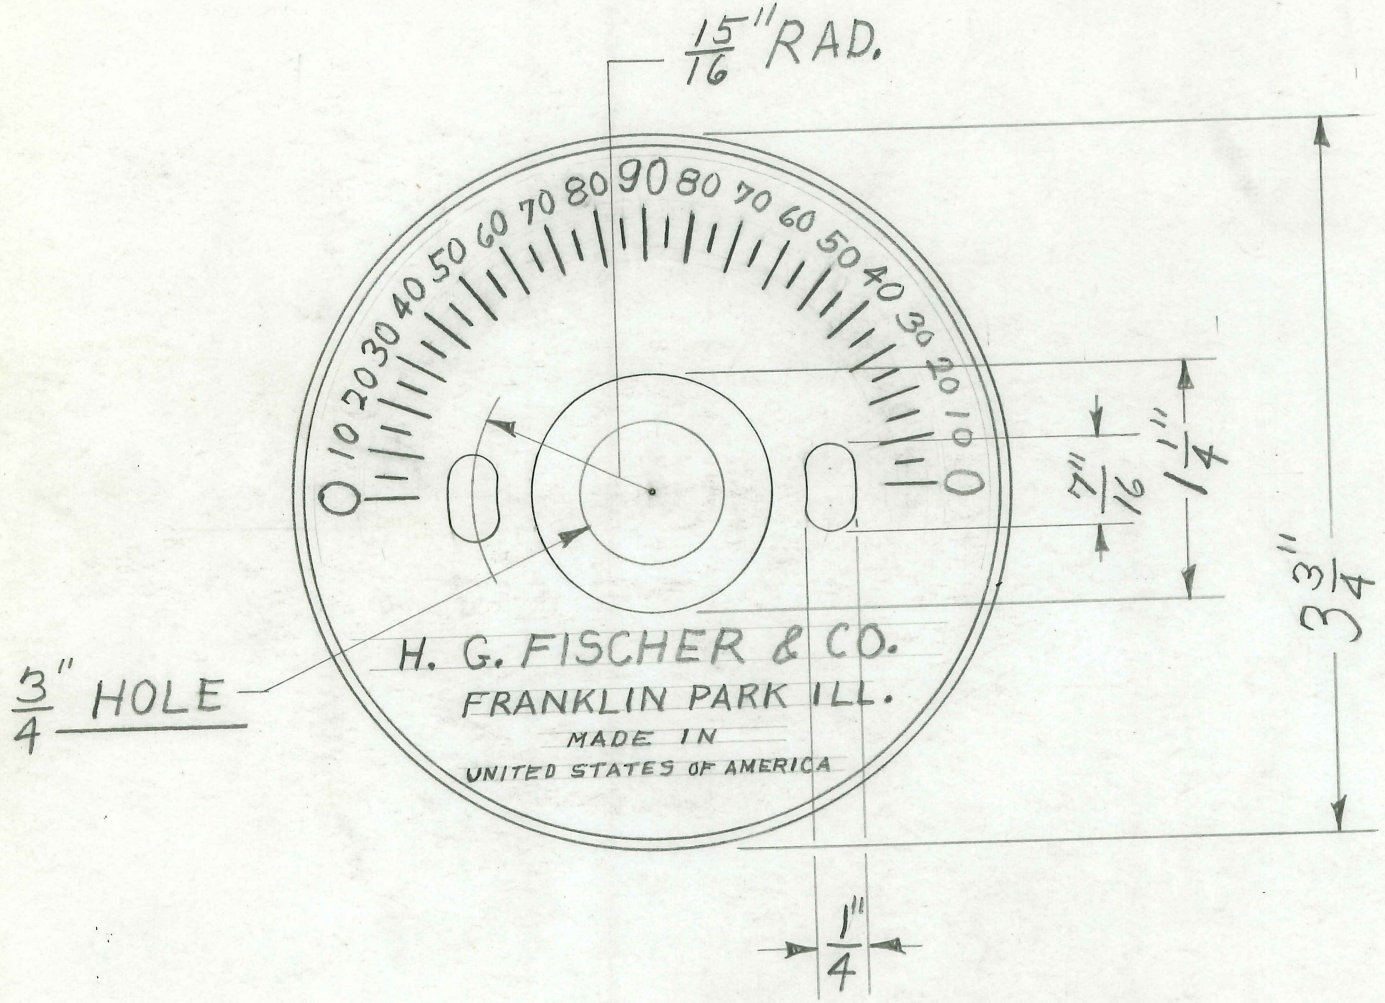

TITLE	FISCHER FLOOR-WALL MOUNTED 8X10 TILTING BUCKY STAND TIE ROD – TOP	H. G. FISCHER & CO. FRANKLIN PARK, ILLINOIS	PART NO. 17760A
		DATE 9-8-48 DR. BY J.B.G. CH'K'D. RS	REVISION: A — WAS 21 1/4 — DATE: 5-8-50 — BY: W.J.
PATTERN	FINISH CAD. #23	SCALE FULL	DIMENSIONS: FRACTIONAL ± .015; DECIMAL ± .005; ANGULAR ± ½°; UNLESS OTHERWISE SPECIFIED
TOOLS	MATERIAL 3/8" DIA. C.R. STEEL ROD		

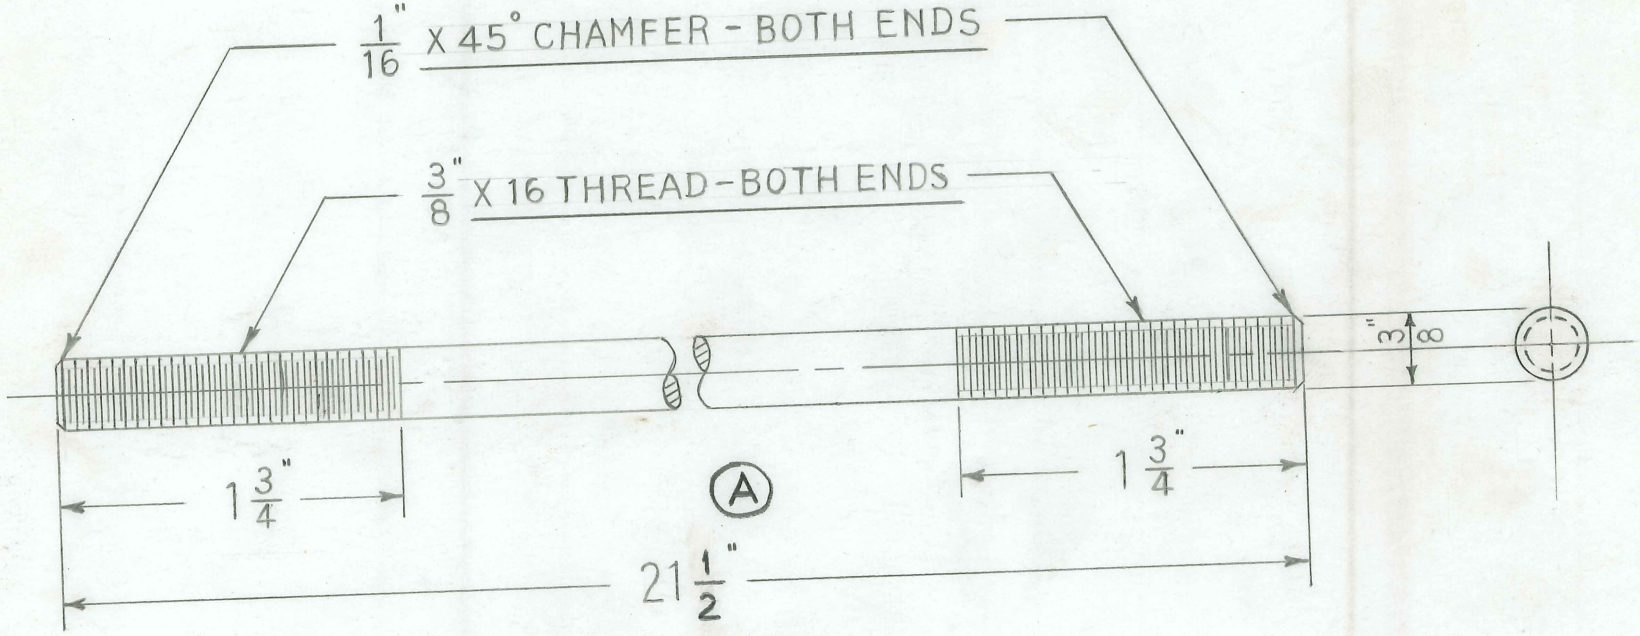

2 - REQUIRED

TITLE: FISCHER FLOOR-WALL MOUNTED 8"X10" TILTING BUCKY STAND TIE ROD - BOTTOM

H. G. FISCHER & CO.
FRANKLIN PARK, ILLINOIS

PART NO. 17761A

DATE 9-9-48 | DR. BY J.B.G. | CH'K'D.

PATTERN	FINISH	SCALE
	CAD. #23	FULL

TOOLS

MATERIAL $\frac{1}{2}$" DIA. C.R. STEEL ROD

DIMENSIONS
FRACTIONAL ± .015
DECIMAL ± .005
ANGULAR ± ½°
UNLESS OTHERWISE SPECIFIED

REVISION	DATE	BY
A WAS 21 $\frac{1}{4}$"	5-8-50	W.J.

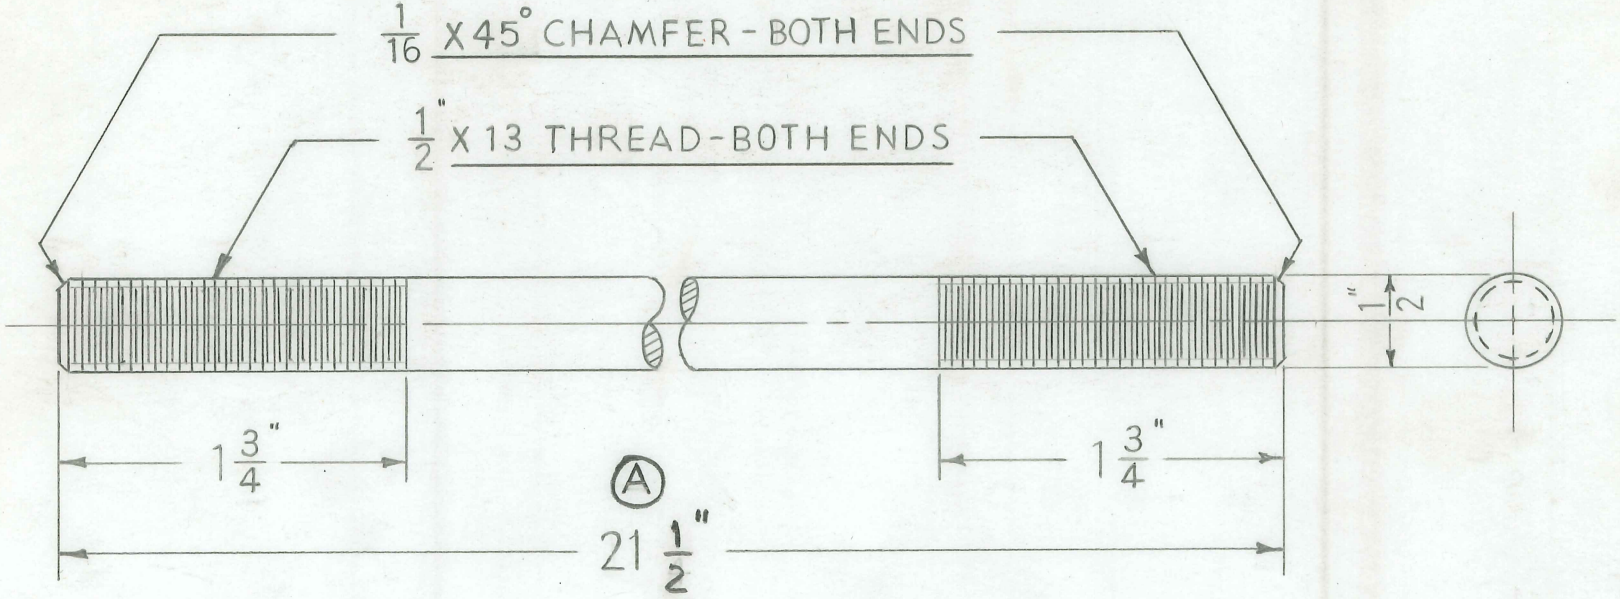

1-REQUIRED

TITLE: SPACER 3/8 – 1/4 × 5/16

H. G. FISCHER, INC.
FRANKLIN PARK, ILLINOIS

PART NO. 17767

DATE: 7-9-76 | DR. BY: S.W.R. | CH'K'D:

REVISION: RELEASE # 175 JJS 8/6/76

FINISH OR COLOR: CAD PLATE # 123

SCALE: FULL SIZE

MATERIAL: C.R.S. 3/8 O.D.

TOLERANCES UNLESS OTHERWISE SPECIFIED

.X	± .030
.XX	± .010
.XXX	± .005
ANGULAR	± 1/2°

17767

USED ON	QTY.
	2

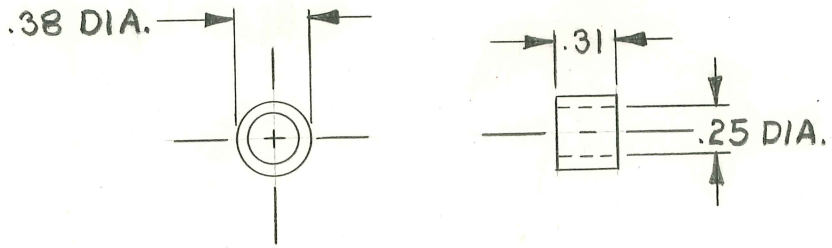

TITLE
FISCHER WALL-FRAME TILTING BUCKY STAND
C'WEIGHT CABLE PULLEY BUSHING

H. G. FISCHER & CO.
FRANKLIN PARK, ILLINOIS

PART NO. 17767A

DATE 9-15-48 | DR. BY W. J. | CH'K'D. J.V.W.

REVISION	DATE	BY
A WAS .318"	11-29-48	W.J.

PATTERN | FINISH | SCALE FULL

TOOLS | MATERIAL 3/8" JEWELERS ROD

DIMENSIONS
FRACTIONAL ± .015
DECIMAL ± .005
ANGULAR ± ½°
UNLESS OTHERWISE SPECIFIED

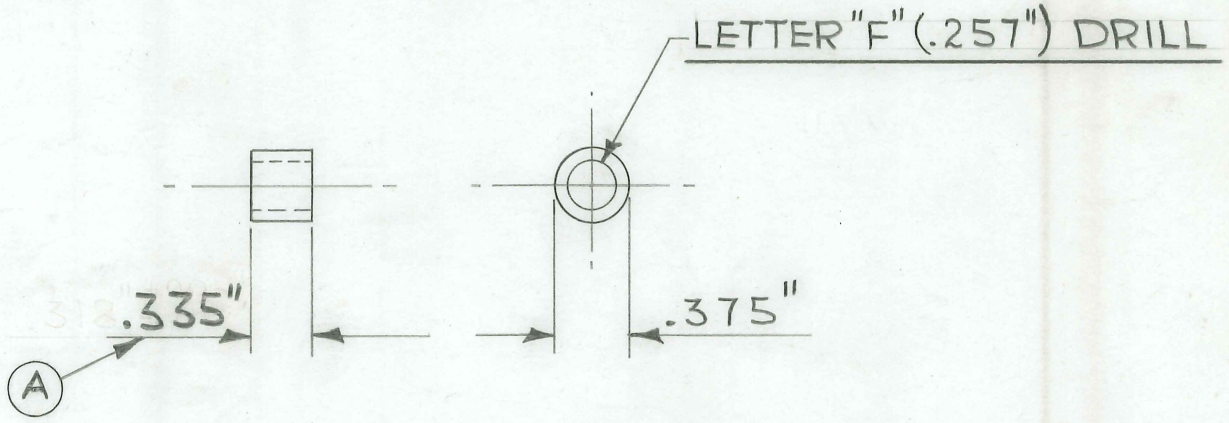

2 REQUIRED

TITLE
FISCHER WALL FRAME TILTING BUCKY STAND
ANGLE INDICATOR POINTER

H. G. FISCHER & CO.
FRANKLIN PARK, ILLINOIS

PART NO. 17780A

DATE 7-12-49 | DR. BY W.J. | CH'K'D. J.V.W.

REVISION		DATE	BY
A	WAS 1/32" C.R.S.	3-8-54	W.J.
*	CHG TO PUNCHING	5-14-56	KTK

PATTERN | FINISH | SCALE FULL

TOOLS: DRILL JIG # 9931

MATERIAL: .040" SHEET 3S - H14 ALUMINUM

DIMENSIONS UNLESS OTHERWISE SPECIFIED
FRACTIONAL ± .015
DECIMAL ± .005
ANGULAR ± ½°

1 REQUIRED

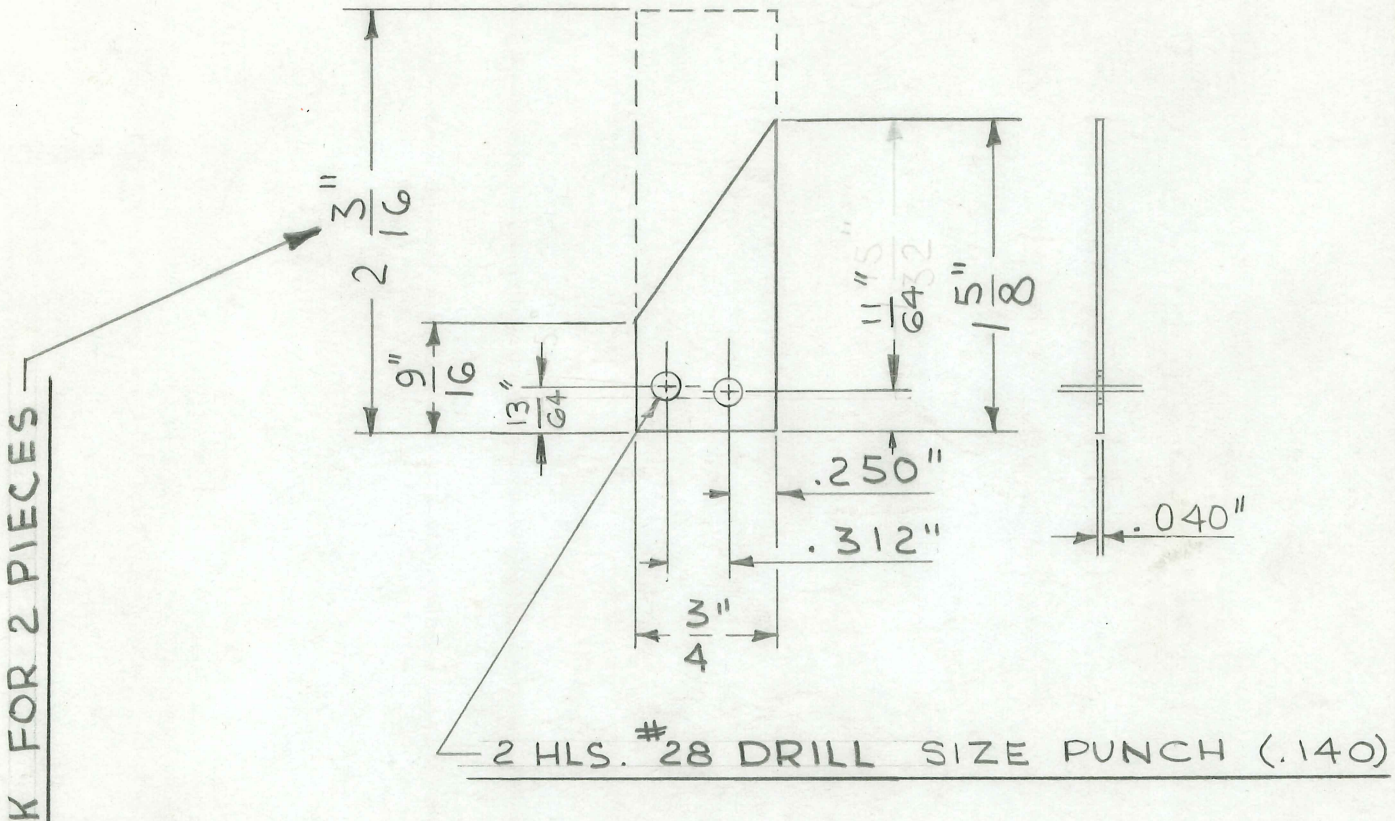

TITLE
FISCHER WALL FRAME TILTING BUCKY STAND
ANGLE INDICATOR POINTER - LEFT

H. G. FISCHER & CO.
FRANKLIN PARK, ILLINOIS

PART NO. 17780AF

DATE 7-12-49 | DR. BY W.J. | CH'K'D. J.V.W.

REVISION	DATE	BY

PATTERN | FINISH RED ANODIZE #30 | SCALE FULL

TOOLS: NEST FOR "V" DIE TOOL #4662

MATERIAL: FROM 17780 A

DIMENSIONS
FRACTIONAL ± .015
DECIMAL ± .005
ANGULAR ± ½°
UNLESS OTHERWISE SPECIFIED

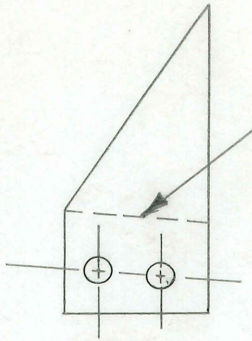

BEND ON DOTTED LINE

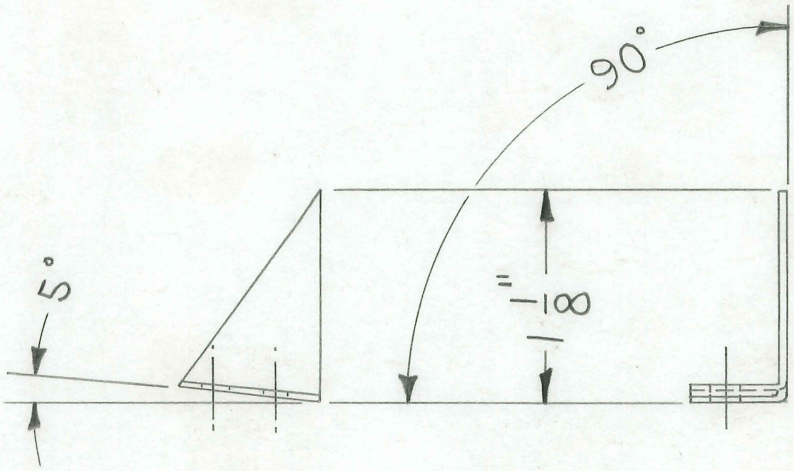

1 REQUIRED

TITLE
FISCHER WALL FRAME TILTING BUCKY STAND
ANGLE INDICATOR POINTER - RIGHT

H. G. FISCHER & CO.
FRANKLIN PARK, ILLINOIS

PART NO. 17780 1/2 A

DATE 1-14-49 DR. BY W.J. CH'K'D. J.V.W.

REVISION	DATE	BY

PATTERN | FINISH RED ANODIZE #30 | SCALE FULL

TOOLS NEST FOR V DIE | MATERIAL FROM 17780 A BLANK PCE. #17780

DIMENSIONS
FRACTIONAL ± .015
DECIMAL ± .005
ANGULAR ± ½°
UNLESS OTHERWISE SPECIFIED

1 REQUIRED

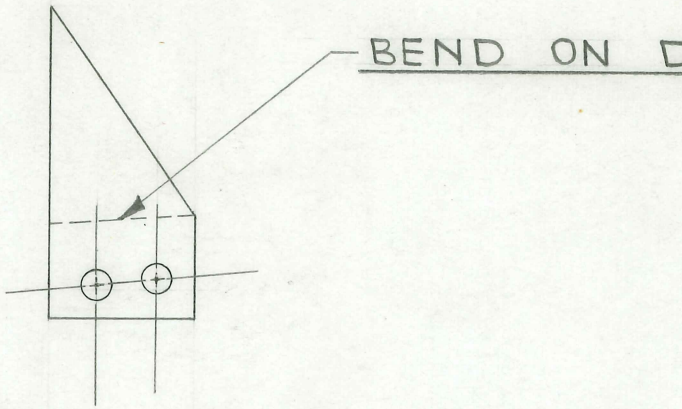

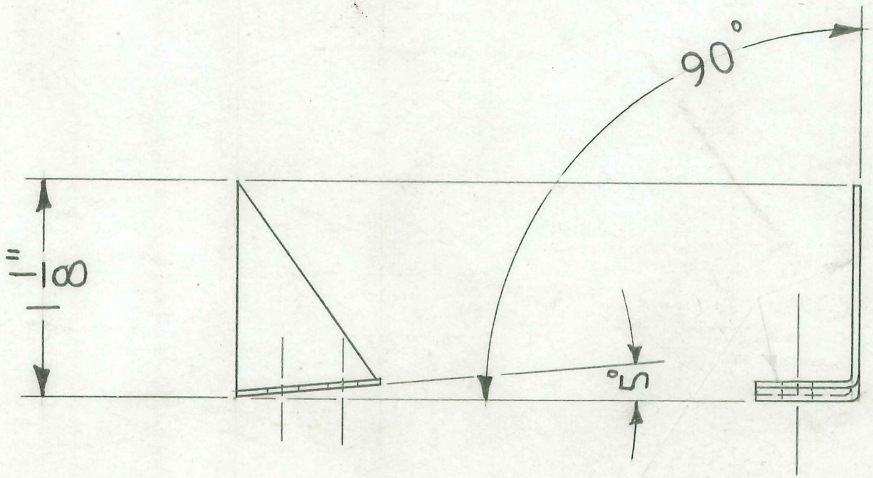

POLISH THESE 2 SURFACES ONLY

TITLE
FISCHER HEAD CLAMP
8" X 10" BUCKY HEAD CLAMP SUPP. BLOCK

H. G. FISCHER & CO.
FRANKLIN PARK, ILLINOIS

PART NO. 17782

DATE 9-24-48 DR. BY W. J. CH'K'D. J.V.W.

REVISION	DATE	BY

PATTERN | FINISH | SCALE FULL

TOOLS
DRILL JIG TOOL #9898

MATERIAL $\frac{3}{8}$" X $\frac{3}{4}$" ALUM. BAR 24ST

DIMENSIONS
FRACTIONAL ± .015
DECIMAL ± .005
ANGULAR ± ½°
UNLESS OTHERWISE SPECIFIED

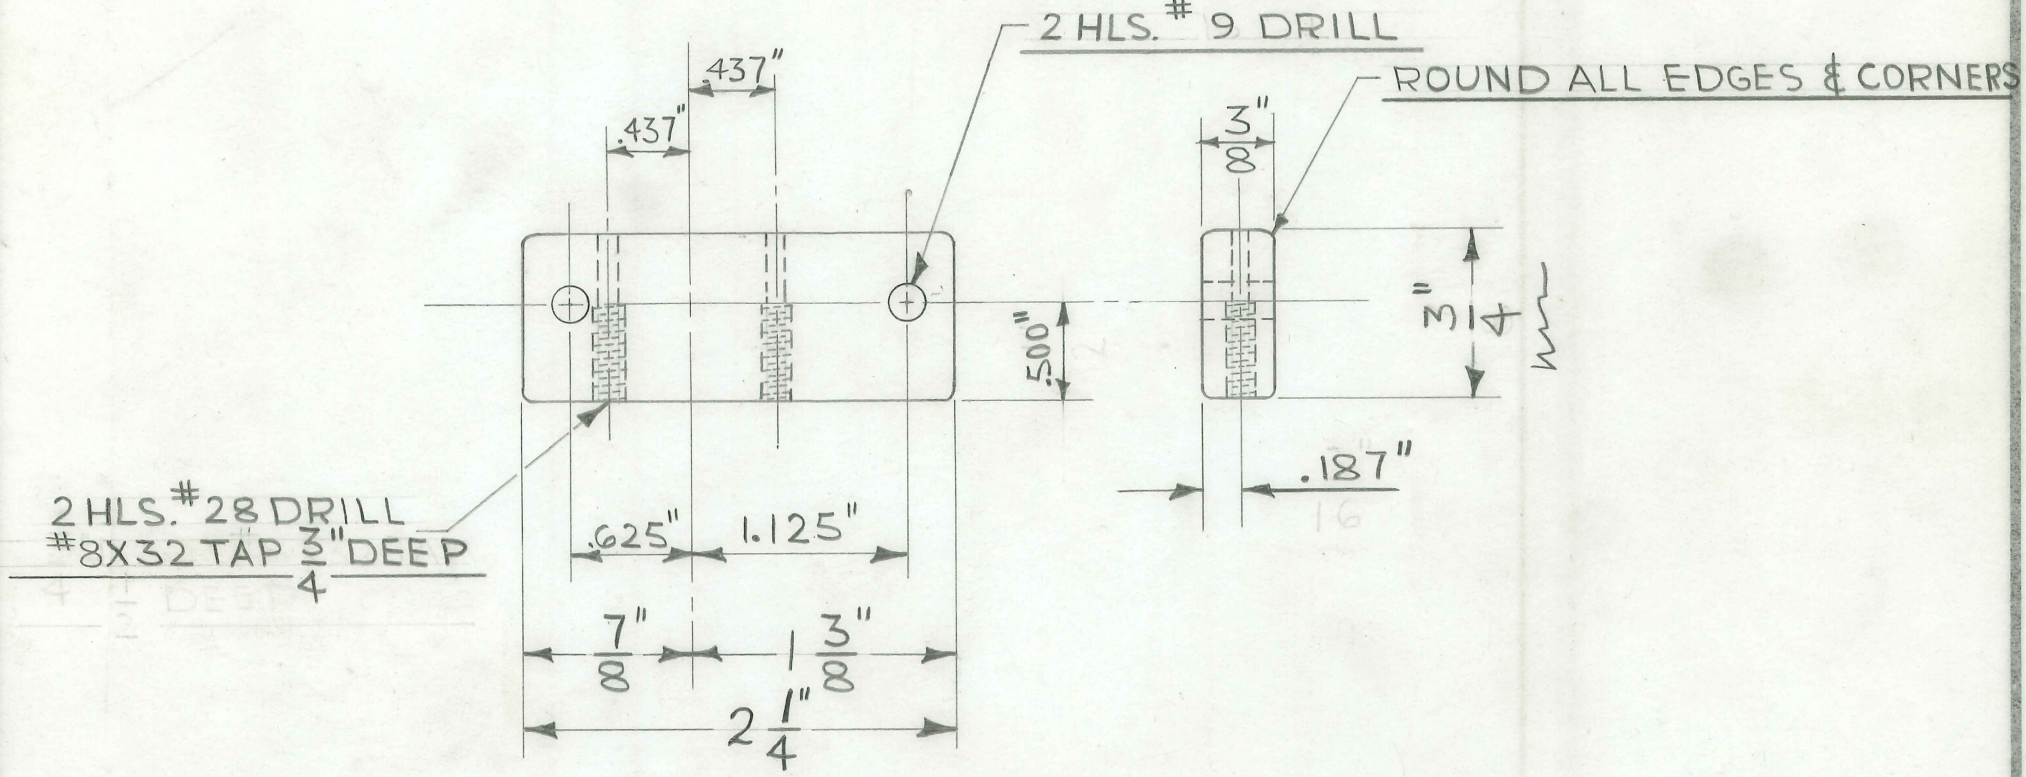

1 REQUIRED

TITLE
FISCHER WALL FRAME TILTING BUCKY STAND
SPACING WASHER

H. G. FISCHER & CO.
FRANKLIN PARK, ILLINOIS

PART NO. 17786

DATE 9-27-48 DR. BY W.J. CH'K'D. J.V.W.

REVISION	DATE	BY

PATTERN | FINISH CAD. #23 | SCALE FULL

TOOLS
BLANKING DIE TOOL # 1096
PIERCING DIE TOOL # 249
WITH NEST.

MATERIAL 1/32" C.R. SHEET STEEL

DIMENSIONS
FRACTIONAL ± .015
DECIMAL ± .005
ANGULAR ± ½°
UNLESS OTHERWISE SPECIFIED

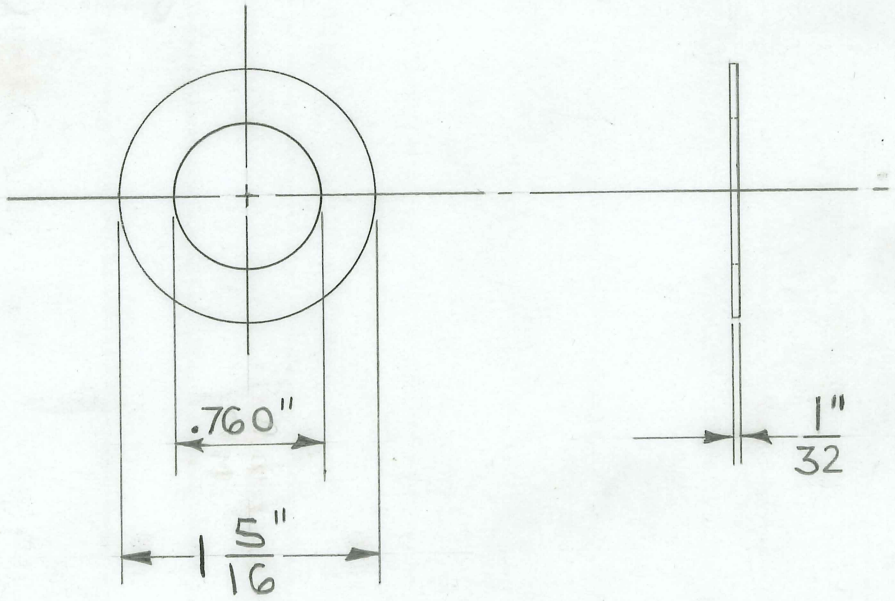

1 REQUIRED

TITLE FISHER FLOOR-WALL MOUNTED 14X17
TILTING BUCKY STAND TIE ROD-BOTTOM

H. G. FISCHER & CO.
FRANKLIN PARK, ILLINOIS

PART NO. 17790

DATE 10-28-48 | DR. BY K.S. | CH'K'D. J.V.W.

REVISION	DATE	BY

PATTERN | FINISH CAD.# 23 | SCALE FULL

TOOLS | MATERIAL $\frac{1}{2}$" DIA. C. R. STEEL ROD

DIMENSIONS
FRACTIONAL ± .015
DECIMAL ± .005
ANGULAR ± ½°
UNLESS OTHERWISE SPECIFIED

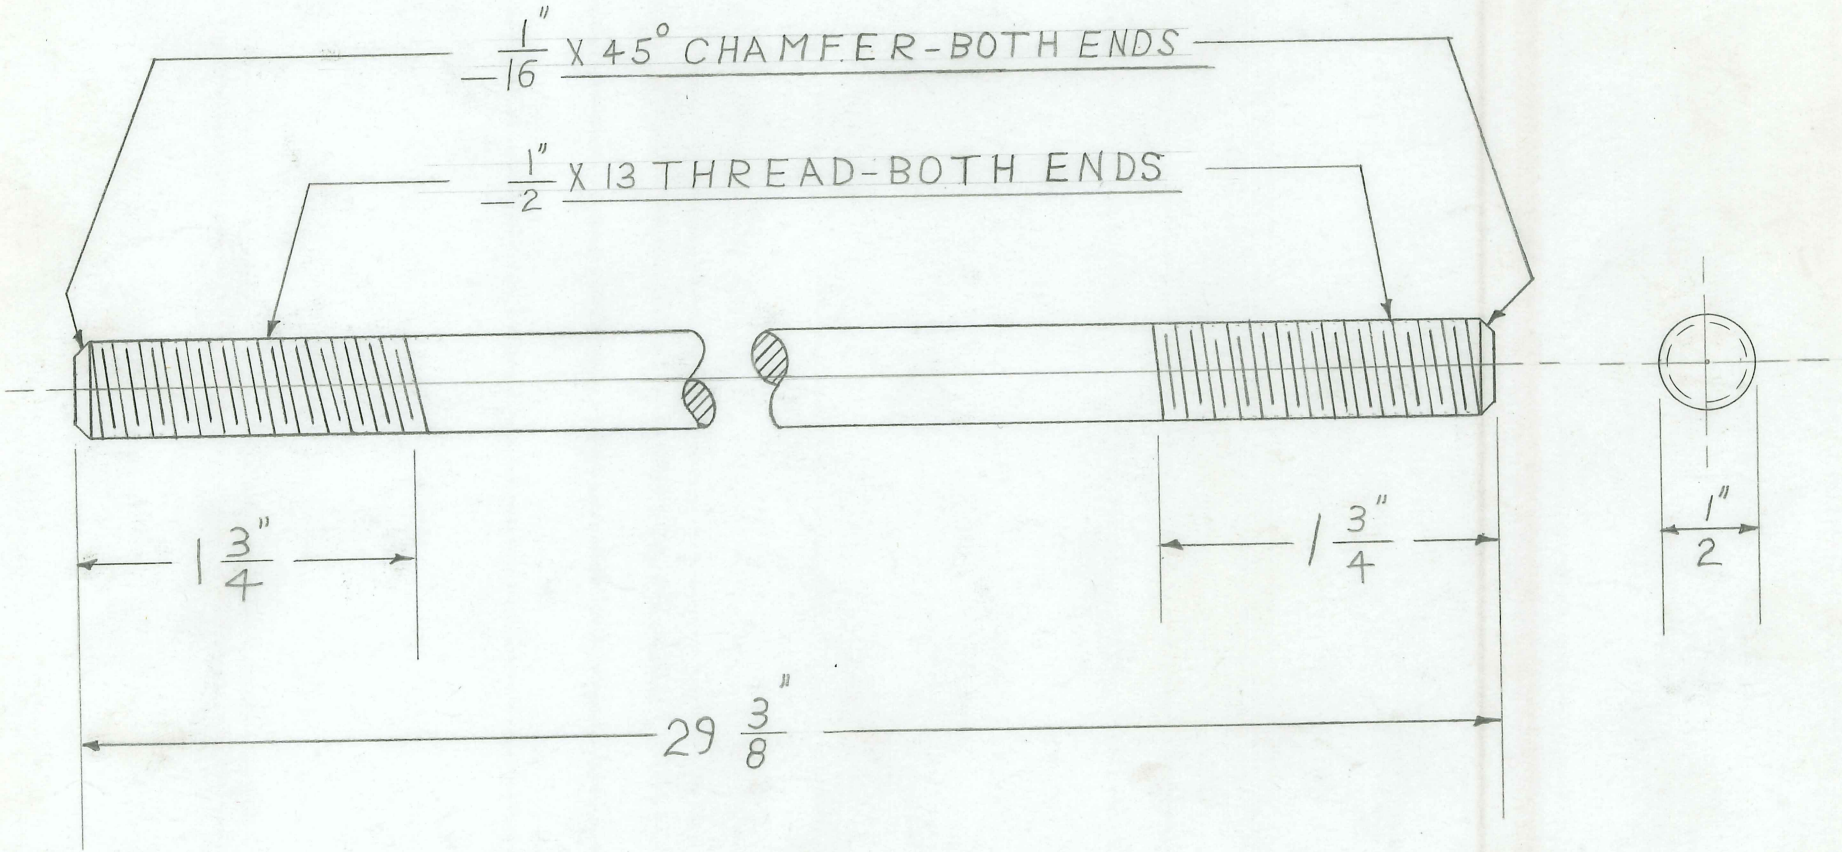

1 REQUIRED

TITLE
FISCHER FLOOR-WALL MOUNTED 14X17
TILTING BUCKY STAND TIE ROD - TOP

H. G. FISCHER & CO.
FRANKLIN PARK, ILLINOIS

PART NO. 17791

DATE 10-12-48 | DR. BY J. B. G. | CH'K'D. J.V.W.

REVISION	DATE	BY

PATTERN | FINISH CAD. # 23 | SCALE FULL

TOOLS | MATERIAL $\frac{3}{8}$" DIA. C.R. STEEL ROD

DIMENSIONS
FRACTIONAL ± .015
DECIMAL ± .005
ANGULAR ± ½°
UNLESS OTHERWISE SPECIFIED

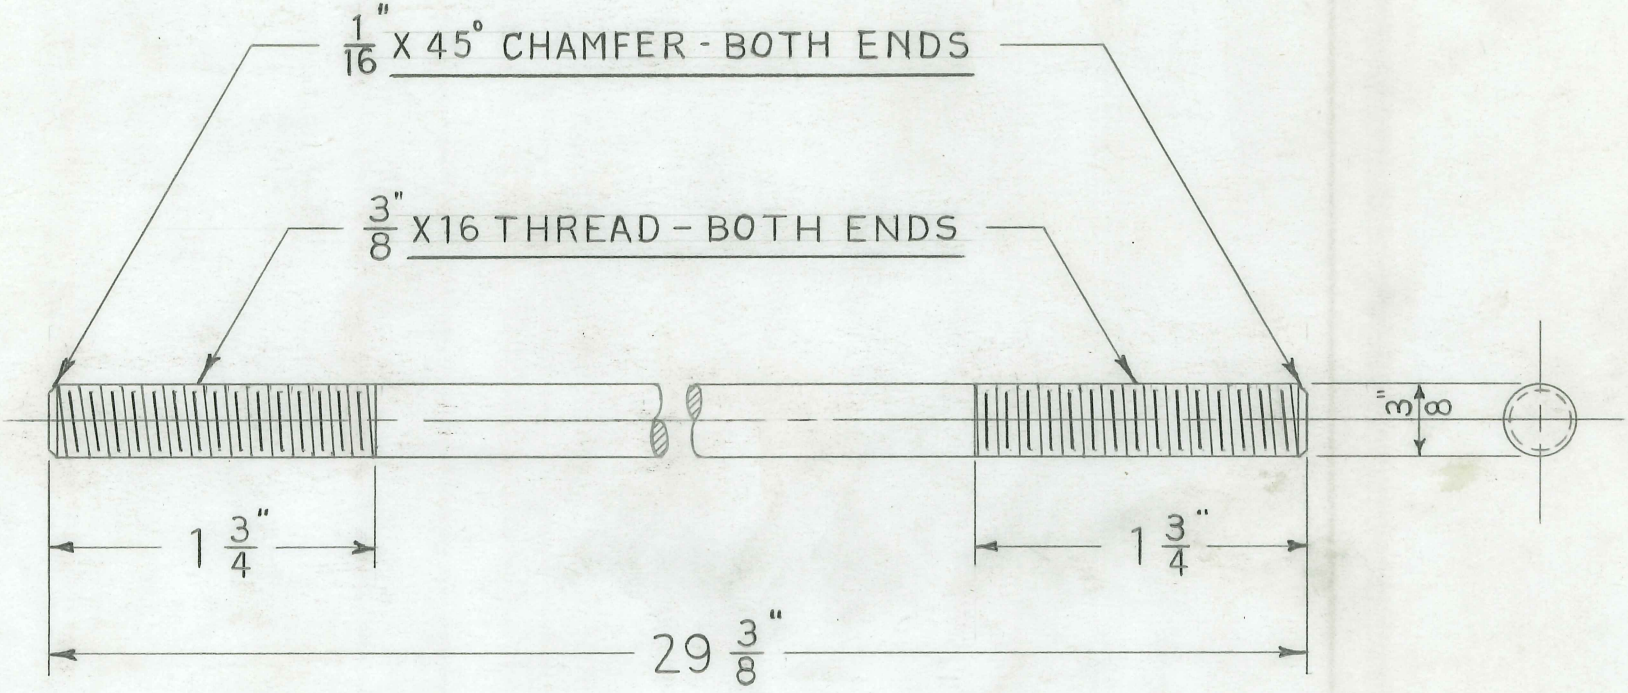

2 - REQUIRED

TITLE

FISCHER WALL FRAME TILTING BUCKY STAND SPRING LOCK SHAFT ASSEM.

H. G. FISCHER & CO.
FRANKLIN PARK, ILLINOIS

PART NO. 17793G

DATE 12-23-48 | DR. BY W.J. | CH'K'D. J.V.W.

REVISION	DATE	BY

PATTERN | FINISH | SCALE FULL

TOOLS: DRILL JIG # 10,039

MATERIAL

DIMENSIONS UNLESS OTHERWISE SPECIFIED
FRACTIONAL ± .015
DECIMAL ± .005
ANGULAR ± ½°

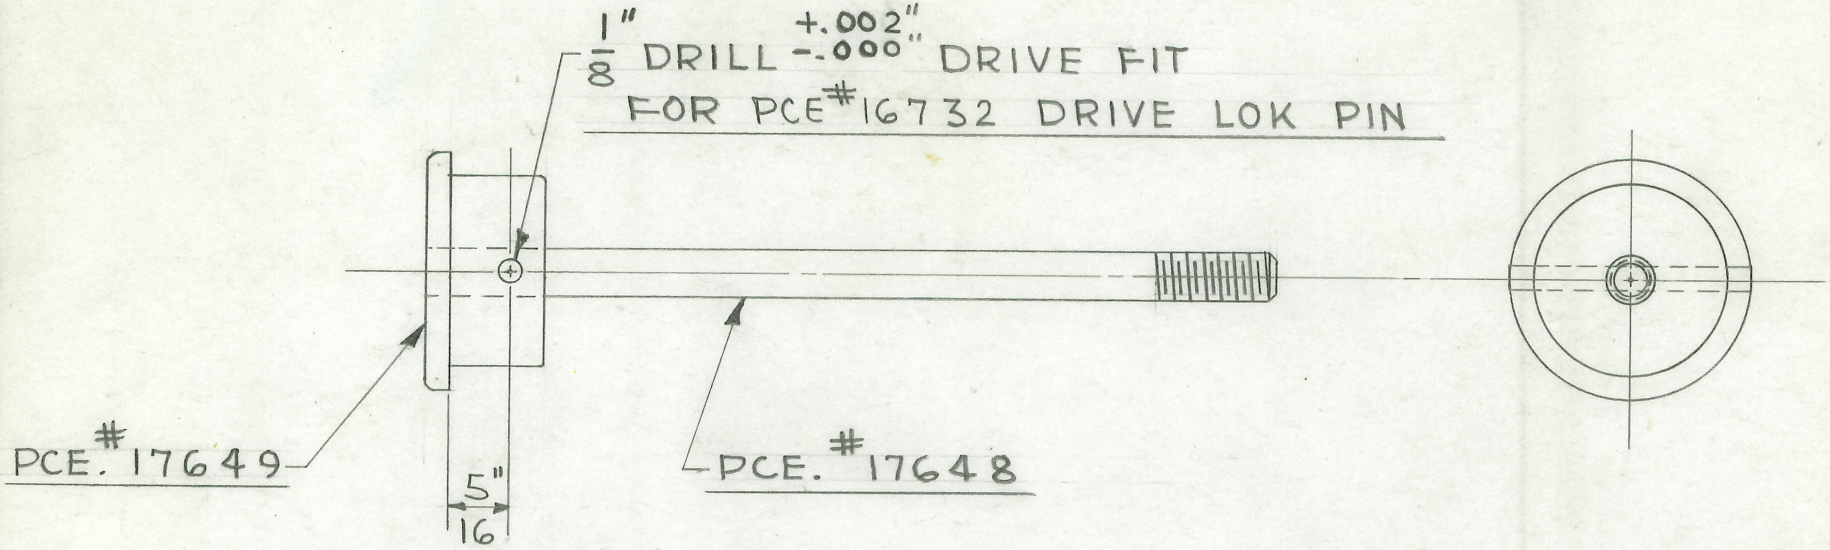

1 REQUIRED

TITLE
WALL FRAME TILTING & NONTILT & IBUCKY CWT. & CABLE ASS'Y 17X17

H. G. FISCHER & CO.
FRANKLIN PARK, ILLINOIS

PART NO. 17794GD

PATTERN	FINISH	SCALE

MATERIAL

TOOLS

DATE 4-2-68 | DR. BY Kwang | CH'K'D.

DIMENSIONS—UNLESS OTHERWISE SPECIFIED:

FRACTIONAL	± .015	THREAD CHAMFER
DECIMAL	± .005	UP TO 5/16 D. - 1/32 X 45°
ANGULAR	± 1/2°	3/8 D. & OVER - 1/16 X 45°

REMOVE ALL BURRS & SHARP CORNERS

USED ON	QTY.	USED ON	QTY.
		17785GB	2
		17800GA	2

REVISION	DATE	BY

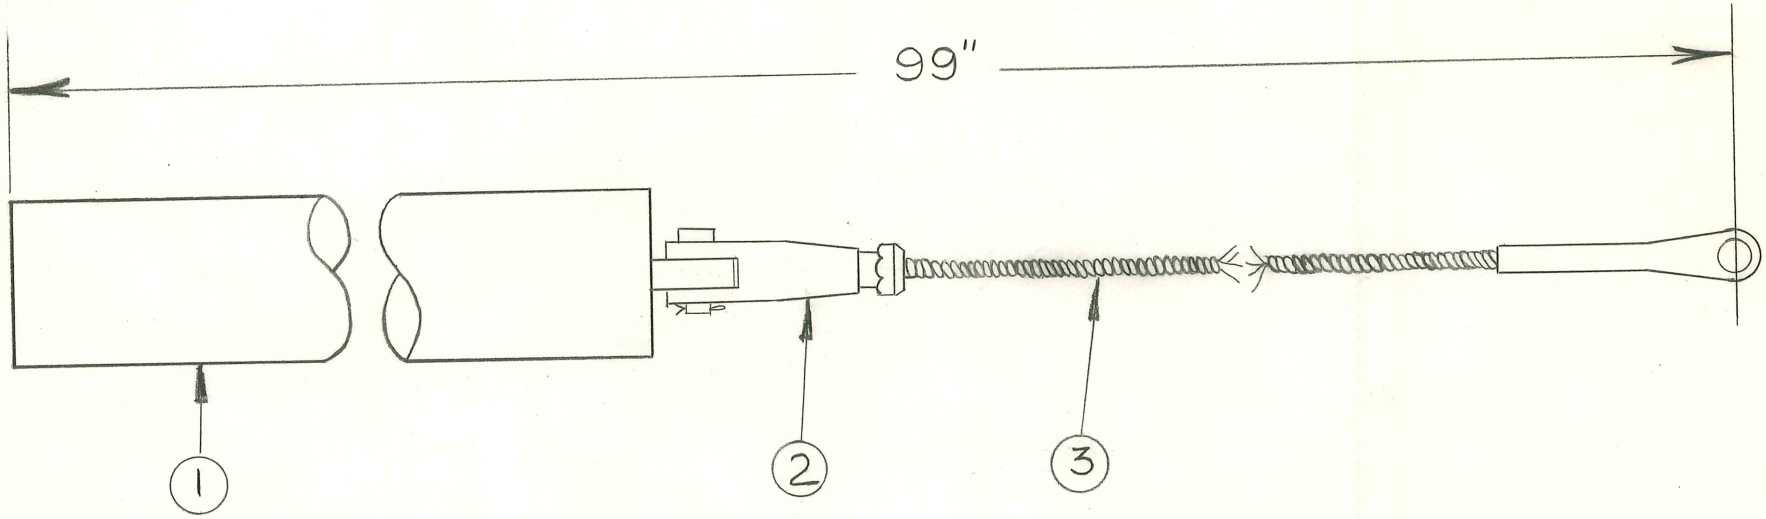

OBSOLETE
ECO# 0407
6-20-75 RR

ITEM	DEPT	AMT	DESCRIPTION	PART NO
3	ASS'Y	1	CLEVIS	17919
2	ASS'Y	1	COUNTER WEIGHT CABLE	17969
1	ASS'Y	1	" WEIGHT TUBE ASS'Y	17795GA

DO NOT SCALE DRAWING.

TITLE

FISCHER TILTING BUCKY STAND
BUCKY SUPPORT ASSEMBLY

H. G. FISCHER & CO.
FRANKLIN PARK, ILLINOIS

PART NO. 177966A

DATE 8/14/64 | DR BY J.H. | CH'K'D. RCT

REVISION	DATE	BY

PATTERN | FINISH BLACK #269 | SCALE HALF

TOOLS | MATERIAL

DIMENSIONS
FRACTIONAL ± .015
DECIMAL ± .005
ANGULAR ± ½°
UNLESS OTHERWISE SPECIFIED

USED ON	QTY.
	2

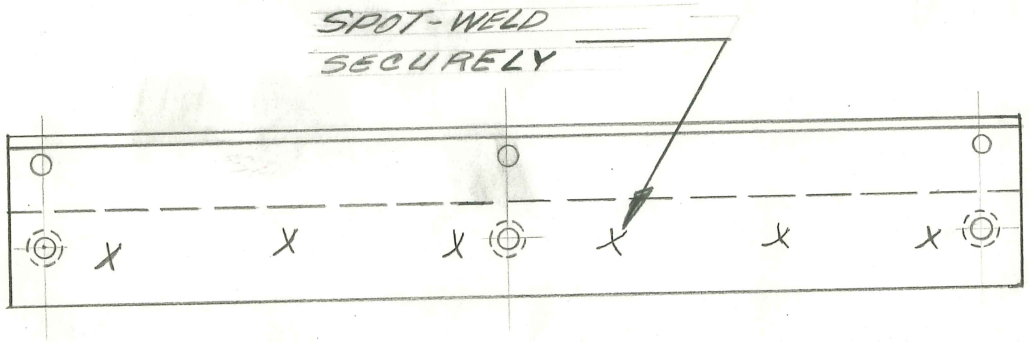

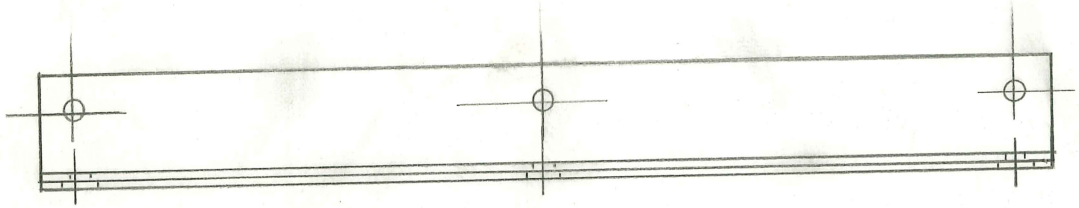

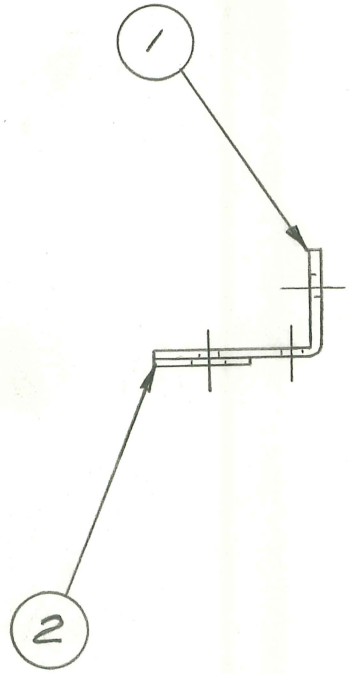

S.M.	1	2	PAD	#177961
S.M.	1	1	SUPPORT	#17814A
PART	AMT	ITEM	NAME	PART NO. OR MATERIAL

H. G. FISCHER & CO.
FRANKLIN PARK, ILLINOIS

PART NO. 177961

TITLE
FISCHER TILTING BUCKY STAND
BUCKY SUPPORT PAD

DATE 8/14/64 | DR BY V.H. | CH'K'D. RCT

SCALE HALF SIZE

PATTERN | FINISH

TOOLS

MATERIAL
#16 GA. (.060) SHEET C.R. STEEL

DIMENSIONS UNLESS OTHERWISE SPECIFIED
FRACTIONAL ± .015
DECIMAL ± .005
ANGULAR ± ½°

REVISION	DATE	BY

USED ON	QTY.
17796GA	1

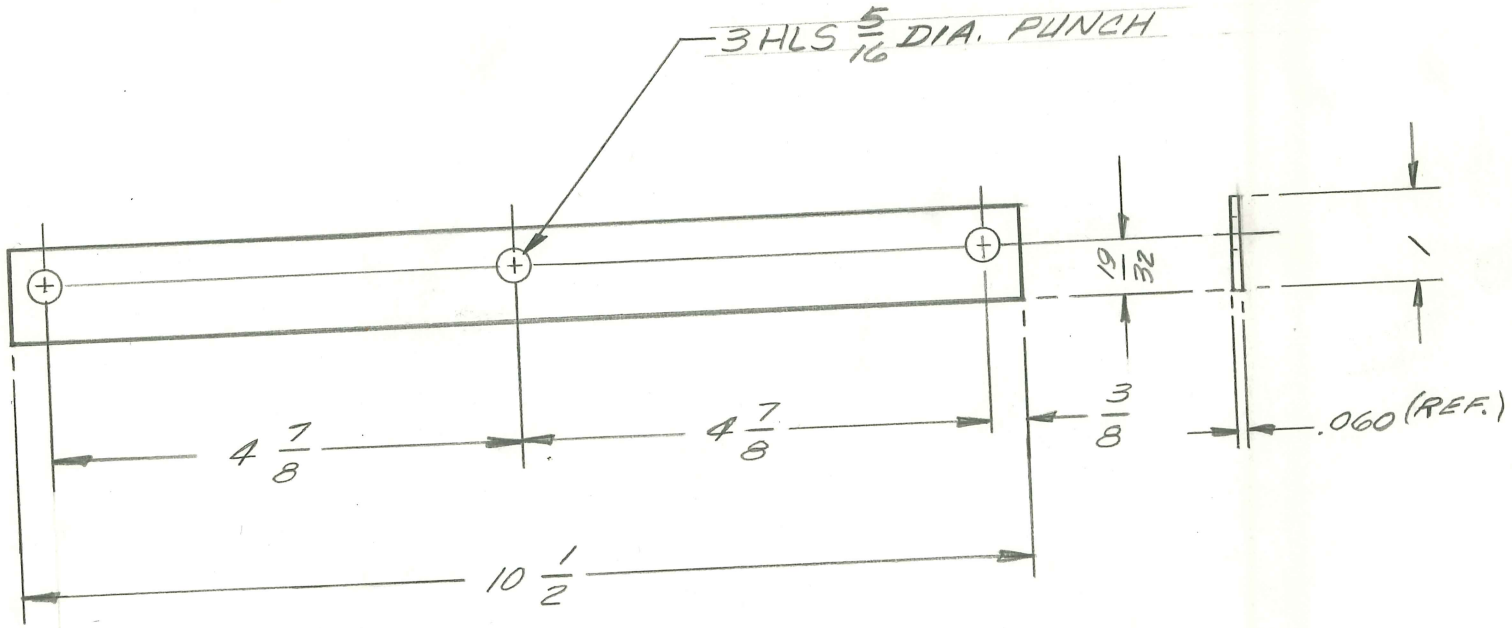

TITLE
FISCHER NON-TILT BUCKY STAND
8"X10" BUCKY CUT.

H. G. FISCHER & CO.
FRANKLIN PARK, ILLINOIS

PART NO. 17806

DATE 11-23-56 DR BY J.V.W. CH'K'D.

REVISION	DATE	BY

PATTERN | FINISH | SCALE FULL

TOOLS

MATERIAL
1 3/4" DIA. C.R. STEEL ROD

DIMENSIONS
FRACTIONAL ± .015
DECIMAL ± .003
ANGULAR ± 1/2°
UNLESS OTHERWISE SPECIFIED

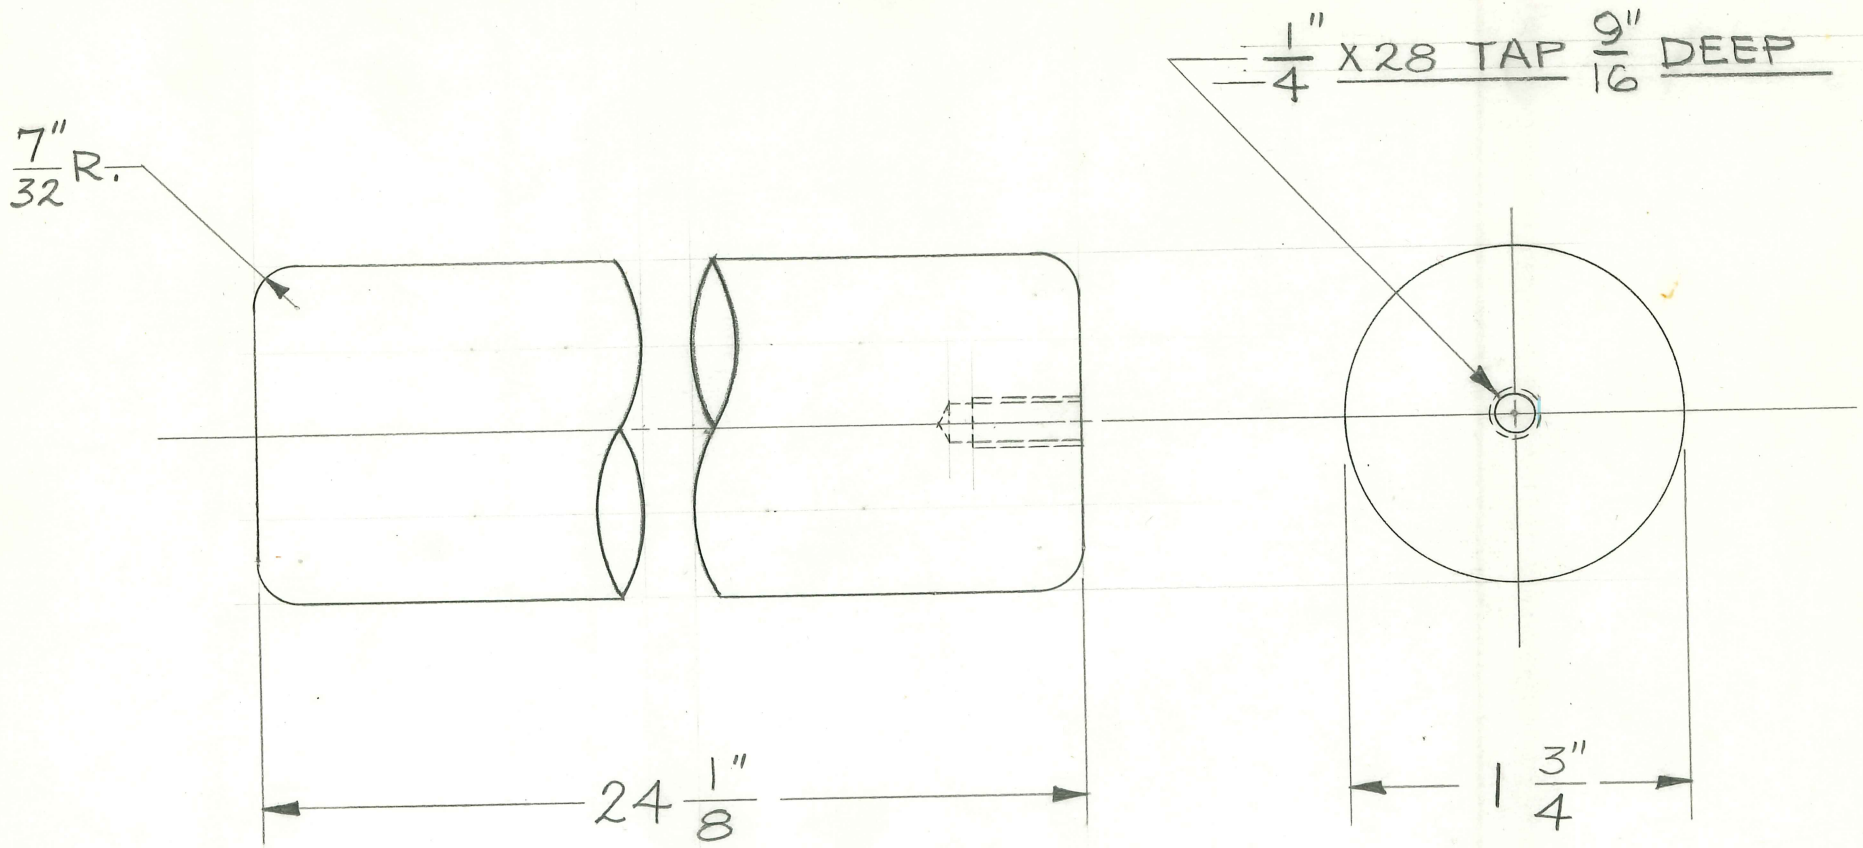

2 REQUIRED

APPROX. 16 1/2 Lbs.

TITLE: MULTI-POSITION VERT. FLUOROSCOPE VERTICAL GUIDE BAR CLAMP

H. G. FISCHER & CO.
FRANKLIN PARK, ILLINOIS

PART NO. 17815

DATE 1-24-49 DR. BY J.V.W. CH'K'D.

REVISION	DATE	BY

PATTERN | FINISH CAD. #23 | SCALE FULL

TOOLS VISE JAWS # 11,007
DRILL JIG # 11,008

MATERIAL $\frac{1}{2}$" X $\frac{7}{8}$" C.R. STEEL BAR

DIMENSIONS UNLESS OTHERWISE SPECIFIED
FRACTIONAL ± .015
DECIMAL ± .005
ANGULAR ± ½°

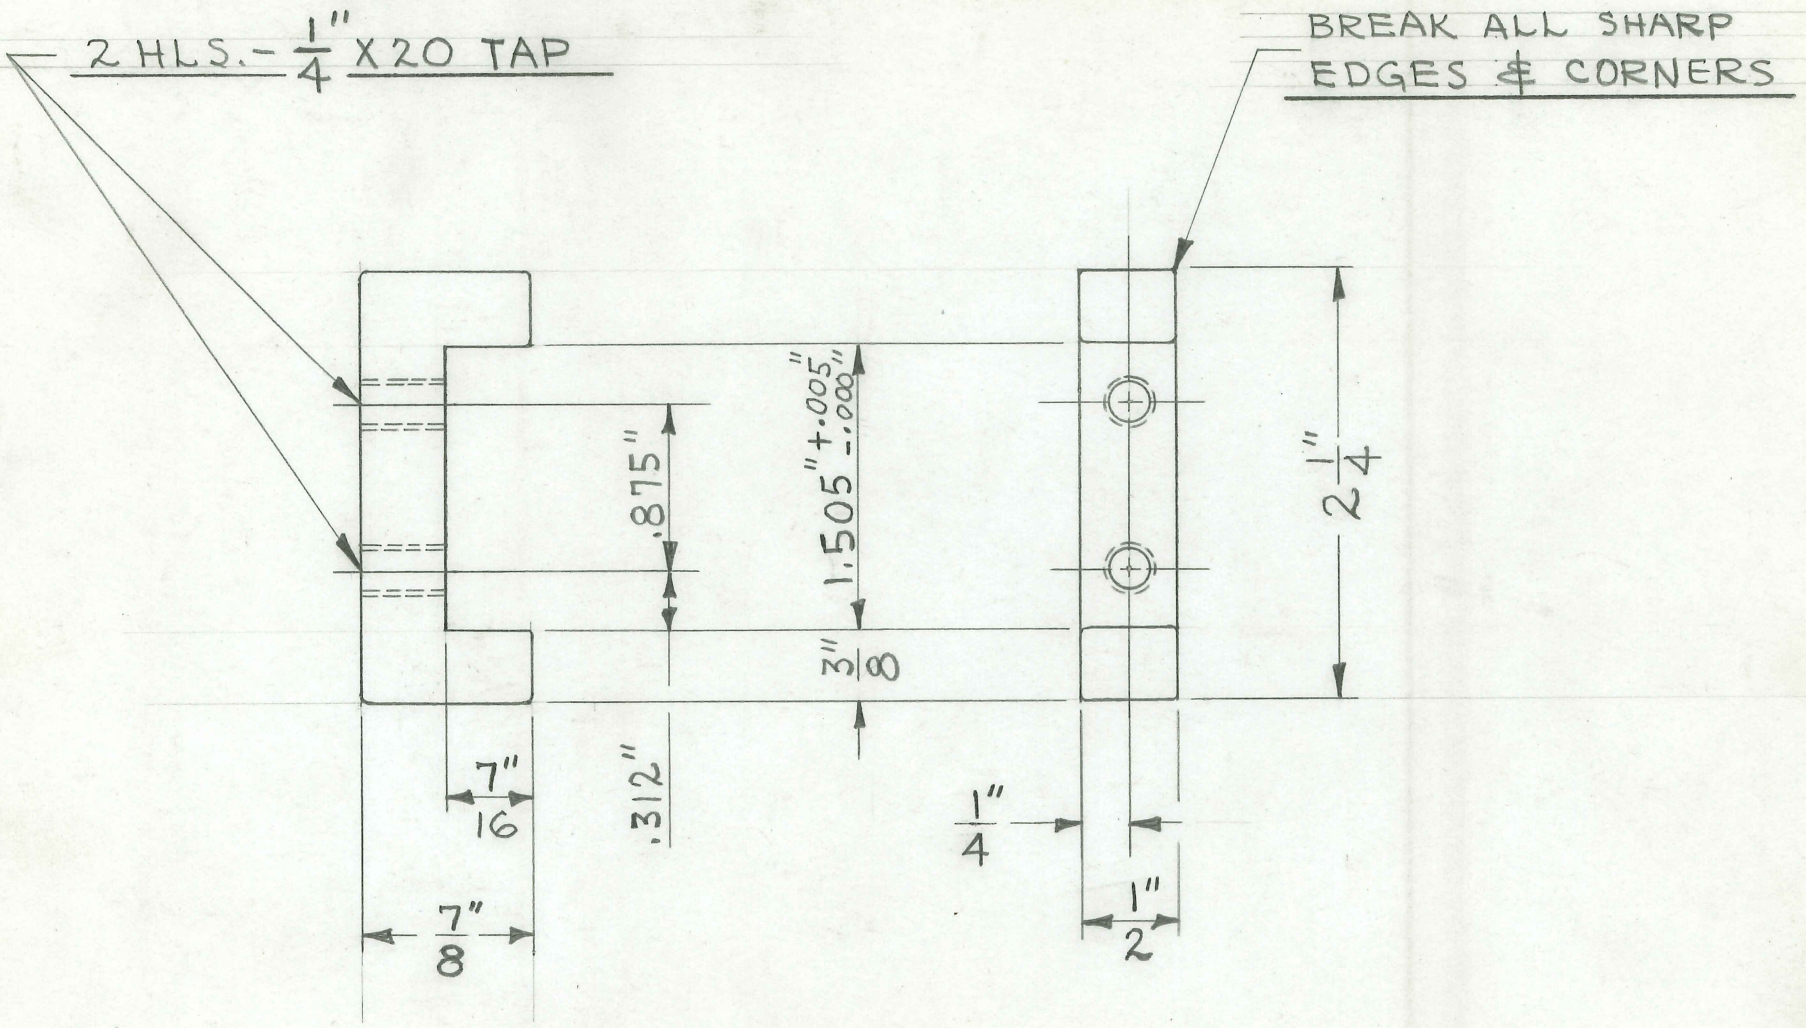

1 REQUIRED

TITLE FISCHER WALL FRAMETILTING BUCKY STAND - C'WEIGHT ASS'Y

H. G. FISCHER & CO.
FRANKLIN PARK, ILLINOIS

PART NO. 17817 G

DATE 11-2-66 | DR. BY B.K. | CH'K'D. RS

REVISION	DATE	BY

PATTERN → | FINISH → | SCALE FULL

MATERIAL - AS SHOWN -

TOOLS

DIMENSIONS—UNLESS OTHERWISE SPECIFIED:

FRACTIONAL	± .015	THREAD CHAMFER
DECIMAL	± .005	UP TO 5/16 D. - 1/32 X 45°
ANGULAR	± 1/2°	3/8 D. & OVER - 1/16 X 45°

REMOVE ALL BURRS & SHARP CORNERS

USED ON	QTY.	USED ON	QTY.
17785GA	2		

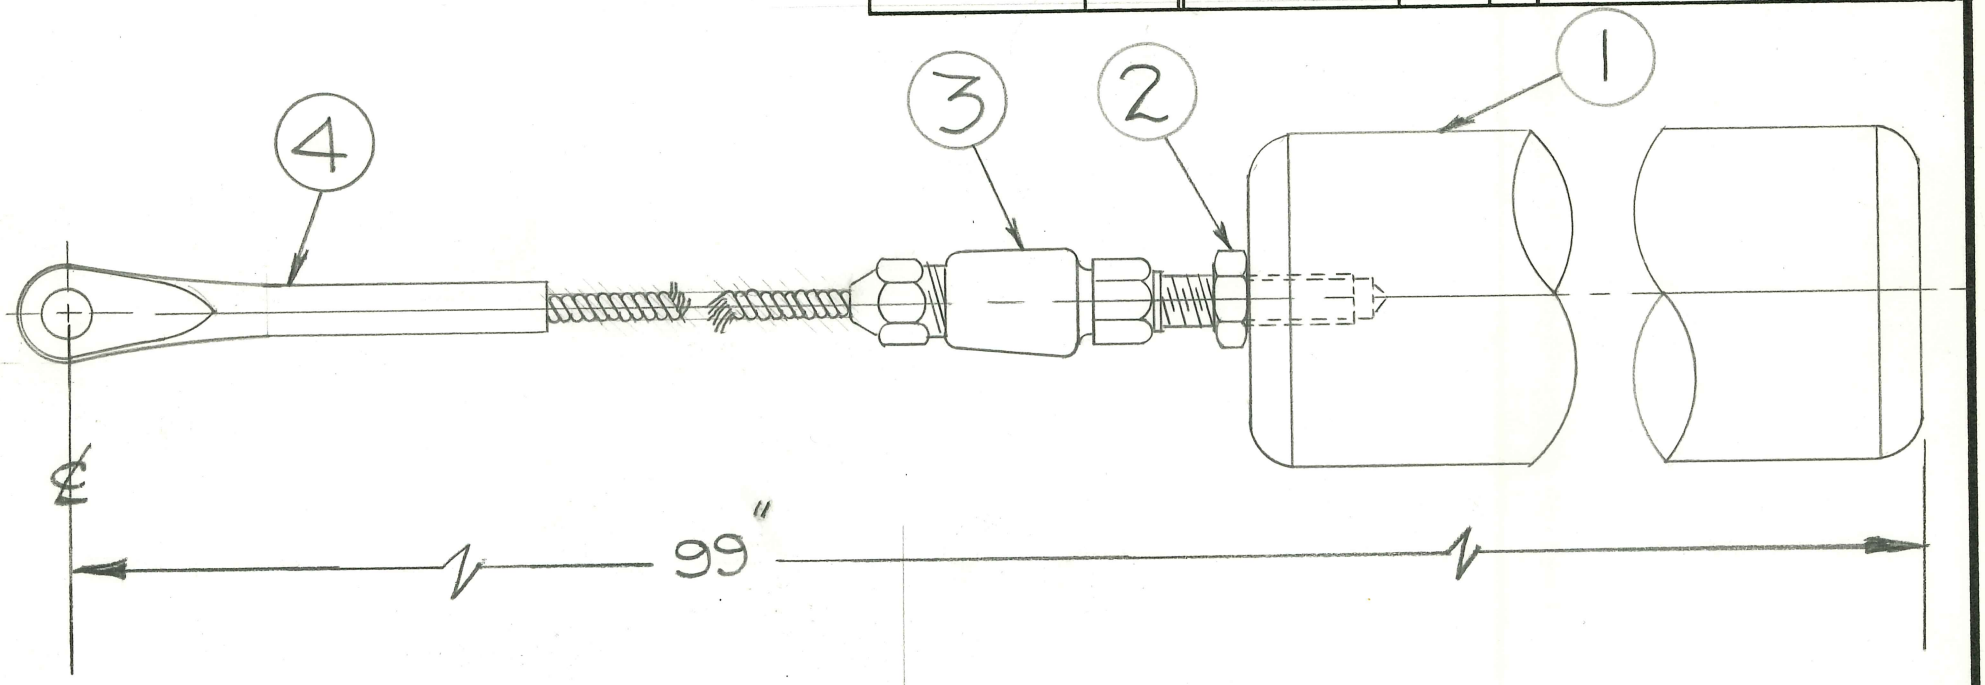

ITEM	QTY	NAME	PART No.
4	1	CABLE	17969
3	1	CONN.	17749AF
2	1	1/4"X20 NUT	20033
1	1	C'WIEGHT	17903

DO NOT SCALE DRAWING.

TITLE
TILTING BUCKY STAND
RECIPROMATIC BUCKY-HEAD CLAMP SUPP. SPACER

H. G. FISCHER & CO.
FRANKLIN PARK, ILLINOIS

PART NO. 17819

DATE 2-12-58	DR BY J.V.W.	CH'K'D.

REVISION	DATE	BY

PATTERN

FINISH CAD. #23

SCALE

TOOLS

MATERIAL
5/16" DIA. C.R. STEEL

DIMENSIONS
FRACTIONAL ± .015
DECIMAL ± .005
ANGULAR ± ½°
UNLESS OTHERWISE SPECIFIED

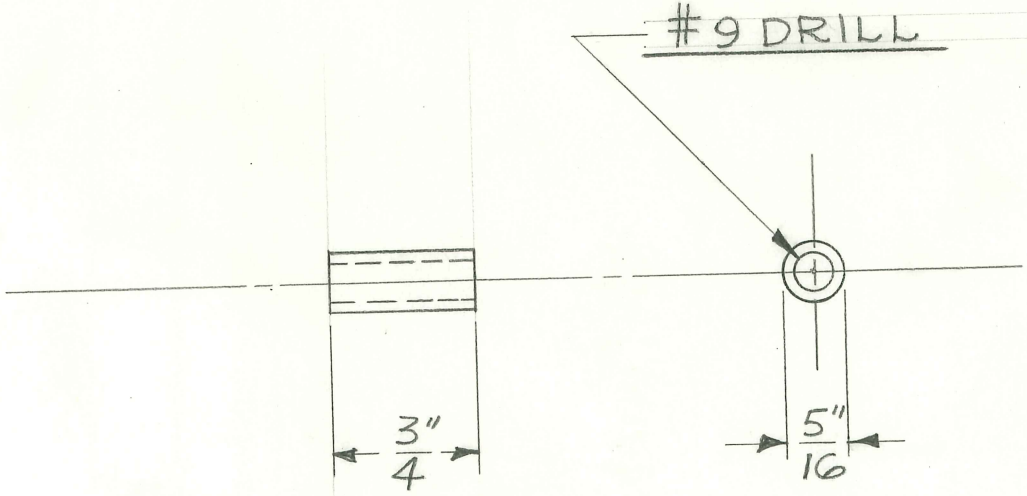

1 REQUIRED

TITLE FISCHER NON-TILT BUCKY STAND BUCKY

SUPPORT BAR

H. G. FISCHER & CO.
FRANKLIN PARK, ILLINOIS

PART NO. 17822

DATE 5-6-53 | DR. BY J.V.W. | CH'K'D.

REVISION		DATE	BY
1	ECO #0201	9-17-74	A.T.
2	ECO#0279	10-28-74	A.T.
3	ECO#0334	12/9/74	T.T.

PATTERN | FINISH TEXTURE WHITE #319 | SCALE FULL

TOOLS: DRILL JIG # 12118

MATERIAL: $\frac{3}{8}$" X 1$\frac{3}{4}$" C.R. STEEL BAR

DIMENSIONS UNLESS OTHERWISE SPECIFIED
FRACTIONAL ± .015
DECIMAL ± .005
ANGULAR ± ½°

USED ON: 17805G (2)
17805½G (2)
17809G (2)

OBSOLETE

2 HLS. - $\frac{49}{64}$" DRILL

BREAK ALL SHARP EDGES & CORNERS

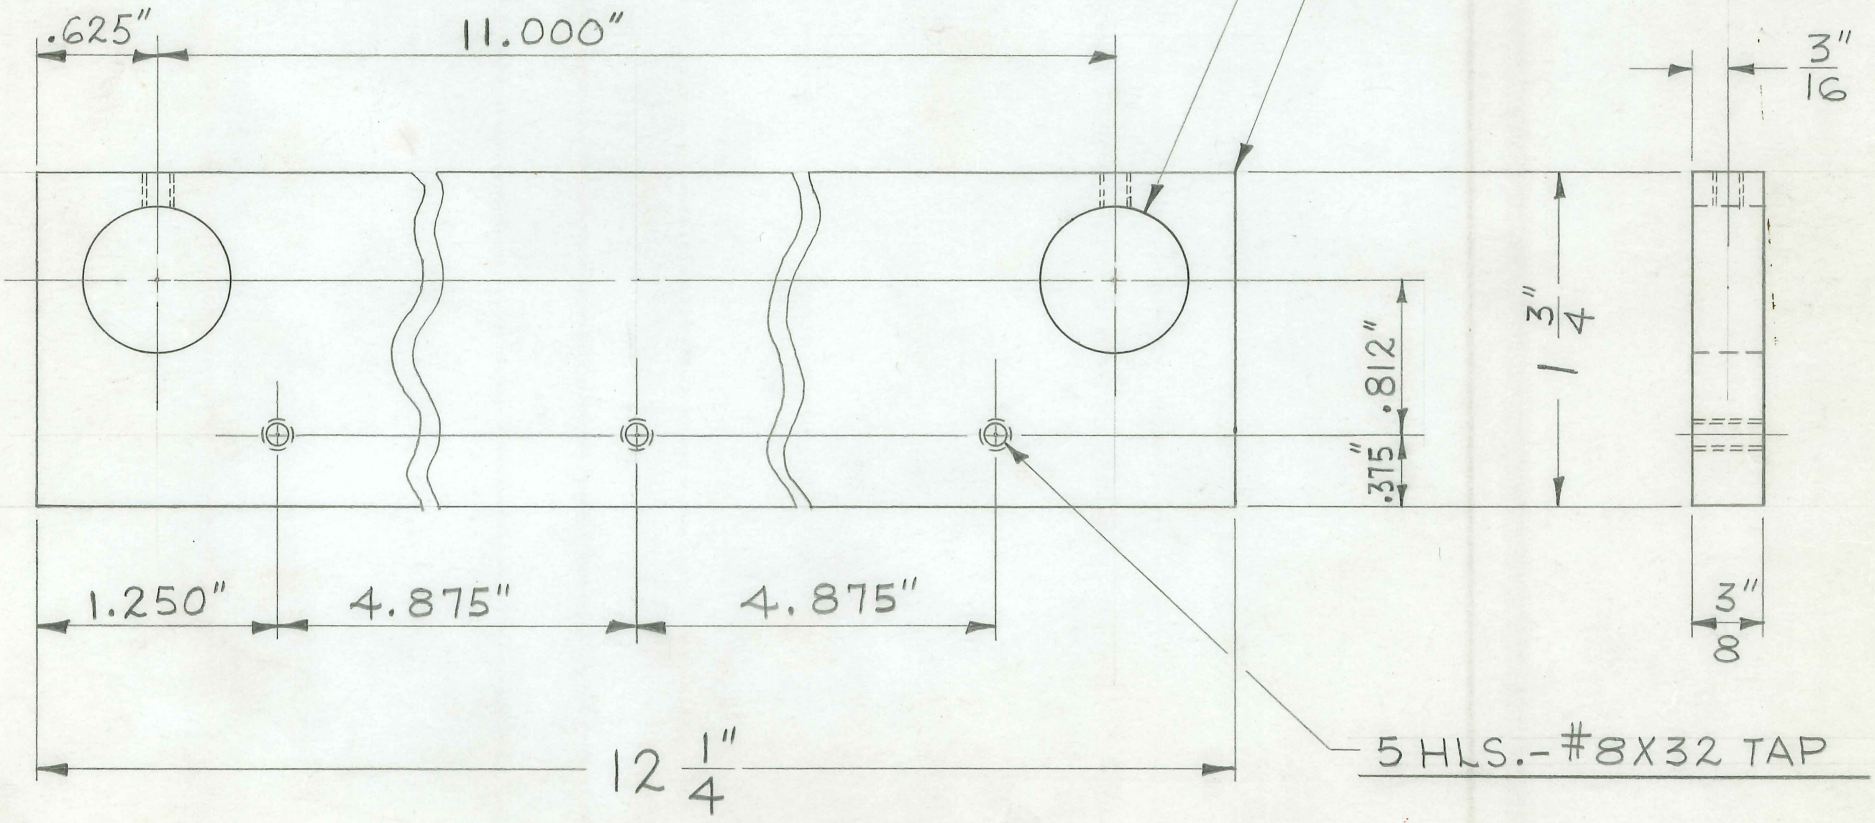

2 REQUIRED

OBSOLETE

TITLE FISCHER WALL FRAME TILTING BUCKY STAND-SPRING LOCK ASSEM. (8x10 & 10x12)

H. G. FISCHER & CO.
FRANKLIN PARK, ILLINOIS

PART NO. 17823 G

DATE 8-1-62 | DR BY RCT | CH'K'D. RS

REVISION	DATE	BY

PATTERN | FINISH | SCALE FULL

TOOLS | MATERIAL

DIMENSIONS
FRACTIONAL ± .015
DECIMAL ± .005
ANGULAR ± ½°
UNLESS OTHERWISE SPECIFIED

USED ON	NO. REQ'D.
17600 G	1
17750 GB	1

NOTE: (1) MUST BE IN PLACE IN (2) BEFORE (5) IS DRIVEN IN.

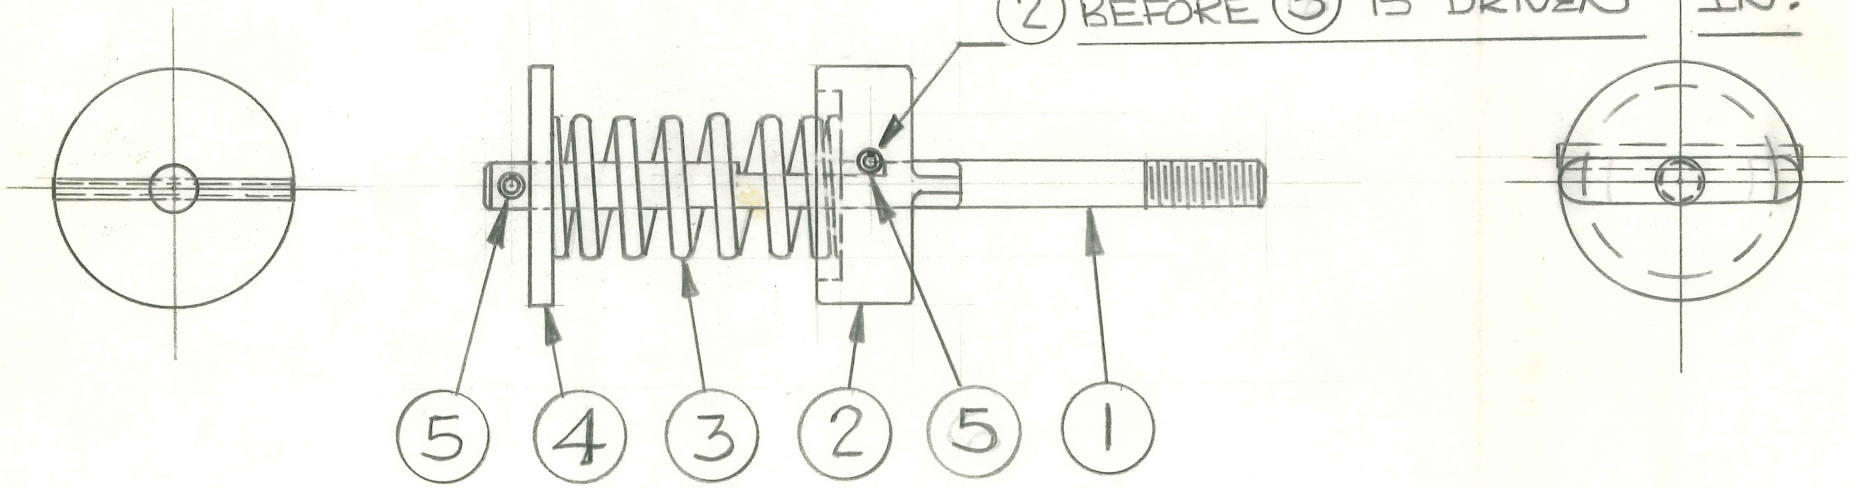

DEPT.	AMT.	ITEM NO.	NAME	PART NO. OR MATERIAL
P.S.	2	5	1/8x1¼ ROLL PIN	16732 A
SM	1	4	WASHER	17776A 23
P.S.	1	3	SPRING	17645-23
M	1	2	BODY	17647A-23
M	1	1	SHAFT	17648A-23

TITLE FISCHER WALL FRAME TILTING BUCKY STAND- SPRING LOCK ASSEMBLY (14 X 17 & 14 X 36)

H. G. FISCHER & CO.
FRANKLIN PARK, ILLINOIS

DATE 8-3-62 | DR. BY E. M. | CH'K'D. RCT

PART NO. 17824 G

REVISION		DATE	BY
1	ECO # 0380	1/20/75	TT
2	ECO #1711 PP, ITEM 4	6/27/79 was 17776	

PATTERN | FINISH | SCALE FULL

TOOLS | MATERIAL

DIMENSIONS UNLESS OTHERWISE SPECIFIED
FRACTIONAL ± .015
DECIMAL ± .005
ANGULAR ± ½°

USED ON	NO. REQ.
17784 GB	1
17785 GA	1

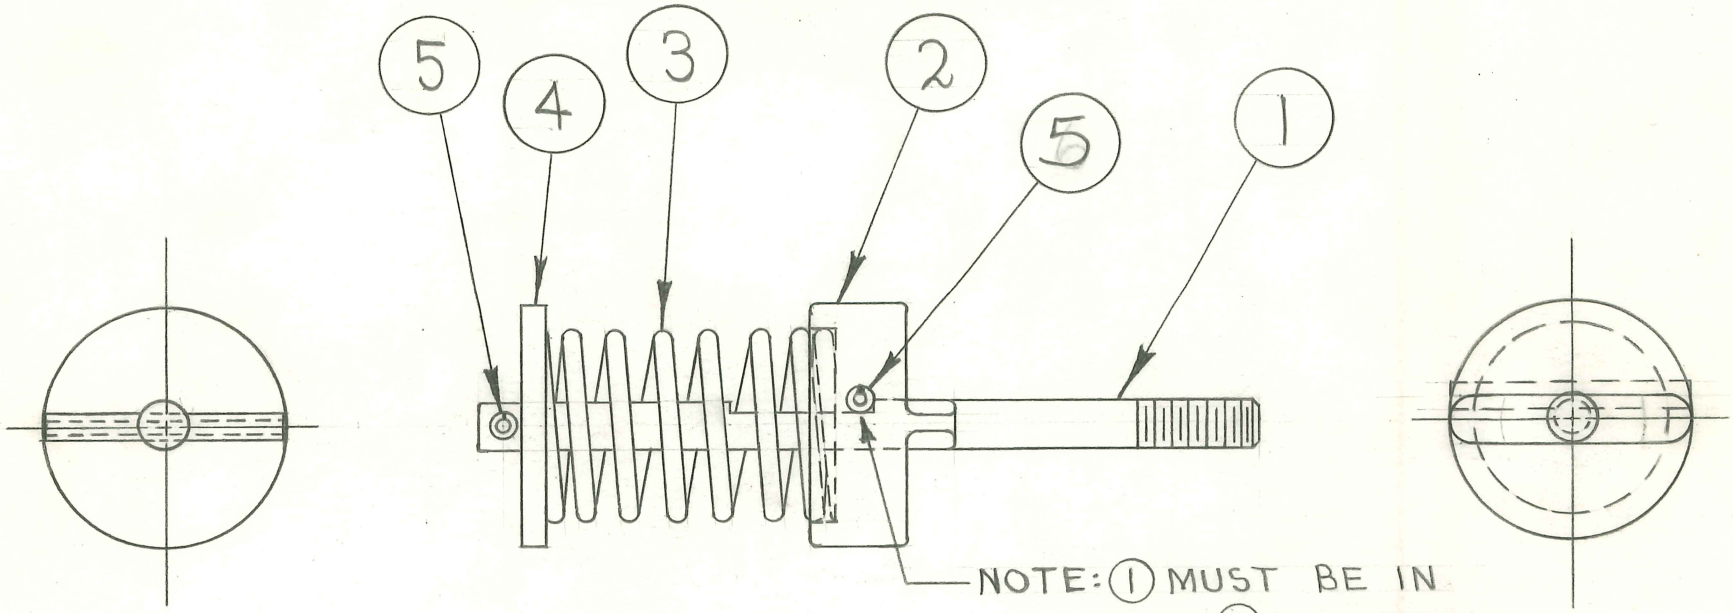

NOTE: (1) MUST BE IN PLACE IN (2) BEFORE (5) IS DRIVEN IN

DEPT.	AMT.	ITEM NO.	NAME	PART NO. OR MAT.
P.S.	2	5	1/8 X 1 1/4 ROLL PIN	16732A
S M	1	4	WASHER	33913 23
P.S.	1	3	SPRING, 1" x 1½" LONG	17646 #123
M	1	2	BODY	17647A #123
M	1	1	SHAFT	17648A #123

TITLE
FISCHER "MP-30" X-RAY UNIT
FIL. TRANSF. CLAMP STRAP

H. G. FISCHER & CO.
FRANKLIN PARK, ILLINOIS

PART NO. 17833

DATE	DR. BY	CH'K'D.
8-31-48	J.V.W.	

REVISION	DATE	BY

PATTERN	FINISH	SCALE
		FULL

DIMENSIONS
FRACTIONAL ± .015
DECIMAL ± .005
ANGULAR ± ½°
UNLESS OTHERWISE SPECIFIED

TOOLS
CUT-OFF & PERF. DIE #721
BIN Y-5

MATERIAL
$\frac{1}{8}$" X $\frac{1}{2}$" FLAT WIRE

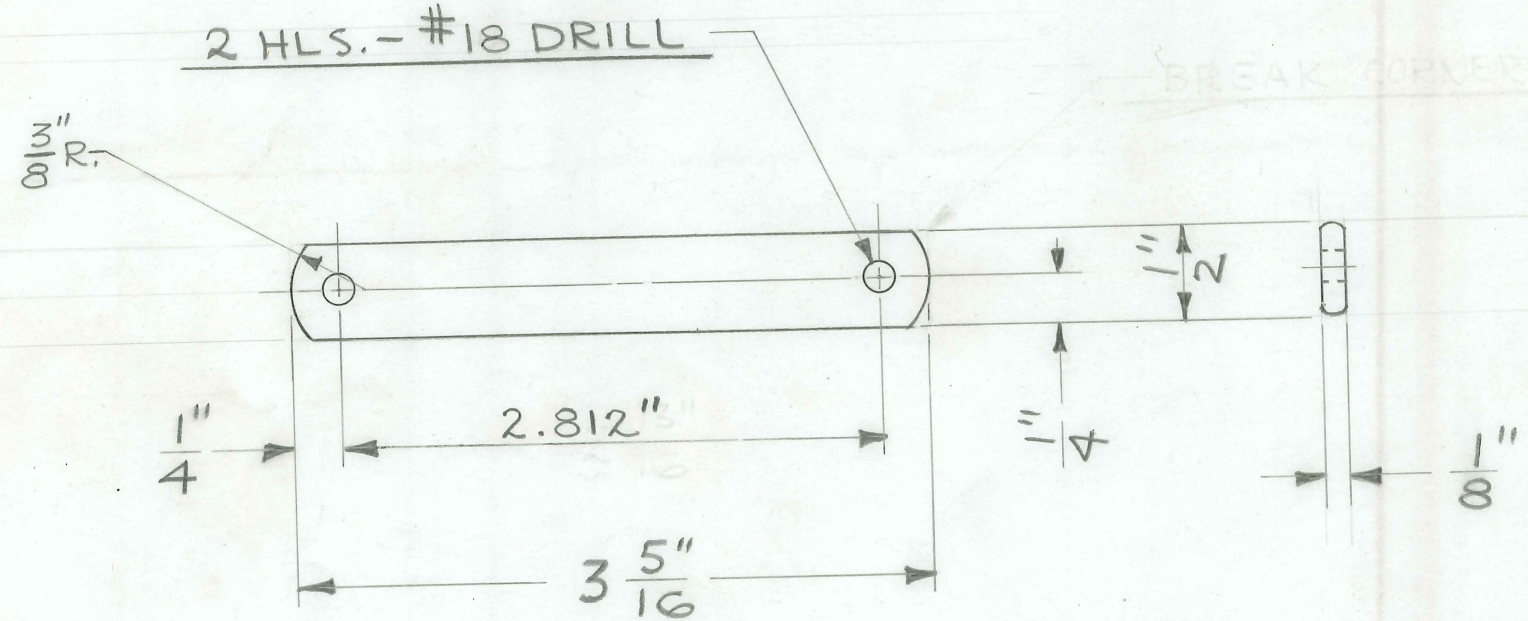

2-REQUIRED

TITLE
FISCHER "MP-30" X-RAY UNIT
TRANSF. STUD - LONG

H. G. FISCHER & CO.
FRANKLIN PARK, ILLINOIS

PART NO. 17834

REVISION	DATE	BY

DATE 8-31-48 | DR. BY J.V.W. | CH'K'D.

SCALE FULL

PATTERN | FINISH

MATERIAL
$\frac{1}{4}$" DIA. C.R. STEEL

TOOLS

DIMENSIONS
FRACTIONAL ± .015
DECIMAL ± .005
ANGULAR ± ½°
UNLESS OTHERWISE SPECIFIED

$\frac{1}{4}$" X20 THREAD

$\frac{1}{32}$" X 45° CHAMFER - BOTH ENDS

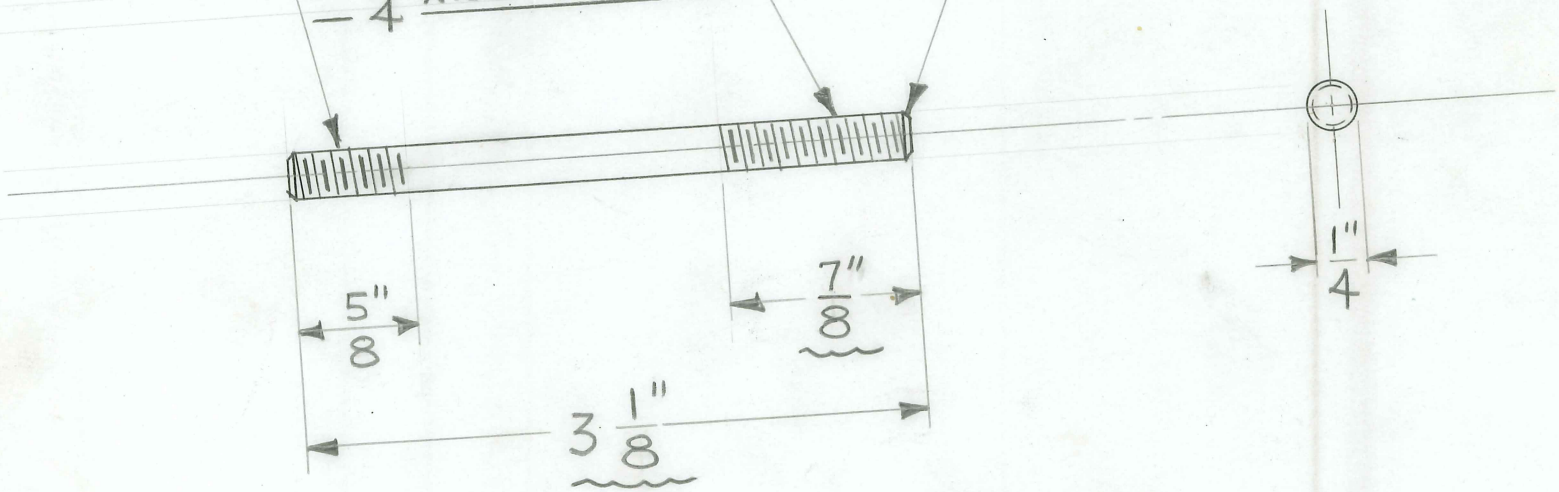

2 REQUIRED

TITLE FISCHER "MP-30" X-RAY UNIT
TRANSF. STUD – SHORT

H. G. FISCHER & CO.
FRANKLIN PARK, ILLINOIS

PART NO. 17835

DATE 8-31-48 | DR. BY J.V.W. | CH'K'D.

SCALE FULL

PATTERN | FINISH

TOOLS

MATERIAL
$\frac{1}{4}$" DIA. C.R. STEEL

DIMENSIONS
FRACTIONAL ± .015
DECIMAL ± .005
ANGULAR ± ½°
UNLESS OTHERWISE SPECIFIED

REVISION	DATE	BY

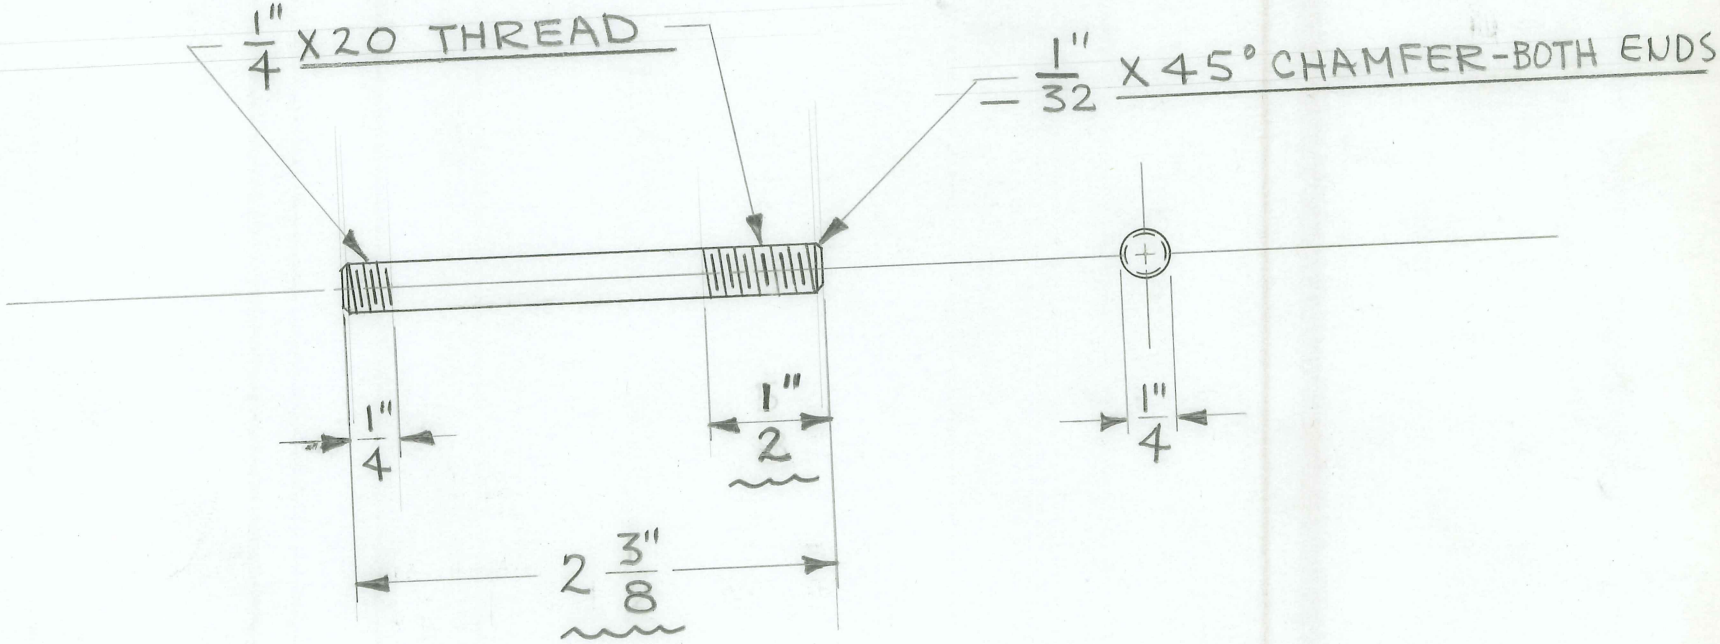

4 REQUIRED

TITLE
FISCHER "MP-30" X-RAY UNIT
TRANSF. MTG. POST

H. G. FISCHER & CO.
FRANKLIN PARK, ILLINOIS

PART NO. 17836A

DATE 4-17-56 DR BY J.V.W. CH'K'D.

REVISION	DATE	BY

PATTERN | FINISH | SCALE FULL

TOOLS

MATERIAL $\frac{7}{16}$" DIA. C.R. STEEL

DIMENSIONS
FRACTIONAL ± .015
DECIMAL ± .005
ANGULAR ± ½°
UNLESS OTHERWISE SPECIFIED

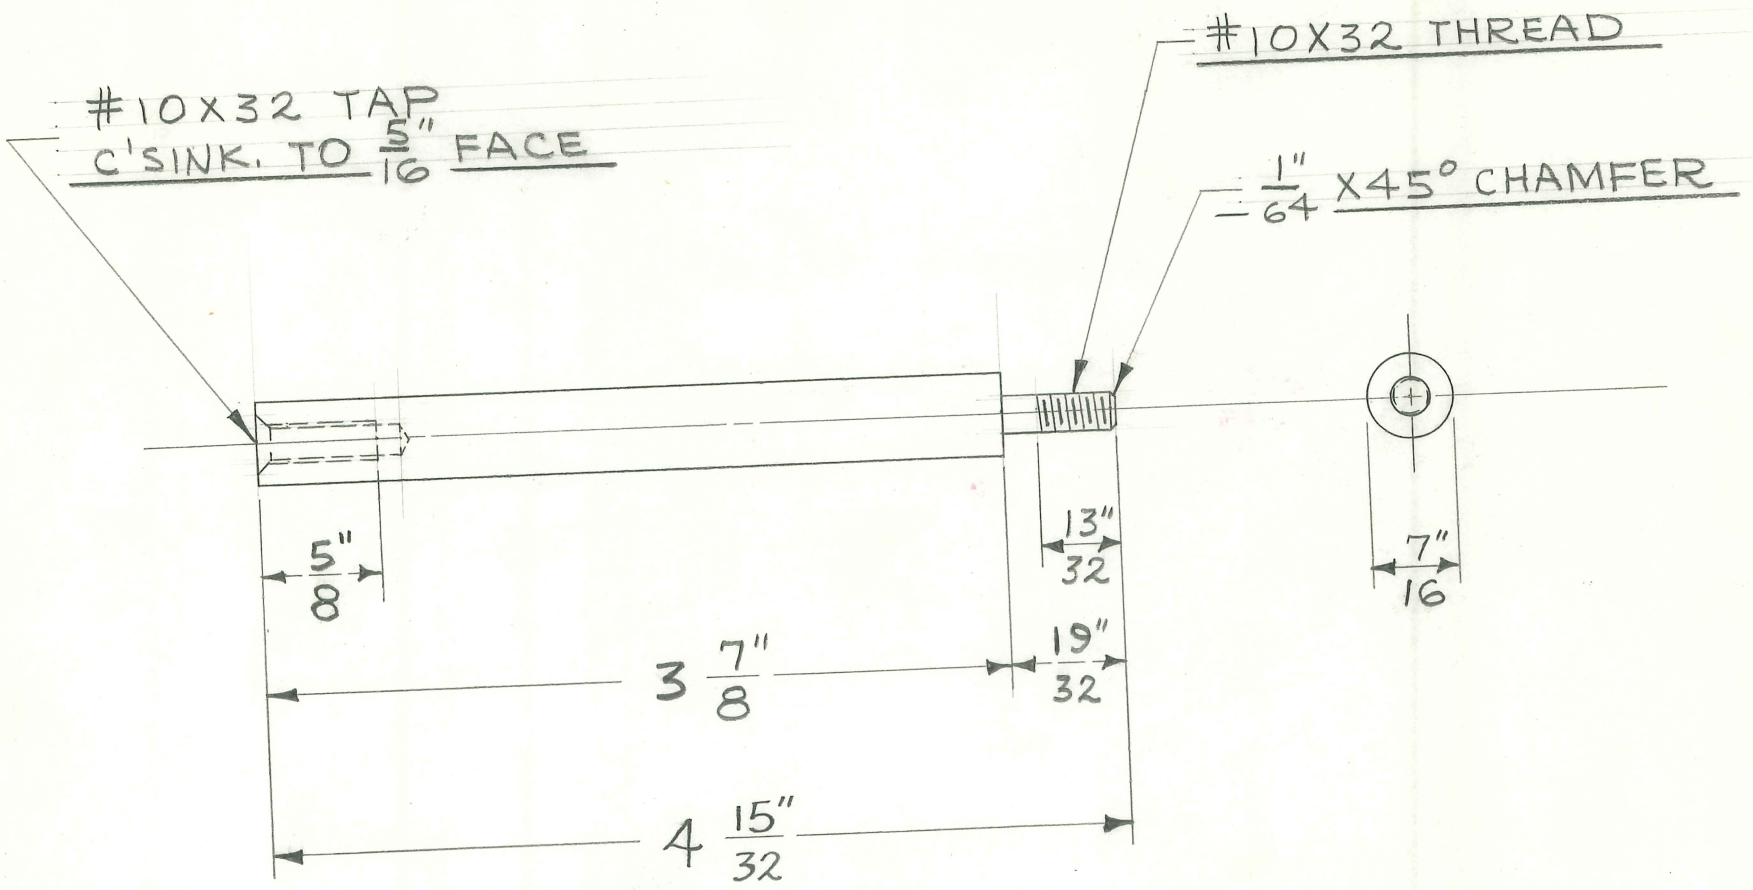

4 REQUIRED

TITLE
FISCHER "MP-30" X-RAY UNIT
TRANSF.- SHIELD - END

H. G. FISCHER & CO.
FRANKLIN PARK, ILLINOIS

PART NO. 17838

REVISION	DATE	BY

DATE 9-2-48 | DR. BY J.V.W. | CH'K'D.

PATTERN | FINISH | SCALE FULL

TOOLS

MATERIAL 1/8" SHEET CANVAS BASE
NATURAL BAKELITE

DIMENSIONS
FRACTIONAL ± .015
DECIMAL ± .005
ANGULAR ± ½°
UNLESS OTHERWISE SPECIFIED

2 REQUIRED

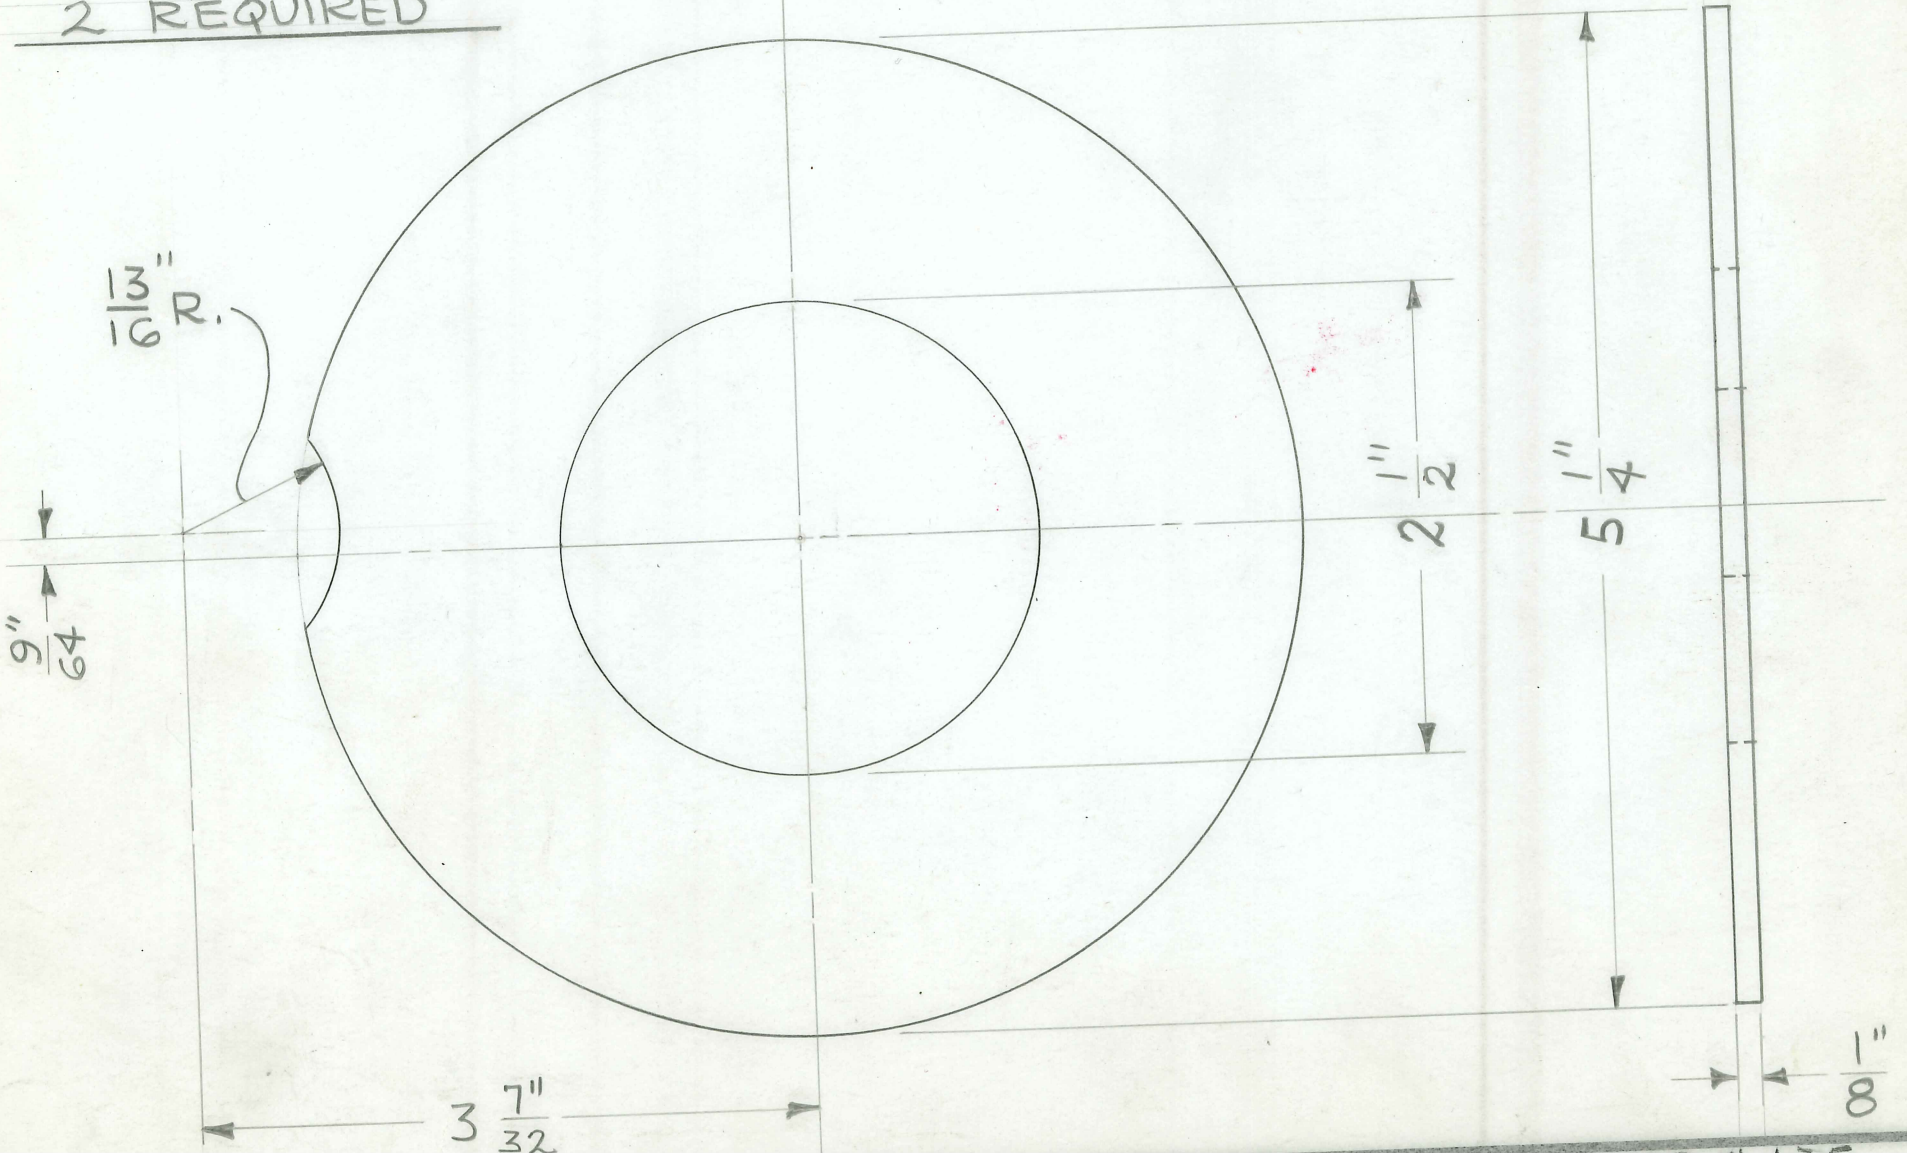

TITLE
FISCHER "MP-30" X-RAY UNIT
TRANSF. SHIELD - CENTER

H. G. FISCHER & CO.
FRANKLIN PARK, ILLINOIS

PART NO. 17839

REVISION	DATE	BY

DATE 9-2-48 | DR. BY J.V.W. | CH'K'D.

PATTERN | FINISH | SCALE FULL

TOOLS

MATERIAL
1/8" SHEET CANVAS BASE
NATURAL BAKELITE

DIMENSIONS
FRACTIONAL ± .015
DECIMAL ± .005
ANGULAR ± ½°
UNLESS OTHERWISE SPECIFIED

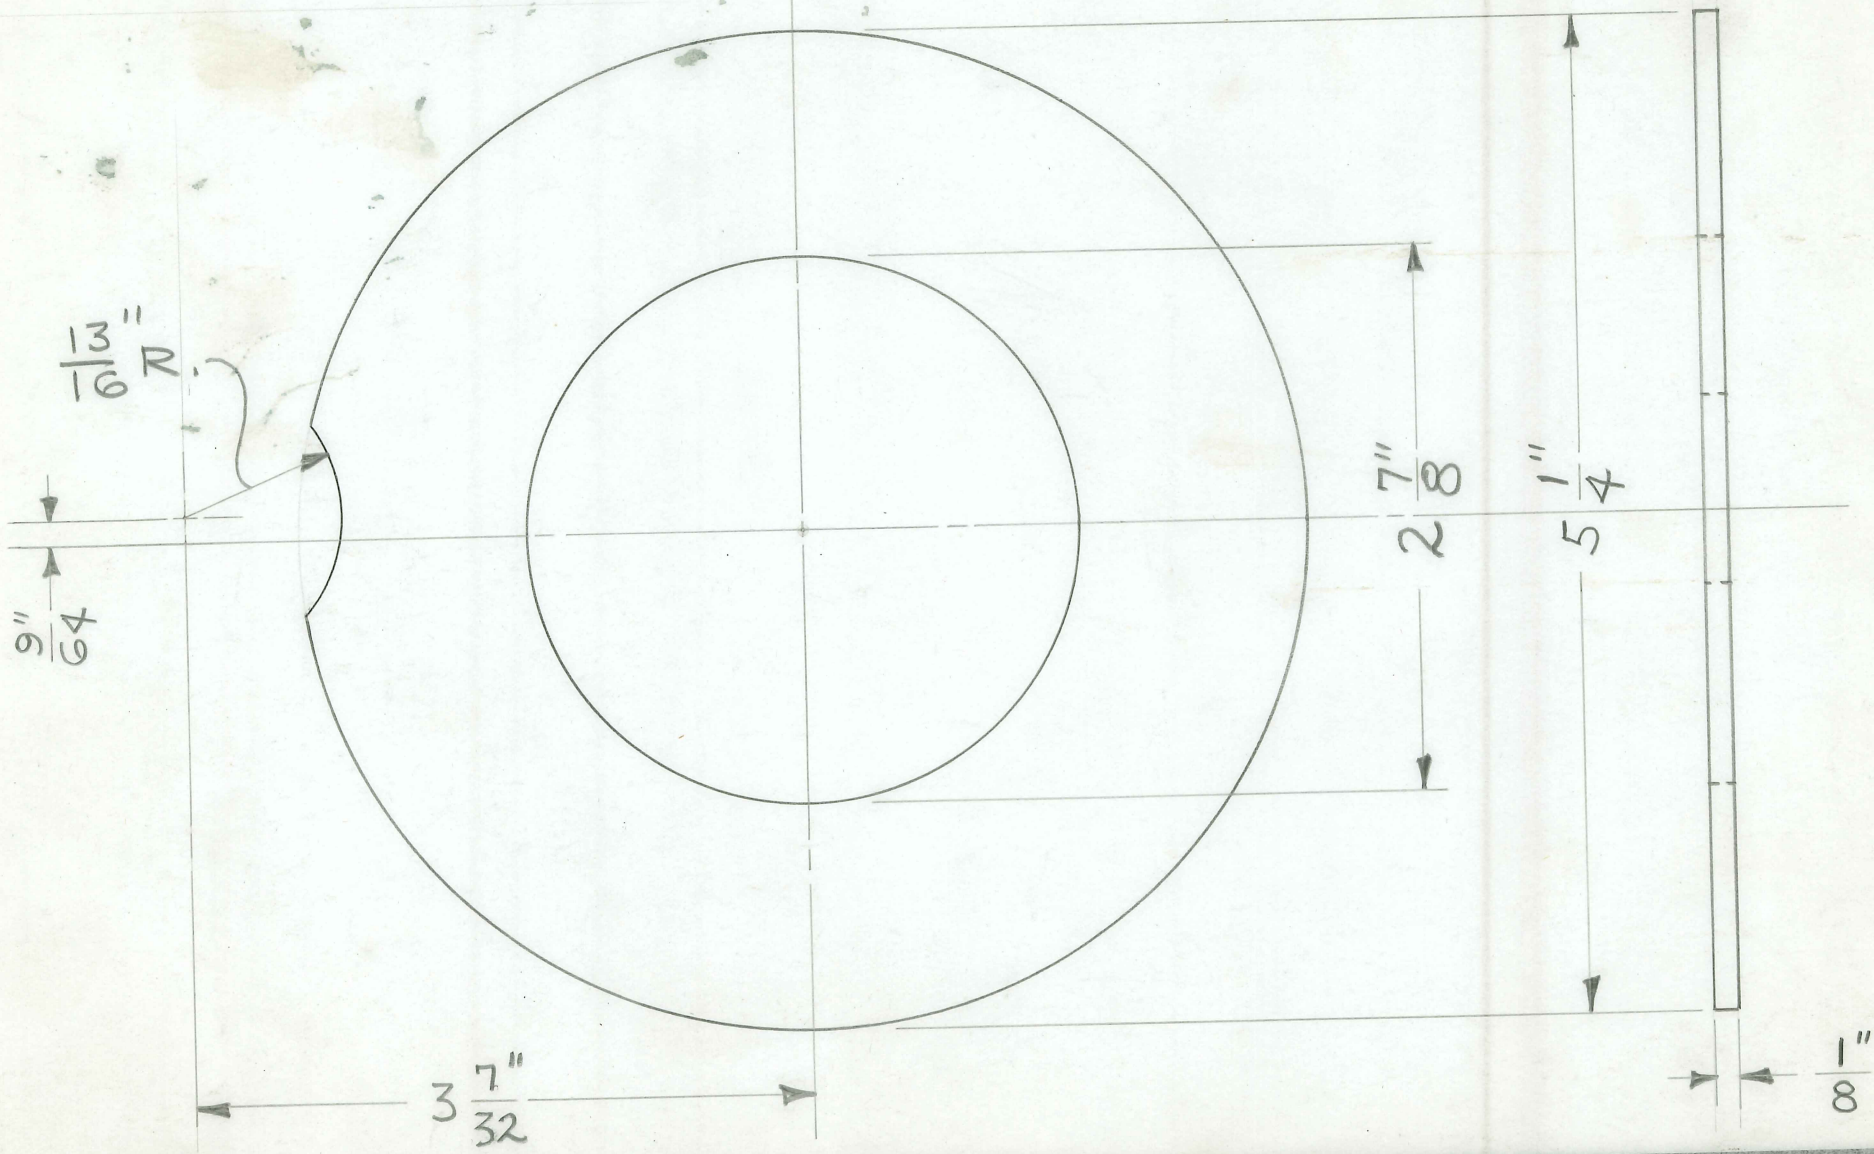

TITLE
FISCHER "MP-30" X-RAY UNIT
SECONDARY COIL SEPERATOR-SHORT

H. G. FISCHER & CO.
FRANKLIN PARK, ILLINOIS

PART NO. 17840

REVISION	DATE	BY

DATE 9-2-48 | DR. BY J.V.W. | CH'K'D.

PATTERN | FINISH | SCALE FULL

TOOLS

MATERIAL
2 7/8" I.D. x 3" O.D.
NATURAL BAKELITE TUBING

DIMENSIONS
FRACTIONAL ± .015
DECIMAL ± .005
ANGULAR ± ½°
UNLESS OTHERWISE SPECIFIED

BREAK EDGES-BOTH ENDS

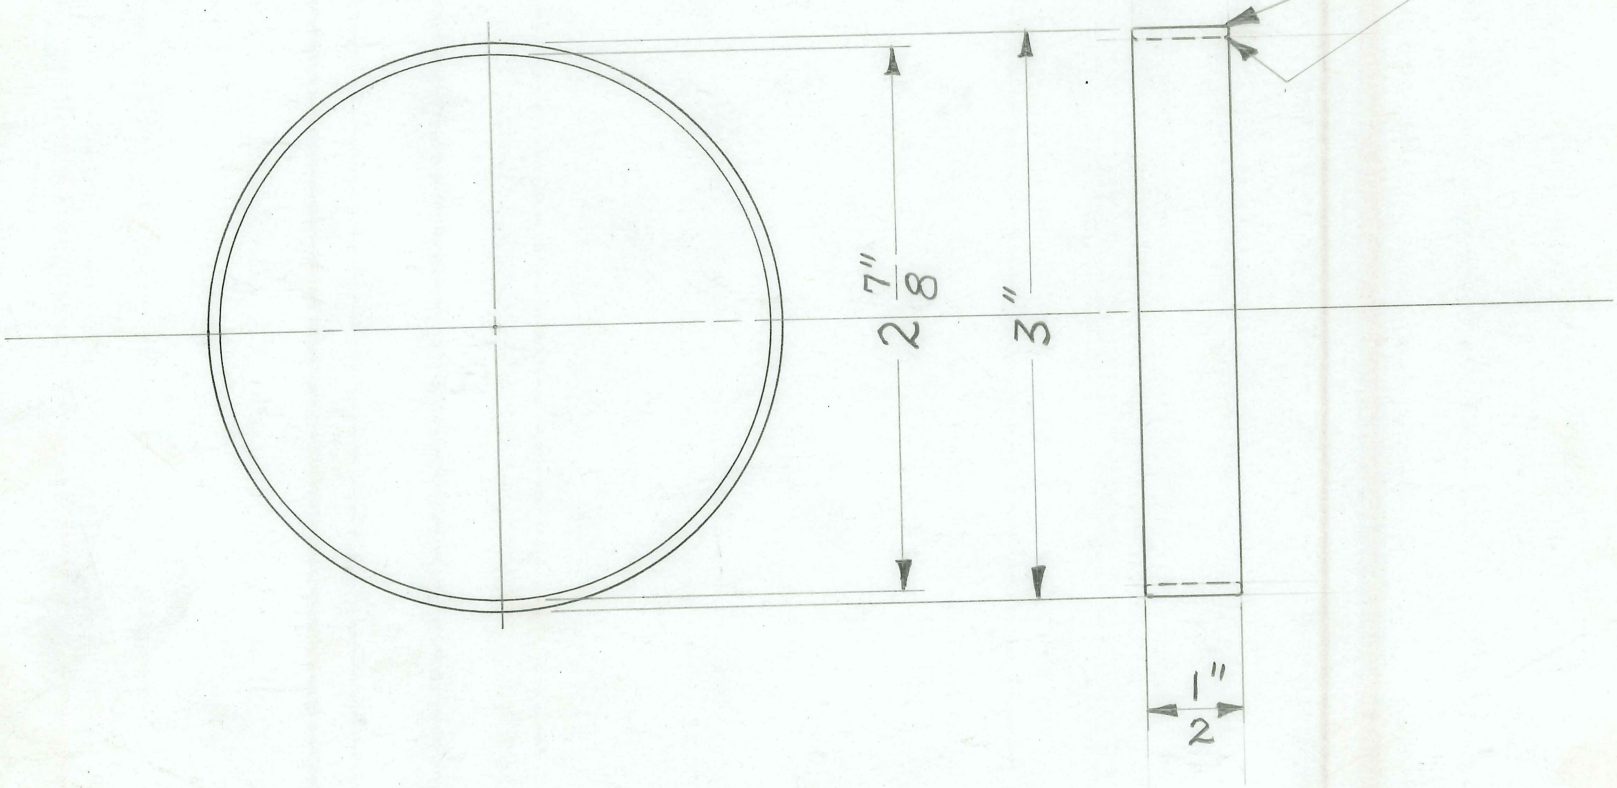

2 REQUIRED

TITLE
FISCHER "MP-30" X-RAY UNIT
SECONDARY COIL SEPERATOR -LONG

H. G. FISCHER & CO.
FRANKLIN PARK, ILLINOIS

PART NO. 17841

REVISION	DATE	BY

DATE 9-2-48 DR. BY J.V.W. CH'K'D.

PATTERN | FINISH | SCALE FULL

TOOLS

MATERIAL
2 7/8" I.D. X 3" O.D.
NATURAL BAKELITE

DIMENSIONS
FRACTIONAL ± .015
DECIMAL ± .005
ANGULAR ± ½°
UNLESS OTHERWISE SPECIFIED

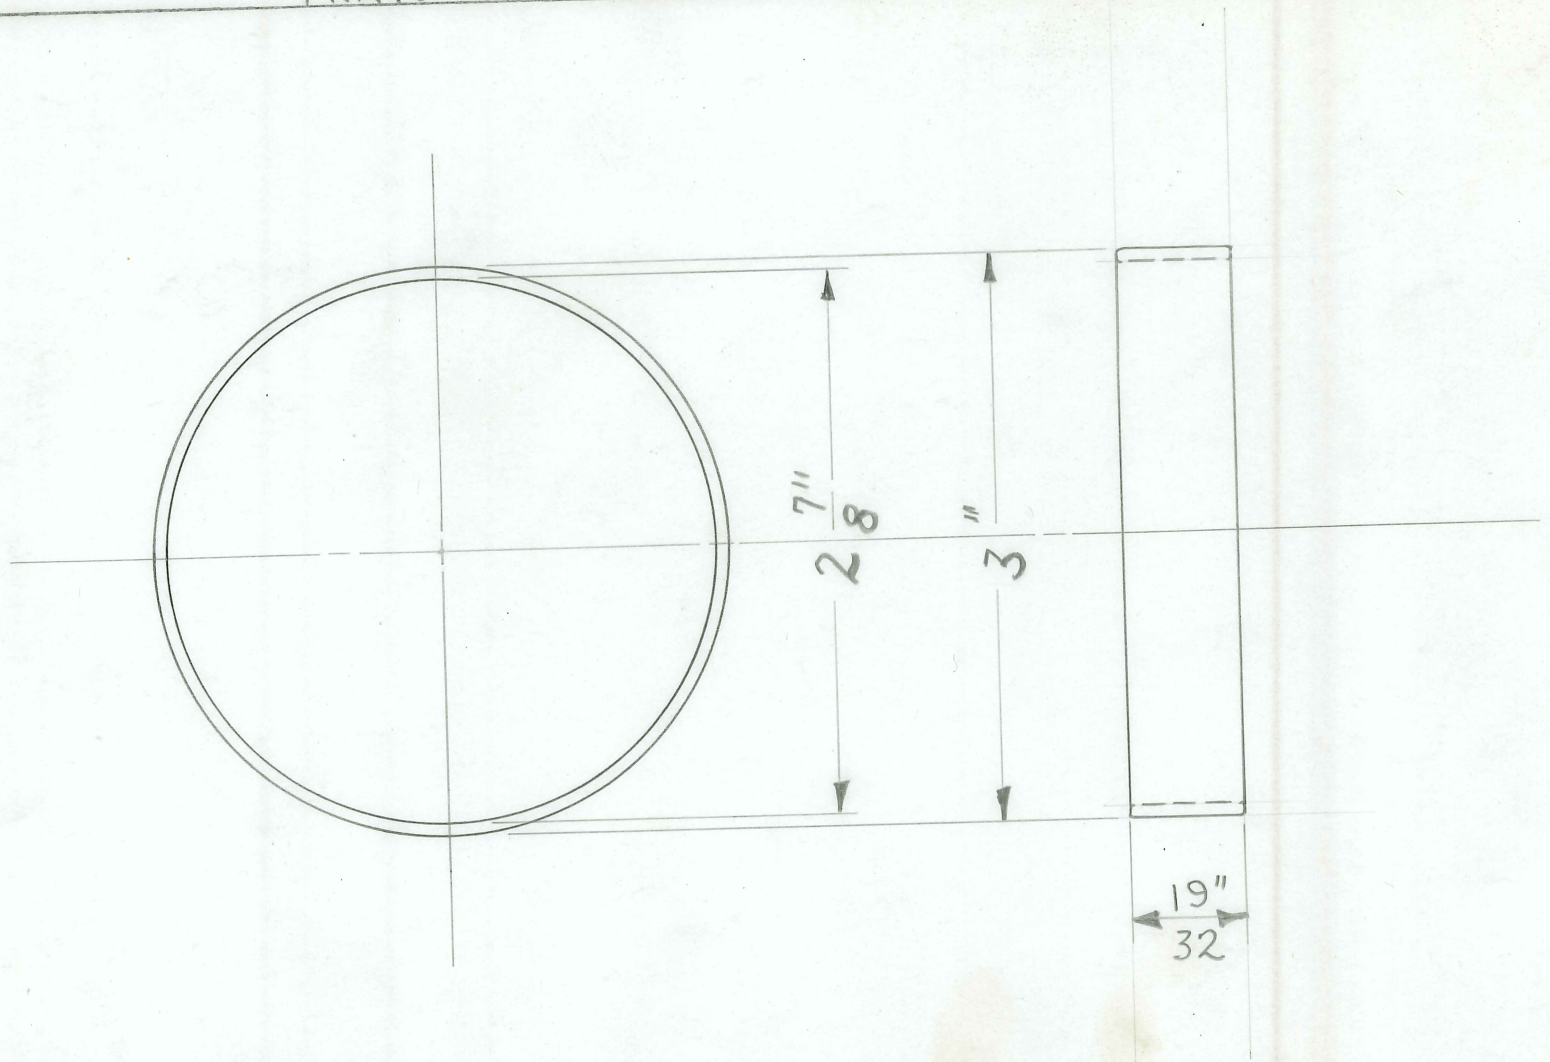

TITLE
FISCHER "MP-30" X-RAY UNIT
SHIELD CLAMPING STRIP

H. G. FISCHER & CO.
FRANKLIN PARK, ILLINOIS

PART NO. 17843

DATE 8-31-48 DR. BY J.V.W. CH'K'D.

REVISION	DATE	BY

PATTERN | FINISH | SCALE FULL

DIMENSIONS
FRACTIONAL ± .015
DECIMAL ± .005
ANGULAR ± ½°
UNLESS OTHERWISE SPECIFIED

TOOLS
PERFORATING DIE #9893

MATERIAL
1/16" SHEET CANVAS BASE BAKELITE

BREAK CORNERS & EDGES

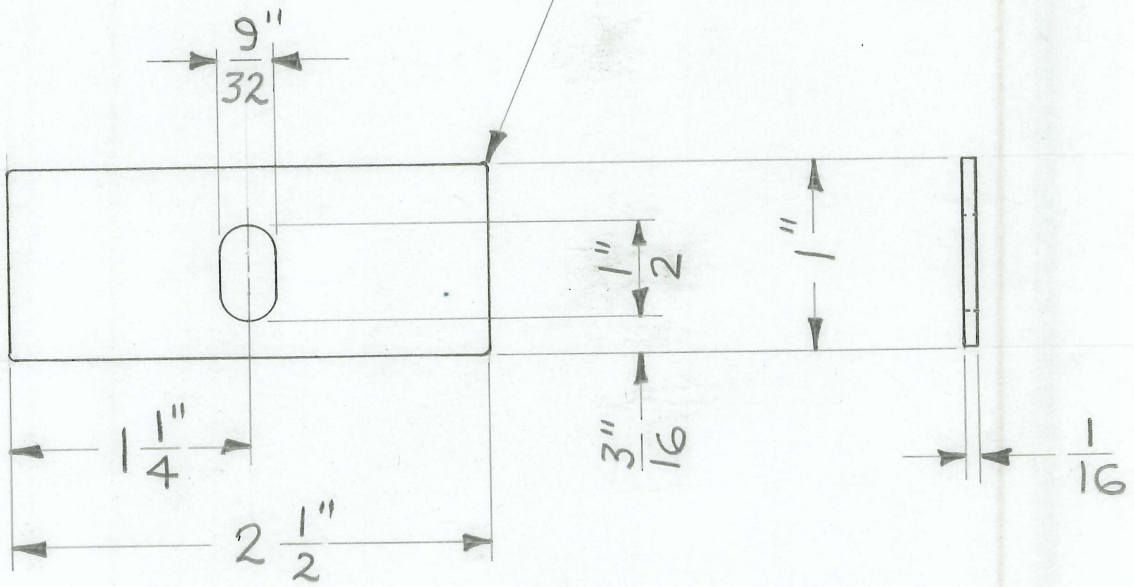

2 REQUIRED

TITLE
FISCHER "MP-30" X-RAY UNIT
X-RAY TUBE SUPP. BRKT.

H. G. FISCHER & CO.
FRANKLIN PARK, ILLINOIS

PART NO. 17844A

DATE 8-31-48 | DR. BY J.V.W. | CH'K'D.

REVISION		DATE	BY
A	WAS 1"	9-18-56	J.V.W.
B	WAS 1"		

PATTERN | FINISH | SCALE FULL

DIMENSIONS
FRACTIONAL ± .015
DECIMAL ± .005
ANGULAR ± ½°
UNLESS OTHERWISE SPECIFIED

TOOLS
CUT-OFF & SLOTTING #9892
BENDING DIE # 4662

MATERIAL
$\frac{1}{8}$" X $\frac{1}{2}$" FLAT WIRE

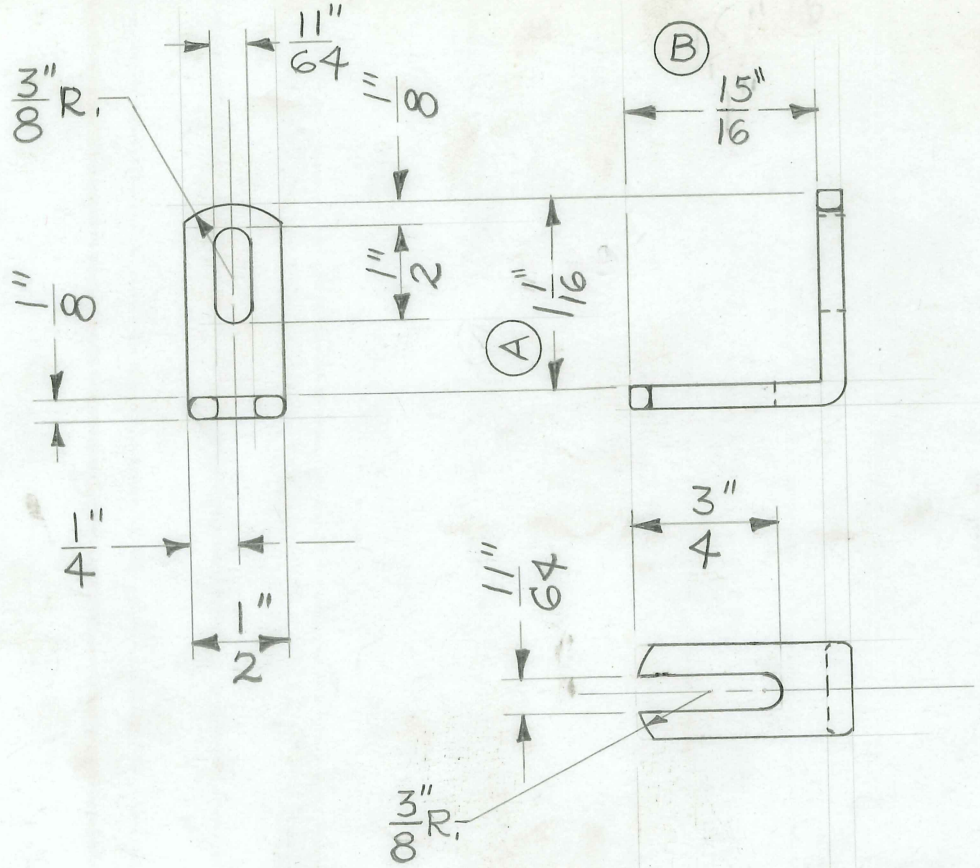

DEVELOPED LENGTH 2 1/16"

2 REQUIRED

TITLE
FISCHER "MP-30" X-RAY UNIT
HIPERSIL CORE PAPER SEPERATOR

H. G. FISCHER & CO.
FRANKLIN PARK, ILLINOIS

PART NO. 17846

DATE 9-2-48 | DR. BY J.V.W. | CH'K'D.

REVISION	DATE	BY

PATTERN	FINISH	SCALE FULL
TOOLS	MATERIAL .020 SHEET WET STRENGTH PAPER	

DIMENSIONS
FRACTIONAL ± .015
DECIMAL ± .005
ANGULAR ± ½°
UNLESS OTHERWISE SPECIFIED

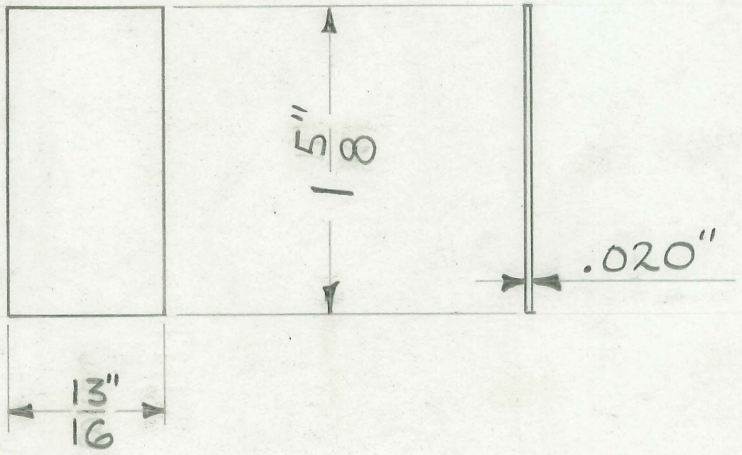

12 REQUIRED

TITLE
FISCHER "MP-30" X-RAY UNIT
PRIMARY COIL TUBE

H. G. FISCHER & CO.
FRANKLIN PARK, ILLINOIS

PART NO. 17847

DATE 9-2-48 | DR. BY J.V.W. | CH'K'D.

REVISION	DATE	BY

PATTERN | FINISH | SCALE FULL

TOOLS
WINDING FIX. # 11289

MATERIAL
PAPER

DIMENSIONS
FRACTIONAL ± .015
DECIMAL ± .005
ANGULAR ± ½°
UNLESS OTHERWISE SPECIFIED

FOR WINDING COIL
ON OUTSIDE OF TUBE

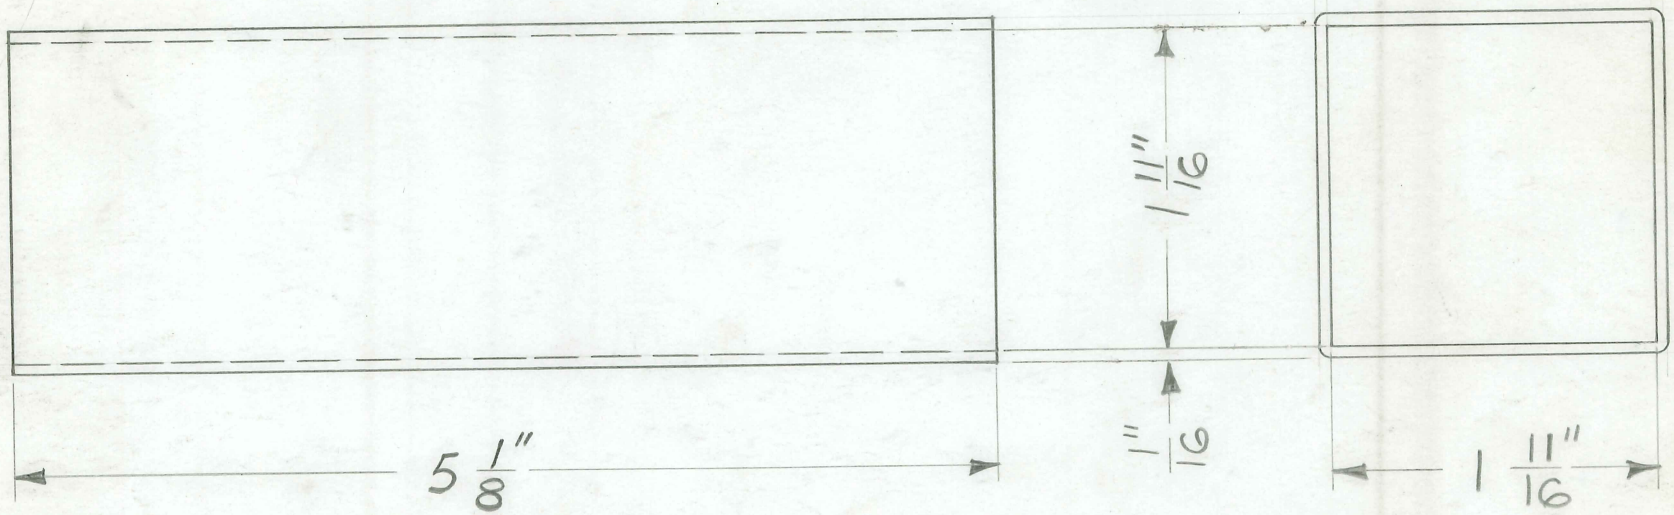

1 REQUIRED

TITLE
FISCHER MP 30 X-RAY
COVER MOUNTING BLOCK

H. G. FISCHER & CO.
FRANKLIN PARK, ILLINOIS

PART NO. 17848 S&M

DATE 9-3-52 | DR BY W.J. | CH'K'D.

REVISION	DATE	BY

PATTERN | FINISH CAD. #23 | SCALE FULL

TOOLS
DRILL JIG # 11705

MATERIAL
3/16" X 1/2" C.R. STEEL BAR

DIMENSIONS
FRACTIONAL ± .015
DECIMAL ± .005
ANGULAR ± ½°
UNLESS OTHERWISE SPECIFIED

SHEAR IN SHEET METAL SHOP

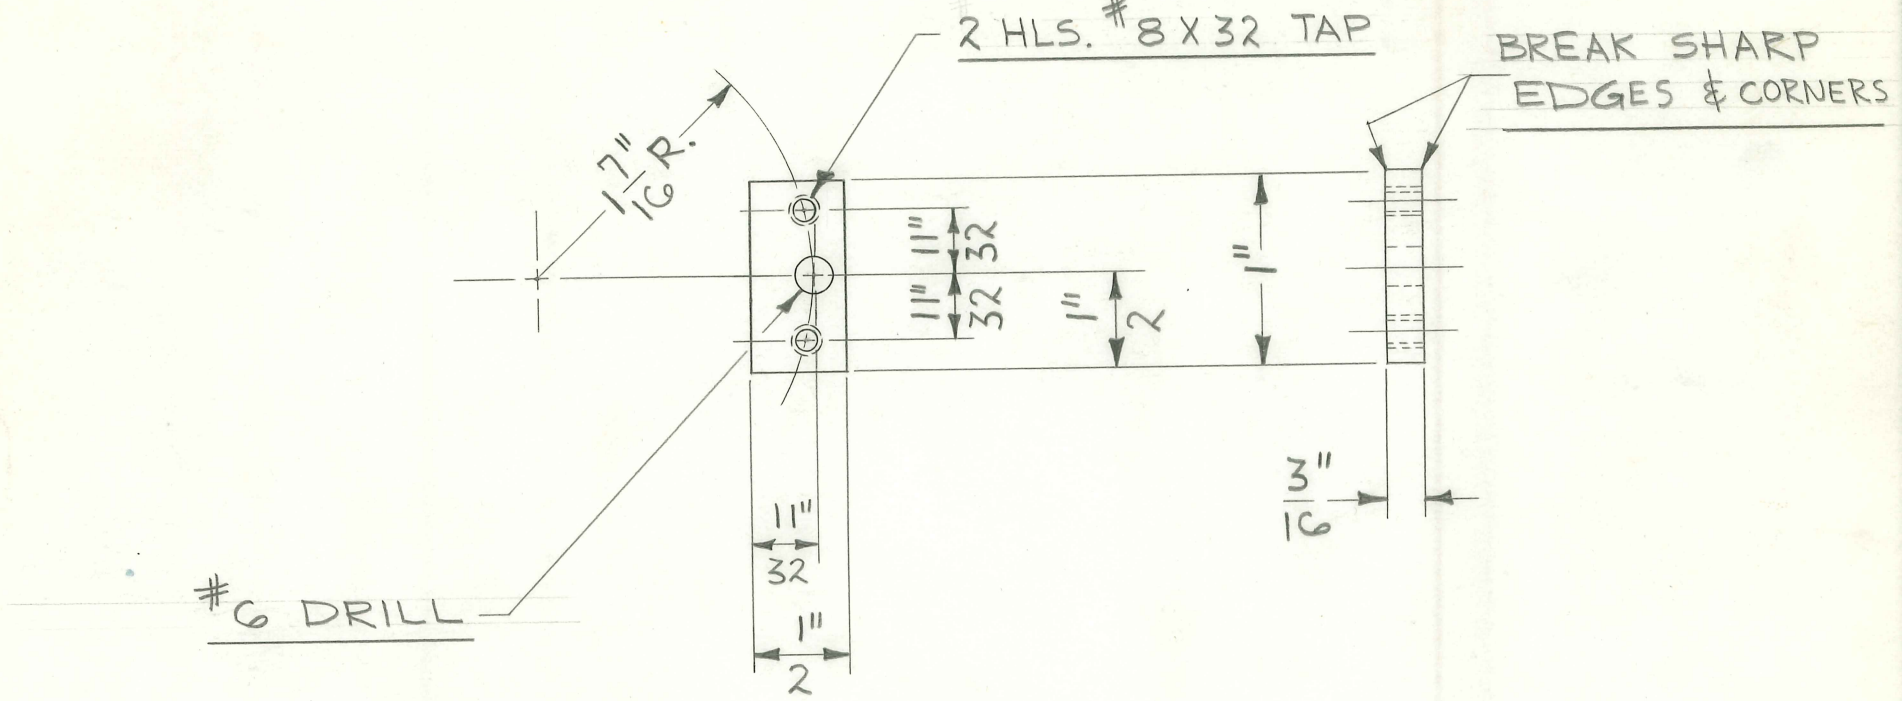

4 REQUIRED

TITLE

FISCHER "MP-30" X-RAY UNIT
GROUND STRIP

H. G. FISCHER & CO.
FRANKLIN PARK, ILLINOIS

DATE 11-29-49 | DR. BY W.J. | CH'K'D. J.V.W.

PART NO. 17853

REVISION	DATE	BY

PATTERN | FINISH | SCALE FULL

TOOLS: BLANKING & PERF. DIE #860-Q4

MATERIAL: .025" SHEET BRASS

DIMENSIONS UNLESS OTHERWISE SPECIFIED
FRACTIONAL ± .015
DECIMAL ± .005
ANGULAR ± ½°

1 REQUIRED

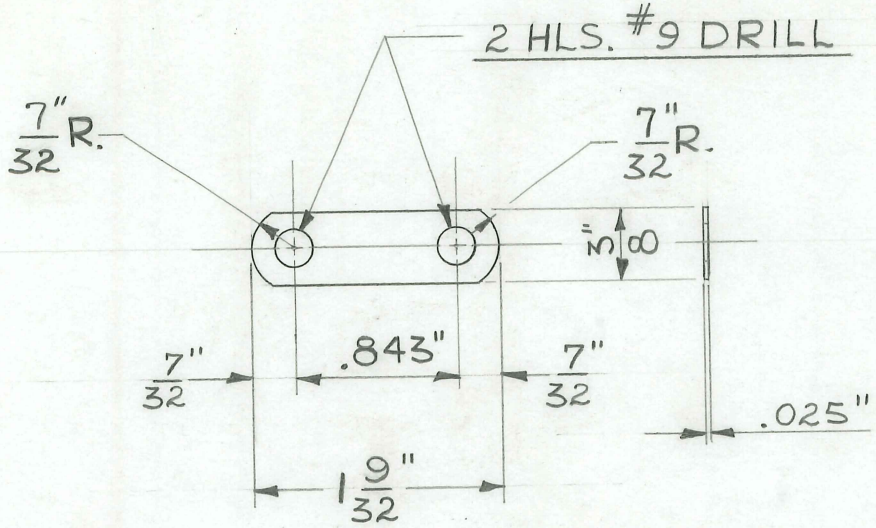

TITLE FISCHER "MP-30" TUBEHEAD PERMANENT FILTER

H. G. FISCHER & CO.
FRANKLIN PARK, ILLINOIS

PART NO. 17866 A

DATE 7-19-57 DR BY J.V.W. CH'K'D.

REVISION		DATE	BY
A	WAS .064	7-20-62	RCT

PATTERN | FINISH | SCALE FULL

DIMENSIONS
FRACTIONAL ± .015
DECIMAL ± .005
ANGULAR ± ½°
UNLESS OTHERWISE SPECIFIED

TOOLS BLANK DIE #8207

MATERIAL ~~#14 GA.~~ .080" SHEET
ALUMINUM #1100-H14
BRIGHT FINISH BOTH SIDES

USED ON #16584GC & #18081GD

PRESS FIT FOR #13716
USE DIE #8207

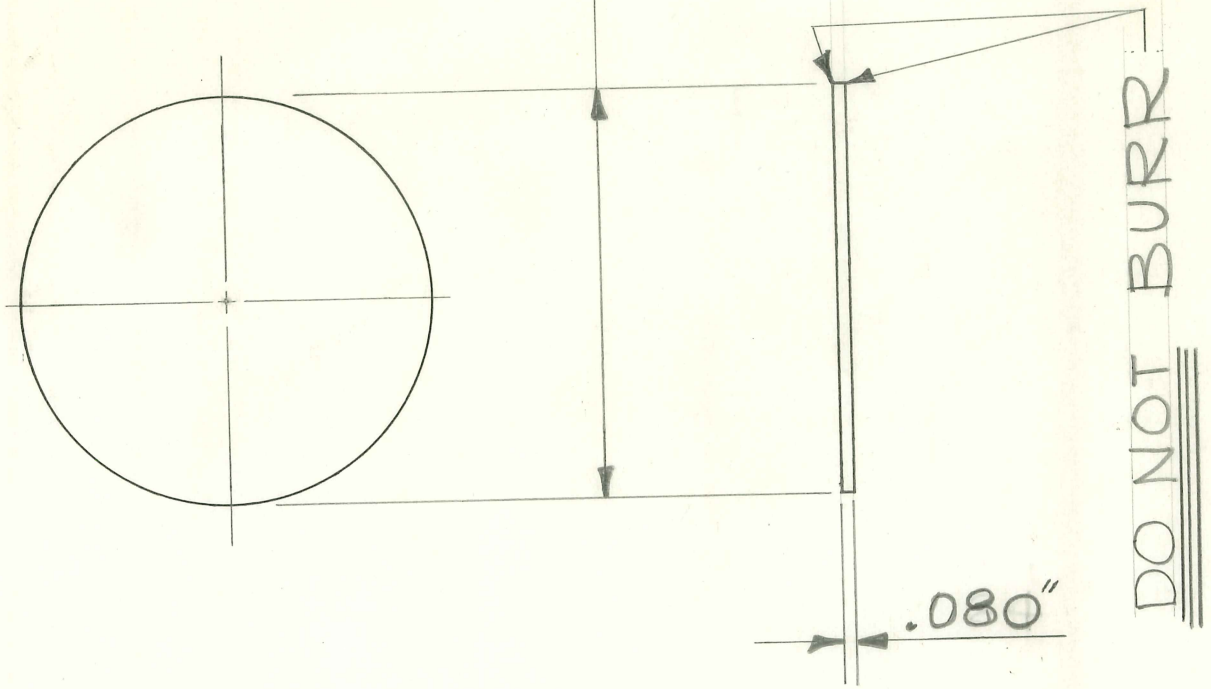

1 REQUIRED

135

TITLE
FISCHER MP-30 UNIT-CONTROL
CIRCUIT BREAKER

H. G. FISCHER & CO.
FRANKLIN PARK, ILLINOIS

PART NO. 17872

REVISION	DATE	BY

DATE 10-12-55 | DR BY RDL | CH'K'D. RC

PATTERN | FINISH | SCALE FULL

TOOLS

MATERIAL HEINEMANN ELECT. CO
CAT.# AM 12 RSK - 19 AMPS - CURVE 5 -
- 120 V. A.C

DIMENSIONS
FRACTIONAL ± .015
DECIMAL ± .005
ANGULAR ± ½°
UNLESS OTHERWISE SPECIFIED

FOR HORIZONTAL OPERATION

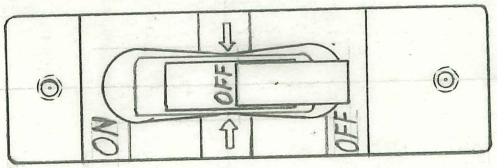

TO OPEN IN 15 SECONDS
24 AMPERES 0.10 VOLTS A.C.

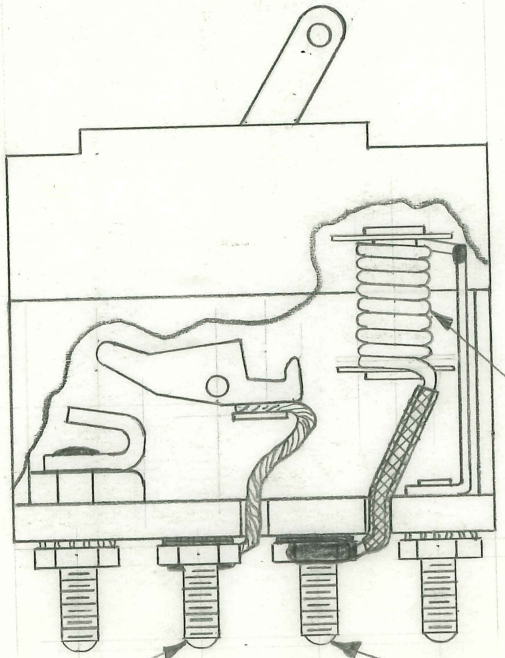

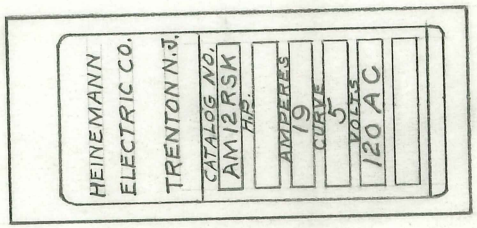

COIL - 9 TURNS
#14 E. WIRE

1240 VOLT TEST

TITLE FISCHER "MP-30" X-RAY UNIT
AUTO CONTROL PAPER TUBE

H. G. FISCHER & CO.
FRANKLIN PARK, ILLINOIS

PART NO. 17876

DATE 9-17-48 DR. BY J.V.W. CH'K'D.

REVISION	DATE	BY

PATTERN | FINISH | SCALE FULL

TOOLS | MATERIAL PAPER

DIMENSIONS
FRACTIONAL ± .015
DECIMAL ± .005
ANGULAR ± ½°
UNLESS OTHERWISE SPECIFIED

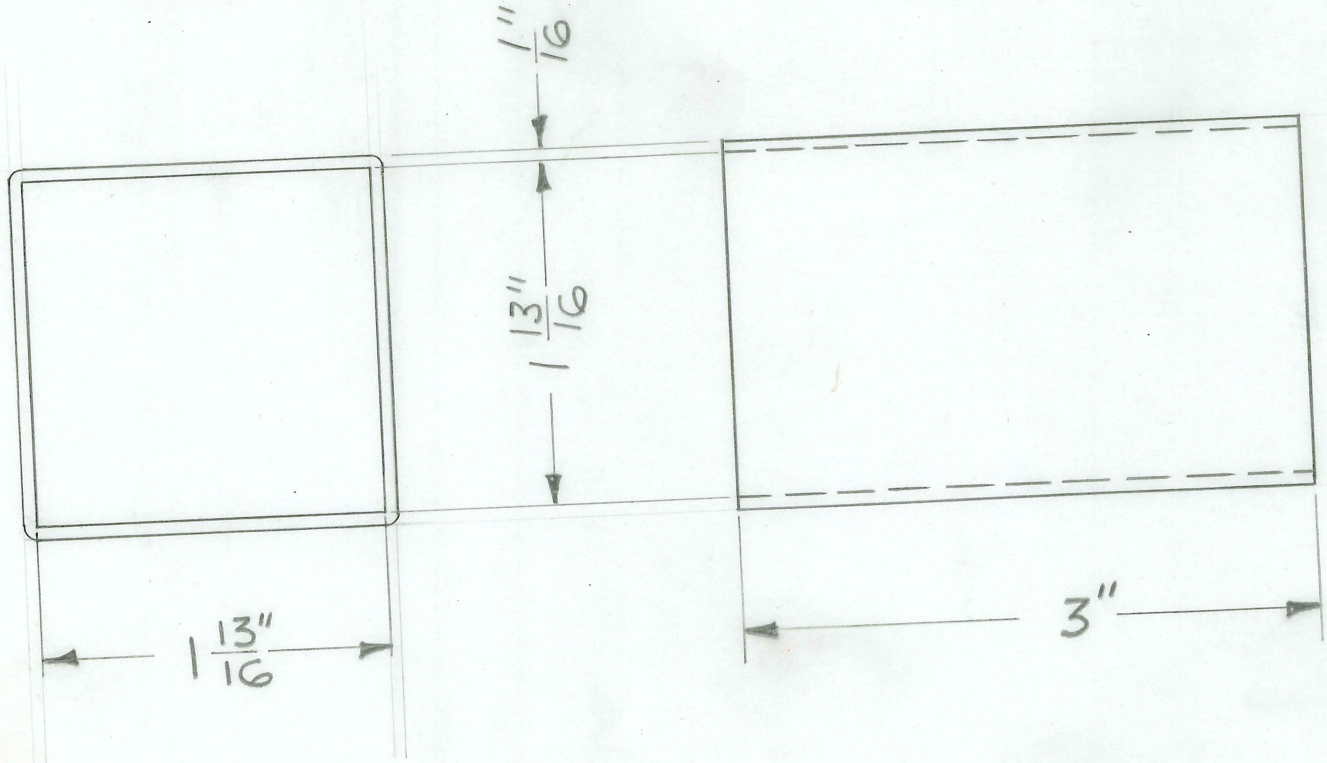

1 REQUIRED

TITLE
FISCHER "MP-30" X-RAY UNIT
RELAY BRACKET

H. G. FISCHER & CO.
FRANKLIN PARK, ILLINOIS

PART NO. 17877A

DATE 9-10-48 DR. BY J.V.W. CH'K'D.

REVISION	DATE	BY
A WAS 2"	12-6-49	W.J.
B " 3 1/2"	"	"
C " 4 23/32"	"	"

PATTERN | FINISH CAD. #23 | SCALE FULL

TOOLS
DRILL JIG # 9885

MATERIAL
#16 GA. (.060") SHEET. C.R. STEEL

DIMENSIONS
FRACTIONAL ± .015
DECIMAL ± .005
ANGULAR ± ½°
UNLESS OTHERWISE SPECIFIED

BENDING DIE #4662

CUT BLANK $1\frac{3}{8}$" WIDE X $5\frac{5}{32}$" LONG Ⓒ
GRAIN TO RUN LENGTHWISE

BREAK SHARP EDGES & CORNERS

6 HLS. - #9 DRILL

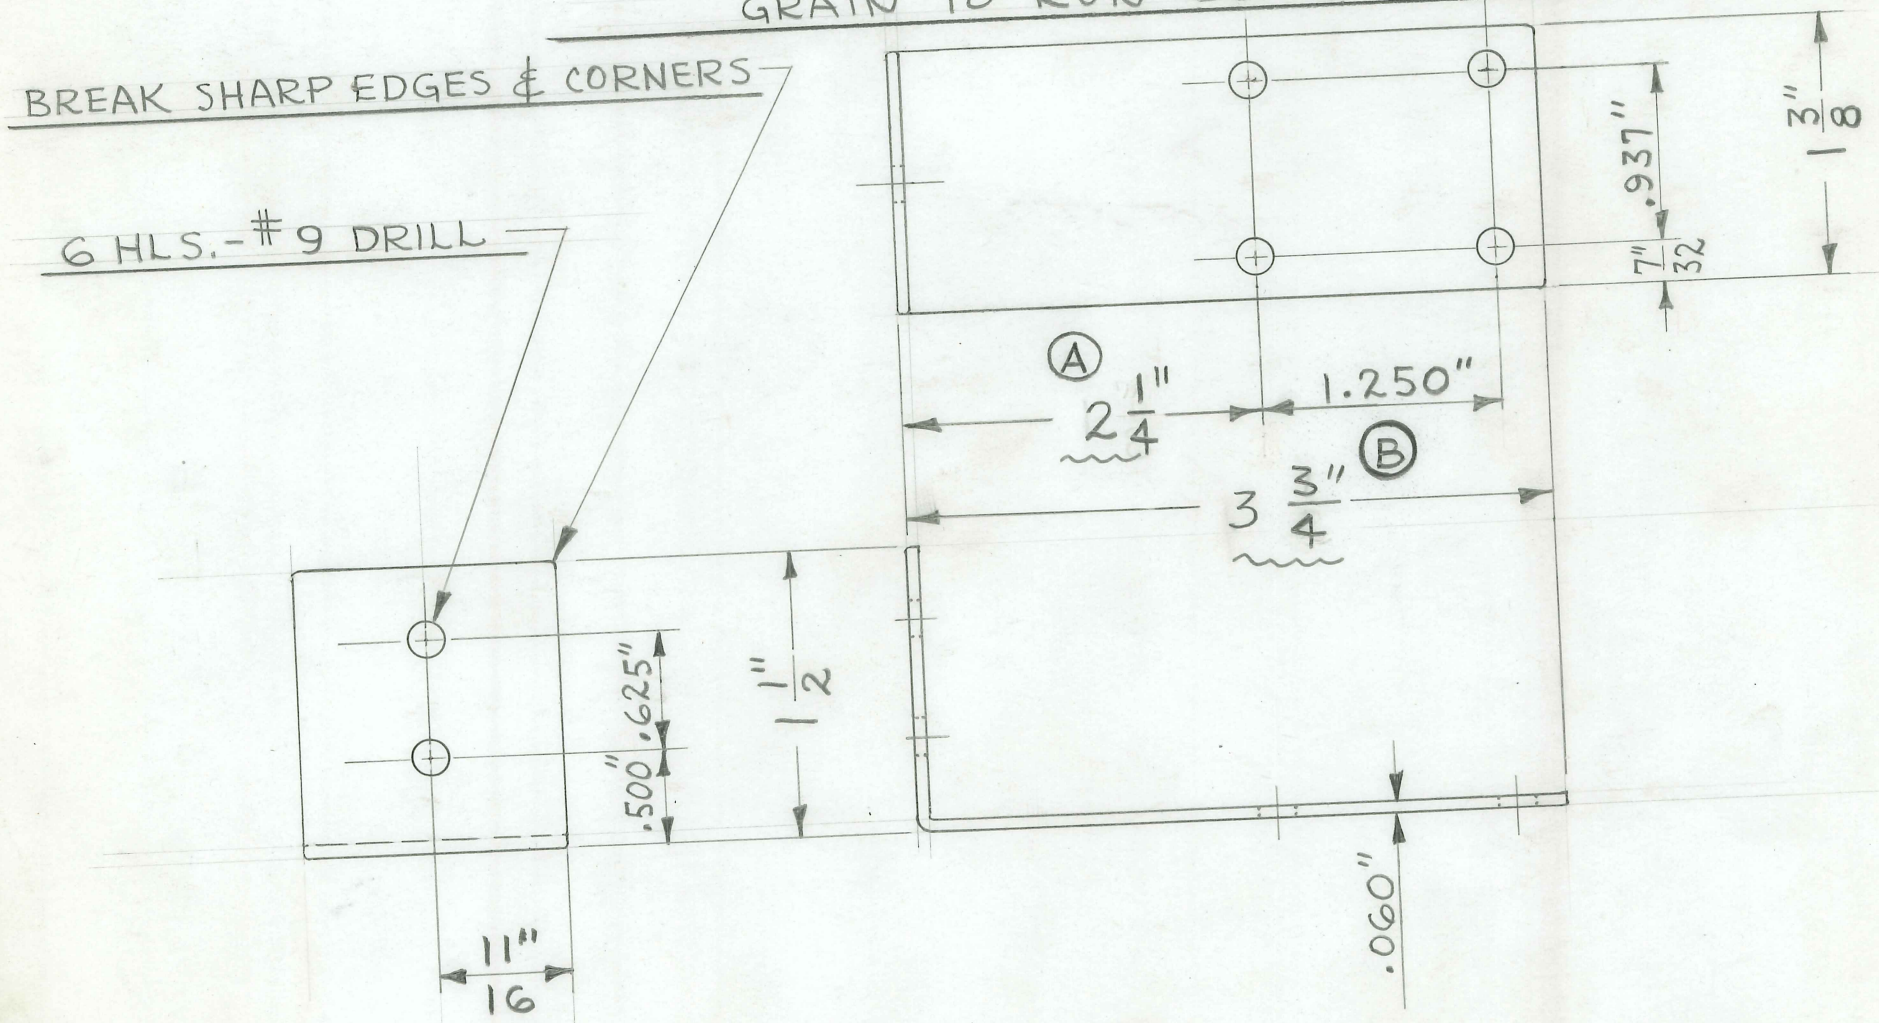

1 REQUIRED

TITLE: FISCHER "MP-30" X-RAY CORD CLAMP STRAP	H. G. FISCHER & CO. FRANKLIN PARK, ILLINOIS		PART NO. 17878
	DATE 9-10-48	DR. BY J.V.W.	CH'K'D.
PATTERN	FINISH CAD. #23	SCALE FULL	DIMENSIONS: FRACTIONAL ± .015; DECIMAL ± .005; ANGULAR ± ½°; UNLESS OTHERWISE SPECIFIED
TOOLS: CUT-OFF & PERF. DIE # 721 BIN Y-5	MATERIAL: $\frac{1}{8}$" X $\frac{1}{2}$" FLAT WIRE		

REVISION	DATE	BY

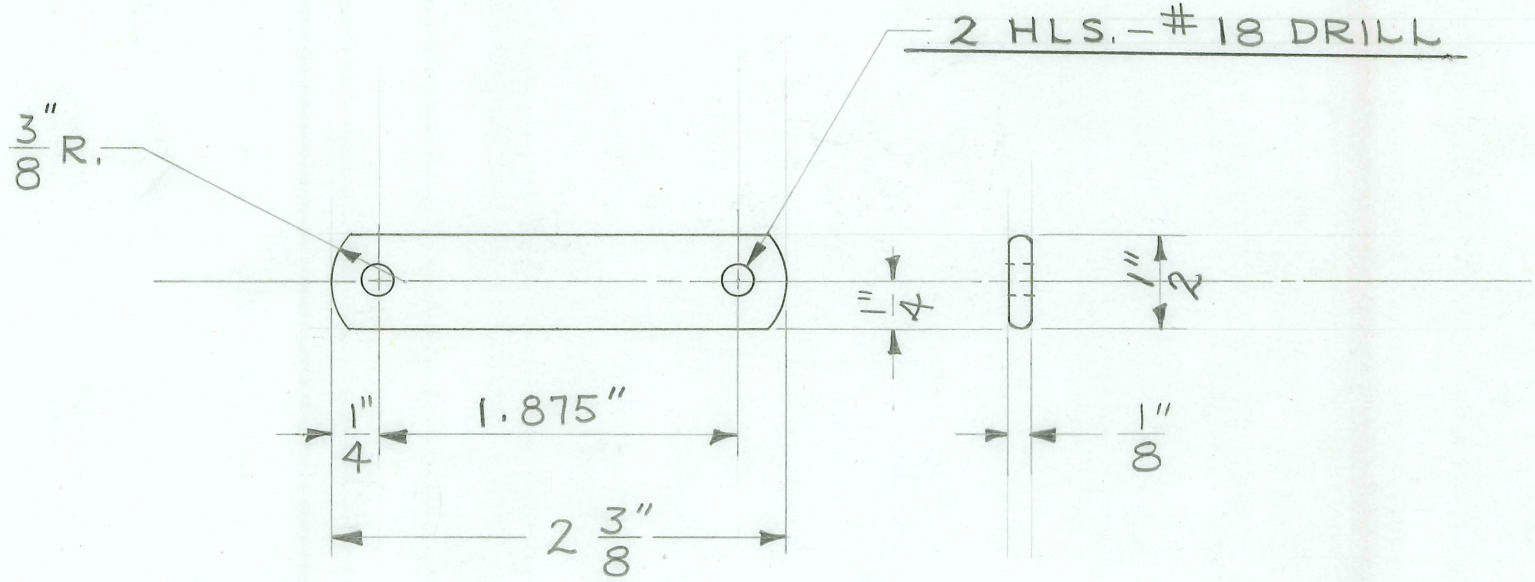

1 REQUIRED

TITLE
FISCHER "MP-30" X-RAY UNIT
COVER SPACER

H. G. FISCHER & CO.
FRANKLIN PARK, ILLINOIS

PART NO. 17879A

DATE 9-10-48 | DR. BY J.V.W. | CH'K'D.

REVISION		DATE	BY
A	WAS $1\frac{1}{8}$"	10-3-49	J.V.W.

PATTERN | FINISH | SCALE FULL

TOOLS

MATERIAL
$\frac{3}{8}$" HEX. BRASS ROD

DIMENSIONS
FRACTIONAL ± .015
DECIMAL ± .005
ANGULAR ± ½°
UNLESS OTHERWISE SPECIFIED

CHAMFER CORNERS
BOTH ENDS

#10X32 TAP-THRU
C'SUNK. TO $\frac{1}{4}$" FACE
BOTH ENDS.

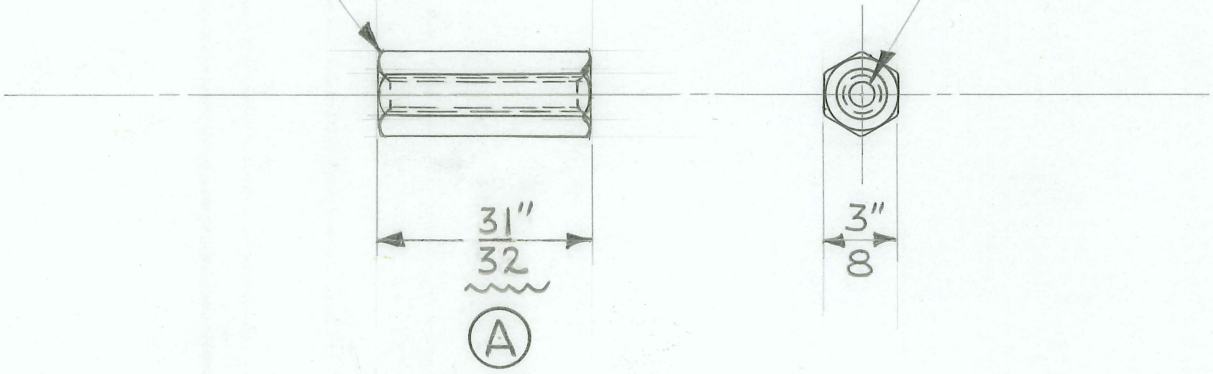

4 REQUIRED

TITLE
FISCHER "MP-30" X-RAY UNIT
TRANSF. CLAMP

H. G. FISCHER & CO.
FRANKLIN PARK, ILLINOIS

PART NO. 17880

DATE 9-11-48 | DR. BY J.V.W. | CH'K'D.

REVISION	DATE	BY

PATTERN | FINISH | SCALE FULL

TOOLS
DRILL JIG TOOL # 9886

MATERIAL
$\frac{1}{4}$" X 1$\frac{1}{4}$" C.R. STEEL BAR

DIMENSIONS
FRACTIONAL ± .015
DECIMAL ± .005
ANGULAR ± ½°
UNLESS OTHERWISE SPECIFIED

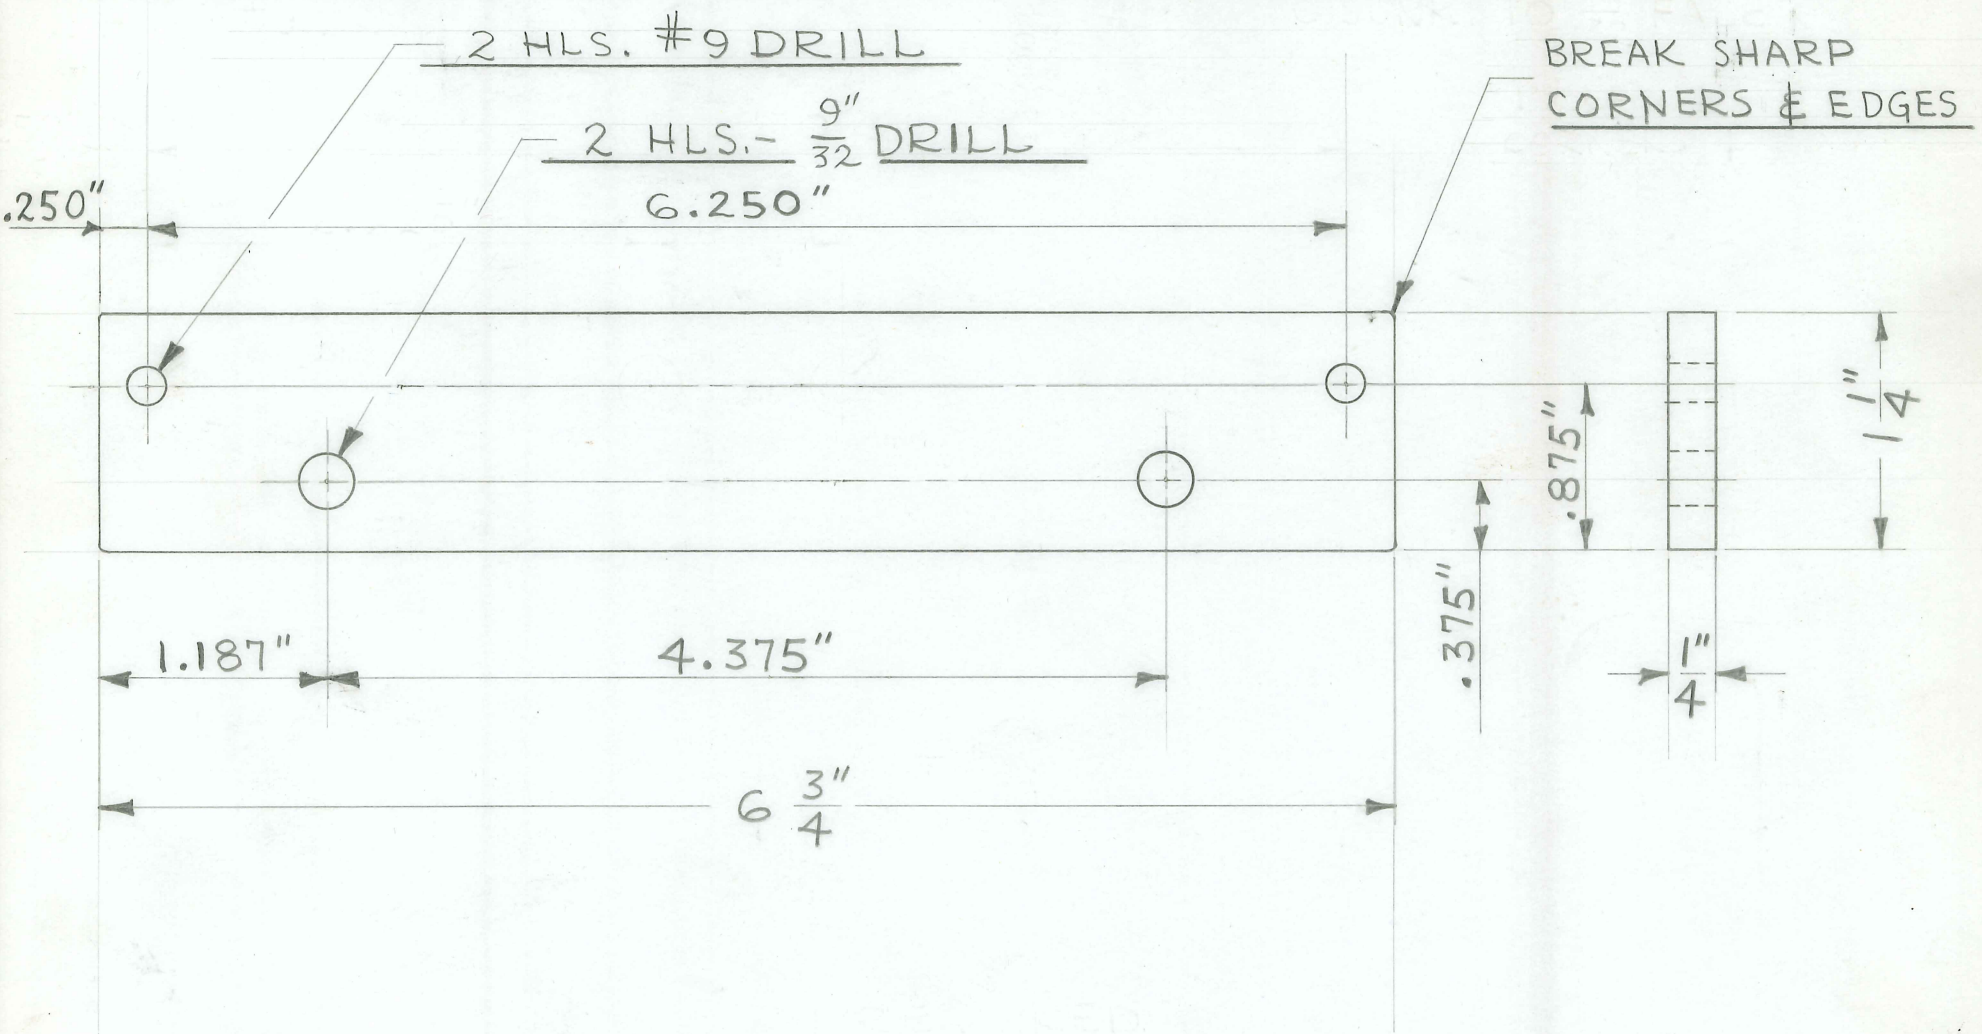

2 REQUIRED

TITLE
FISCHER "MP-30" X-RAY UNIT
TRANSF. CLAMP - LOWER

H. G. FISCHER & CO.
FRANKLIN PARK, ILLINOIS

PART NO. 17881A

DATE 9-11-48 | DR. BY J.V.W. | CH'K'D.

REVISION	DATE	BY
A WAS #16 DRILL C'SUNK TO 11/32" FACE	5-6-52	W.V.

PATTERN | FINISH | SCALE FULL

TOOLS
DRILL JIG TOOL # 9886

MATERIAL
1/4" X 1 1/4" C.R. STEEL BAR

DIMENSIONS UNLESS OTHERWISE SPECIFIED
FRACTIONAL ± .015
DECIMAL ± .005
ANGULAR ± ½°

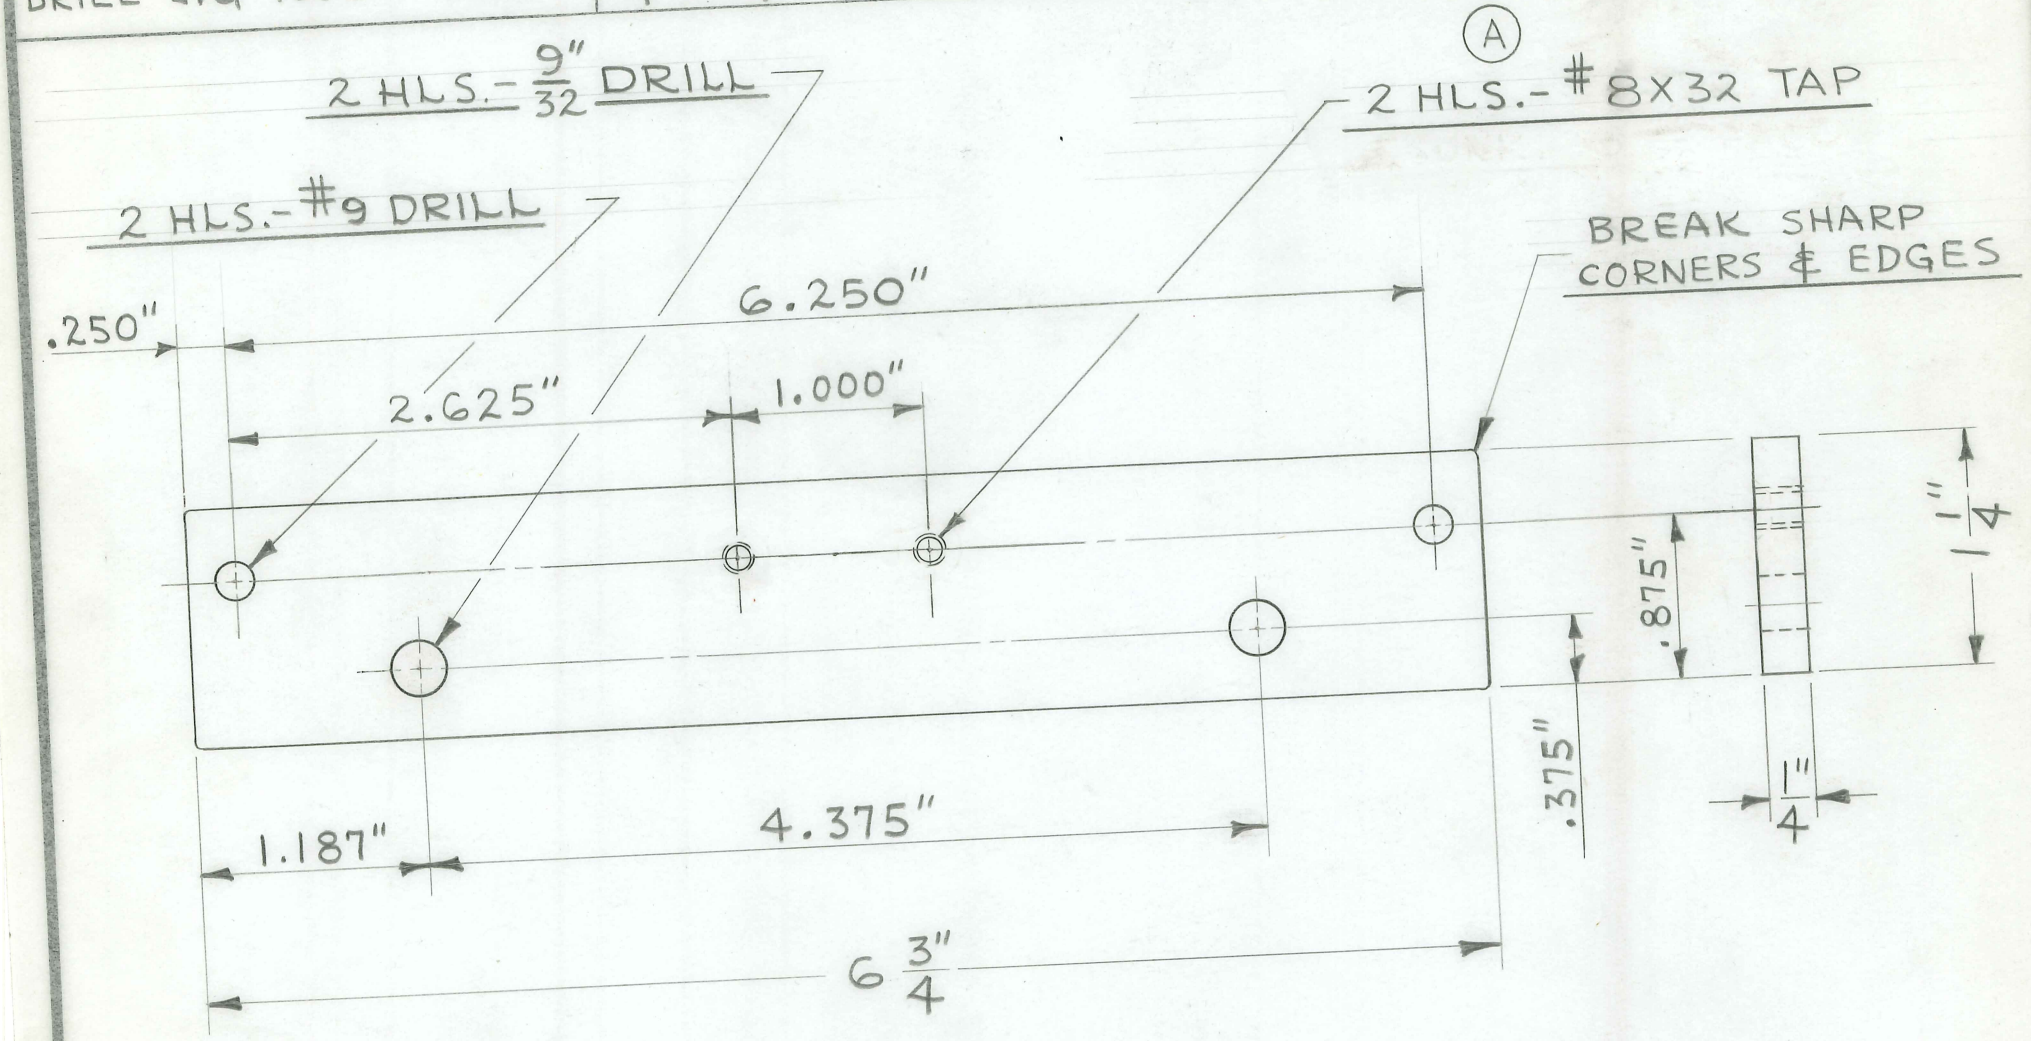

2 REQUIRED

TITLE
FISCHER "MP-30" X-RAY UNIT
TRANSF. SUPP. SPACER

H. G. FISCHER & CO.
FRANKLIN PARK, ILLINOIS

PART NO. 17882C

DATE 9-11-48 | DR. BY J.V.W. | CH'K'D.

REVISION		DATE	BY
A	WAS $5\frac{1}{16}$"	10-3-49	J.V.W.
B	WAS $4\frac{15}{16}$"	11-28-49	W.J.
C	WAS $5\frac{11}{16}$"	10-3-55	J.V.W.

PATTERN | FINISH | SCALE FULL

TOOLS

MATERIAL
$\frac{3}{8}$" DIA. BRASS ROD

DIMENSIONS
FRACTIONAL ± .015
DECIMAL ± .005
ANGULAR ± ½°
UNLESS OTHERWISE SPECIFIED

#20 TAP DRILL $\frac{3}{4}$" DEEP
#10X32 TAP $\frac{5}{8}$" DEEP
C'SUNK. TO $\frac{1}{4}$" FACE

BREAK EDGES-BOTH ENDS

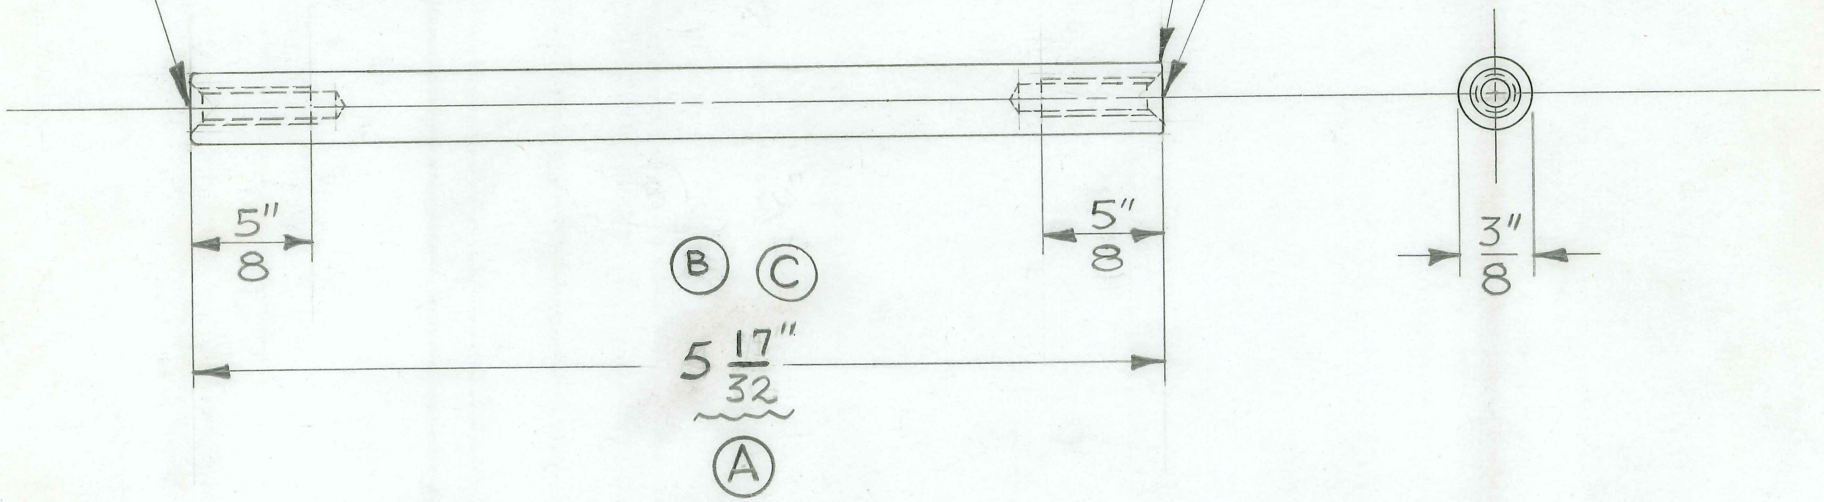

4 REQUIRED

TITLE FISCHER "MP-30" X-RAY UNIT
RESISTOR BRACKET

H. G. FISCHER & CO.
FRANKLIN PARK, ILLINOIS

DATE 9-13-48 | DR. BY J.V.W. | CH'K'D.

PART NO. 17883F

REVISION	DATE	BY

PATTERN | FINISH | SCALE FULL

TOOLS
BENDING FIXTURE #9884

MATERIAL FROM 17883
USE STOCK BRACKETS THAT
ARE SENT IN WITH RESISTORS

DIMENSIONS
FRACTIONAL ± .015
DECIMAL ± .005
ANGULAR ± ½°
UNLESS OTHERWISE SPECIFIED

STRAIGHTEN AS SHOWN HERE
THEN BEND AS SHOWN BELOW

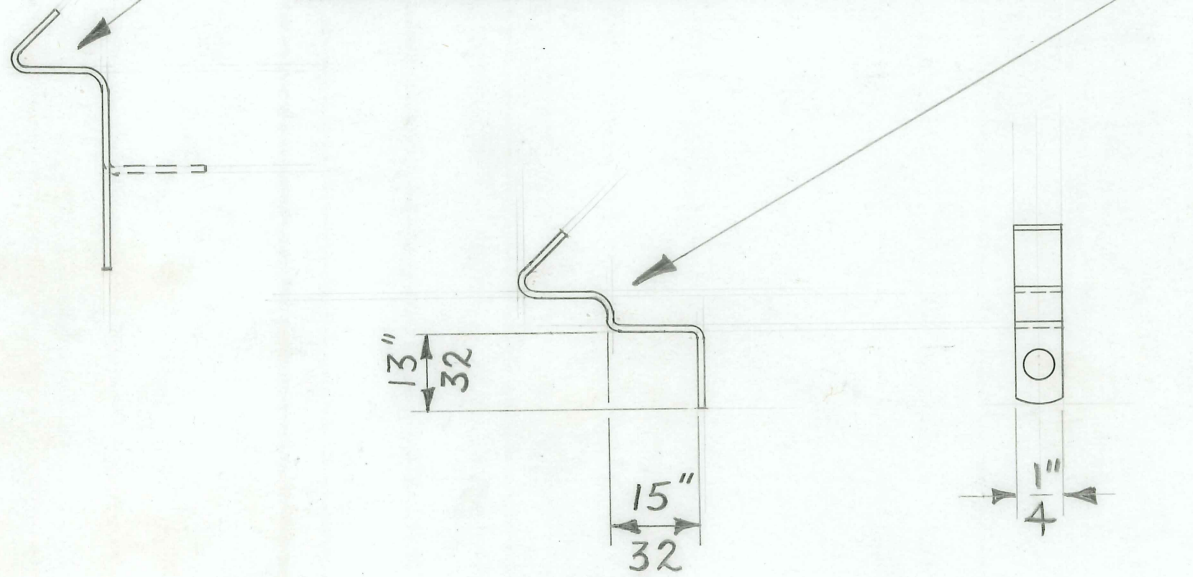

2 REQUIRED

TITLE
FISCHER "MP-30" X-RAY UNIT
TERMINAL BOARD SUPP. ANGLE-BLANK

H. G. FISCHER & CO.
FRANKLIN PARK, ILLINOIS

PART NO. 17884

DATE 9-28-48 DR. BY J.V.W. CH'K'D.

REVISION	DATE	BY

PATTERN | FINISH | SCALE FULL

TOOLS

MATERIAL
#20 GA. (.036") SHEET C.R. STEEL

DIMENSIONS
FRACTIONAL ± .015
DECIMAL ± .005
ANGULAR ± ½°
UNLESS OTHERWISE SPECIFIED

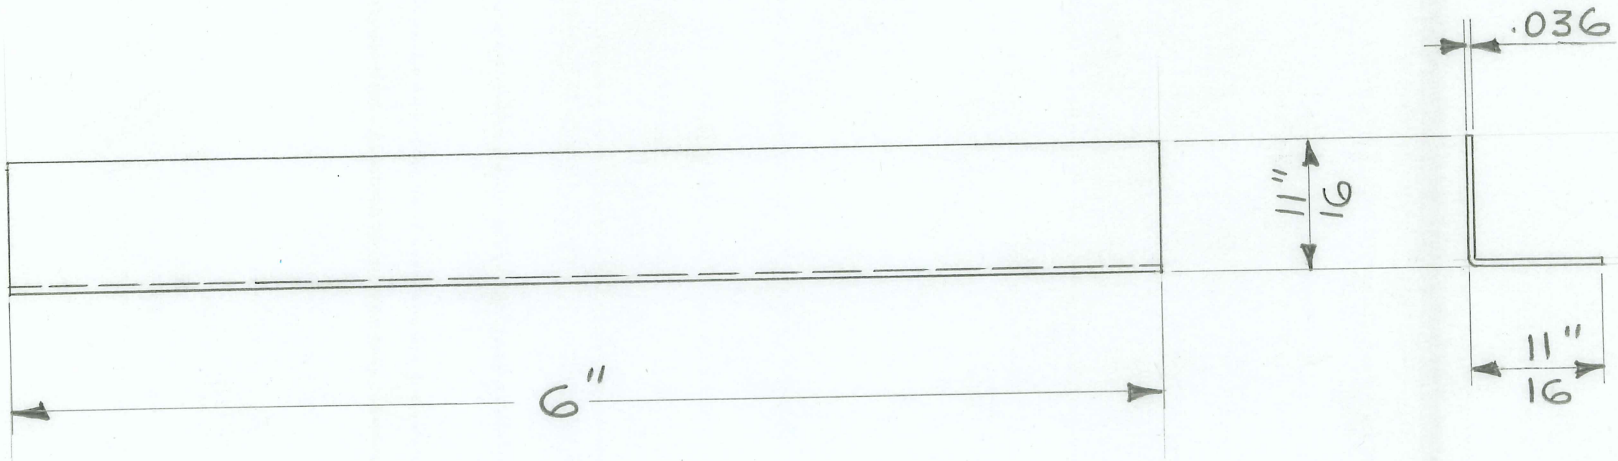

2 REQUIRED

TITLE
FISCHER "MP-30" X-RAY UNIT
TERMINAL BOARD SUPP. ANGLE

H. G. FISCHER & CO.
FRANKLIN PARK, ILLINOIS

PART NO. 17884F

DATE	DR. BY	CH'K'D.
9-11-48	J.V.W.	

REVISION	DATE	BY

PATTERN	FINISH	SCALE
		FULL

TOOLS
DRILL JIG # 9882

MATERIAL
FROM 17884

DIMENSIONS
FRACTIONAL ± .015
DECIMAL ± .005
ANGULAR ± ½°
UNLESS OTHERWISE SPECIFIED

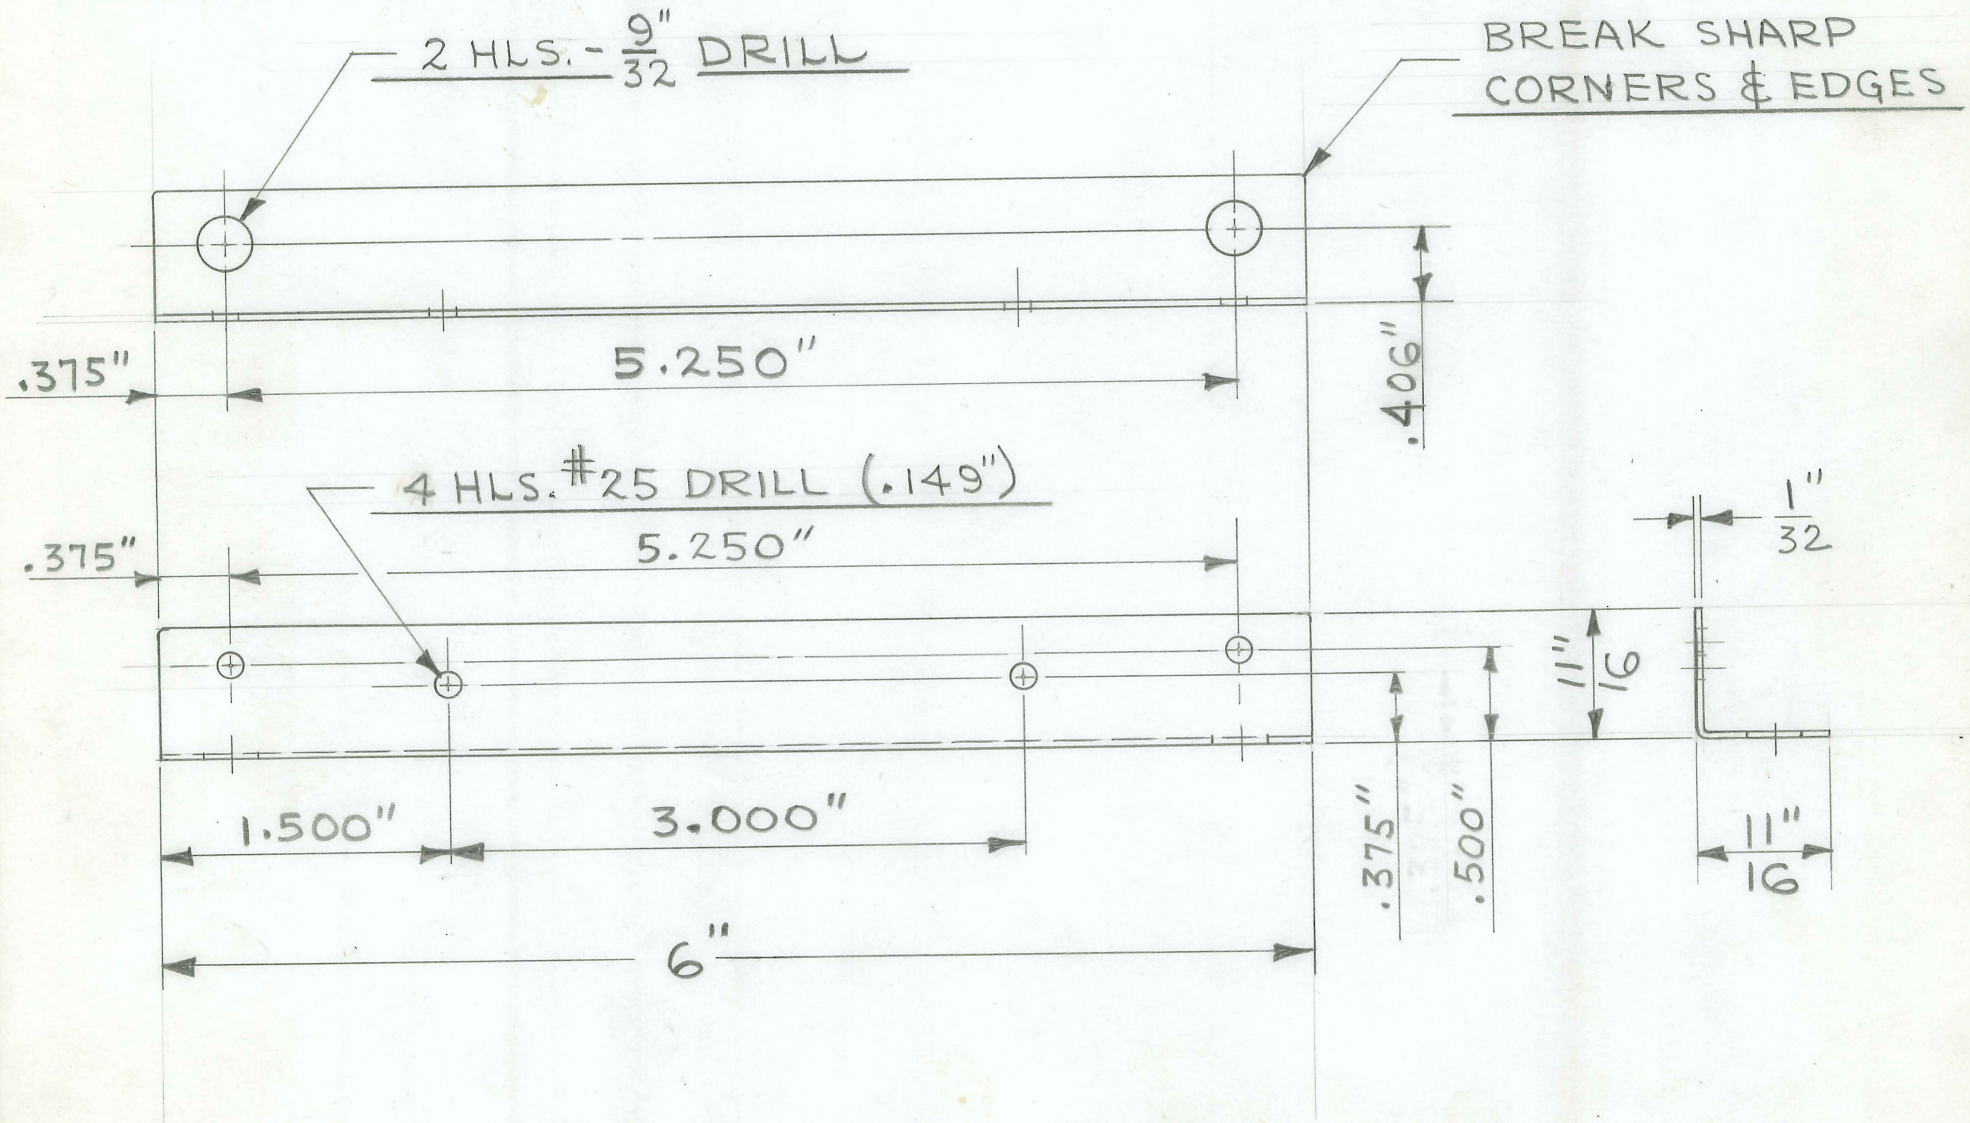

2 REQUIRED

TITLE
FISCHER "MP-30" X-RAY UNIT
CORD CLAMP BLOCK

H. G. FISCHER & CO.
FRANKLIN PARK, ILLINOIS

DATE 9-8-48 | DR. BY J.V.W. | CH'K'D.

PART NO. 17885B

REVISION		DATE	BY
A	WAS 7/8"	10-3-49	J.V.W.
B	" 4 HLS.	5-6-52	W.J.

PATTERN | FINISH | SCALE FULL

DIMENSIONS
FRACTIONAL ± .015
DECIMAL ± .005
ANGULAR ± ½°
UNLESS OTHERWISE SPECIFIED

TOOLS
DRILL JIG TOOL #9883
VISE JAWS #9899

MATERIAL
½" x ¾" ALUMINUM BAR (24ST)

BREAK SHARP CORNERS & EDGES

ROUND THESE EDGES APPROX. 1/16" R. BOTH SIDES

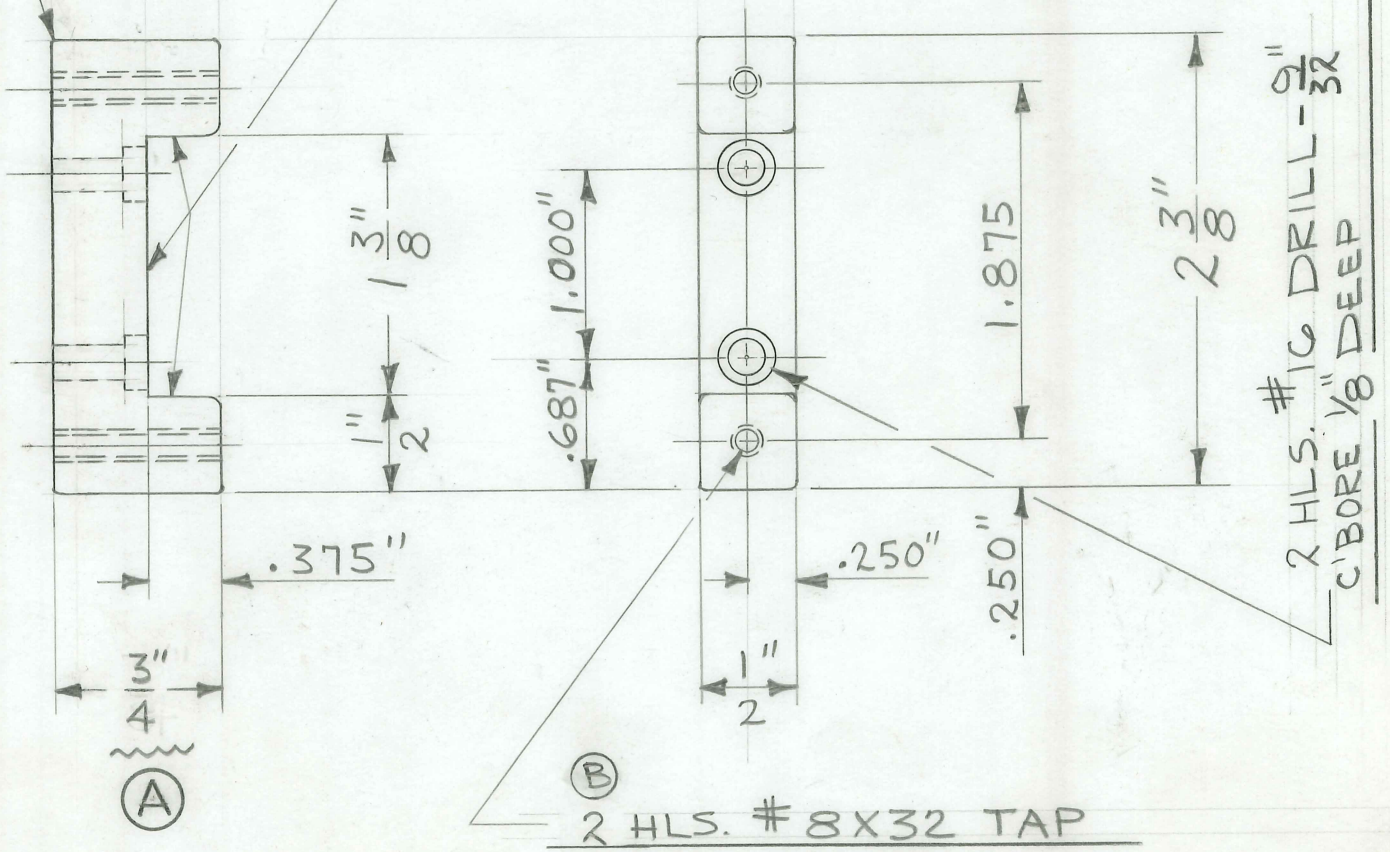

1 REQUIRED

TITLE FISCHER "MP-30" X-RAY UNIT
LINE & VOLTAGE CHANGE TERMINAL BOARD

H. G. FISCHER & CO.
FRANKLIN PARK, ILLINOIS

PART NO. 17886

DATE 9-13-49 | DR. BY J.V.W. | CH'K'D.

REVISION		DATE	BY
A	LETTERING & NUMBERING CHANGED	11-21-49	W.J.

PATTERN | FINISH | SCALE FULL

TOOLS | MATERIAL: BOUGHT OUTSIDE

DIMENSIONS UNLESS OTHERWISE SPECIFIED
FRACTIONAL ± .015
DECIMAL ± .005
ANGULAR ± ½°

1 REQUIRED

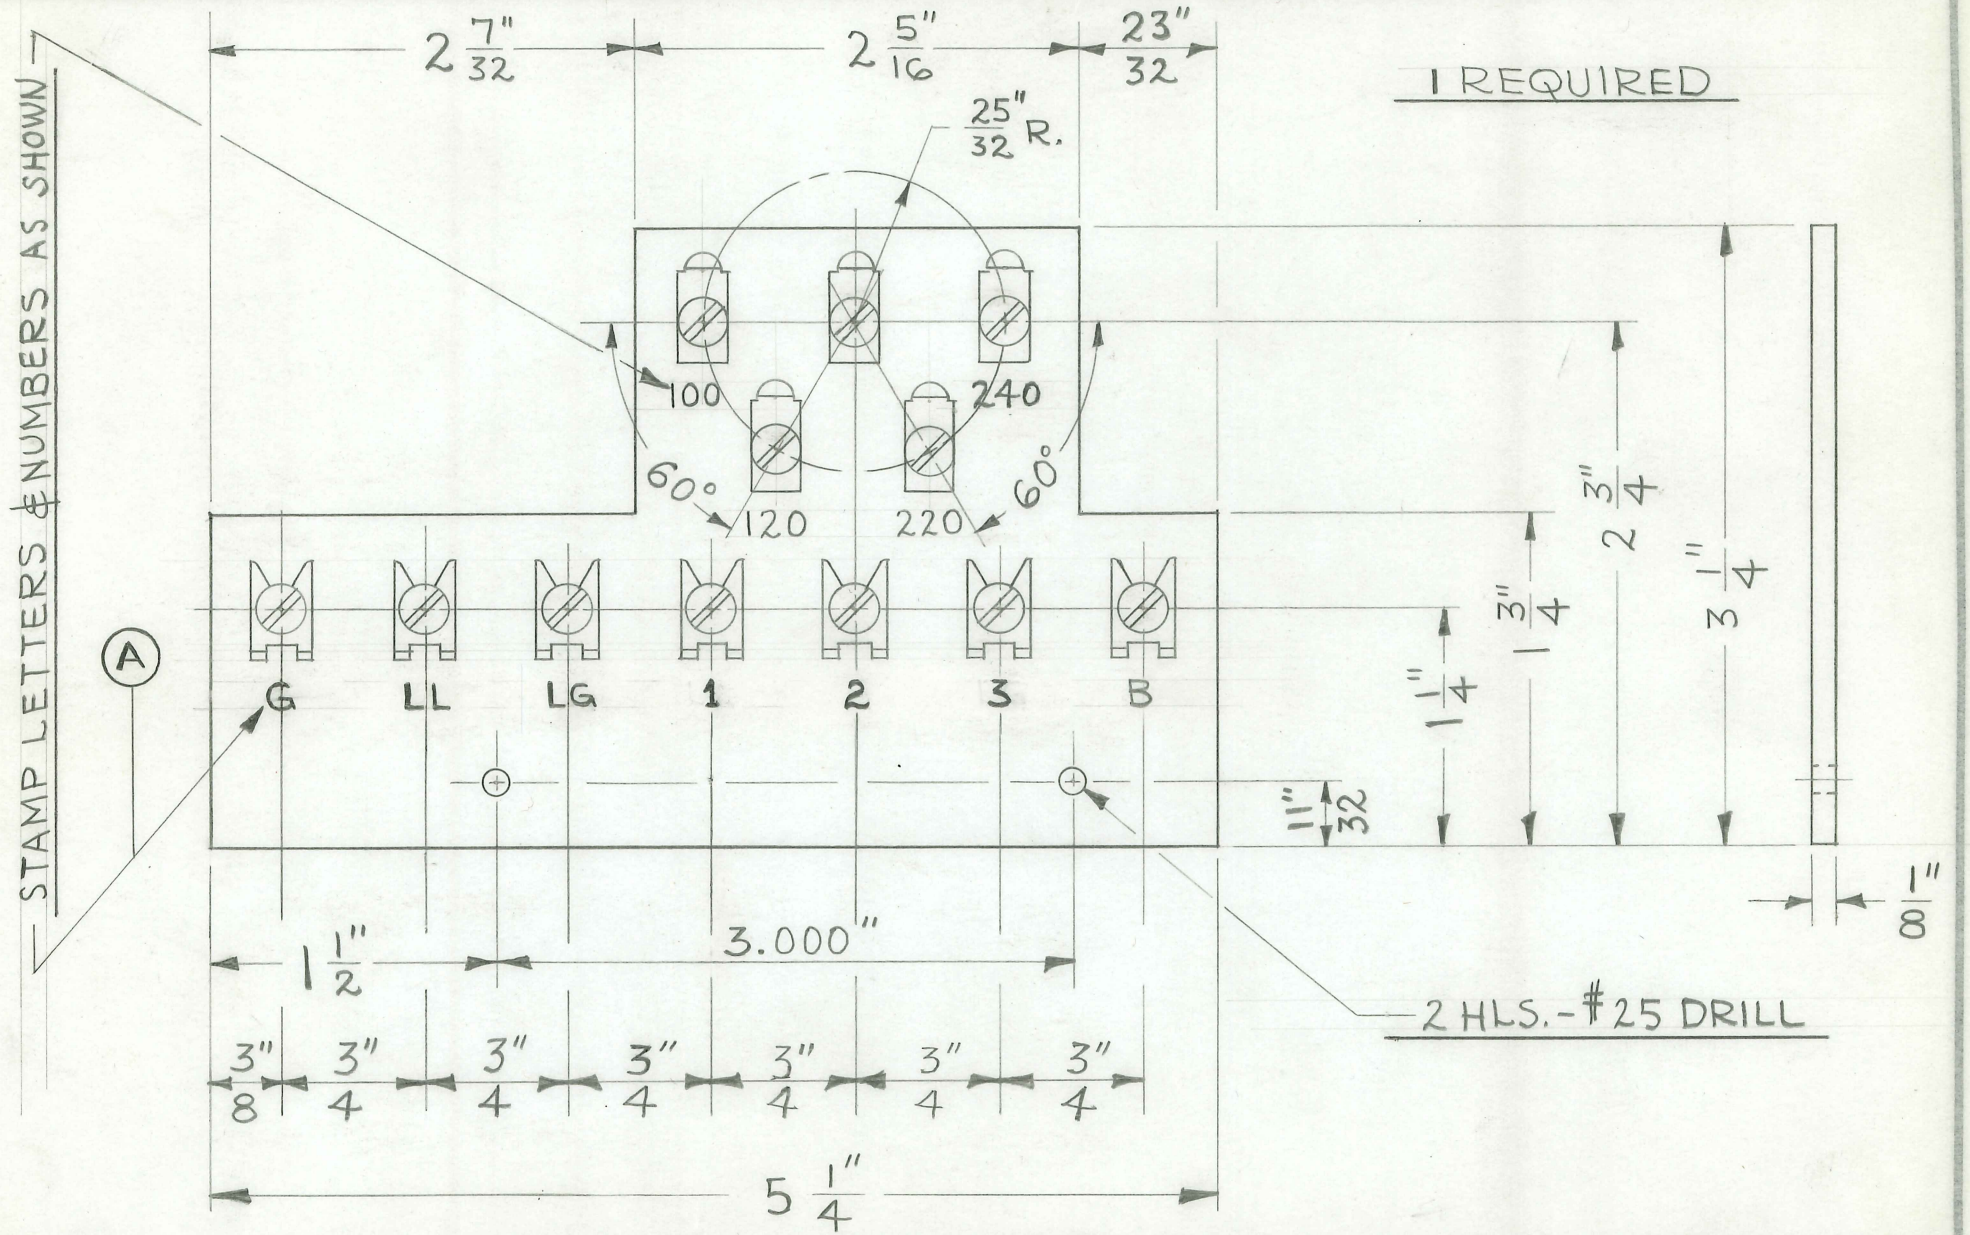

TITLE

COUNTERWEIGHT

PATTERN	FINISH	SCALE
↓	↓	

MATERIAL $1\frac{3}{4}$" DIA. C.R.S. ROD SPEC: 01-015

TOOLS ↓

H. G. FISCHER & CO.
FRANKLIN PARK, ILLINOIS

PART NO. 17903

DATE	DR. BY	CH'K'D.
11-2-66	B.K	RS

DIMENSIONS—UNLESS OTHERWISE SPECIFIED:

		THREAD CHAMFER
FRACTIONAL	± .015	UP TO 5/16 D. - 1/32 X 45°
DECIMAL	± .005	3/8 D. & OVER - 1/16 X 45°
ANGULAR	± 1/2°	

REMOVE ALL BURRS & SHARP CORNERS

USED ON	QTY.	USED ON	QTY.
17817G	1		

	REVISION	DATE	BY
	WAS $\frac{1}{4}$ R. x $\frac{7}{32}$ TYP. REQ. 986	4/18/69	SCD
1	ECO # 0388	1/29/75	TT

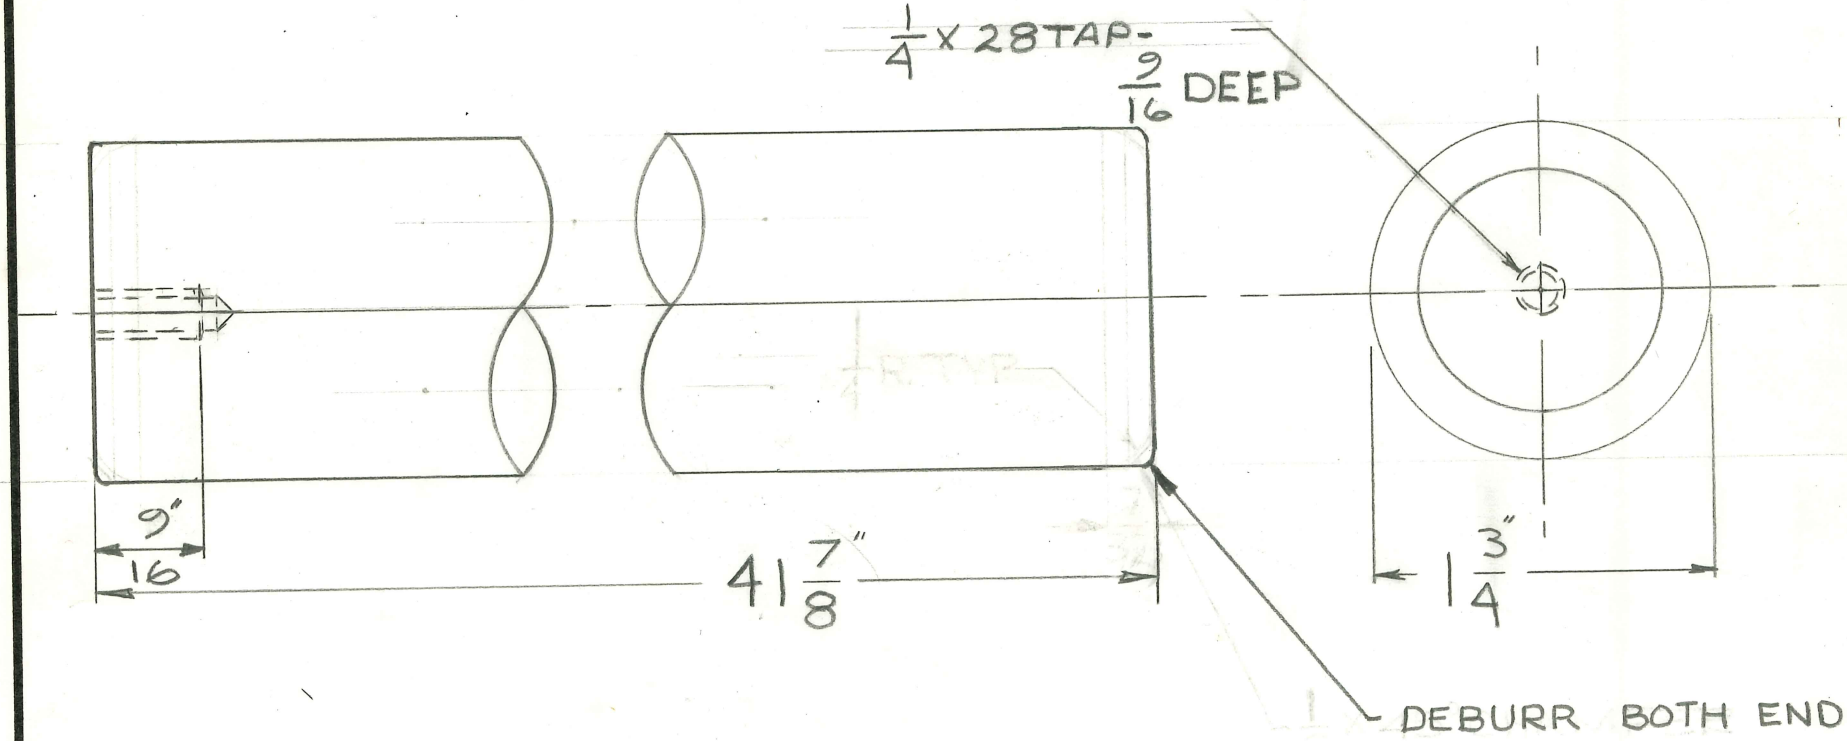

DO NOT SCALE DRAWING.

TITLE
FISCHER "TC-50" TRANS. & TUBE ASSEM.
X-RAY TUBE MTG. SUPPORT

H. G. FISCHER & CO.
FRANKLIN PARK, ILLINOIS

DATE 6-15-56 DR BY C.E.K. CH'K'D. J.V.W.

PART NO. 17904

REVISION	DATE	BY

PATTERN | FINISH | SCALE FULL

TOOLS | MATERIAL FROM #11311G

DIMENSIONS
FRACTIONAL ± .015
DECIMAL ± .005
ANGULAR ± ½°
UNLESS OTHERWISE SPECIFIED

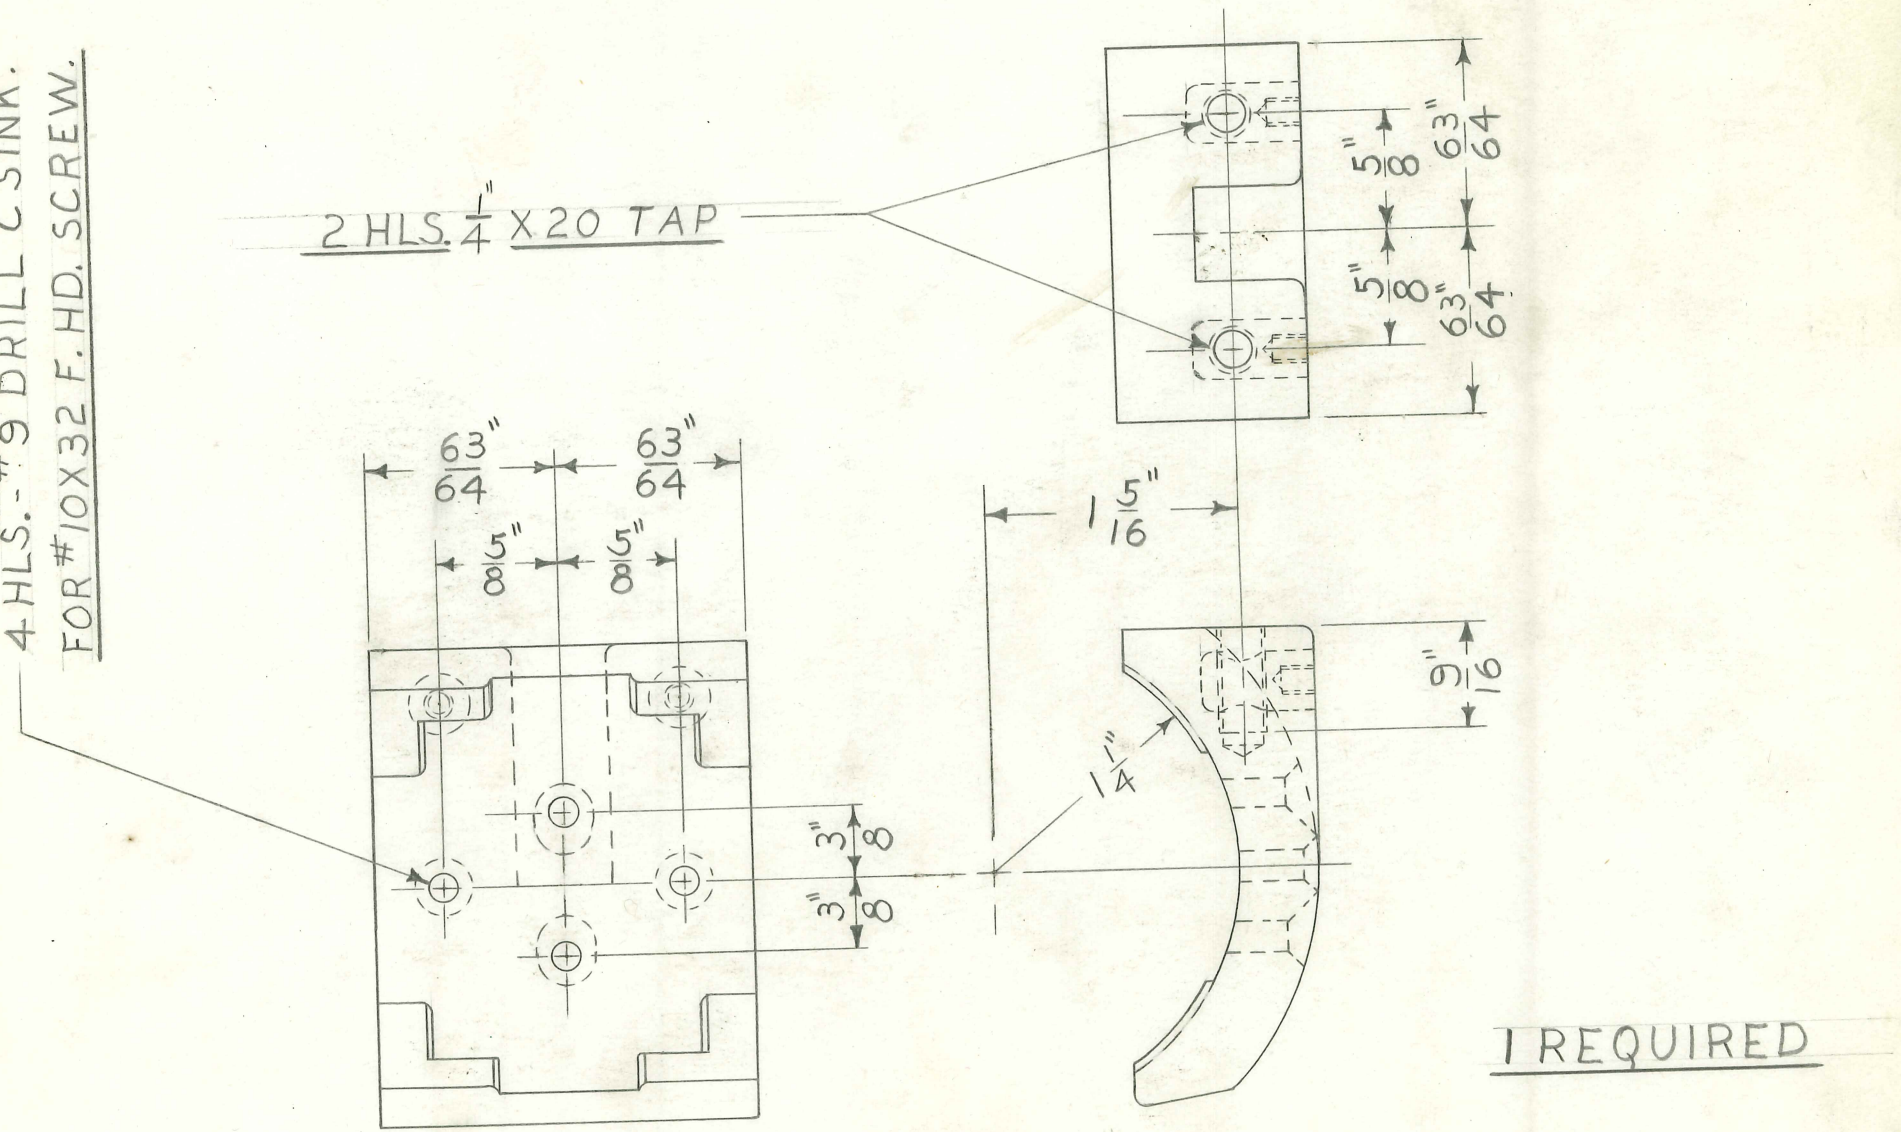

1 REQUIRED

FOLDER # 136

TITLE
DELUXE TILT TABLE
TABLE TOP FLAT HEAD NUT

H. G. FISCHER & CO.
FRANKLIN PARK, ILLINOIS

DATE 11-17-50 | DR. BY W.J. | CH'K'D. J.V.W.

PART NO. 17908

REVISION	DATE	BY

PATTERN | FINISH CAD. # 23 | SCALE 2" = 1"

TOOLS | MATERIAL 3/16" DIA. BRASS ROD

DIMENSIONS
FRACTIONAL ± .015
DECIMAL ± .005
ANGULAR ± ½°
UNLESS OTHERWISE SPECIFIED

8 REQUIRED

#8 X 32 TAP. C'SINK TO 3/16" FACE - THIS END

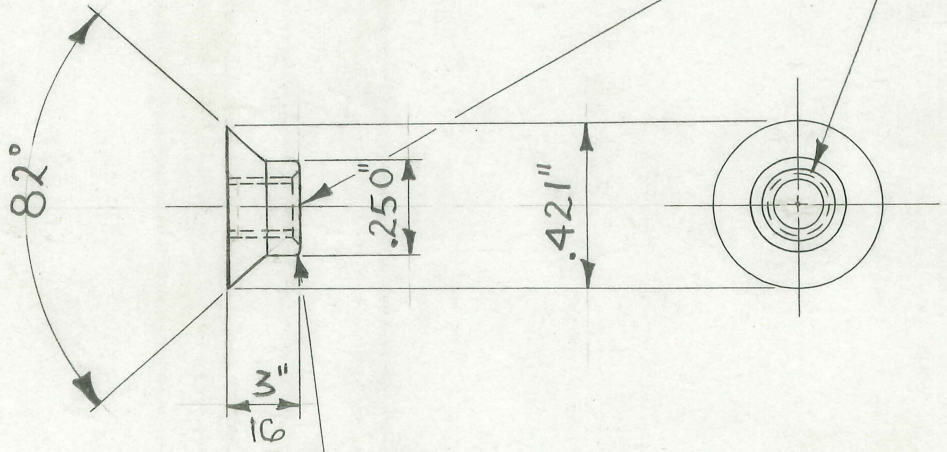

BREAK SHARP EDGES

TITLE FISCHER MOD. "T" X-RAY TRANSF. HEAD ANGLE INDICATOR

H. G. FISCHER & CO.
FRANKLIN PARK, ILLINOIS

DATE 3-7-52 | DR. BY J.V.W. | CH'K'D. RCT

PART NO. 17922C

REVISION		DATE	BY
A	WAS BRASS	1-21-54	J.V.W.
B1	WAS ALUM.	11-65	RCT
B2	WAS # 30		
C1	WAS 3/16	11/27/67	SCD
C2	WAS 7/16		
C3	WAS 3/16		
C4	WAS .120 SEE BULL. 413		

PATTERN | FINISH #102 (B2) | SCALE FULL

DIMENSIONS
FRACTIONAL ± .015
DECIMAL ± .005
ANGULAR ± ½°
UNLESS OTHERWISE SPECIFIED

TOOLS "V" DIE # 6336-01
BLANK & PIERCE # 11683

MATERIAL
#20 GA. (.035) SHEET C.R. STL.

CUT STOCK 1 1/8" WIDE

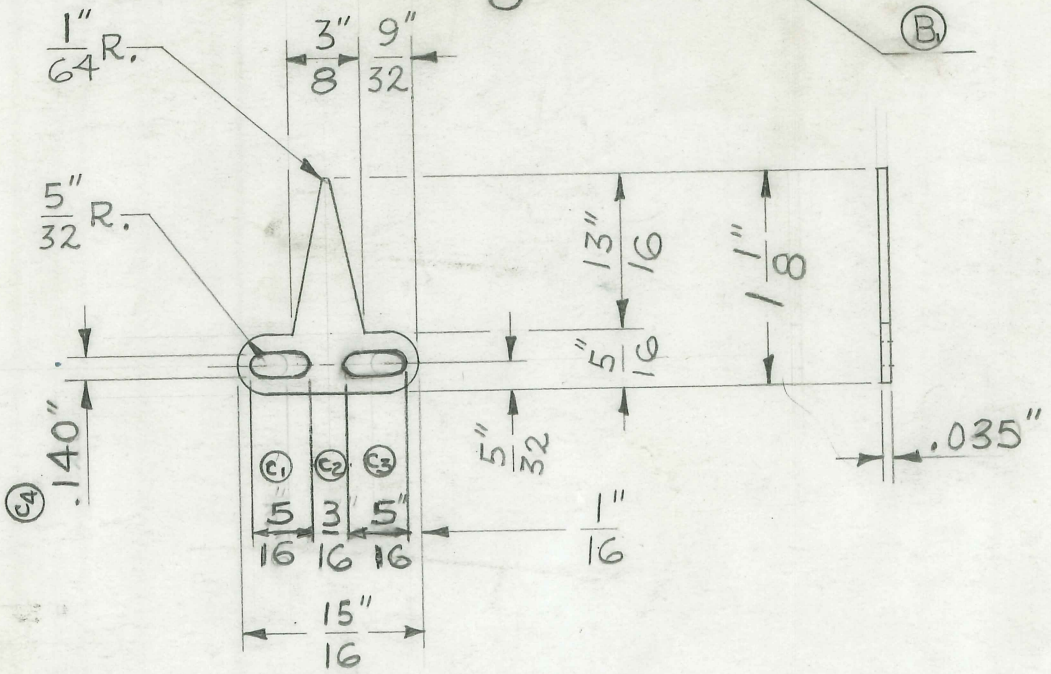

GRAIN TO RUN IN THIS DIRECTION

BLANK

FINISH NOTE:
POLISH THESE 2 FACES ONLY

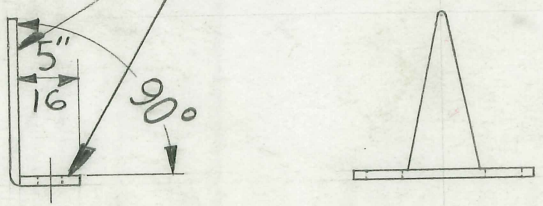

FOLDER #136

TITLE DELUXE RF-100 X-RAY
HORIZ. SLIDE INNER TUBE SHIPPING STOP

H. G. FISCHER & CO.
FRANKLIN PARK, ILLINOIS

PART NO. 17931

DATE 6-28-51 | DR. BY W.J. | CH'K'D J.V.W.

REVISION	DATE	BY

PATTERN | FINISH | SCALE FULL

DIMENSIONS
FRACTIONAL ± .015
DECIMAL ± .005
ANGULAR ± ½°
UNLESS OTHERWISE SPECIFIED

TOOLS NEST PCE#
CUT OFF DIE #3045 G3

MATERIAL 1/8" X 5/8" FLAT WIRE

21/64" DIE INSERT & PUNCH #11592 TO BE USED WITH MASTER DIE BLOCK #9938

1 REQUIRED

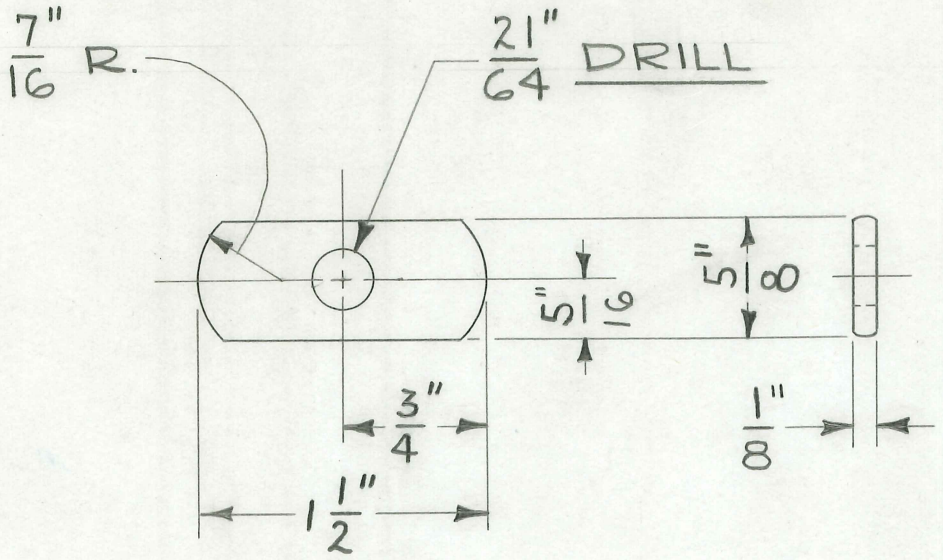

FOLDER #127

TITLE ELECTRONIC CERVICAL FULL SPINE BLOCKER – MASK ARM BUSHING

H. G. FISCHER & CO.
FRANKLIN PARK, ILLINOIS

PART NO. 17932

DATE 4-25-51 | DR. BY J.N.W. | CH'K'D.

REVISION	DATE	BY

PATTERN | FINISH | SCALE FULL

TOOLS | MATERIAL $\frac{5}{16}$" DIA. C.R. STEEL

DIMENSIONS
FRACTIONAL ± .015
DECIMAL ± .005
ANGULAR ± ½°
UNLESS OTHERWISE SPECIFIED

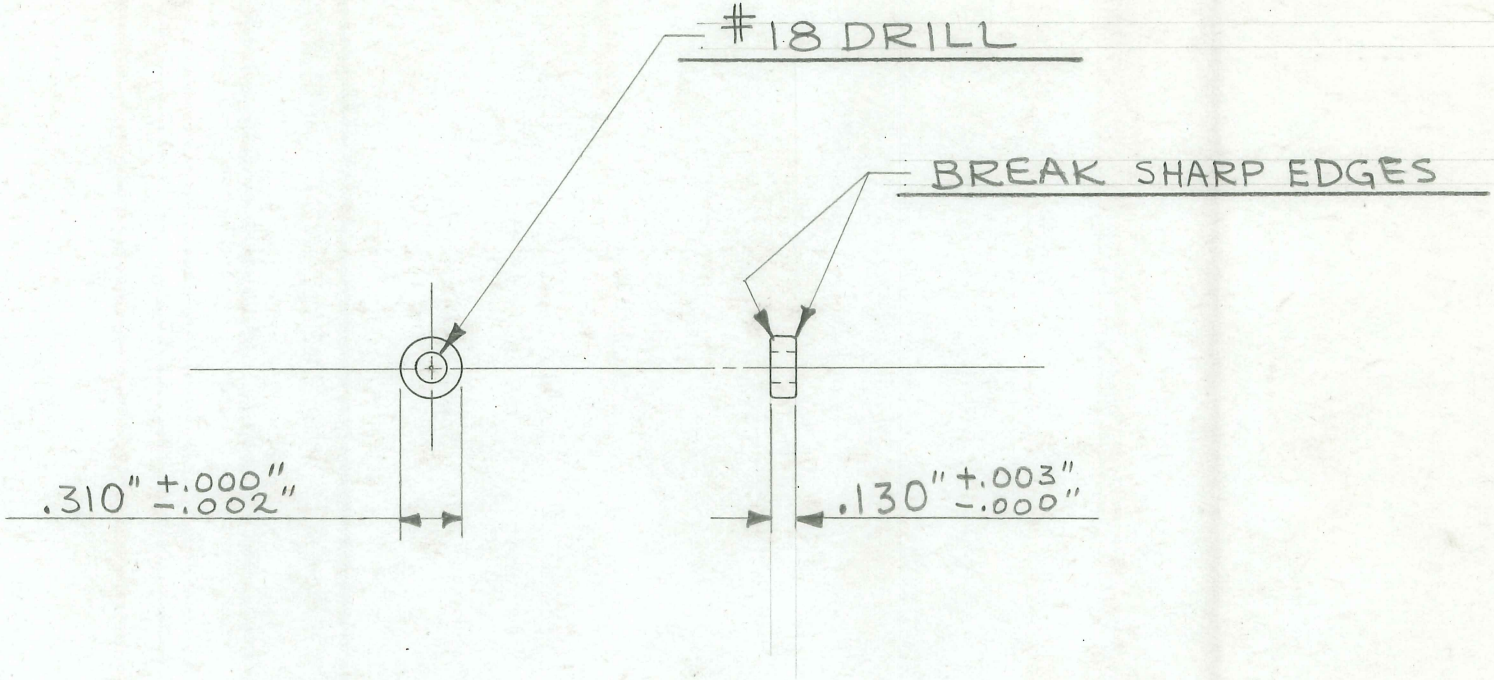

1 REQUIRED

FOLDER #130

TITLE ELECTRONIC CERVICAL FULL SPINE BLOCKER-MASK ARM POST

H. G. FISCHER & CO.
FRANKLIN PARK, ILLINOIS

PART NO. 17933

REVISION	DATE	BY

DATE 4-24-51 | DR. BY J.V.W. | CH'K'D.

PATTERN | FINISH | SCALE FULL

TOOLS | MATERIAL $\frac{3}{8}$" DIA. BRASS ROD

DIMENSIONS UNLESS OTHERWISE SPECIFIED
FRACTIONAL ± .015
DECIMAL ± .005
ANGULAR ± ½°

BREAK ALL SHARP EDGES

#8X32 TAP - $\frac{9}{32}$" DEEP
C'BORE. WITH #18 DRILL - $\frac{1}{16}$" DEEP

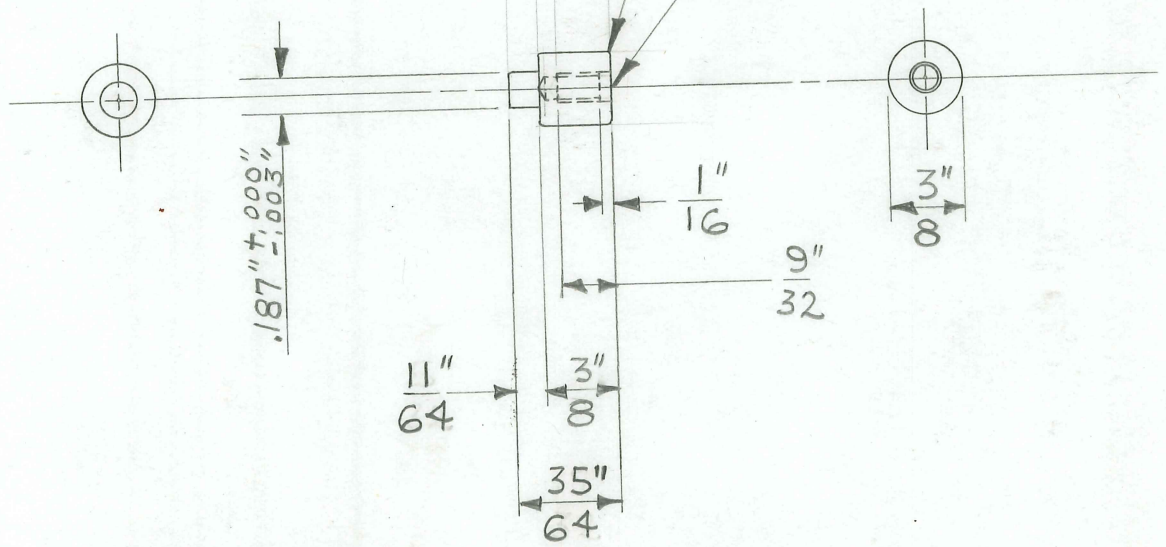

1 REQUIRED

FOLDER #130

TITLE ELECTRONIC CERVICAL FULL SPINE BLOCKER — SOLENOID LINK

H. G. FISCHER & CO.
FRANKLIN PARK, ILLINOIS

PART NO. 17934

DATE 4-24-51 | DR. BY J.V.W. | CH'K'D.

REVISION	DATE	BY

PATTERN | FINISH CAD. #23 | SCALE FULL

DIMENSIONS
FRACTIONAL ± .015
DECIMAL ± .005
ANGULAR ± ½°
UNLESS OTHERWISE SPECIFIED

TOOLS CUT-OFF DIE #708 bin 0-3
BENDING FIX. # 11559

MATERIAL $\frac{1}{16}$" x $\frac{1}{2}$" C.R. STEEL FLAT WIRE

DRILL JIG # 11560

CUT LENGTH TO GAGE LOCATED ON DRILL JIG

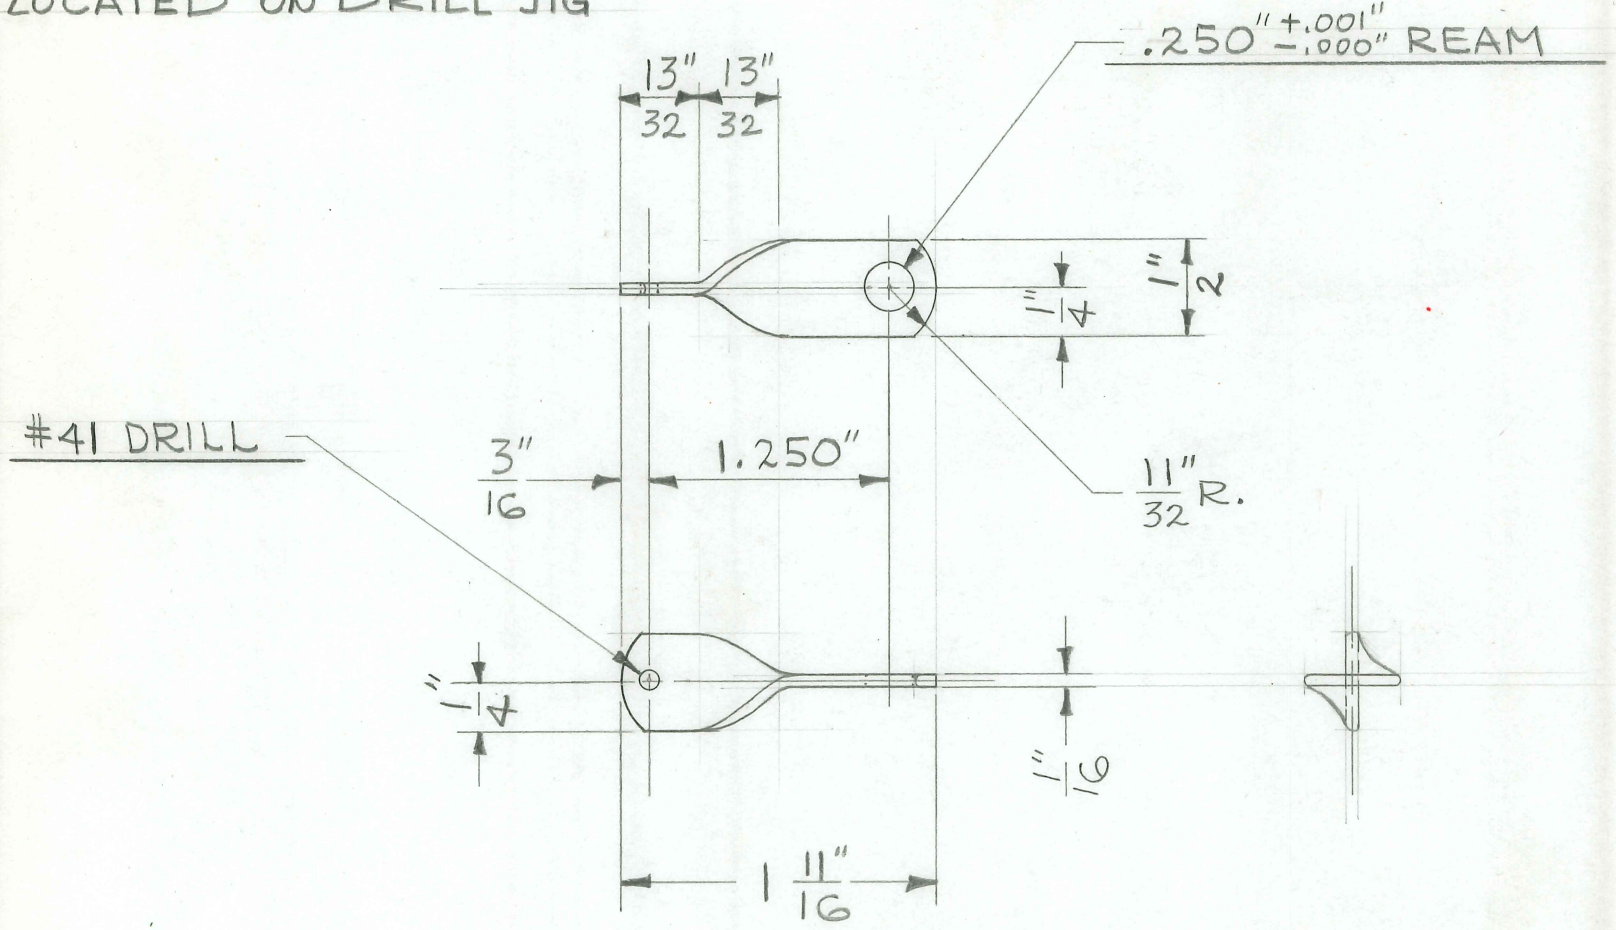

1 REQUIRED

FOLDER #130

TITLE ELECTRONIC CERVICAL FULL SPINE BLOCKER - MASK ARM

H. G. FISCHER & CO.
FRANKLIN PARK, ILLINOIS

DATE 4-25-51 | DR. BY J.V.W. | CH'K'D.

PART NO. 17938

REVISION	DATE	BY

PATTERN | FINISH CAD. #23 | SCALE FULL

TOOLS CUT-OFF DIE #708 bin 0-3
DRILL JIG # 11561

MATERIAL $\frac{1}{8}$" x $\frac{1}{2}$" C.R. STEEL FLAT WIRE

DIMENSIONS
FRACTIONAL ± .015
DECIMAL ± .005
ANGULAR ± ½°
UNLESS OTHERWISE SPECIFIED

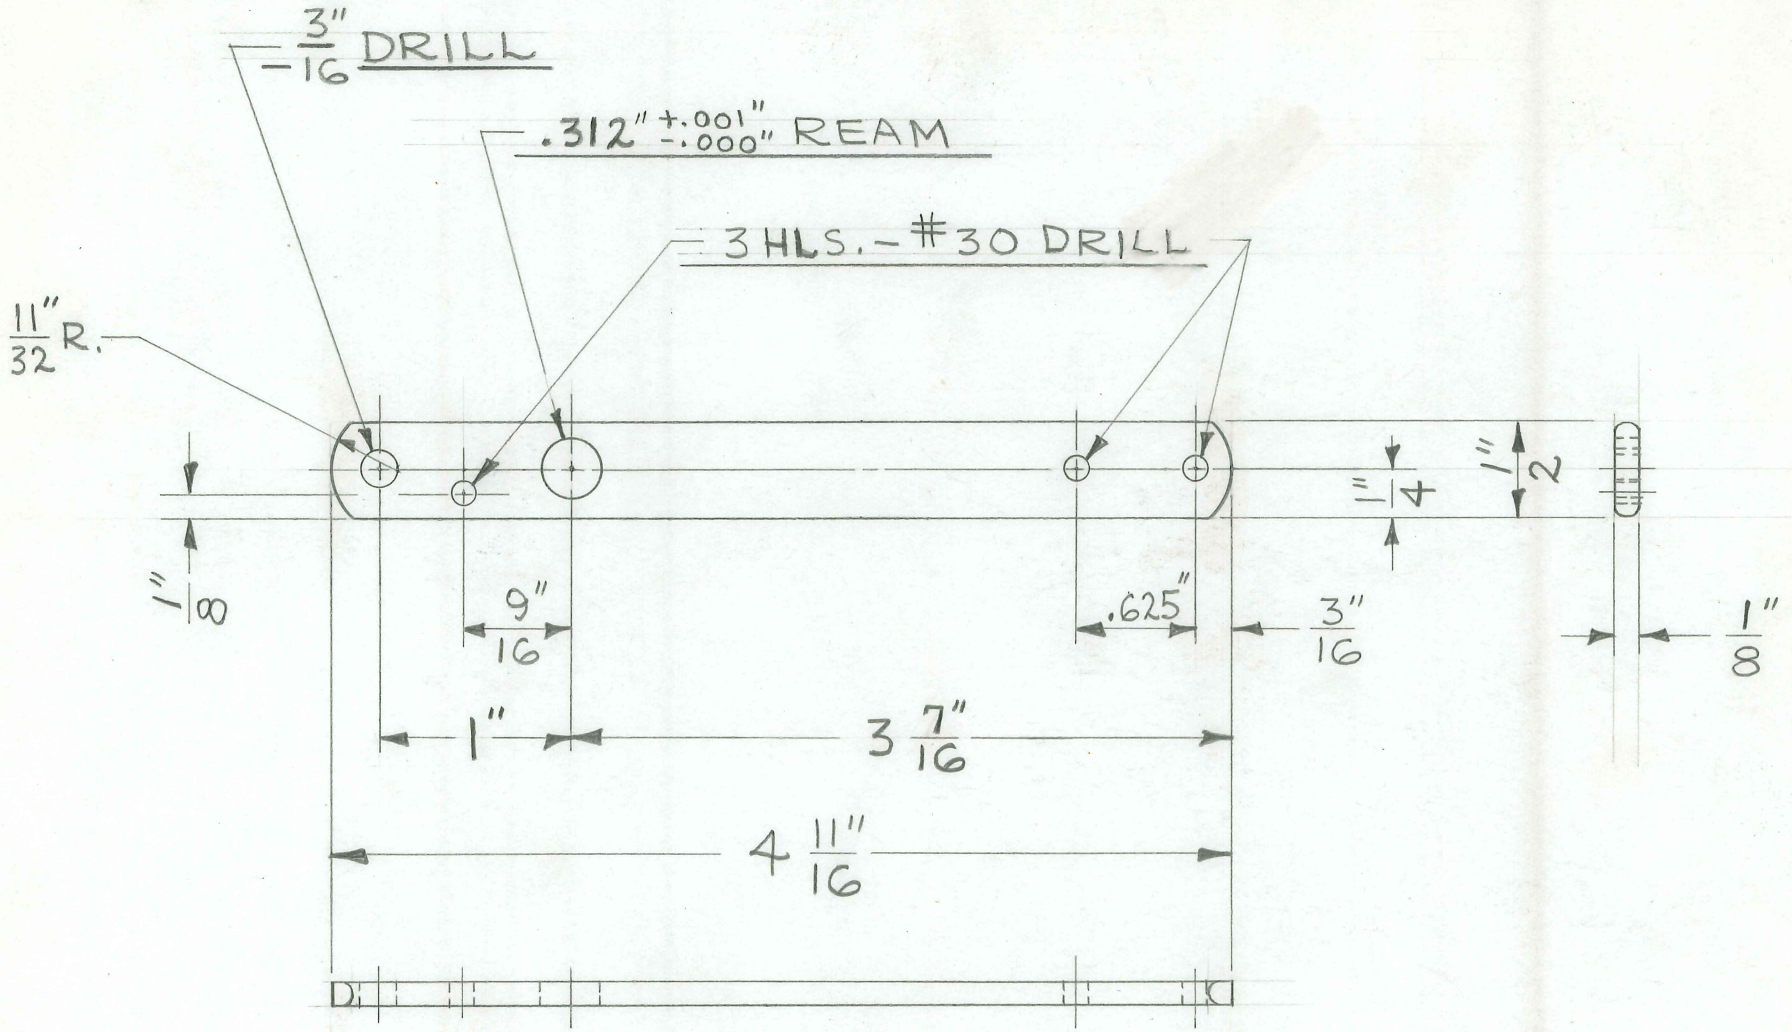

1 REQUIRED

FOLDER #130

TITLE ELECTRONIC CERVICAL FULL SPINE BLOCKER – MASK

H. G. FISCHER & CO.
FRANKLIN PARK, ILLINOIS

PART NO. 17939

DATE 4-25-51 | DR. BY J.V.W. | CH'K'D.

REVISION	DATE	BY

PATTERN | FINISH | SCALE FULL

TOOLS
RECTANGULAR DIE #9204
NEST PCE. #17939

MATERIAL
$\frac{1}{8}$" X 1" BRASS BAR

DIMENSIONS
FRACTIONAL ± .015
DECIMAL ± .005
ANGULAR ± ½°
UNLESS OTHERWISE SPECIFIED

DRILL JIG # 11562

FILE APPROX. $\frac{1}{16}$" RADIUS ON TOP AND BOTTOM EDGES OF PORTION INSIDE TWO ARROWS.
BREAK ALL OTHER SHARP EDGES & CORNERS.

2 HLS. – #30 DRILL C'SUNK. TO $\frac{17}{64}$" FACE

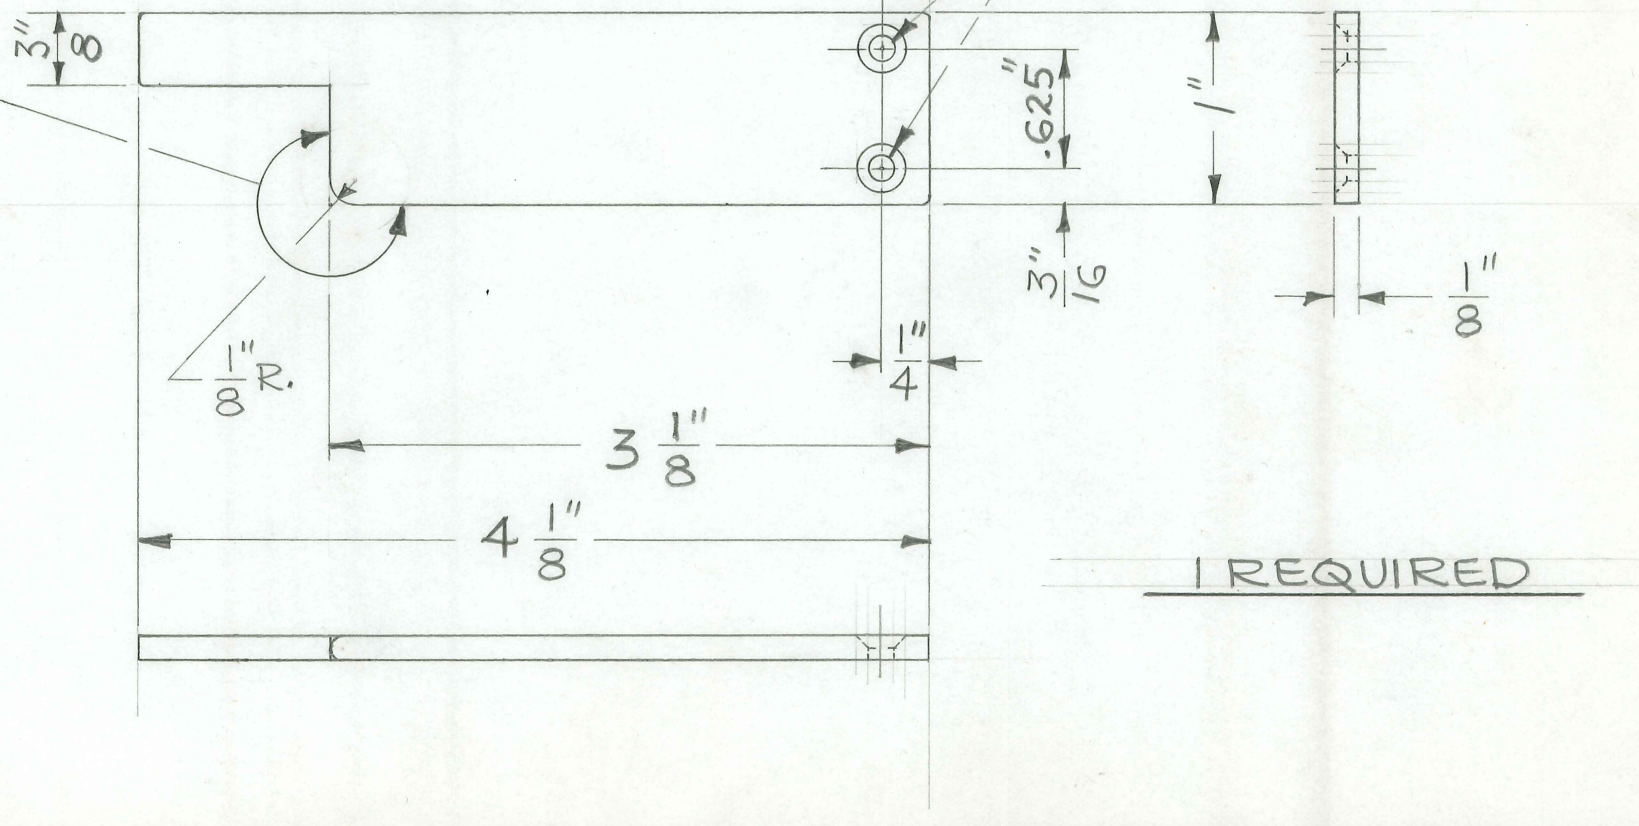

1 REQUIRED

FOLDER # 130

TITLE ELECTRONIC CERVICAL FULL SPINE BLOCKER – MASK & ARM ASSEMBLY

H. G. FISCHER & CO.
FRANKLIN PARK, ILLINOIS

PART NO. 17940G

DATE 4-25-51 | DR. BY J.V.W. | CH'K'D.

REVISION	DATE	BY

PATTERN | FINISH | SCALE FULL

TOOLS

MATERIAL 2-#13757 1-#17938-23
1-#17933 1-#17939

DIMENSIONS
FRACTIONAL ± .015
DECIMAL ± .005
ANGULAR ± ½°
UNLESS OTHERWISE SPECIFIED

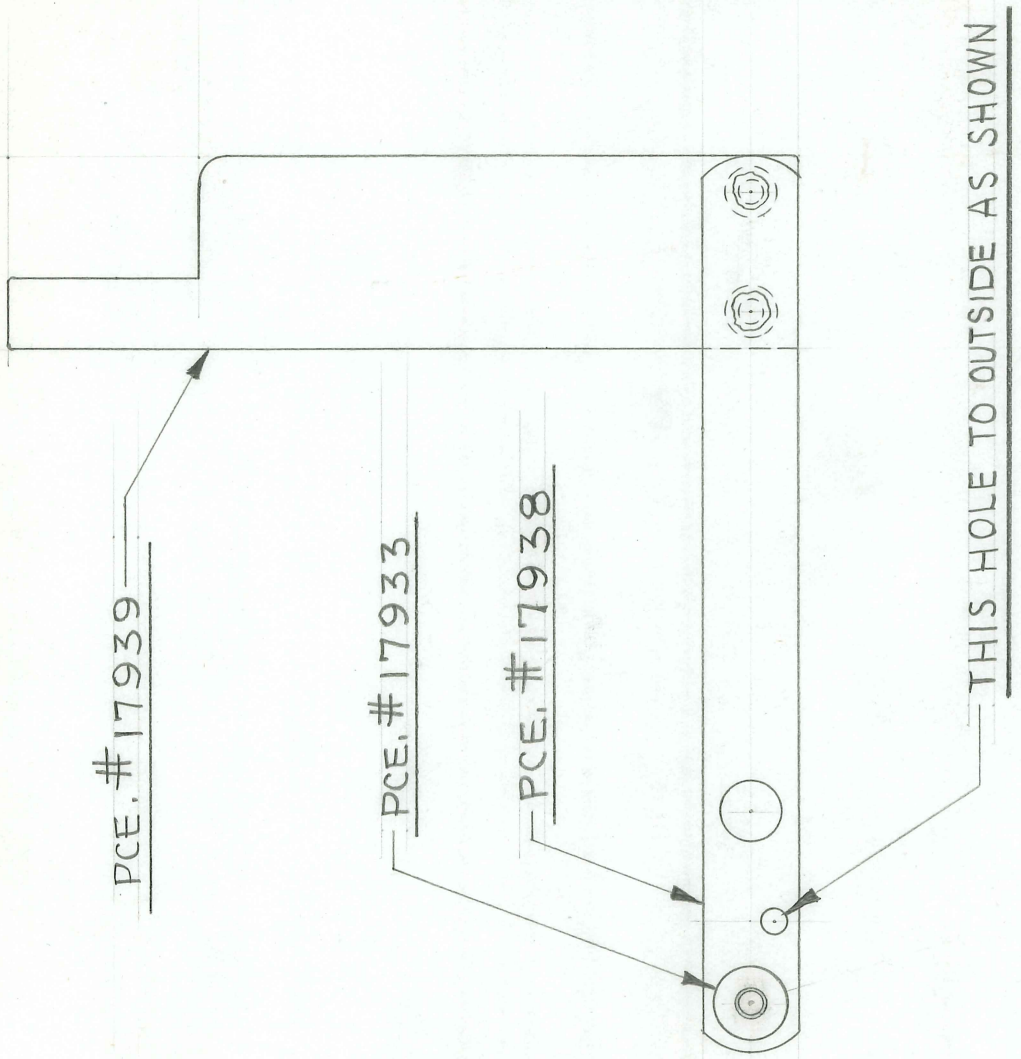

1 REQUIRED

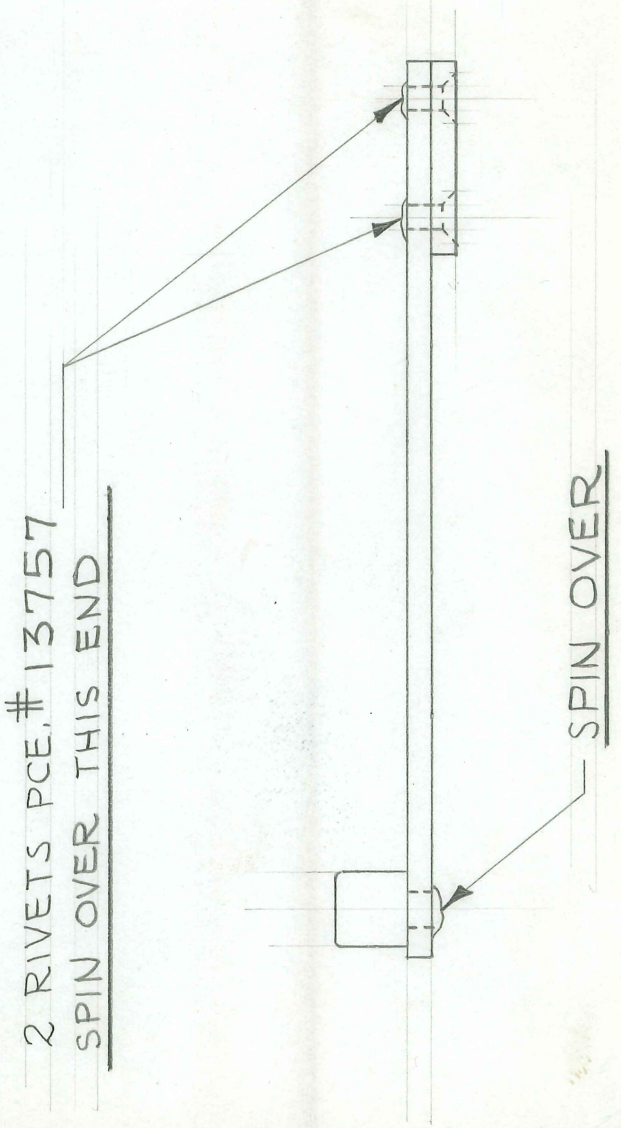

FOLDER #130

TITLE: ELECTRONIC CERVICAL FULL SPINE BLOCKER - MASK SLIDE STRIP	H. G. FISCHER & CO. FRANKLIN PARK, ILLINOIS		PART NO. 17941
	DATE 4-25-51	DR. BY J.V.W.	CH'K'D.
PATTERN	FINISH CAD. #23	SCALE FULL	DIMENSIONS: FRACTIONAL ± .015; DECIMAL ± .005; ANGULAR ± ½°; UNLESS OTHERWISE SPECIFIED
TOOLS: CUT-OFF & PIERCE DIE #7693 bin Q-4	MATERIAL: 1/16" x 3/8" C.R. STEEL FLAT WIRE		

REVISION	DATE	BY

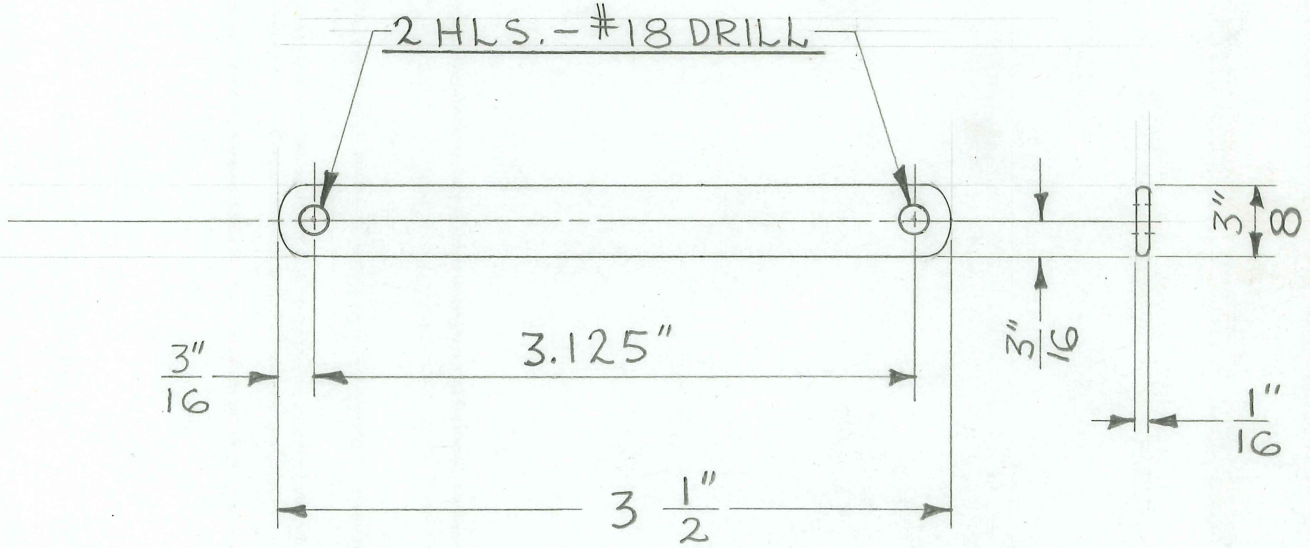

2 REQUIRED

FOLDER #130

TITLE
ELECTRONIC CERVICAL FULL SPINE BLOCKER— SOLENOID SILENCER

H. G. FISCHER & CO.
FRANKLIN PARK, ILLINOIS

PART NO. 17942

DATE 4-24-51 | DR. BY J.V.W. | CH'K'D.

REVISION	DATE	BY

PATTERN | FINISH CAD. #23 | SCALE FULL

TOOLS: RECTANGULAR DIE #11563

MATERIAL: $\frac{1}{16}$" X $\frac{7}{8}$" SHEARED C.R. STEEL

DIMENSIONS UNLESS OTHERWISE SPECIFIED
FRACTIONAL ± .015
DECIMAL ± .005
ANGULAR ± ½°

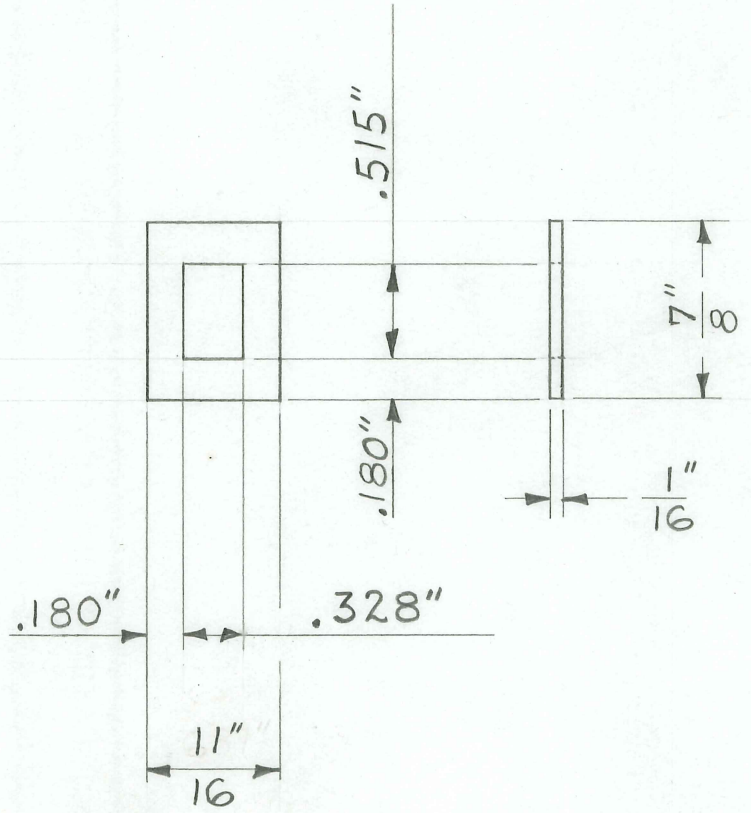

1 REQUIRED

FOLDER #130

TITLE ELECTRONIC CERVICAL FULL SPINE BLOCKER - SOLENOID CLAMP STRIP

H. G. FISCHER & CO.
FRANKLIN PARK, ILLINOIS

DATE 4-25-51 | DR. BY J.N.W. | CH'K'D.

PART NO. 17943

REVISION	DATE	BY

PATTERN | FINISH | SCALE FULL

TOOLS: DRILL JIG # 11564

MATERIAL: $\frac{1}{8}$" X $\frac{1}{4}$" C.R. STEEL BAR

DIMENSIONS UNLESS OTHERWISE SPECIFIED
FRACTIONAL ± .015
DECIMAL ± .005
ANGULAR ± ½°

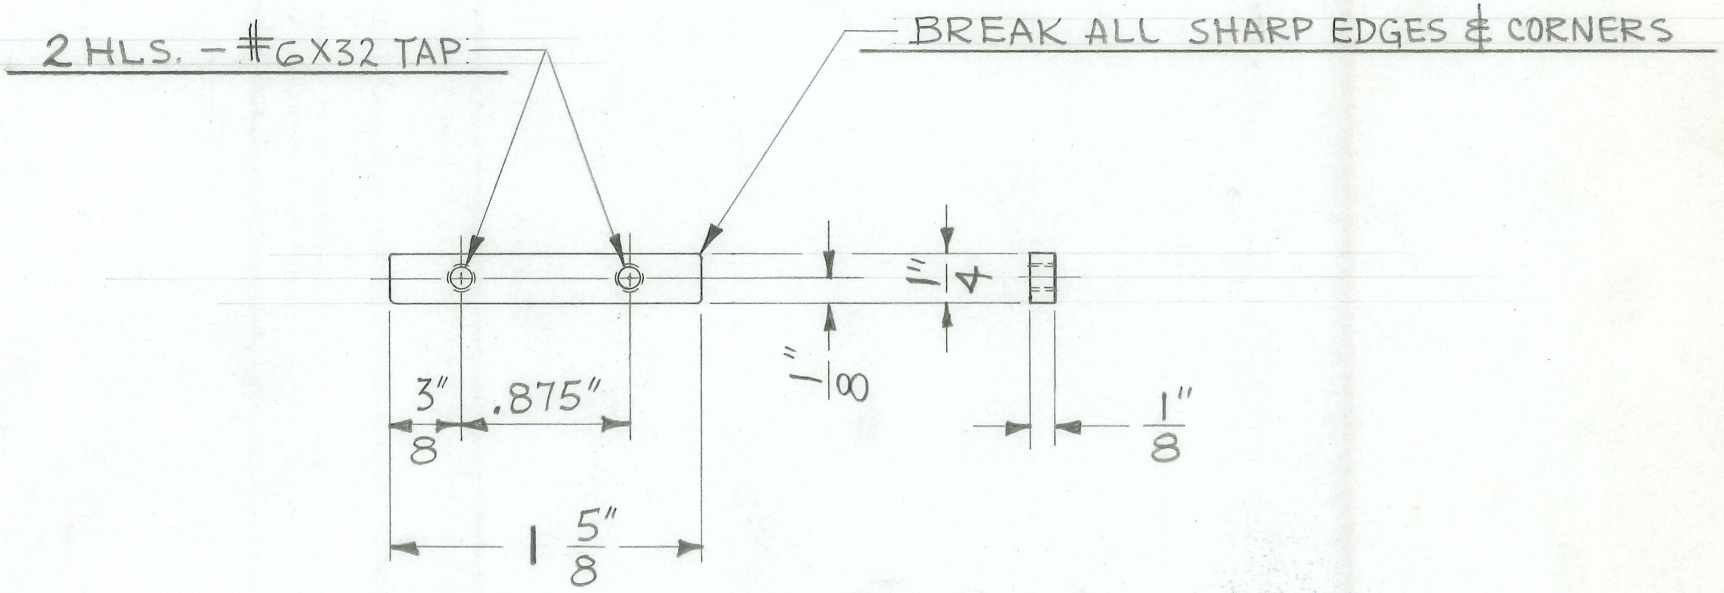

2 REQUIRED

FOLDER #130

TITLE ELECTRONIC CERVICAL FULL SPINE BLOCKER-MASK SLIDE STRIP SPACER

H. G. FISCHER & CO.
FRANKLIN PARK, ILLINOIS

PART NO. 17946

DATE 4-25-51 | DR. BY J.V.W. | CH'K'D.

REVISION	DATE	BY

PATTERN | FINISH | SCALE FULL

TOOLS | MATERIAL 3/8" DIA. BRASS ROD

DIMENSIONS
FRACTIONAL ±.015
DECIMAL ±.005
ANGULAR ± ½°
UNLESS OTHERWISE SPECIFIED

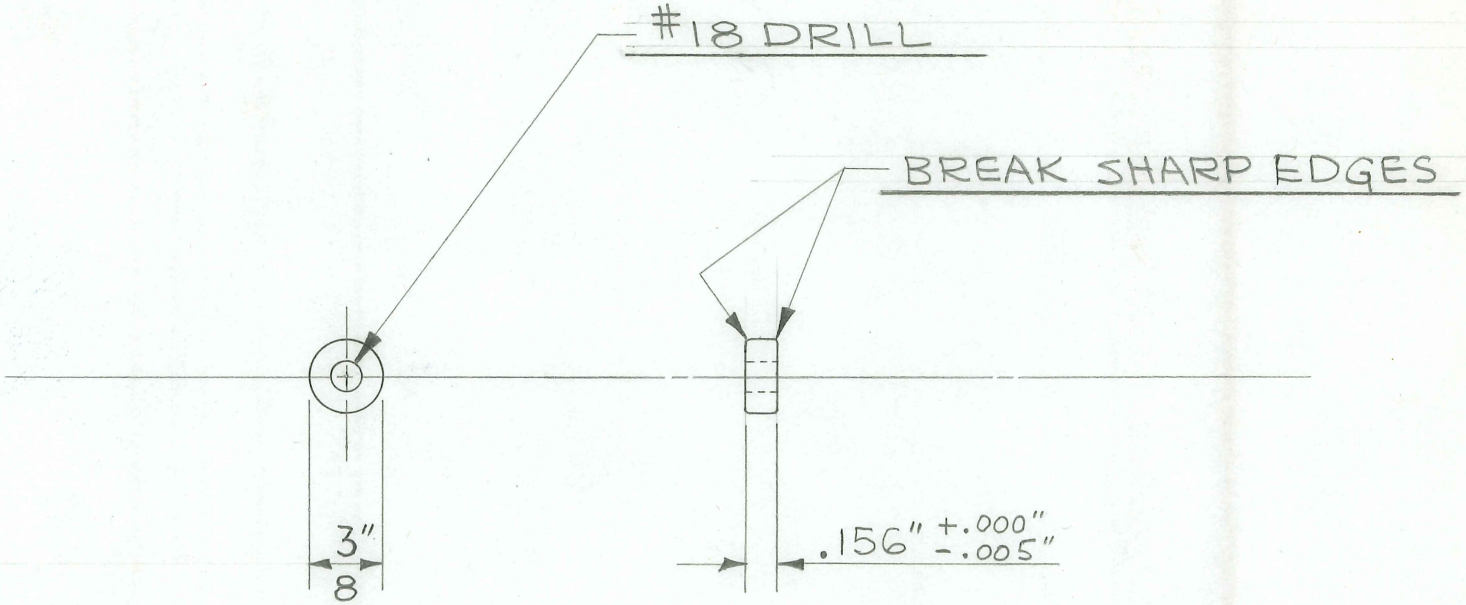

2 REQUIRED

FOLDER #130

TITLE ELECTRONIC CERVICAL FULL SPINE BLOCKER SOLENOID LINK SPACER

H. G. FISCHER & CO.
FRANKLIN PARK, ILLINOIS

PART NO. 17947

DATE 4-24-51 DR. BY J.V.W. CH'K'D.

REVISION	DATE	BY

PATTERN | FINISH | SCALE FULL

TOOLS | MATERIAL 5/16" DIA. BRASS ROD

DIMENSIONS
FRACTIONAL ± .015
DECIMAL ± .005
ANGULAR ± ½°
UNLESS OTHERWISE SPECIFIED

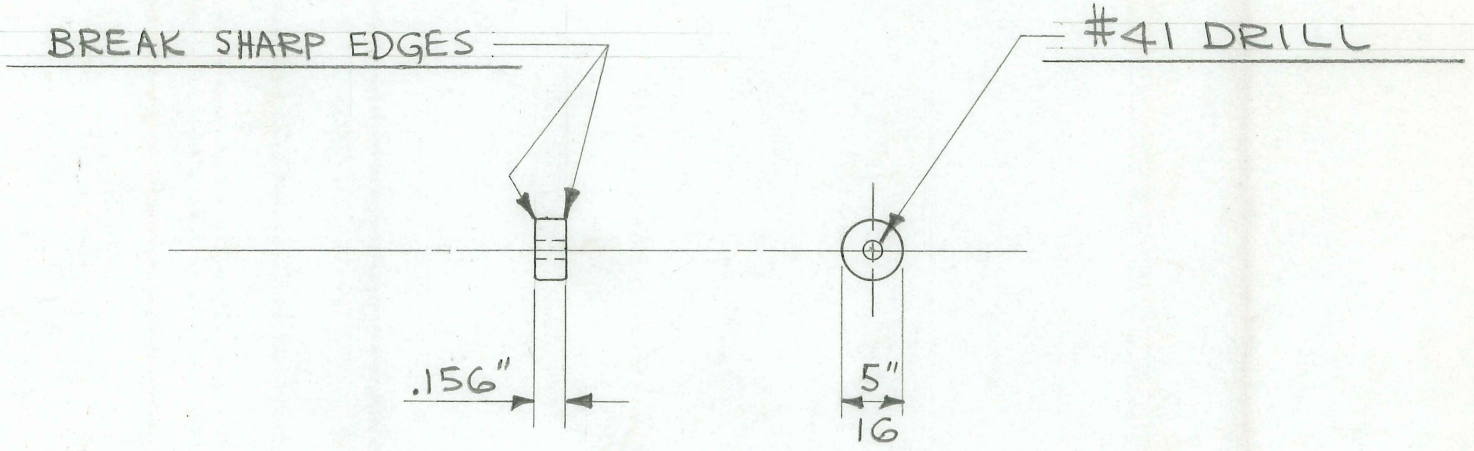

2 REQUIRED

FOLDER #130

TITLE

BUSHING FOR S17992
BALL BEARING ROLLER

H. G. FISCHER & CO.
FRANKLIN PARK, ILLINOIS

DATE 6-13-51 | DR. BY W.J. | CH'K'D. J.V.W.

PART NO. 17948

REVISION	DATE	BY

PATTERN | FINISH | SCALE FULL

TOOLS | MATERIAL 3/8 DIA. BRASS ROD

DIMENSIONS
FRACTIONAL ± .015
DECIMAL ± .005
ANGULAR ± ½°
UNLESS OTHERWISE SPECIFIED

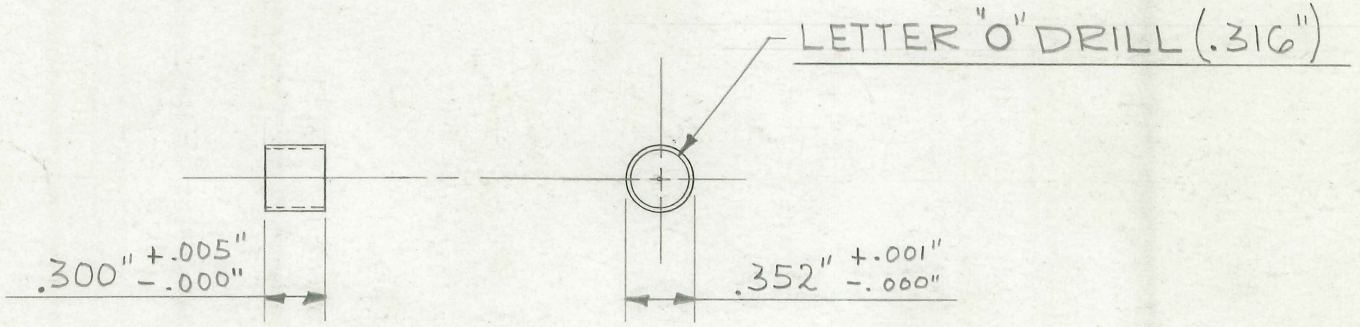

FOLDER #127

TITLE $1\frac{1}{8}$" BEARING AND BUSHING WITH $\frac{5}{16}$" HOLE

H. G. FISCHER & CO.
FRANKLIN PARK, ILLINOIS

PART NO. 17949

DATE 3-19-51 | DR. BY J.V.W. | CH'K'D.

REVISION	DATE	BY

PATTERN | FINISH | SCALE FULL

TOOLS | MATERIAL $\frac{1}{2}$" DIA. JEWELERS ROD

DIMENSIONS
FRACTIONAL ± .015
DECIMAL ± .005
ANGULAR ± ½°
UNLESS OTHERWISE SPECIFIED

BREAK ALL SHARP EDGES

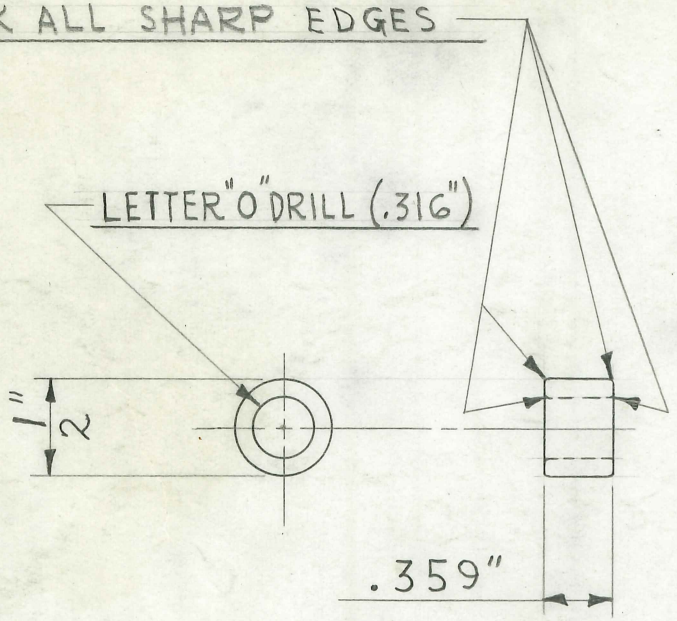

1 REQ. FOR EACH BEARING

PCE.# 17926

PRESS BUSHING INTO BEARING IN ARBOR PRESS.

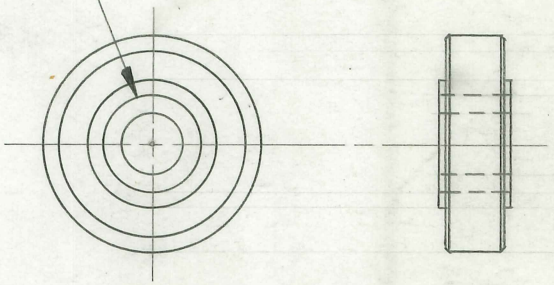

L.C. SMITH
K8A SKF } BEARING

FOLDER #127

TITLE

TC 50 ON DELUXE STAND
ANGLE INDICATOR PLATE

H. G. FISCHER & CO.
FRANKLIN PARK, ILLINOIS

DATE	DR. BY	CH'K'D.
3-7-50	W.J.	J.V.W.

PART NO. 17951A

PATTERN	FINISH	SCALE
	SEE NOTE	FULL

TOOLS

MATERIAL: 20 GA. (.032") SHEET BRASS

DIMENSIONS UNLESS OTHERWISE SPECIFIED

FRACTIONAL	± .015
DECIMAL	± .005
ANGULAR	± ½°

REVISION		DATE	BY
A	WAS 2 7/8"	3-8-50	W.J.

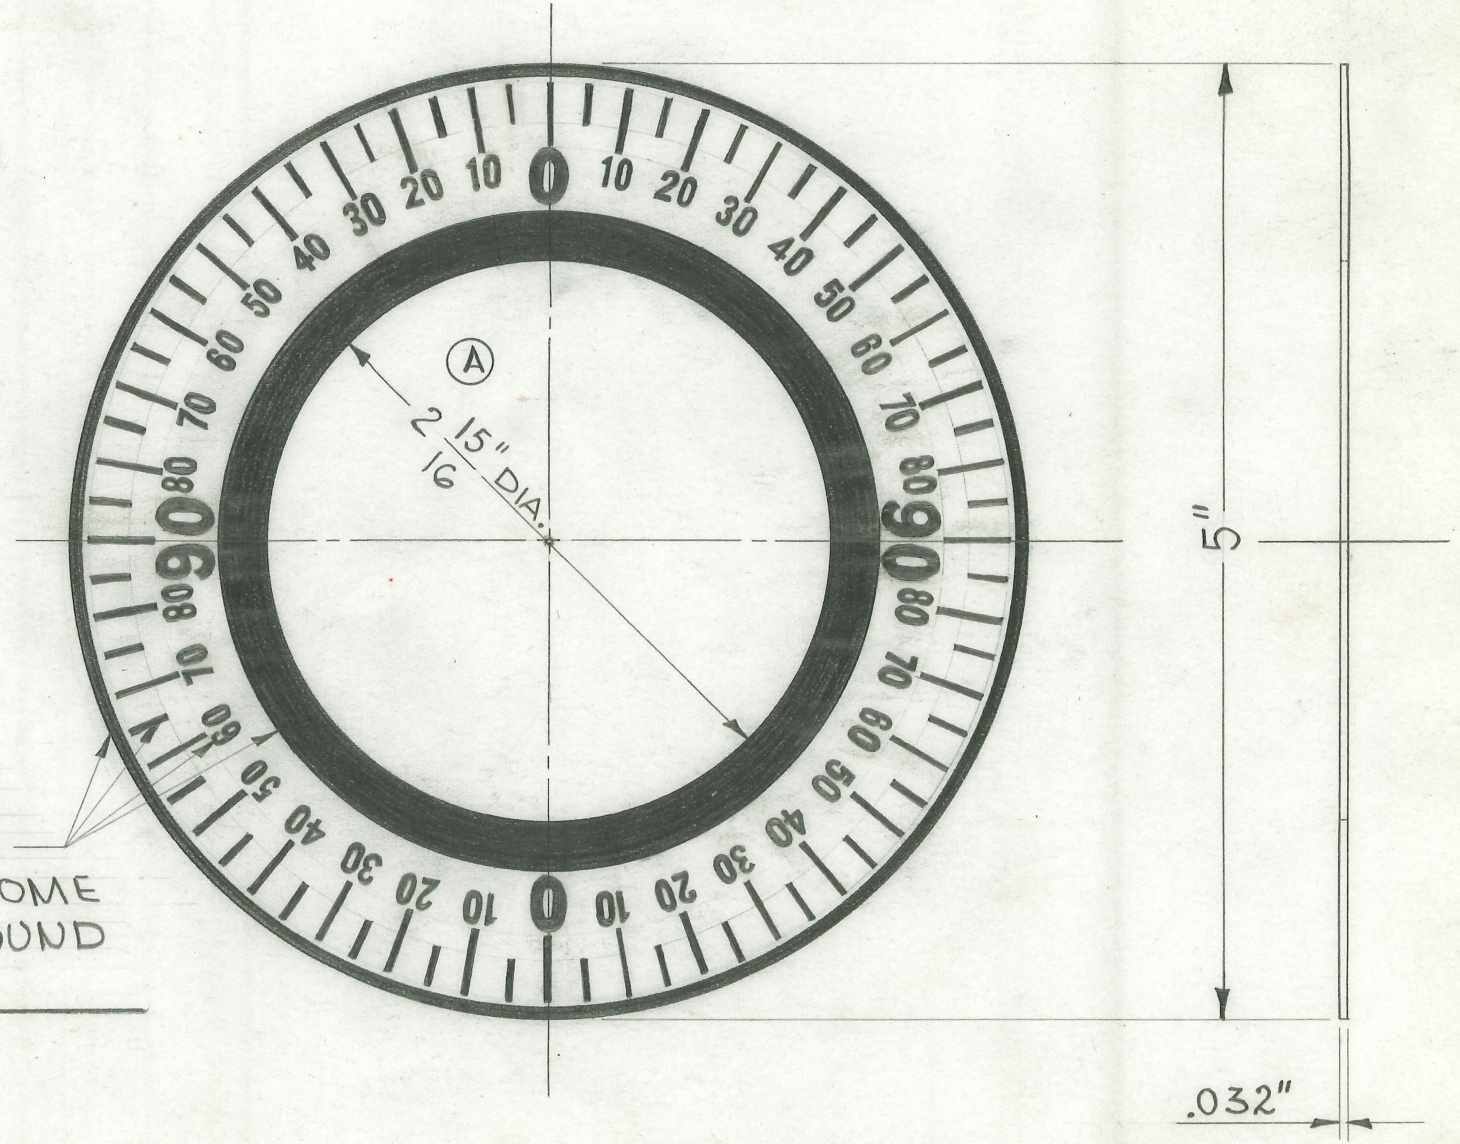

ANGLE INDICATIONS, NUMERALS, BORDER & BORDER AROUND CENTER HOLE - CHROME PLATED. BACKGROUND BLACK ENAMEL.

FOLDER # 136

TITLE: FISCHER DELUXE "TC-50" X-RAY CABLE HOOK

H. G. FISCHER & CO.
FRANKLIN PARK, ILLINOIS

PART NO. 17953F

DATE 11-17-48 | DR. BY J.V.W. | CH'K'D.

REVISION	DATE	BY

PATTERN 2397 | FINISH CHROME #2 | SCALE FULL

TOOLS: DRILL JIG TOOL #9980

MATERIAL: CAST IN BRASS FROM 17953

DIMENSIONS
FRACTIONAL ± .015
DECIMAL ± .005
ANGULAR ± ½°
UNLESS OTHERWISE SPECIFIED

1 REQUIRED

C'BORE. TO FLAT FACE

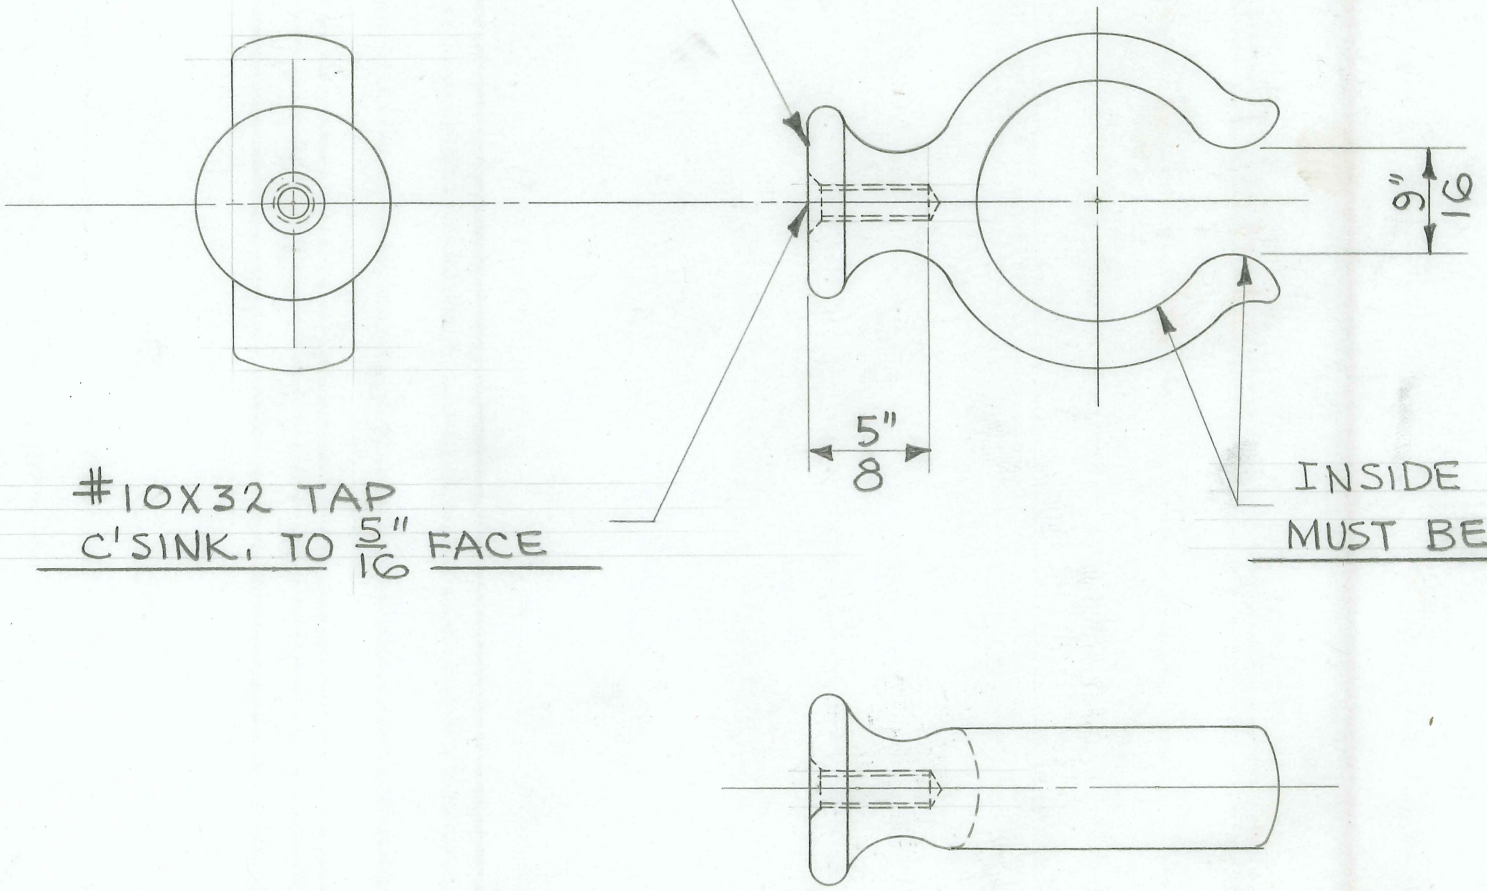

#10X32 TAP
C'SINK. TO 5/16" FACE

INSIDE SURFACES MUST BE SMOOTH

FOLDER # 136

TITLE

FISCHER DELUXE "TC-50" X-RAY CABLE HOOK SHAFT

H. G. FISCHER & CO.
FRANKLIN PARK, ILLINOIS

PART NO. 17954

PATTERN	FINISH	SCALE	DATE	DR. BY	CH'K'D.
	CHROME #2	FULL	11	J.V.W.	

TOOLS

MATERIAL
5/8" DIA. C.R. STEEL

DIMENSIONS
FRACTIONAL ± .015
DECIMAL ± .005
ANGULAR ± ½°
UNLESS OTHERWISE SPECIFIED

REVISION	DATE	BY

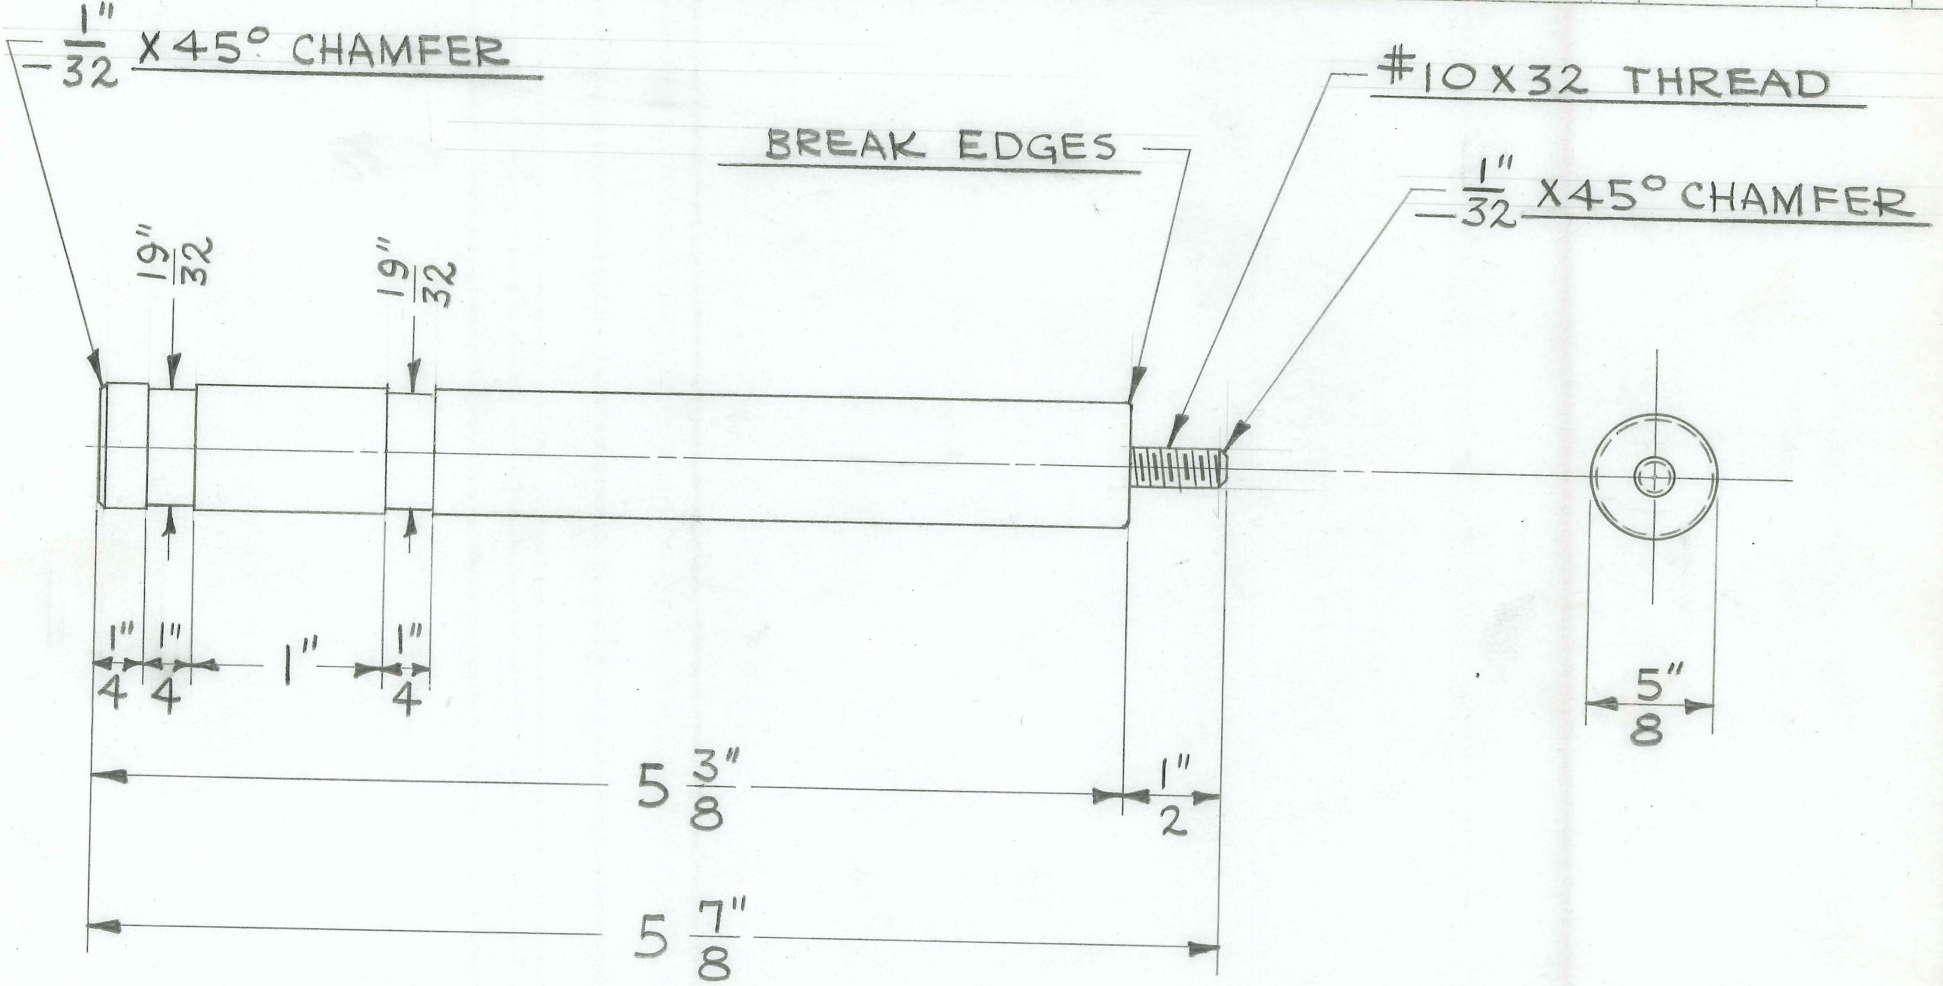

1 REQUIRED

FOLDER #136

TITLE

FISCHER "TC 50" ON DELUXE STAND HORIZONTAL ANGLE POINTER

H. G. FISCHER & CO.
FRANKLIN PARK, ILLINOIS

DATE 10-2-48 DR. BY W.J. CH'K'D.

PART NO. 17956

REVISION	DATE	BY

PATTERN

FINISH RED #87

SCALE FULL

TOOLS
DRILL JIG TOOL #9922

MATERIAL 1/32" C.R. SHEET STEEL

DIMENSIONS
FRACTIONAL ± .015
DECIMAL ± .005
ANGULAR ± ½°
UNLESS OTHERWISE SPECIFIED

"V" DIE # 6372

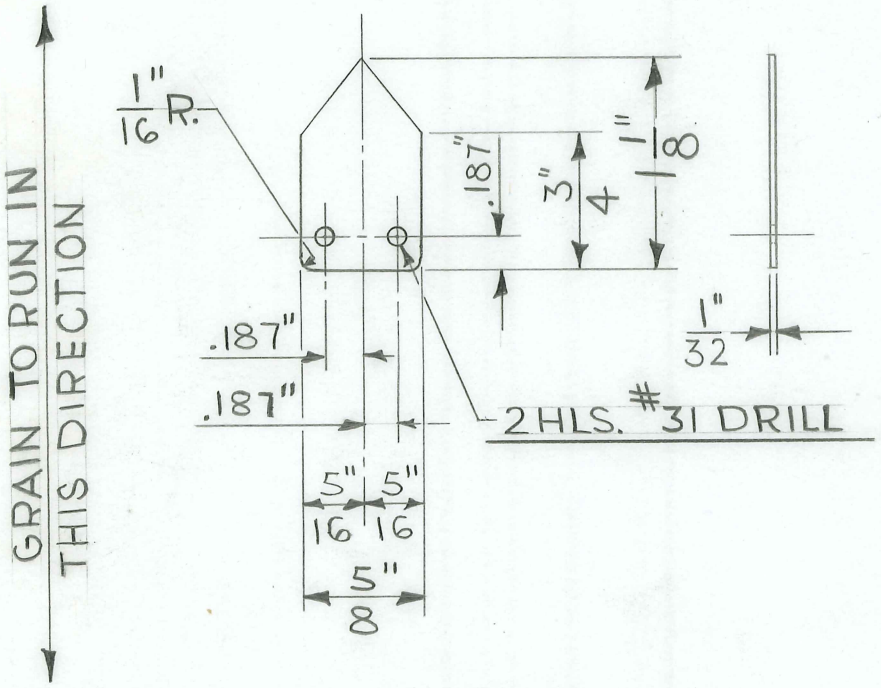

DEVELOPMENT

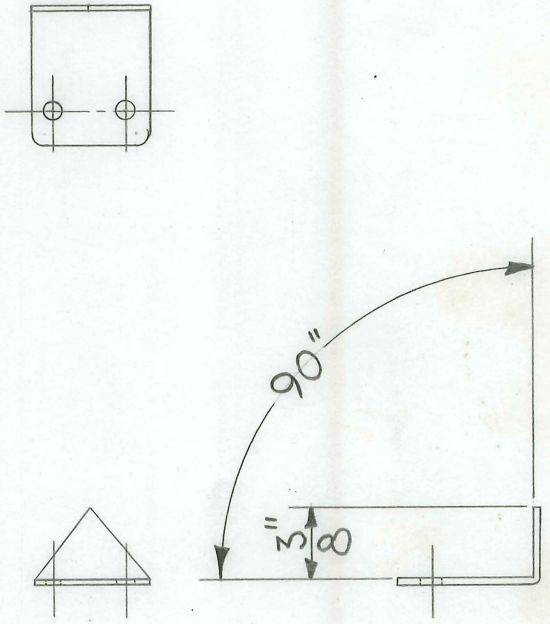

1 REQUIRED

FOLDER #136

TITLE FISCHER "TC-50" ON DELUXE STAND VERTICAL ANGLE POINTER (OLD STYLE FORK NEW BEARING PLATES)	H. G. FISCHER & CO. FRANKLIN PARK, ILLINOIS	PART NO. 17957B	
	DATE 1-7-53 DR BY W.J. CH'K'D.	REVISION	DATE BY
PATTERN / FINISH RED # 87 / SCALE FULL	DIMENSIONS FRACTIONAL ± .015, DECIMAL ± .005, ANGULAR ± ½° UNLESS OTHERWISE SPECIFIED		
TOOLS / MATERIAL FROM 17957A			

CUT OFF SECTION INDICATED
BY DOTTED LINES TO DIMENSION SHOWN

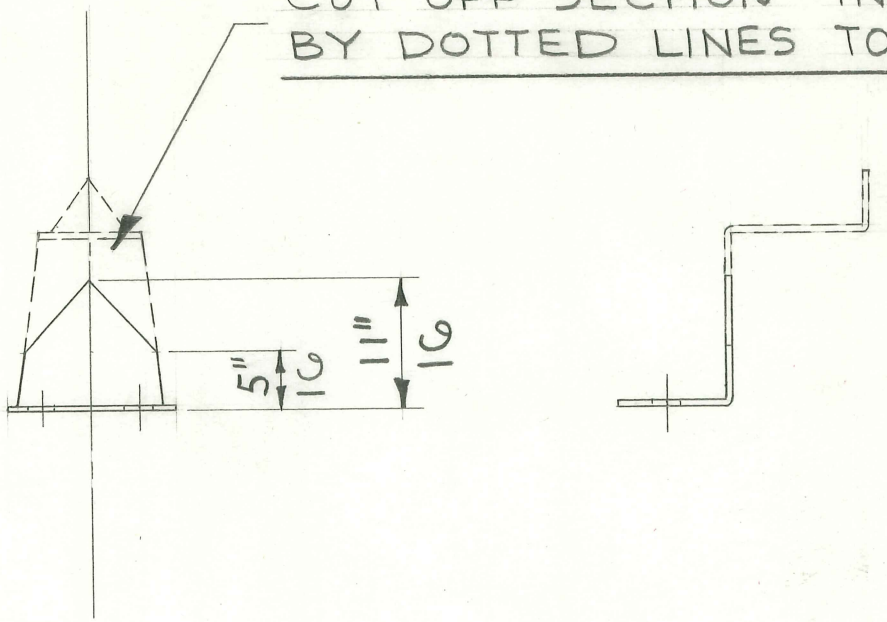

4 REQUIRED

FOLDER #136

TITLE FISCHER "TC-50" ON DELUXE STAND
C'WT. - CABLE CONN. LINK

H. G. FISCHER & CO.
FRANKLIN PARK, ILLINOIS

DATE 11-19-52 | DR. BY | CH'K'D.

PART NO. 17959C

REVISION	DATE	BY
C Bull 709	10-31-68	CLL

PATTERN | FINISH | SCALE FULL

TOOLS CINTIMATIC
DRILL JIG # 9912

MATERIAL
$\frac{1}{4}$" X $\frac{3}{4}$" C.R. STEEL BAR

DIMENSIONS
FRACTIONAL ± .015
DECIMAL ± .005
ANGULAR ± ½°
UNLESS OTHERWISE SPECIFIED

USED ON	AMT
17968 GC	1

BREAK ALL SHARP CORNERS & EDGES

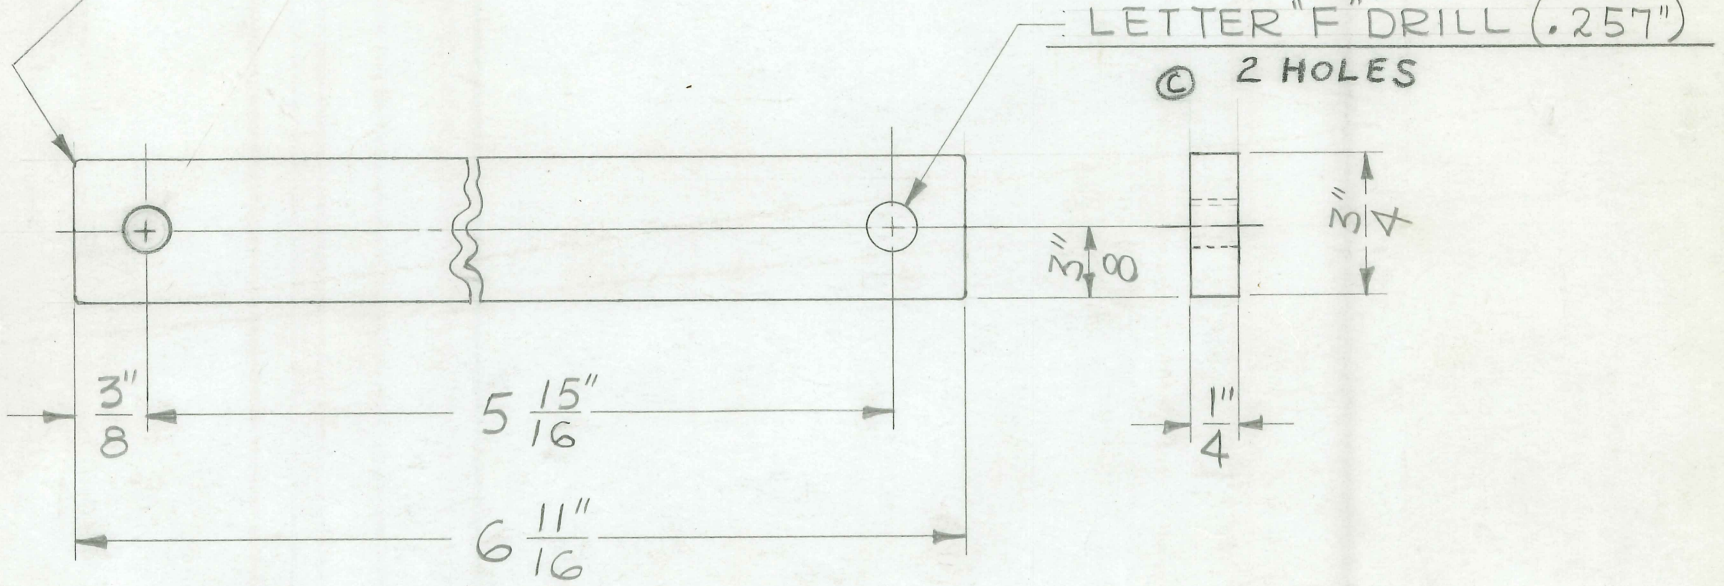

1 REQUIRED

TITLE

FISCHER "TC-50" ON DELUXE TUBE STAND
UPRIGHT GUIDE BAR

H. G. FISCHER & CO.
FRANKLIN PARK, ILLINOIS

PART NO. 17964

DATE 9-30-48 | DR. BY J.B.G. | CH'K'D. J.V.W.

REVISION	DATE	BY
A FINISH CHANGE ℄ TO ℄ OF HOLES ADDED	9-7-50	J.V.W.

PATTERN

FINISH ~~CHROME #2 ALL OVER~~

SCALE FULL

TOOLS ~~DRILL JIG TOOL #9515~~
DRILL JIG TOOL #11401

MATERIAL $\frac{5}{8}$" X $1\frac{1}{4}$" C.R. STEEL BAR (SEE NOTE)

DIMENSIONS UNLESS OTHERWISE SPECIFIED
FRACTIONAL ± .015
DECIMAL ± .005
ANGULAR ± ½°

FINISH - CAD. #23 - MASK THESE 2 SURFACES THEN PAINT

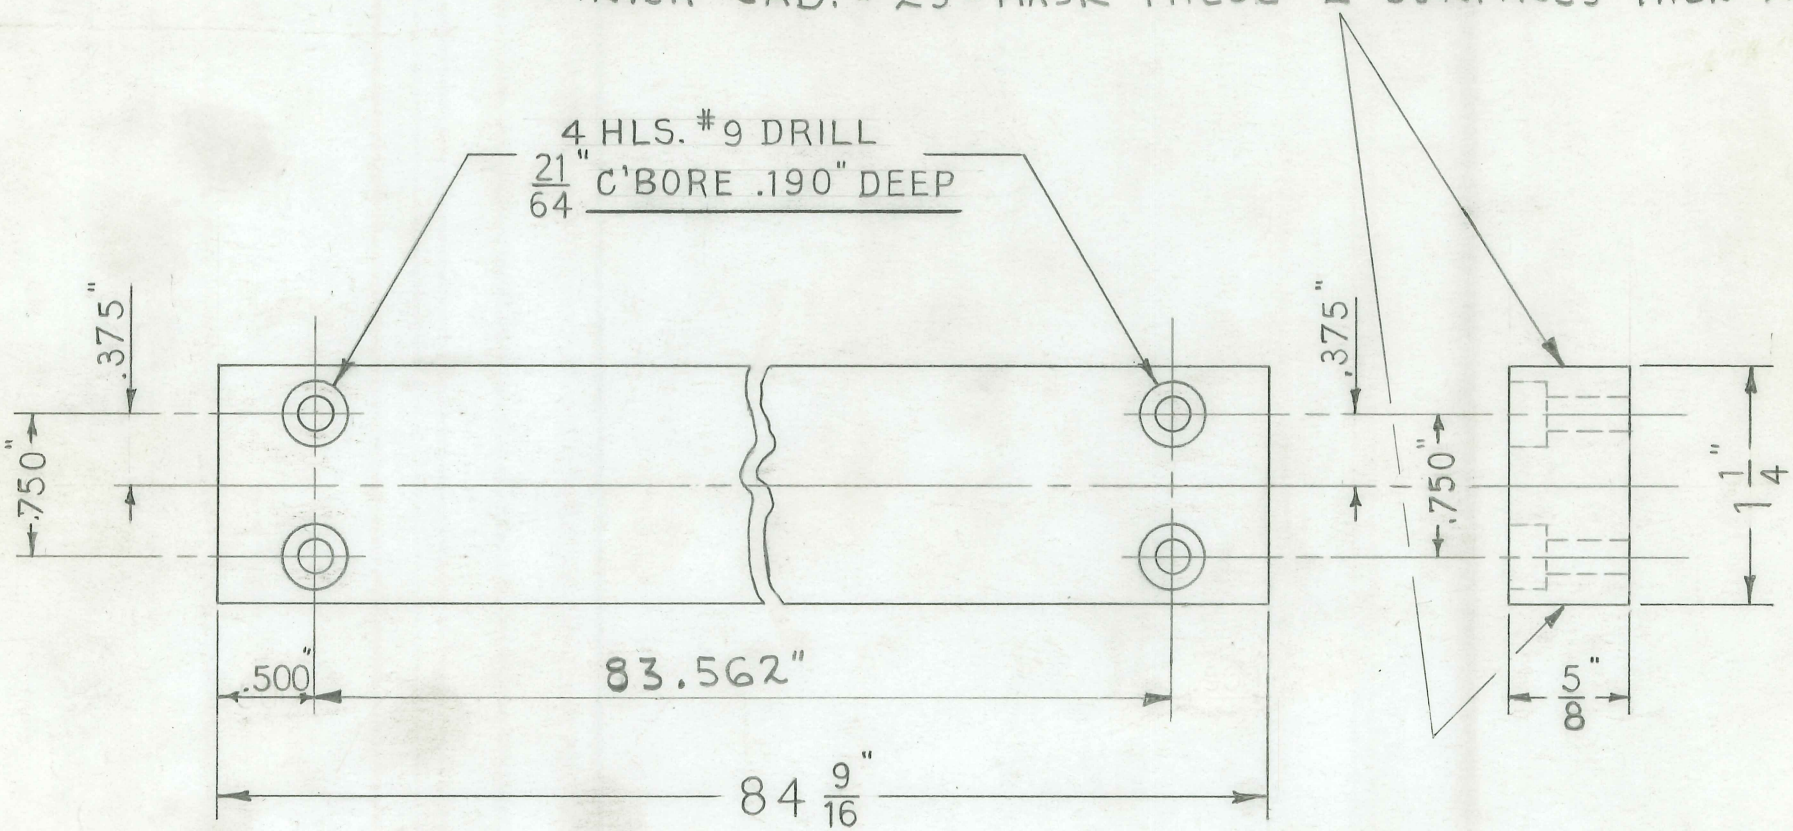

ORDER STOCK IN 16FT. LENGTHS - IF POSSIBLE

1 - REQUIRED

FOLDER #136

TITLE

FISCHER "TC-50" DELUXE STAND
TUBE HEAD–HORIZ. INNER TUBE PLUG PIN

H. G. FISCHER & CO.
FRANKLIN PARK, ILLINOIS

DATE 3-4-49 | DR. BY J.V.W. | CH'K'D.

PART NO. 17974

REVISION	DATE	BY

PATTERN | FINISH | SCALE FULL

TOOLS | MATERIAL $\frac{3}{16}$" DIA. C.R. STEEL

DIMENSIONS
FRACTIONAL ± .015
DECIMAL ± .005
ANGULAR ± ½°
UNLESS OTHERWISE SPECIFIED

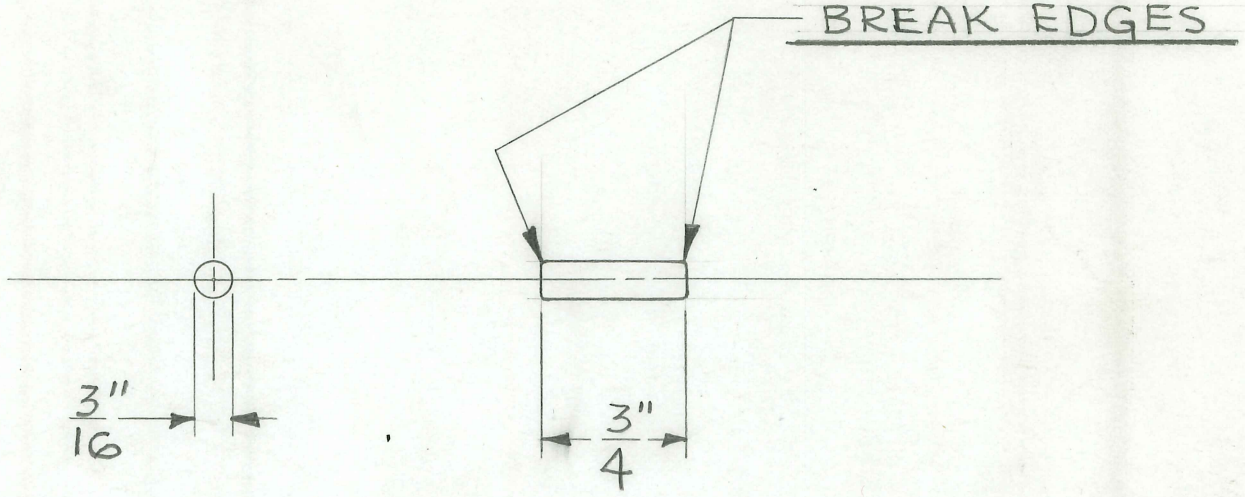

2 REQUIRED

FOLDER #136

TITLE FISCHER DELUXE "TC-50" TUBE HEAD
HORIZ. OUTER TUBE PLUG

H. G. FISCHER & CO.
FRANKLIN PARK, ILLINOIS

PART NO. 17976F

DATE 3-4-49 DR. BY J.V.W. CH'K'D.

REVISION	DATE	BY

PATTERN 2417 | FINISH | SCALE FULL

TOOLS | MATERIAL 80-10-10 BRONZE CASTING

DIMENSIONS UNLESS OTHERWISE SPECIFIED
FRACTIONAL ± .015
DECIMAL ± .005
ANGULAR ± ½°

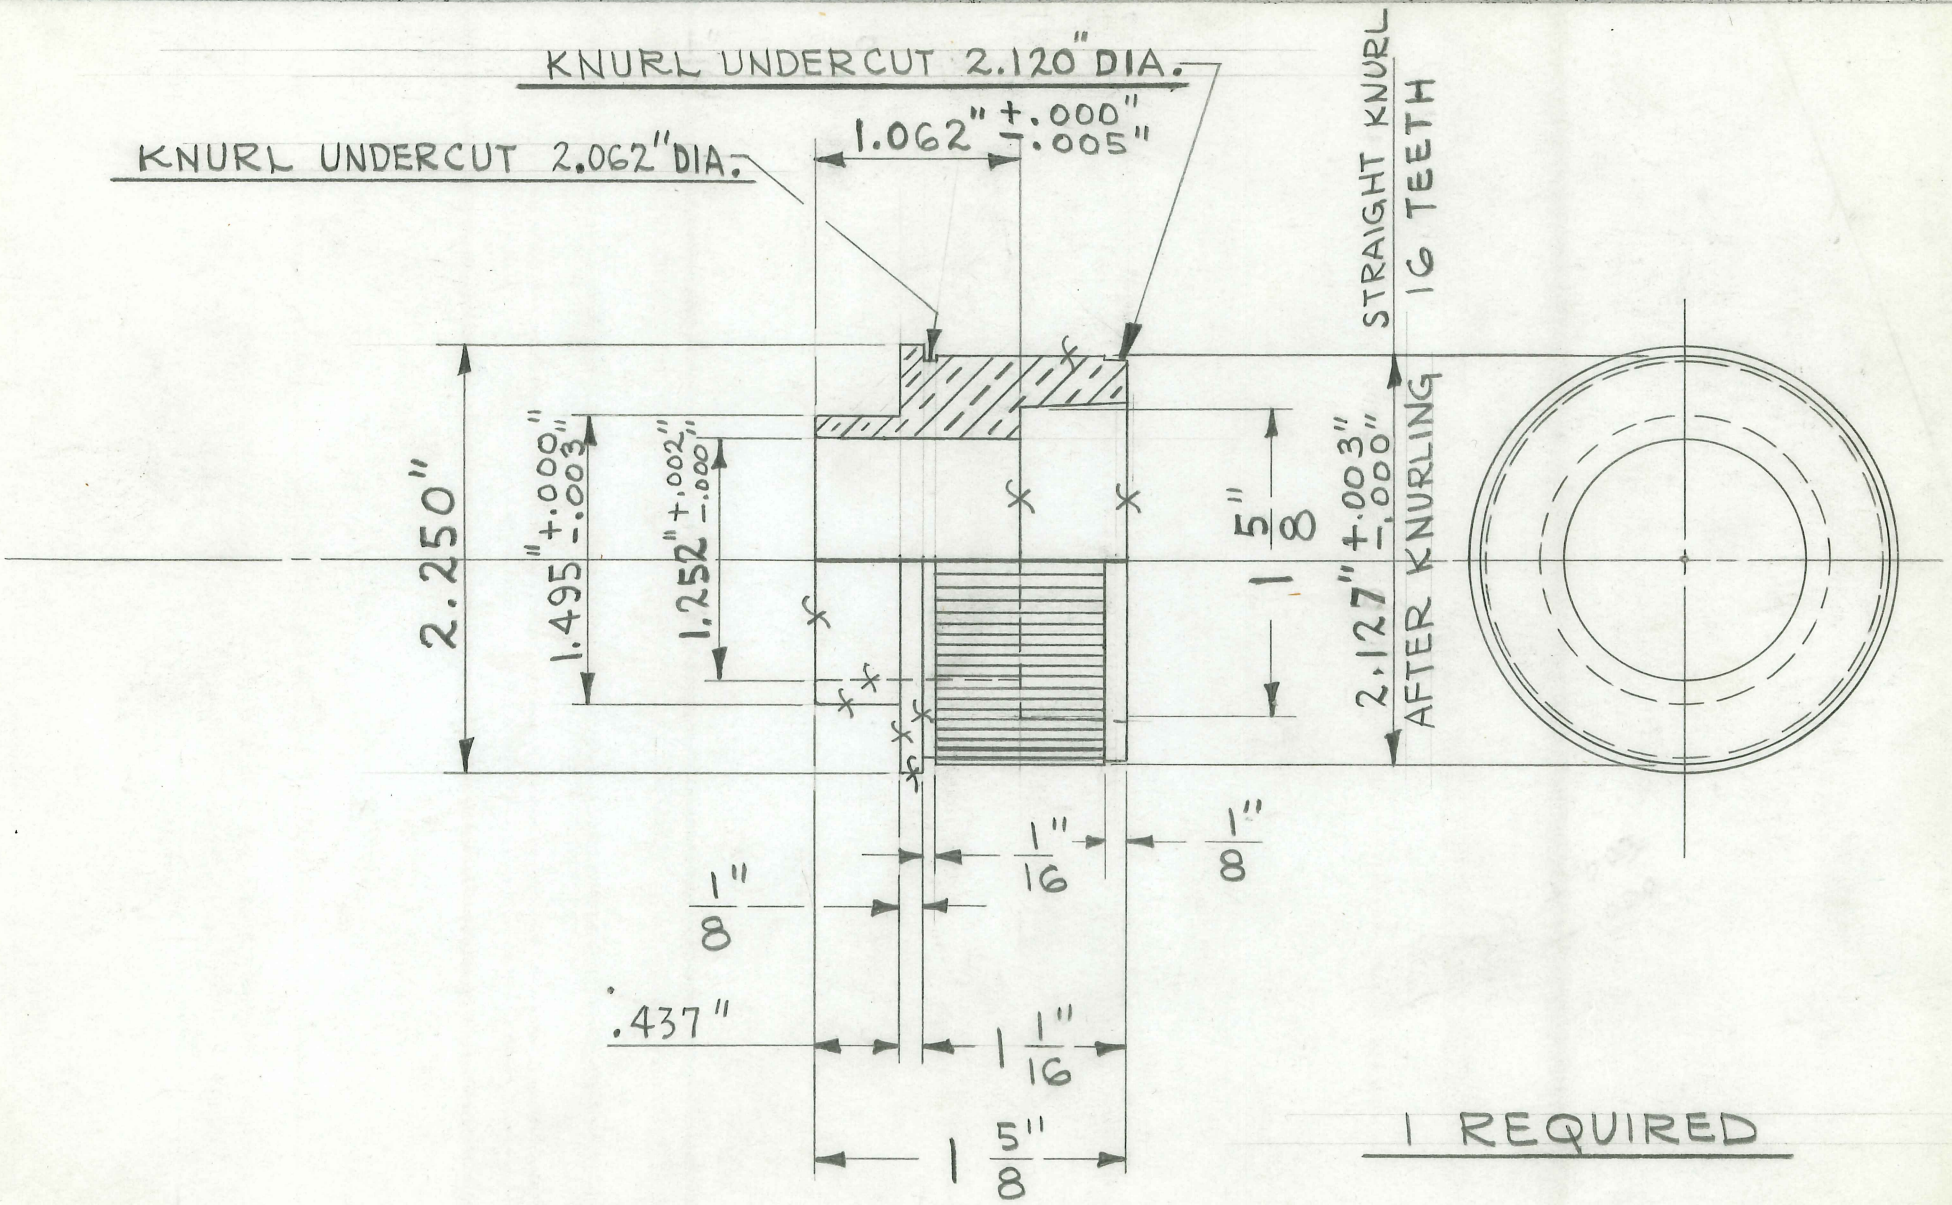

1 REQUIRED

FOLDER # 136

TITLE

FISCHER "TC-50" ON DELUXE STAND
TUBE HEAD – HORIZ. INNER TUBE PLUG

H. G. FISCHER & CO.
FRANKLIN PARK, ILLINOIS

DATE 3-4-49 | DR. BY J.V.W. | CH'K'D.

PART NO. 17977

REVISION	DATE	BY

PATTERN | FINISH | SCALE FULL

TOOLS | MATERIAL: $1\frac{1}{2}$" DIA. C.R. STEEL

DIMENSIONS UNLESS OTHERWISE SPECIFIED
FRACTIONAL ± .015
DECIMAL ± .005
ANGULAR ± ½°

BREAK ALL SHARP EDGES

$\frac{5}{16}$" X 24 TAP – 1" DEEP
C'BORE. $\frac{1}{8}$" DEEP
WITH LETTER "O" DRILL

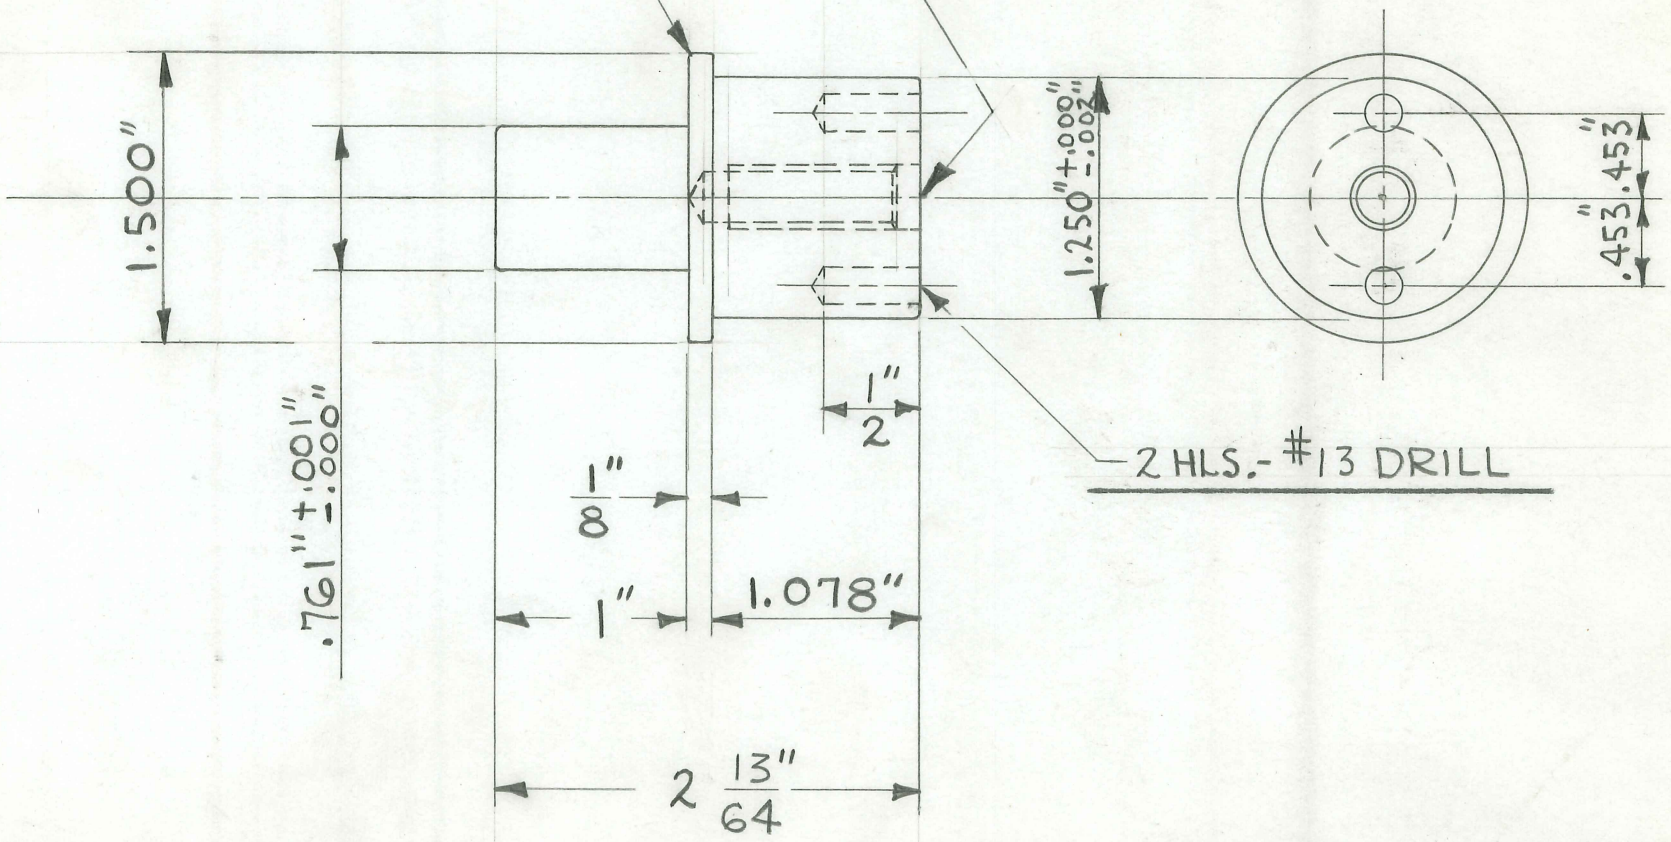

1 REQUIRED

FOLDER #136

TITLE

FISCHER "L-200" & "RF-100" X-RAY UNIT
TUBE ADAPTER BLOCKER SLIDE GUIDE BAR

H. G. FISCHER & CO.
FRANKLIN PARK, ILLINOIS

PART NO. 17984A

DATE 3-16-49 | DR. BY W.J. | CH'K'D.

REVISION		DATE	BY
A	WAS 1/4"	7-5-55	W.V.
B	" 2 7/32"		

PATTERN | FINISH CAD. #23 | SCALE FULL

TOOLS DRILL JIG #11018
CUT OFF DIE #7693-43

MATERIAL 1/8" X 3/8" C.R. STEEL BAR

DIMENSIONS UNLESS OTHERWISE SPECIFIED
FRACTIONAL ± .015
DECIMAL ± .005
ANGULAR ± ½°

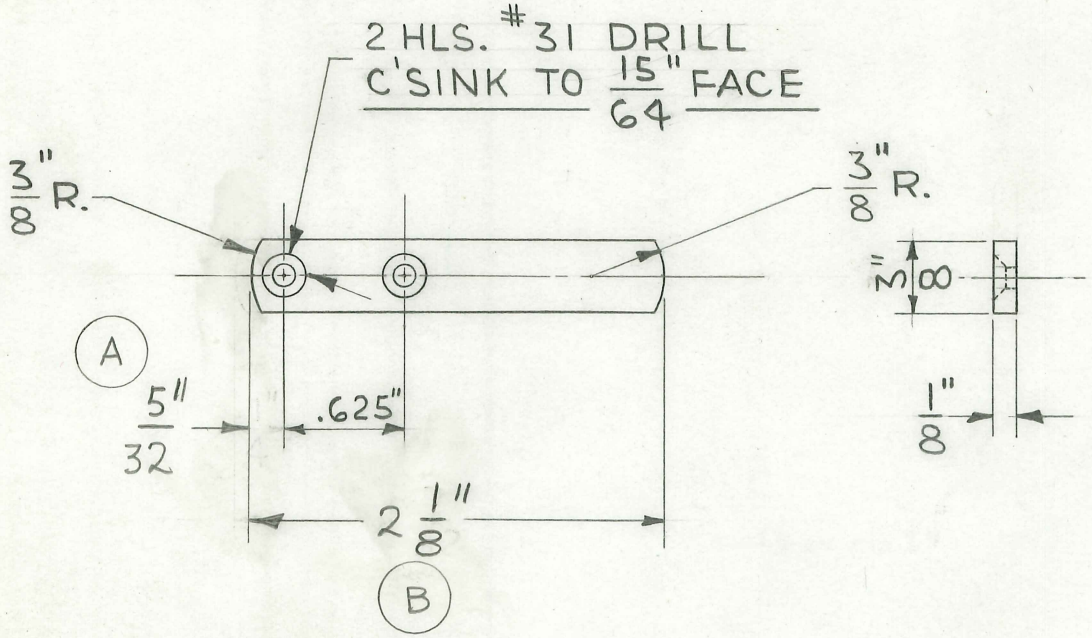

1 REQUIRED

FOLDER #130

TITLE

FISCHER DELUXE TC-50 X-RAY BEARING BUSHING - SMALL

H. G. FISCHER & CO.
FRANKLIN PARK, ILLINOIS

PART NO. 17987

DATE 3-21-49 DR. BY W.J. CH'K'D. J.V.W.

REVISION	DATE	BY

PATTERN | FINISH | SCALE FULL

TOOLS | MATERIAL $\frac{3}{8}$" DIA. BRASS BAR

DIMENSIONS
FRACTIONAL ± .015
DECIMAL ± .005
ANGULAR ± ½°
UNLESS OTHERWISE SPECIFIED

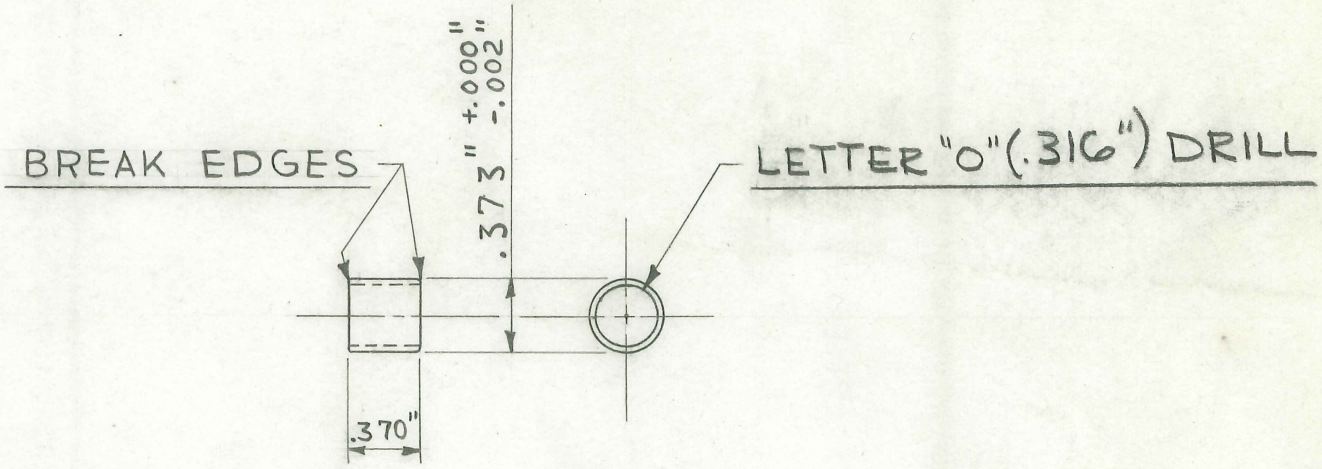

6 REQUIRED

FOLDER # 136

TITLE BALL BEARING 9-26×8mm.

H. G. FISCHER & CO.
FRANKLIN PARK, ILLINOIS

PART NO. S 17992

DATE 6-13-51 DR. BY W. J. CH'K'D. J.V.W.

REVISION	DATE	BY
RELEASED BEFORE P/R NUMBERS WERE DESIGNATED		

PATTERN | FINISH | SCALE FULL

TOOLS | MATERIAL #39 SKF

DIMENSIONS
FRACTIONAL ± .015
DECIMAL ± .005
ANGULAR ± ½°
UNLESS OTHERWISE SPECIFIED

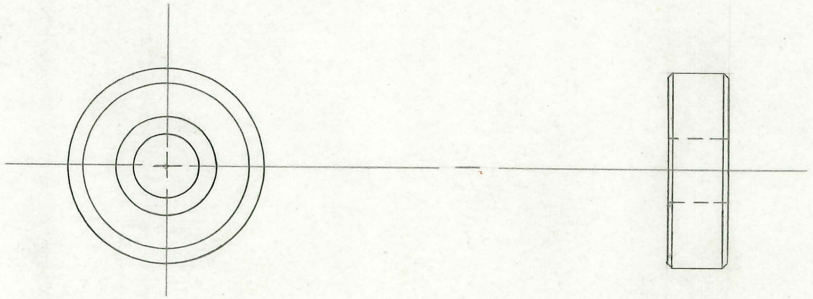

BORE = 9 MM. (0.3543")
O.D. = 26 MM. (1.0236")
WIDTH = 8 MM. (0.315")

FOLDER #127

TITLE

FISCHER "L-200" & "RF"-100 X-RAY UNIT

BLOCKER SLIDE POSITIONING PIN

H. G. FISCHER & CO.
FRANKLIN PARK, ILLINOIS

PART NO. 17994

DATE 11-1-49 | DR. BY W. J. | CH'K'D. J.Y.W.

REVISION	DATE	BY

PATTERN | FINISH CAD. # 23 | SCALE FULL

TOOLS | MATERIAL 5/16" DIA. C.R. STEEL ROD

DIMENSIONS
FRACTIONAL ± .015
DECIMAL ± .005
ANGULAR ± ½°
UNLESS OTHERWISE SPECIFIED

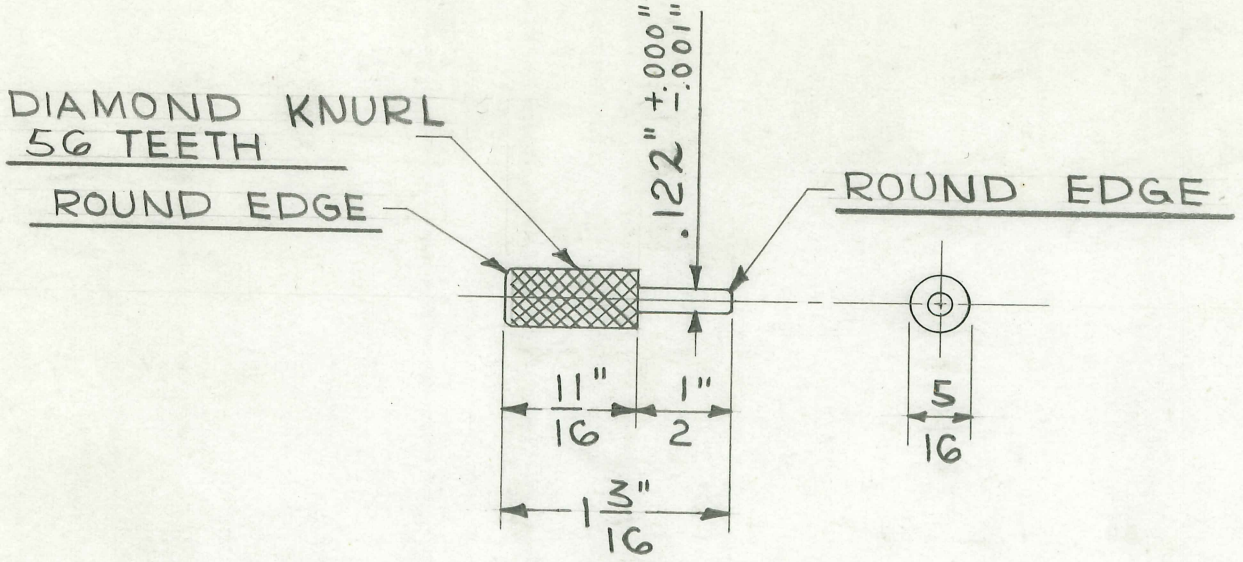

1 REQUIRED

FOLDER # 130

TITLE

FISCHER HEAD CLAMP
CLAMPING ARM ACTUATOR

H. G. FISCHER & CO.
FRANKLIN PARK, ILLINOIS

PART NO. 17703F

DATE 10-22-48 DR. BY W. J. CH'K'D. J.V.W.

REVISION	DATE	BY

PATTERN 2373 | FINISH CAD. #23 | SCALE FULL

TOOLS MILLING FIX. #9959
DRILL JIG #9958

MATERIAL CAST IN BRASS

DIMENSIONS UNLESS OTHERWISE SPECIFIED
FRACTIONAL ± .015
DECIMAL ± .005
ANGULAR ± ½°

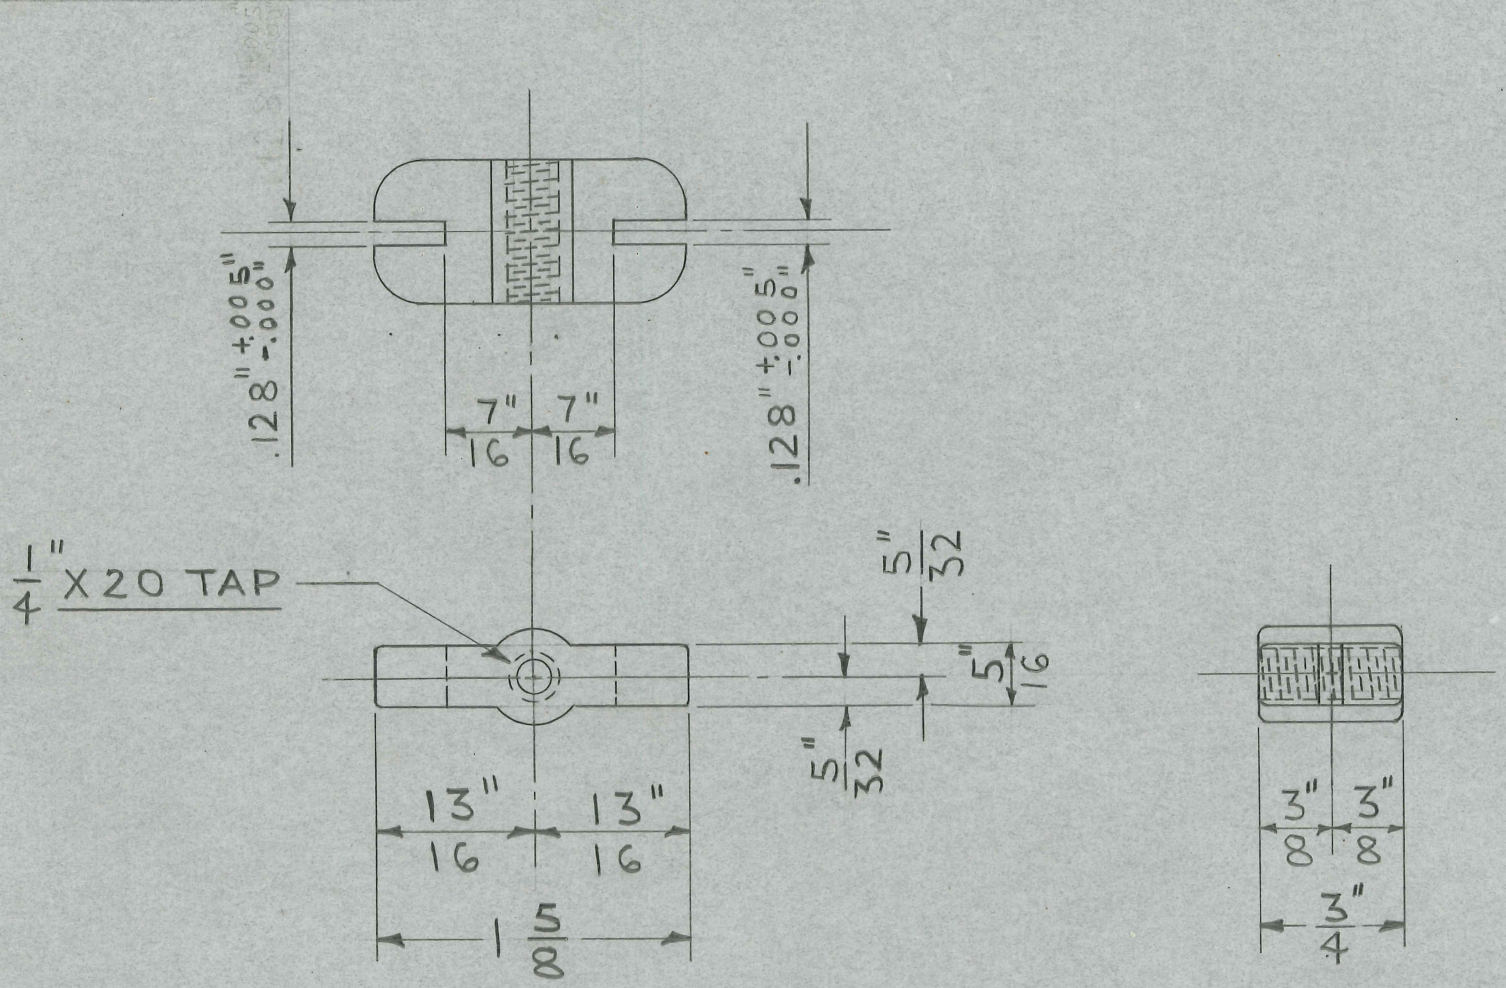

1 REQUIRED

FOLDER #137

TITLE

FISCHER HEAD CLAMP CLAMPING ARM ACTUATING PIN

H. G. FISCHER & CO.
FRANKLIN PARK, ILLINOIS

PART NO. 17710

DATE 10-20-48 DR. BY W.J. CH'K'D J.V.W.

REVISION	DATE	BY

PATTERN | FINISH CAD. #23 | SCALE FULL

TOOLS | MATERIAL 1" 1/8 DIA. C.R. STEEL

DIMENSIONS
FRACTIONAL ± .015
DECIMAL ± .005
ANGULAR ± ½°
UNLESS OTHERWISE SPECIFIED

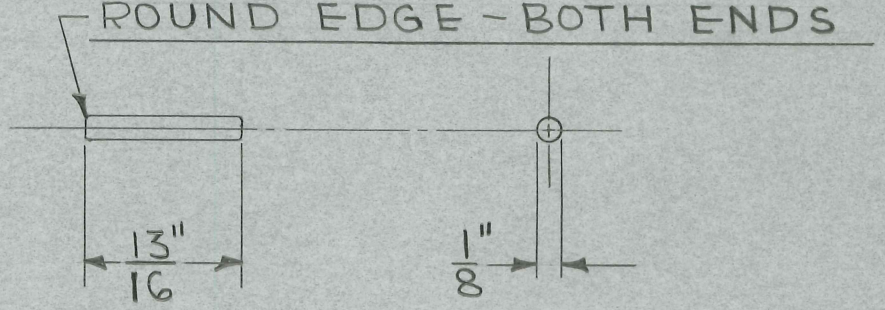

2 REQUIRED

FOLDER #137

TITLE

FISCHER HEAD CLAMP
CLAMPING ARM BUSHING

H. G. FISCHER & CO.
FRANKLIN PARK, ILLINOIS

PART NO. 17711

DATE 10-15-48 | DR. BY W.J. | CK'K'D. J.V.W.

REVISION	DATE	BY

PATTERN | FINISH CAD. # 23 | SCALE FULL

TOOLS | MATERIAL 3/8" JEWELERS ROD

DIMENSIONS UNLESS OTHERWISE SPECIFIED
FRACTIONAL ± .015
DECIMAL ± .005
ANGULAR ± ½°

BREAK EDGE - BOTH ENDS

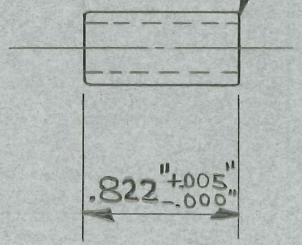

LETTER "F" (.257") DRILL

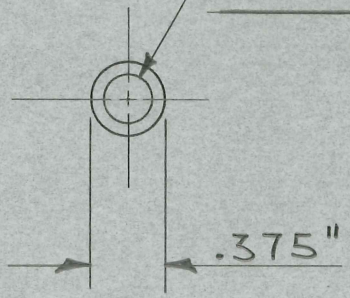

2 REQUIRED

FOLDER #137

H. G. FISCHER & CO.
FRANKLIN PARK, ILLINOIS

PART NO. 16999A

FISCHER "PRECISION 200" X-RAY UNIT
VERTICAL SPINE UNIT BUCKY LOCK SHAFT 8-30-50 W.J.
CAD.# 23 SCALE FULL

DIMENSIONS
FRACTIONAL ± .015
DECIMAL ± .005
ANGULAR ± ½°
UNLESS OTHERWISE SPECIFIED

REVISION | DATE | BY

3/8" DIA. C.R. STEEL ROD

1 REQUIRED

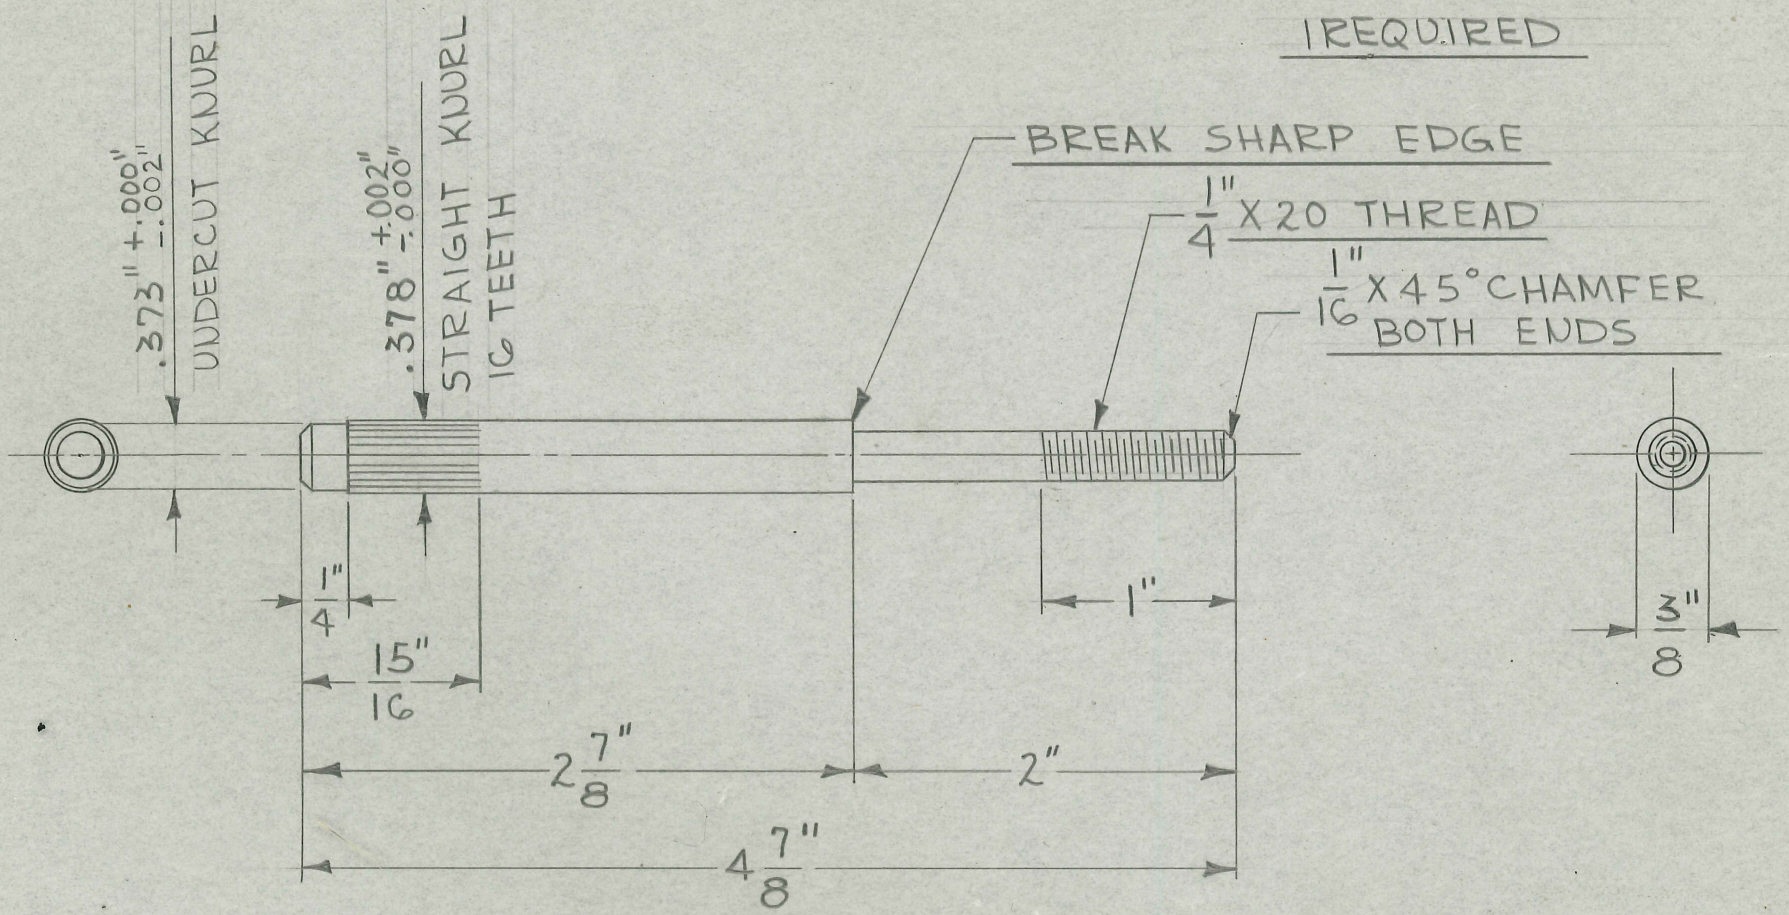

FOLDER # 136

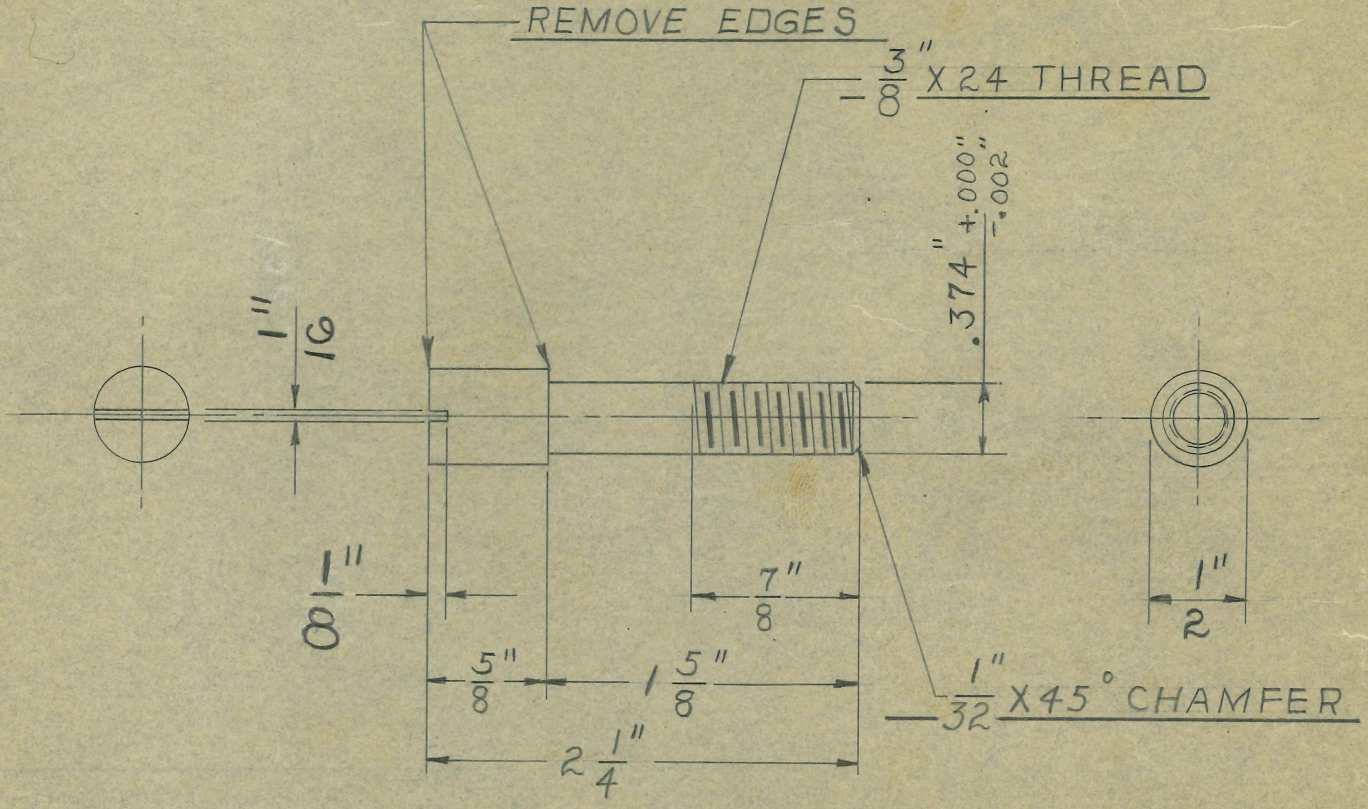

2 REQUIRED

DIMENSIONS	
FRACTIONAL	± .015
DECIMAL	± .005
ANGULAR	± ½°

UNLESS OTHERWISE SPECIFIED

SIZE	1/2"	ISSUE 7-16-47	W.J.
KIND	C.R. STEEL	CHANGED	
SHAPE	ROD	"	
FINISH	CAD. #23	"	
TEMP.		"	
PATT.		"	

TITLE:

FISCHER "PRECISION 200" X-RAY UNIT

BUCKY STAND BASE LEVELING SUPP. PIN

H. G. FISCHER & CO.
2335 WABANSIA AVE.
CHICAGO, ILL.

CAT. NO.

PART NO. 16998

TITLE

FISCHER RF-100 X-RAY UNIT
PULLMAN SASH C'BALANCE

H. G. FISCHER & CO.
FRANKLIN PARK, ILLINOIS

PART NO. 17098

DATE 11-12-48 | DR'N BY W.J. | CH'K'D BY J.V.W.

REVISION	DATE	BY

PATTERN | FINISH | SCALE FULL

TOOLS | MATERIAL FROM 17156

DIMENSIONS
FRACTIONAL ± .015
DECIMAL ± .005
ANGULAR ± ½°
UNLESS OTHERWISE SPECIFIED

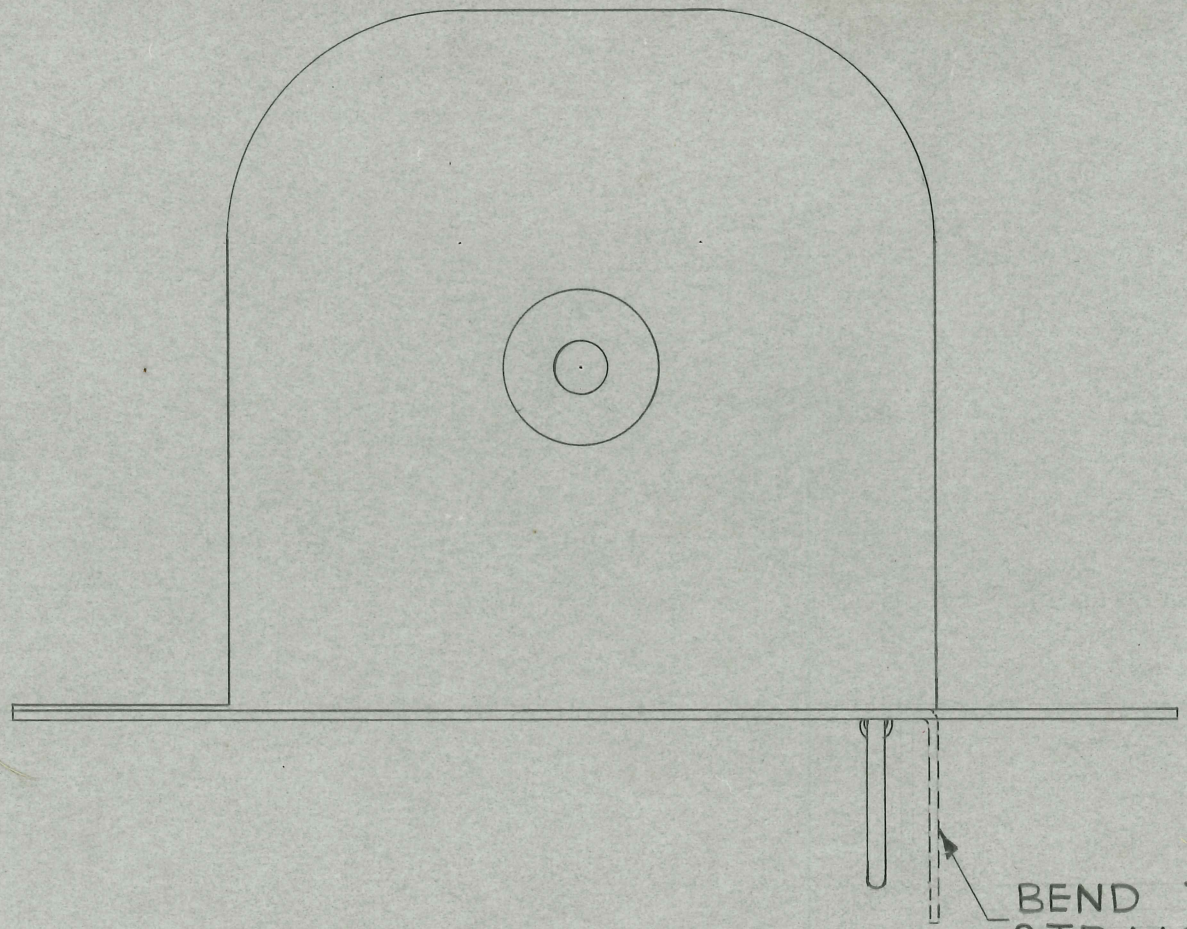

BEND THIS END UP
STRAIGHT AS SHOWN

1 REQUIRED

FOLDER #107

TITLE

FISCHER "MP-30" X-RAY UNIT
CONTROL TERMINAL BOARD

H. G. FISCHER & CO.
FRANKLIN PARK, ILLINOIS

PART NO. 17887

DATE 9-13-49 DR. BY J.V.W. CH'K'D.

REVISION | DATE | BY

PATTERN | FINISH | SCALE FULL

TOOLS | MATERIAL

BOUGHT OUTSIDE

DIMENSIONS
FRACTIONAL ± .015
DECIMAL ± .005
ANGULAR ± ½°
UNLESS OTHERWISE SPECIFIED

1 REQUIRED

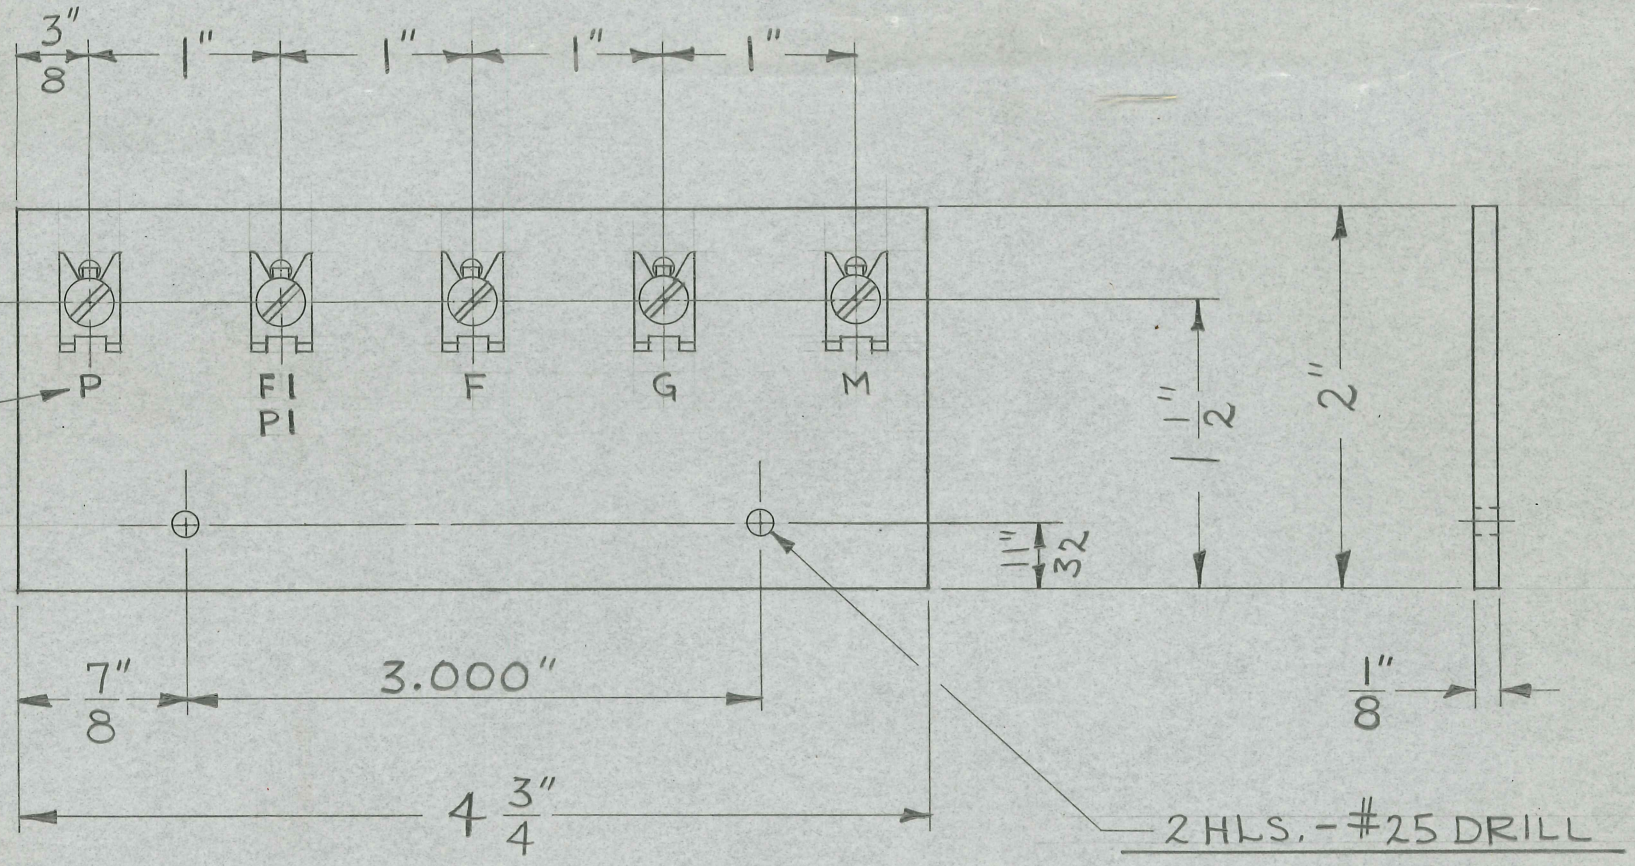

STAMP LETTERS AS SHOWN

FOLDER #135

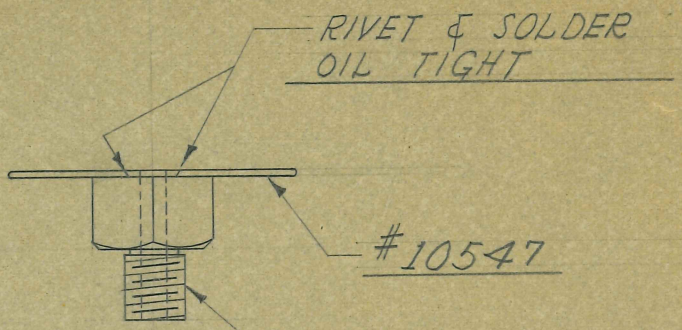

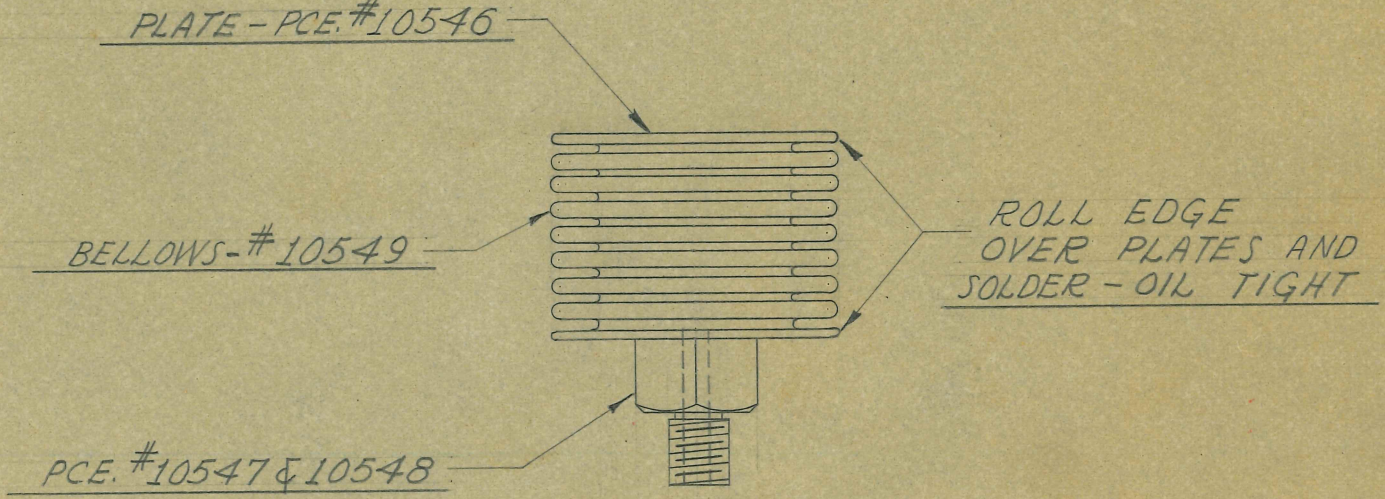

OBSOLETE

SIZE		ISSUE 3-31-37	J.W.
KIND		CHANGED	
SHAPE		"	
FINISH		"	
TEMP.		"	
PATT.		"	

TITLE: FISCHER SYNCHROTIMED BUCKY EXPANSION CHAMBER

H. G. FISCHER & CO.
2335 WABANSIA AVE.
CHICAGO, ILL.

CAT. NO.

PART NO. 10504G

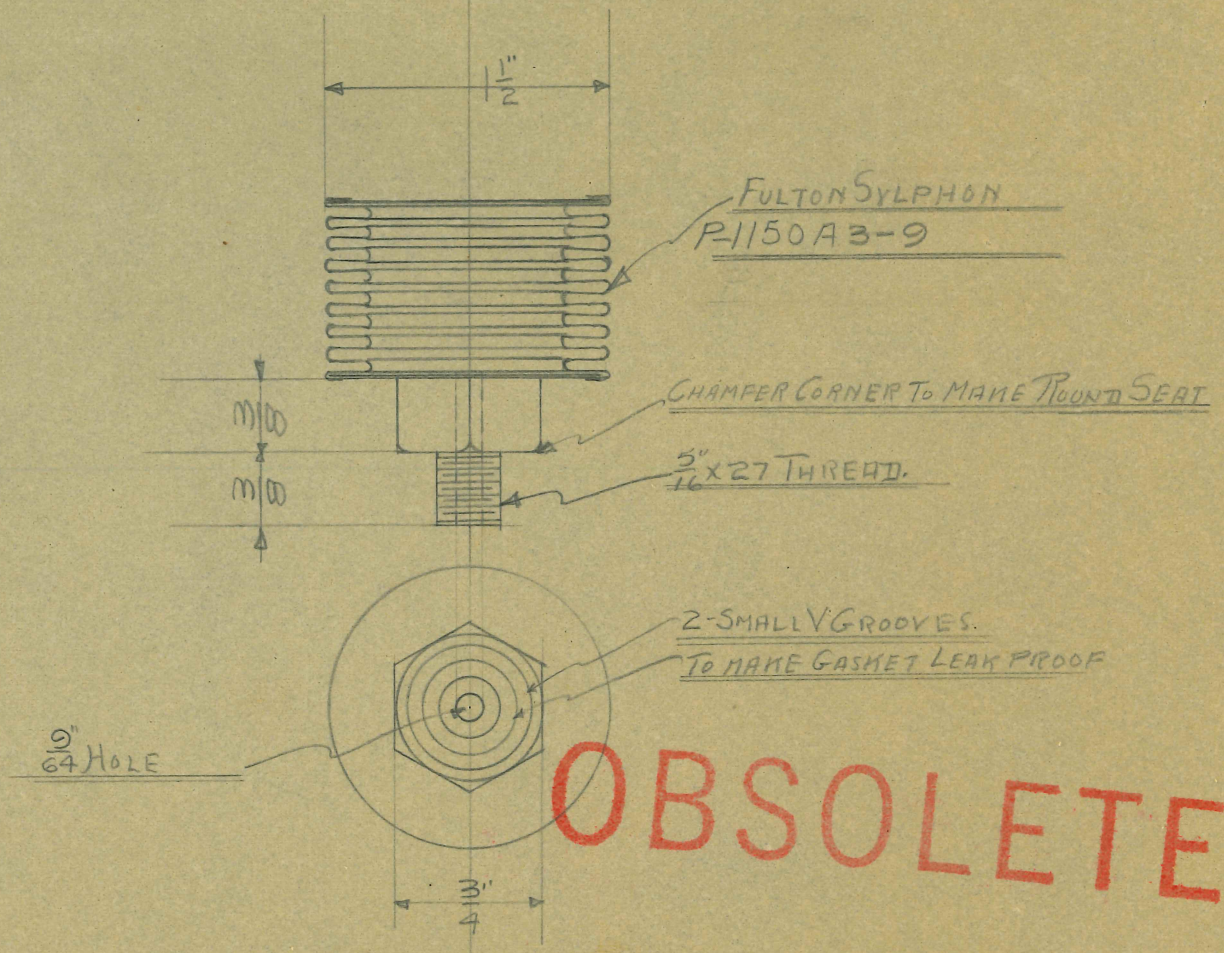

OBSOLETE

SIZE		ISSUE 3-17-37	
KIND		CHANGED	
SHAPE		"	
FINISH		"	
TEMP.		"	
PATT.		"	

TITLE: OIL TYPE BUCKY EXPANSION CHAMBER.

H. G. FISCHER & CO.
2335 WABANSIA AVE.
CHICAGO, ILL.

CAT. NO.

PART NO. 10504 G

TITLE

FISCHER DELUXE TC-50 X-RAY
BEARING BUSHING - LARGE

H. G. FISCHER & CO.
FRANKLIN PARK, ILLINOIS

PART NO. 17986

DATE 3-21-49 | DRAWN BY W. J. | CHK'D. J.V.W.

REVISION	DATE	BY

PATTERN | FINISH | SCALE FULL

TOOLS | MATERIAL $\frac{9}{16}$" DIA. BRASS ROD

DIMENSIONS UNLESS OTHERWISE SPECIFIED
FRACTIONAL ± .015
DECIMAL ± .005
ANGULAR ± ½°

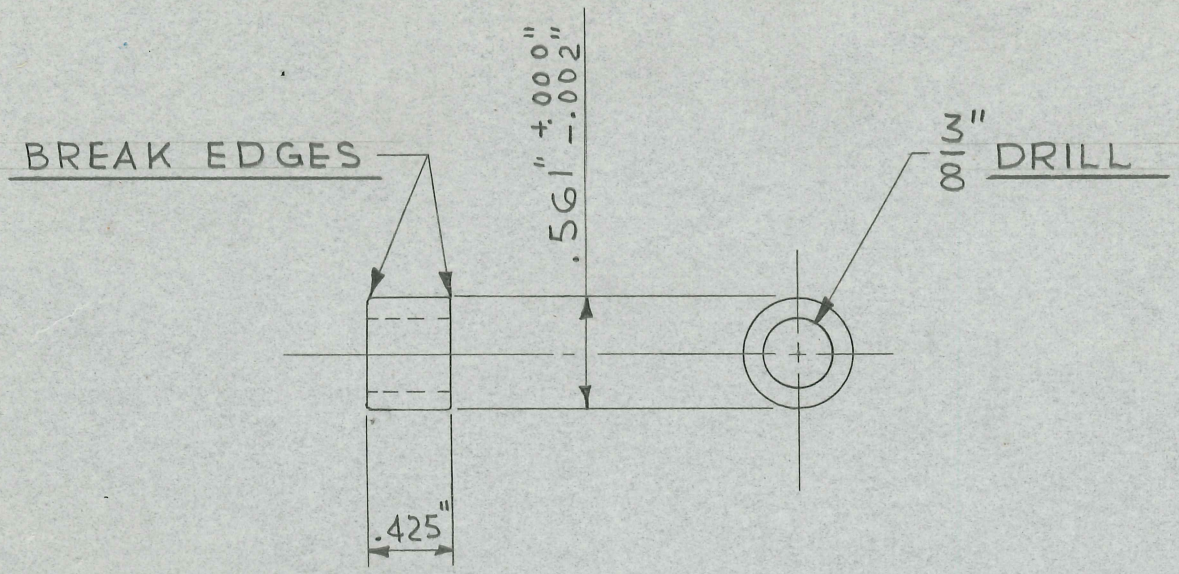

8 REQUIRED

FOLDER # 136

...LL MOUNTING BRACKET

H. G. FISCHER, INC.
FRANKLIN PARK, ILLINOIS

PART No.

DATE: 12.20.74 | DR. BY: AEM | CH'K'D:

REVISION

CAD #123

SCALE: FULL

MATERIAL: 11 GA. (.120) CRS SPEC: 41-448

DIMENSIONS
.X ± .030
.XX ± .010
.XXX ± .005
ANGULAR ± 1/2°
UNLESS OTHERWISE SPECIFIED

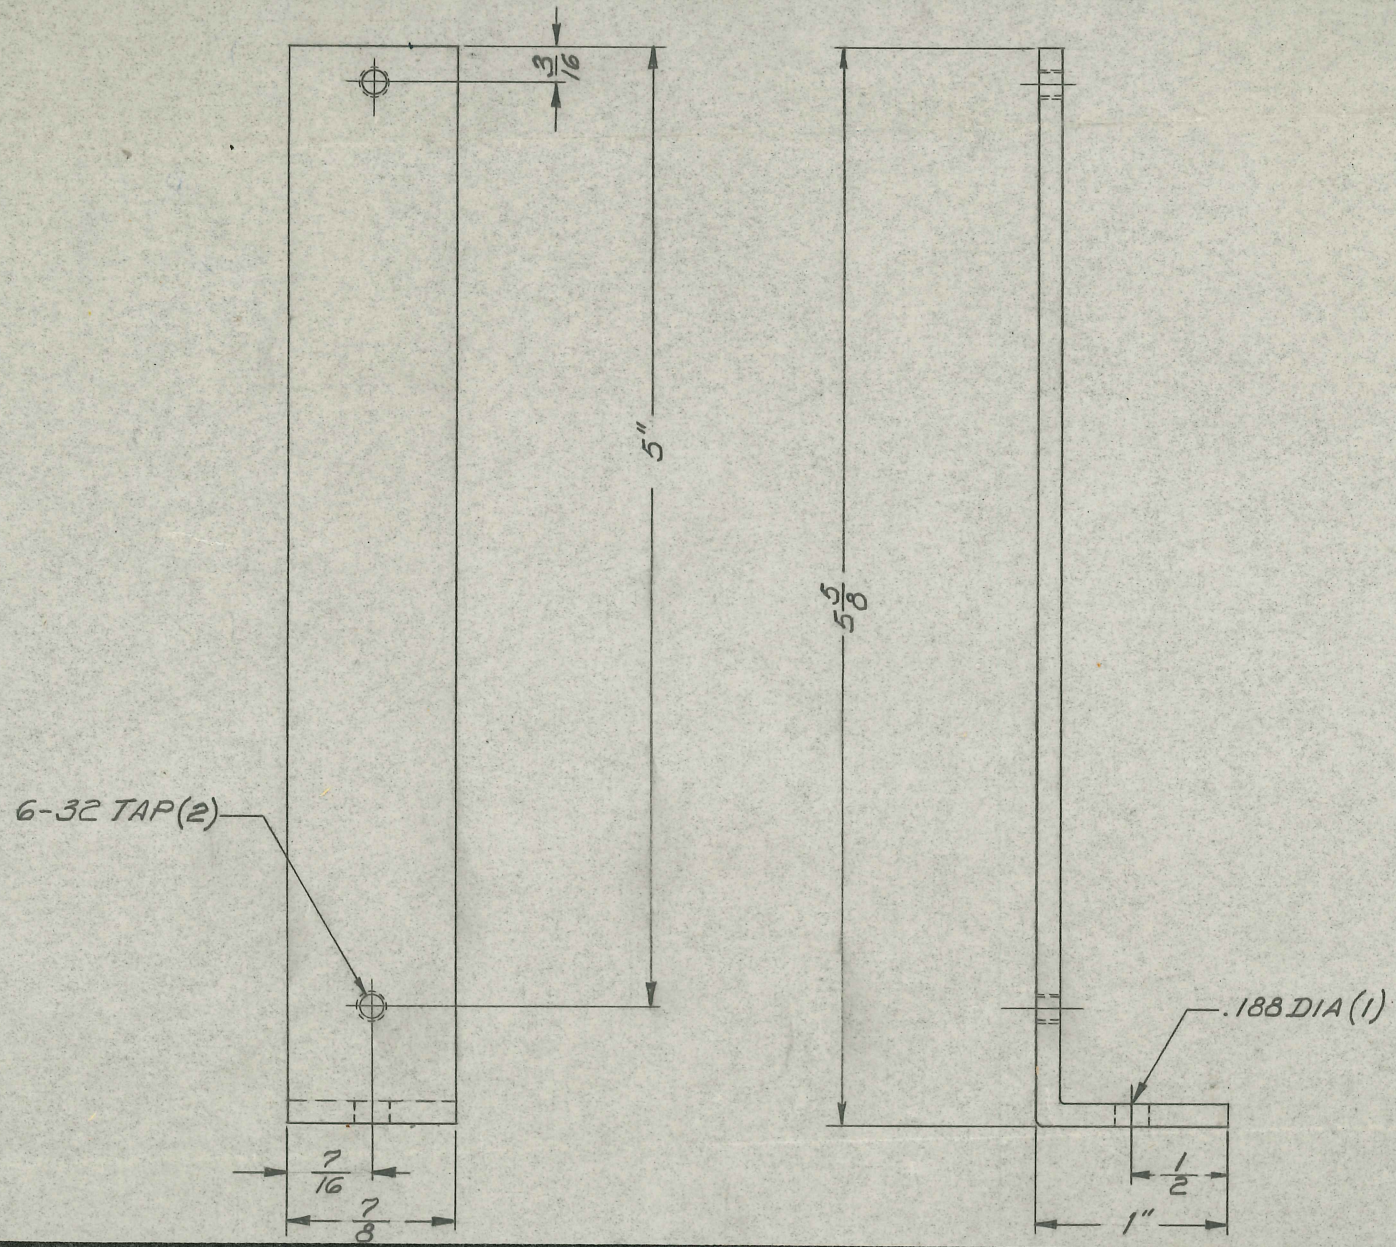

TITLE:

H. G. FISCHER, INC.
FRANKLIN PARK, ILLINOIS

PART NO.

DATE: 5-19-77 | DR. BY: S.W.R. | CH'K'D:

REVISION

FINISH OR COLOR: DEEP ETCH CLEAR ANODIZE-#199

SCALE: FULL SIZE

MATERIAL: 2" x 1" ALUMINUM

TOLERANCES
.X ± .030
.XX ± .010
.XXX ± .005
ANGULAR ± 1/2°
UNLESS OTHERWISE SPECIFIED

USED ON	QTY.
	1

VOID
5-19-77
S.W.R.

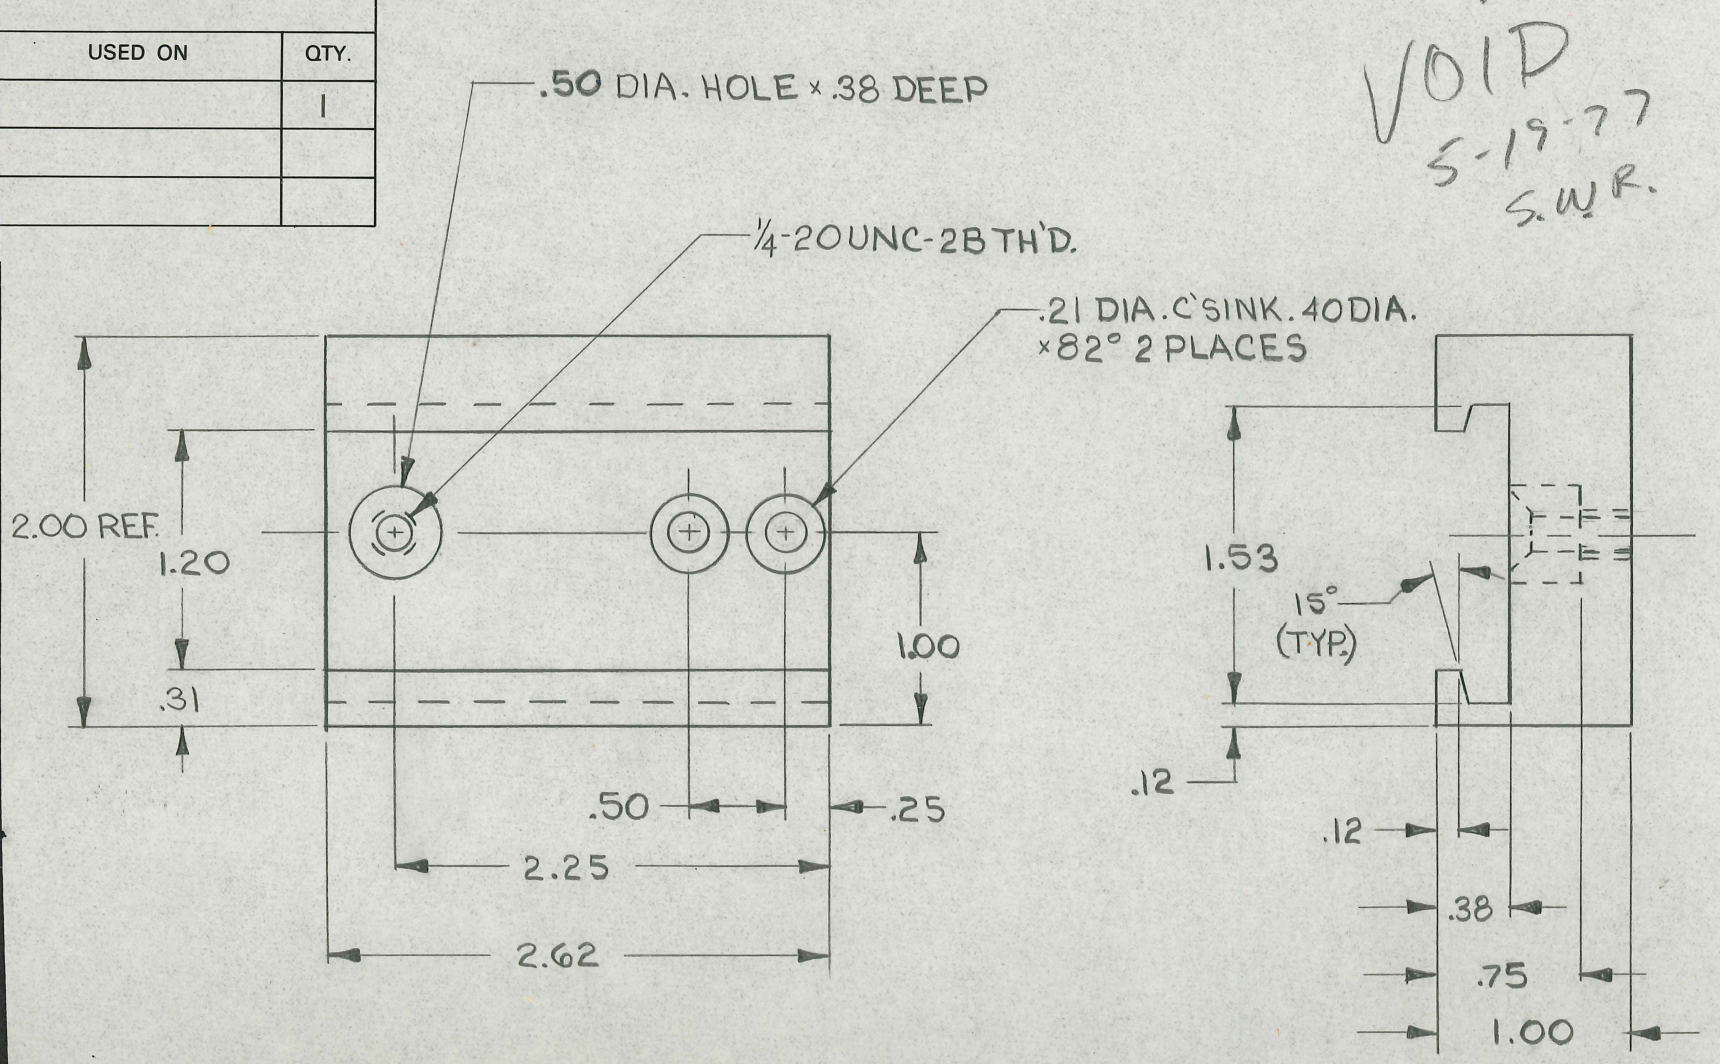

TITLE

DIODE MOUNTING BOARD

H. G. FISCHER & CO.
FRANKLIN PARK, ILLINOIS

PART NO. 673222

DATE 5/5/71	DR. BY A.H.P	CH'K'D.

REVISION		DATE	BY
A	E.C.O. 1738	7-??-??	PA

PATTERN	FINISH	SCALE
		FULL

MATERIAL
1/8 THICK, G-10 PHENOLIC

TOOLS

DIMENSIONS—UNLESS OTHERWISE SPECIFIED:

		THREAD CHAMFER
FRACTIONAL	± .015	UP TO 5/16 D. - 1/32 X 45°
DECIMAL	± .005	3/8 D. & OVER - 1/16 X 45°
ANGULAR	± 1/2°	

REMOVE ALL BURRS & SHARP CORNERS

USED ON	QTY.	USED ON	QTY.
905222	1		

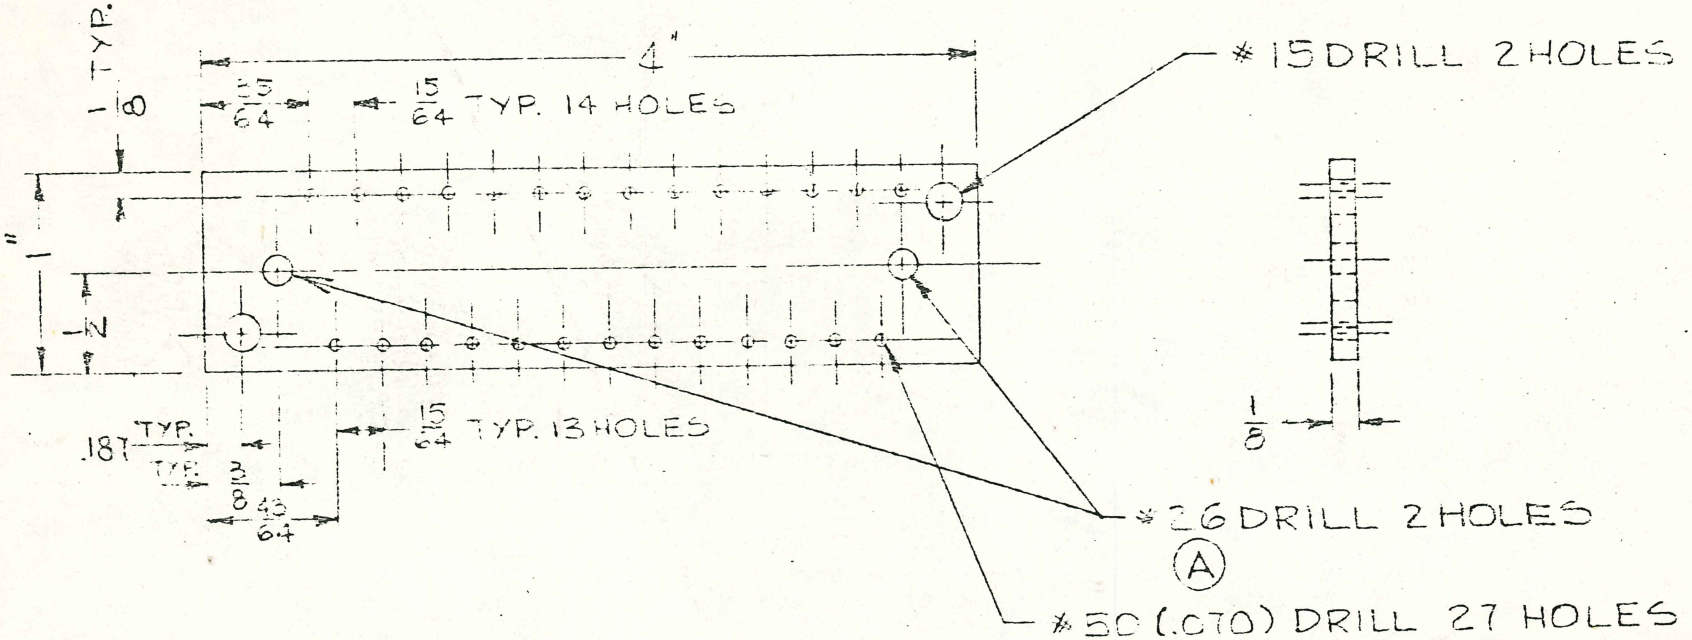

APPROVED SOURCE
METROPOLITAN CENTRAL

DO NOT SCALE DRAWING.

TITLE:

H. G. FISCHER, INC.
FRANKLIN PARK, ILLINOIS

PART NO.

DATE: 10-4-76 | DR. BY: C.B.R. | CH'K'D:

REVISION

FINISH OR COLOR: DEEP ETCH, CLEAR ANODIZE #199

SCALE: FULL SIZE

MATERIAL: 1"x1" ALUMINUM

TOLERANCES
.X ± .030
.XX ± .010
.XXX ± .005
ANGULAR ± 1/2°
UNLESS OTHERWISE SPECIFIED

USED ON	QTY.
	1

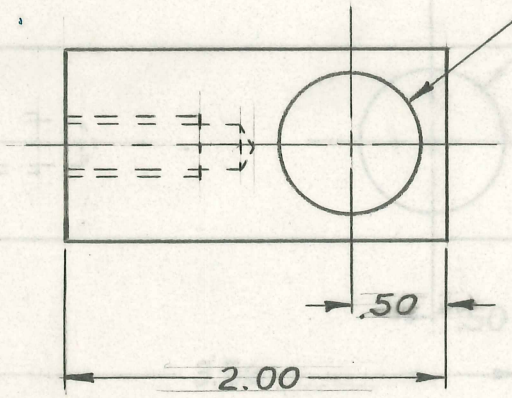

VOID
REVISED & REDRAWN
5-18-77
S.W.R.

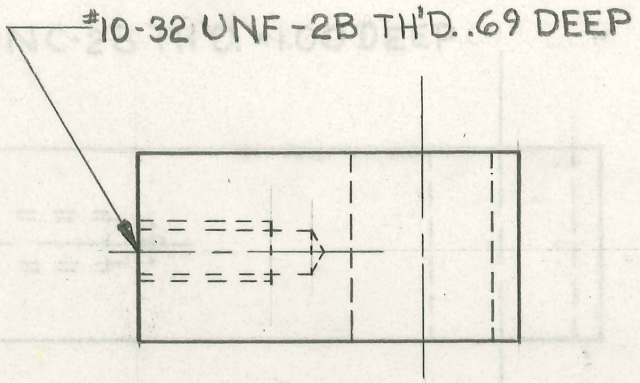

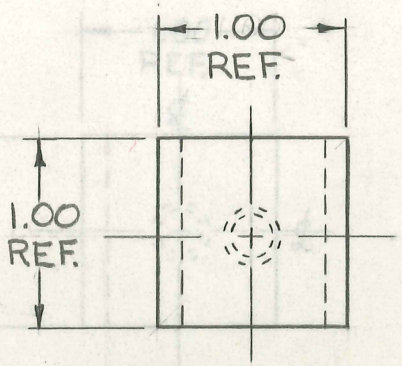

NOTES:

1.) PART TO BE FREE OF ALL BURRS & SHARP EDGES.

TITLE: GUIDE, CASSETTE

H. G. FISCHER, INC.
FRANKLIN PARK, ILLINOIS

PART NO.

DATE: 9-29-76 | DR. BY: C.B.R. | CH'K'D:

REVISION

FINISH OR COLOR: DEEP ETCH, CLEAR ANODIZE #199

SCALE: FULL SIZE

MATERIAL: MAKE FROM #39554

TOLERANCES
.X ± .030
.XX ± .010
.XXX ± .005
ANGULAR ± 1/2°
UNLESS OTHERWISE SPECIFIED

USED ON	QTY.
	1

VOID
REVISED & REDRAWN
5-19-77 S.W.R.

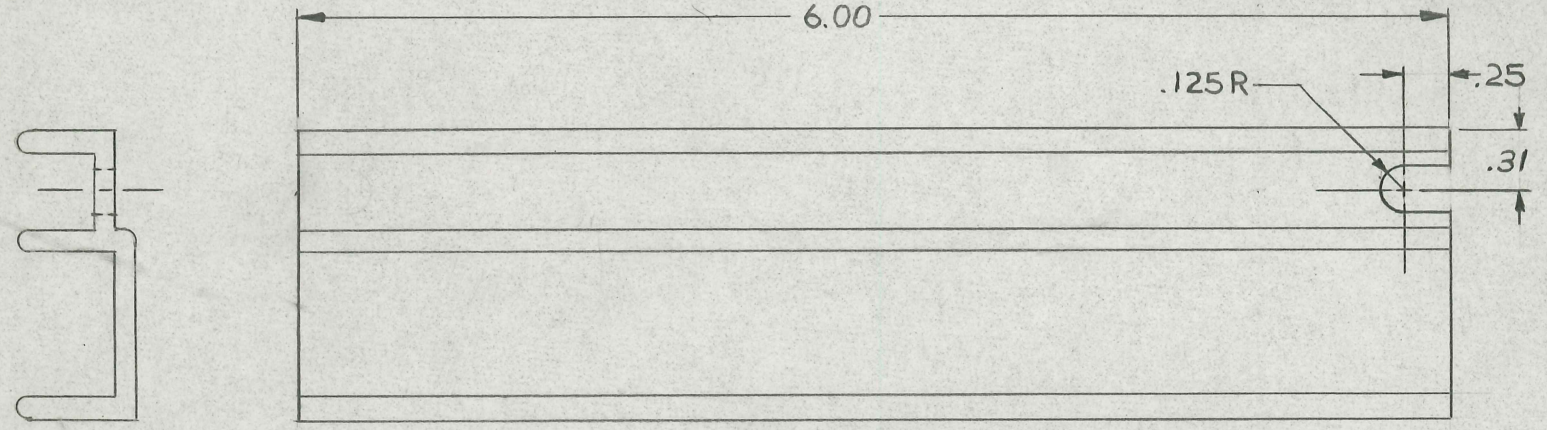

NOTES:

1.) PART TO BE FREE OF ALL BURRS & SHARP EDGES.

TITLE: GUIDE, CASSETTE

H. G. FISCHER, INC.
FRANKLIN PARK, ILLINOIS

PART NO.

DATE: 9-29-76 | DR. BY: C.B.R. | CH'K'D:

REVISION

FINISH OR COLOR: DEEP ETCH, CLEAR ANODIZE #199

SCALE: FULL SIZE

MATERIAL: MAKE FROM #39554

TOLERANCES
.X ± .030
.XX ± .010
.XXX ± .005
ANGULAR ± 1/2°
UNLESS OTHERWISE SPECIFIED

USED ON	QTY.
	1

VOID
REVISED & REDRAWN
5-19-77
S.W.R.

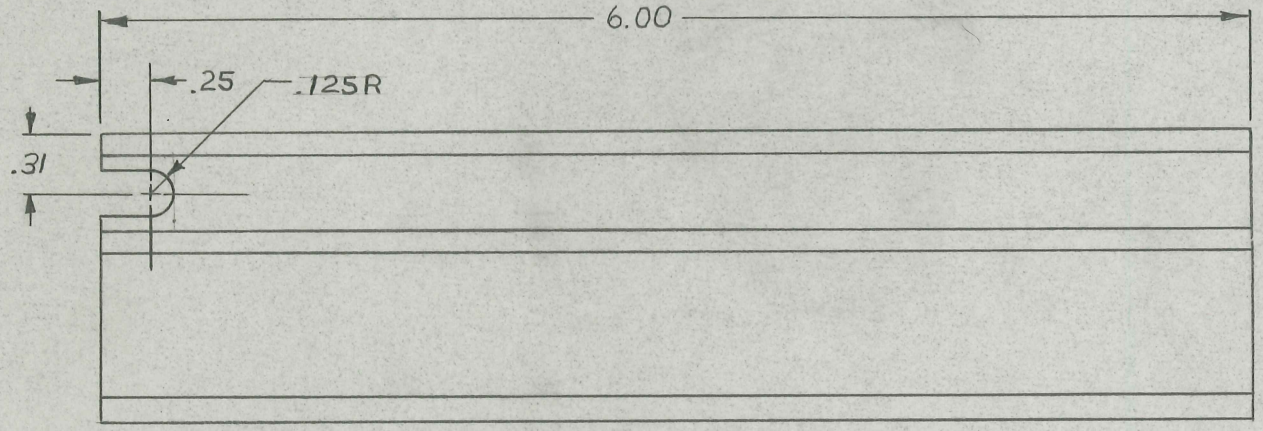

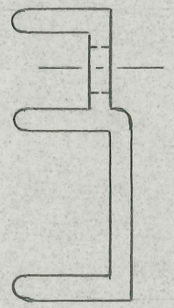

NOTES:

1.) PART TO BE FREE OF ALL BURRS & SHARP EDGES.

TITLE: MOUNTING BRACKET

H. G. FISCHER, INC.
FRANKLIN PARK, ILLINOIS

PART No. 3910-02

DATE: 9/24/74 | DR. BY: A.S.T. | CH'K'D:

REVISION: 1

FINISH:

SCALE: 3/4 X

MATERIAL: #11 GA. (.120) CRS SHEET SPEC: 41-448

DIMENSIONS
.X ± .030
.XX ± .010
.XXX ± .005
ANGULAR ± 1/2°
UNLESS OTHERWISE SPECIFIED

USED ON: 3910-01 (2)

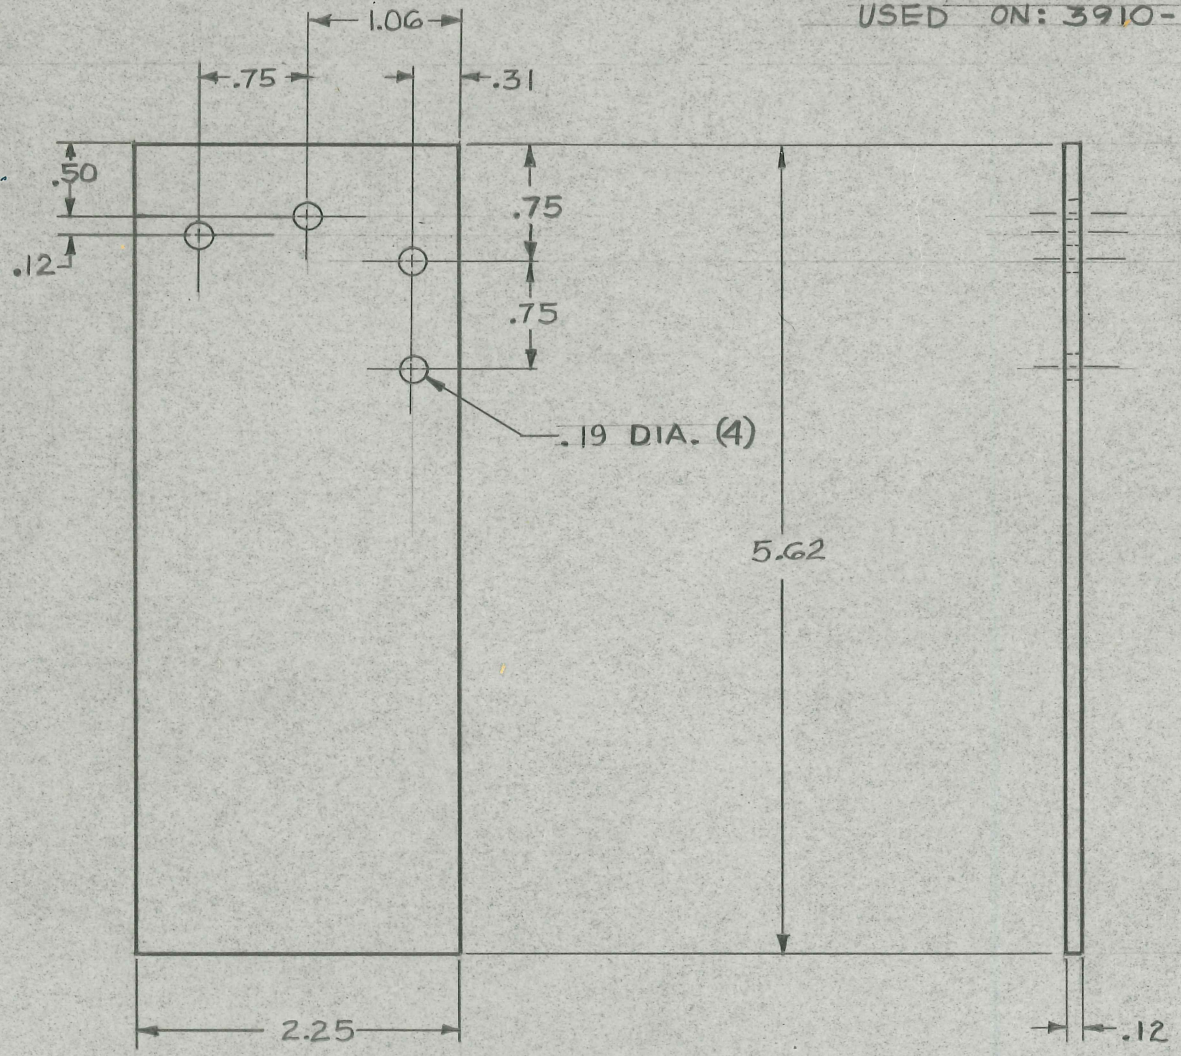

TITLE: 1"x1" SQUARE TUBE

H. G. FISCHER, INC.
FRANKLIN PARK, ILLINOIS

PART No. 3910-03

DATE: 9-25-74 | DR. BY: A.S.T. | CH'K'D:

REVISION: 1

FINISH:

SCALE: 3/8X

MATERIAL: #11 GA.(.120) CRS TUBE (SQ.) SPEC: 55-631

DIMENSIONS UNLESS OTHERWISE SPECIFIED

.X	± .030
.XX	± .010
.XXX	± .005
ANGULAR	± 1/2°

USED ON: 3910-01

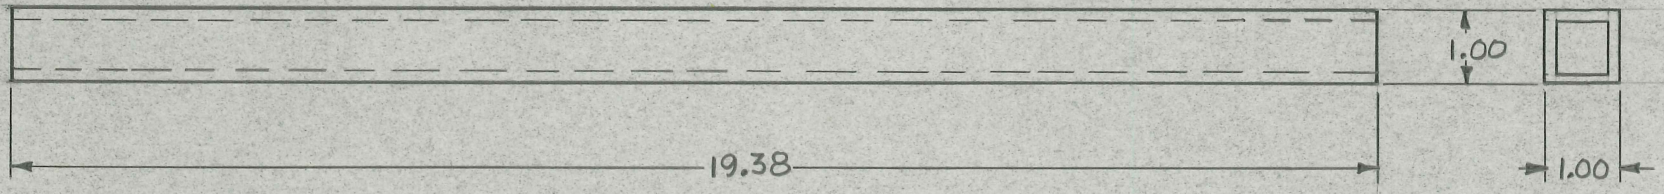

TITLE: MOUNTING MOTOR PLATE

H. G. FISCHER, INC.
FRANKLIN PARK, ILLINOIS

PART No. 3910-04

DATE: 9-25-74 | DR. BY: A.S.T. | CH'K'D:

REVISION: 1

FINISH:

SCALE: 3/4 X

MATERIAL: # 11 GA. (.120) CRS SHEET SPEC: 41-448

DIMENSIONS UNLESS OTHERWISE SPECIFIED
.X ± .030
.XX ± .010
.XXX ± .005
ANGULAR ± 1/2°

USED ON: 3910-01

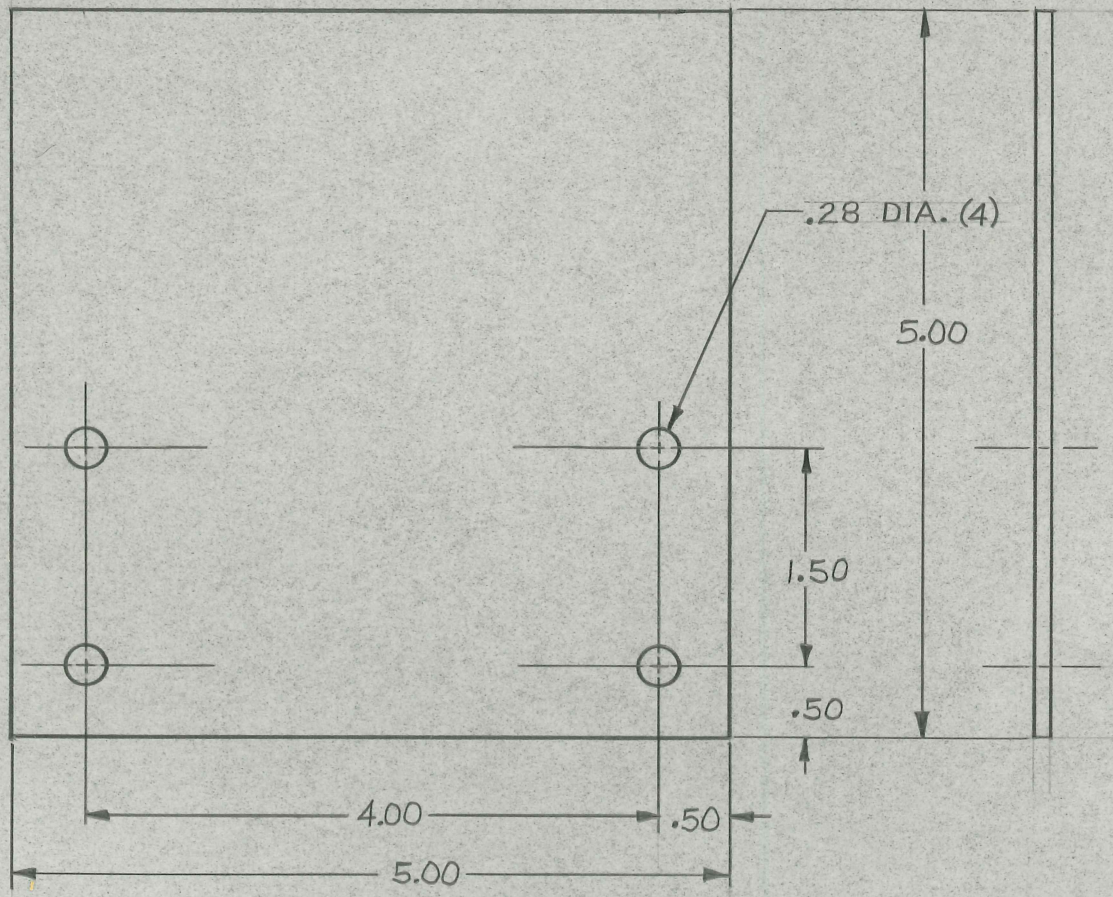

H. G. FISCHER & Co.

MANUFACTURERS

X-RAY AND ELECTRO SURGICAL MEDICAL EQUIPMENT

GENERAL OFFICE 2323-2345 WABANSIA AVE.

CHICAGO

REPRESENTATIVES
IN ALL
PRINCIPAL CITIES
AND FOREIGN COUNTRIES

CABLE ADDRESS
"FISCHERCO"
TELEPHONE
ARMITAGE 0322

February 20, 1941

Dear Doctor:

We are very happy to enclose with this letter another group of abstracts covering the uses of galvanic and contractile currents.

It is our purpose to provide these abstracts, for our friends and customers, as new reports and articles appear in the medical press. We shall appreciate any comments you care to make.

Sincerely yours,

H. G. FISCHER & COMPANY

H. T. Fischer

Vice President

HTF:MW

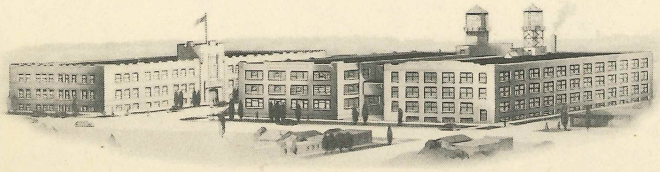

H. G. FISCHER & Co.

MANUFACTURERS

X-RAY AND ELECTRO SURGICAL MEDICAL EQUIPMENT

GENERAL OFFICE AND FACTORY 9451-9491 W. BELMONT AVE

FRANKLIN PARK, ILL.

REPRESENTATIVES IN ALL PRINCIPAL CITIES AND FOREIGN COUNTRIES

CABLE ADDRESS "FISCHERCO"

TELEPHONES FRANKLIN PARK, GLADSTONE 5-0612

CHICAGO, TUXEDO 9-0400

February 6, 1951

J. Paul Spanogle, D. O.
43 Lincoln Way, W.
Chambersburg, Pennsylvania

Dear Doctor Spanogle:

Thank you for your recent request for a copy of our Manual of Simplified X-ray Technic.

We are pleased to send you herewith a copy of our Manual and we hope you will find it to be of some interest and value to you in your work.

If we may be of any further service to you at any time please do not hesitate to call upon us.

Cordially yours,

H. G. FISCHER & CO.

K. M. Miller

Field Service Department

KDM:bc
enc.

H. G. FISCHER & Co.

MANUFACTURERS

X-RAY AND ELECTRO SURGICAL MEDICAL EQUIPMENT

GENERAL OFFICE 2323-2345 WABANSIA AVE.

CHICAGO

REPRESENTATIVES IN ALL PRINCIPAL CITIES AND FOREIGN COUNTRIES

CABLE ADDRESS "FISCHERCO" TELEPHONE ARMITAGE 0322

May 9, 1940.

Dr. F. J. Moeninghoff,
Monett, Missouri.

Dear Dr. Moeninghoff:

We have been requested by our Mr. Charles O. Porter to give you a comparison on the McIntosh Sinustat and the Fischer Model "J", between the following currents:

McIntosh Straight Galvanic Smooth - the equivalent is obtained on the Model "J" by placing your dials on points 1 and 1.

McIntosh Galvanic Wave Uni-Directional - the equivalent is obtained on the Model "J" by placing your dials on 2 and 0.

McIntosh Galvanic Wave Smooth - the equivalent is obtained on the Model "J" by placing your dials on 4 and 1.

Galvanic Wave Rough - This appears to be a rectified AC current, but unfiltered. We do not have this current on our machine.

320 cycle Sinusoidal - the equivalent is obtained on the Model "J" by placing your dials on 2 and 1.

320 cycle Sinusoidal Wave - The equivalent is obtained by placing the dials on the Model "J" on 4 and 2.

If we can be of further service advise us.

Cordially yours,

H. G. FISCHER & CO.

P. P. Muskat

Vice-President.

PPM:F Z.

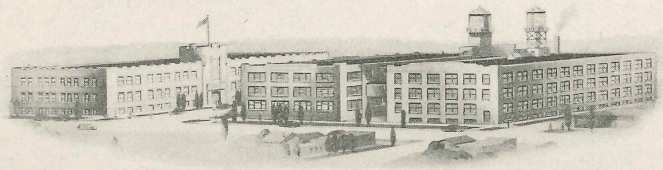

H. G. FISCHER & Co.

MANUFACTURERS

X-RAY AND ELECTRO SURGICAL MEDICAL EQUIPMENT

GENERAL OFFICE 2323-2345 WABANSIA AVE.

CHICAGO 47, ILL.

REPRESENTATIVES
IN ALL
PRINCIPAL CITIES
AND FOREIGN COUNTRIES

CABLE ADDRESS
"FISCHERCO"
TELEPHONE
ARMITAGE 0321

September 23, 1946

F. J. Moennighoff, M.D.
Monett, Missouri

Dear Dr. Moennighoff:

It has just been discovered, Dr. Moenninghoff, that we failed to send you the technic chart and the instructions for the operation and maintenance of your model "J" galvanic and contractile currents generator. We believe that the enclosed instructions will be of assistance to you.

You had asked if we have a service man in your territory. Yes, we do. Mr. G. H. Richardson, 405 South McGuire, Warrensburg, Missouri represents us in your territory.

Yours very truly,

H. G. FISCHER & CO.

M. A. White

MAW:pwr

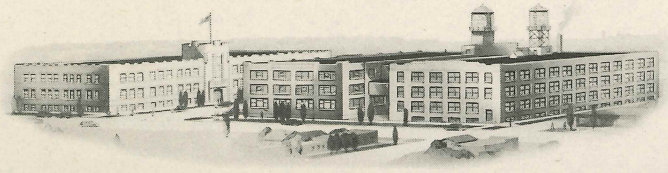

FORM 10 5M 10-21

H. G. Fischer & Co. inc.
MANUFACTURERS
X-RAY AND ELECTRO THERAPEUTIC EQUIPMENT
Home Office 2335-2343 WABANSIA AVE.
Chicago

BRANCHES
DES MOINES, IOWA.
LOS ANGELES, CAL.
MONTREAL, CAN.
LEESBURG, VA.
NEW YORK, N.Y.
PHILADELPHIA, PA.

TELEPHONES
ARMITAGE 323-324

November 8, 1921.

To the Trade:-

On November 10th, 1921, prices on Fischer Dental X-ray Outfits will be reduced to the following schedule:

Cat. No. 540 Fischer No. 1 Dental X-ray Unit, with Coolidge Tube, Shield, Tube Support Arm, Time Switch, Meter and a supply of Films, Developing Chemicals, etc., $600.00

Cat. No. 543 Fischer Dental X-ray Unit "de luxe", with Coolidge Tube, Shield, all necessary Meters, Controls, etc., with a set of Dark Room Supplies & Accessories, $800.00

Cat. No. 816 Fischer Type "R" X-ray Unit, with Tube Support attached; constructed to operate the straight Radiator Coolidge Tube at from 2½ to 5-inch gap at 10 M. A.; with Coolidge Tube, Shield, Meters, Hand Switch on Connecting Cable, and Cord Reels. $650.00

Cat. No. 534 Fischer 2-A Interrupterless X-ray Transformer, with Rheostatic Control, without Accessories, $500.00

Cat. No. 535 Fischer 2-A Interrupterless X-ray Transformer, with 7-inch Gas Tube, Tube Stand, Dental Cone, Fluoroscope Plate Box and all necessary Dark Room Paraphernalia $650.00

Cat. No. 805 Fischer 2-B Interrupterless X-ray Transformer, with Auto Transformer Control, Milli-ampere Meter, Spark Meter, Polarity Indicator, etc., but without Accessories. $645.00

Cat. No. 800 Fischer 2-B Interrupterless X-ray Transformer, complete with all necessary Accessories for proper operation, including Coolidge Tube, Tube Stand, Plate Chest, Fluoroscope, Overhead Wiring, Filament Transformer and Controller, and a large assortment of Plates, Films and Dark Room material. $1000.00

Cat. No. 509, the original Fischer "H5" Dental X-ray Unit, in solid mahogany cabinet, without Accessories, $250.00

Cat. No. 510, Fischer "H5" Dental X-ray Unit, with Gas Tube, Tube Stand, Films, Plates and all necessary Developing Supplies, $360.00

The discount to the trade on all of the foregoing, is 40%, with the exception of the Coolidge Tube, where the discount is to be figured 10% from the face of the invoice, with an additional 10% for payment within ten days from date of invoice.

After November 15th, there will be no Installing Fee deducted from Fischer invoices. Bills as rendered will be net, and installation will be made in every instance, where desired, at actual cost. We have, to-day, Service Stations spread liberally throughout the country, and are in excellent position to take care of sales, installations or trouble service, better than ever before.

We thank you for your valued patronage in the past, and solicit a greater percentage for the future.

Very truly yours,
H. G. FISCHER & CO. INC.

HTF*EW

Boulder Museum of History
1206 Euclid Avenue
Boulder, Colorado 80302

A Brief Outline of the History

of

H. G. FISCHER & COMPANY

INCORPORATED

2333-43 WABANSIA AVENUE

CHICAGO

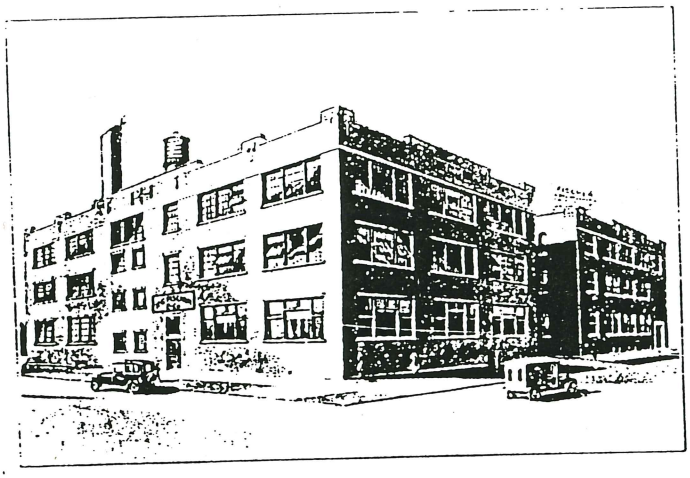

The Home of Fischer

QUALITY, COURTESY
AND SERVICE

2333-43 Wabansia Avenue
CHICAGO

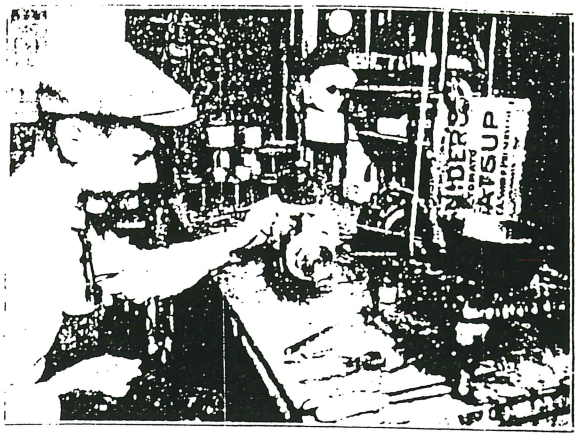

The First Fischer "Factory"

THE HISTORY of H. G. Fischer & Company, Inc., is an industrial epic of accomplishment. From a one-room basement shop to the top of the ladder in an even dozen years. Twelve years of steady, irresistible growth—a victorious march of success—from an *idea* to an *industry*.

Twelve years ago H. G. Fischer & Company, Inc., began the manufacture of High Frequency machines, a type of electrical apparatus which was beginning to find favor among physicians for the treatment of certain forms of disease.

The one-room basement shop, one man and one coil-winding machine comprised the factory and the

manufacturing organization. Truly, not a very elaborate layout—but, behind this modest establishment was an idea—a vision of the future—that Electro-Physiotherapy, practiced along scientific lines, was to be inevitably the one big development in the medical field.

The first Fischer machines were decided improvements over existing types, and found a ready market, and the rapidly increasing demand soon forced a move to larger quarters.

This was the awakening of the seedling—the giant had begun to grow.

The next Fischer Factory was a rented space—a rather secluded building of triangular shape, with the main entrance on an alley.

The number of employes gradually increased, more efficient machines constructed, much experimental work engaged in, and the Fischer line so broadened that in a remarkably short time additional floor space was imperative.

A new mill-constructed building had just been completed in the neighborhood, and the entire third floor was leased.

In less than a year's time the second floor had been added to the third; a year later two neighborhood stores were rented for manufacturing purposes; also a considerable space for storage.

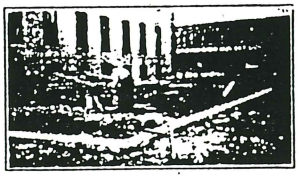

Laying Foundation for Warehouse

The vacant land east was purchased and a steel warehouse erected—and as rapidly as each new space was provided it was filled to overflowing.

Expansion followed expansion—additional property was purchased, and a great, modern three-story mill-constructed brick factory, with the most approved sprinkler system for fire protection, was erected.

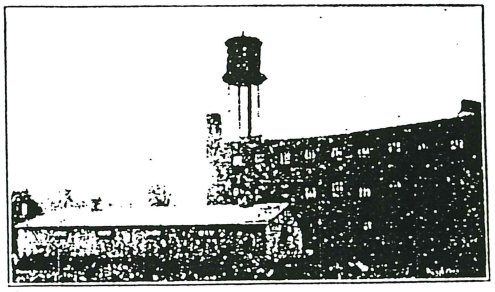

Warehouse Completed

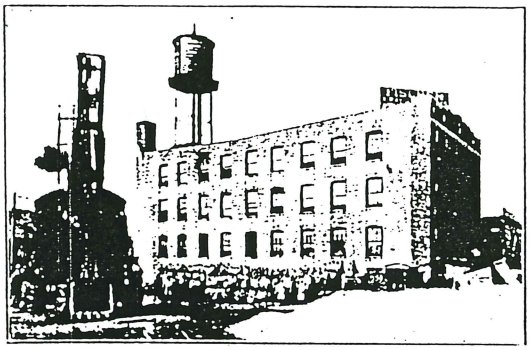

Breaking Ground for the New Factory

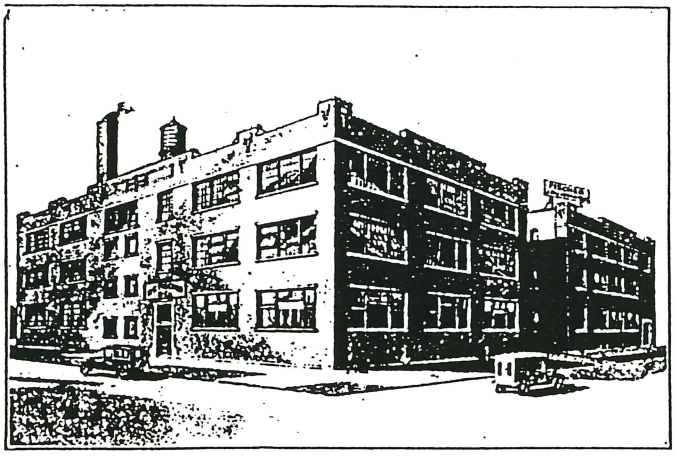

We Now Occupy These Premises, and the Capacity Is Utilized to the Limit

The greatest stimulant toward Physiotherapeutic progress and general acceptance by the medical profession was the recent European war. Physicians and surgeons saw apparently hopeless cases resurrected, and, as has been stated, the Physiotherapy service became in truth "the human salvage service."

H. G. Fischer & Company, Inc., has had a big share in this development. Fischer equipment and Fischer service are well known to thousands of physicians because practically every Reconstruction Hospital and branch of the Veterans' Bureaus was equipped with Fischer apparatus.

New devices and ideas are constantly being developed and tested—there is no let-up in the effort to improve and refine Fischer apparatus, and to increase its usefulness and efficiency. Physicians everywhere are showing their appreciation of and confidence in H. G. Fischer & Company's efforts in producing better equipment and rendering the best possible service, with constant repeat orders—the *finest* tribute.

A trip through the Fischer plant brings out many interesting and educational facts. The pictures in this booklet show but a few of the hundreds of operations involved in the manufacture of Physicians Electrical Equipment.

Take a walk through this splendid, completely equipped plant —we want you to meet the Officers and Directors of H. G. Fischer & Company, Inc., to see the various departments in action, and shake hands with the "boys" who are responsible for the conduct of the institution.

H. G. Fischer
President and Treasurer

H. T. Fischer
Secretary
Director of Sales

P. P. Musket
Vice President
Electrical Engineer

Officers and Directors

Chas. Musket
Director
Factory Superintendent

A. W. Mathis
Director
Manager, Retail Sales

H. H. Osborn
Master Mechanic
Superintendent of Works

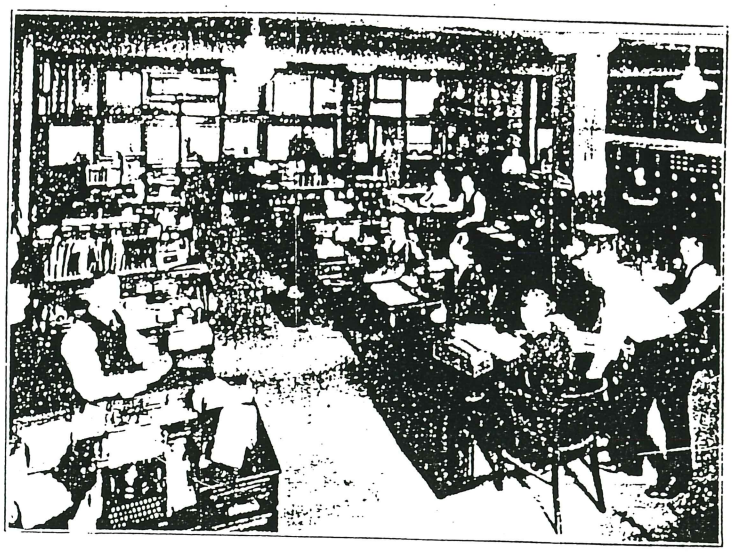

First, let us visit the General Office, shake hands with Mr. P. H. Brown, upon whose shoulders rests the responsibility of office routine, with the many and varied attendant duties.

Here, in an orderly group, are the executive, sales, advertising, order, billing, bookkeeping, service, record, filing, purchasing, costs, draughting and mailing departments.

Accuracy and Service are the watchwords—your rush order received in the morning is entered, filled, shipped and billed often before noon, and any service called for is given attention immediately.

This is our Mailing Department, where upward of 18,000 "Fischer's Magazines" are sent out every month. An educational paper, sent to a select list of physicians, mostly operators of Fischer equipment, offering many valuable suggestions pertaining to the use and care of Electrical Apparatus.

Through this medium H. G. Fischer & Co., Inc., are building up a very close contact with users of their equipment, and are creating a demand as well as bringing about a much broader understanding of the scientific principles which underlie electrotherapy.

Note the steel and concrete vault—a great value is placed on records. Every evening all desks are cleared—the vault receives all valuable papers.

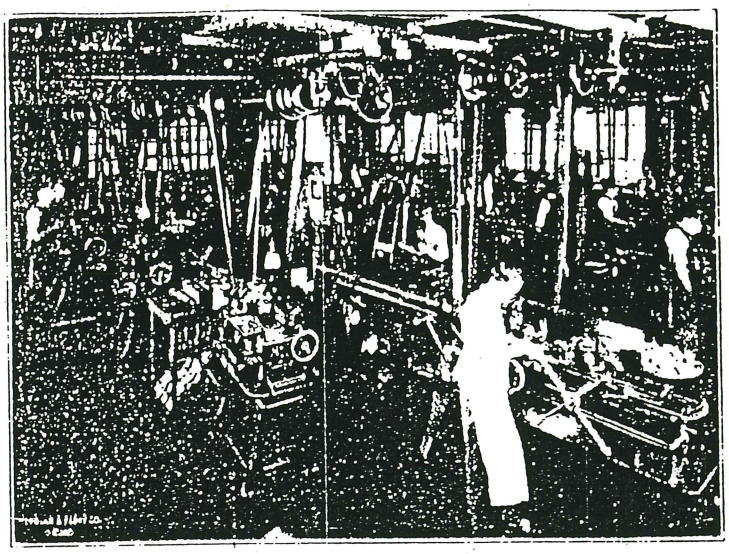

Let us now pass through the plant.

Mr. Chas. Musket, *Factory Superintendent*, bids you welcome to the machine shop. Here the pulsing and humming of busy machines brings a feeling of real activity to the visitor.

Modern machinery, skillfully manned, cutting, punching, grinding, bending and shaping the raw material preparatory to the assembling operations, greets the eye. Automatic equipment is continually chewing up steel, brass, copper, silver, rubber, bakelite, fibre, etc., and turning out parts to the tune of over 50,000 a day.

Bob, our clever toolmakers' foreman, guarantees that his accurately made tools, jigs and dies will exactly duplicate parts—that's why replacements on Fischer Apparatus are easy to take care of.

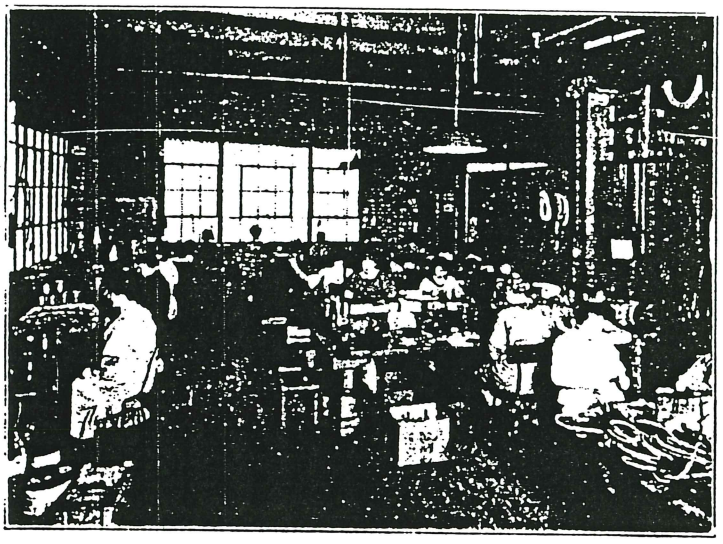

Mr. John Ingstad is foreman of the Coil Winding and Cable Department.

Did you ever stop to figure that it takes thousands of turns of wire, sometimes no heavier than a hair, totalling many thousands of feet, yes, several miles, to make a high tension transformer such as is used in X-ray and Diathermy machines?

Every turn is counted—every turn and layer is carefully insulated from the others, that the finished product may be guaranteed against breakdown.

If you could look through the wall to the right you would see these same coils being carefully bound and mounted, ready for their final immersion into oil tanks.

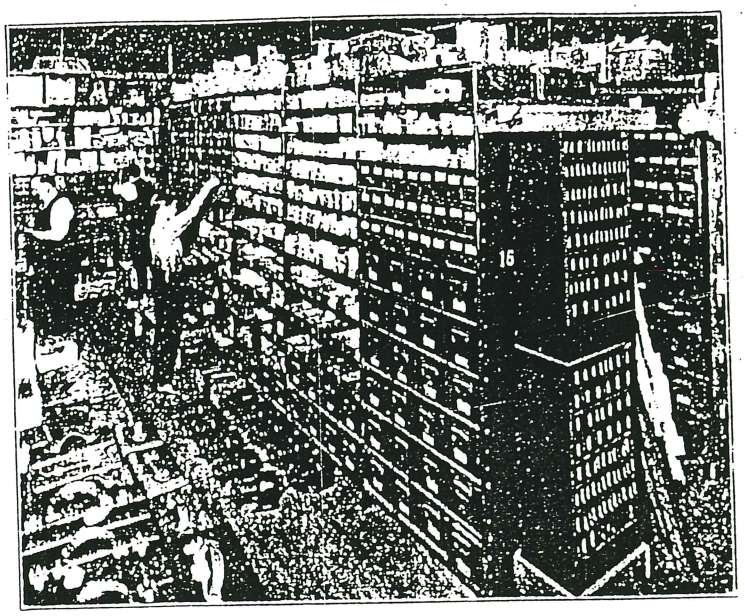

What do we do now with all these intricate and numerous parts? Let's go in the Part Stock Room and ask Mr. Frank Emmerling, who has charge.

Too bad we can't show you the other tiers of steel stock racks, but the camera man said it was too difficult. Inventory figures show just how many hundreds of thousands of parts are always carried on hand in this section.

Every part is ordered out on requisition, and every part, having been carefully gauged and made with properly designed tools, will fit just exactly where it is intended without alteration.

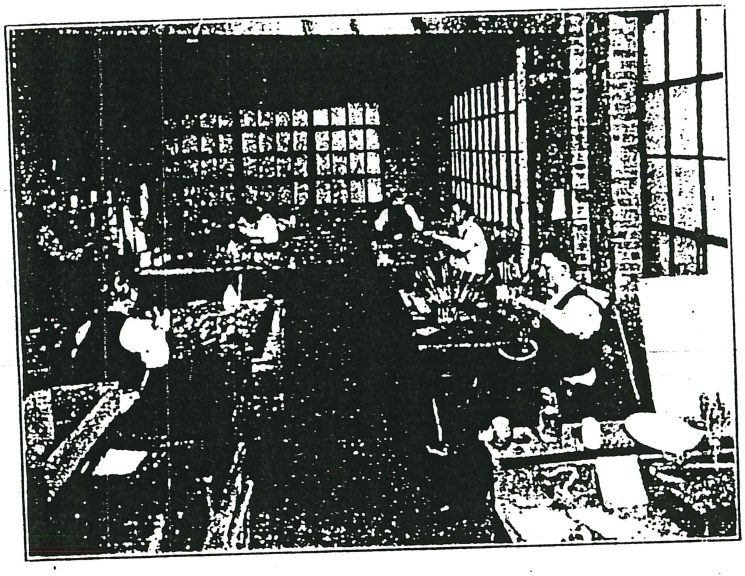

Did you know that we did all our own Glass Blowing? Meet Mr. Ed. Wandner, who is a past master in the art of making brittle, plain glass tubing into seemingly impossible shapes.

Not Ed. alone—all of our glass-blowers are masters of their trade. We make our own X-ray tubes, high frequency electrodes, insulating tubes, and effect all manner of glass repairs.

You can draw your own conclusions as to the value of being able to produce vacuum tubes of all types, pumped just exactly correct for the apparatus with which such tubes are to be used.

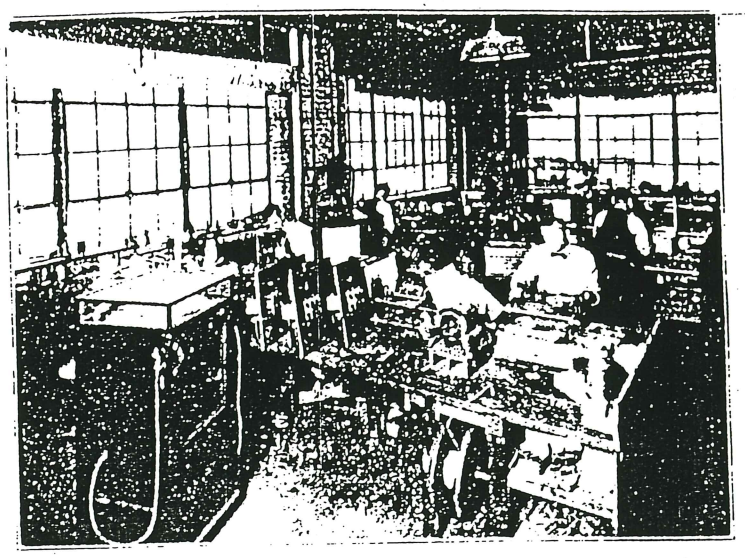

So far you have seen a lot of parts being made up—let's go into the Assembling Department; we want you to shake hands with Mr. Arthur Nowicki. Art has been with us for so long that he can put electrical apparatus together with his eyes closed, and get it right.

In this picture is shown only a small corner of the assembling floor. A personal visit, with plenty of time allowed for each step, is necessary before one can grasp the importance of this division.

Here the parts are taken from stock and built into cabinets or portable carrying cases under careful, constant supervision.

Every item manufactured by H. G. Fischer & Company, Inc., or which passes through our hands must go through the Inspection Department. Mr. Joe Herzog sure is one excellent sleuth when it comes to locating defects—he really should be a member of the Pinkerton staff.

Never mind, Joe, we mean that as a compliment. We must find errors, if errors there are, right here; and we do correct many items. On the other hand, there are mighty few complaints from our customers simply because we do pay so much attention to careful inspection and testing.

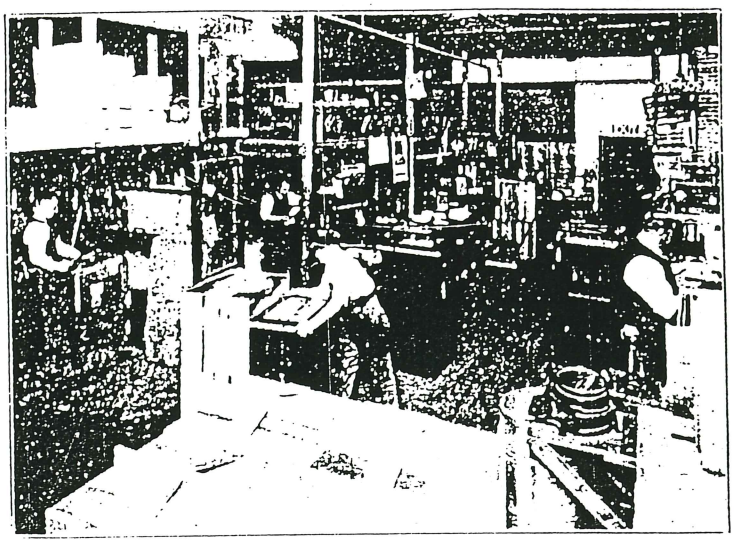

A very important cog in the wheel is our Shipping Department. Meet Mr. Ed. Oberdieck, who presides therein—fat, healthy and smiling.

Well, one needs all three in a crowded shipping room. Only the best of packing materials are used tissue paper, paper cartons and boxes, wooden crates and wooden boxes to insure our goods arriving in perfect condition at destination, whether five miles away or five thousand miles.

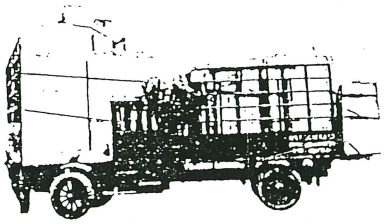

The "Fischer" Trucks

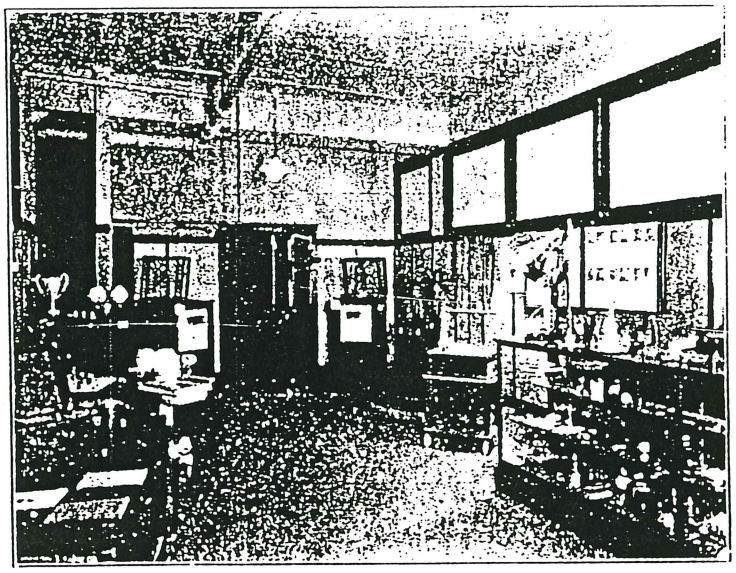

We surely must take you through our demonstrating room, where we have completed outfits on exhibition. Here you will see all the very latest machines for electro-physiotherapy work, as well as a most complete line of accessories, and we are always ever-ready to make demonstrations.

Lectures and clinics are calendared for the second Monday of every month in this room. Over 18,000 invitations are extended each month, and physicians especially talented in particular phases of electrotherapeutic work appear on the program. This service alone is just one of the many sides of the educational work carried on continually by H. G. Fischer & Company, Inc.

Do you recognize any of these folks? They are the officers and most of the sales force of H. G. Fischer & Company, Inc. Photo was made at a recent get-together festival here at Chicago.

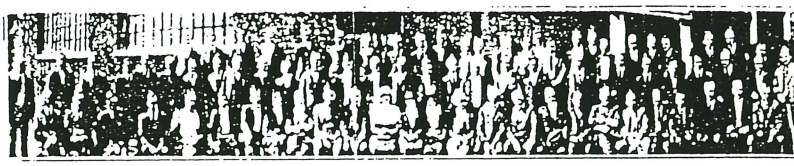

Perhaps you will recognize yourself in this photograph, taken at a Fischer Convention in 1921. The Educational Department is ever on the watch for opportunities to help Physicians master Physiotherapy.

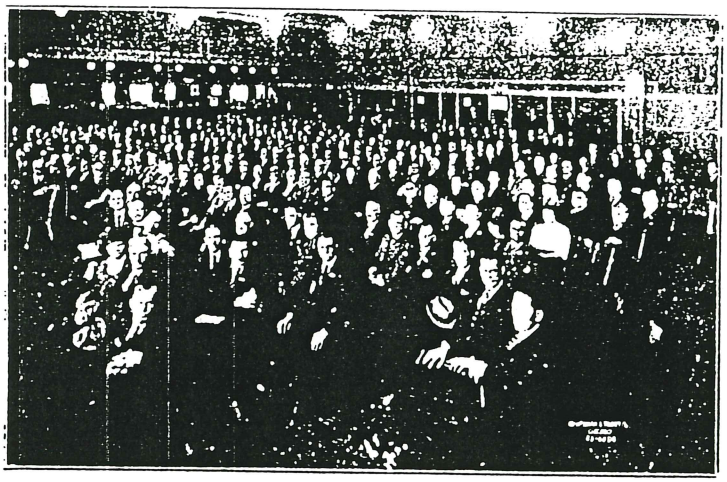

Here is a splendidly representative gathering of physicians from 31 of these United States and 3 foreign countries, who attended a recent physicians' meeting at the invitation of H. G. Fischer & Company, Inc., at Chicago.

This illustration shows only about one-half of the almost 700 attendants, who were so pleased with our efforts in promoting the meeting that they presented us with this beautiful Loving Cup, inscribed:

To

H. G. Fischer & Company, Inc.,

in appreciation of their efforts to promote medical efficiency by inaugurating the Physiotherapeutic Meeting in Chicago, October 15 to 19, 1923

from

The Physicians in Attendance

A Fischer Company Picnic

The Employes (or, as they are most often referred to, the "business associates") of H. G. Fischer & Company, Inc., are kept in close touch with conditions through the activities of their Welfare League —consisting of and controlled by themselves entirely.

The Annual Picnic out in the woods, and the periodic receptions and dances are eagerly looked forward to by all. These meetings outside business hours, as well as the many gatherings of the heads of the departments each week, serve to enlighten, strengthen and intensify Fischer Service both inside and outside the factory.

Our Story Was Brief—

Let us add, that *your welfare is our welfare.*

Co-operation is a word that possibly has been overworked to a great extent, but to us it means just this—if we can give you the benefit of our vast manufacturing and experimental experience, extending over a period of twelve years, we are always glad to do so.

Being in constant contact with the physicians who are employing electro-physiotherapy daily, we are able to suggest plans and ideas that will be advantageous to you from many angles.

When in doubt, consult
"The House of Service."

The Fischer Employe's Creed

I believe in the work I am turning out, in the firm I am working for, and in my ability to get results.

I believe that honest work can be handed out by honest methods.

I believe in turning out every bit of my work of such quality that I would be proud of it if I were paying for it myself.

I believe in working, not weeping; in boosting, not knocking; and in the pleasure of my job.

I believe in clean working conditions, and consider it a duty to myself to assist in keeping my department orderly and sanitary.

I believe that a man gets what he goes after, and that one deed done today is worth two deeds tomorrow, and that no man is down and out until he has lost faith in himself.

I believe in today and the work I am doing, in tomorrow and the work I hope to do, and in the reward which the future holds.

I believe that in attempting to pass the buck I would only display ignorance and prove my incapacity.

I believe in preparing myself for advancement so that the firm I work for need not look to outsiders to fill the more important positions.

I believe in courtesy, in kindness, in generosity, in good cheer, in friendship, in open minded criticism and in honest competition.

I believe there is something doing for every man ready to do it.

I believe I'll get ready

RIGHT NOW